



NEW YORK STATE THRUWAY AUTHORITY
PLANS FOR CONSTRUCTING ACCELERATION AND DECELERATION LANES ON A PORTION OF THE
NEW YORK STATE THRUWAY, ONTARIO SECTION: Subdivision 8A
 From Station 2244+52 to Station 2287+80, a length of 0.82 mile in the Town of Salina
 AND FOR CONSTRUCTING THE
ELECTRONICS PARKWAY (HOPKINS ROAD) INTERCHANGE
 At Station 2264+95, a length of 1.51 miles in the Town of Salina
 A TOTAL LENGTH OF 2.33 MILES CONTRACT No. O.T. 53-8
 AND FOR CONSTRUCTING ACCELERATION AND DECELERATION LANES ON A PORTION OF THE
NEW YORK STATE THRUWAY, MOHAWK SECTION: Subdivision 8B
 From Station 2502+47 to Station 2542+11, a length of 0.75 mile in the Town of DeWitt
 AND FOR CONSTRUCTING THE
THOMPSON ROAD INTERCHANGE
 At Station 2519+90, a length of 1.30 miles in the Town of DeWitt
 A TOTAL LENGTH OF 2.05 MILES CONTRACT No. M.T. 53-8
 AND FOR CONSTRUCTING PORTIONS OF
ELECTRONICS PARKWAY (HOPKINS ROAD)
 From Station 29+20 to Station 42+65, a length of 0.25 mile in the Town of Salina
EXTENSION OF SEVENTH NORTH STREET
 From Station 3+53 to Station 20+92, a length of 0.33 mile in the Town of Salina
THOMPSON ROAD
 From Station B 9+10 to Station B 42+36, a length of 0.78 mile in the Town of DeWitt
COLLEGE PLACE
 From Station C 15+00 to Station C 26+89, a length of 0.22 mile in the Town of DeWitt
 A TOTAL LENGTH OF 1.50 MILES CONTRACT No. S.T. 53-20
 AND FOR RECONSTRUCTING A PORTION OF THE
SYRACUSE - BRIDGEPORT, PART 1 (KINNE ST.) S.H. No. 672
 Between Station 22+32 and Station 46+33, a length of 0.62 mile in the Town of DeWitt
 CONTRACT No. R.C. 53-36
 66 SHEETS A TOTAL COMBINED LENGTH OF 6.58 MILES
ONONDAGA COUNTY

COUNTY	SHEET No.	TOTAL SHEETS
ONONDAGA	1	66
N.Y. STATE THRUWAY, ONTARIO SECTION, SUB DIV. 8A		
INTERCHANGE AT ELECTRONICS PARKWAY (HOPKINS ROAD)		
N.Y. STATE THRUWAY, MOHAWK SECTION, SUB DIV. 8B		
INTERCHANGE AT THOMPSON ROAD		

TYPE OF CONSTRUCTION	
Reinforced Cement Concrete Pavement	4.16 Miles
Asphalt Concrete, Type 1A, Opt.	0.37 Mile
Foundation Course-Gravel	0.20 Mile
Miscellaneous Work	1.85 Miles

Including
 H.G.S., Electronics P'kwy Interchange Station 2264+95
 Composite Beam, 4 Spans, 2 @ 37' 9", 1 @ 64' 9",
 1 @ 57' 9"


H.G.S., Thompson Road, Station 2509+00 Comp. Beam,
 4 Spans, 2 @ 39' 0", 1 @ 59' 10", 1 @ 67' 1"

H.G.S., Thompson Road Interchange, Station 2519+90
 Composite Beam, 4 Spans, 1 @ 37' 9", 1 @ 64' 9",
 1 @ 57' 9", 1 @ 37' 3"

H.G.S., Kinne St. (Relocating of S.H. 672) Sta. 2549+40
 Composite Beam, 4 Spans, 2 @ 37' 6", 2 @ 72' 9"

STANDARD STRUCTURE SHEETS
 39-9, 46-4, 47-37, 49-65, 49-7, 49-42, 50-1R, 50-34,
 51-3, 51-11R, 51-11W, 51-20, 51-21, 51-40, 52-17A,
 52-17B, 52-17C, 52-17D, 52-43, 53-41, 53-106

All work contemplated under this contract to be covered
 by and in conformity with the specifications adopted
 January 2, 1951, except as modified on these plans and
 in the Itemized Proposal.

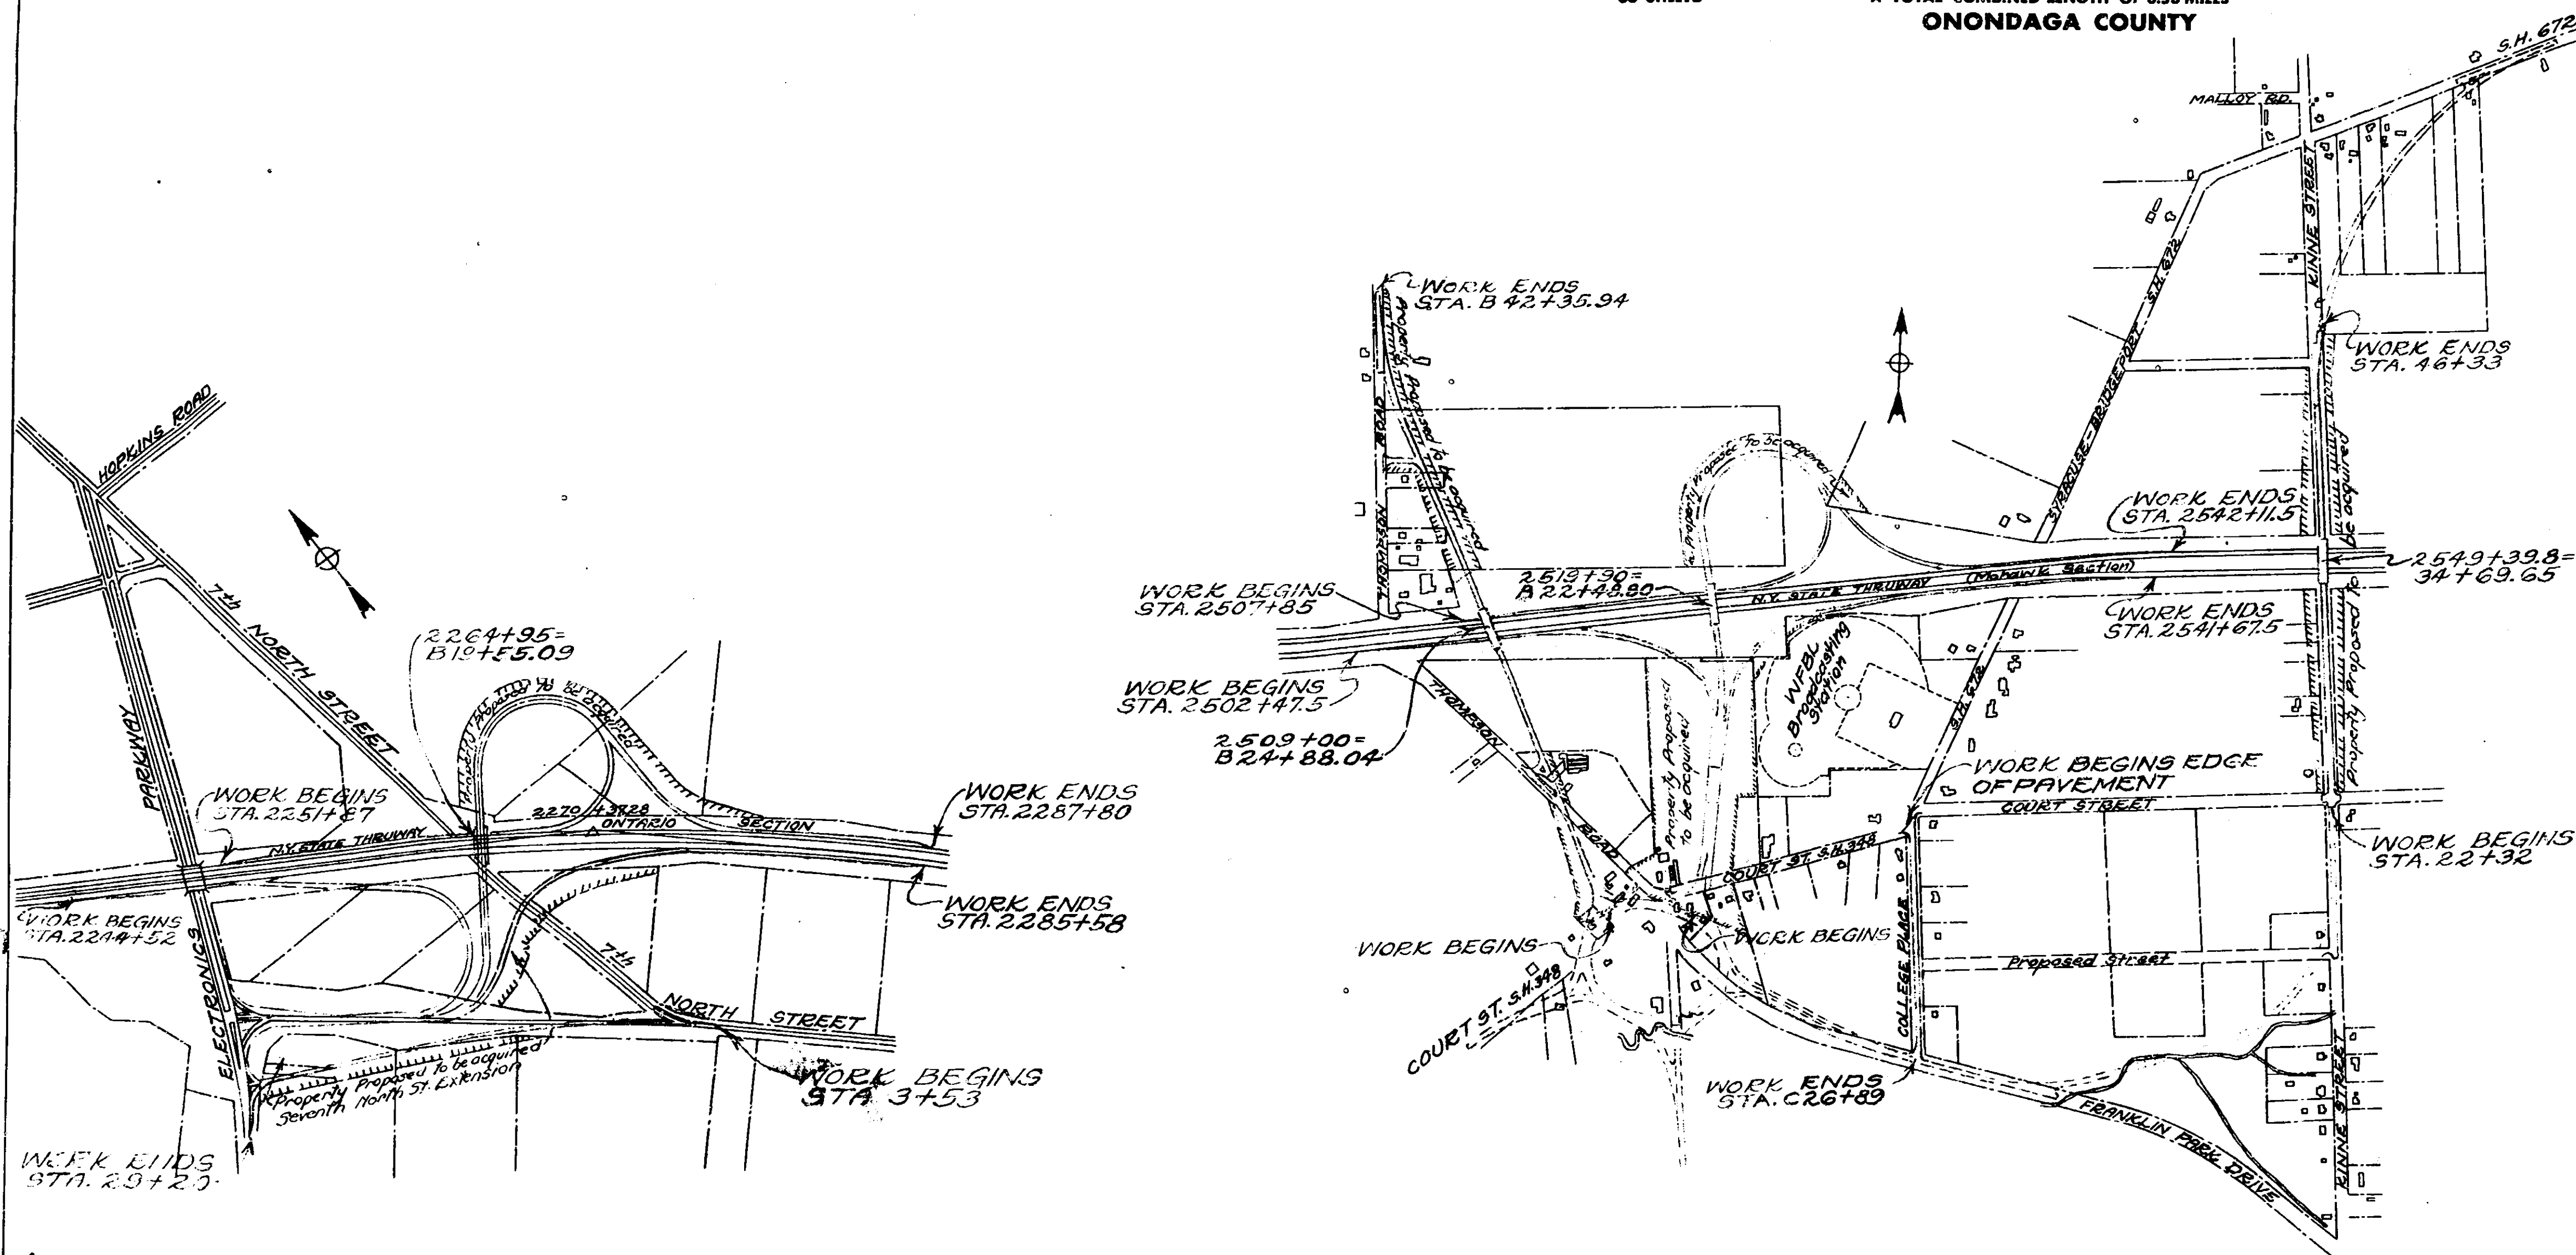

INTERCHANGE AT ELECTRONICS PARKWAY


INTERCHANGE AT THOMPSON ROAD

Made By D. F. Huchart Traced By D. F. Huchart Checked By W. G. Hoffmann
 O.T. 53-8, M.T. 53-8, S.T. 53-20, R.C. 53-36

Prepared pursuant to the
 Highway Law and recommended by
 4/1/53
 Engineer District No. 3

O.T. 53-8, M.T. 53-8, S.T. 53-20, R.C. 53-36


NEW YORK STATE DEPARTMENT OF PUBLIC WORKS DIVISION OF CONSTRUCTION	
Approved <u>Cepis 16</u> 1953	J. B. MORRAN Chief Engineer
Approved <u>Apr 16</u> 1953	E. T. GAWKINS Deputy Chief Engineer
Approved <u>APRIL 16</u> 1953	E. W. WENDELL Deputy Chief Engineer
Approved <u>Apr 16</u> 1953	
NEW YORK STATE THRUWAY AUTHORITY	
B. D. TALLAMY, Chairman	
By: <u>C. H. LANG</u> Deputy Chief Engineer	

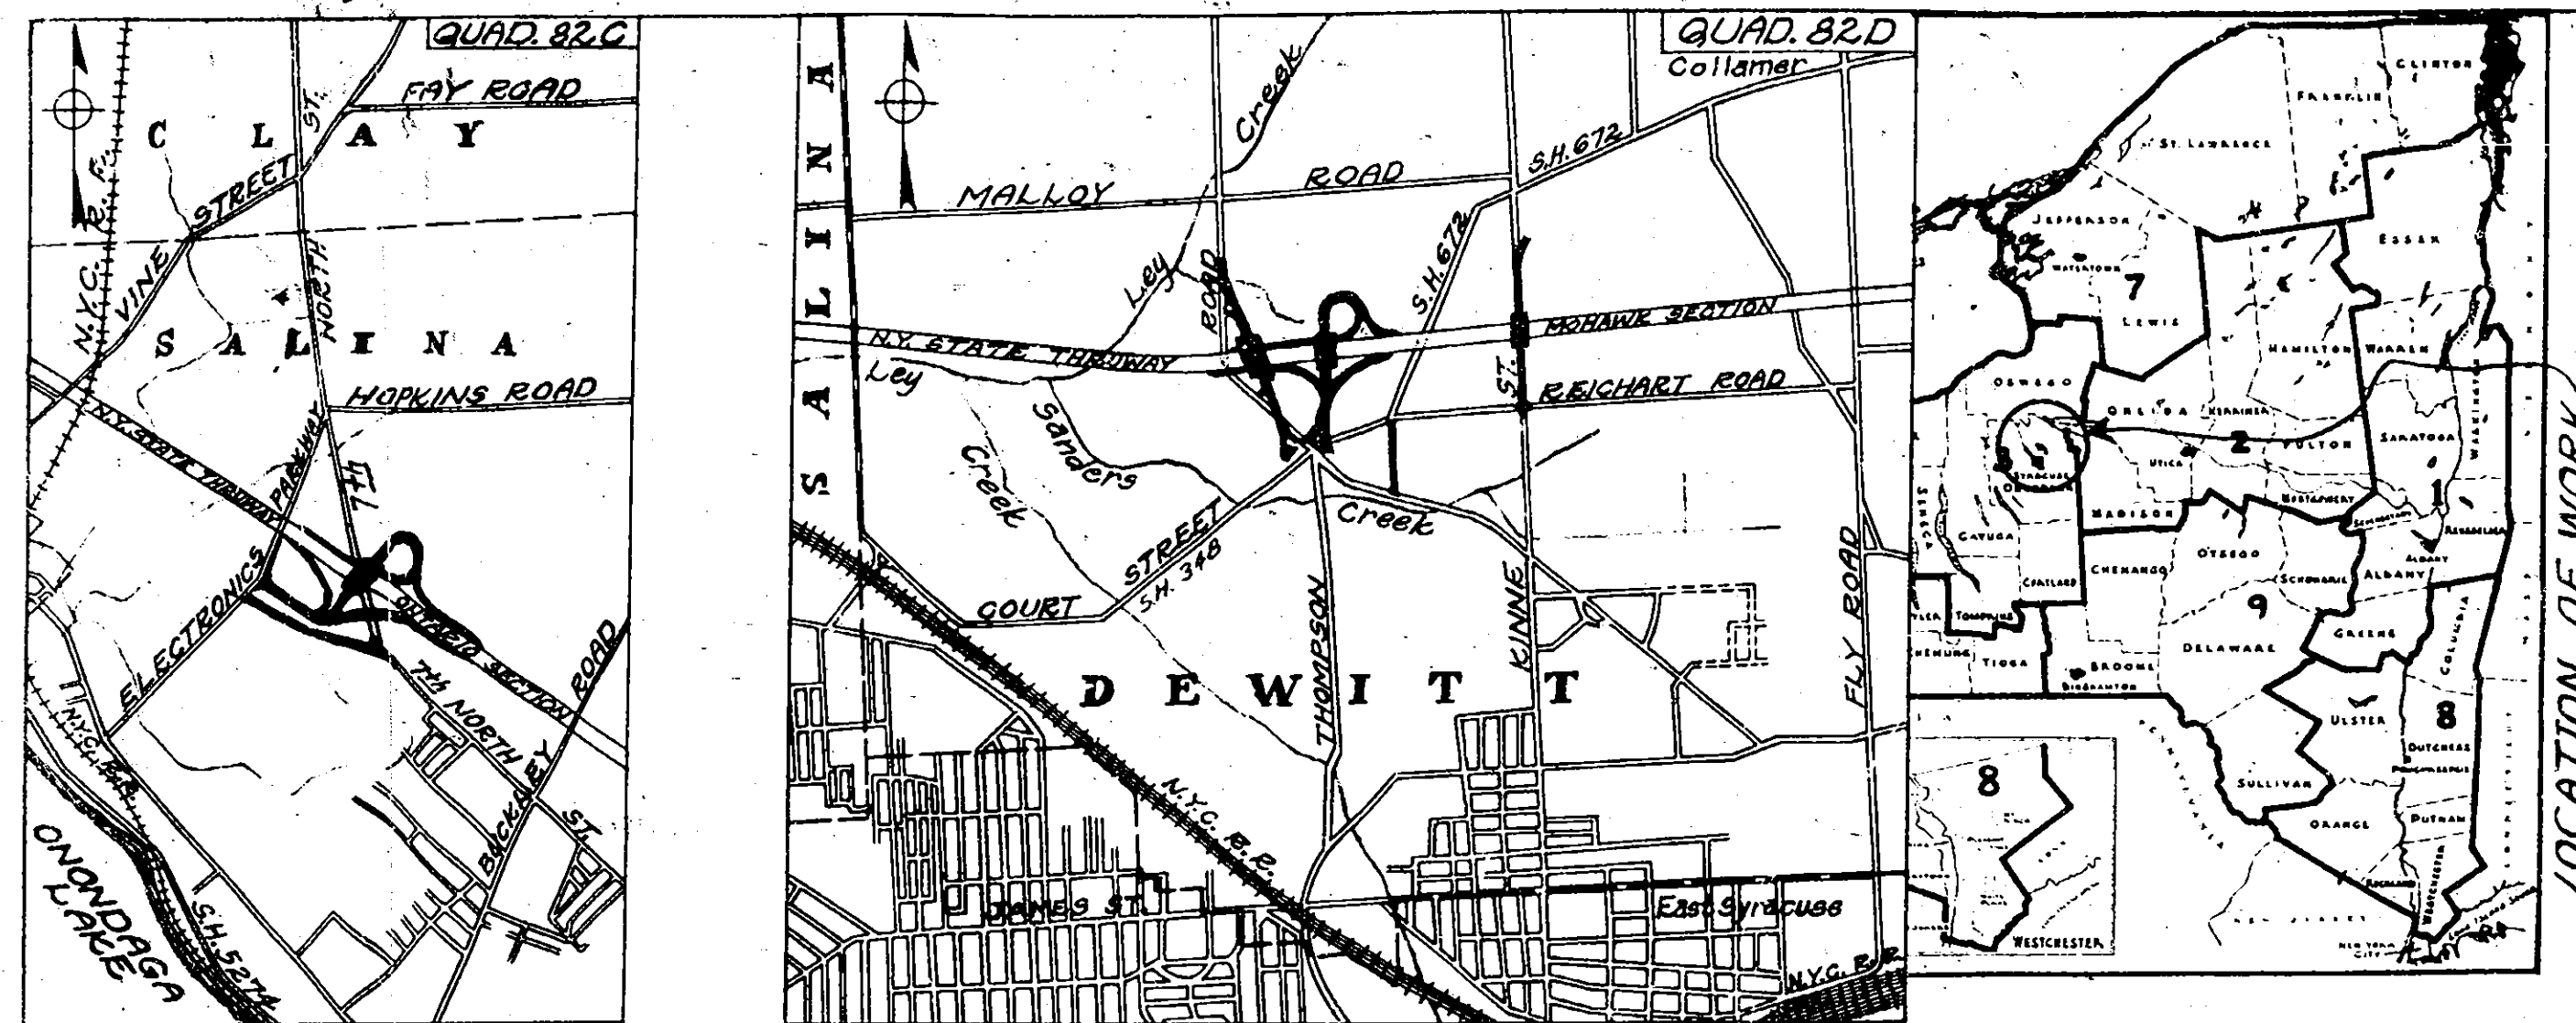

CONTRACT NO.	TYPE	LENGTH FEET	W.D.P. FEET	THICK OF TOP	S.Y. PAVE.	C.Y. CONC.	TONS OF TOP	MATERIALS SAND, GRAVEL, ASPHALT	CEMENT	ASPH. CONC.	GRAVEL ACCESS RD.
MT 53-8	REINF. CONC.	11,922	2.33	Various	Various	24,680	5,817	ALPHA			
OT 53-8	REINF. CONC.	13,170	2.49	Various	Various	26,473	6,422	ATLAS			
RC 53-36	REINF. CONC.	2,112	0.52	24"	44"	5,794	1,448	LEHIGH			710
ST 53-20 - Concrete Pave	REINF. CONC.	1,194	0.23	22"	34"	3,326	468	FEDERAL	BARRETT		
Thompson Road	REINF. CONC.	4,232	0.76	24"	44"	8,970	2,243	No. AMER.			
Hopkins Road	REINF. CONC.	11,89	0.22	12"	16"	11,57	239	CENTURY			
Seventh North St.	REINF. CONC.	2,320	0.48	24"	44"	6,797	1,699				
DATE OF CONTRACT	DATE OF STARTING	DATE OF COMPLETION	DATE OF ACCEPTANCE								
MAY 21, 1953	MAY 19, 1953	SEPT. 23, 1954	SEPT. 23, 1954								

CONTRACTOR: W.E. O'NEIL CONST. CO., INC.
DISTRICT ENGR: W.M. ROBINSON
ENGR-IN-CHARGE: H.D. ROUNDS

Seventh North St. Extension (County Rd 45)
to be maintained by Onondaga County,
by letter dated March 11, 1955 under
Art. 2, Title 9 of the Public Authorities Law.

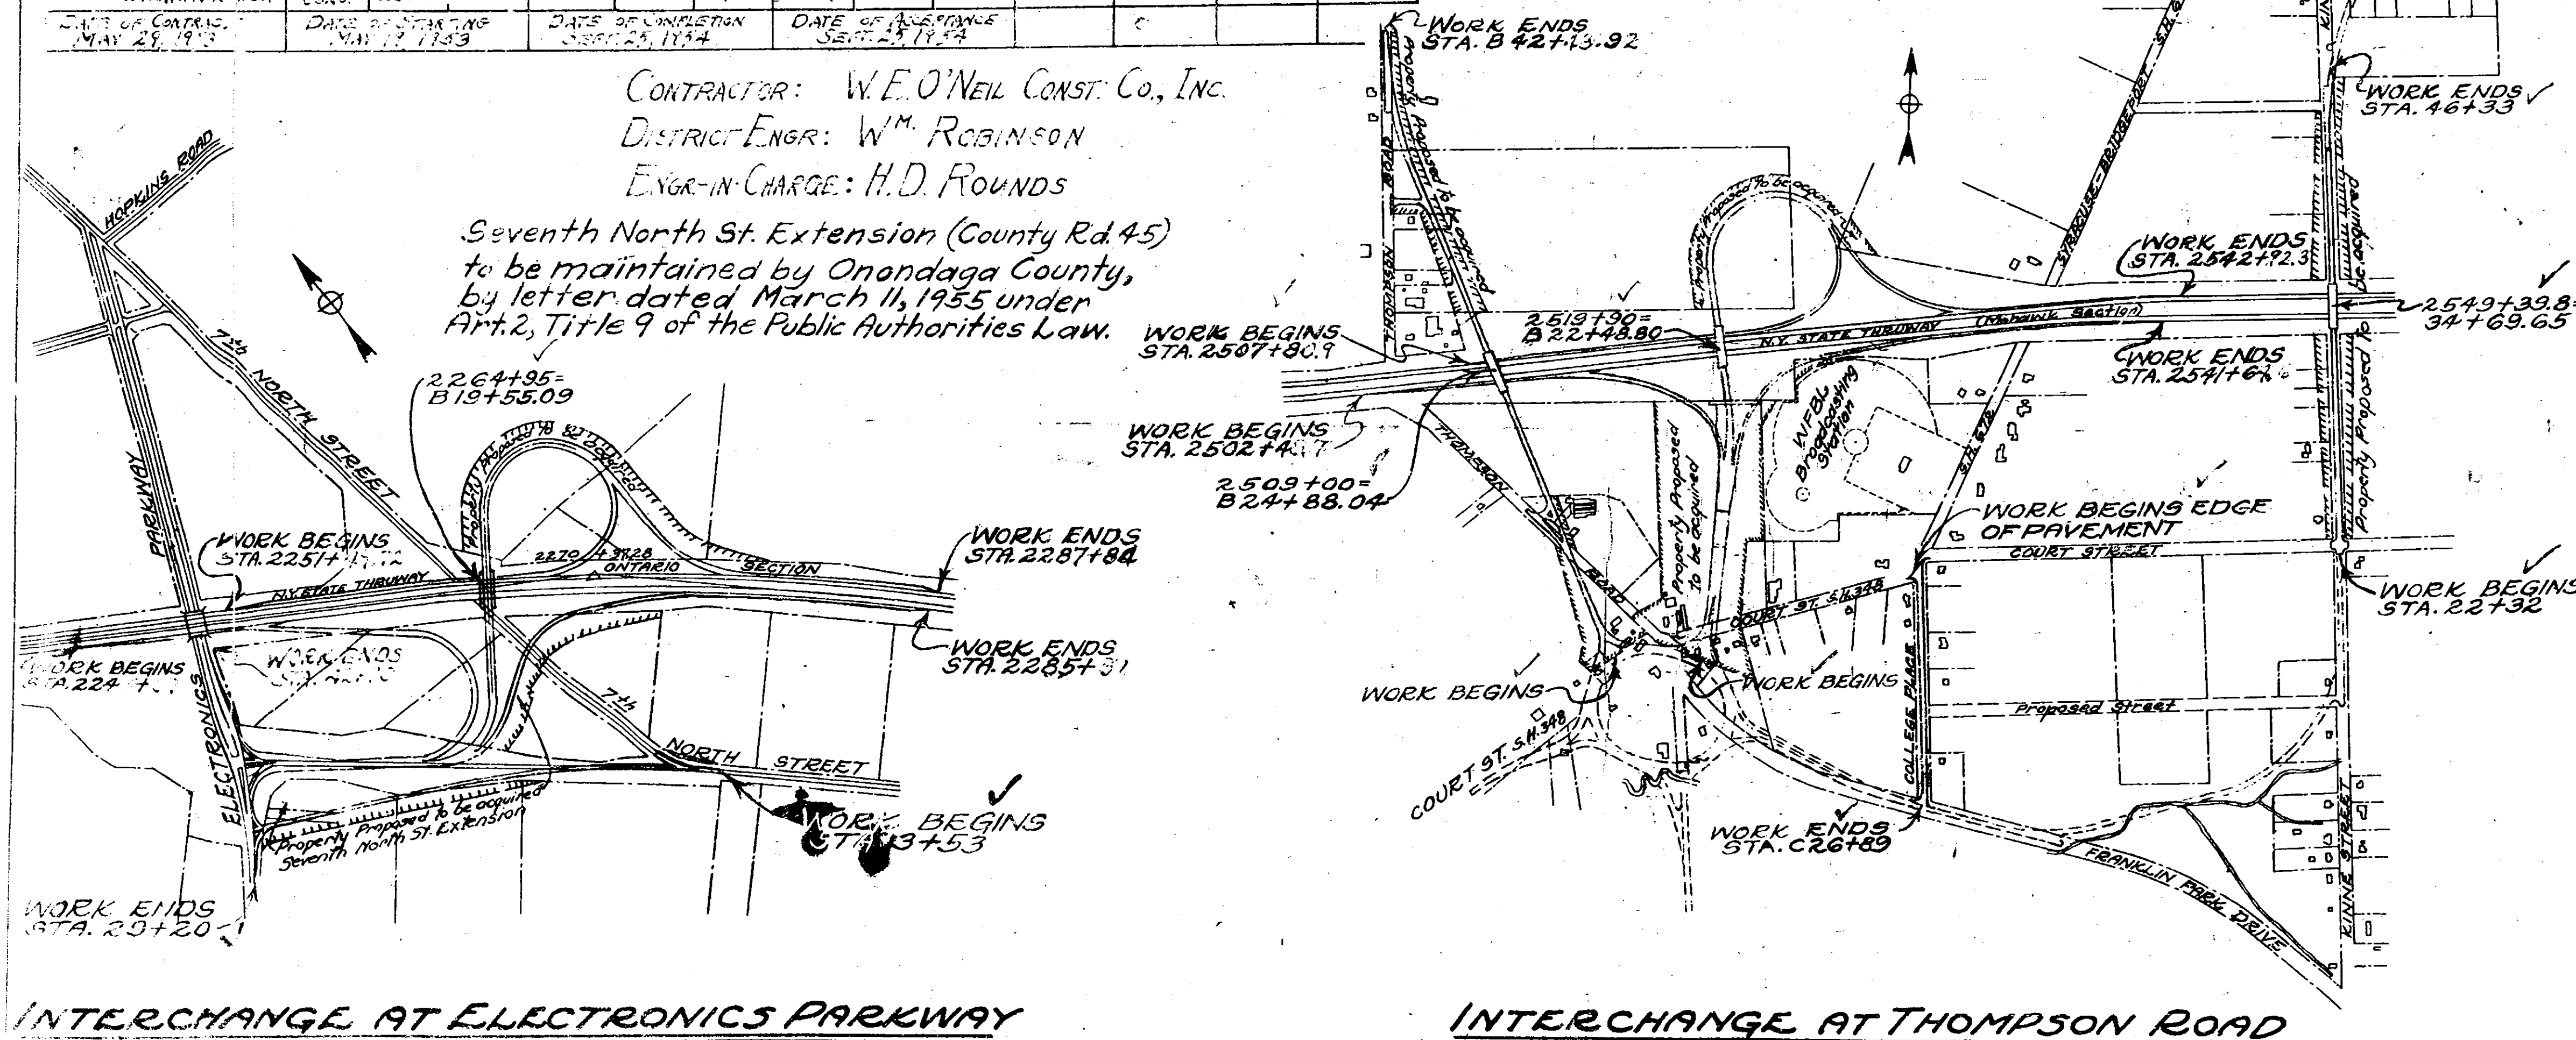

NEW YORK STATE THRUWAY AUTHORITY
PLANS FOR CONSTRUCTING ACCELERATION AND DECELERATION LANES ON A PORTION OF THE
NEW YORK STATE THRUWAY, ONTARIO SECTION: Subdivision 8A
From Station 2244+52 to Station 2287+80, a length of 0.73 mile in the Town of Salina
AND FOR CONSTRUCTING THE
ELECTRONICS PARKWAY (HOPKINS ROAD) INTERCHANGE
At Station 2264+95, a length of 1.74 miles in the Town of Salina
A TOTAL LENGTH OF 2.47 MILES CONTRACT No. O.T. 53-8
AND FOR CONSTRUCTING ACCELERATION AND DECELERATION LANES ON A PORTION OF THE
NEW YORK STATE THRUWAY, MOHAWK SECTION: Subdivision 8B
From Station 2502+47 to Station 2542+11, a length of 0.93 mile in the Town of DeWitt
AND FOR CONSTRUCTING THE
THOMPSON ROAD INTERCHANGE
At Station 2519+90, a length of 1.40 miles in the Town of DeWitt
A TOTAL LENGTH OF 2.33 MILES CONTRACT No. M.T. 53-8
AND FOR CONSTRUCTING PORTIONS OF
ELECTRONICS PARKWAY (HOPKINS ROAD)
From Station 29+20 to Station 42+65, a length of 0.22 mile in the Town of Salina
EXTENSION OF SEVENTH NORTH STREET
From Station 3+53 to Station 20+92, a length of 0.44 mile in the Town of Salina
THOMPSON ROAD
From Station B 9+10 to Station B 42+36, a length of 0.76 mile in the Town of DeWitt
COLLEGE PLACE
From Station C 15+00 to Station C 26+89, a length of 0.23 mile in the Town of DeWitt
A TOTAL LENGTH OF 1.65 MILES CONTRACT No. S.T. 53-20
AND FOR RECONSTRUCTING A PORTION OF THE
SYRACUSE - BRIDGEPORT, PART 1 (KINNE ST.) S.H. No. 672
Between Station 22+32 and Station 46+33, a length of 0.55 mile in the Town of DeWitt
CONTRACT No. R.C. 53-36
A TOTAL COMBINED LENGTH OF 6.85 MILES
ONONDAGA COUNTY

COUNTY	SHEET No.	TOTAL SHEETS
ONONDAGA	1	66
N.Y. STATE THRUWAY, ONTARIO SECTION, SUB DIV. 8A		
INTERCHANGE AT ELECTRONICS PARKWAY (HOPKINS ROAD)		
N.Y. STATE THRUWAY, MOHAWK SECTION, SUB DIV. 8B		
INTERCHANGE AT THOMPSON ROAD		

1R

TYPE OF CONSTRUCTION
Reinforced Cement Concrete Pavement 6.49 Miles
Asphalt Concrete, Type 1A, Opt. 0.38 Mile
Foundation Course-Gravel 0.13 Mile
Miscellaneous Work 0.22 Miles

Including
H.G.S. Electronics Parkway Interchange Station 2264+95
Composite Beam, 4 Spans, 2 @ 37' 9", 1 @ 64' 9",
1 @ 57' 9"

H.G.S., Thompson Road, Station 2509+00 Comp. Beam,
4 Spans, 2 @ 39' 0", 1 @ 59' 10", 1 @ 67' 1"

H.G.S., Thompson Road Interchange, Station 2519+90
Composite Beam, 4 Spans, 1 @ 37' 0", 1 @ 64' 9",
1 @ 57' 9", 1 @ 37' 3"

H.G.S., Kinne St. (Relocating of S.H. 672) Sta. 2549+40
Composite Beam, 4 Spans, 2 @ 37' 6", 2 @ 72' 9"

STANDARD STRUCTURE SHEETS
39-9, 46-4, 47-37, 49-65, 49-7, 49-42, 50-1R, 50-34,
51-3, 51-11R, 51-11W, 51-20, 51-21, 51-40, 52-17A,
52-17B, 52-17C, 52-17D, 52-43, 53-41, 53-106


All work contemplated under this contract to be covered
by and in conformity with the specifications adopted
January 2, 1951, except as modified on these plans and
in the Itemized Proposal.

Thompson Road (County Road 13) to be
maintained by Onondaga County, by
letter dated March 16, 1955 under Art. 2,
Title 9 of the Public Authorities Law.

Syracuse-Bridgeport, Pt. 1, S.H. 672 to
be maintained by New York State Dept.
of Public Works, by letter dated
March 16, 1955 under Art. 2, Title 9
of the Public Authorities Law.


NEW YORK STATE DEPARTMENT OF PUBLIC WORKS DIVISION OF CONSTRUCTION	
Approved	April 16, 1953
J. B. McMorran	Chief Engineer
Approved	April 16, 1953
E. T. GAWKINS	Deputy Chief Engineer
Approved	April 16, 1953
E. W. WENDELL	Deputy Chief Engineer
NEW YORK STATE THRUWAY AUTHORITY	
B. D. TALLAMY, Chairman	
By: C. H. LANG	Deputy Chief Engineer

Prepared pursuant to the
Highway Law and recommended by
the Engineer-in-Charge
District No. 3

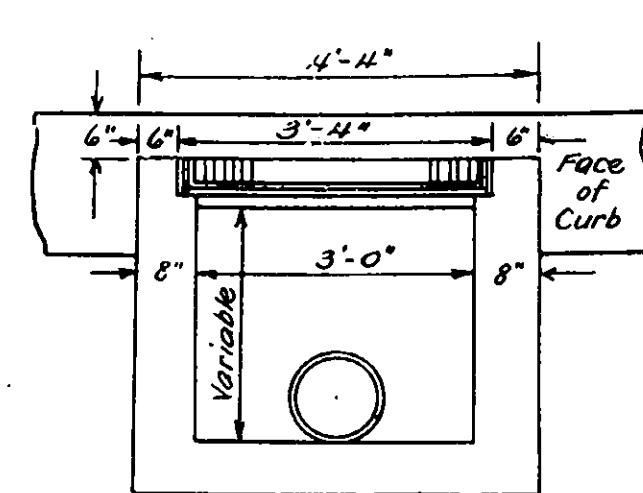


LONGITUDINAL SECTION THRU
CENTER OF GRATE

Scale $\frac{1}{2}" = 1'-0"$

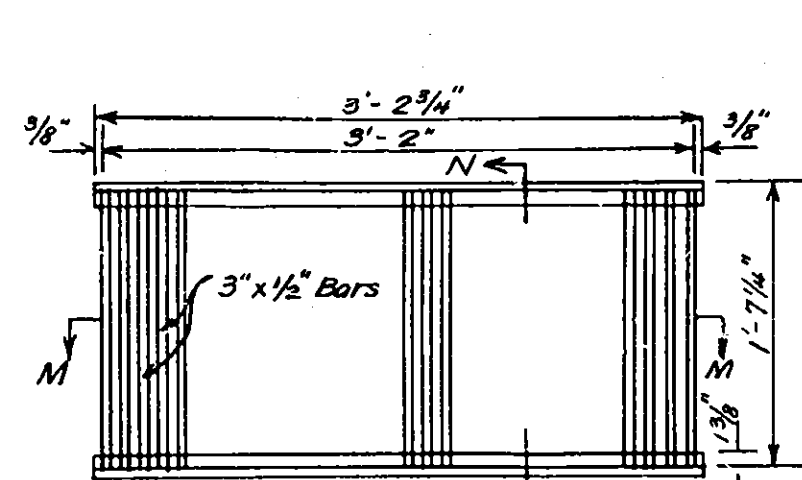


PLAN

SECTION M-M

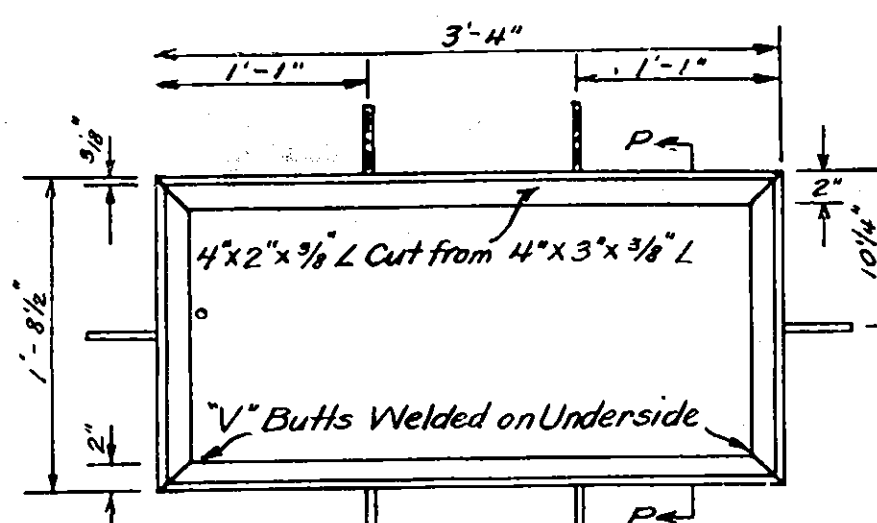


PLAN

SECTION P-P

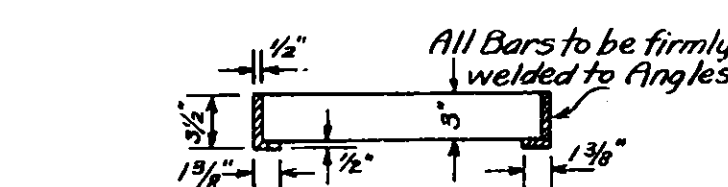


SECTION N-N


DETAILS FOR SPECIAL STEEL GRATING AND FRAME

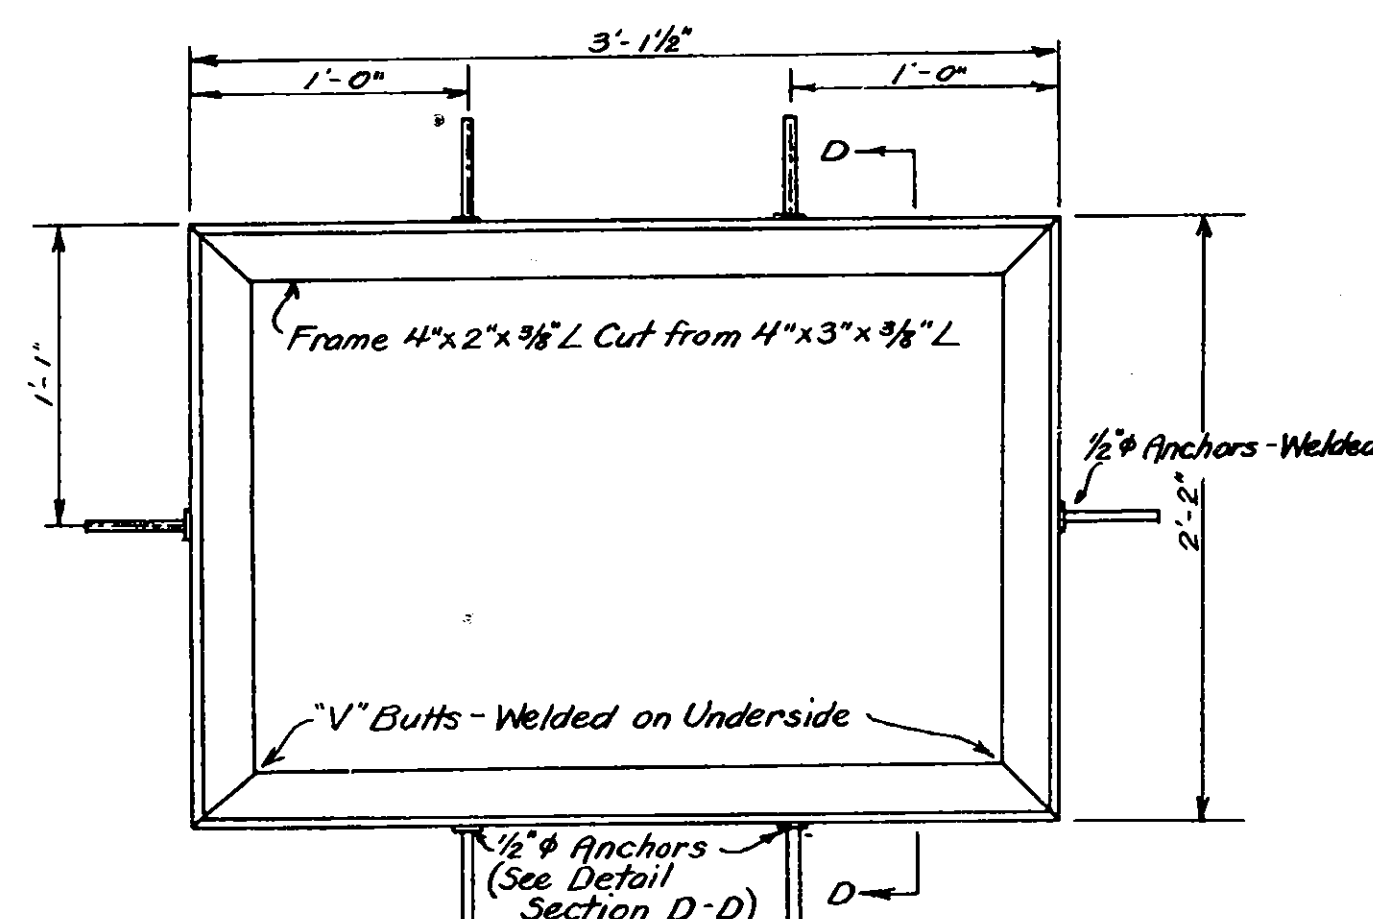


SECTION D-D

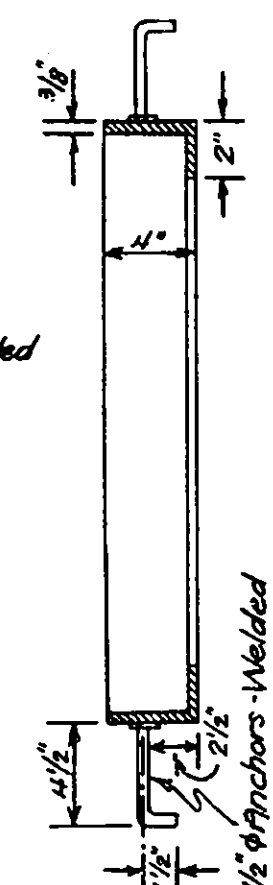


SECTION F-F.

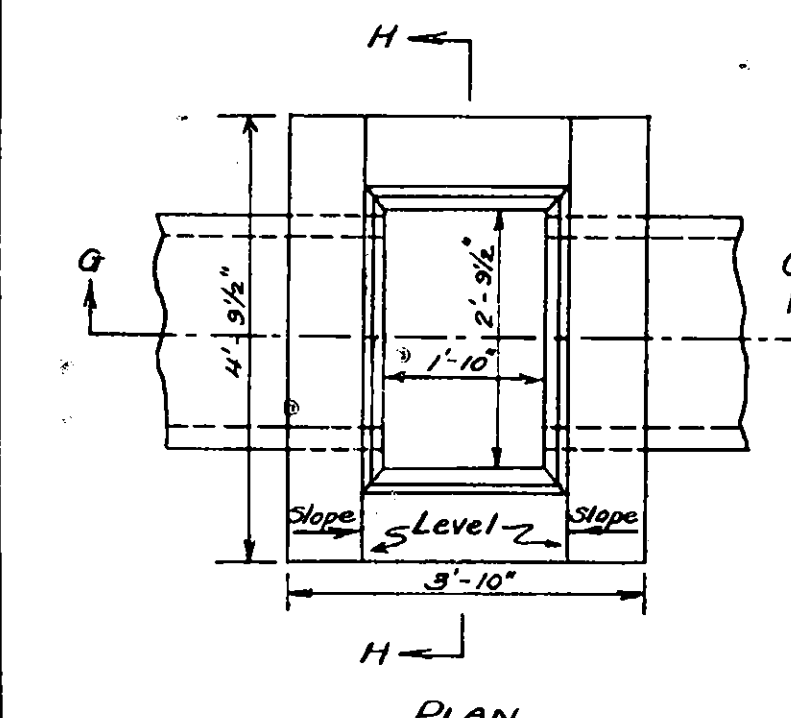

PLAN

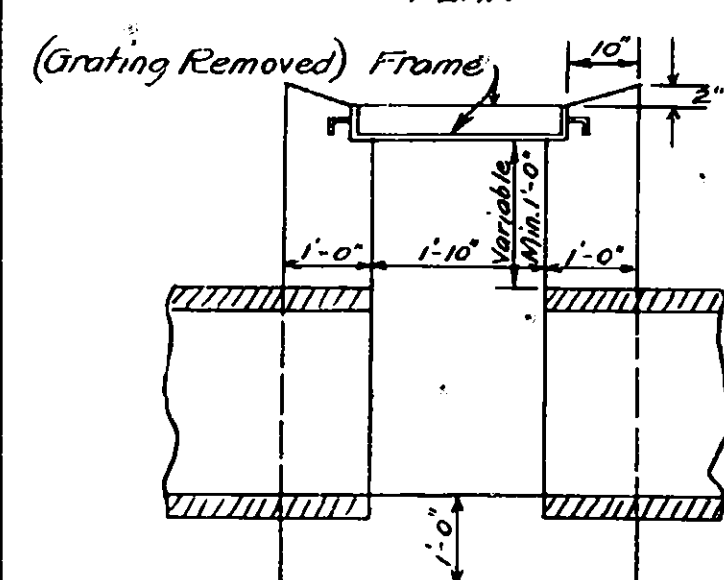

SECTION G-G

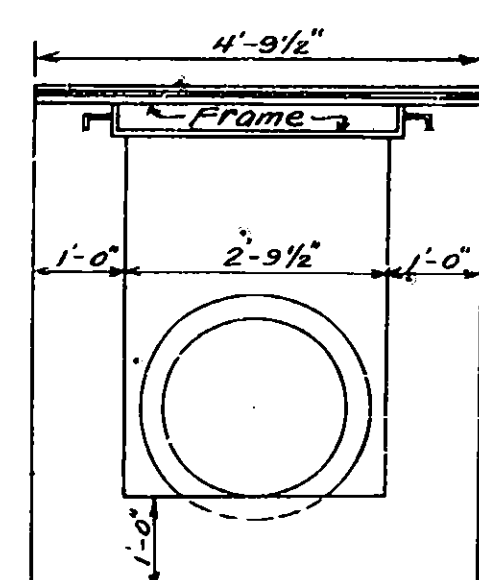

SECTION H-H

(For Pipe Sizes to 24" Diameter)

Scale: $1/2" = 1'-0"$

PLAN OF GRATING
Scale 3"=1'-0"

DETAILS FOR TYPE "T" INLET FRAME AND GRATING

Scale 3" = 1'-0"

BENCH MARKS		
STATION	DESCRIPTION	ELEV.
<i>Electronics Park Interchange</i>		
2250+93	N.E. Wing - N.W. Cor. East Abutment	423.22
2262+50	S.E. Cor. Rt. Head Wall - South Lane (Thruway)	436.26
2270+00	N.W. Cor. Drop Inlet in Mall (Thruway)	448.30
2251+50	12" Willow - 100ft. Left (B.M.*264)	448.73
<i>Thompson Road Interchange</i>		
2504+60	N.E. Cor. D.I. on Right (Thruway)	411.71
2512+05	60" Elm - 130ft. Right (B.M.*235)	419.44
2534+20	N.E. Cor. D.I. in Mall (Thruway)	423.2
2549+60	S.W. Cor. Rt. Head Wall - North Lane (Thruway)	413.60
B17+00	40" Elm on Left	421.25
B38+90	Spikes in pole on left	405.00
C4+50	Barton's Corners	413.14
22+80	At Intersection Minne & Court Streets	409.71
2535+50	30" Ash on Left. (B.M.*297)	410.87
49+59	Pole on Left - Minne St.	413.90

CULVERT MATERIALS						Reinf. Bars	Misc.
STATION	DESCRIPTION	R.C. Culvert Pipe				3/8" x 6	Met.
		15"	18"	24"	30"	L.F.	Lb.
<u>Electronics Park Interchange Roadways</u>							
B0+90	60ft. of 24" R.C. Culvert Pipe with 2 D.I.'s			60		750	
C0+38 Ed.	44ft. of 15" " " " " " Spec. D.I.	44				310	
B11+80 &	136ft. of 15" " " " " " D.I.	136				370	
B18+25 &	72ft. of 30" " " " " "			72			
B20+95 &	120ft. of 30" " " " " "			120			
E6+40 Ed.	48ft. of 24" " " " " "			48			
B33+40 Ed.	48ft. of 18" " " " " "		48				
B47+00 Ed.	16ft. of 24" " " " " "			16			
D10+50 Ed.	80ft. of 24" " " " " "			80			
{ 2257+00 (Thru. Sta.)							
C13+75 Ed.	Build D.I. - So. Ditch					370	
B0+24 Lt.	44ft. of 15" " " " " " with D.I.	44				310	
B0+96 Rt.	Build D.I.					310	
<u>SEVENTH NORTH STREET EXTENSION</u>							
18+75	72ft. of 24" R.C. Culvert Pipe			72	40		
<u>APPROACHES FOR BRIDGE AT THOMPSON ROAD</u>							
B34+00 - L130	60ft. of 18" R.C. Culvert Pipe Ditch X-ing			60			
B38+10	60ft. of 18" " " " " "			60			
B38+58 &	88ft. of 24" " " " " "			88			
<u>Thompson Road Interchange</u>							
A20+80 &	112 ft. of 24" " " " " "			112			
A32+70 Ed.	16 ft. of 30" " " " " "				16		
D5+40 Ed.	44 ft. of 24" " " " " "			44			
E4+40 Ed.	88 ft. of 24" " " " " "			88			
F6+78 Ed.	8 ft. of 24" " " " " " with D.I.			8		370	
{ F6+78 Ed. to							
F7+78 Ed.	100ft. of 24" " " " " "			100			
<u>Approaches For Bridge at Kinne Street</u>							
23+06	56ft. of 24" R.C. Culvert Pipe			56			
36+10	124ft. of 30" " " " " "				124		
39+30	108ft. of 18" " " " " "			108			
43+03	76ft. of 18" " " " " "			76			
44+40 - 37' Lt.	56ft. of 18" " " " " " - Ditch X-ing			56			
24+40 - 37' Lt.	56ft. of 18" " " " " "			56			
TOTAL		224	444	772	332	40	2800

BEAM TYPE GUIDE RAILING			
STATION TO STATION	SIDE	LIN. FT.	
<u>Electronics Park</u>			
B1G+40 to B18+40	L & R	400	
B20+78 to B25+48	L & R	940	
<u>Approaches-Thompson Road Bridge</u>			
19+29 to 23+59	R	430	
19+30 to 23+70	L	440	
25+98 to 29+78	R	380	
26+09 to 29+79	L	370	
<u>Thompson Road Interchange Roadways</u>			
18+47 to 21+37	L	290	
18+67 to 21+37	R	270	
23+67 to 28+17	R	450	
23+67 to 28+67	L	500	
<u>Approaches-Minnie Street Bridge</u>			
26+43 to 33+43	R	700	
26+43 to 33+43	L	700	
35+96 to 42+66	R	610	
35+96 to 42+66	L	610	
TOTAL		7030	

COUNTY		SHEET No.	TOTAL SHEETS
ONONDAGA		2	66
N.Y. STATE THRUWAY, ONTARIO SECTION - SUB. DIV. 8 A			
INTERCHANGE AT ELECTRONICS PARKWAY (HOPKINS ROAD)			
N.Y. STATE THRUWAY, MOHAWK SECTION - SUB. DIV. 8 B			
INTERCHANGE AT THOMPSON ROAD			

EARTHWORK					
STATION - STATION	CUT IN CU. YDS.	FILL IN CU. YDS.	BAL	BORROW IN CU. YDS.	SURPLUS IN CU. YDS.
<u>Seventh North Street Extension</u>					
3+53 - 9+60	2139	1726	1.24		
9+60 - 20+78	19576	32			19540
<u>Interchange - Electronics Parkway</u>					
B0+35 - B18+90	21317	11153			8484
B20+27 - B31+14	12210	23966		15351	
B31+14 - B50+82	34930	383			33889
C 0+00 - C9+50	19701	0			19701
C9+50 - C26+55	3568	2674	1.33		
D0+00 - D27+24	5329	10372		6599	
E 0+00 - E23+13	14996	779			14100
<u>Thompson Road Bridge Approaches</u>					
Traffic Circle - B24+13	3928	20853		20594	
B25+55 - B42+36	3499	20762		20859	
<u>Interchange - Thompson Road</u>					
Traffic Circle - A21+85	1341	18446		20056	
A 23+19 - A38+02	1110	25750		28655	
A38+02 - A53+11	1527	1162	1.31		
F 0+00 - F19+46	1997	4730		3787	
E 0+00 - E24+33	1881	10264		10181	
D 0+00 - D21+50	2759	860			1770
<u>Kinne Street Bridge Approaches</u>					
22+32 - 33+91	158	37590		48092	
35+49 - 46+33	339	33000		37658	
College Place	2831	182			2623
TOTALS	154536	224750		206832	100107

EARTHWORK SUMMARY	
Item 2B - Unclassified Excavation	Cu. Yds.
Roadways as per Earthwork Sheets	154 536
Net Borrow " " " "	180 489
From Drainage Sheets	436
Stripping Topsoil - Electronics Parkway Interchange	153
" " " " - Thompson Road Approaches	1200
" " " " - Thompson Road Inter. Roadways	4900
Replacing Topsoil	7015
Intersection - Extension of Seventh North Street	150
Total Item 2 B	348 879
Estimate - Item 2 B	351 000
" " " - Item 5	4 530


Made By W. H. Checked By Wm F. Holman Traced By J. E. Holman Checked By Wm F. Holman

*Prepared pursuant to the
Highway Law and recommended by*


[Signature]
Engineer District No. 3

4/1/53

EARTHWORK SUMMARY	
Item 2B - Unclassified Excavation	Cu. Yds.
Roadways as per Earthwork Sheets	154 536
Net Borrow " " " "	180 489
From Drainage Sheets	436
Stripping Topsoil - Electronics Parkway Interchange	153
" " " " - Thompson Road Approaches	1200
" " " " - Thompson Road Inter. Roadways	4900
Replacing Topsoil	7015
Intersection - Extension of Seventh North Street	150
Total Item 2 B	348 879
Estimate - Item 2 B	351 000
" " - Item 5	4 590

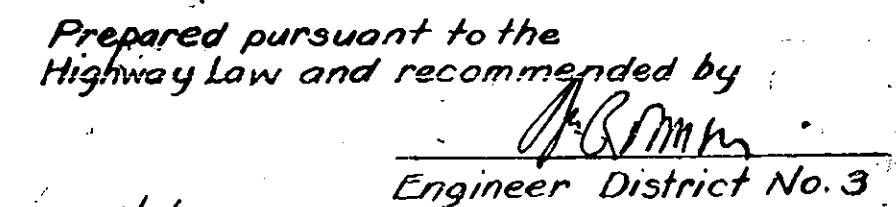


COUNTY	SHEET No.	TOTAL SHEETS
ONONDAGA	3	66
N.Y. STATE THRUWAY, ONTARIO SECTION, SUBDIV. 8A		
INTERCHANGE AT ELECTRONICS PARKWAY (HOPKINS ROAD)		
EXTENSION OF SEVENTH NORTH STREET		

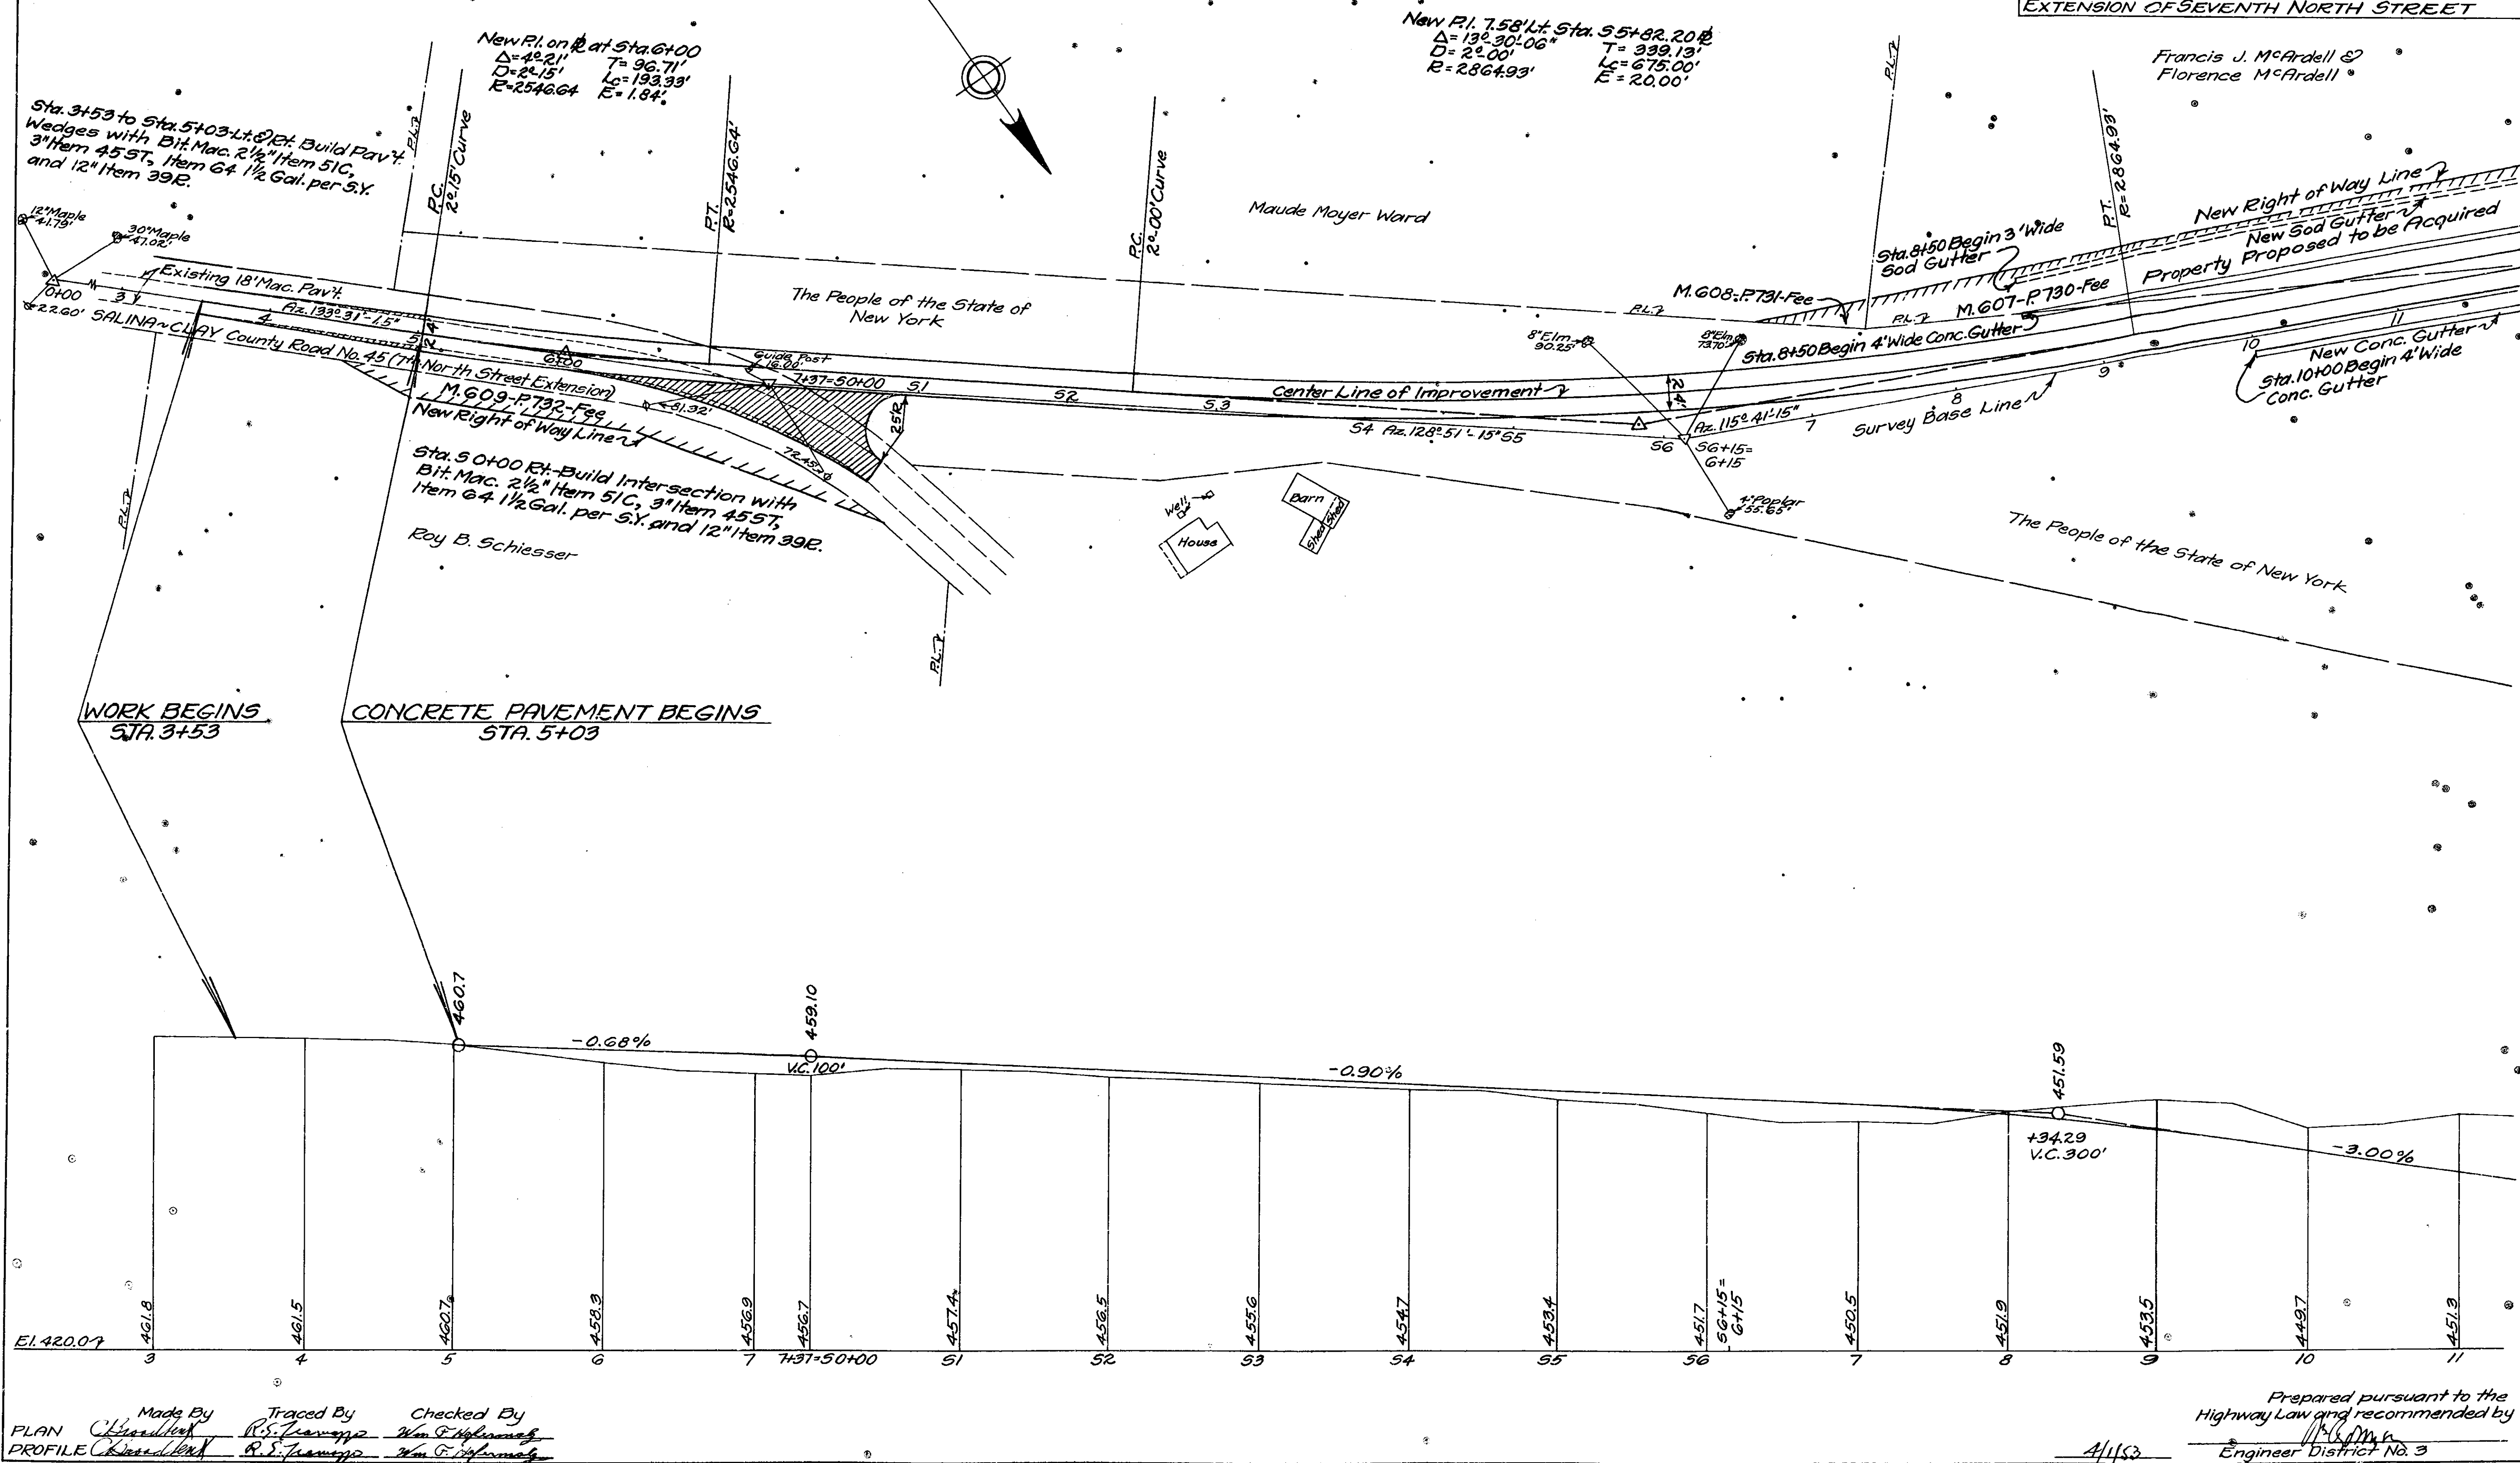

COUNTY	SHEET NO.	TOTAL SHEETS
ONONDAGA	3	66
N.Y. STATE THRUWAY, ONTARIO SECTION, SUBDIV. 8A		
INTERCHANGE AT ELECTRONICS PARKWAY (HOPKINS ROAD)		
EXTENSION OF SEVENTH NORTH STREET		

Francis J. McArdell & V
Florence McArdell

3R

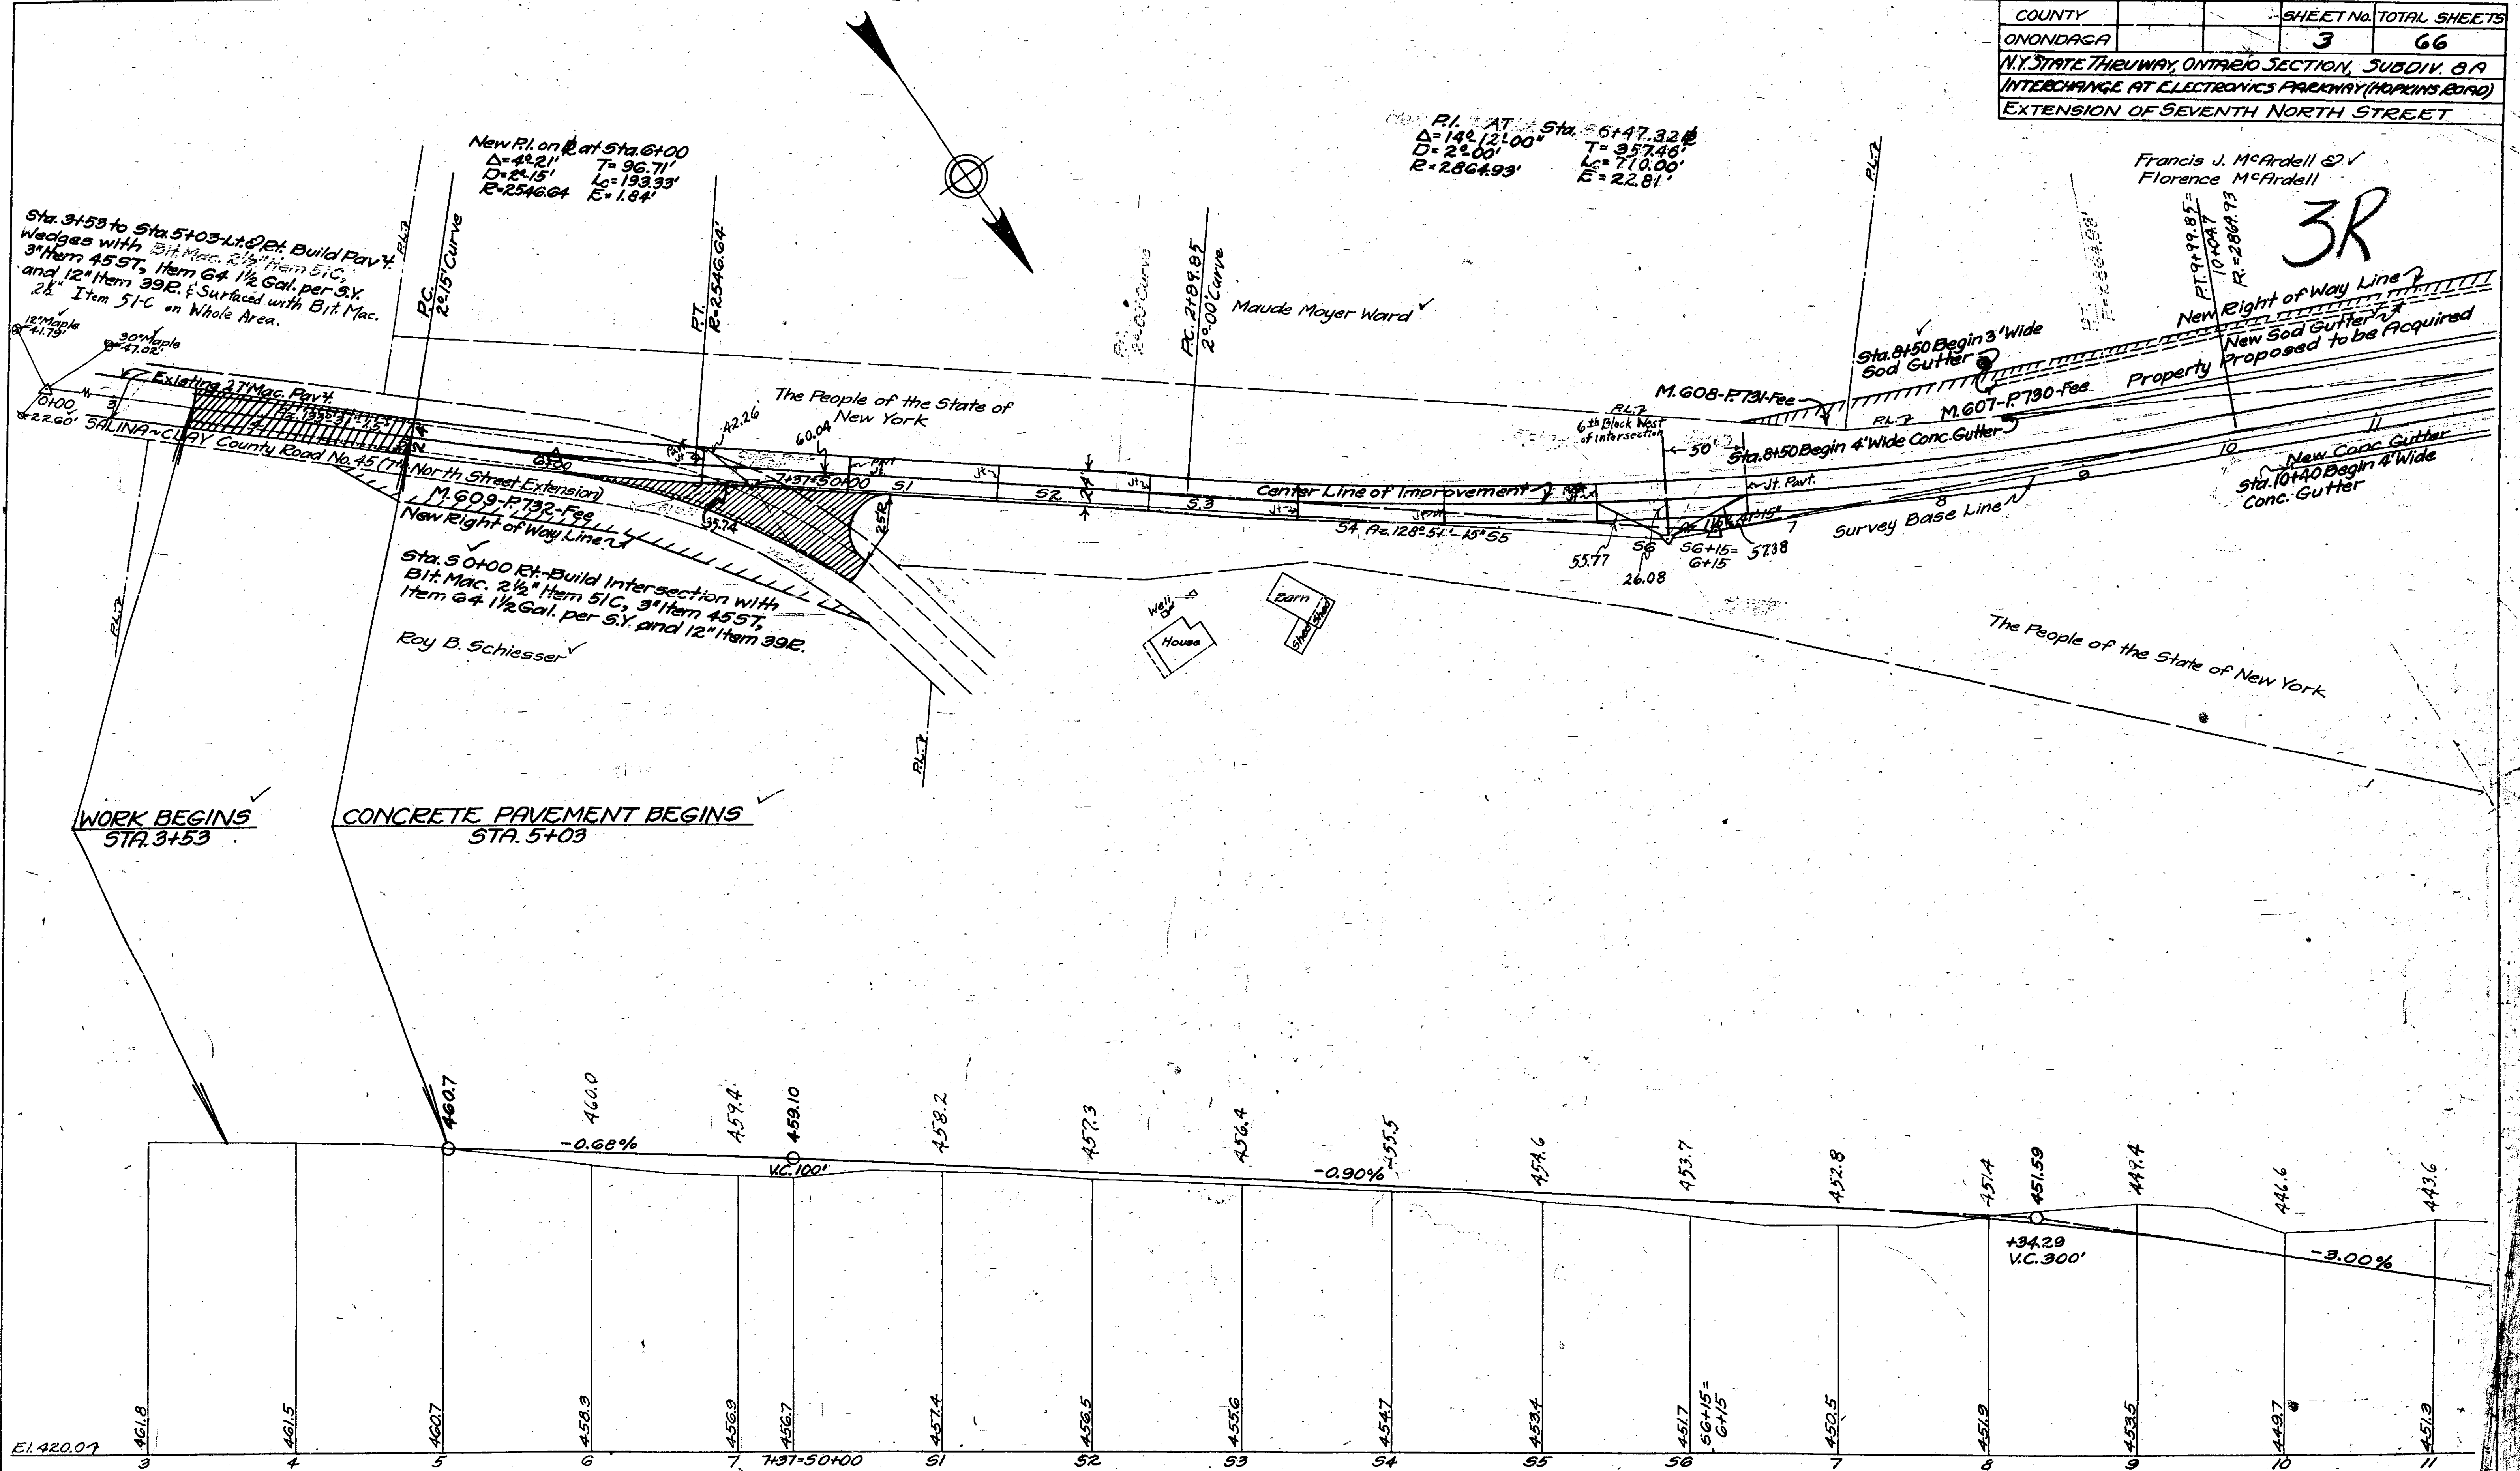


Made By Traced By Checked By
PLAN *[Signature]* *[Signature]* *[Signature]*
PROFILE *[Signature]* *[Signature]* *[Signature]*

Prepared pursuant to the
Highway Law and recommended by
[Signature]
Engineer District No. 3

TYPICAL SECTION






Scale: 3/8"=1'-0"

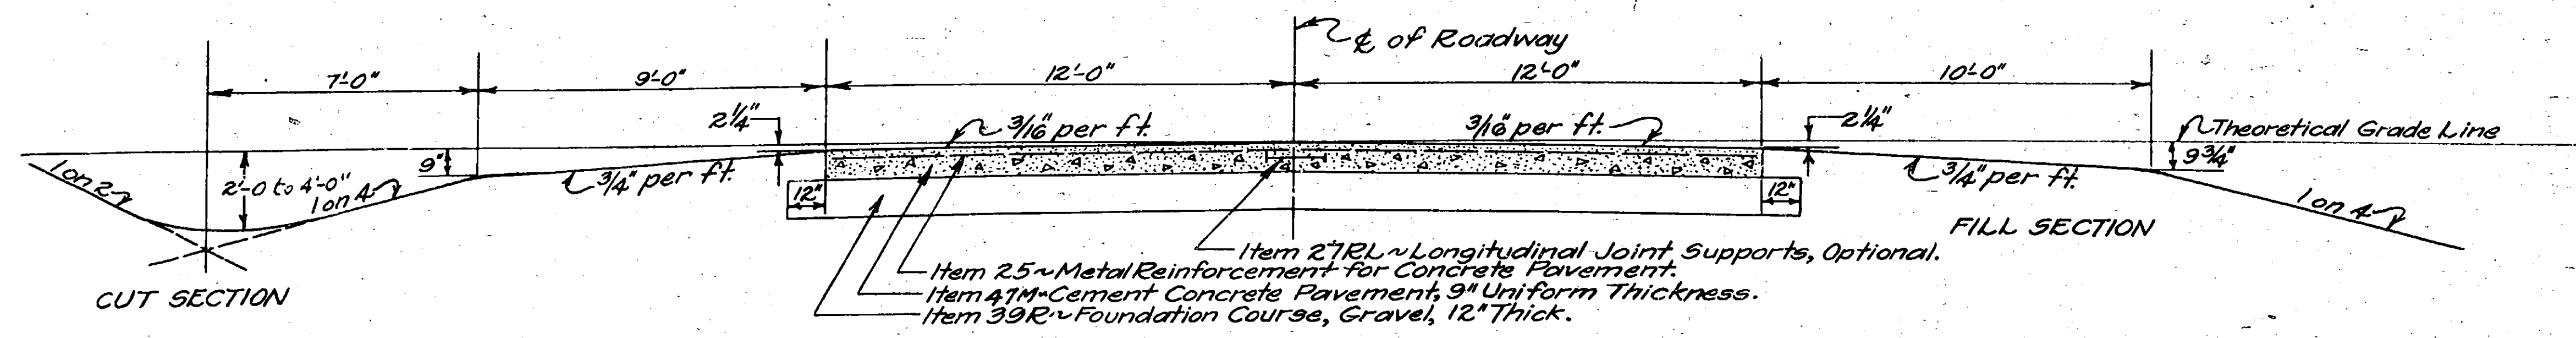

COUNTY	SHEET No.	TOTAL SHEETS
ONONDAGA	4	66

NY STATE THRUWAY, ONTARIO SECTION, SUBDIV. 8 A
INTERCHANGE AT ELECTRONICS PARKWAY (HAKINIS ROAD)
EXTENSION OF SEVENTH NORTH STREET



4R

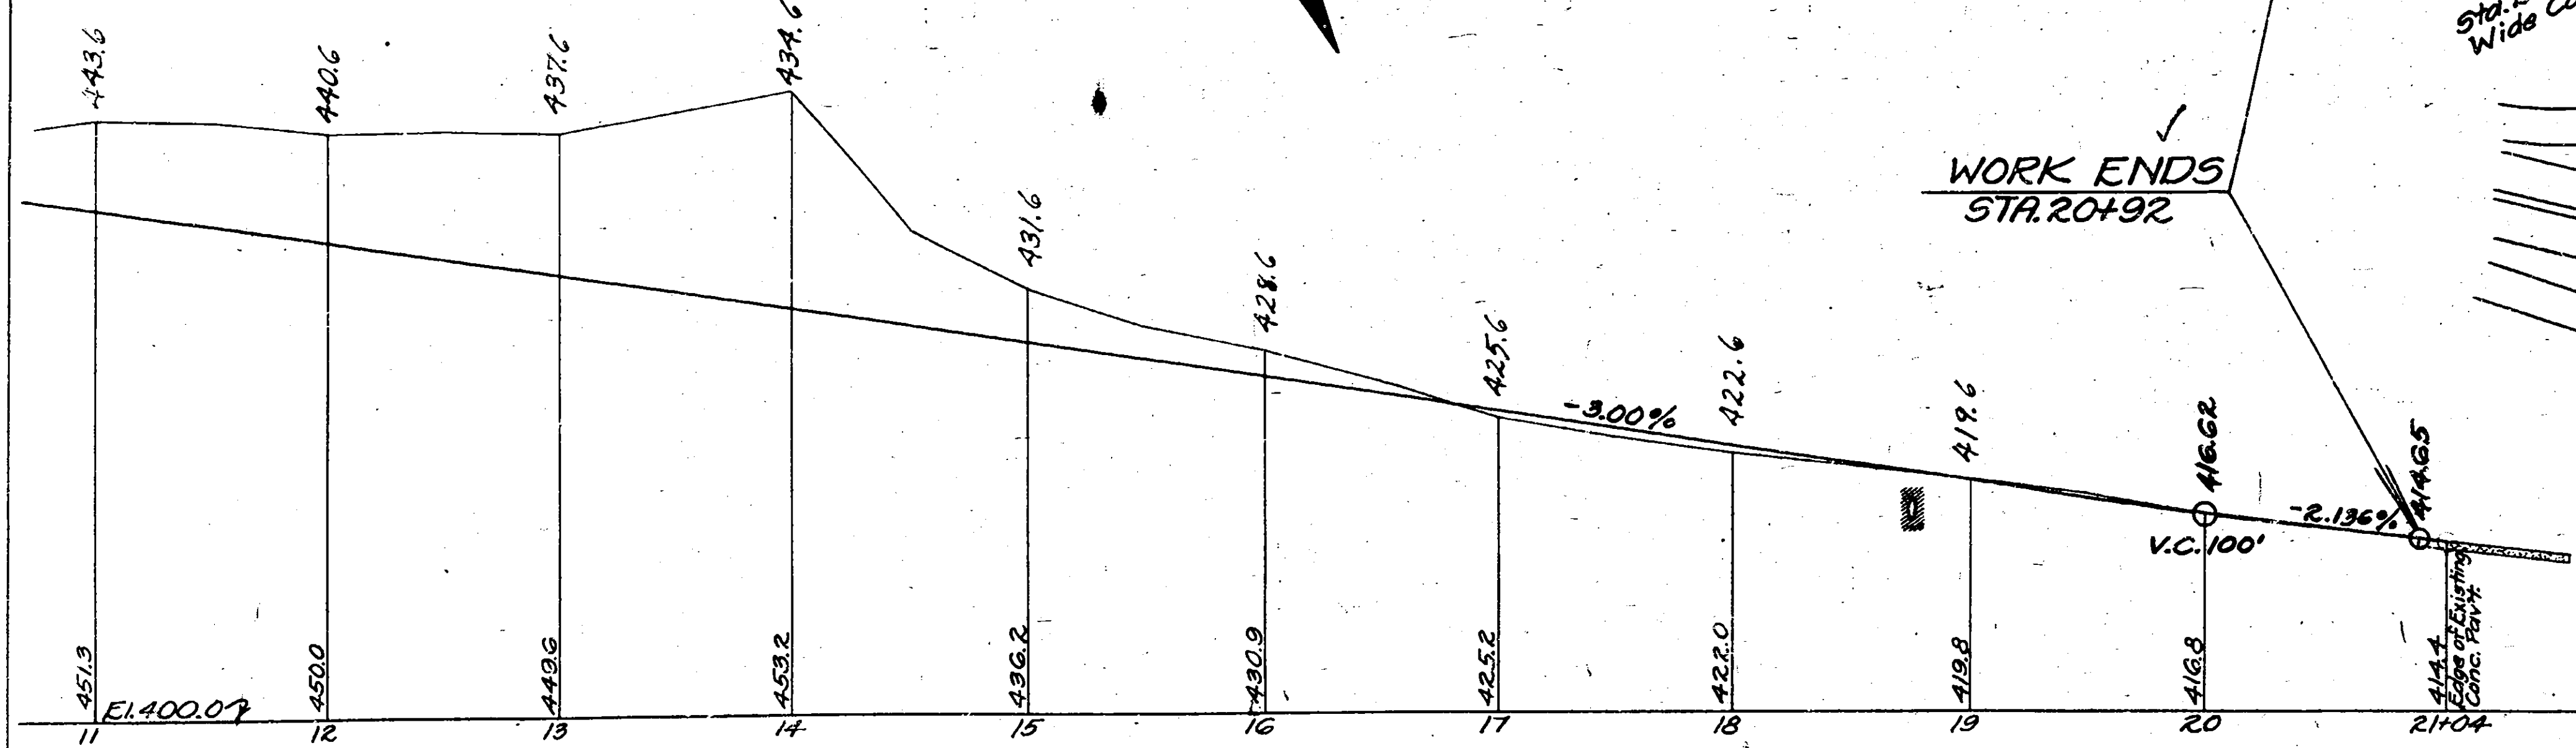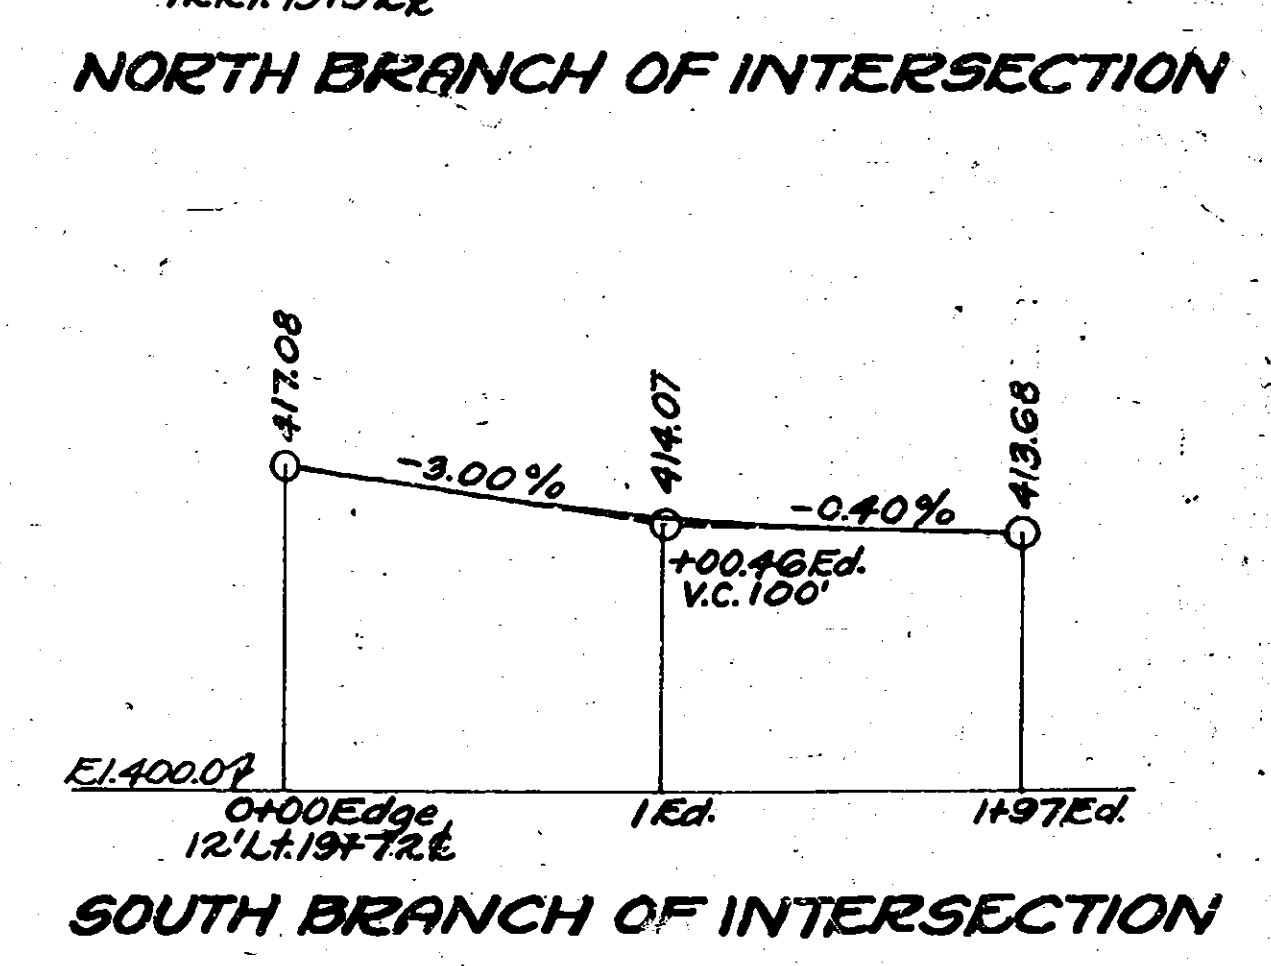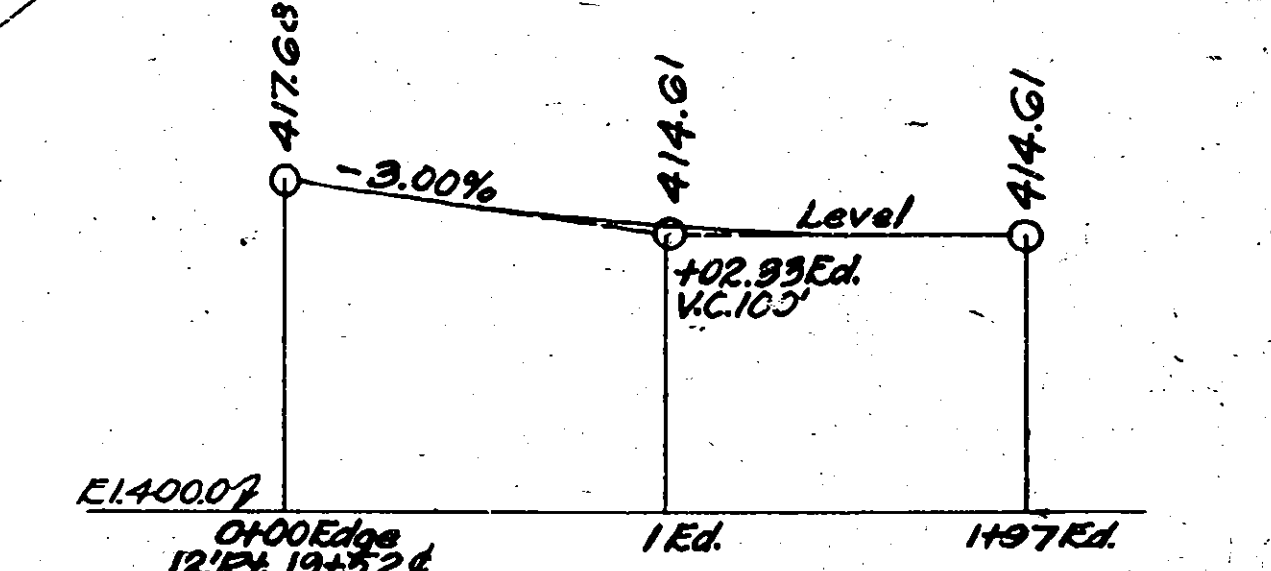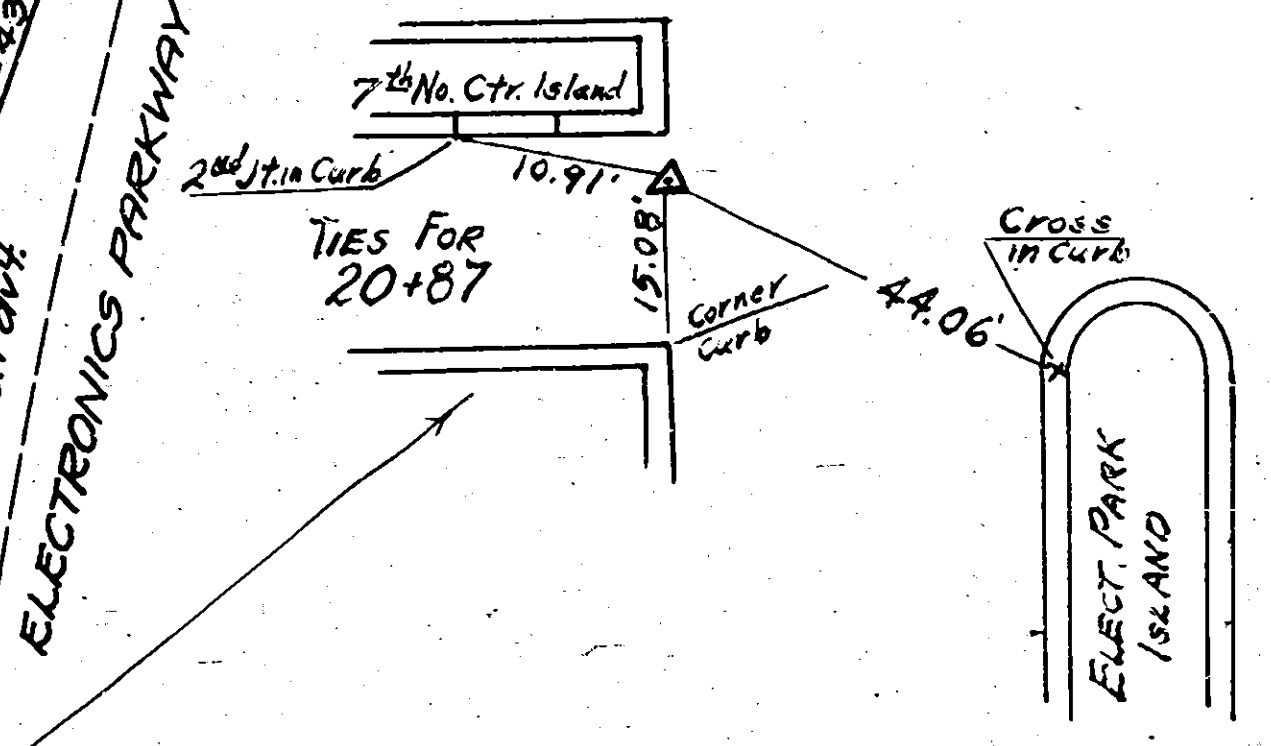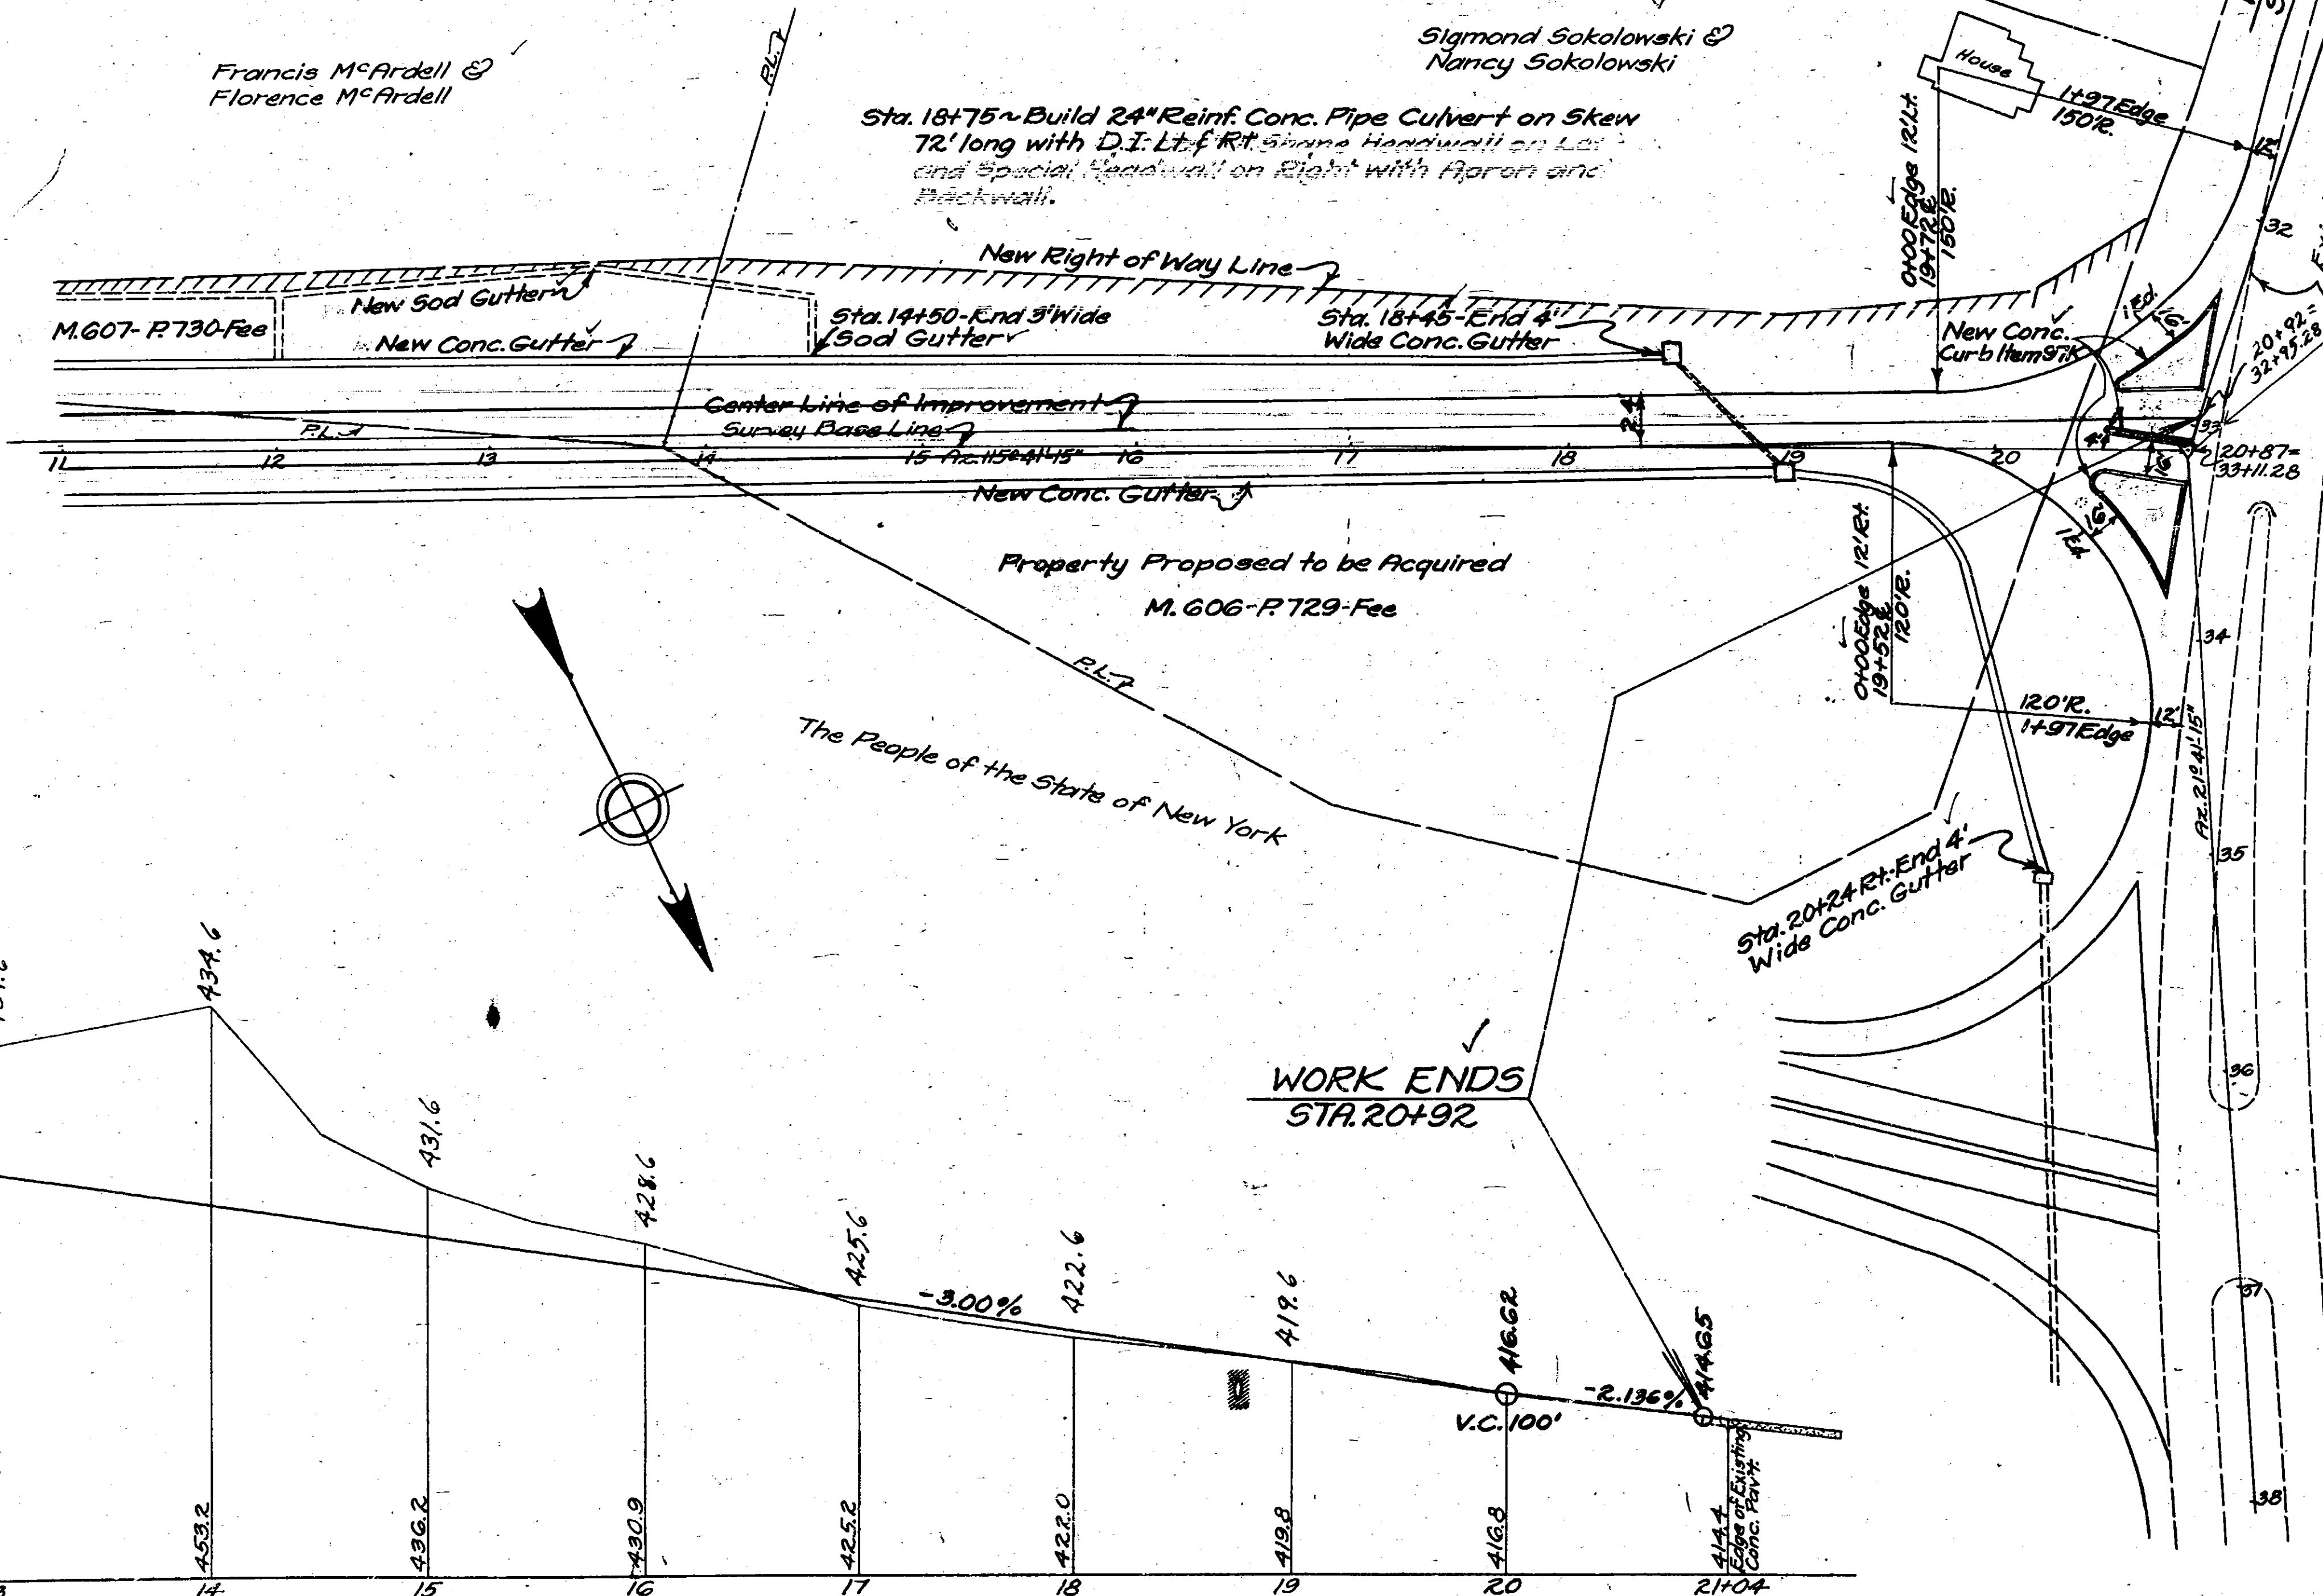

Made By: C. Brundage
Traced By: R. S. Trappe
Checked By: Wm. G. Hoffmann
PLAN: C. Brundage
PROFILE: C. Brundage

Prepared pursuant to the Highway Law and recommended by
Engineer District No. 3
4/1/52

COUNTY	SHEET NO.	TOTAL SHEETS
ONONDAGA	5	66
N.Y. STATE THRUWAY, ONTARIO SECTION		
N.Y. STATE THRUWAY, ONTARIO SECTION, SUB DIV. 8A		
INTERCHANGE AT ELECTRONICS PARKWAY (HOPKINS ROAD)		

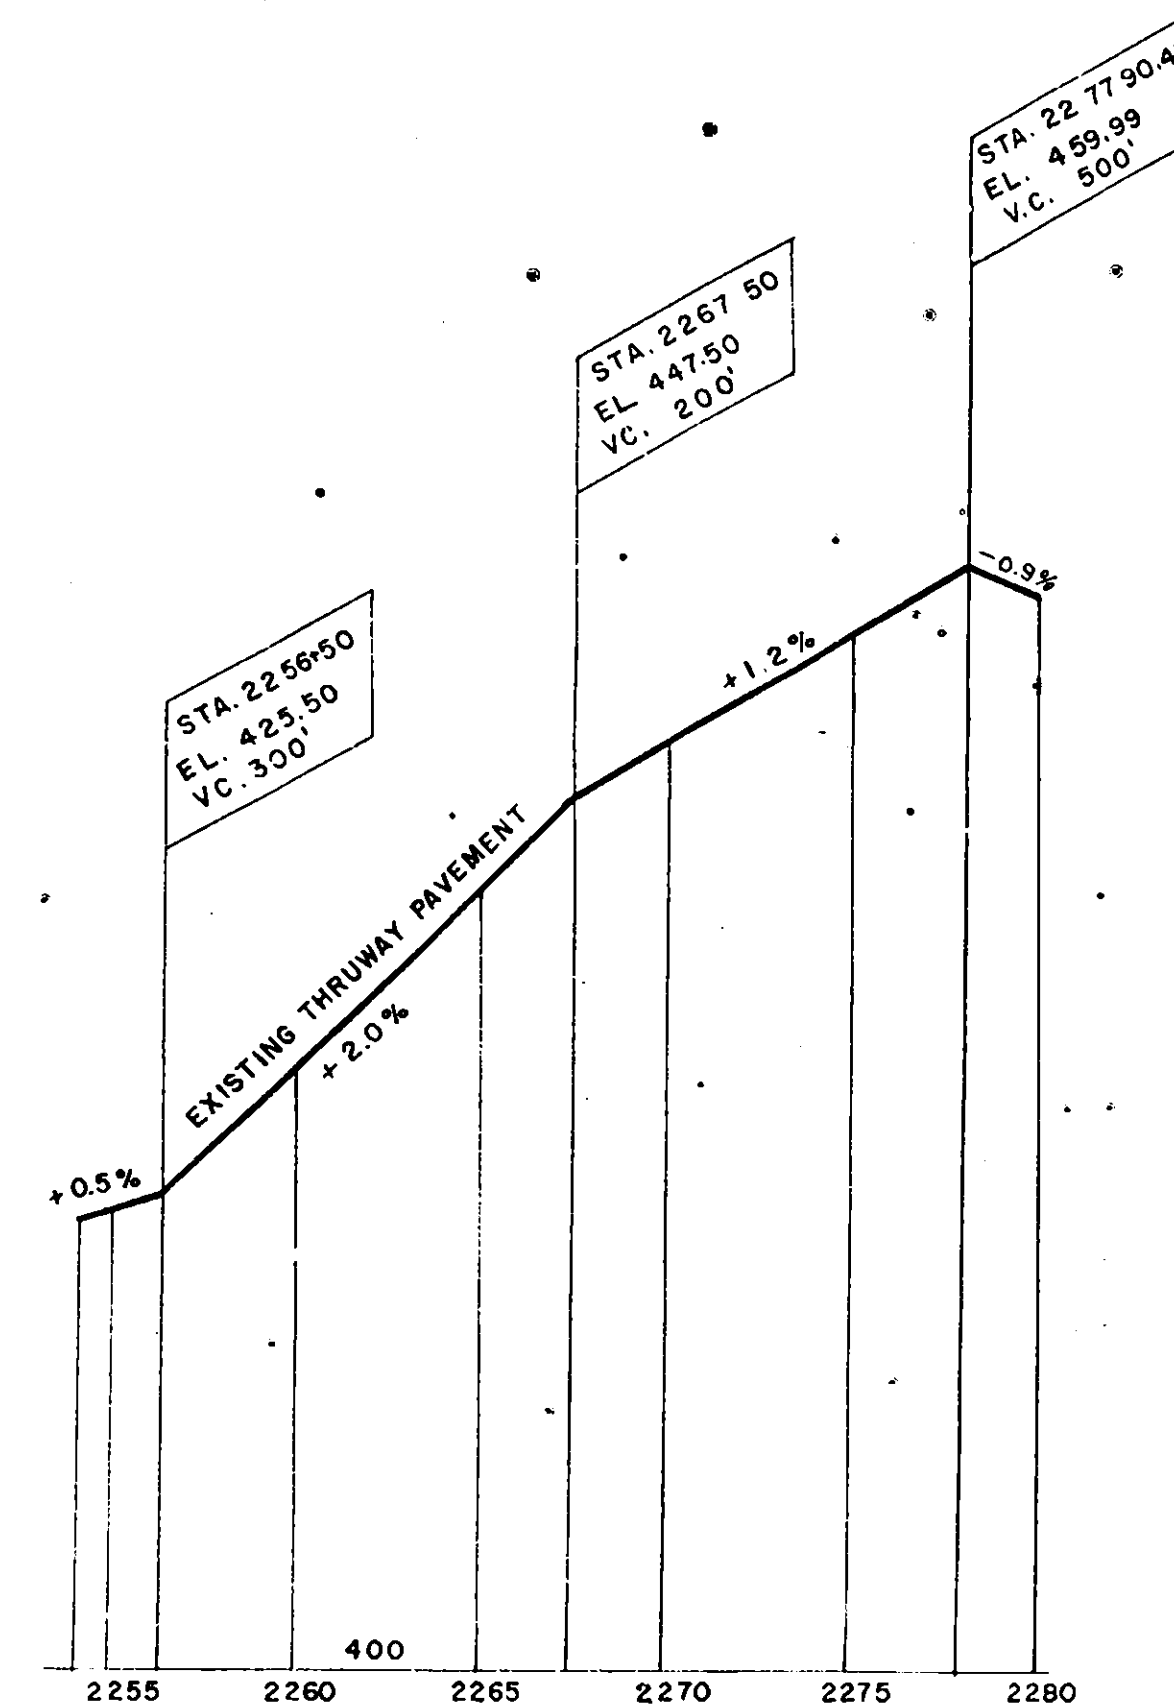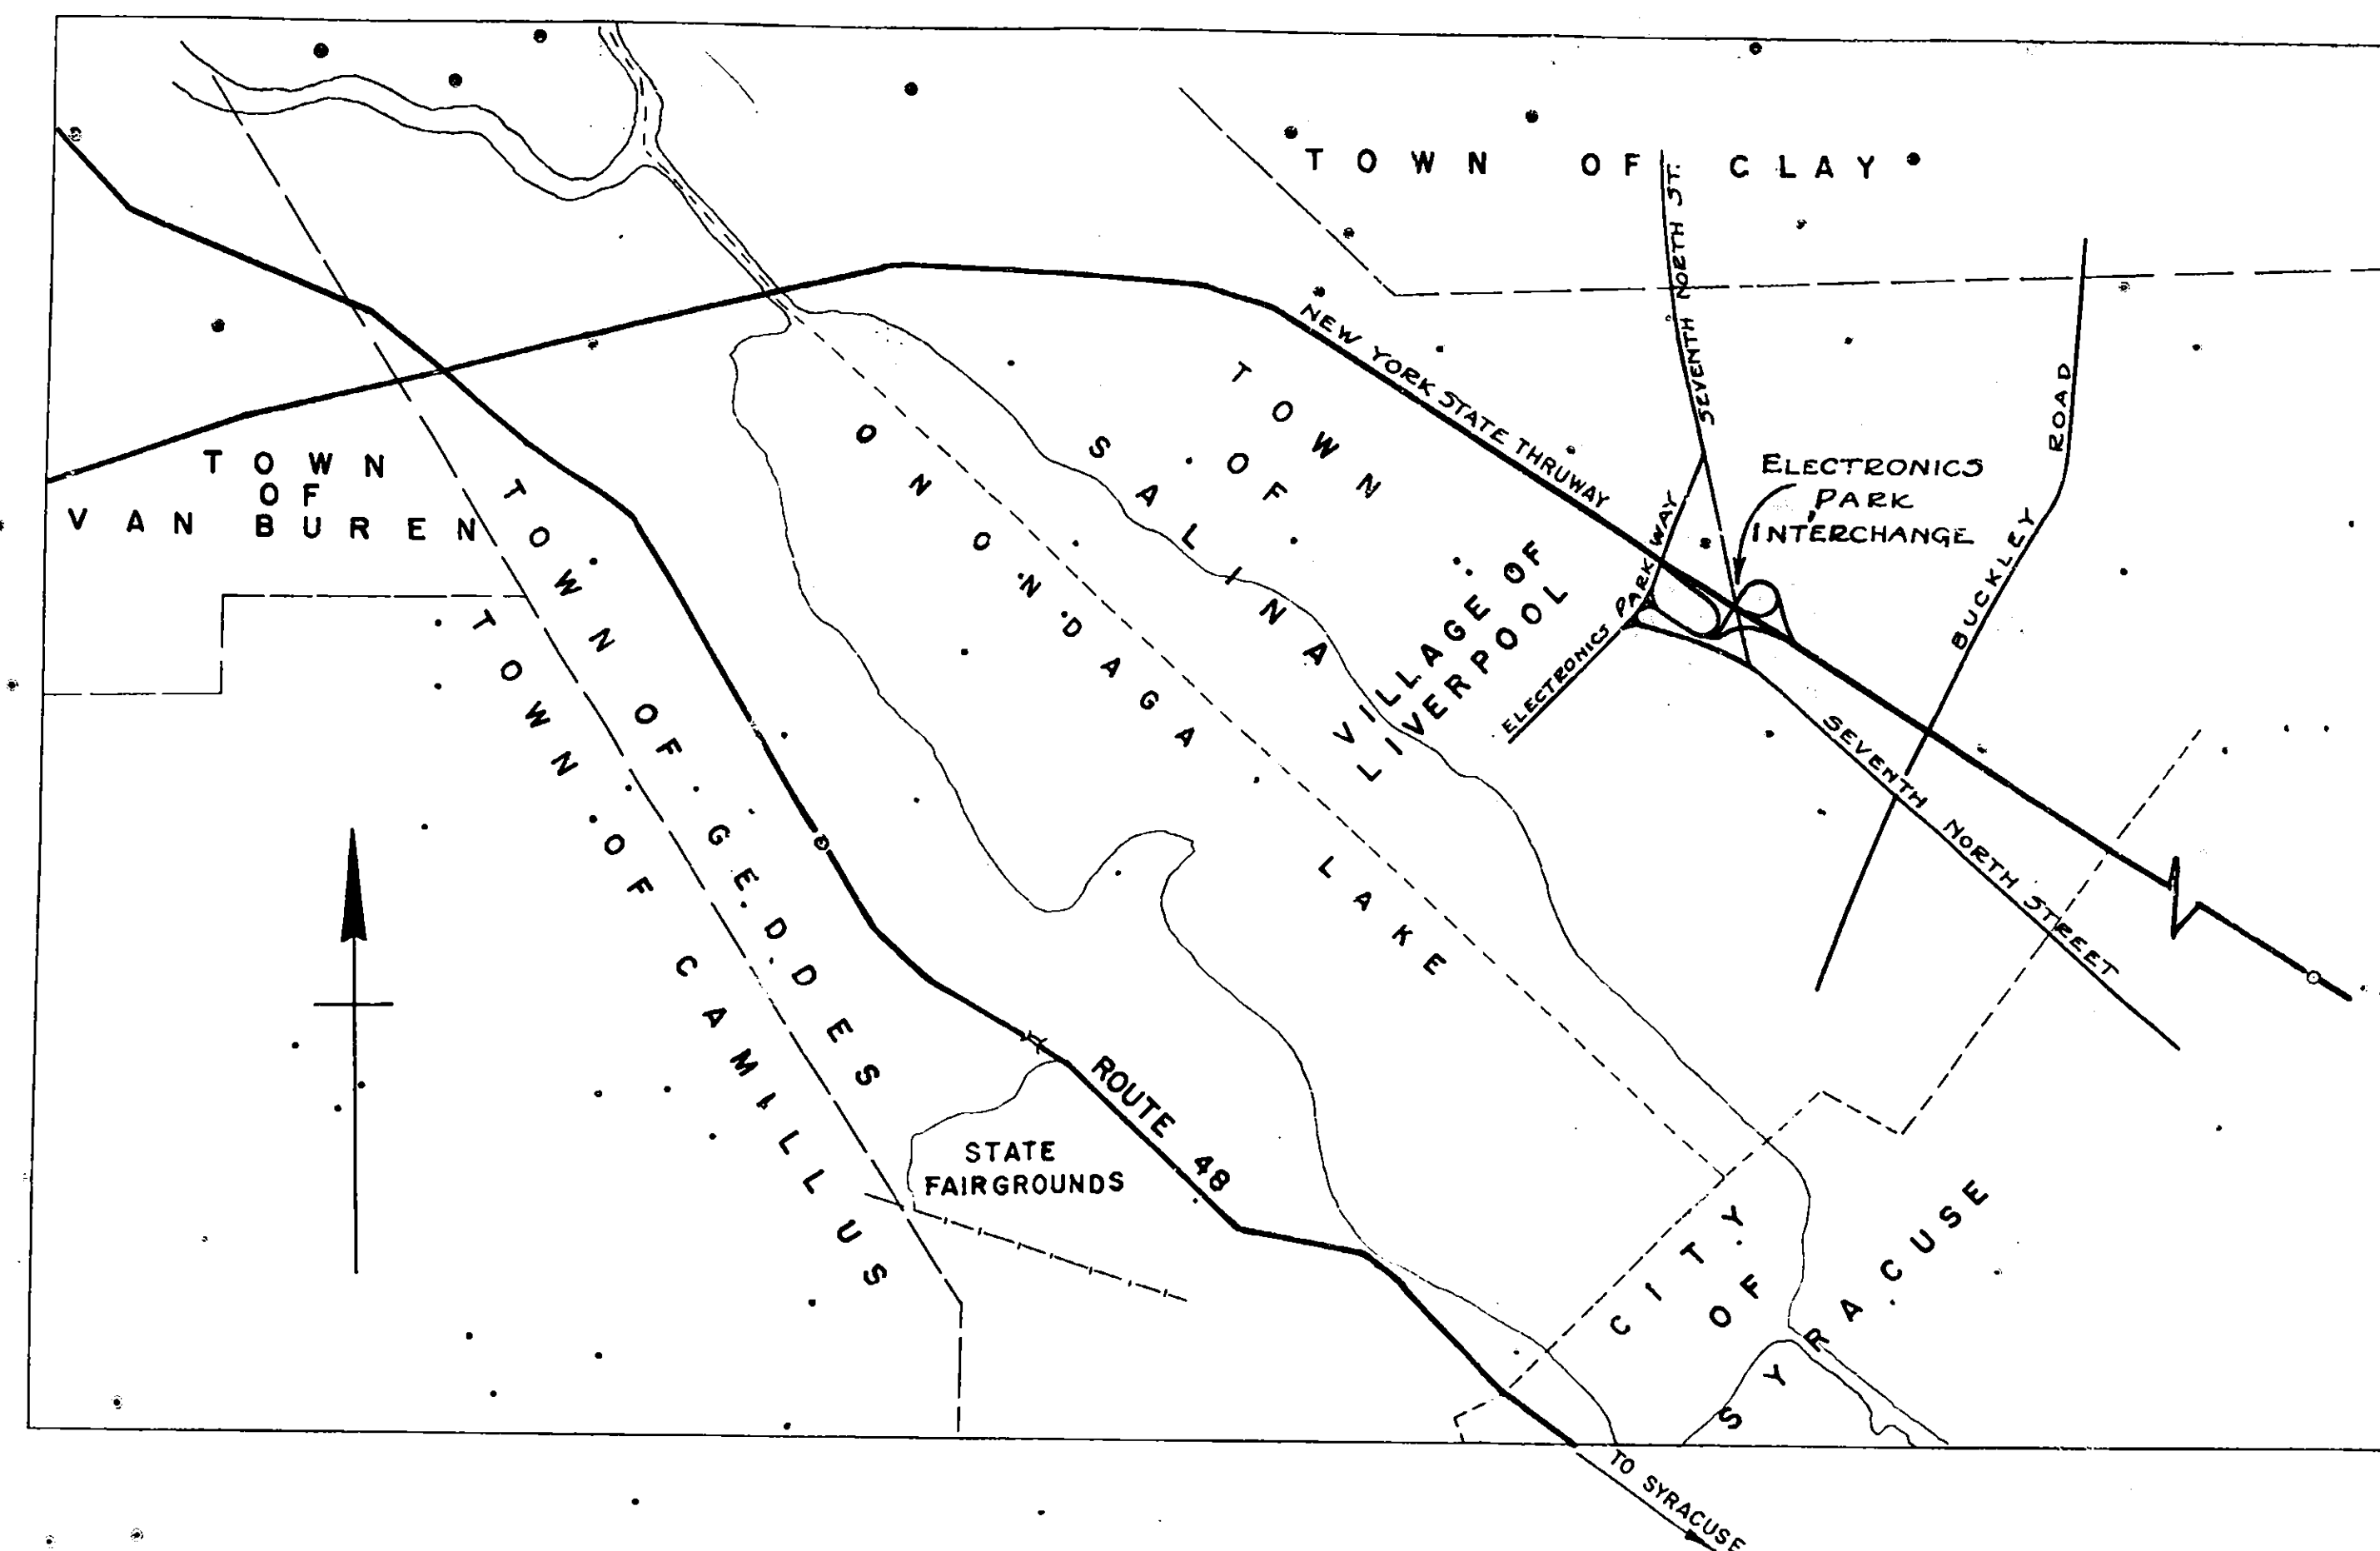

PROFILE ON THRUWAY
THEORETICAL GRADE
HOR. 1" = 500'
VERT. 1" = 10'

DEPARTMENT OF PUBLIC WORKS

RECOMMENDED *Joseph C. Frederick* Feb 26, 1953
JOSEPH C. FEDERICK
ASST. DISTRICT ENGINEER DATE

APPROVED *E.T. GAWKINS* 3/2/53
E.T. GAWKINS
DEPUTY CHIEF ENGINEER DATE

E.W. Wendell MAY 1, 1953
E.W. WENDELL
DEPUTY CHIEF ENGINEER DATE



J.B. McMorran 3/2/53
J.B. MC MORRAN
CHIEF ENGINEER DATE

APPROVED *March 1, 1953*
NEW YORK STATE THRUWAY AUTHORITY

B.D. TALLAMY, CHAIRMAN

BY *C.H. Lang*
C.H. LANG
DEPUTY CHIEF ENGINEER

PRELIMINARY LAYOUT
NEW YORK STATE THRUWAY AND HOPKINS ROAD
TRAFFIC INTERCHANGE

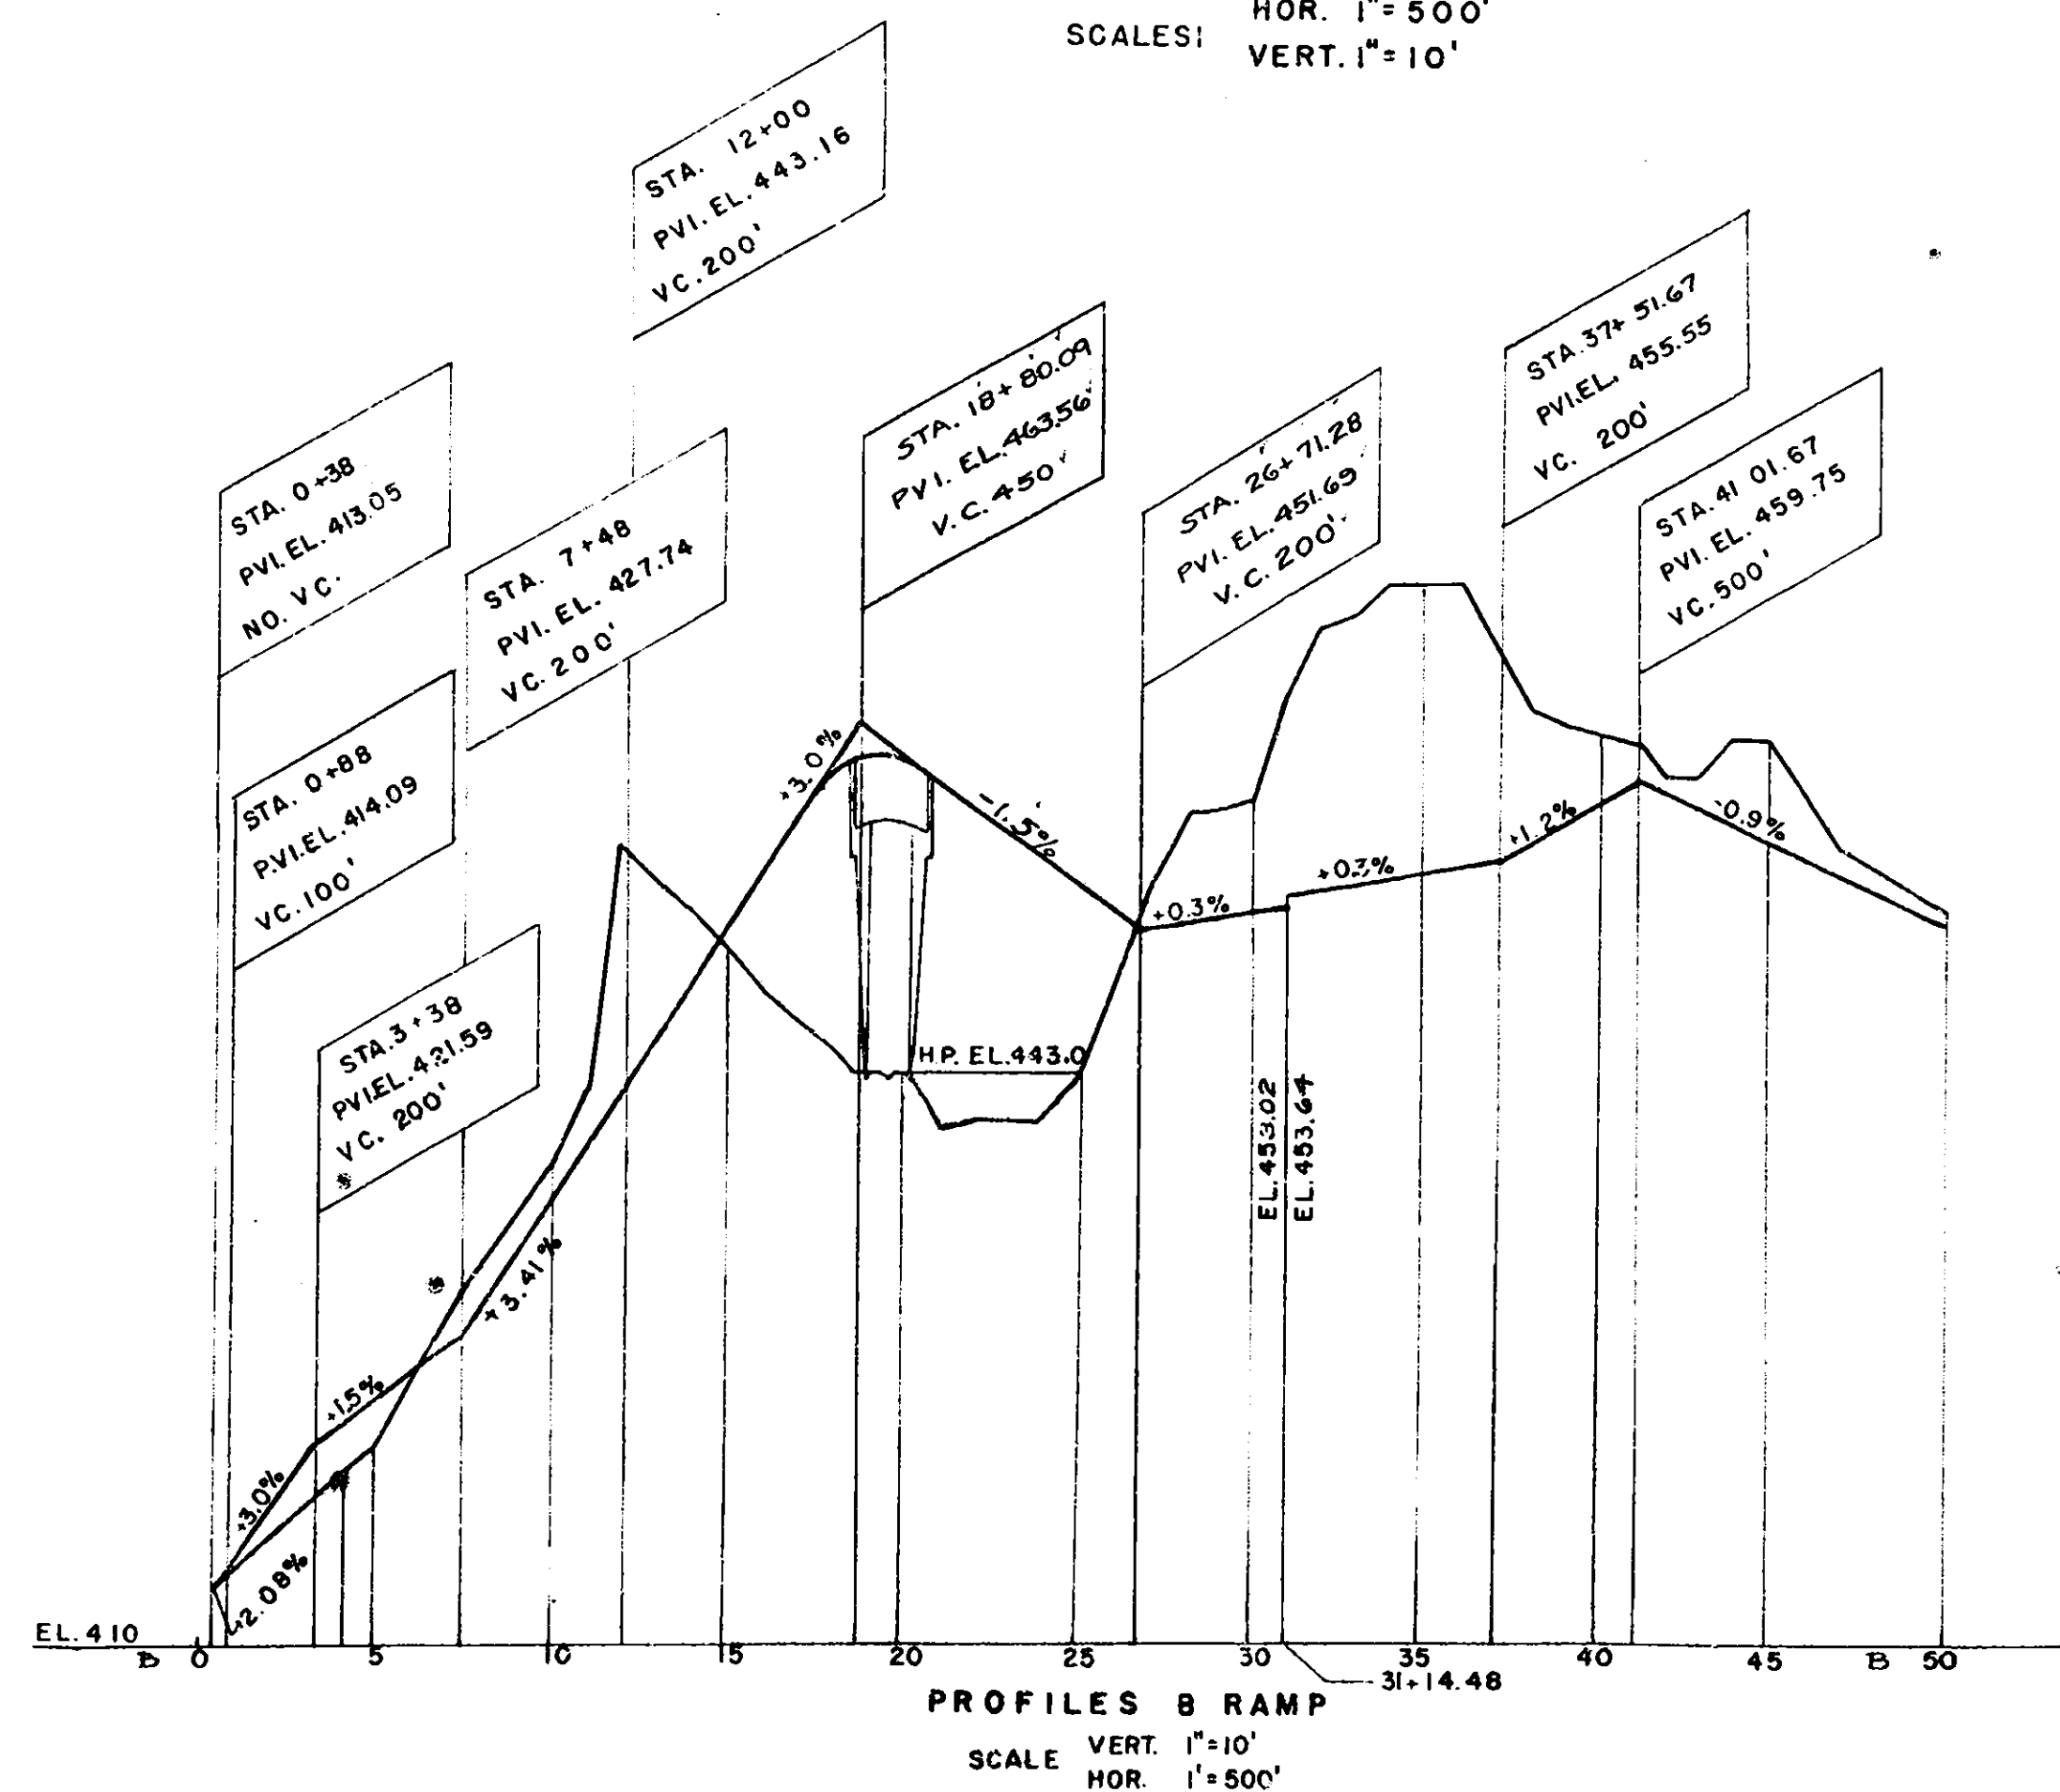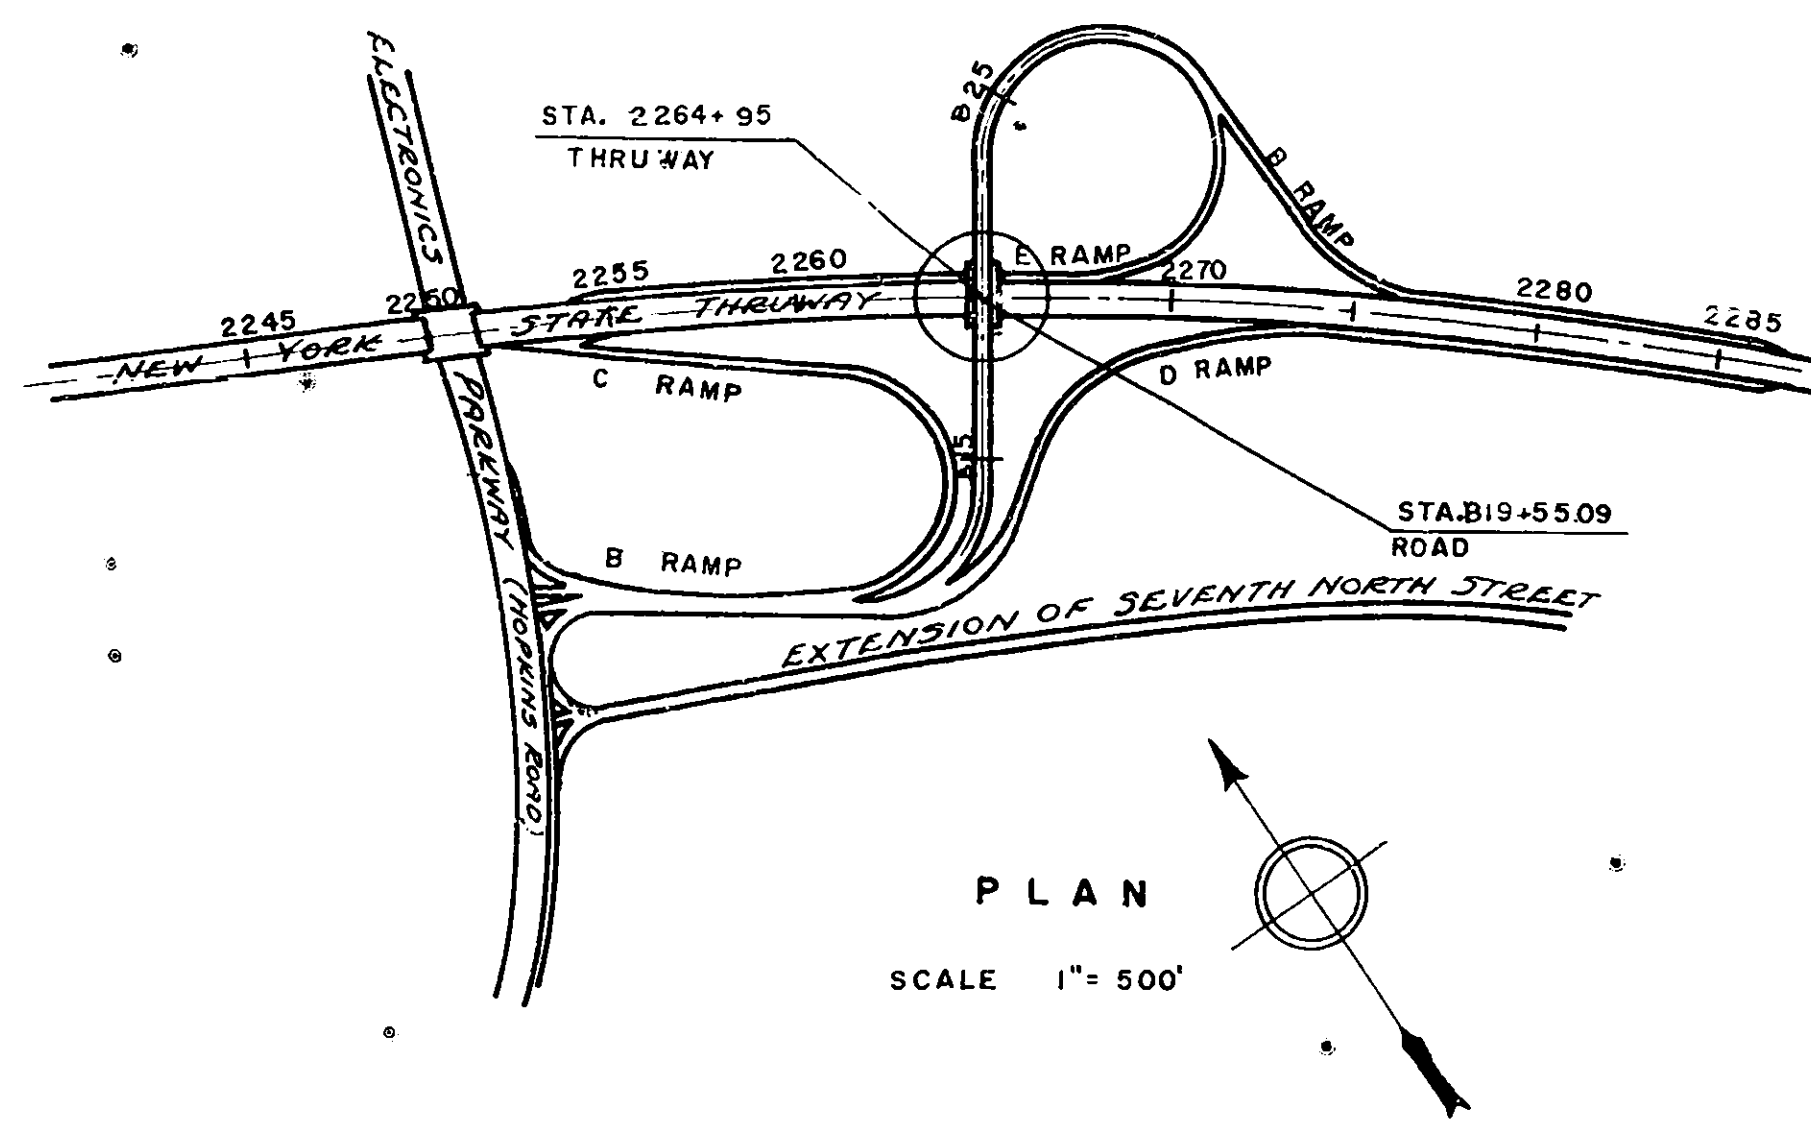


PREPARED AND RECOMMENDED

UROUHAUT & DOYLE CONSULTING ENGINEERS
NEW YORK STATE PROFESSIONAL ENGINEERS LICENSE NO. 5667

DATE

COUNTY	SHEET NO.	TOTAL SHEETS
ONONDAGA	6	66
N.Y. STATE THRUWAY - ONTARIO SECTION SUBDIV 8A		
INTERCHANGE AT ELECTRONICS PARKWAY (HOPKINS ROAD)		

TYPICAL SECTIONS INTERCHANGE AT HOPKINS ROAD

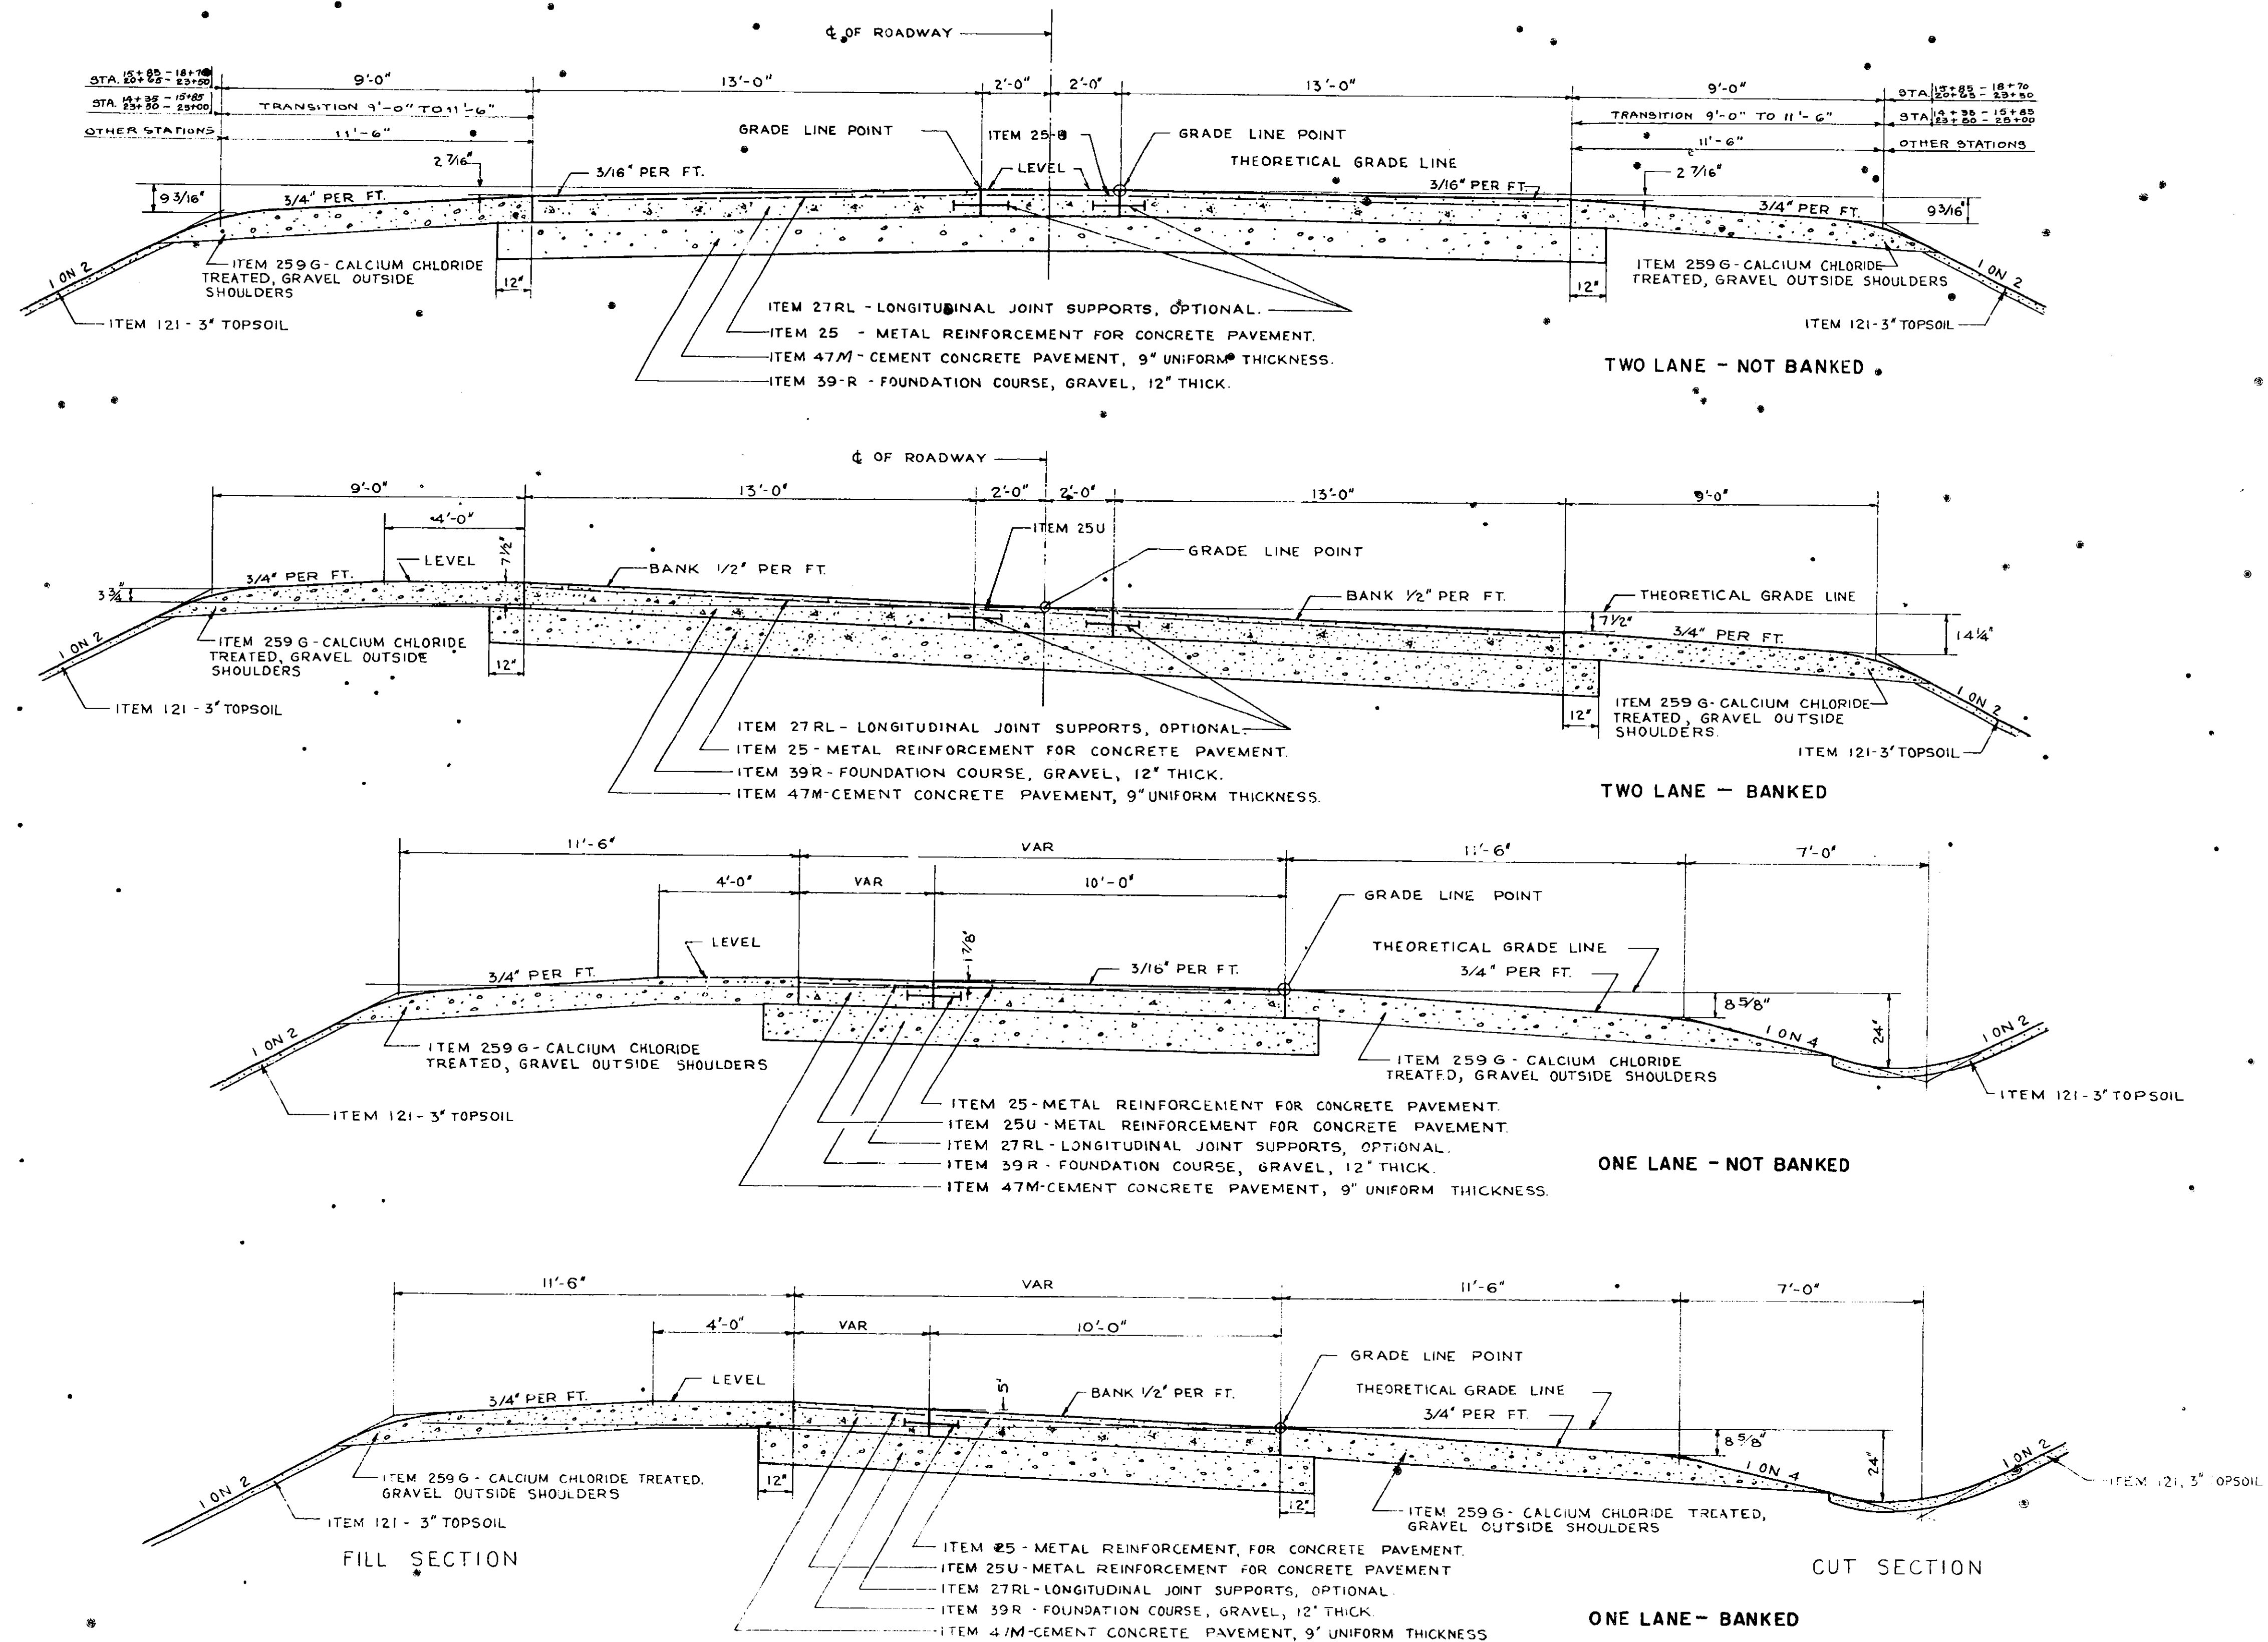


PREPARED AND RECOMMENDED

URQUHART & DOYLE CONSULTING ENGINEERS
 NEW YORK STATE PROFESSIONAL ENGINEERS LICENSE NO. 5667
 DATE 12-6-53

TYPICAL ROAD SECTIONS
 NEW YORK STATE THRUWAY AND HOPKINS ROAD
 TRAFFIC INTERCHANGE

COUNTY			SHEET NO.	TOTAL SHEETS
ONDONAGA			7	66
N.Y. STATE THRUWAY, ONTARIO SECTION, SUB DIV. BA				
INTERCHANGE AT ELECTRONICS PARKWAY, (HOPKINS ROAD)				

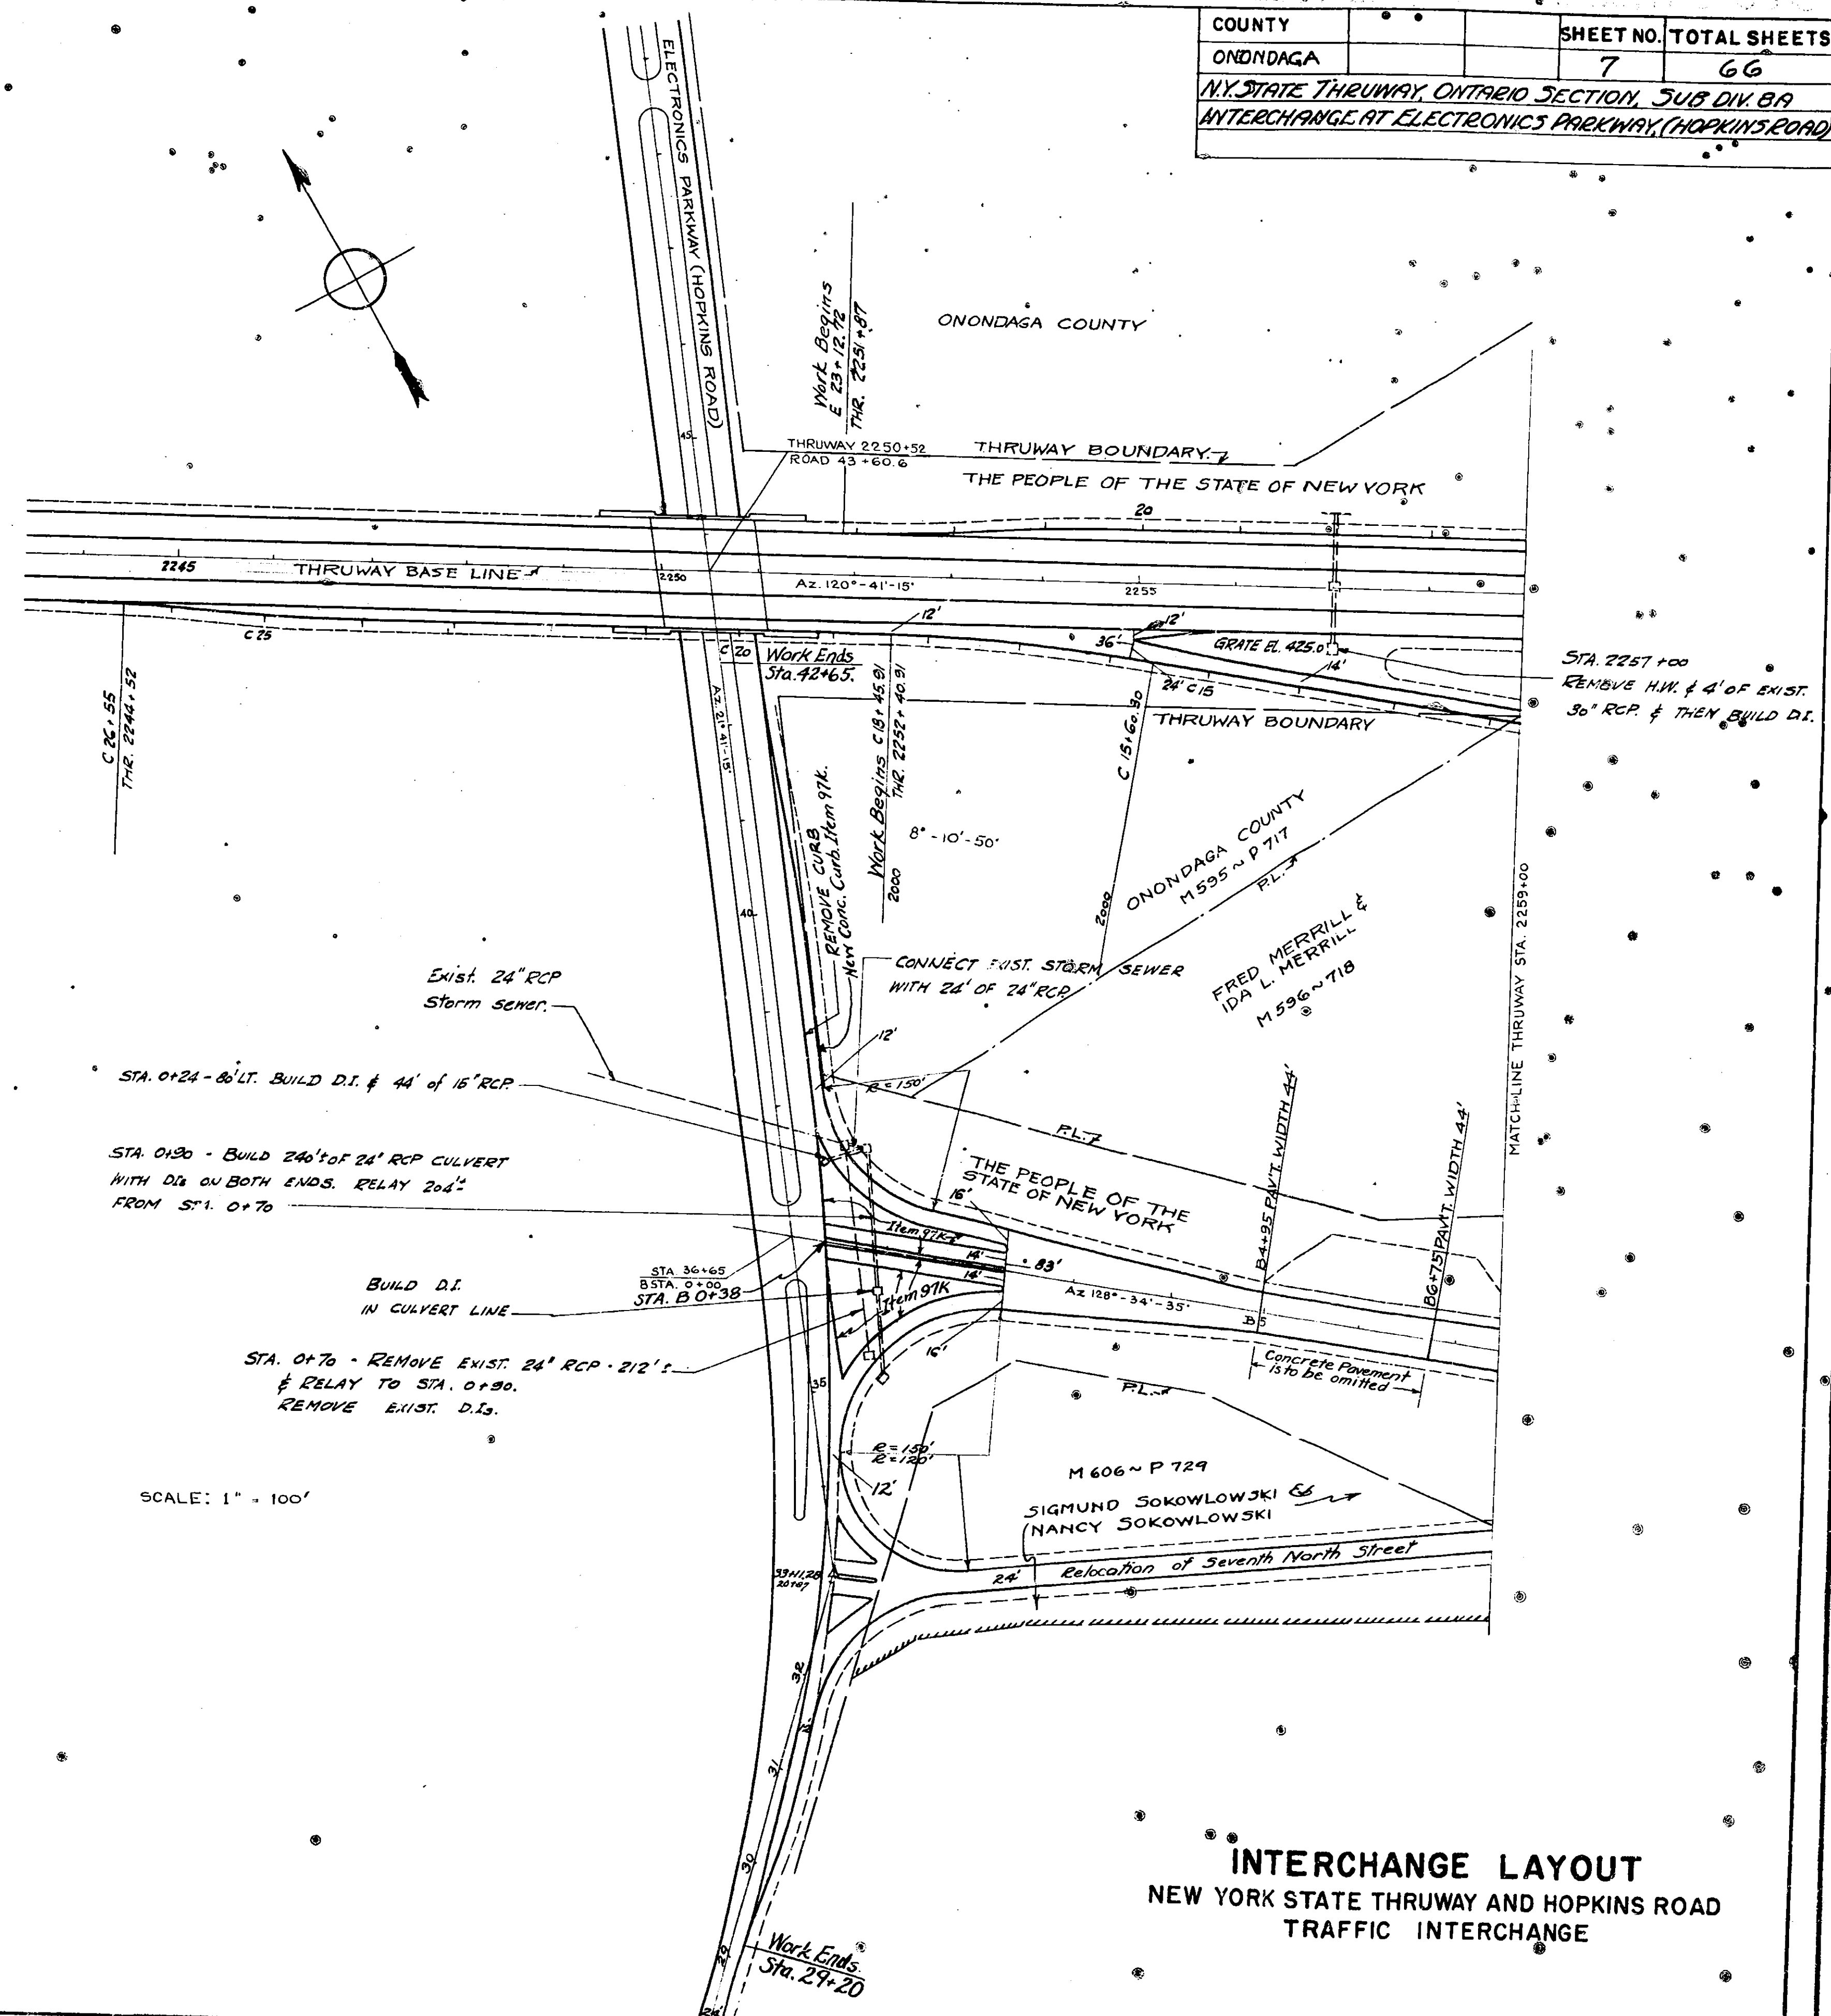

PREPARED AND RECOMMENDED


UQUHART & DOYLE CONSULTING ENGINEERS
NEW YORK STATE PROFESSIONAL ENGINEERS LICENSE NO. 5667

INTERCHANGE LAYOUT

NEW YORK STATE THRUWAY AND HOPKINS ROAD TRAFFIC INTERCHANGE

COUNTY	SHEET NO.	TOTAL SHEETS
ONONDAGA	7	66
NY STATE THRUWAY, ONTARIO SECTION, SUB DIV. 8A		
INTERCHANGE AT ELECTRONICS PARKWAY (HOPKINS ROAD)		

7R

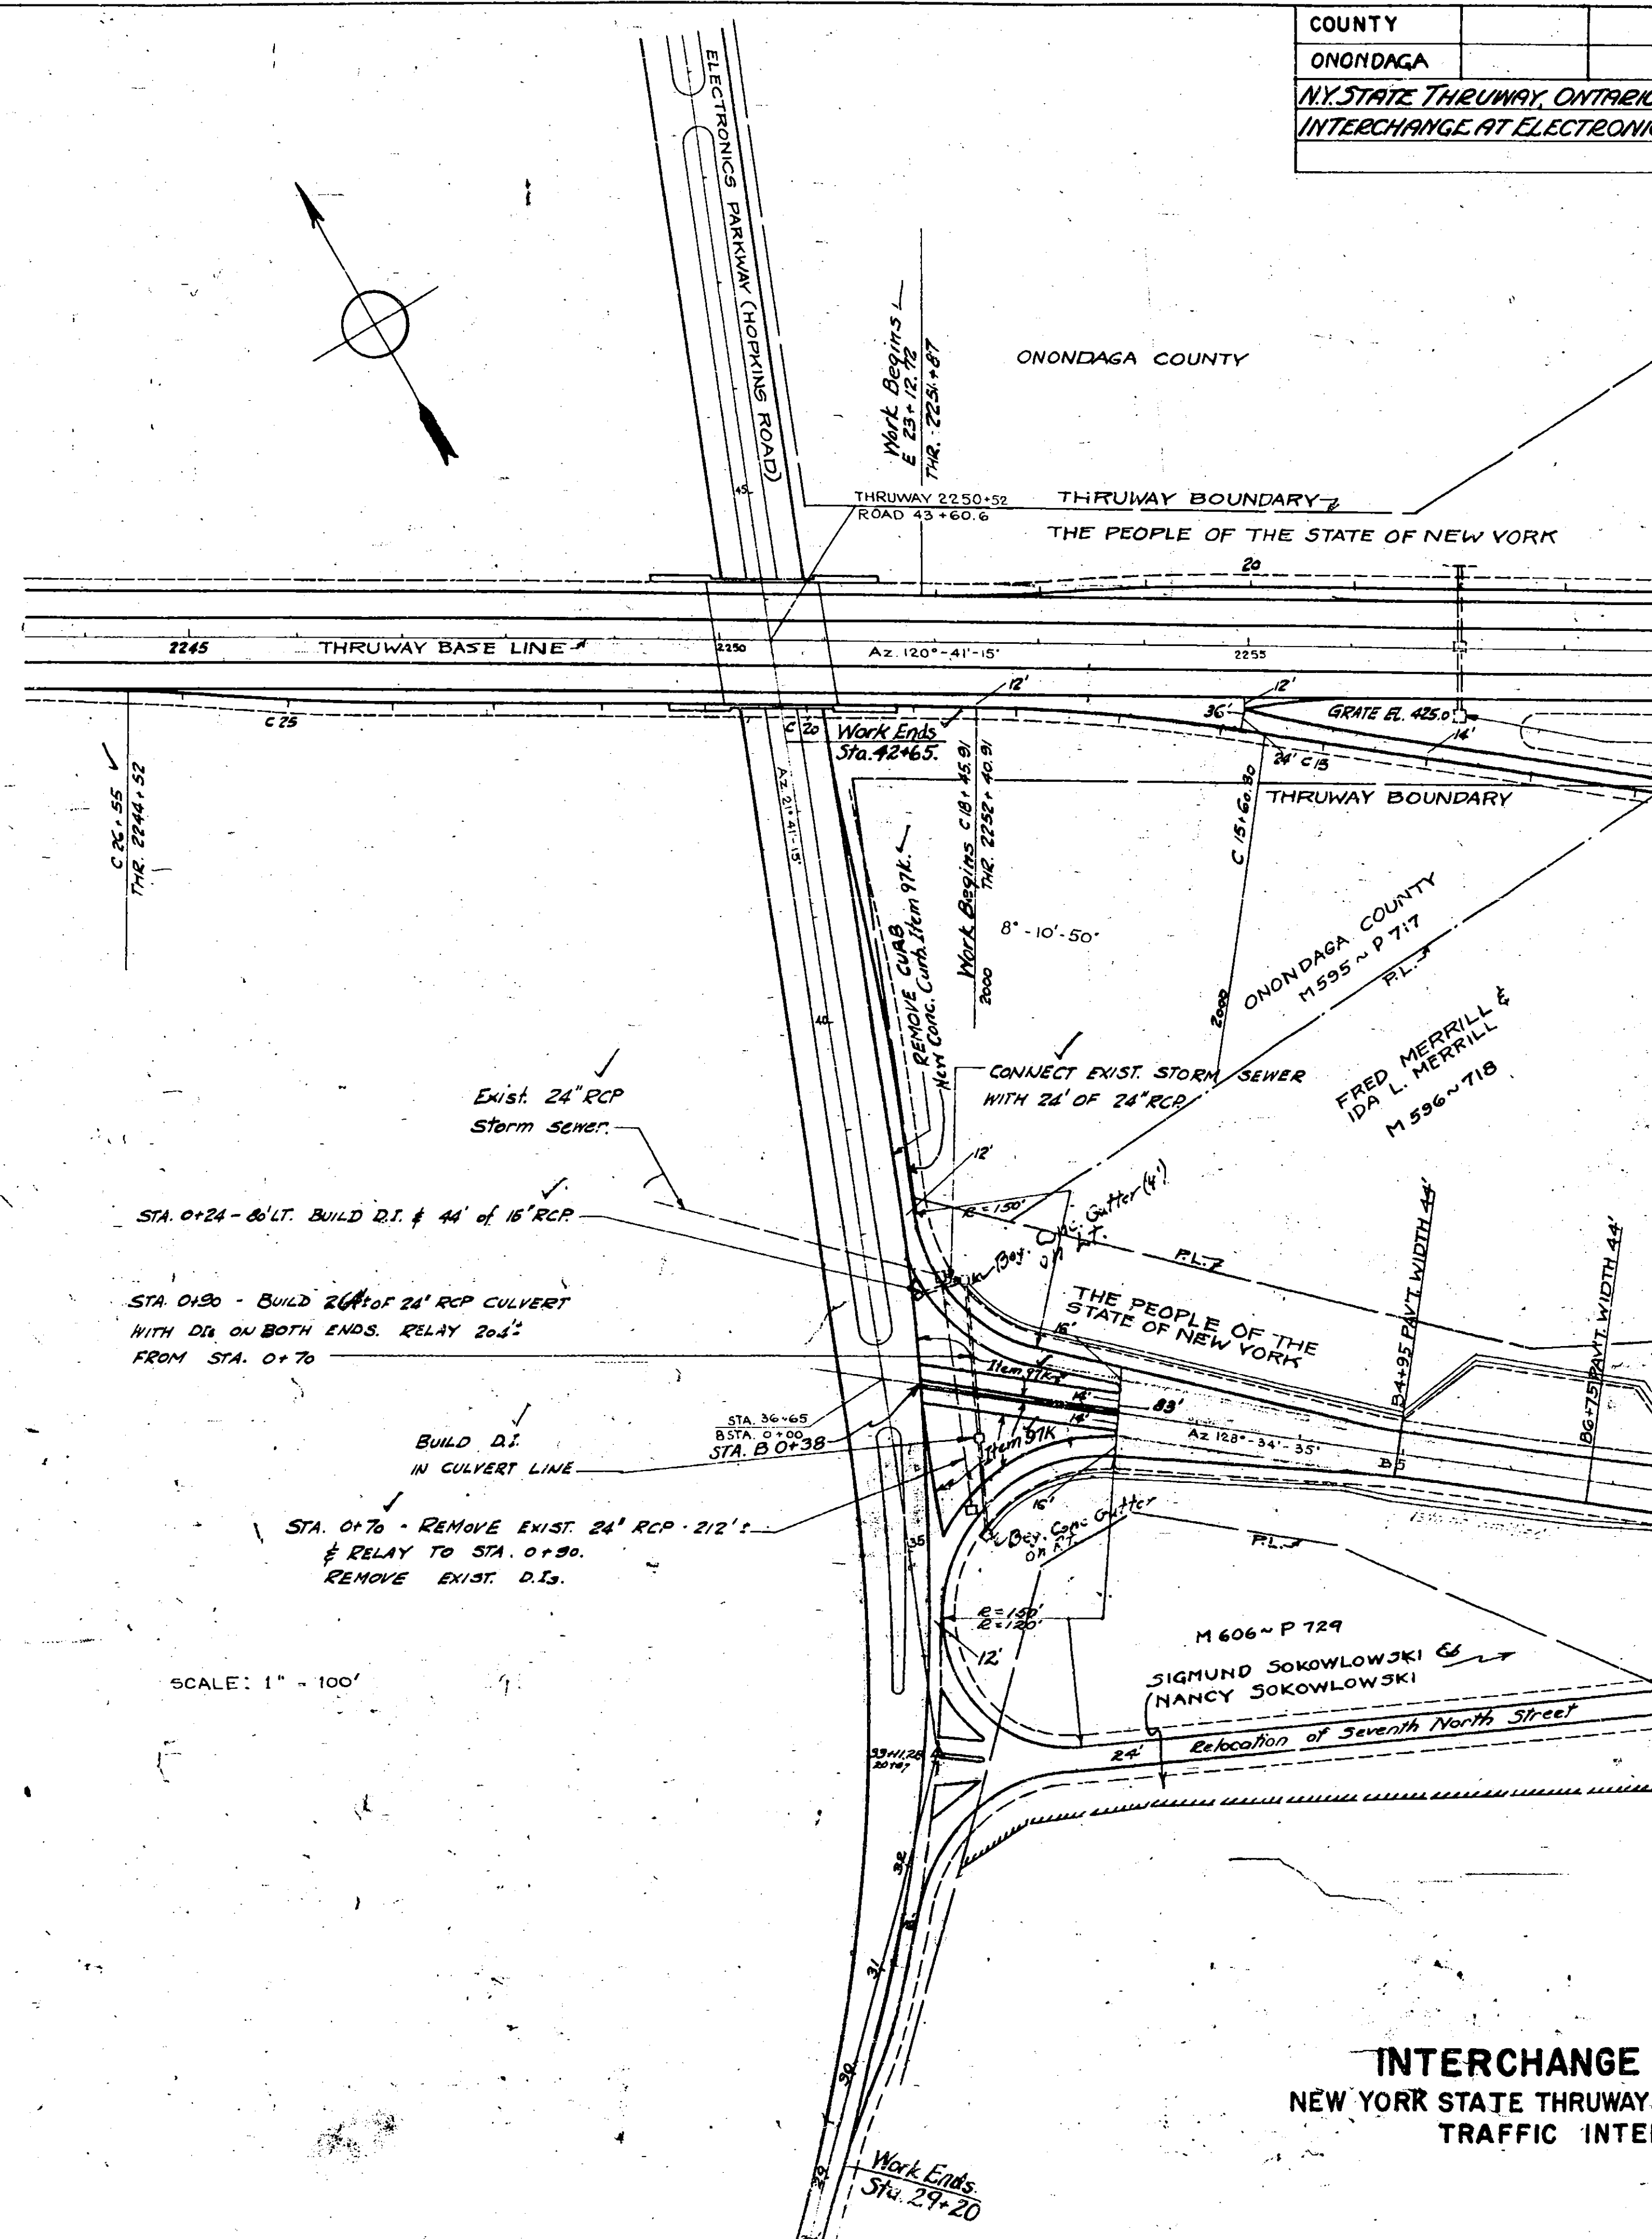

STA. 2257+00
REMOVE H.W. & 4' OF EXIST.
30" RCP & THEN BUILD D.I.


MATCH LINE THRUWAY STA. 2259+00

SCALE: 1" = 100'

INTERCHANGE LAYOUT
NEW YORK STATE THRUWAY AND HOPKINS ROAD
TRAFFIC INTERCHANGE

PREPARED AND RECOMMENDED
UQUHART B DOYLE CONSULTING ENGINEERS
NEW YORK STATE PROFESSIONAL ENGINEERS LICENSE NO. 5667
DATE
FEB 16 - 53

COUNTY	SHEET NO.	TOTAL SHEETS
ONONDAGA	8	66
NEW YORK STATE THRUWAY ONTARIO SECTION SUB DIV. 0A		
INTERCHANGE AT ELECTRONICS PARKWAY (HOPKINS ROAD)		

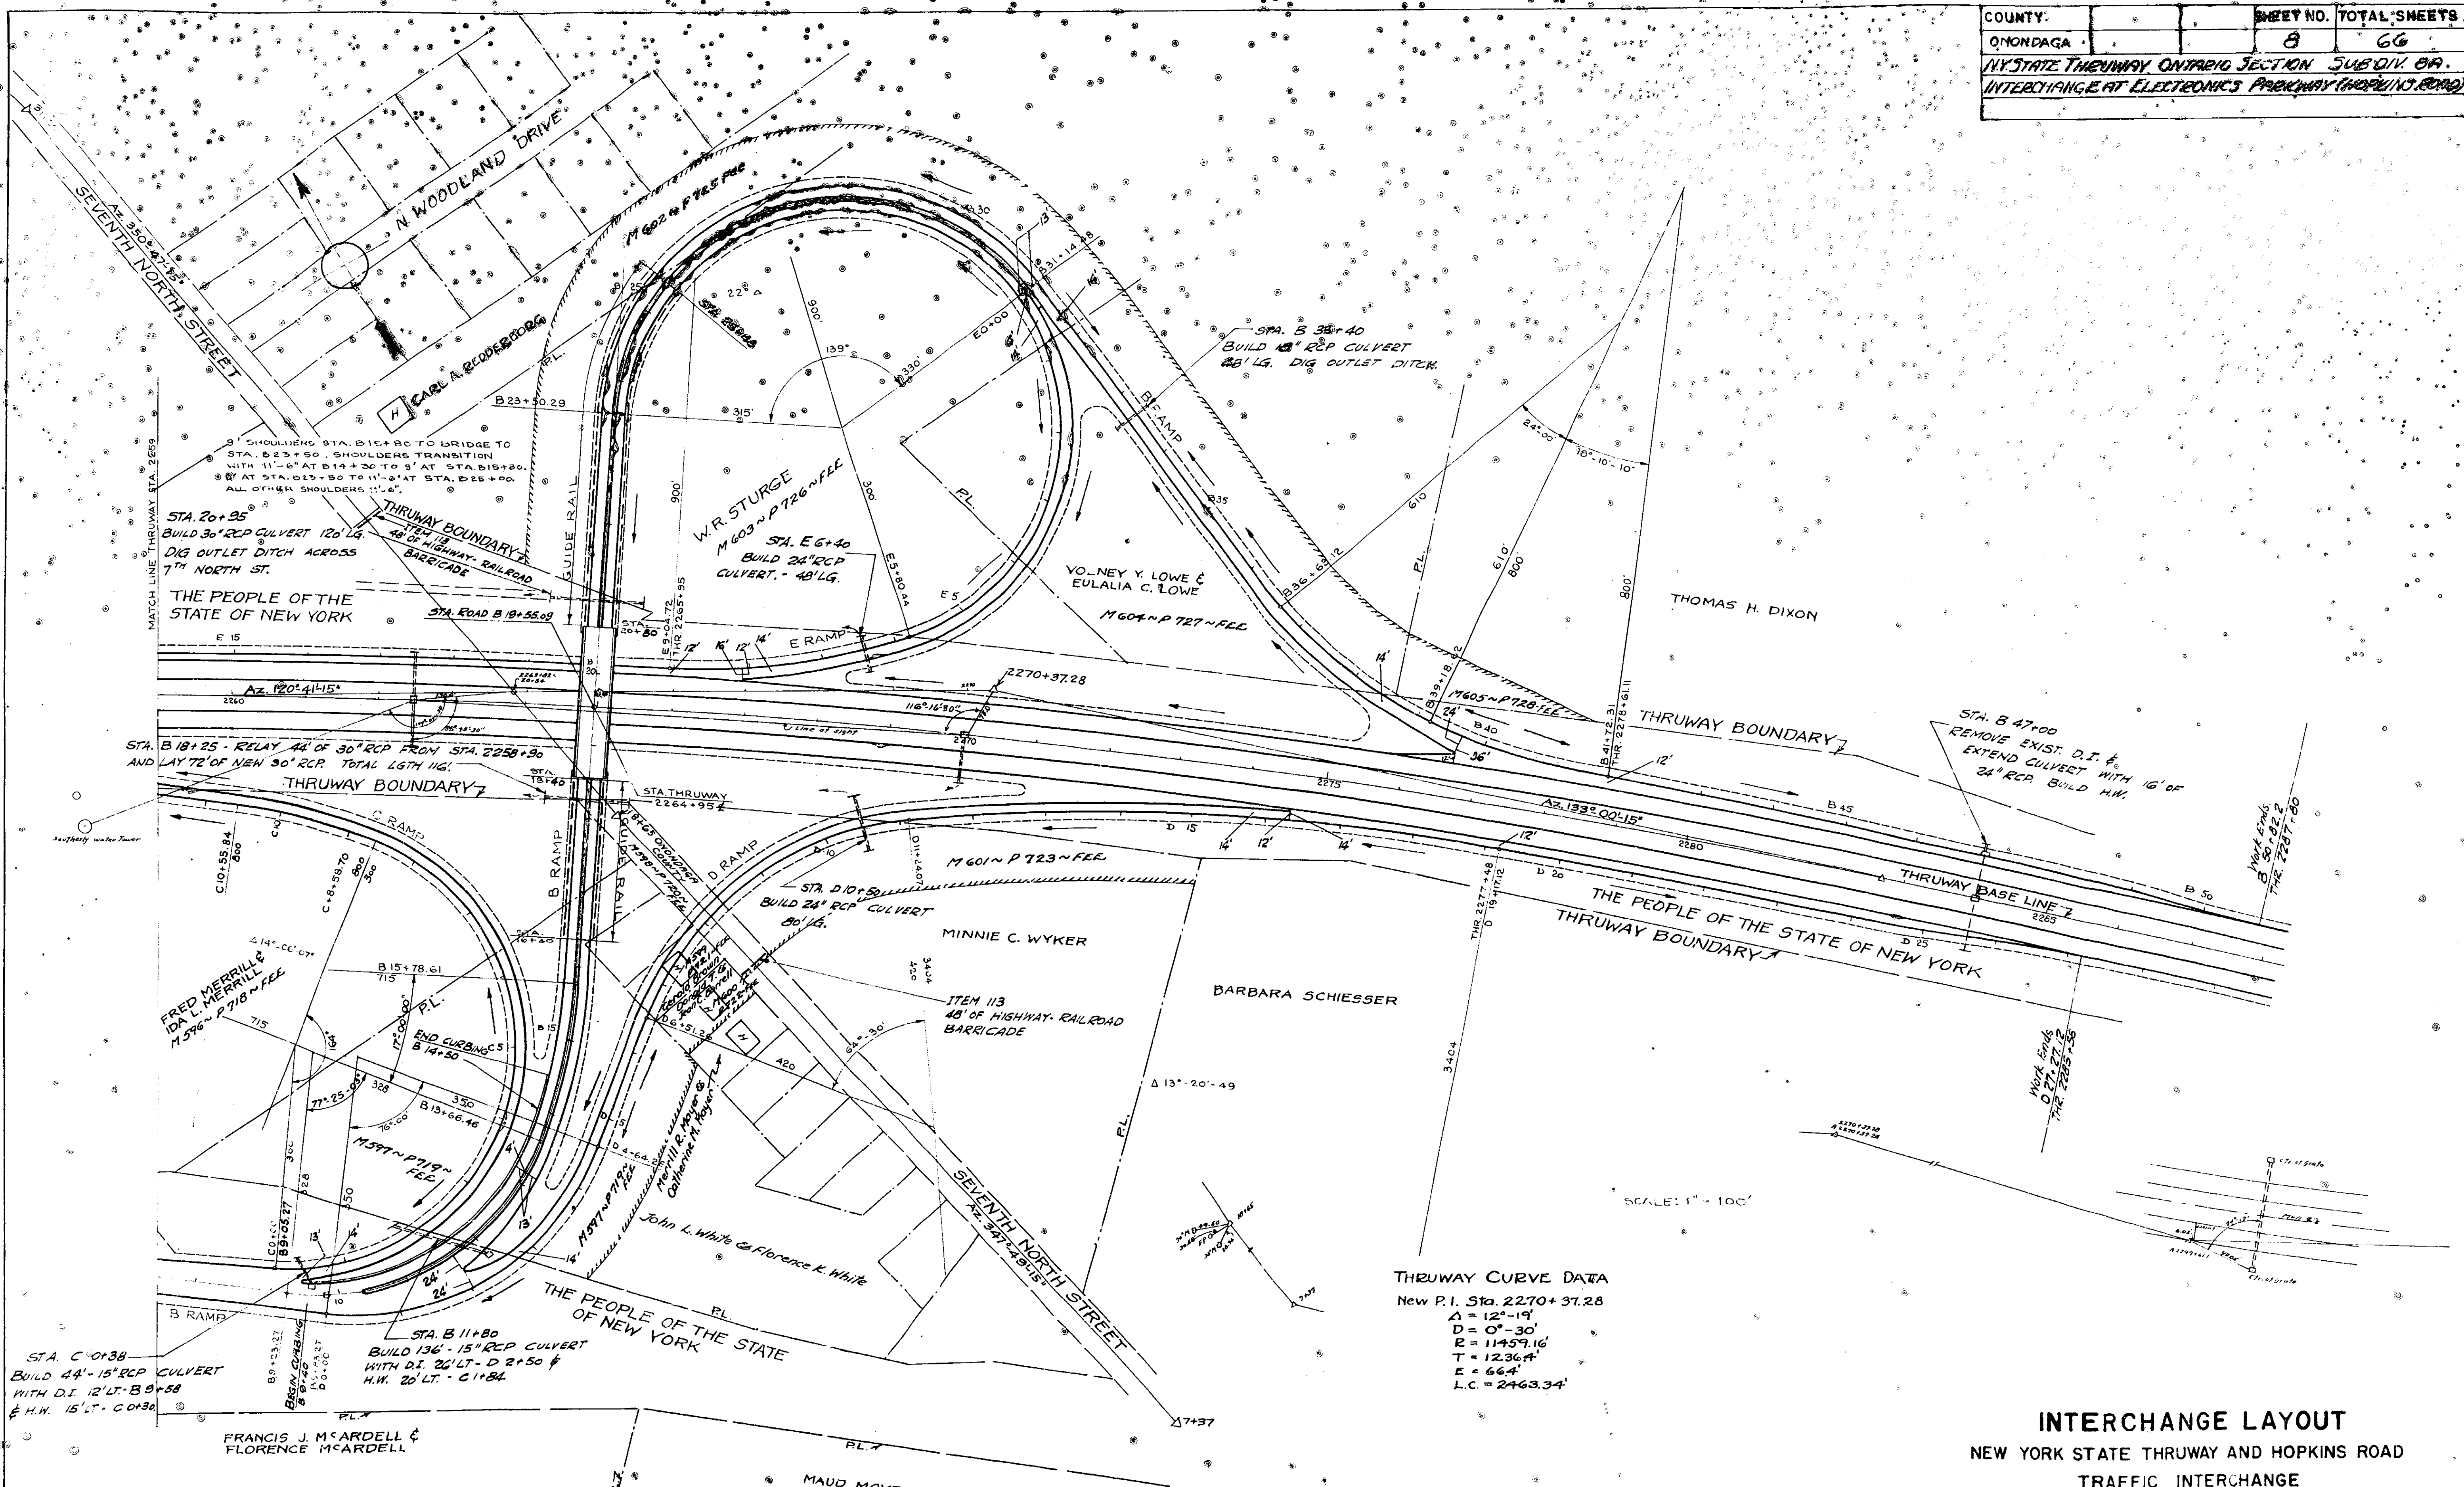


THRUWAY CURVE DATA
 New P.I. Sta. 2270+37.28
 Δ = 12°-19'
 D = 0°-30'
 E = 11459.16'
 T = 1236.4'
 E = 664'
 L.C. = 2463.34'

INTERCHANGE LAYOUT NEW YORK STATE THRUWAY AND HOPKINS ROAD TRAFFIC INTERCHANGE

PREPARED AND RECOMMENDED
 LUNCHART & DOYLE CONSULTING ENGINEERS
 NEW YORK STATE PROFESSIONAL ENGINEERS LICENSE NO. 5667
 DATE Feb 16-13


COUNTY	SHEET NO.	TOTAL SHEETS
ONONDAGA	8	66
NEW YORK STATE THRUWAY ONTARIO SECTION SUB DIV. 8A		
INTERCHANGE AT ELECTRONICS PARKWAY (HOPKINS ROAD)		

8R

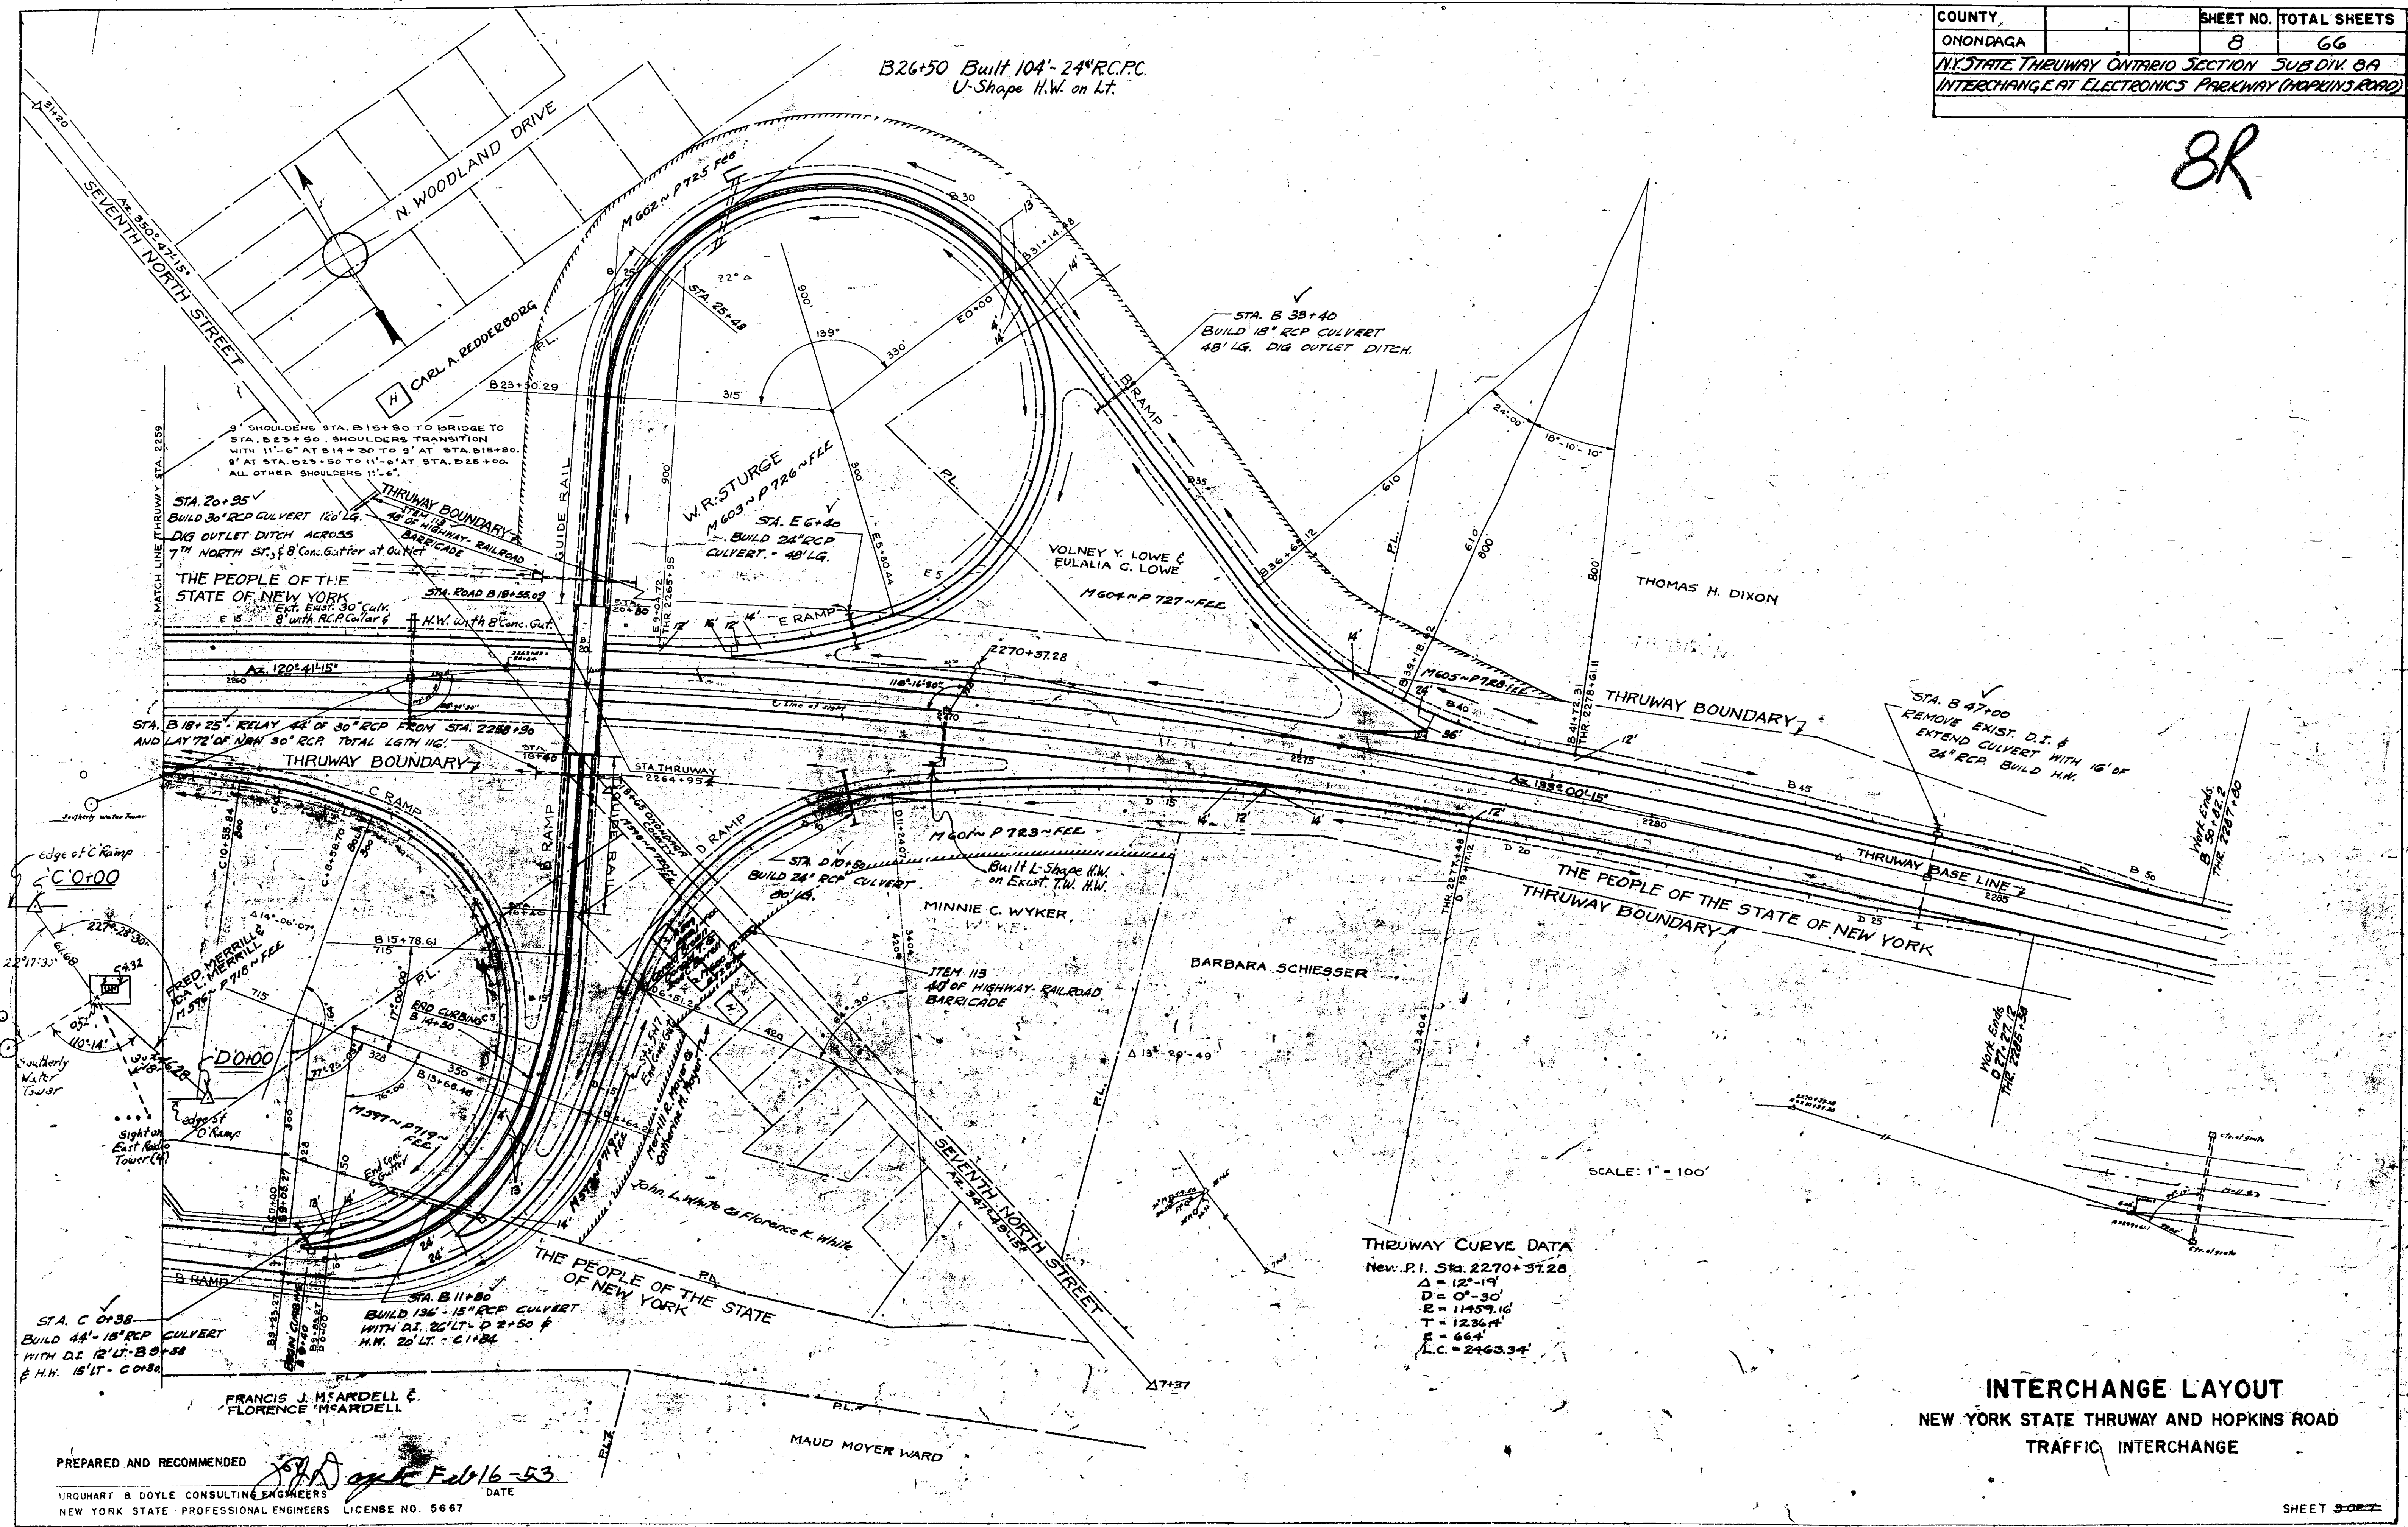


INTERCHANGE LAYOUT
 NEW YORK STATE THRUWAY AND HOPKINS ROAD
 TRAFFIC INTERCHANGE


COUNTY		SHEET NO.	TOTAL SHEETS
ONONDAGA		9	66
N.Y. STATE THRUWAY ONTARIO SECTION SUBDIV. 8A			
INTERCHANGE AT ELECTRONICS PARKWAY (HOPKINS ROAD)			

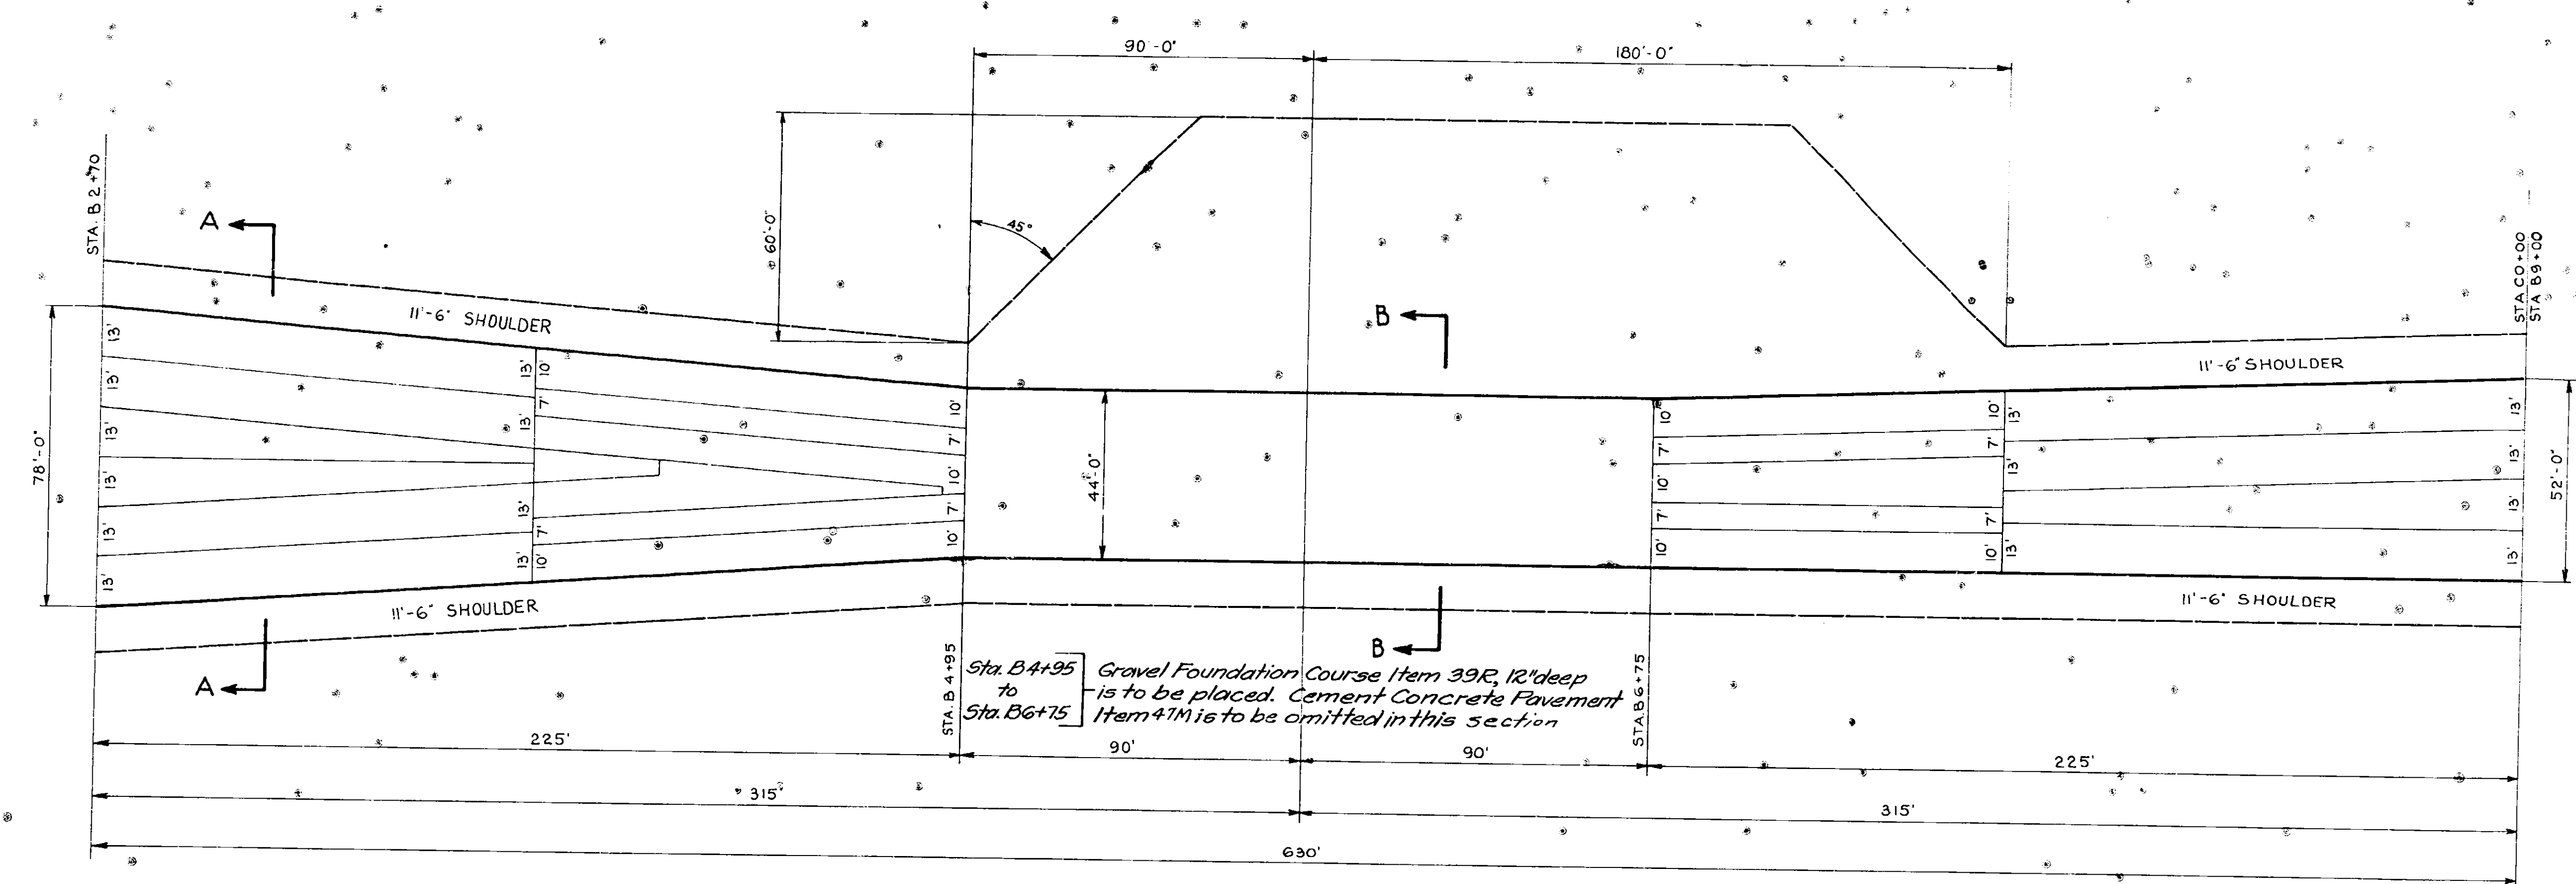

CONTROL AREA PLAN
SCALE: 1" = 25'-0"

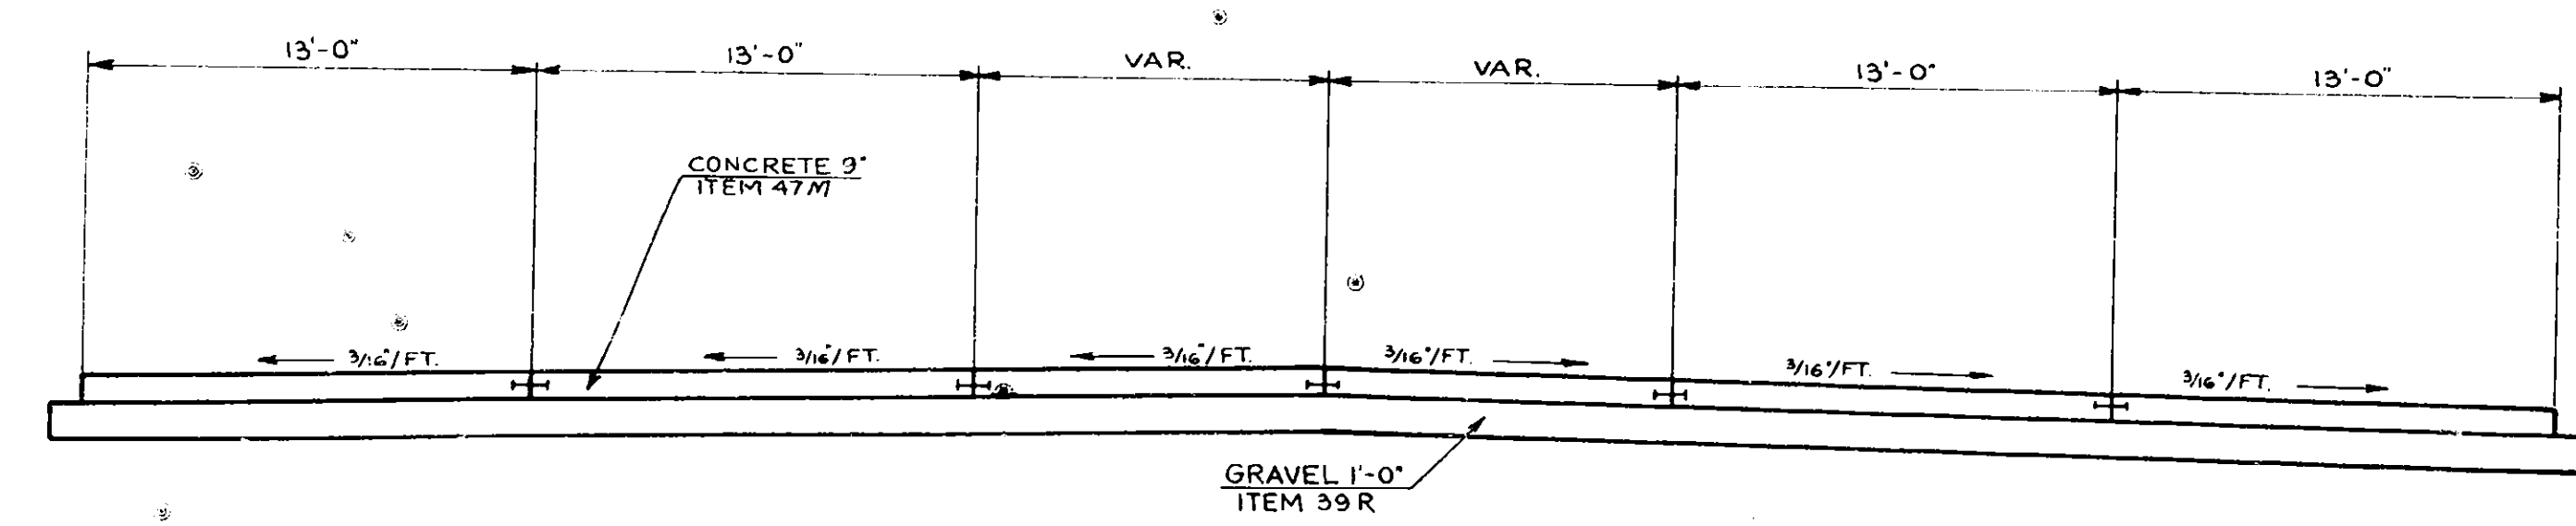

SECTION A-A
SCALE: 1" = 5'-0"

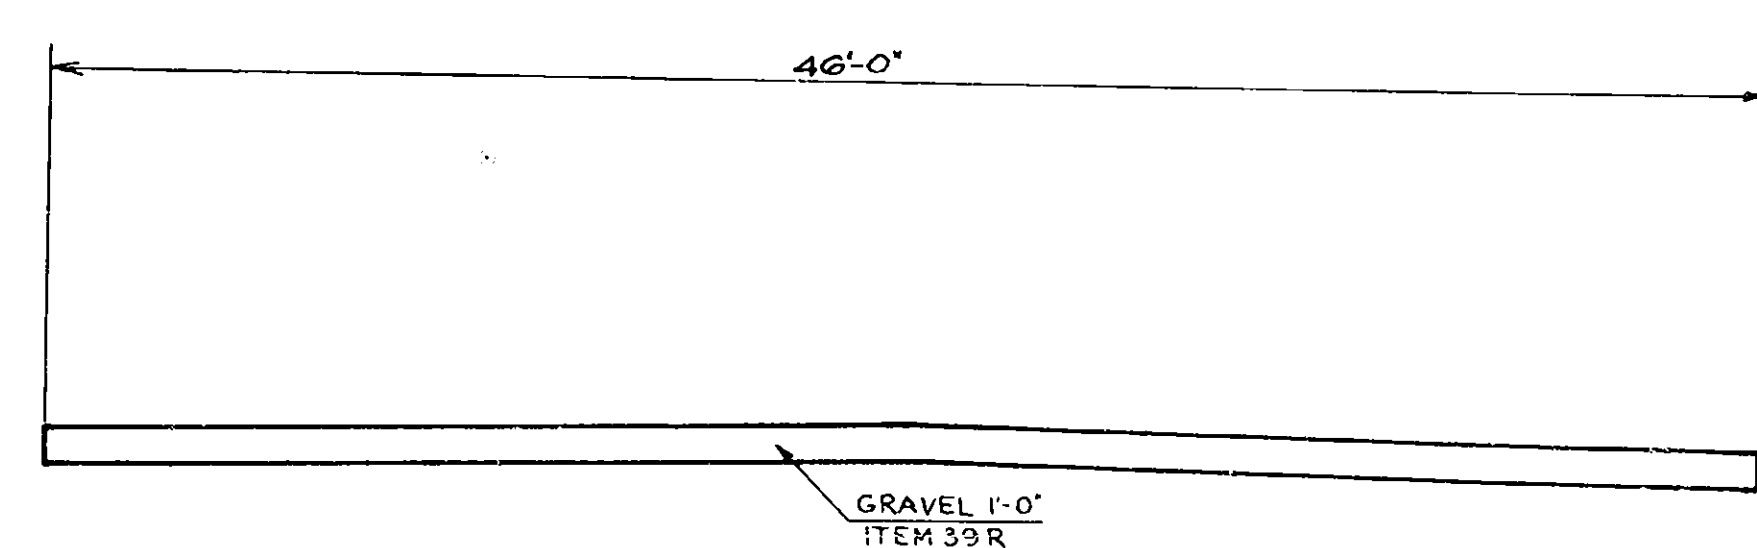


SECTION B-B
SCALE: 1" = 5'-0"

CONTROL AREA PLAN
NEW YORK STATE THRUWAY AND HOPKINS ROAD
TRAFFIC INTERCHANGE


PREPARED AND RECOMMENDED
URQUHART AND DOYLE CONSULTING ENGINEERS
NEW YORK STATE PROFESSIONAL ENGINEERS LICENSE NO 5667
DATE Mar 9-53

COUNTY		SHEET NO.	TOTAL SHEETS
ONONDAGA		9	66
N.Y. STATE THRUWAY ONTARIO SECTION SUBDIV. 8A			
INTERCHANGE AT ELECTRONICS PARKWAY (HOPKINS ROAD)			


9R

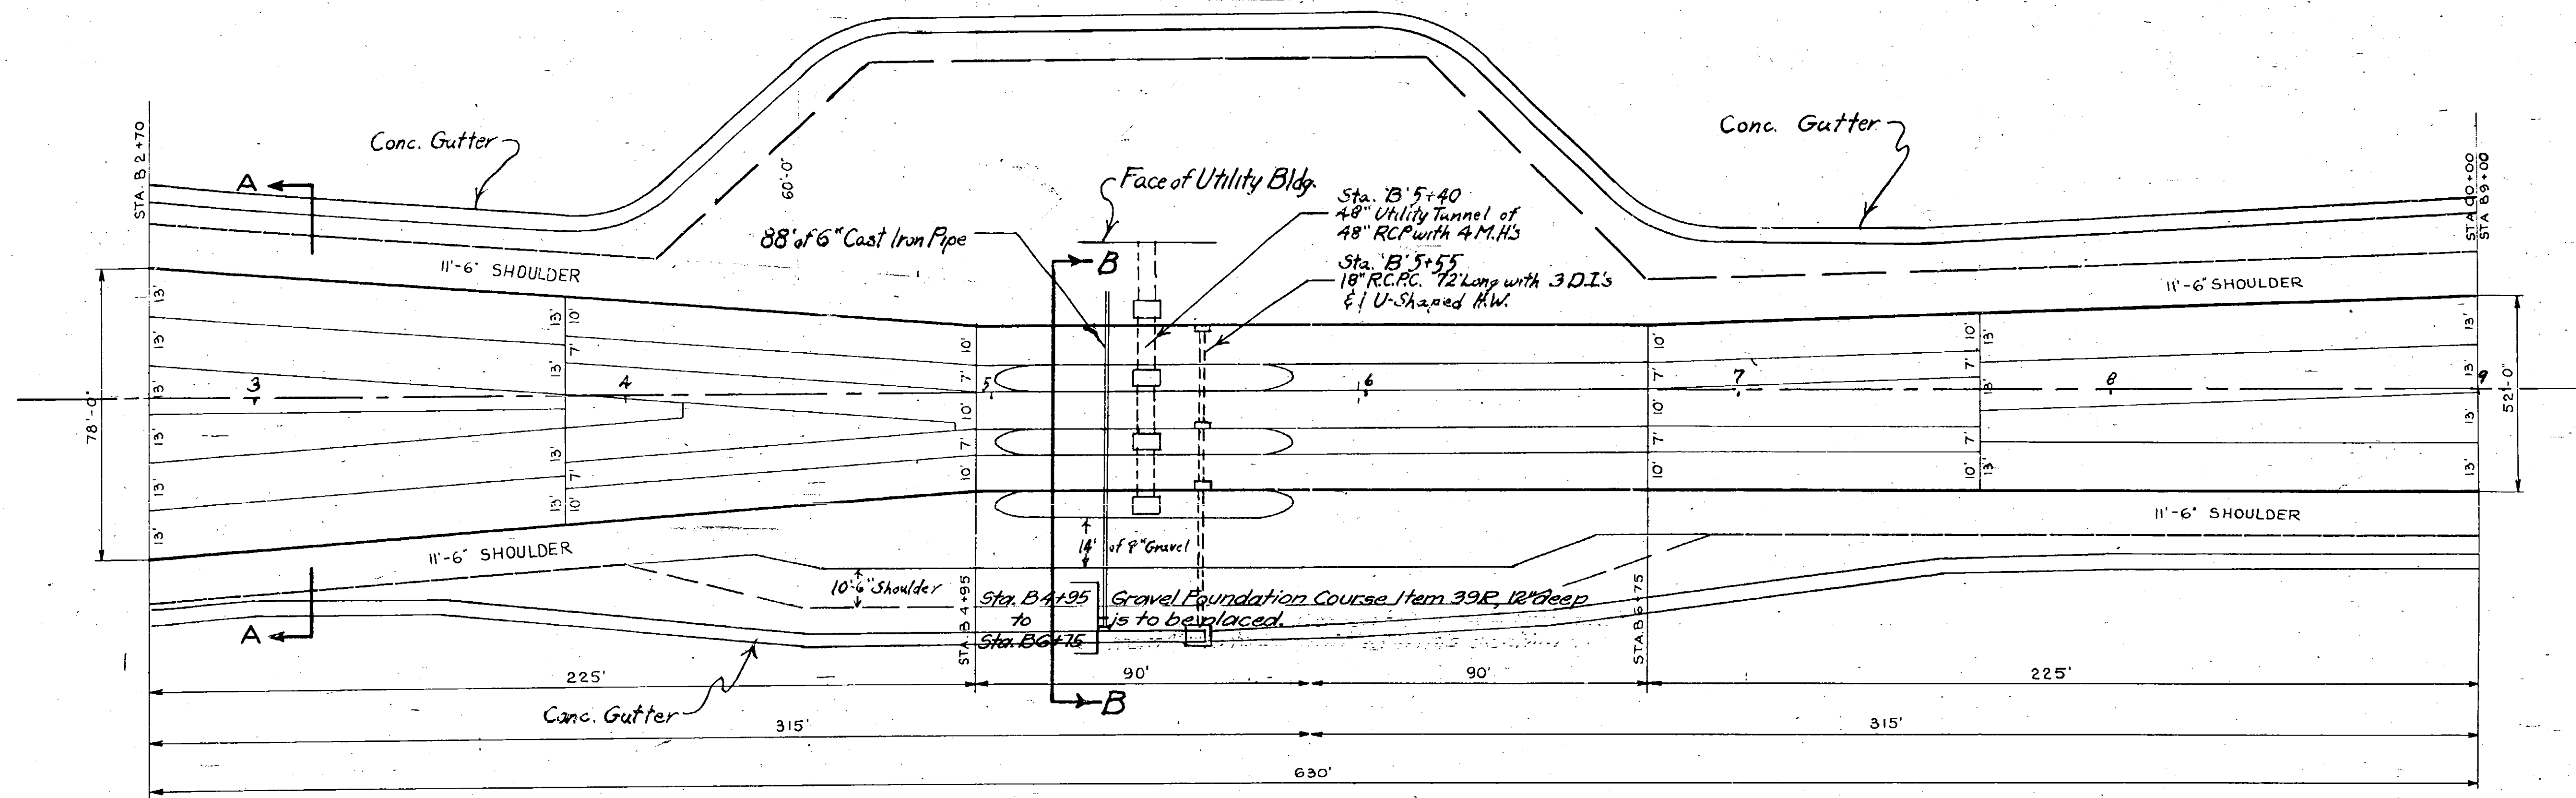

CONTROL AREA PLAN
SCALE: 1" = 25'-0"

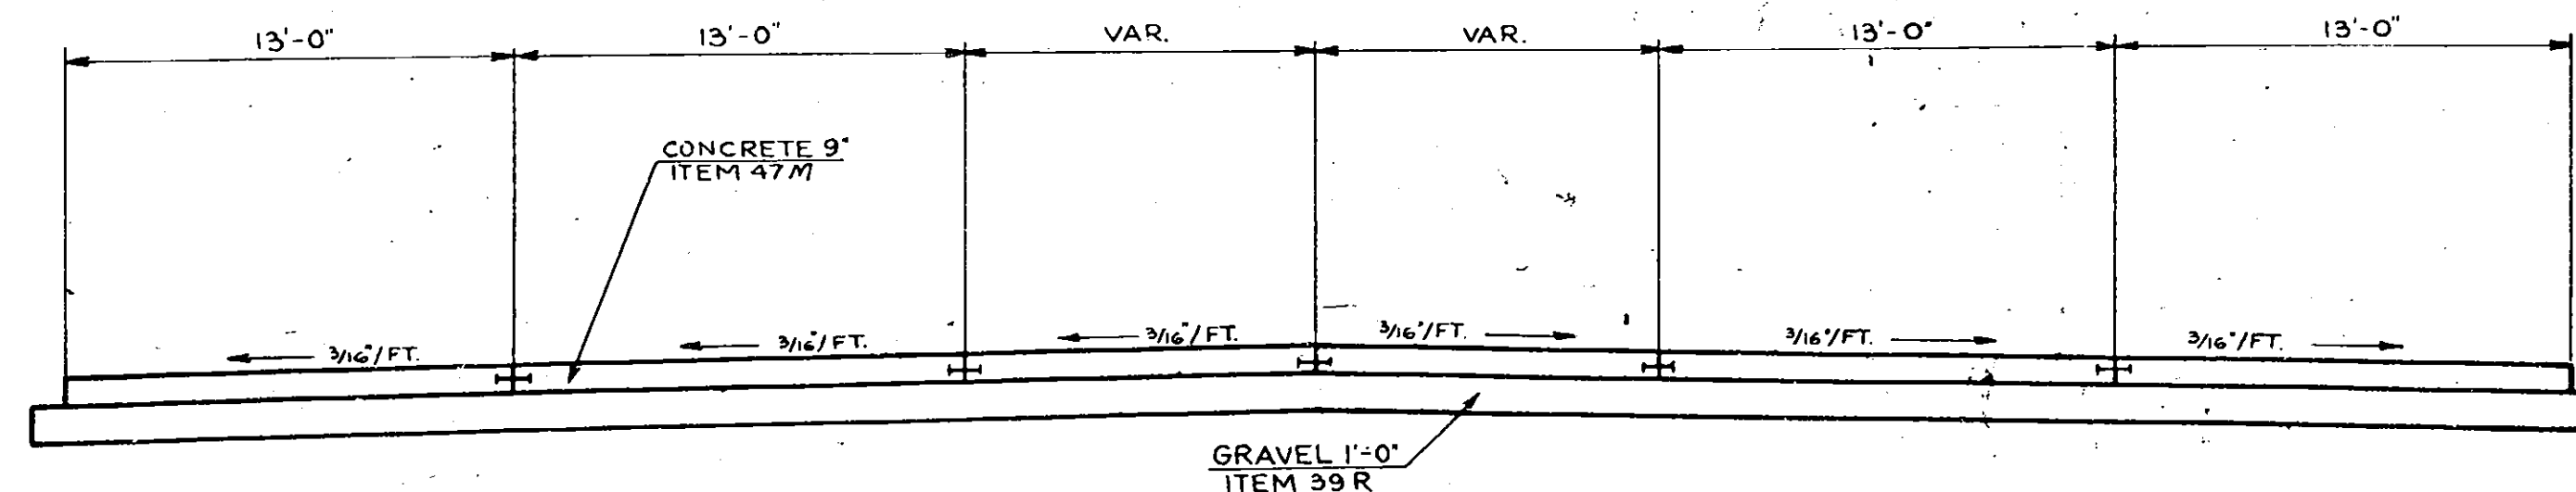

SECTION A-A
SCALE: 1" = 5'-0"

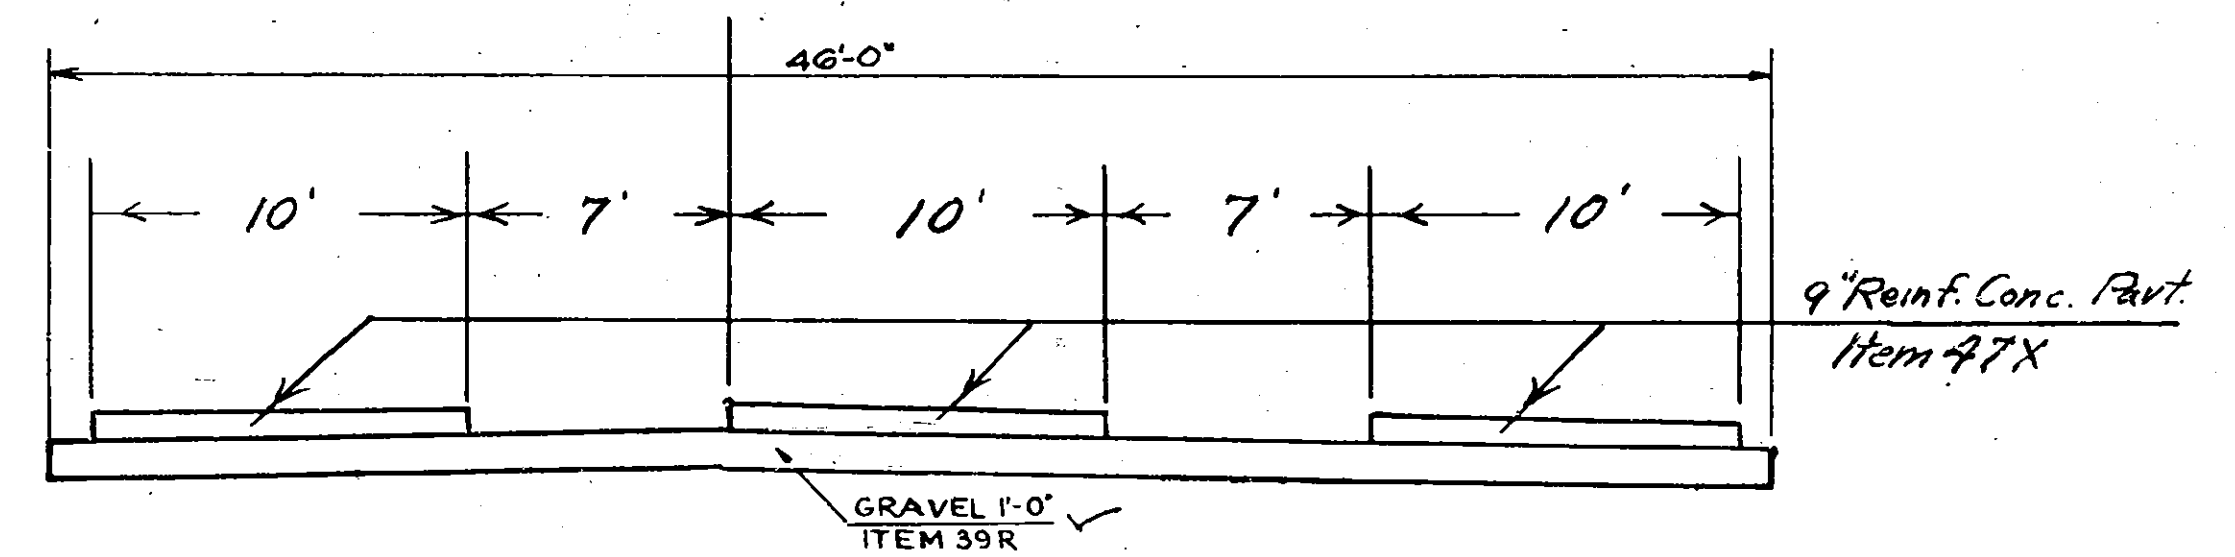


SECTION B-B
SCALE: 1" = 5'-0"

CONTROL AREA PLAN
NEW YORK STATE THRUWAY AND HOPKINS ROAD
TRAFFIC INTERCHANGE

PREPARED AND RECOMMENDED

URQUHART AND DOYLE CONSULTING ENGINEERS
NEW YORK STATE PROFESSIONAL ENGINEERS LICENSE NO 5667
DATE
Mar 9-53

COUNTY	SHEET NO	TOTAL SHEETS
ONONDAGA	10	66
N.Y. STATE THRUWAY-ONTARIO SECTION SUBDIV. 8A		
INTERCHANGE AT ELECTRONICS PARKWAY (HOPKINS ROAD)		

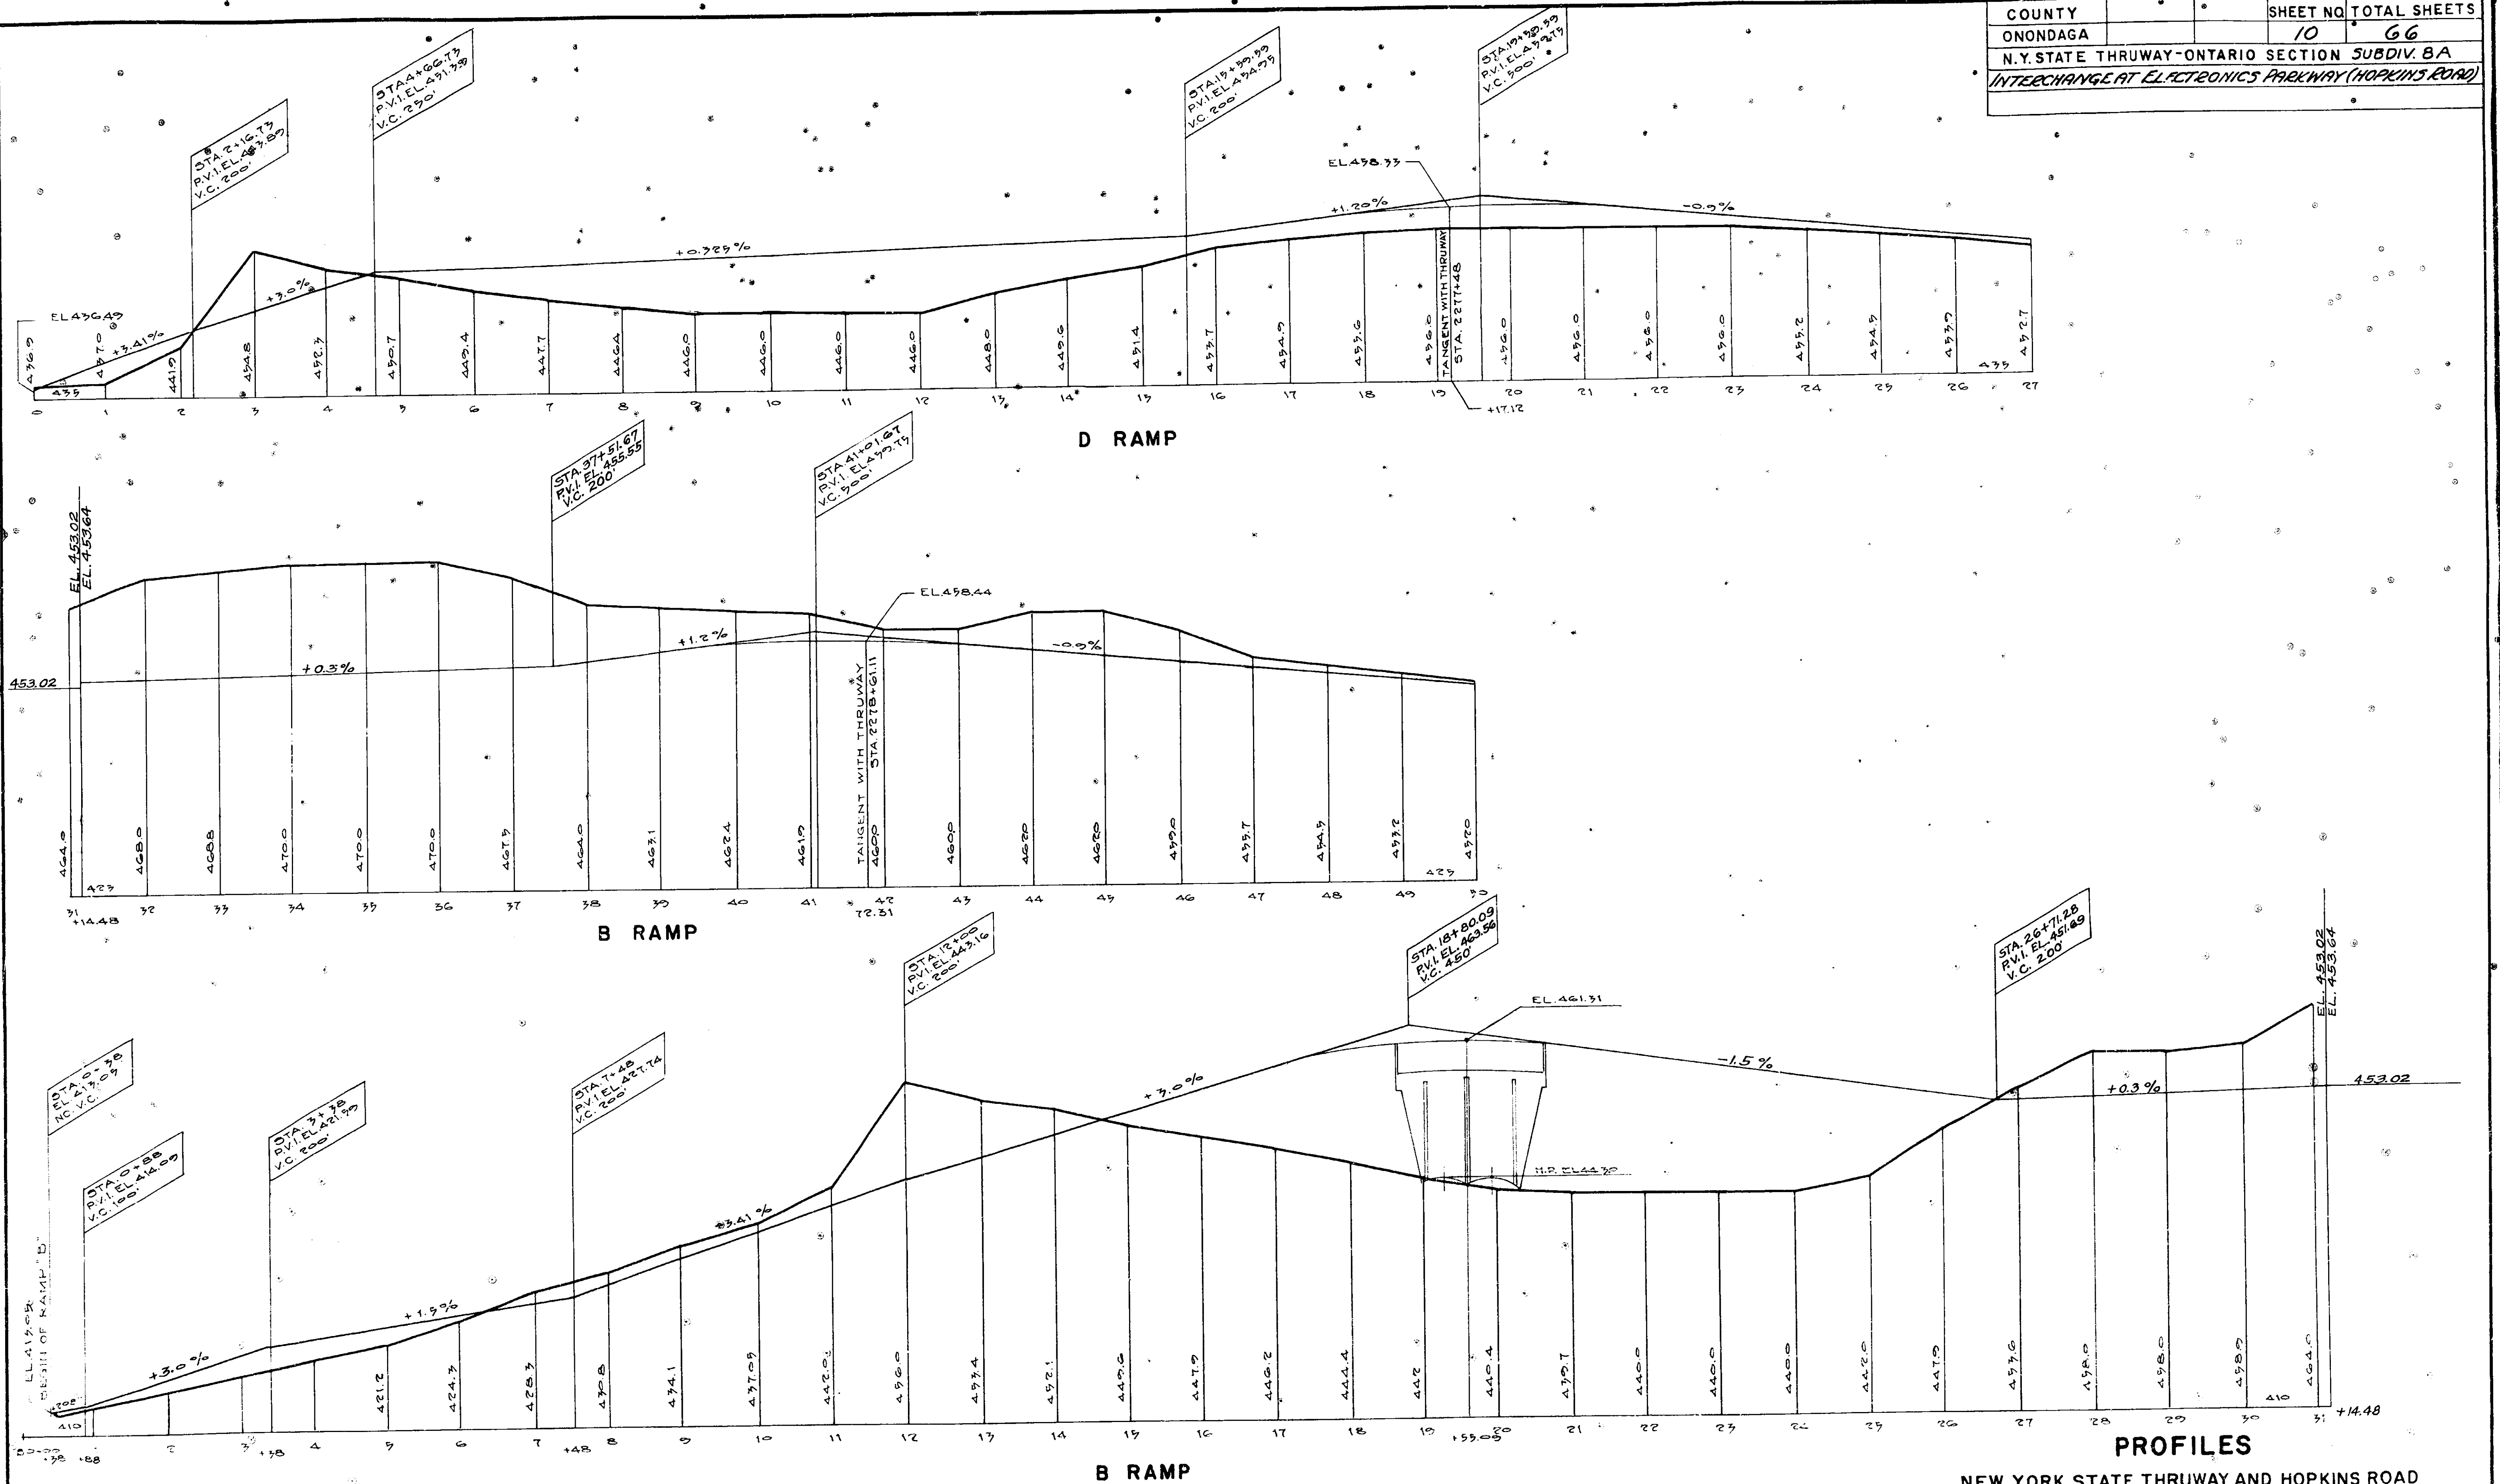




PROFILES

NEW YORK STATE THRUWAY AND HOPKINS ROAD
TRAFFIC INTERCHANGE

PREPARED AND RECOMMENDED
URQUHART AND DOYLE CONSULTING ENGINEERS
DATE Feb 16-53
NEW YORK STATE PROFESSIONAL ENGINEERS LICENSE NO. 5667

COUNTY	SHEET NO	TOTAL SHEETS
ONONDAGA	10	66
N.Y. STATE THRUWAY-ONTARIO SECTION SUBDIV. 8A		
INTERCHANGE AT ELECTRONICS PARKWAY (HOPKINS ROAD)		

10R

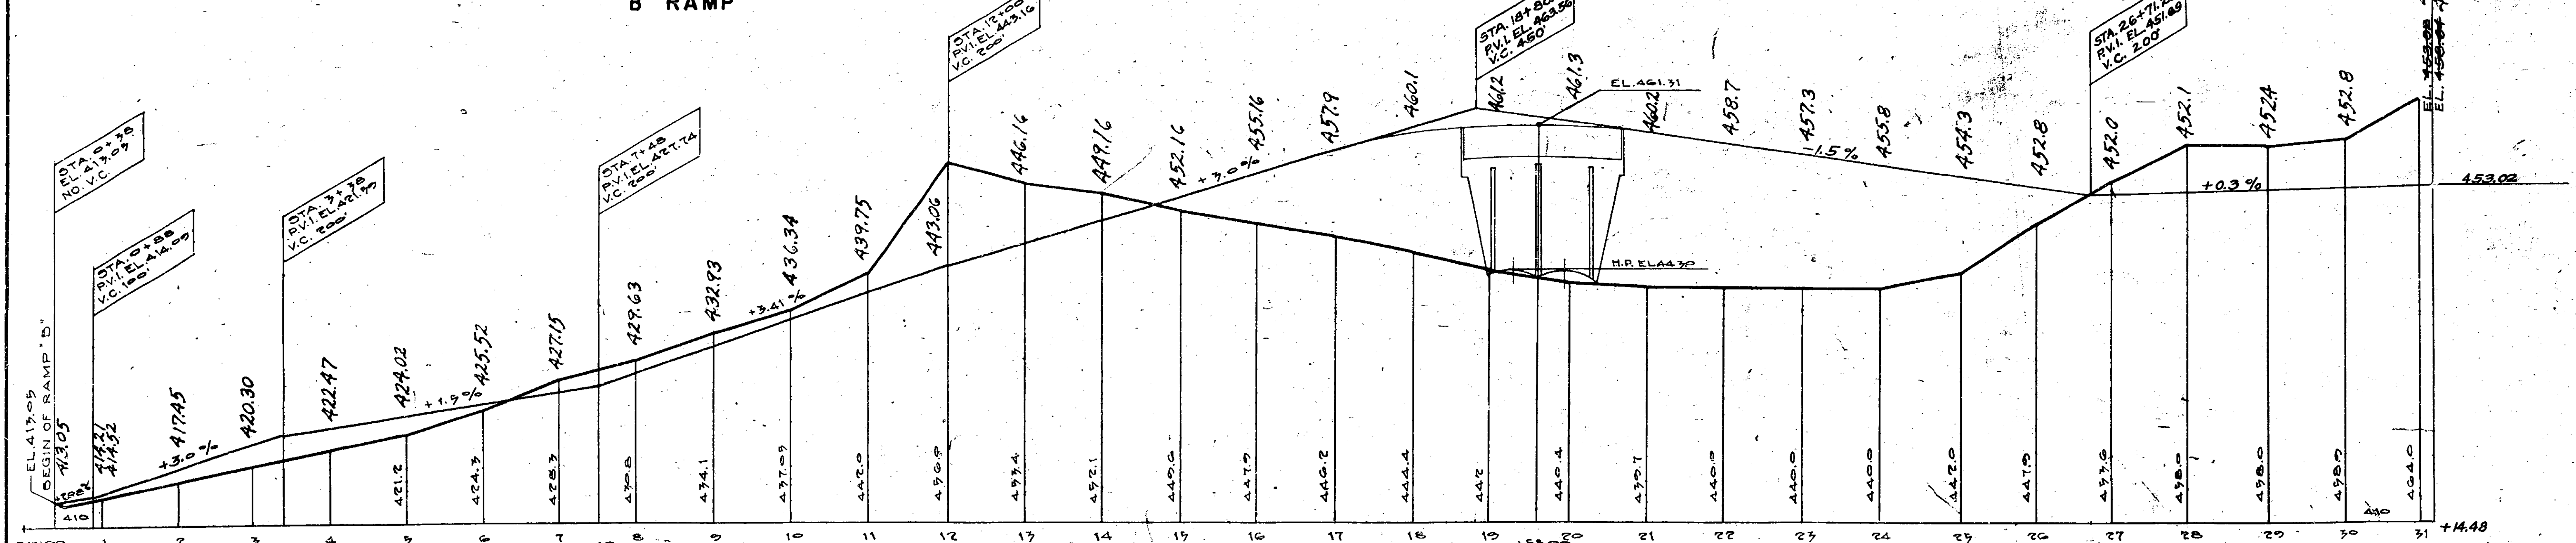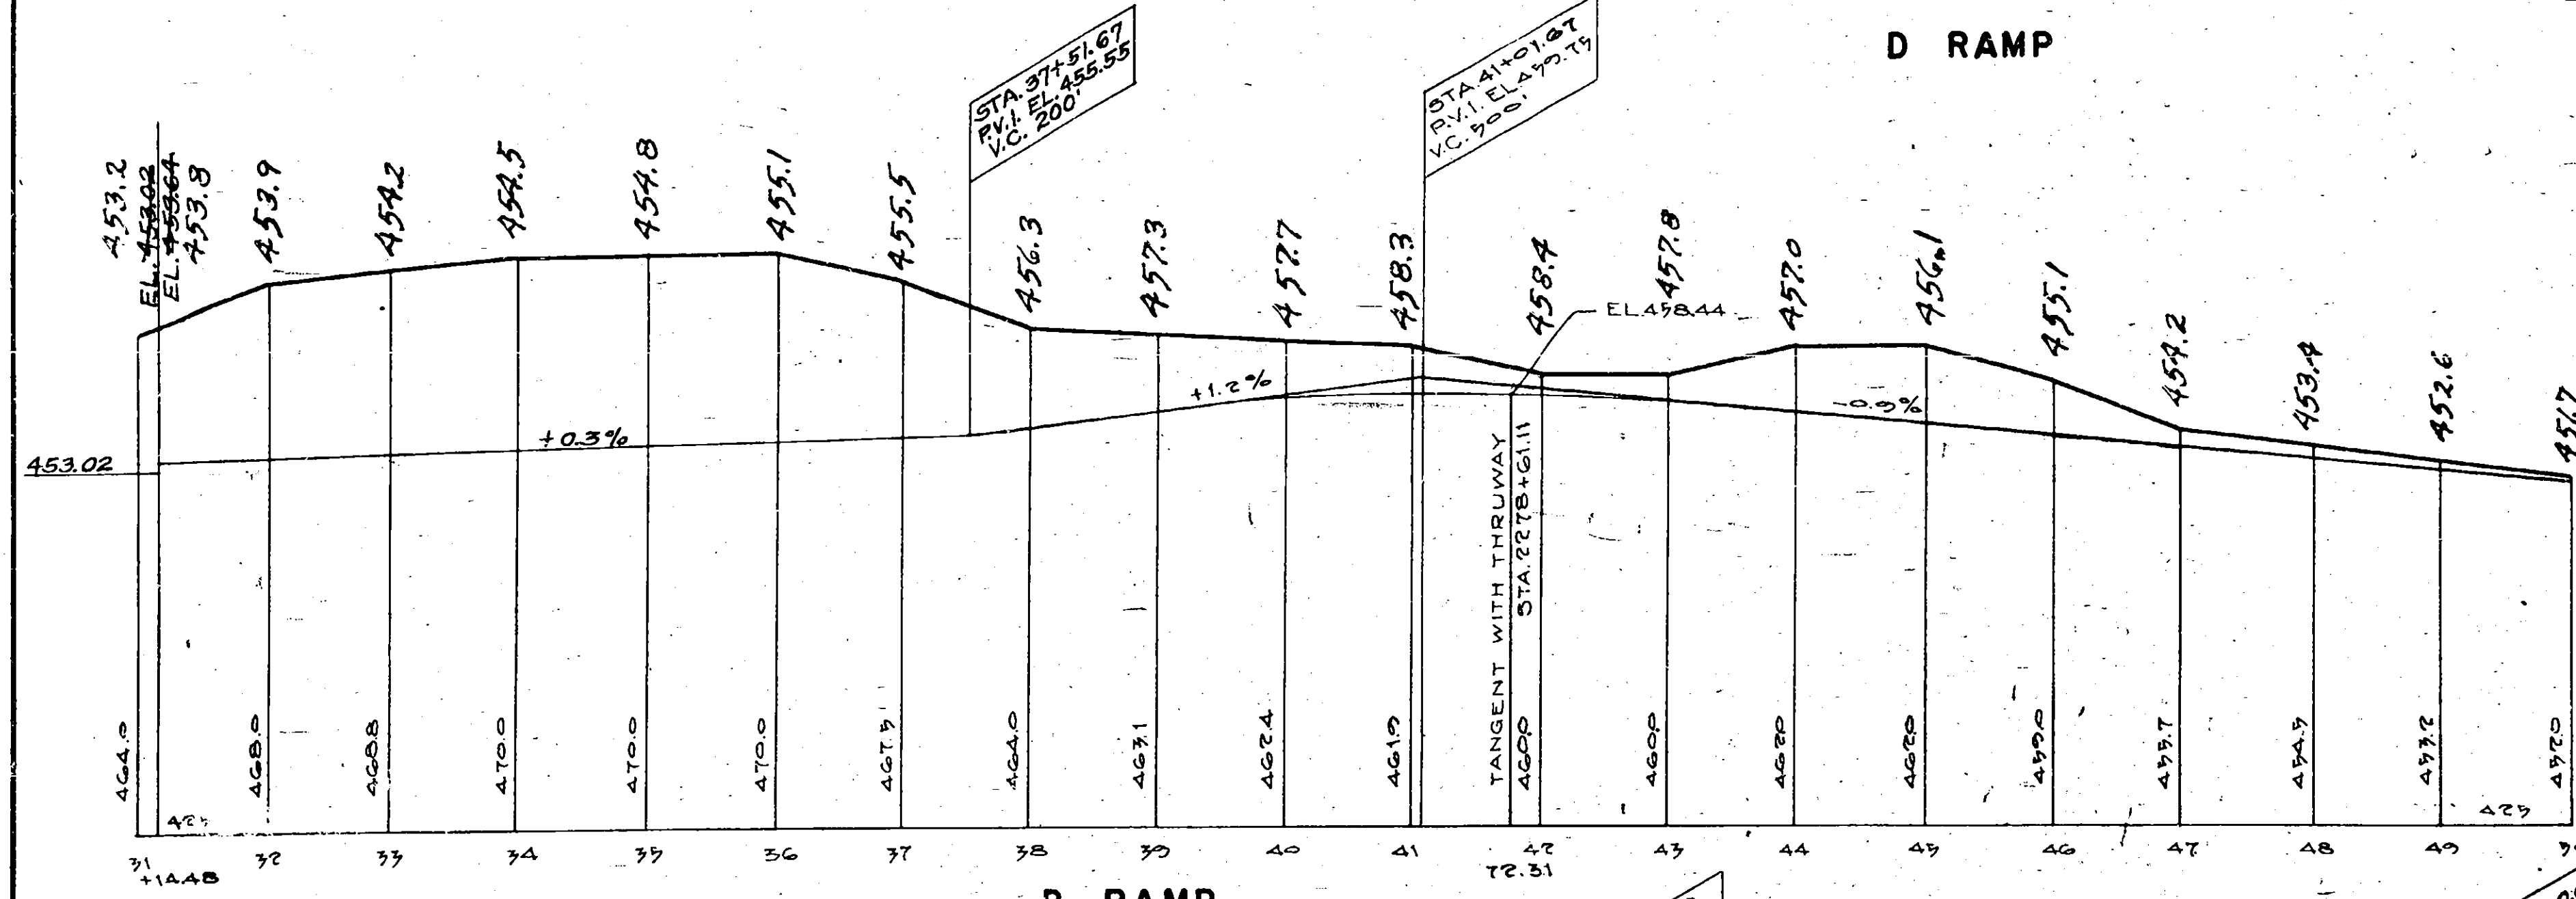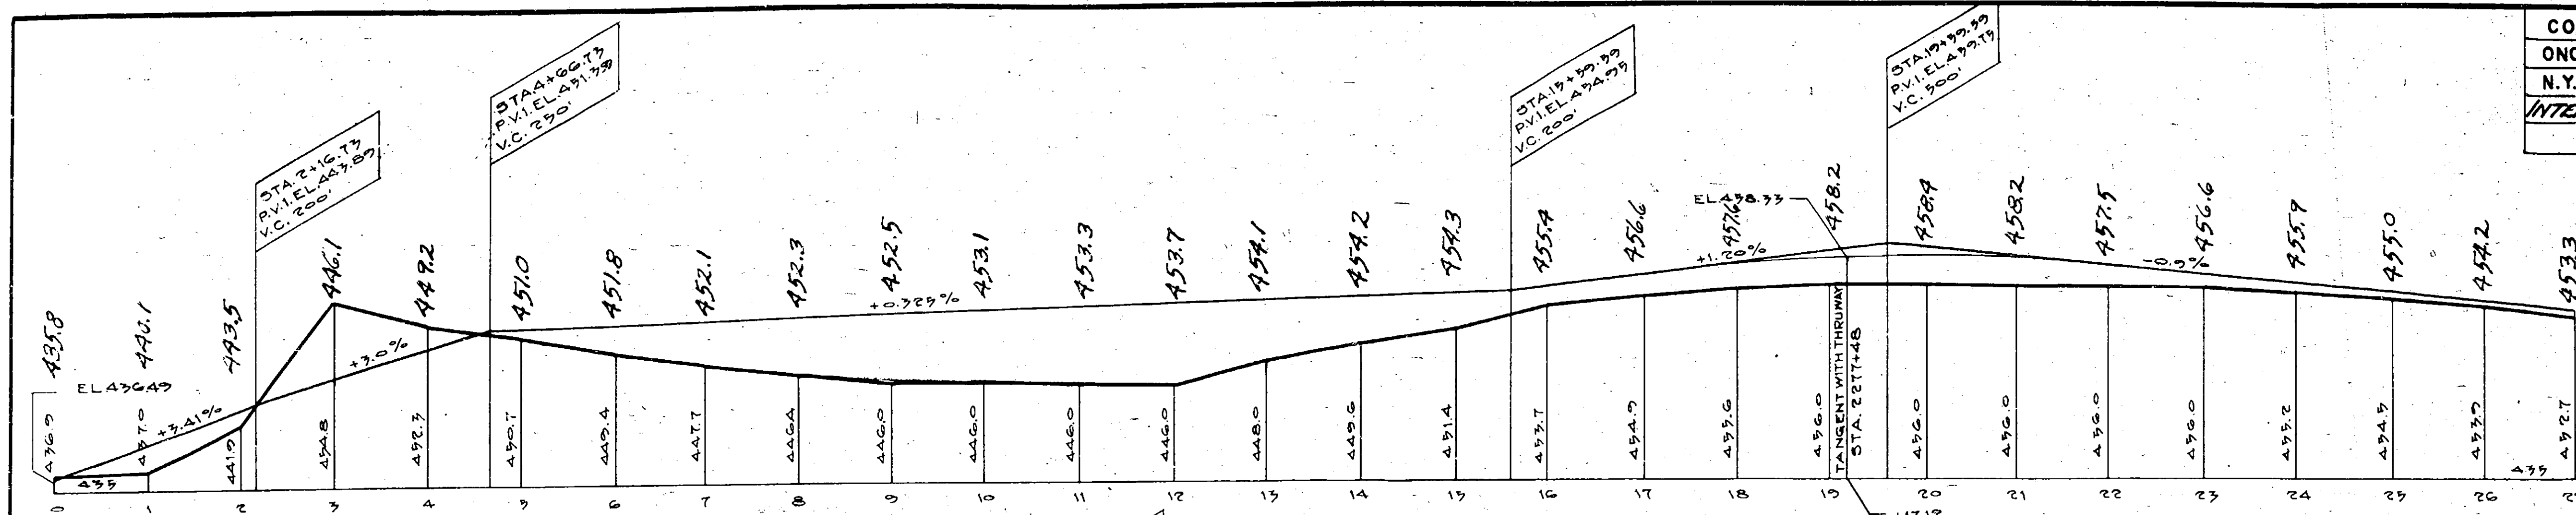


PROFILES


NEW YORK STATE THRUWAY AND HOPKINS ROAD
TRAFFIC INTERCHANGE

PREPARED AND RECOMMENDED
URQUHART AND DOYLE CONSULTING ENGINEERS
NEW YORK STATE PROFESSIONAL ENGINEERS LICENSE NO. 5667
DATE
FEB 16-63

COUNTY	SHEET NO.	TOTAL SHEETS
ONONDAGA	11	66
N.Y. STATE THRUWAY ONTARIO SECTION, SUB DIV. B 19		
INTERCHANGE AT ELECTRONICS PARKWAY (HOPKINS ROAD)		

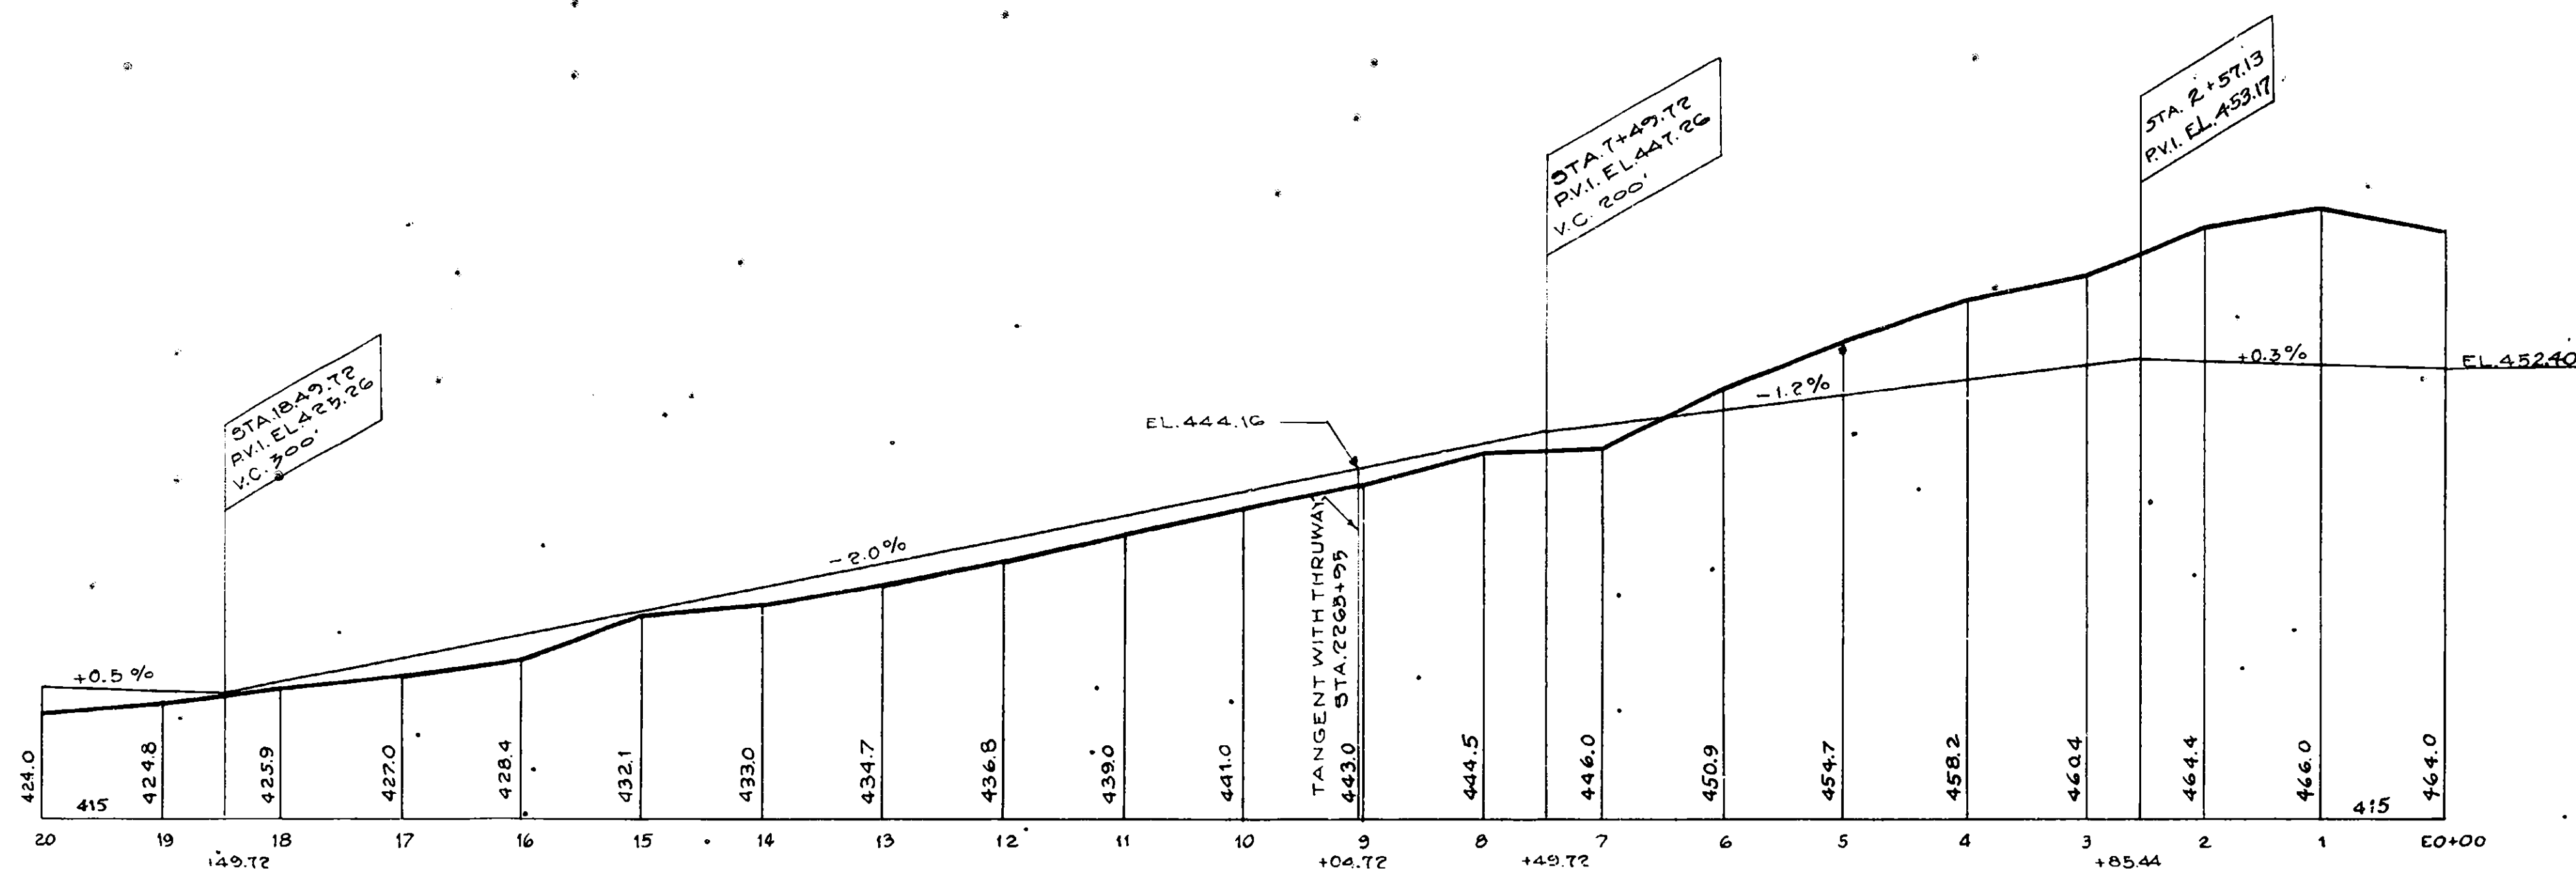

E-RAMP

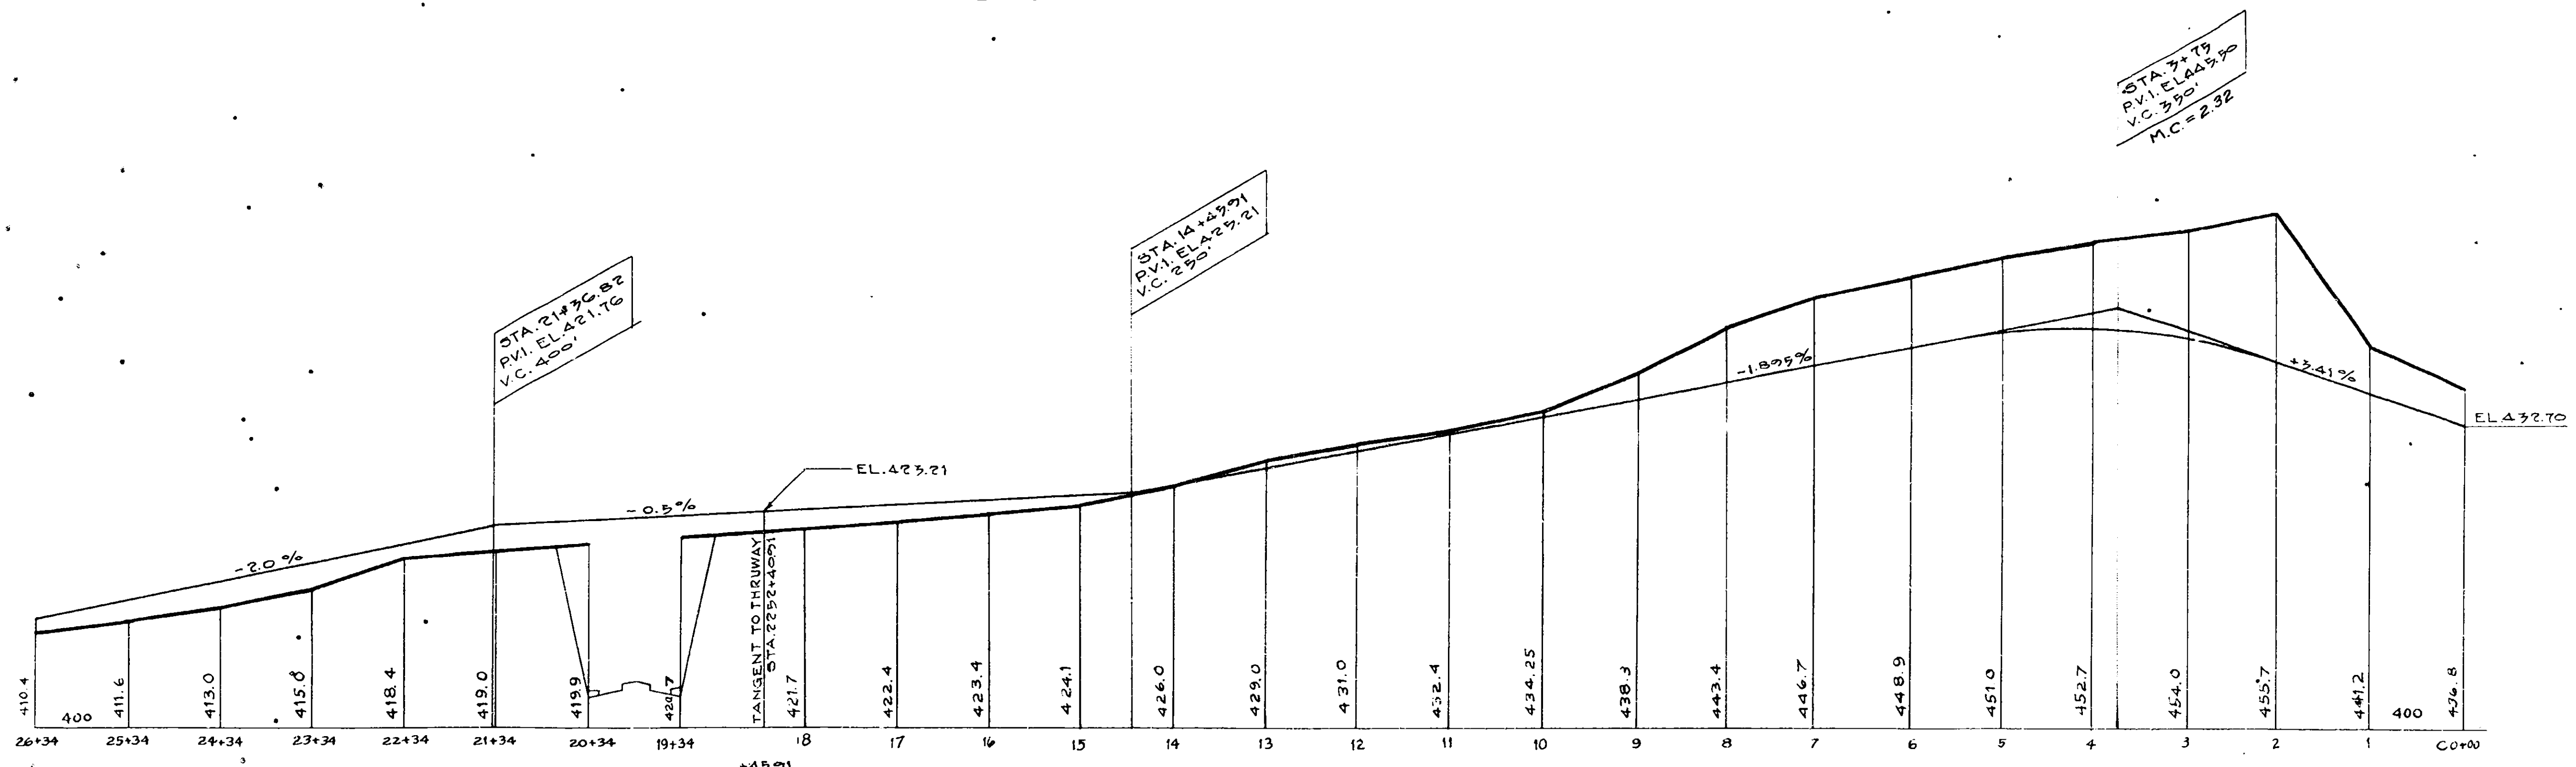



C-RAMP

PROFILES
NEW YORK STATE THRUWAY AND HOPKINS ROAD
TRAFFIC INTERCHANGE

PREPARED AND RECOMMENDED
URQUHART & DOYLE, CONSULTING ENGINEERS
NEW YORK STATE PROFESSIONAL ENGINEERS LICENSE NO. 5667
DATE Feb 16-58

COUNTY	SHEET NO.	TOTAL SHEETS
ONONDAGA	11	66
N.Y. STATE THRUWAY ONTARIO SECTION, SUB DIV. B/A		
INTERCHANGE AT ELECTRONICS PARKWAY (HOPKINS ROAD)		

11R

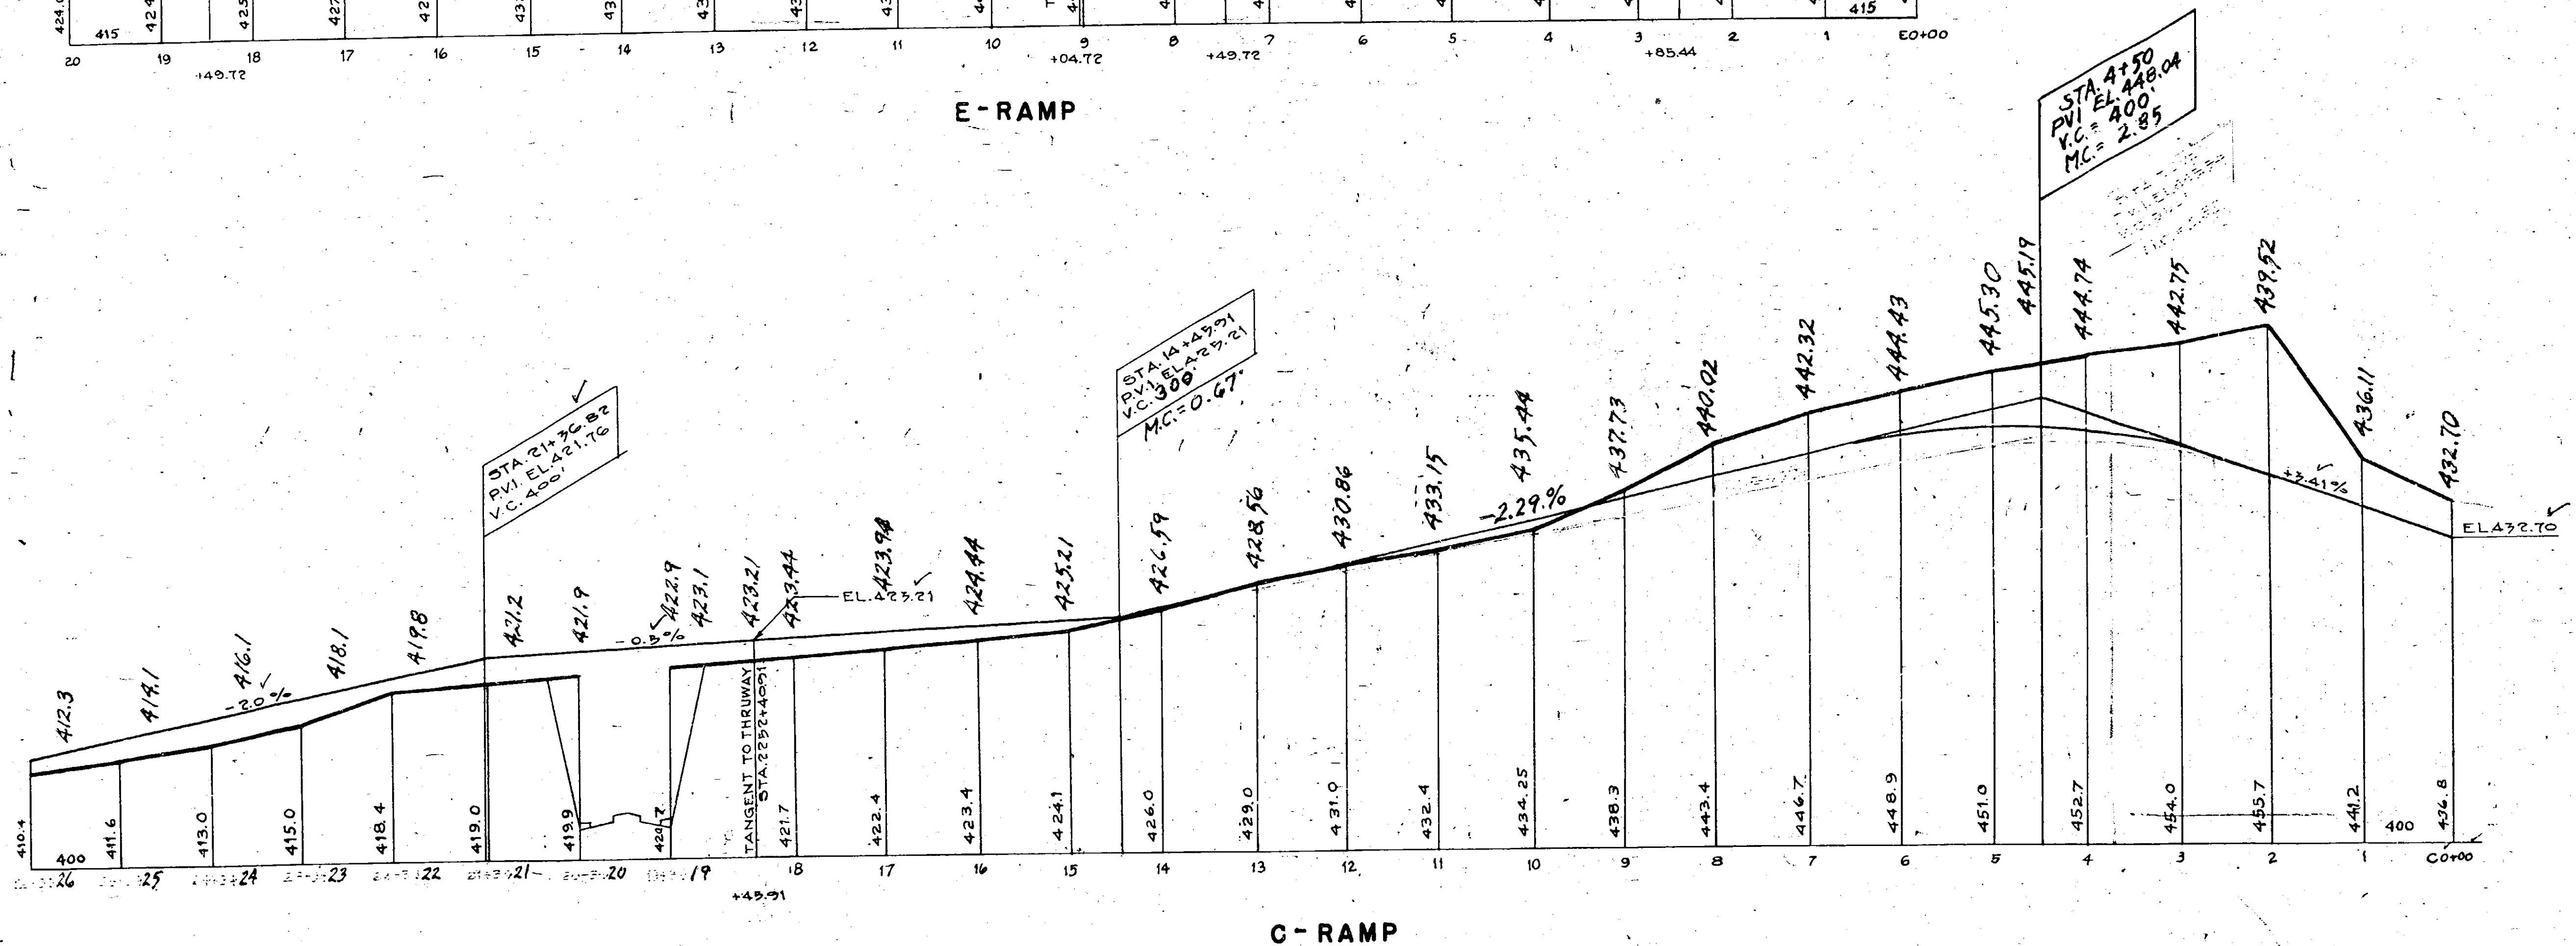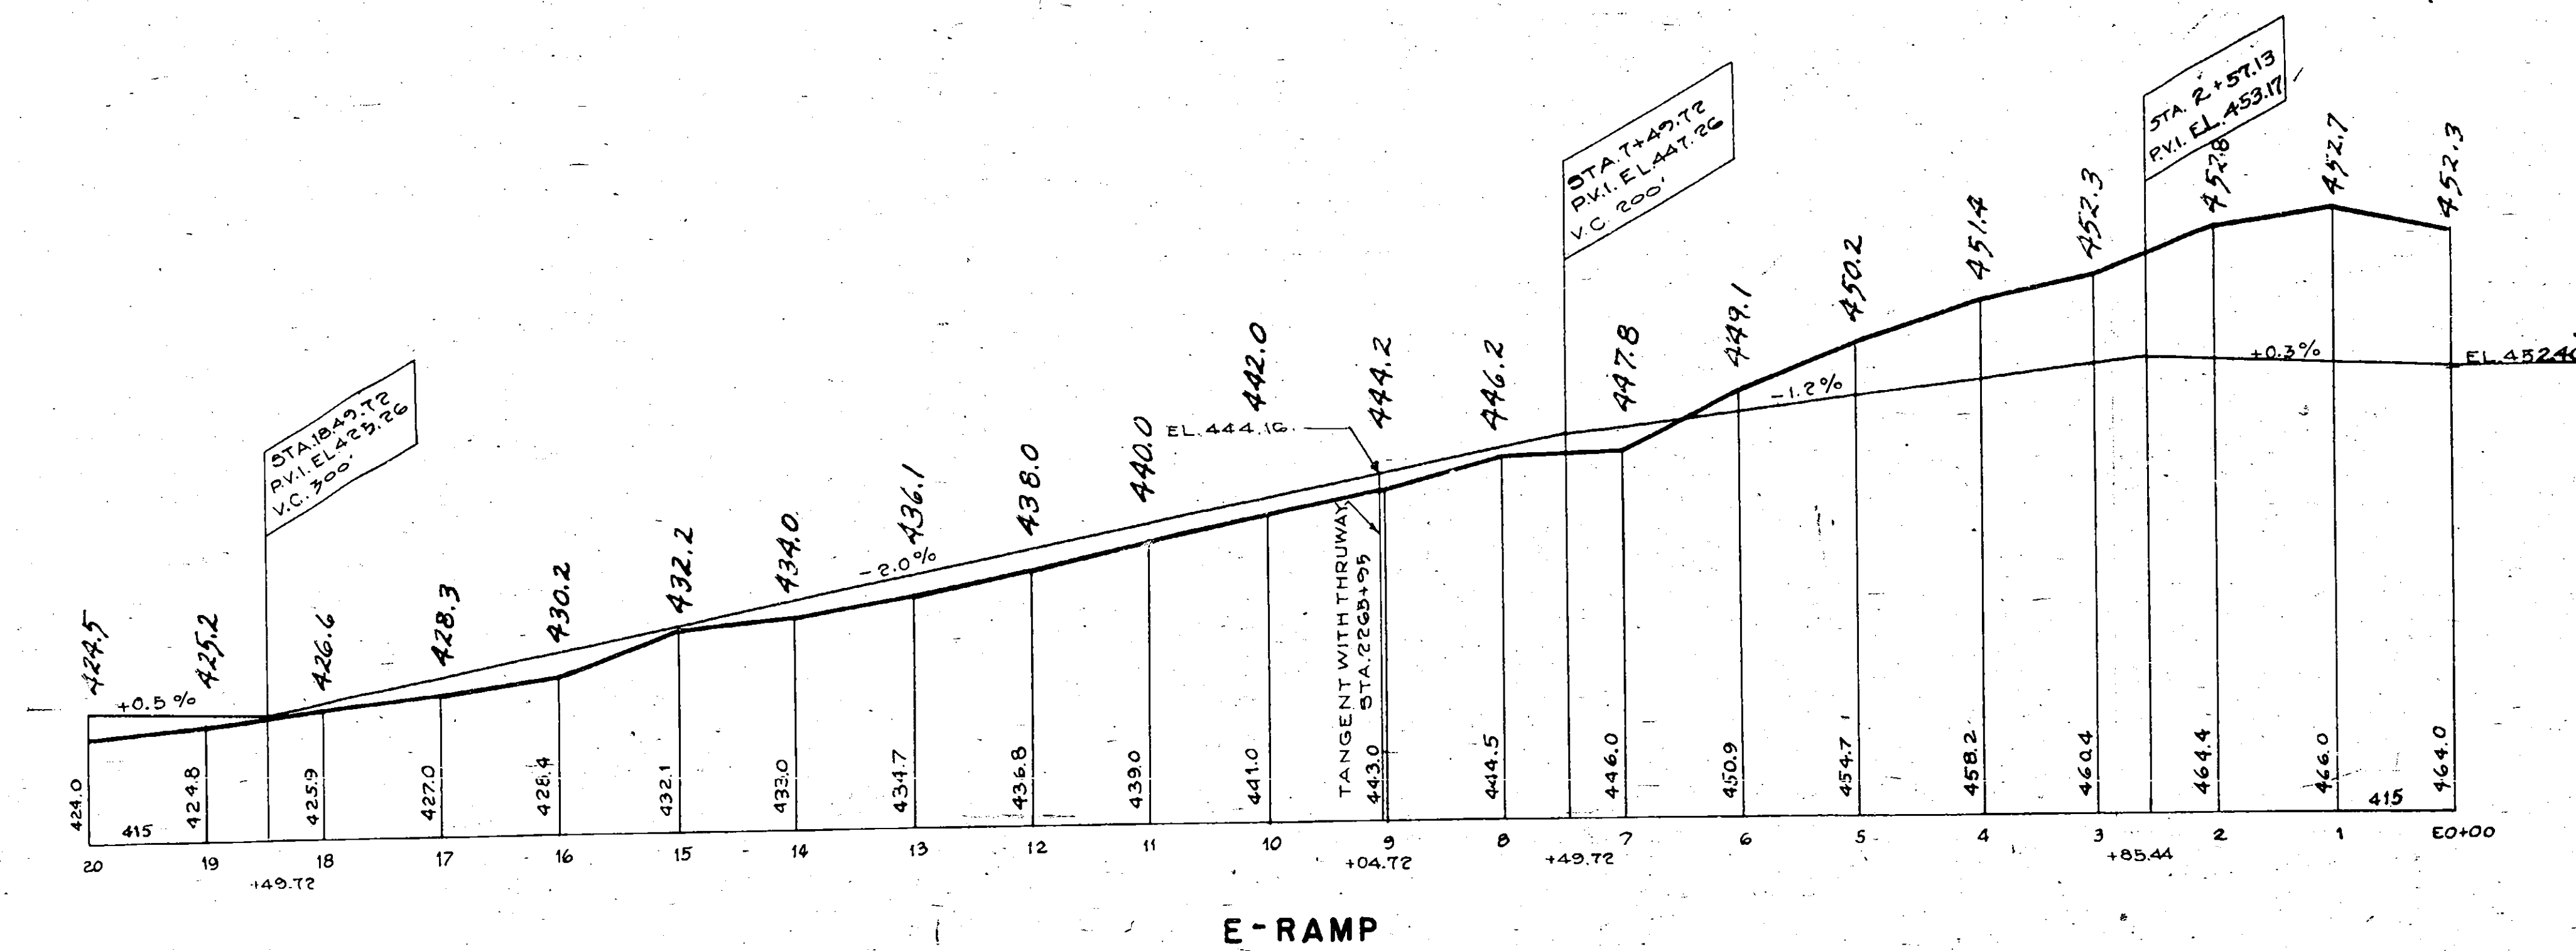

Grade Raised Above Water Table

PROFILES

NEW YORK STATE THRUWAY AND HOPKINS ROAD
TRAFFIC INTERCHANGE





PREPARED AND RECOMMENDED

URQUHART & DOYLE, CONSULTING ENGINEERS
NEW YORK STATE PROFESSIONAL ENGINEERS LICENSE NO. 5667


DATE

SHEET 5 OF 22

COUNTY	SHEET NO.	TOTAL SHEETS
ONONDAGA	12	66
N.Y. STATE THRUWAY ONTARIO SECTION SUBDIV 8A		
INTERCHANGE AT ELECTRONICS PARKWAY, (HOPKINS ROAD)		

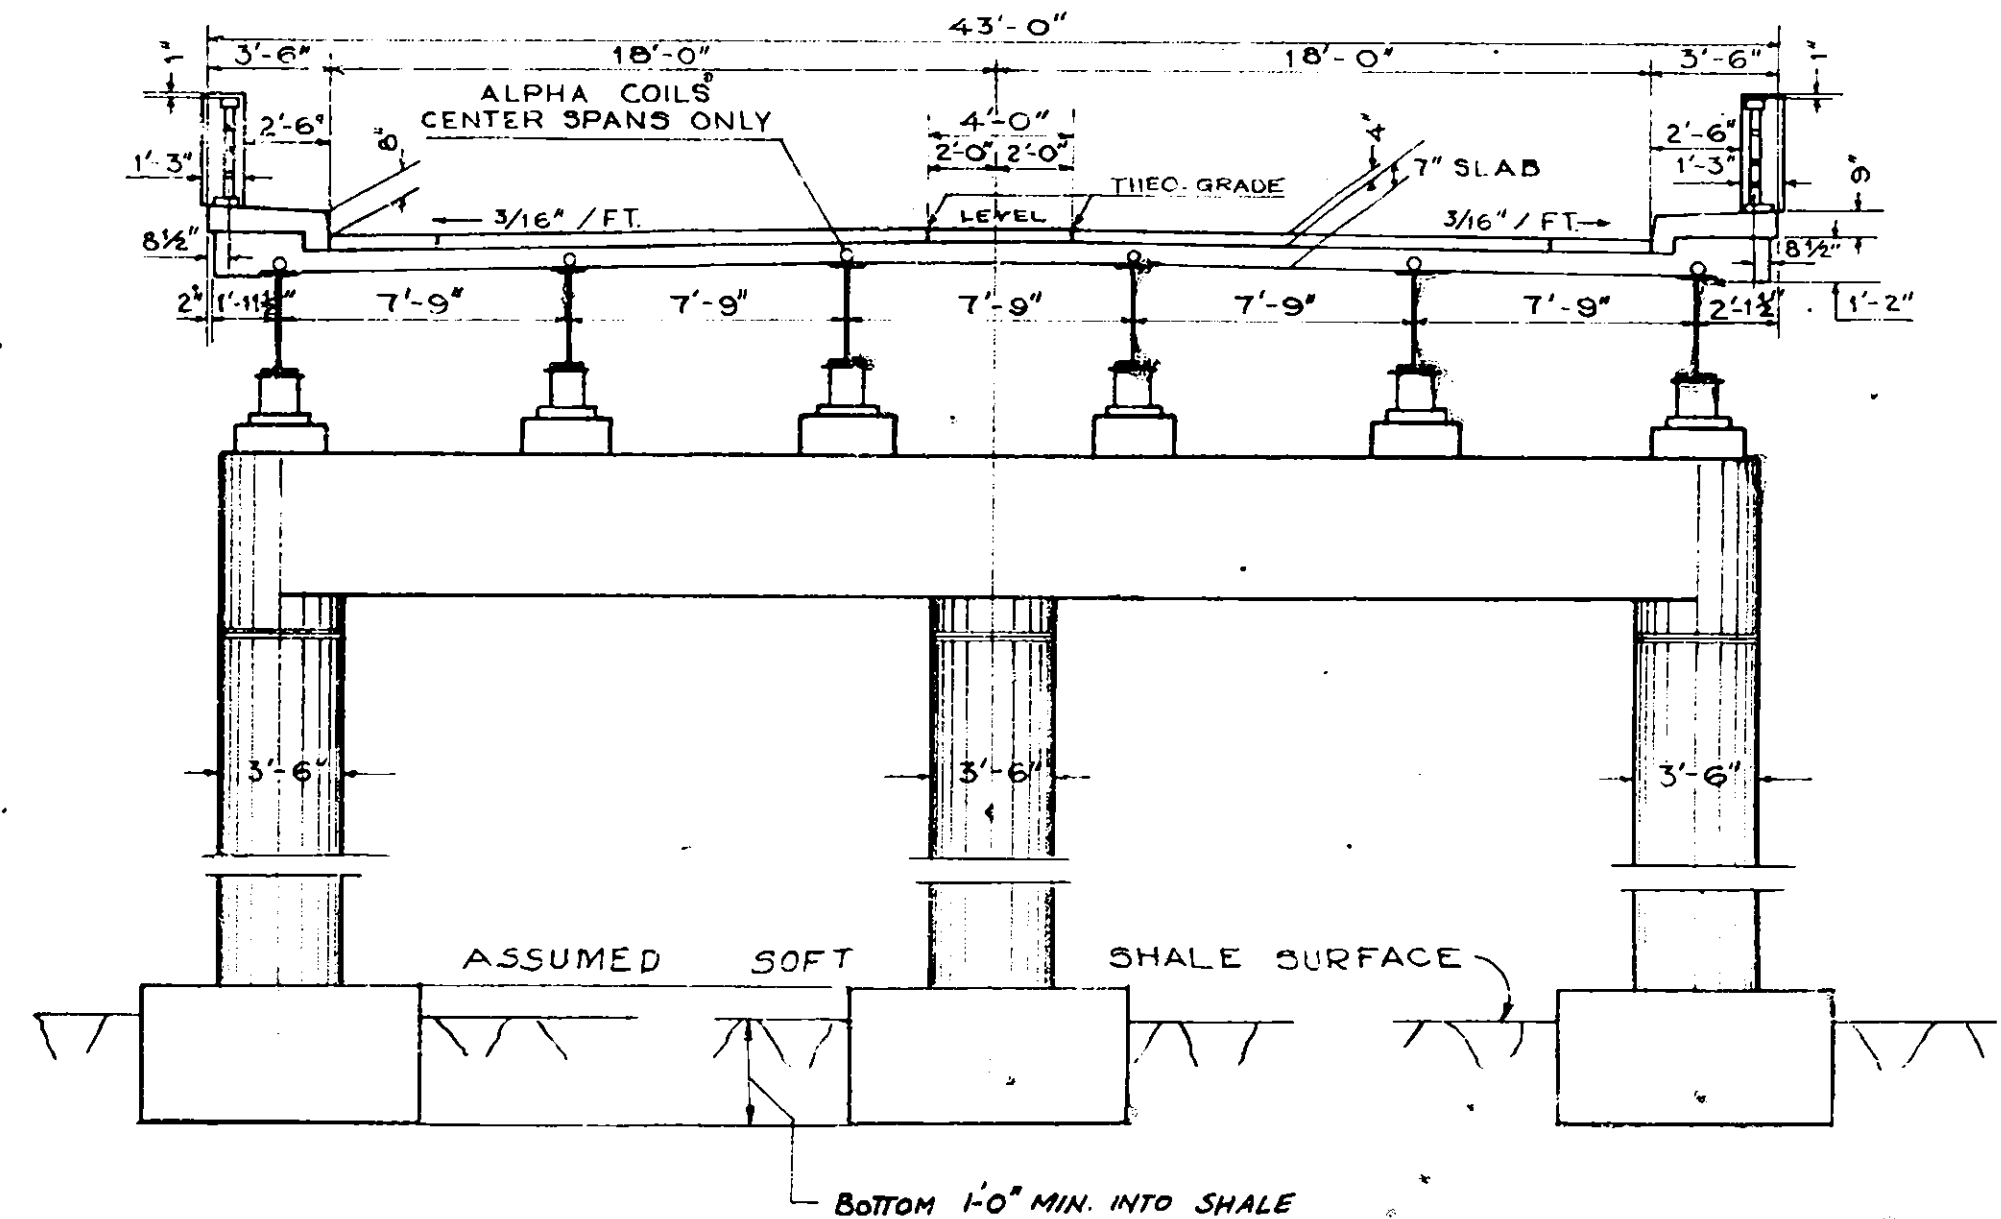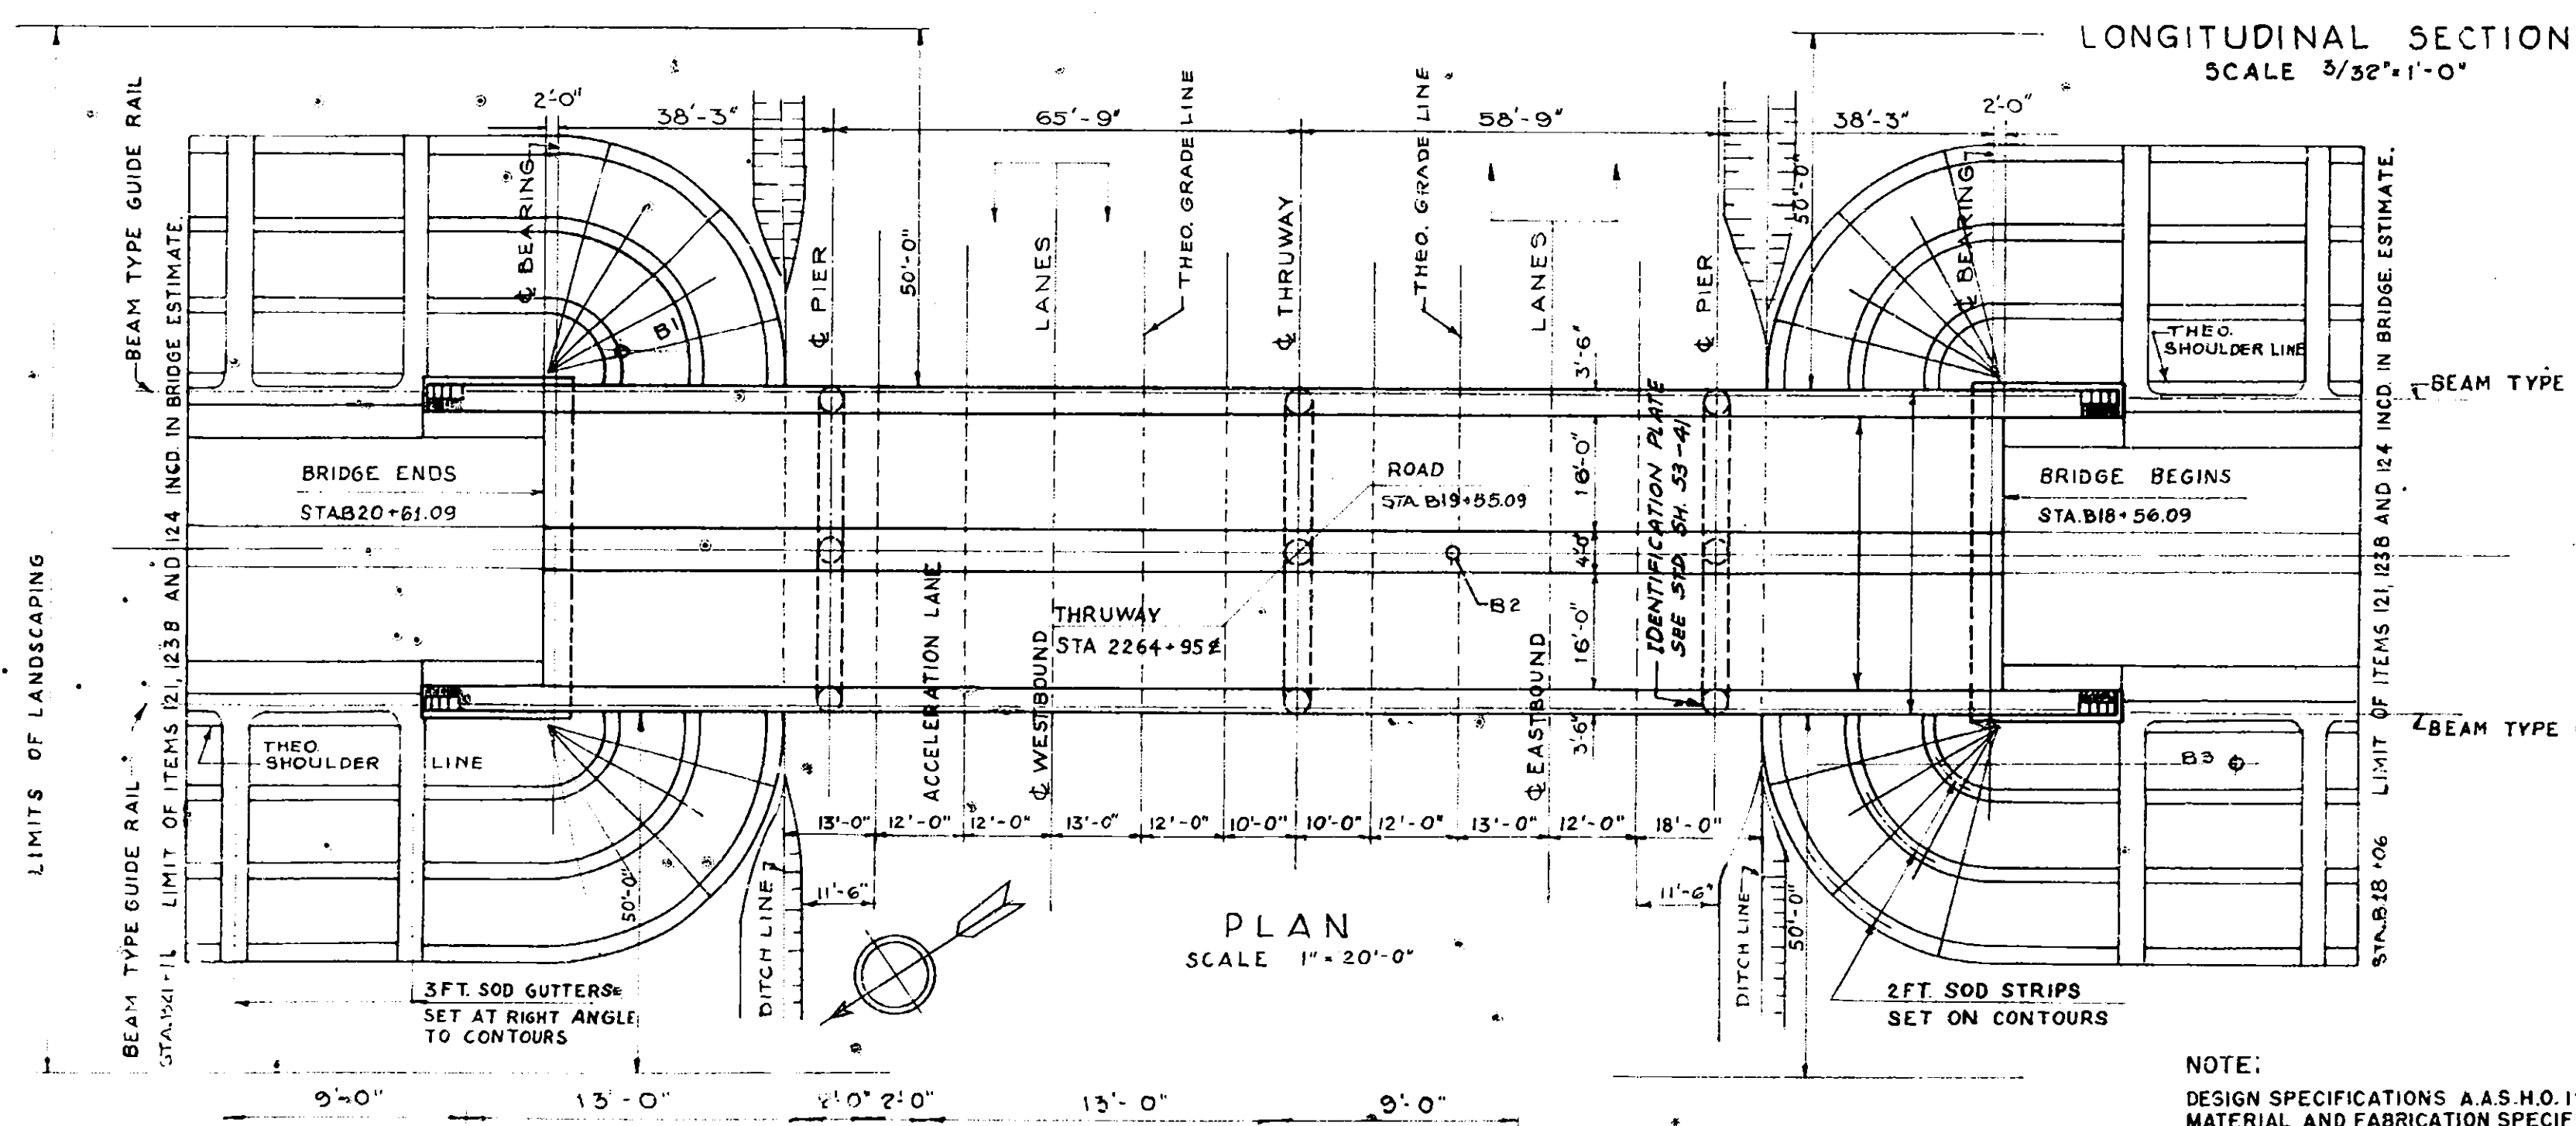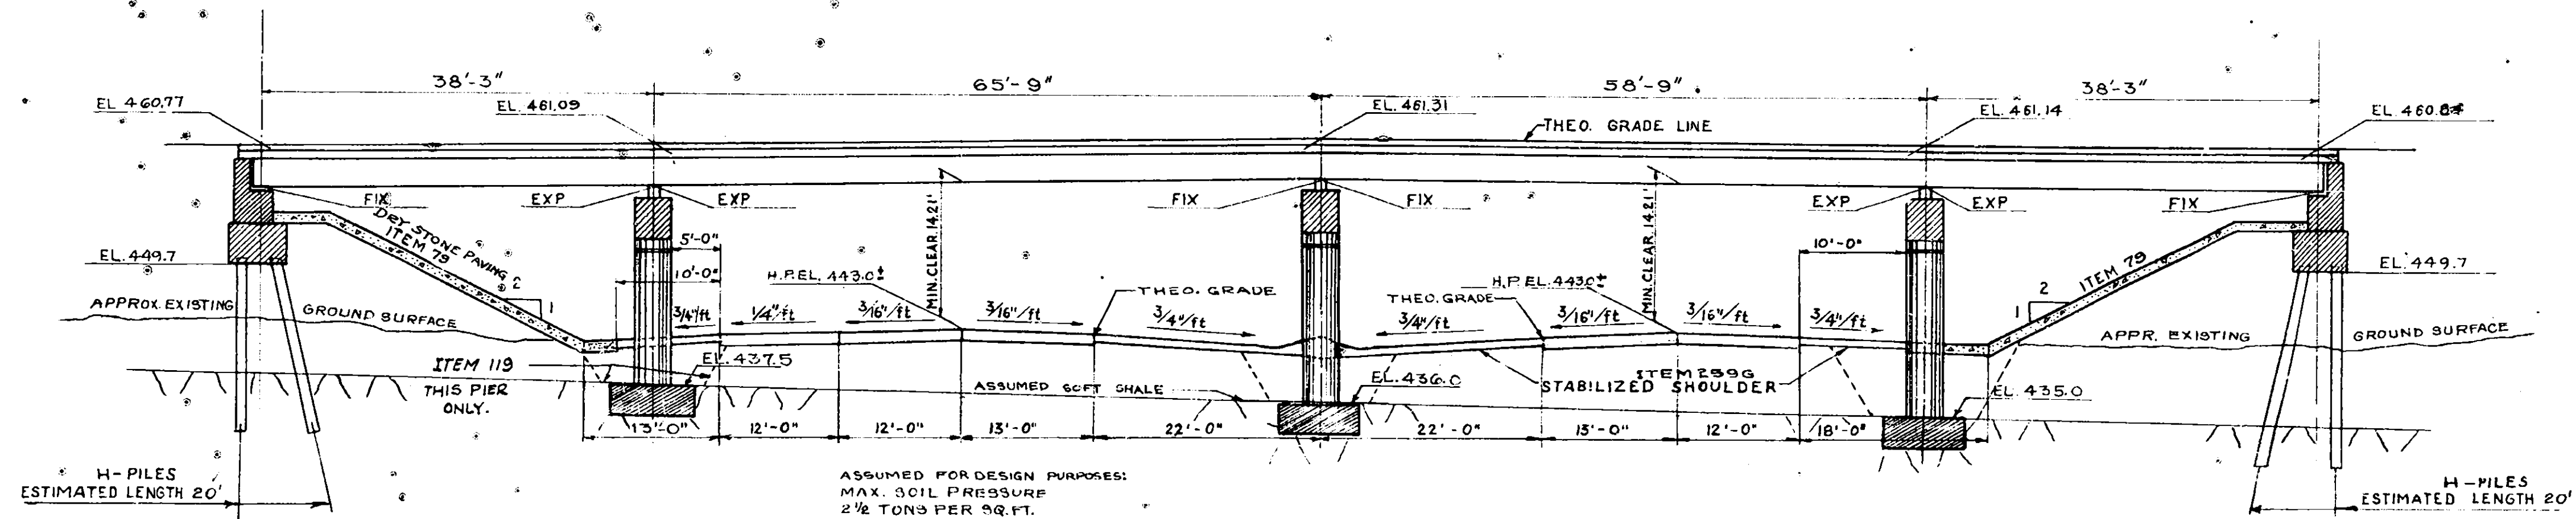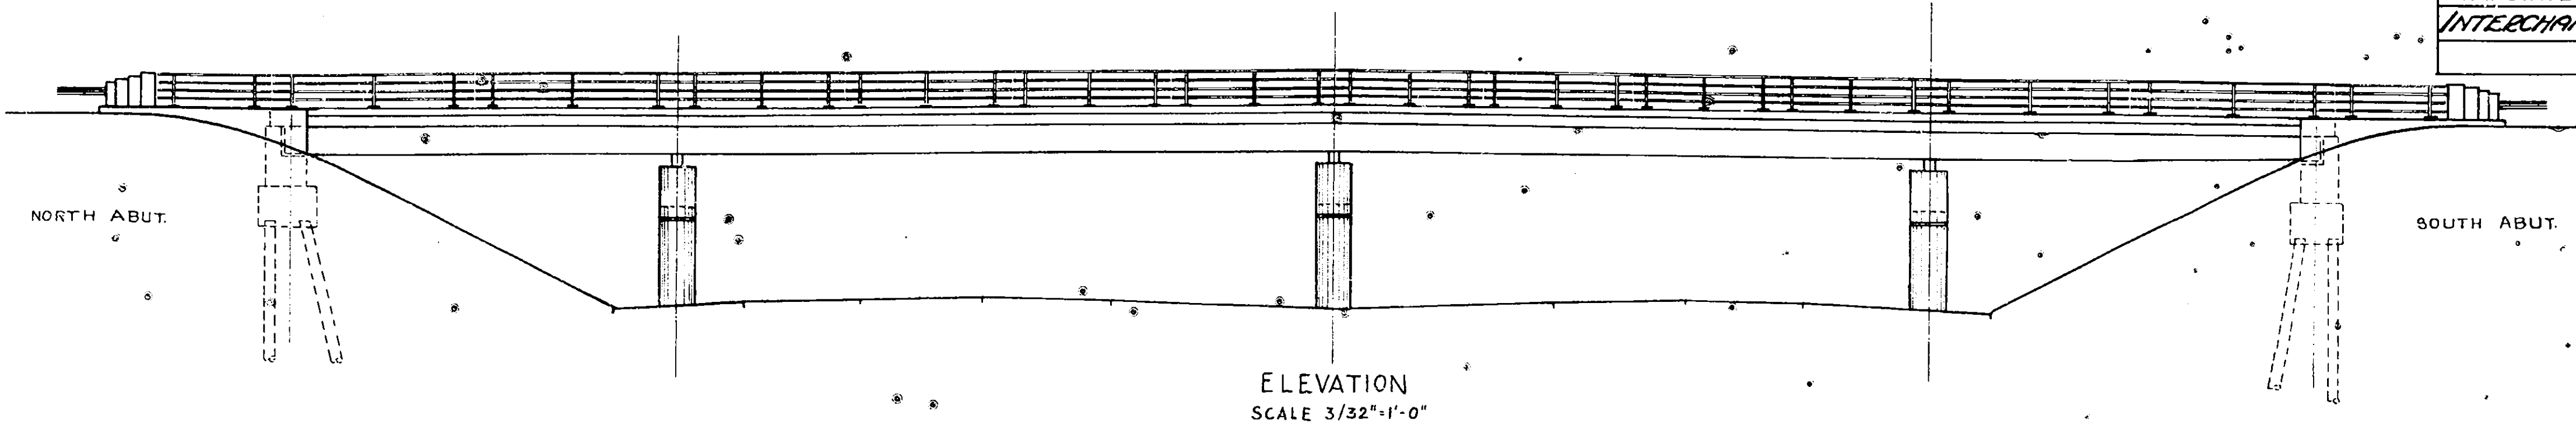

NOTE:
DESIGN SPECIFICATIONS A.A.S.H.O. 1949-H20-S16 LOADING MODIFIED
MATERIAL AND FABRICATION SPECIFICATIONS N.Y.S.D.P.W. JAN. 2, 1951
SUPERSTRUCTURE W/ BEAMS, COMPOSITE CONSTRUCTION CENTER
SPANS ONLY.
FOUNDATION TREATMENT OF ABUTMENTS ON PILES: FOR DESIGN
PURPOSES, THE ASSUMED LOAD PER PILE DOES NOT EXCEED 35 TONS.
PIER CONCRETE BENTS ON SPREAD FOOTINGS: FOR DESIGN PURPOSES,
THE ASSUMED FOUNDATION PRESSURE UNDER PIERS DOES NOT EXCEED
272 TONS PER SQ. FT. MAX.

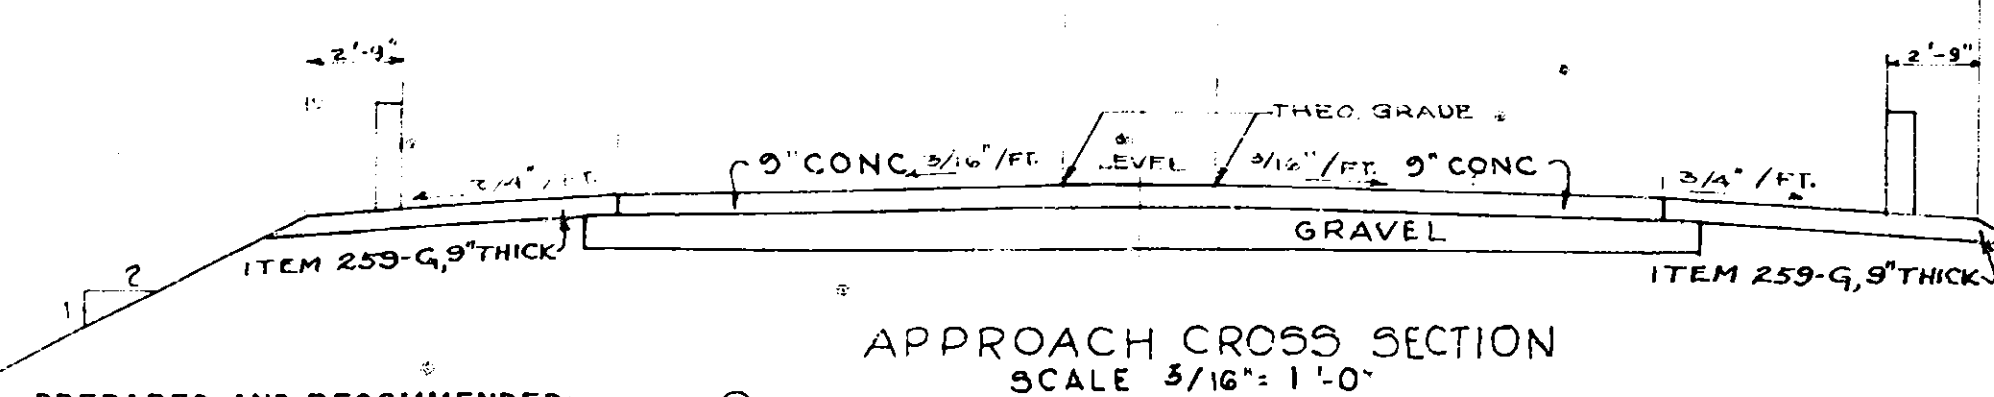

PREPARED AND RECOMMENDED:







URQUHART & DOYLE, CONSULTING ENGINEERS
NEW YORK STATE PROFESSIONAL ENGINEERS LICENSE NO. 5667
DATE

PRELIMINARY LAYOUT
NEW YORK STATE THRUWAY AND HOPKINS ROAD
TRAFFIC INTERCHANGE

SHEET 60FT

COUNTY	SHEET NO.	TOTAL SHEETS
ONONDAGA	13	66
N.Y. STATE THRUWAY-ONTARIO SECTION SUBDIV. 8A.		
INTERCHANGE AT ELECTRONICS PARKWAY, (HOPKINS ROAD)		

NOTE:
PLACING OF PILES AND CONSTRUCTION OF THE ABUTMENTS WILL NOT BE PERMITTED UNTIL THE HIGHWAY EMBANKMENT ADJACENT TO THE STRUCTURE HAS BEEN PLACED AND CONSOLIDATED IN A MANNER AND FOR A PERIOD OF TIME SATISFACTORY TO THE DEPUTY CHIEF ENGINEER (BRIDGES)

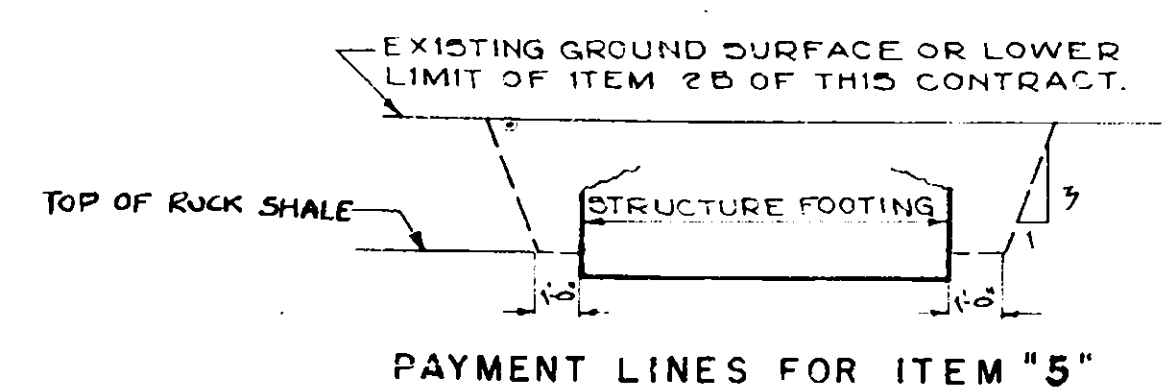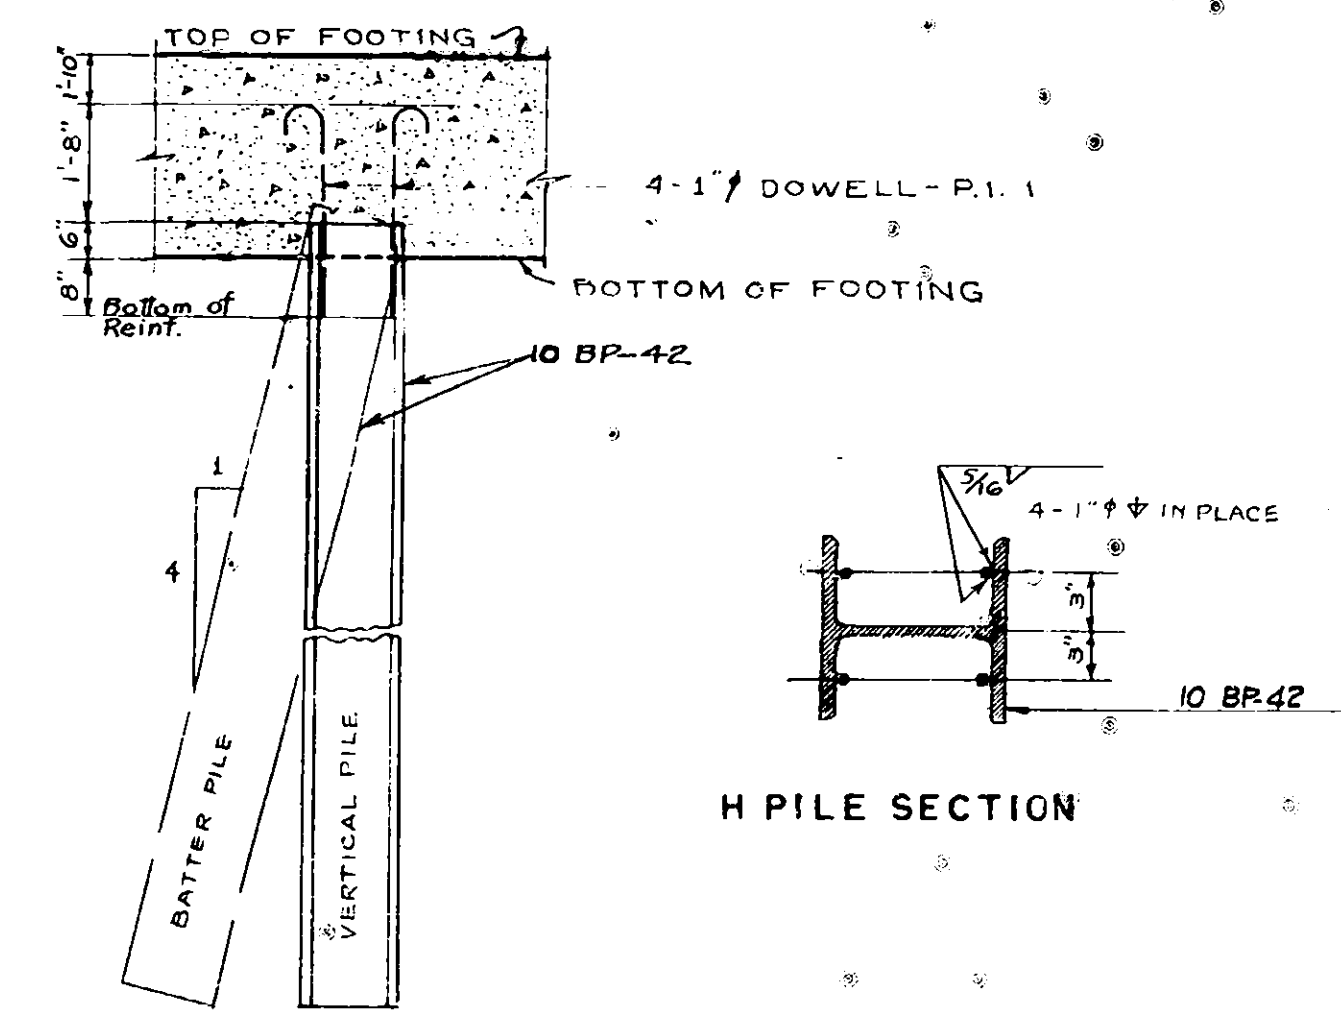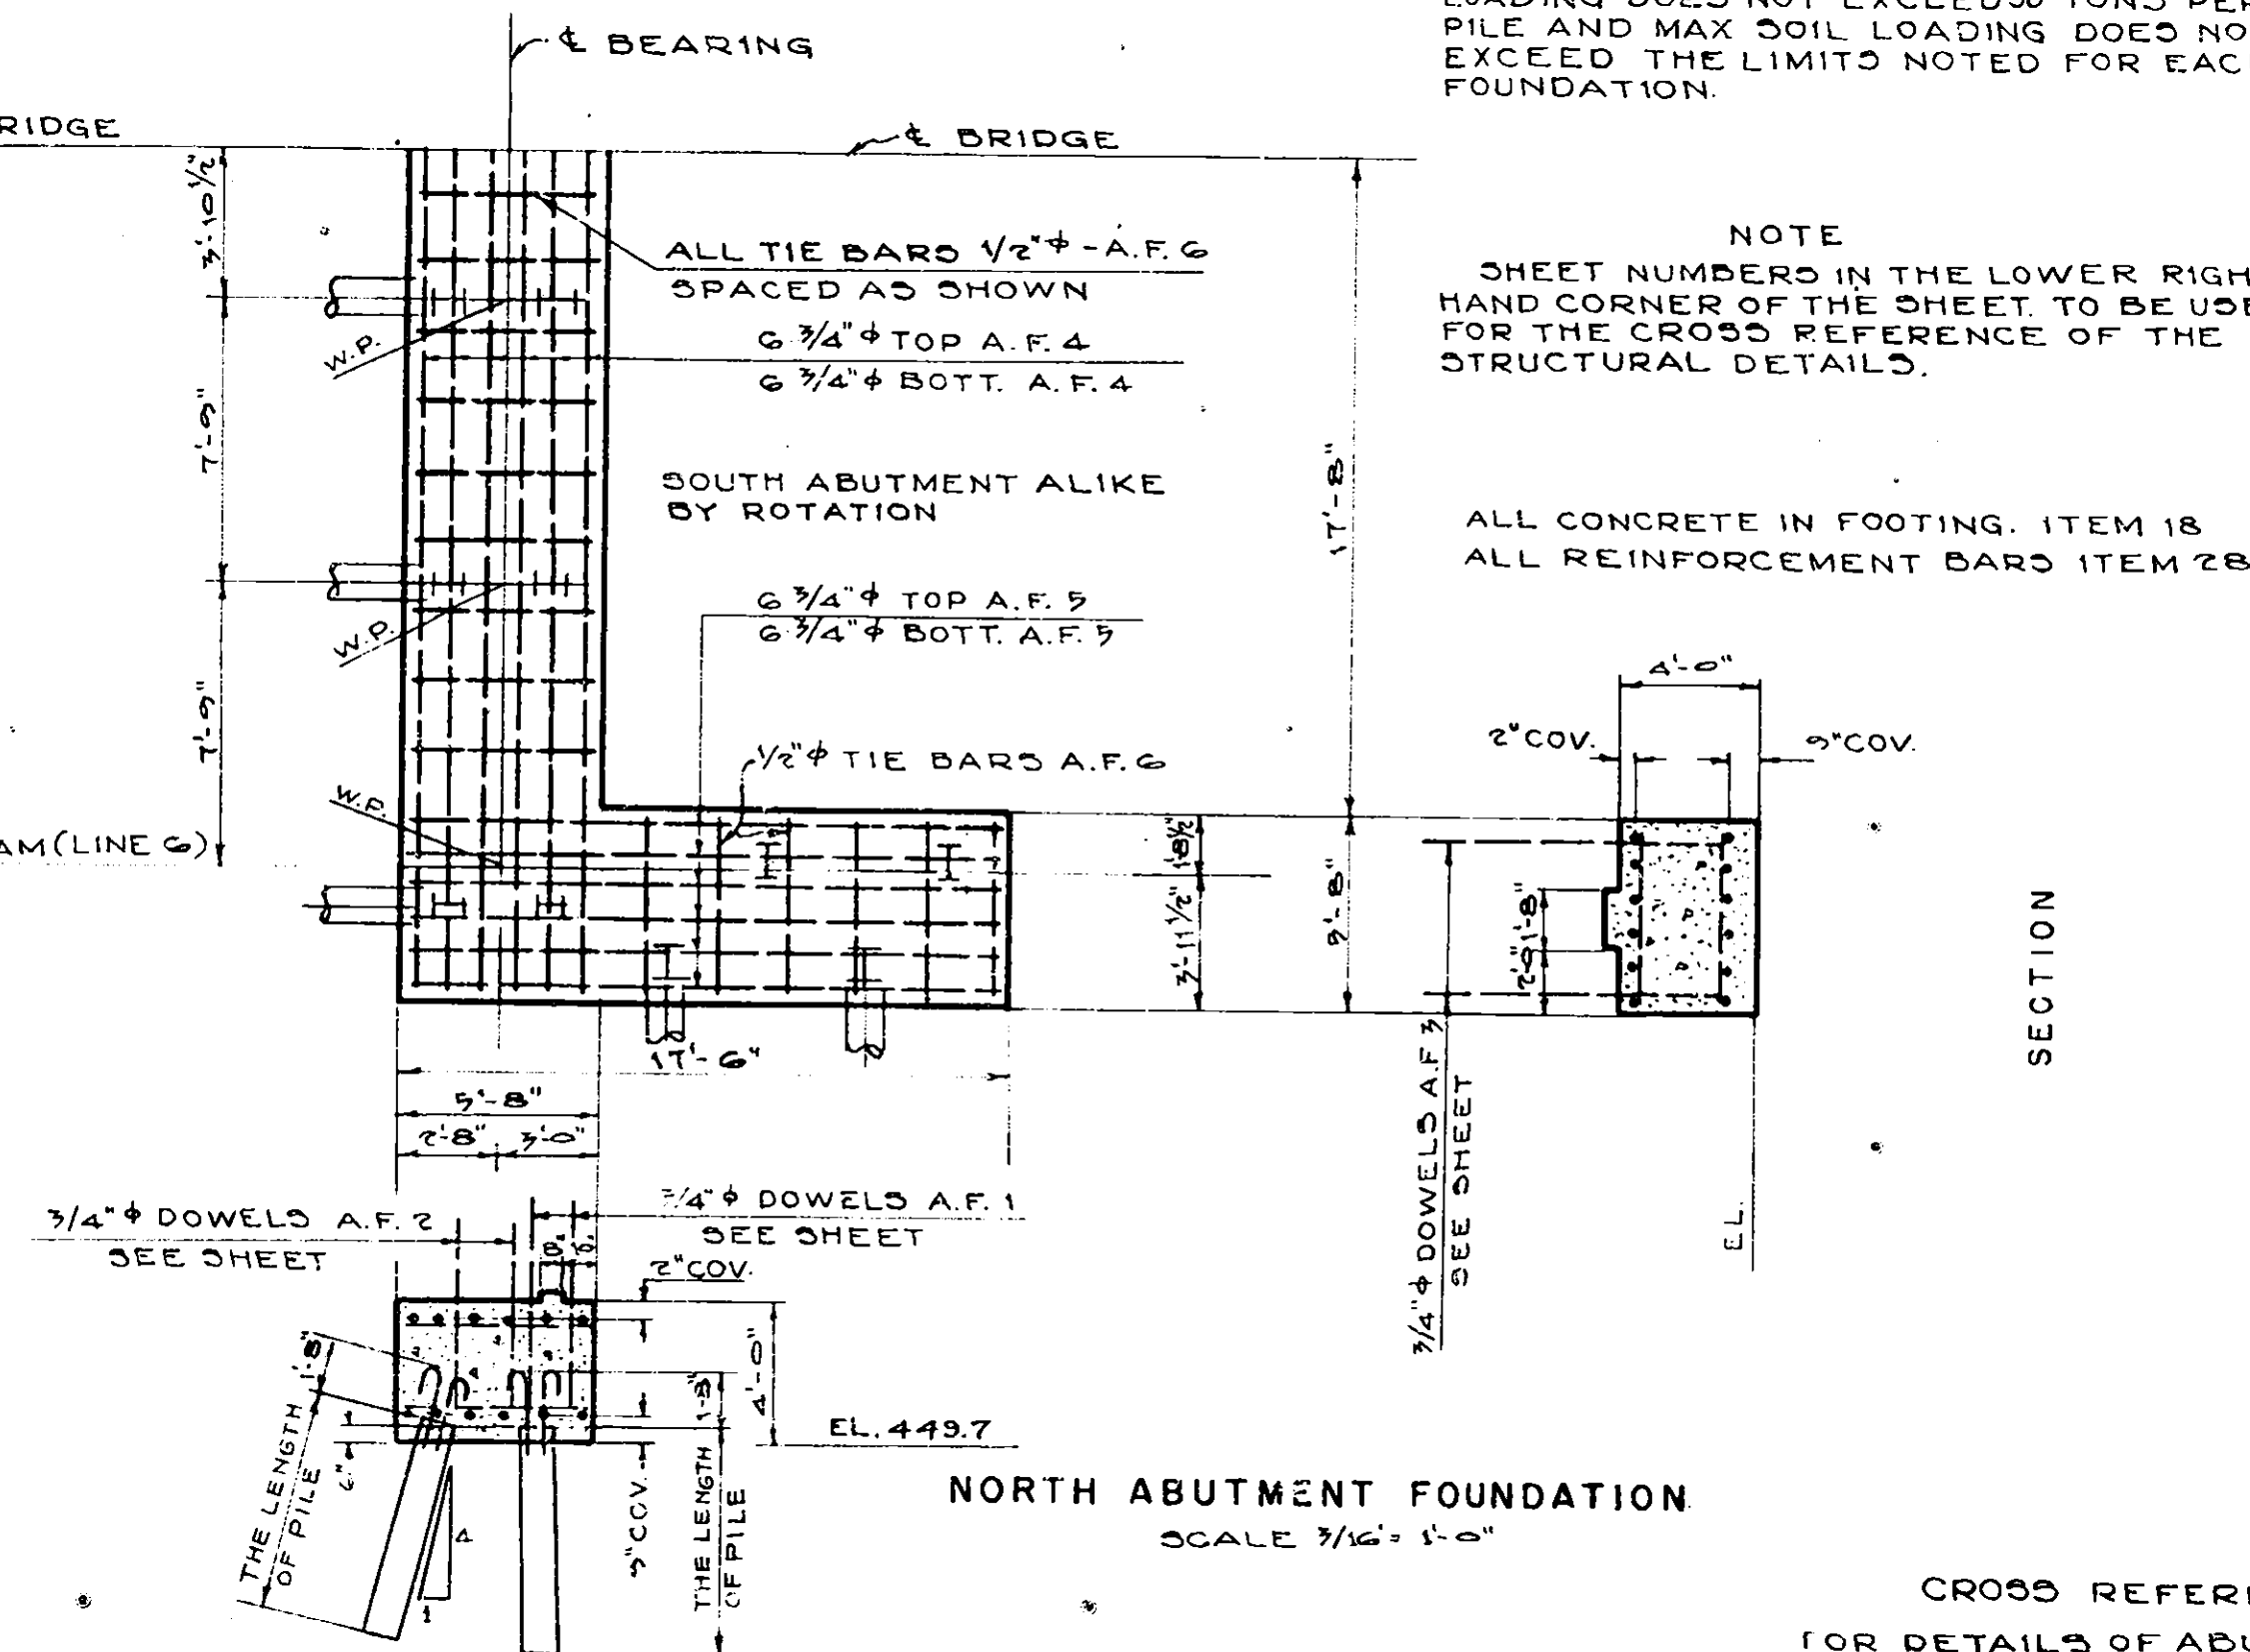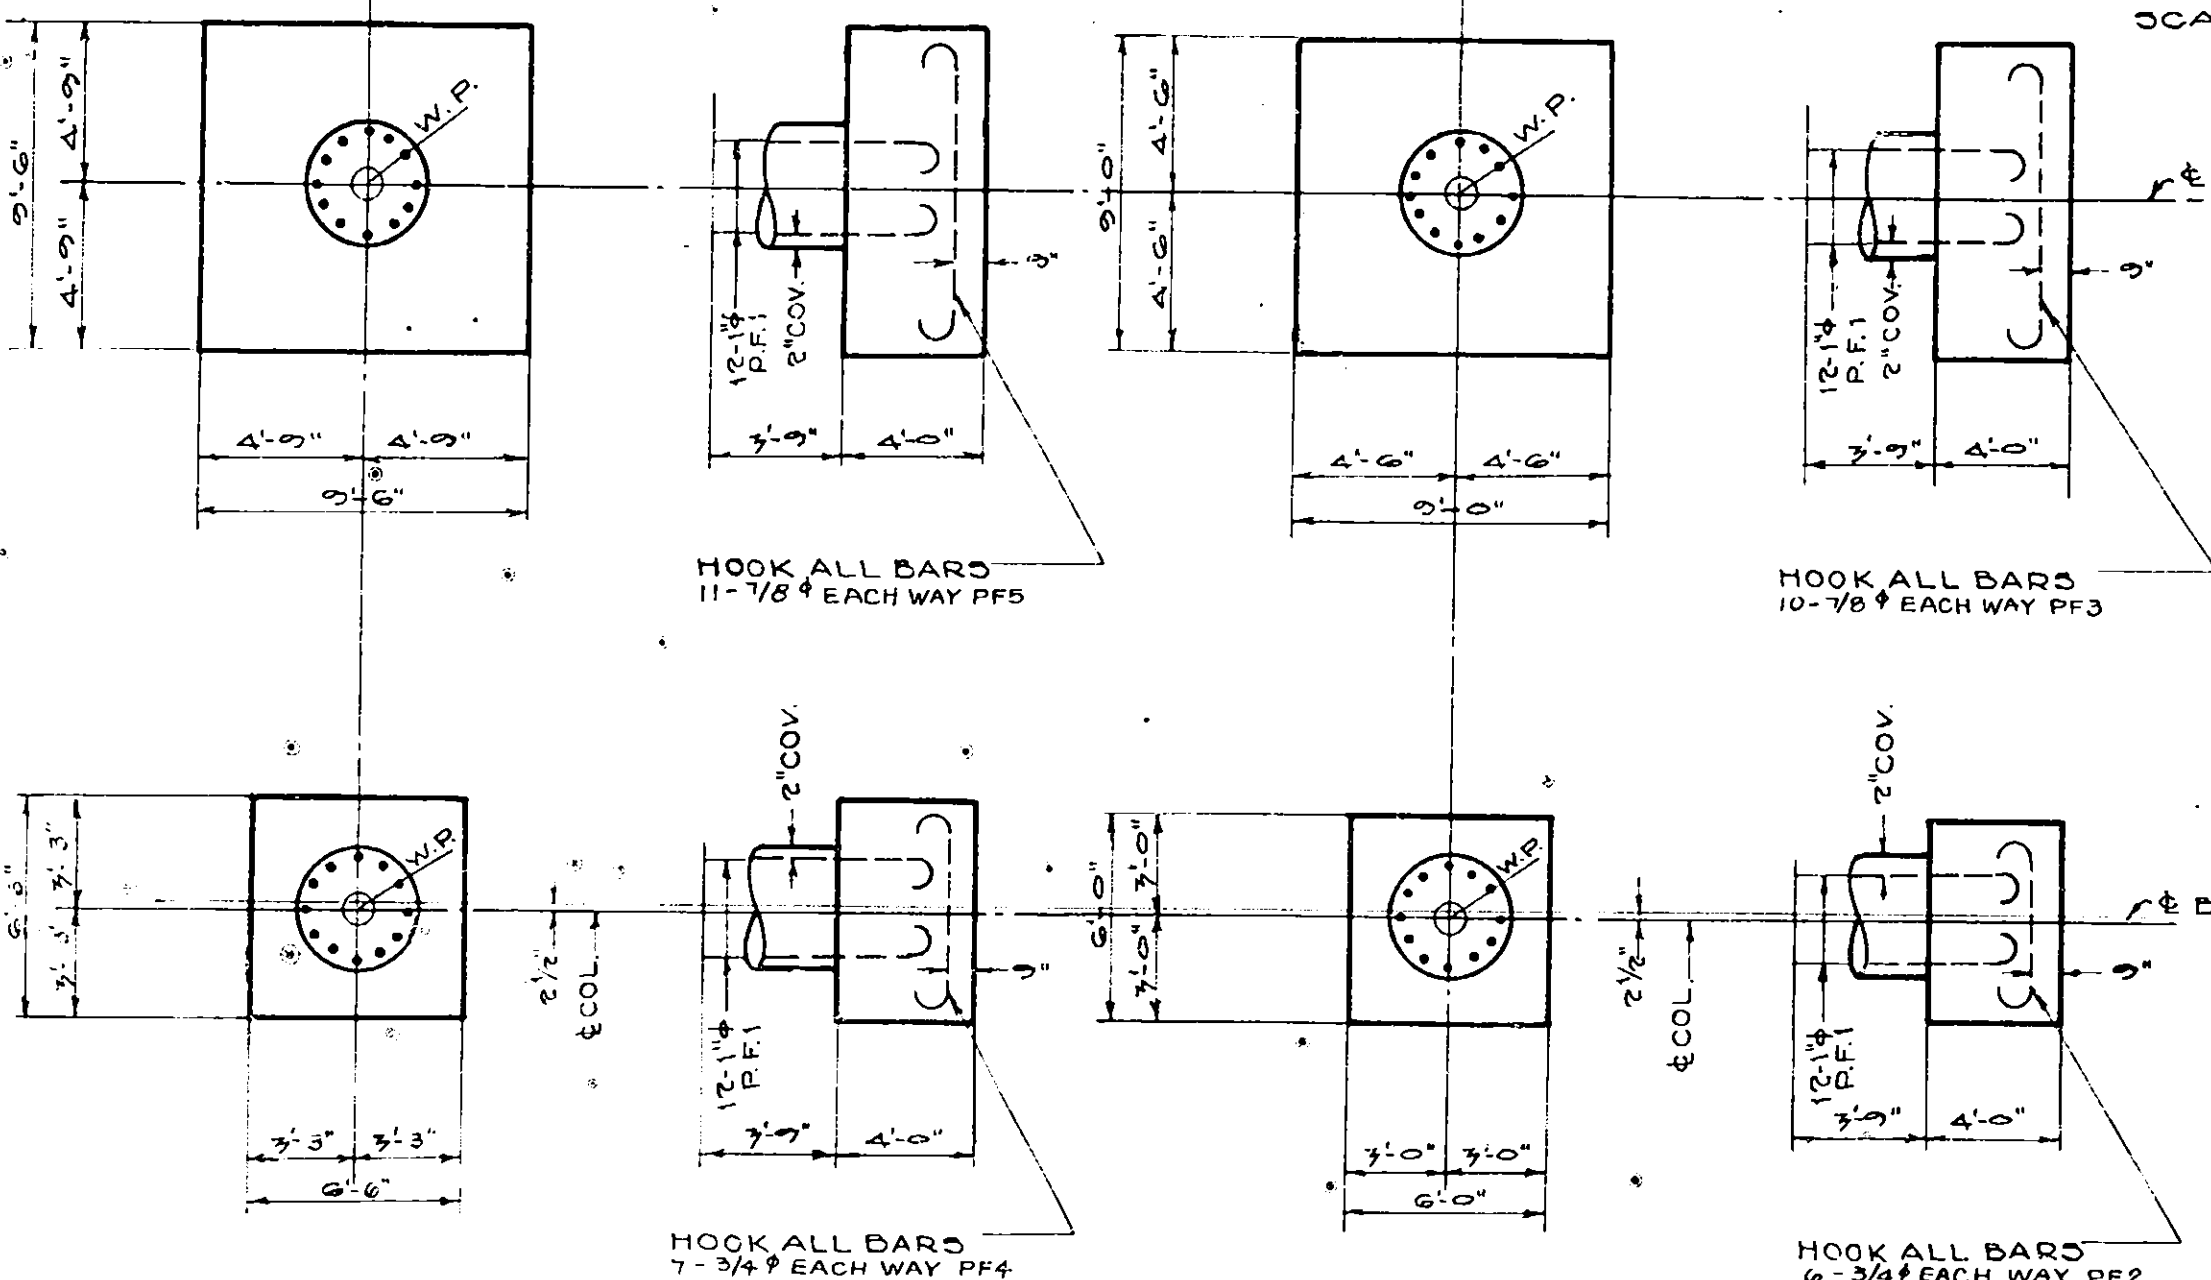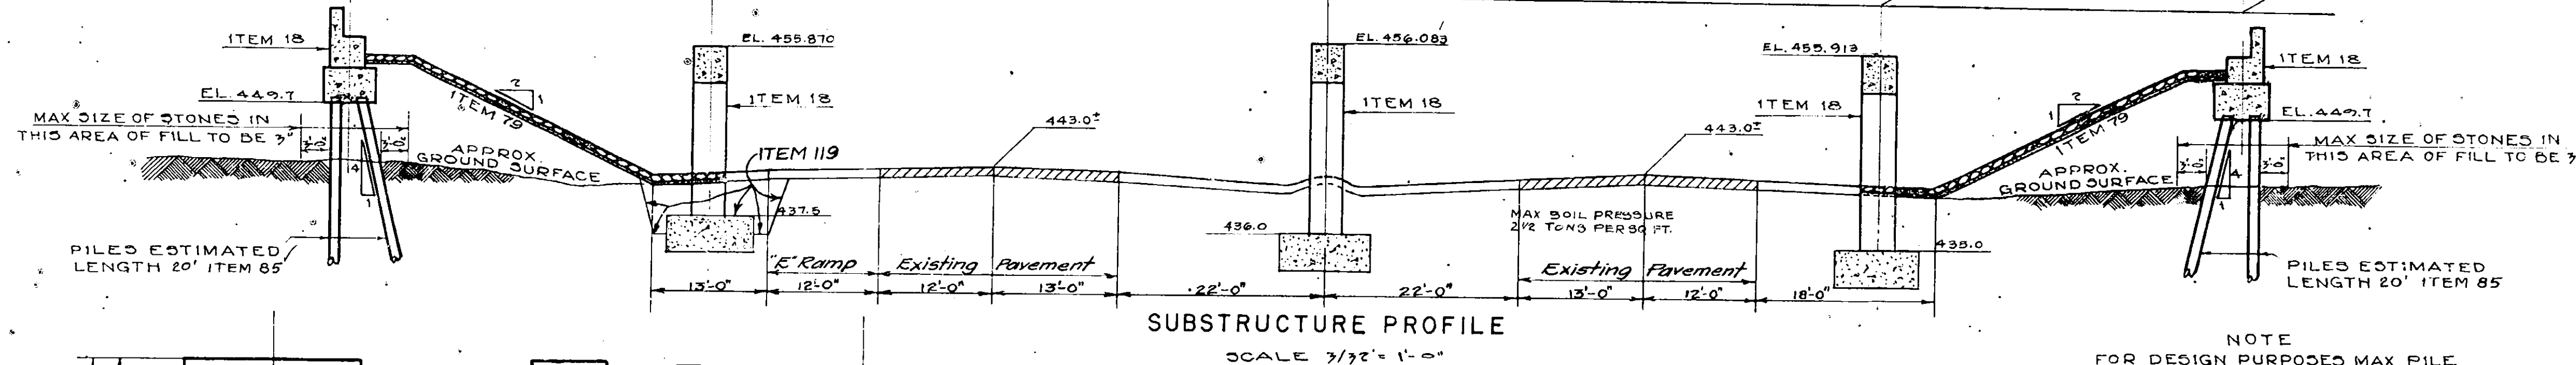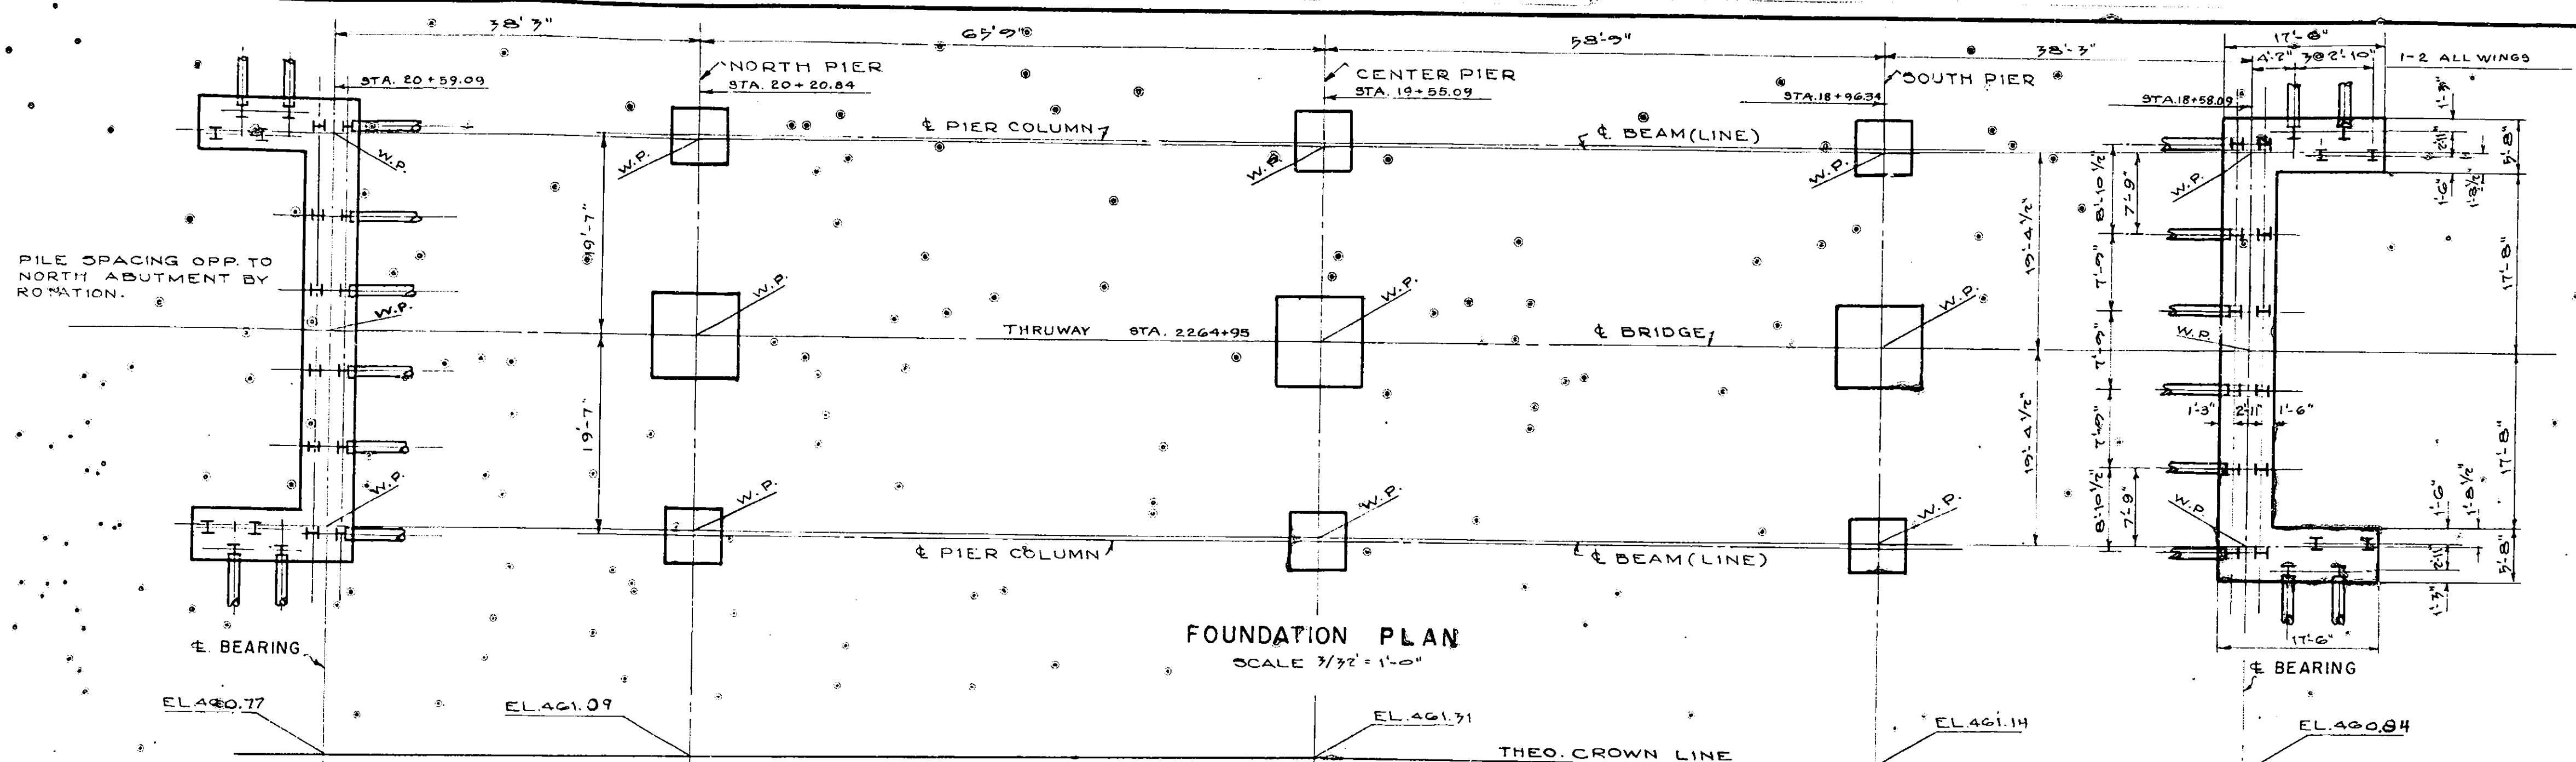

SUBSTRUCTURE DETAILS NEW YORK STATE THRUWAY AND HOPKINS ROAD TRAFFIC INTERCHANGE

CROSS REFERENCE
FOR DETAILS OF ABUTMENTS SEE SHEET 13
FOR DETAILS OF PIERS SEE SHEET 14
FOR DETAILS OF BARS SEE SHEET 21
FOR DETAILS OF ANCHOR BOLTS SEE SHEET 19

COUNTY	SHEET NO.	TOTAL SHEETS
ONONDAGA	15	66
N.Y. STATE THRUWAY-ONTARIO SECTION - SUR.DIV. 8A		
INTERCHANGE AT ELECTRONICS PARKWAY (HOPKINS ROAD)		

SUBSTRUCTURE QUANTITIES				
ITEM NO.	DESCRIPTION	UNIT	NEAT	ROUNDED
5	TRENCH, CULVERT & BRIDGE EXCAVATION	C.Y.	600	700
15-2	PORTLAND CEMENT, TYPE 2	BBL.	595	609
15-M	NATURAL CEMENT, TYPE N	BBL.	85	87
18	CLASS IA CONCRETE FOR STRUCTURES	C.Y.	425	435
28	BAR REINFORCEMENT FOR STRUCTURES	LB.	37,000	38,000
85	STEEL BEARING PILES	LF	800	900
87	FURNISHING EQUIPMENT FOR DRIVING PILES	NEC.	NEC.	NEC.
79	DRY STONE PAVING	S.Y.	420	420
121	TOP SOIL PLACED FROM STOCKPILES	C.Y.	420	450
123	SEEDING	ACRE	.4	.5
124	SODDING	S.Y.	410	430
119	RUN OF BANK GRAVEL FILL	C.Y.	45	50

SUBSTRUCTURE GENERAL NOTES

CONSTRUCTION JOINTS SHALL BE PLACED ONLY AS AND WHERE SHOWN ON THE PLANS, EXCEPT WHERE PERMISSION IN WRITING IS GIVEN BY THE DEPUTY CHIEF ENGINEER (BRIDGES). IN WHICH CASE, HIS SUPPLEMENTAL INSTRUCTIONS SHALL BE STRICTLY FOLLOWED.

AFTER THE CONCRETE IS CURED, THE CONTRACTOR SHALL APPLY A WATER-PROOFING OIL TREATMENT, AS DESCRIBED IN THE SPECIFICATIONS FOR M-41 W TO ALL EXPOSED SURFACES.

ALL SHOE BEARING SURFACES SHALL BE CAST 14" ABOVE ELEVATIONS SHOWN ON THE PLANS, AND AFTER THE CONCRETE IS CURED, SHALL BE BUSH-HAMMERED TO THE REQUIRED ELEVATIONS.


THE CONTRACTOR'S ATTENTION IS DIRECTED TO THE SPECIAL NOTES FOR THIS STRUCTURE WHICH APPEAR IN THE PROPOSAL. PARTICULAR ATTENTION SHOULD BE GIVEN TO THE FOUNDATION NOTE WHICH BRIEFLY OUTLINES THE ANTICIPATED SUBSURFACE CONDITIONS AT THE SITE OF THE STRUCTURE, AND WHICH SPECIFIES CERTAIN REQUIREMENTS RELATIVE TO THE CONSTRUCTION.

NOTE~ FOR LOCATION OF IDENTIFICATION PLATE, SEE STANDARD SHEET 53-41.

CROSS REFERENCE

FOR LAYOUT OF PIERS SEE SHEET 13
FOR DETAILS OF REINFORCING BARS SEE SHEET 21
FOR DETAILS OF PIER FOUNDATION SEE SHEET 13
FOR DETAILS OF ANCHOR BOLTS SEE SHEET 19

SUBSTRUCTURE DETAILS NEW YORK STATE THRUWAY AND HOPKINS ROAD TRAFFIC INTERCHANGE

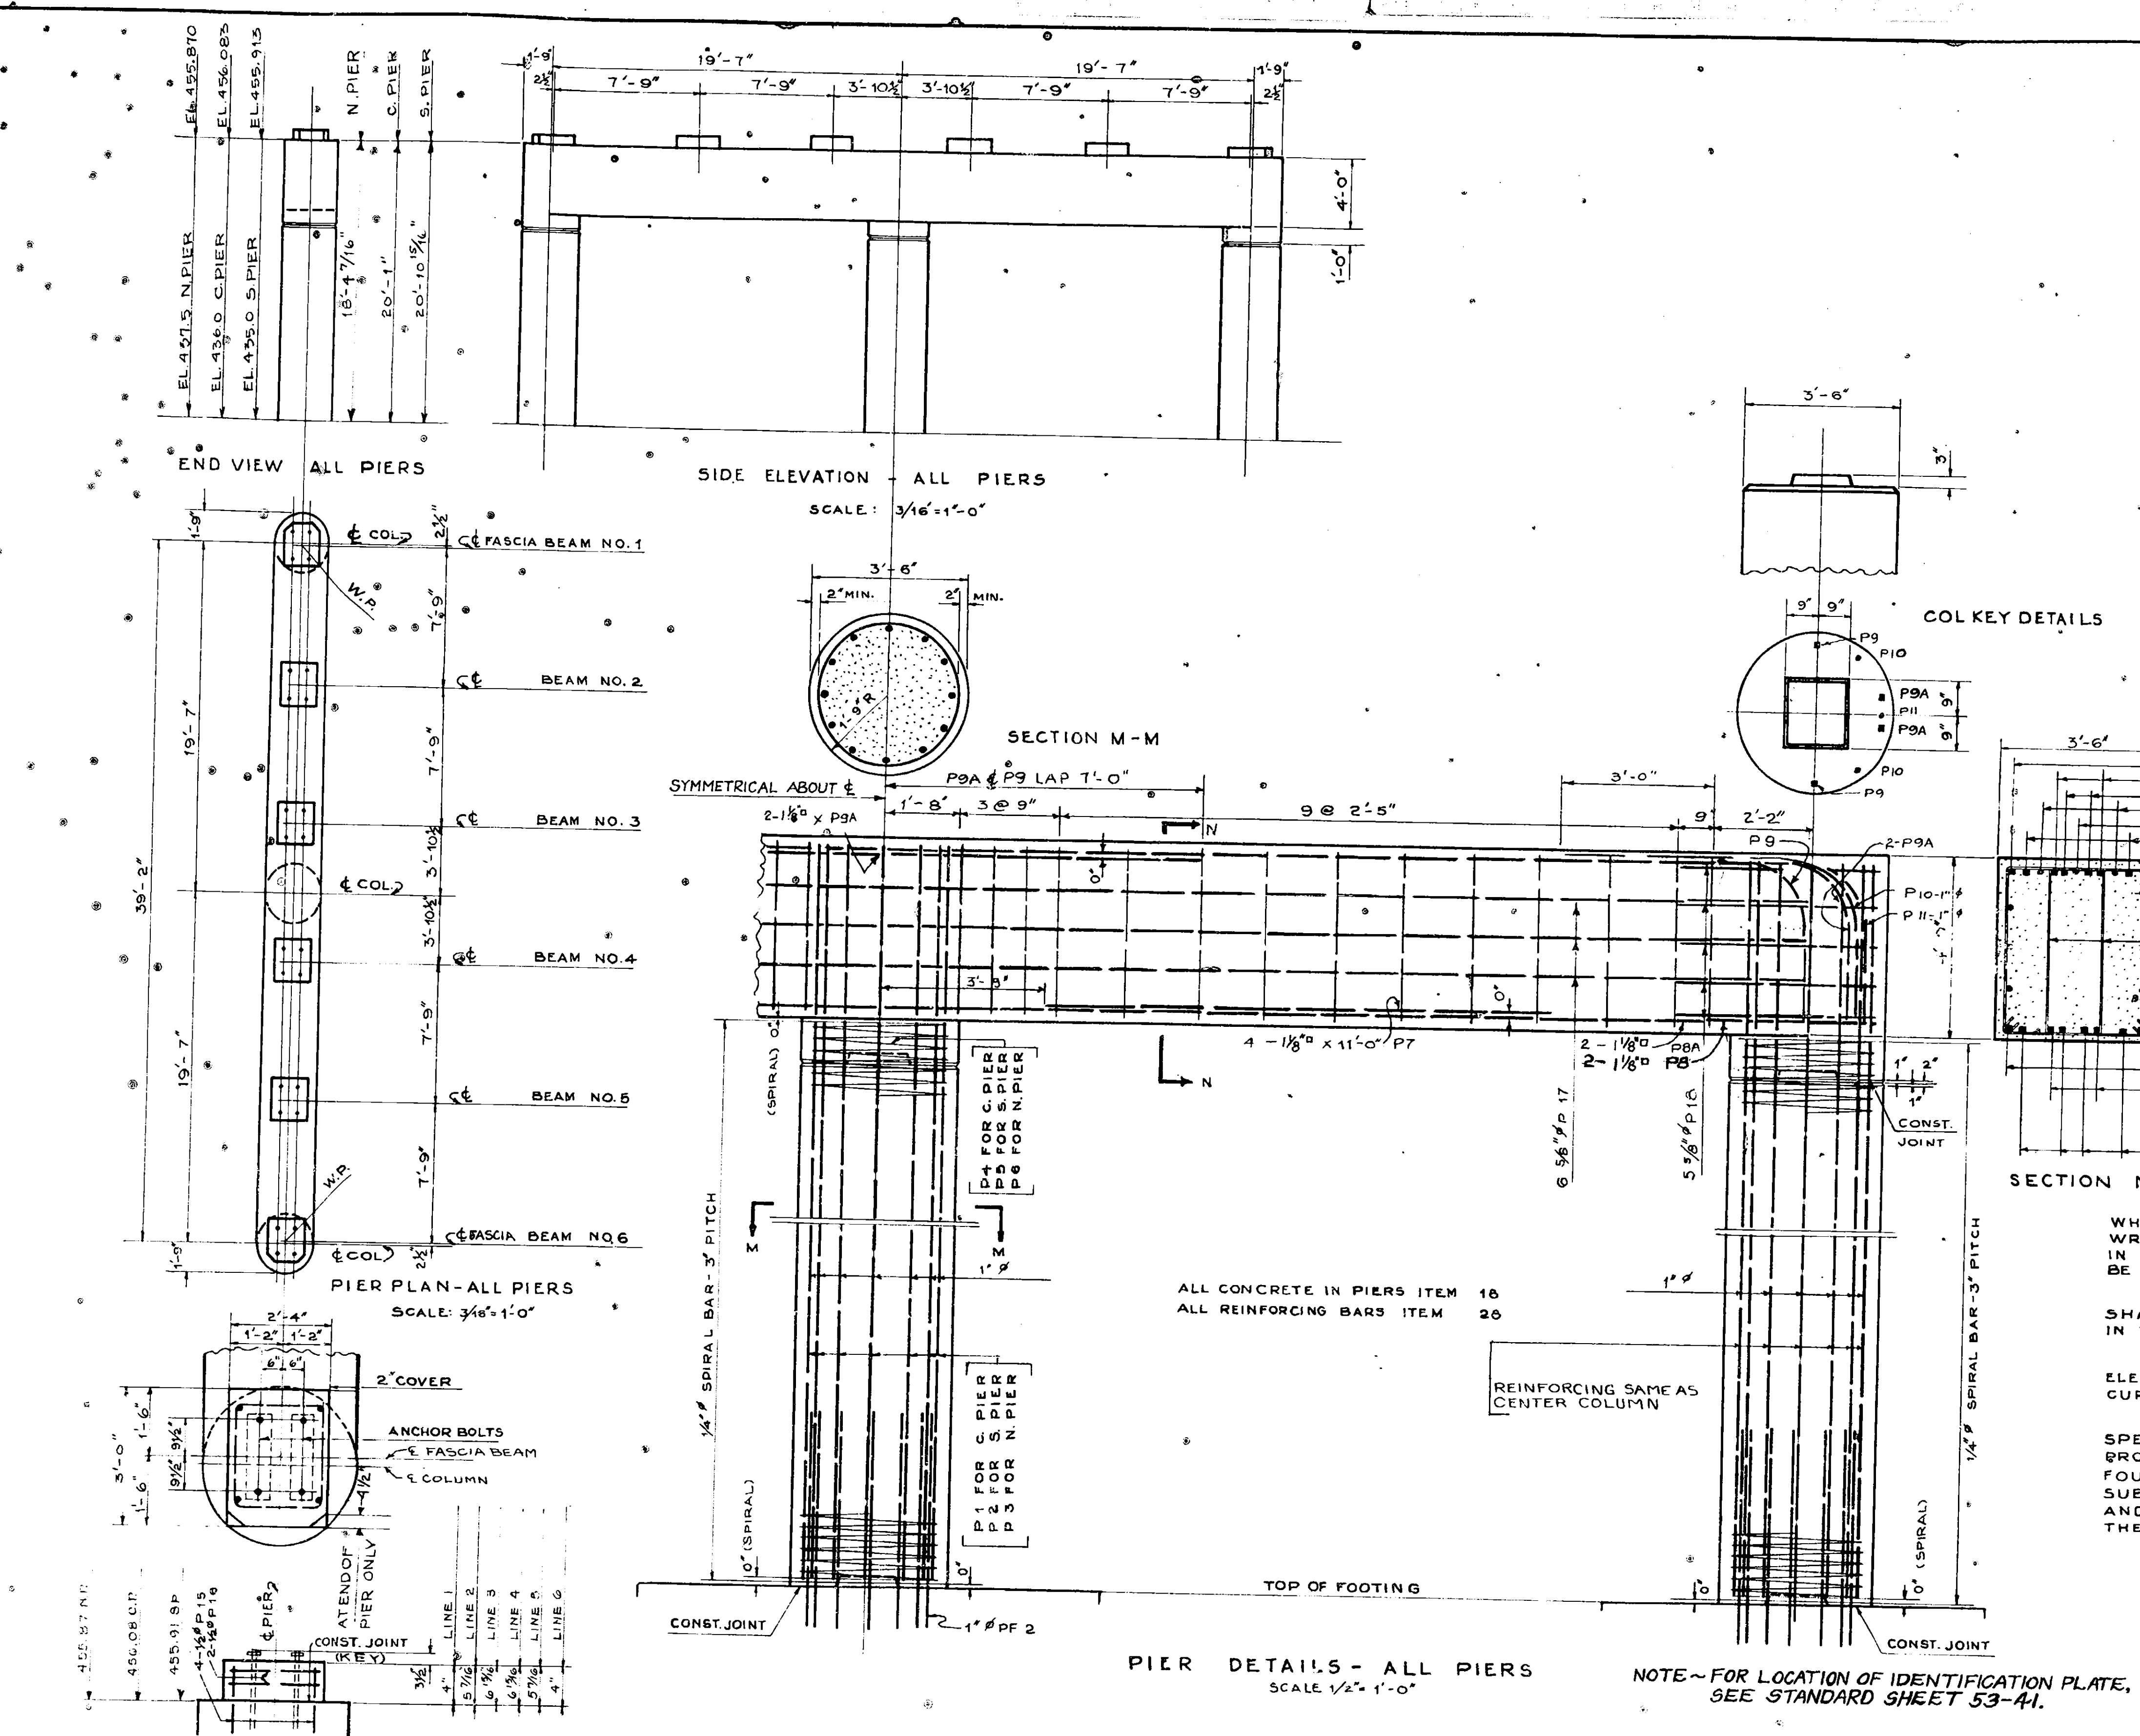


PREPARED AND RECOMMENDED: *[Signature]* F-19-53
 UROUHART & DOYLE, CONSULTING ENGINEERS
 NEW YORK STATE PROFESSIONAL ENGINEERS LICENSE NO. 5667
 DATE

COUNTY		SHEET NO.	TOTAL SHEETS
ONONDAGA		15	36
N.Y. STATE THRUWAY-ONTARIO SECTION - SUB.DIV. 8A			
INTERCHANGE AT ELECTRONICS PARKWAY (HOPKINS ROAD)			
ROUTE 48 INTERCHANGE BRIDGE			

15K

SUBSTRUCTURE QUANTITIES				
ITEM NO.	DESCRIPTION	UNIT	NEAT	ROUNDED
5	TRENCH,CULVERT & BRIDGE EXCAVATION	C.Y.	600	700
15-2	PORTLAND CEMENT, TYPE 2	BBL.	595	609
15-N	NATURAL CEMENT, TYPE N	BBL.	85	87
18	CLASS IA CONCRETE FOR STRUCTURES	C.Y.	425	435
28	BAR REINFORCEMENT FOR STRUCTURES	L.B.	37,000	38,000
85	STEEL BEARING PILES	L.F.	800	500
87	FURNISHING EQUIPMENT FOR DRIVING PILES	SEC.	SEC.	SEC.
79	DRY, STONE PAVING	S.Y.	420	400
121	TOP SOIL PLACED FROM STOCKPILES	C.Y.	200	250
123	SEEDING	ACRE:	4	6
124	SODDING	S.Y.	410	430
119	RUN OF BANK GRAVEL FILL	C.Y.	45	50

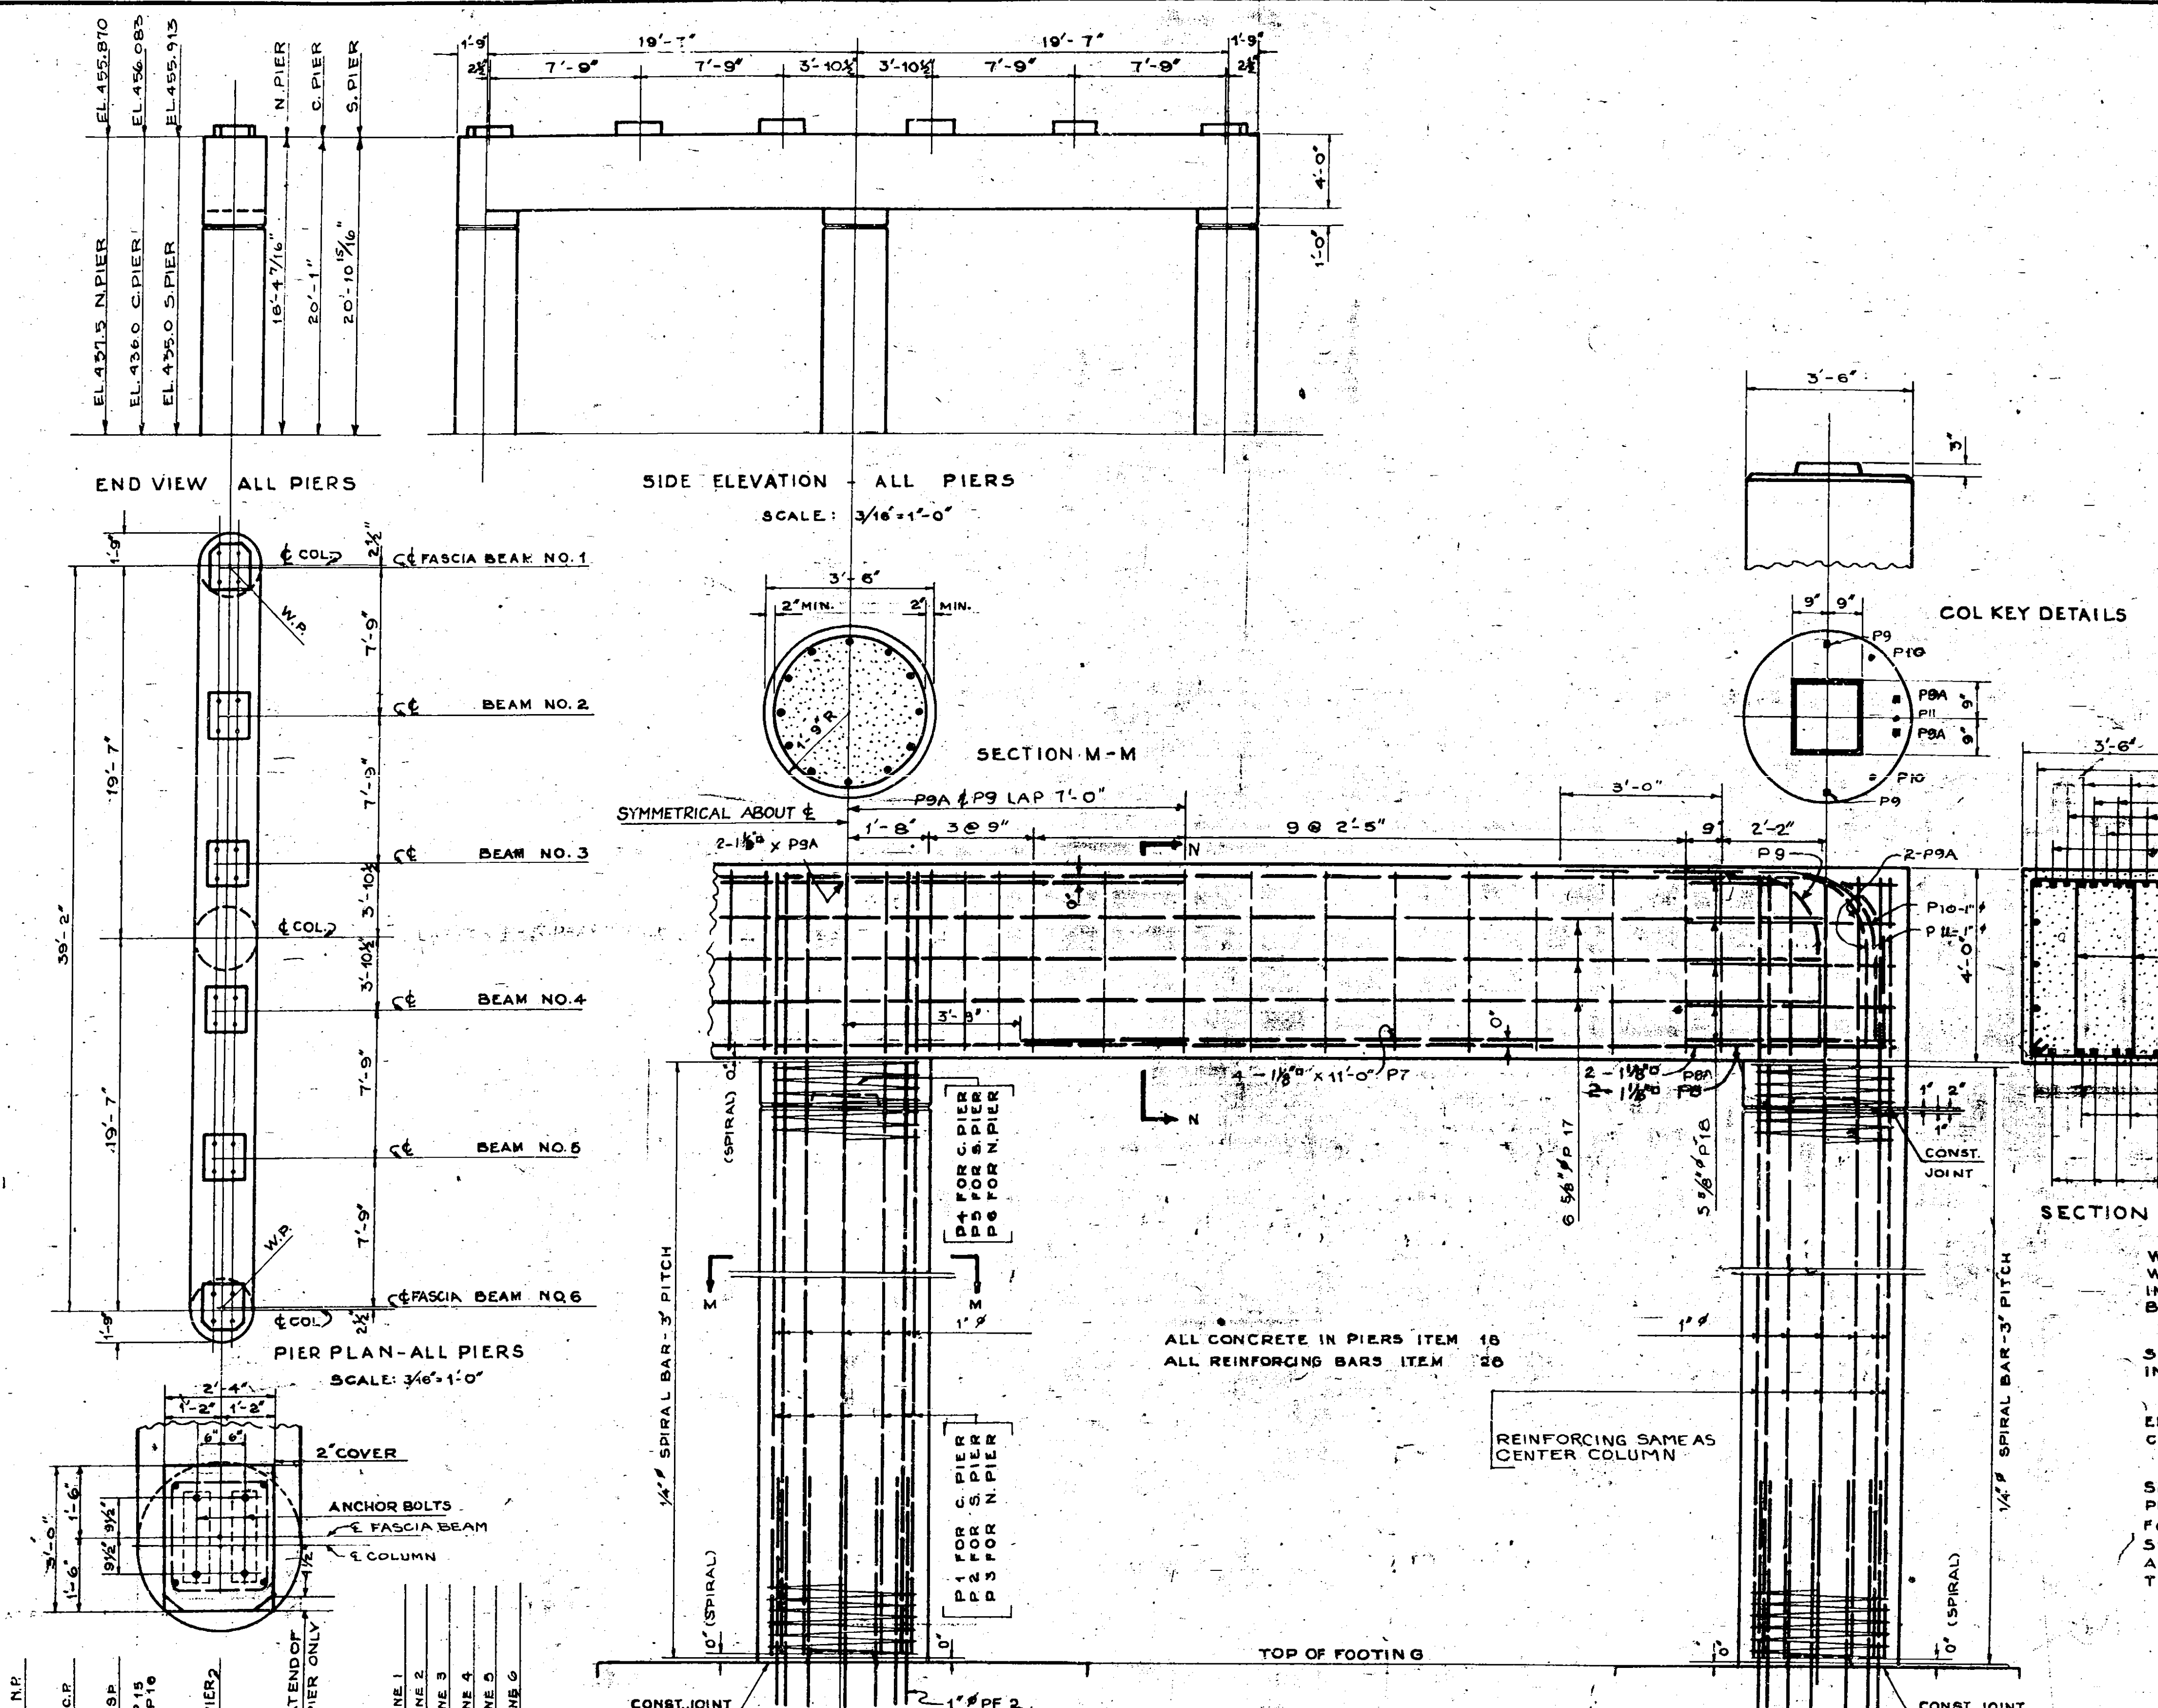

SUBSTRUCTURE
GENERAL NOTES

SECTION N-N

CONSTRUCTION JOINTS SHALL BE PLACED ONLY AS AND WHERE SHOWN ON THE PLANS, EXCEPT WHERE PERMISSION IN WRITING IS GIVEN BY THE DEPUTY CHIEF ENGINEER (BRIDGES), IN WHICH CASE, HIS SUPPLEMENTAL INSTRUCTIONS SHALL BE STRICTLY FOLLOWED.

AFTER THE CONCRETE IS CURED, THE CONTRACTOR SHALL APPLY A WATER-PROOFING OIL TREATMENT, AS DESCRIBED IN THE SPECIFICATIONS FOR M-41W TO ALL EXPOSED SURFACES.

ALL SHOE BEARING SURFACES SHALL BE CAST 14' ABOVE ELEVATIONS SHOWN ON THE PLANS, AND AFTER THE CONCRETE IS CURED, SHALL BE BUSH-HAMMERED TO THE REQUIRED ELEVATIONS.

THE CONTRACTOR'S ATTENTION IS DIRECTED TO THE SPECIAL NOTES FOR THIS STRUCTURE WHICH APPEAR IN THE PROPOSAL. PARTICULAR ATTENTION SHOULD BE GIVEN TO THE FOUNDATION NOTE WHICH BRIEFLY OUTLINES THE ANTICIPATED SUBSURFACE CONDITIONS AT THE SITE OF THE STRUCTURE, AND WHICH SPECIFIES CERTAIN REQUIREMENTS RELATIVE TO THE CONSTRUCTION.

BUILT ACCORDING TO PLAN

SUBSTRUCTURE DETAILS

NEW YORK STATE THRUWAY AND HOPKINS ROAD TRAFFIC INTERCHANGE

PREPARED AND RECOMMENDED:

URQUHART & DOYLE, CONSULTING ENGINEERS
NEW YORK STATE PROFESSIONAL ENGINEERS LICENSE NO. 366

DATE

SHEET 15

SUPERSTRUCTURE

GENERAL NOTES

THE DESIGN OF THE STRUCTURE IS BASED ON A.A.S.H.O. SPECIFICATIONS, 1949, H20-S16-44 LOADING, AND CURRENT MODIFICATIONS AND ADDITIONS. ALL CONCRETE OF SUPERSTRUCTURE SHALL BE ITEM 18, EXCEPT CONCRETE OF PYLONS, WHICH SHALL BE ITEM 19, AND CEMENT CONCRETE PAVEMENT, WHICH SHALL BE ITEM 47 BM.

THE COST OF FURNISHING AND INSTALLING METAL EXPANSION MATERIAL, METAL WATER STOP, PREMOULDED BITUMINOUS JOINT MATERIALS, CAULKING COMPOUND, PARA-PLASTIC, SPONGE RUBBER, ASPHALT ROOFING FELT, ETC., SHALL BE INCLUDED IN THE BID PRICES OF THE RESPECTIVE CONCRETE ITEMS OF THE CONTRACT.

ALL MATERIALS, WORKMANSHIP, AND FABRICATION SHALL CONFORM TO NEW YORK STATE DEPARTMENT OF PUBLIC WORKS SPECIFICATIONS, JANUARY 2, 1951, AND CURRENT MODIFICATIONS AND ADDITIONS.

WHERE CAULKING COMPOUND IS TO CONTACT CONCRETE SURFACES, SUCH CONCRETE SHALL BE THOROUGHLY CLEANED AND DRY, AND PRIMED WITH A PRIMING COAT AT LEAST 30 MINUTES BEFORE THE APPLICATION OF CAULKING COMPOUND. THIS WORK SHALL BE DONE BY EXPERIENCED MEN, AND THE COMPLETE OPERATION SHALL BE SPECIALLY DIRECTED BY THE ENGINEER.

CONSTRUCTION JOINTS SHALL BE PLACED ONLY AS AND WHERE SHOWN ON THE PLANS, EXCEPT WHEN PERMISSION IN WRITING IS GIVEN BY THE DEPUTY CHIEF ENGINEER OF BRIDGES, IN WHICH CASE HIS SUPPLEMENTAL INSTRUCTIONS SHALL BE STRICTLY FOLLOWED.

AFTER THE CONCRETE IS CURED, THE CONTRACTOR SHALL APPLY A WATERPROOFING OIL TREATMENT, AS DESCRIBED IN THE SPECIFICATIONS FOR "M-41W" TO ALL EXPOSED SURFACES EXCEPT THE UNDERSIDE OF SLABS. TWO APPLICATIONS OF WATERPROOFING OIL TREATMENT SHALL BE APPLIED AT THE TOP OF THE SLAB. THE SECOND APPLICATION SHALL BE APPLIED TWO DAYS PRIOR TO THE PLACING OF THE PAVEMENT OR SIDEWALK.


IMMEDIATELY BEFORE PLACING PAVEMENT CONCRETE, THE CONCRETE SURFACE OR SURFACES UPON WHICH IT IS TO BE PLACED SHALL BE THOROUGHLY WETTED DOWN CONTINUOUSLY FOR ONE HOUR, IF THE AIR TEMPERATURE IS ABOVE 50° F. PAYMENT FOR THIS WORK WILL BE INCLUDED IN THE PRICE BID FOR ITEM 47-BM.

THE CONTRACTOR'S ATTENTION IS DIRECTED TO ALL SPECIAL NOTES FOR THIS STRUCTURE WHICH APPEAR IN THE PROPOSAL PARTICULAR ATTENTION SHOULD BE GIVEN TO THE FOUNDATION NOTE, WHICH BRIEFLY OUTLINES THE ANTICIPATED SUBSURFACE CONDITIONS OF THE SITE OF THE STRUCTURE, AND WHICH SPECIFIES CERTAIN REQUIREMENTS RELATIVE TO CONSTRUCTION.

SUPERSTRUCTURE QUANTITIES

ITEM NO.	DESCRIPTION	UNIT	NEAT	ROUNDED
15-2	PORTLAND CEMENT, TYPE 2	BBL.	382	397
15-N	NATURAL CEMENT, TYPEN	BBL.	74	78
18	CLASS 1A CONCRETE FOR STRUCTURES	C.Y.	270	280
19	CLASS 1A CONCRETE FOR RAILINGS	C.Y.	2.5	3
28	BAR REINFORCEMENT FOR STRUCTURES	LB	63,500	66,000
28B	SPIRAL BAR SHEAR CONNECTORS	LB	2,100	2,200
29	STRUCTURAL STEEL	LB	230,300	237,200
37	METAL RAILINGS	LF	462	465
47 BM	CEMENT CONCRETE PAVEMENT	C.Y.	92	100
* 25 F	STEEL FABRIC REINFORCEMENT	S.Y.	820	830
15-BA	PORTLAND CEMENT, TYPE 1A	BBL.	136	149

* STEEL FABRIC REINFORCEMENT IS TO BE FURNISHED IN FLAT SHEETS

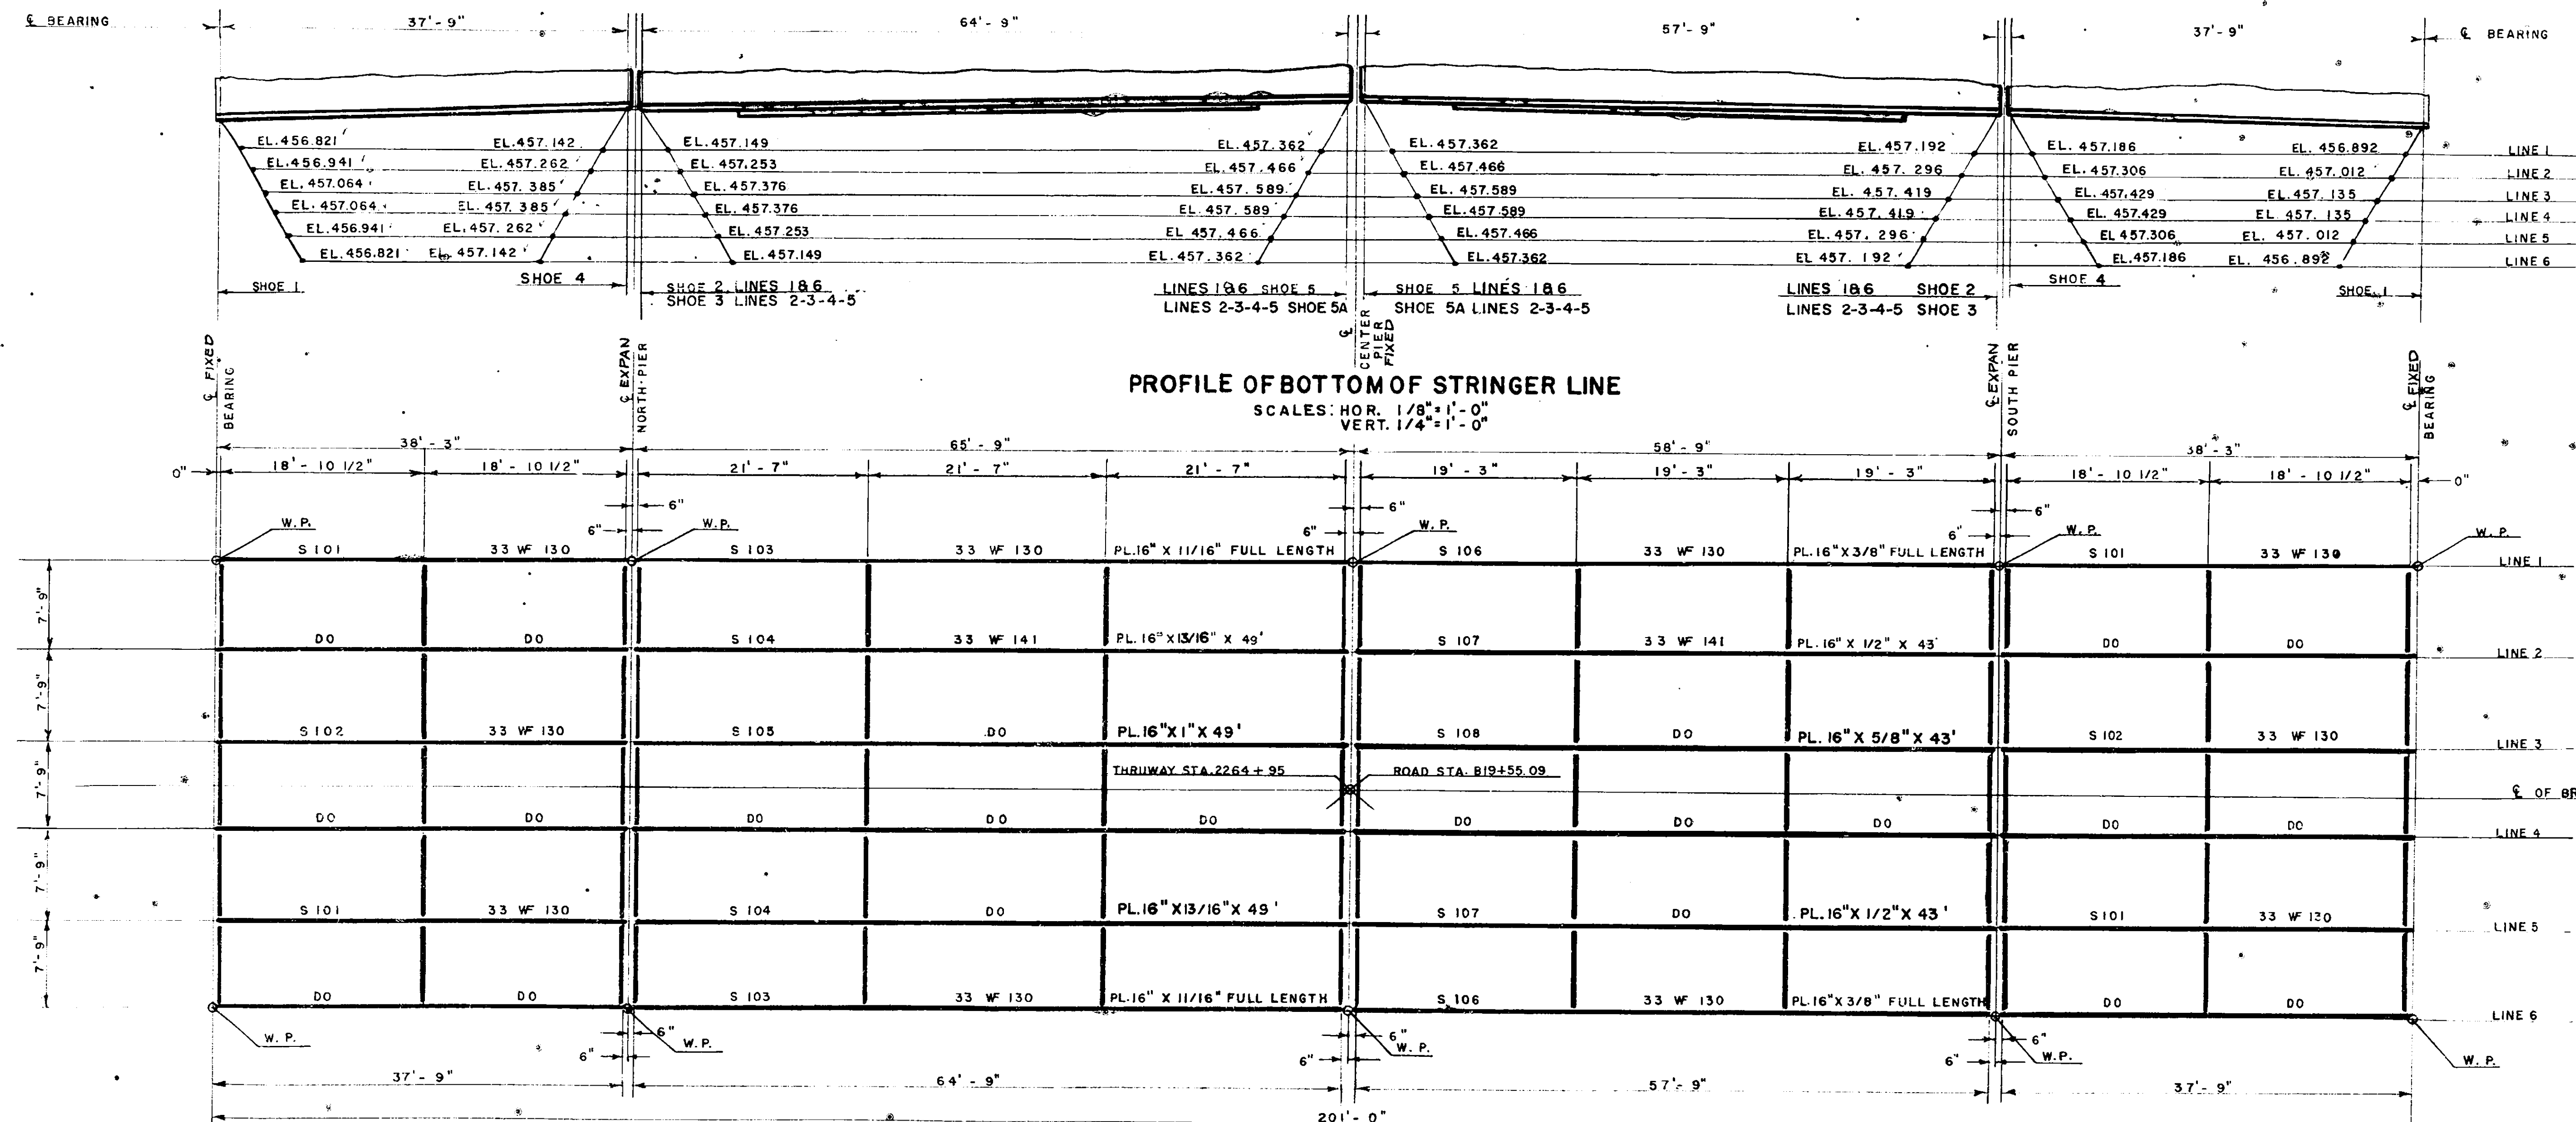

PREPARED AND RECOMMENDED:

URQUHART & DOYLE, CONSULTING ENGINEERS
NEW YORK STATE PROFESSIONAL ENGINEERS LICENSE NO. 5667

DATE

COUNTY	SHEET NO.	TOTAL SHEETS
ONONDAGA	16	66
N.Y. STATE THRUWAY-ONTARIO SECTION SUBDIV. 8 A		
INTERCHANGE AT ELECTRONICS PARKWAY (HOPKINS ROAD)		

SUPERSTRUCTURE GENERAL NOTES

THE DESIGN OF THE STRUCTURE IS BASED ON A.A.S.H.O. SPECIFICATIONS, 1949, H20-S16-44 LOADING, AND CURRENT MODIFICATIONS AND ADDITIONS. ALL CONCRETE OF SUPERSTRUCTURE SHALL BE ITEM 18, EXCEPT CONCRETE OF PYLONS, WHICH SHALL BE ITEM 19, AND CEMENT CONCRETE PAVEMENT, WHICH SHALL BE ITEM 47BM.

THE COST OF FURNISHING AND INSTALLING METAL EXPANSION MATERIAL, METAL WATER STOP, PREMOULDED BITUMINOUS JOINT MATERIAL, CAULKING COMPOUND, PARA-PLASTIC, SPONGE RUBBER, ASPHALT ROOFING FELT, ETC., SHALL BE INCLUDED IN THE BID PRICES OF THE RESPECTIVE CONCRETE ITEMS OF THE CONTRACT.

ALL MATERIALS, WORKMANSHIP, AND FABRICATION SHALL CONFORM TO NEW YORK STATE DEPARTMENT OF PUBLIC WORKS SPECIFICATIONS, JANUARY 2, 1951, AND CURRENT MODIFICATIONS AND ADDITIONS.

WHERE CAULKING COMPOUND IS TO CONTACT CONCRETE SURFACES, SUCH CONCRETE SHALL BE THOROUGHLY CLEANED AND DRY, AND PRIMED WITH A PRIMING COAT AT LEAST 30 MINUTES BEFORE THE APPLICATION OF CAULKING COMPOUND. THIS WORK SHALL BE DONE BY EXPERIENCED MEN, AND THE COMPLETE OPERATION SHALL BE SPECIALLY DIRECTED BY THE ENGINEER.

CONSTRUCTION JOINTS SHALL BE PLACED ONLY AS AND WHERE SHOWN ON THE PLANS, EXCEPT WHEN PERMISSION IN WRITING IS GIVEN BY THE DEPUTY CHIEF ENGINEER OF BRIDGES, IN WHICH CASE HIS SUPPLEMENTAL INSTRUCTIONS SHALL BE STRICTLY FOLLOWED.


AFTER THE CONCRETE IS CURED, THE CONTRACTOR SHALL APPLY A WATERPROOFING OIL TREATMENT, AS DESCRIBED IN THE SPECIFICATIONS FOR M-41W TO ALL EXPOSED SURFACES EXCEPT THE UNDERSIDE OF SLABS. TWO APPLICATIONS OF WATERPROOFING OIL TREATMENT SHALL BE APPLIED AT THE TOP OF THE SLAB. THE SECOND APPLICATION SHALL BE APPLIED TWO DAYS PRIOR TO THE PLACING OF THE PAVEMENT OR SIDEWALK.

IMMEDIATELY BEFORE PLACING PAVEMENT CONCRETE, THE CONCRETE SURFACE OR SURFACES UPON WHICH IT IS TO BE PLACED SHALL BE THOROUGHLY WETTED DOWN CONTINUOUSLY FOR ONE HOUR, IF THE AIR TEMPERATURE IS ABOVE 50°F. PAYMENT FOR THIS WORK WILL BE INCLUDED IN THE PRICE BID FOR ITEM 47-BM.

THE CONTRACTOR'S ATTENTION IS DIRECTED TO ALL SPECIAL NOTES FOR THIS STRUCTURE WHICH APPEAR IN THE PROPOSAL. PARTICULAR ATTENTION SHOULD BE GIVEN TO THE FOUNDATION NOTE, WHICH BRIEFLY OUTLINES THE ANTICIPATED SUBSURFACE CONDITIONS OF THE SITE OF THE STRUCTURE, AND WHICH SPECIFIES CERTAIN REQUIREMENTS RELATIVE TO CONSTRUCTION.

SUPERSTRUCTURE QUANTITIES				
ITEM NO.	DESCRIPTION	UNIT	NEAT	ROUNDED
15-2	PORTLAND CEMENT, TYPE 2	BBL.	382	397
15-N	NATURAL CEMENT, TYPE N	BBL.	74	76
18	CLASS 1A CONCRETE FOR STRUCTURES	C.Y.	279	289
19	CLASS 1A CONCRETE FOR RAILINGS	C.Y.	25	3
28	BAR REINFORCEMENT FOR STRUCTURES	LB.	53,500	56,000
28B	SPIRAL BAR SHEAR CONNECTORS	LB.	2,000	2,000
29	STRUCTURAL STEEL	LB.	230,300	237,000
37	METAL RAILINGS	LF.	462	465
47 BM	CEMENT CONCRETE PAVEMENT	C.Y.	92	100
* 25 F	STEEL FABRIC REINFORCEMENT	S.Y.	820	830
15-BR	PORTLAND CEMENT, TYPE 1A	BBL.	176	179

* STEEL FABRIC REINFORCEMENT IS TO BE FURNISHED IN FLAT SHEETS

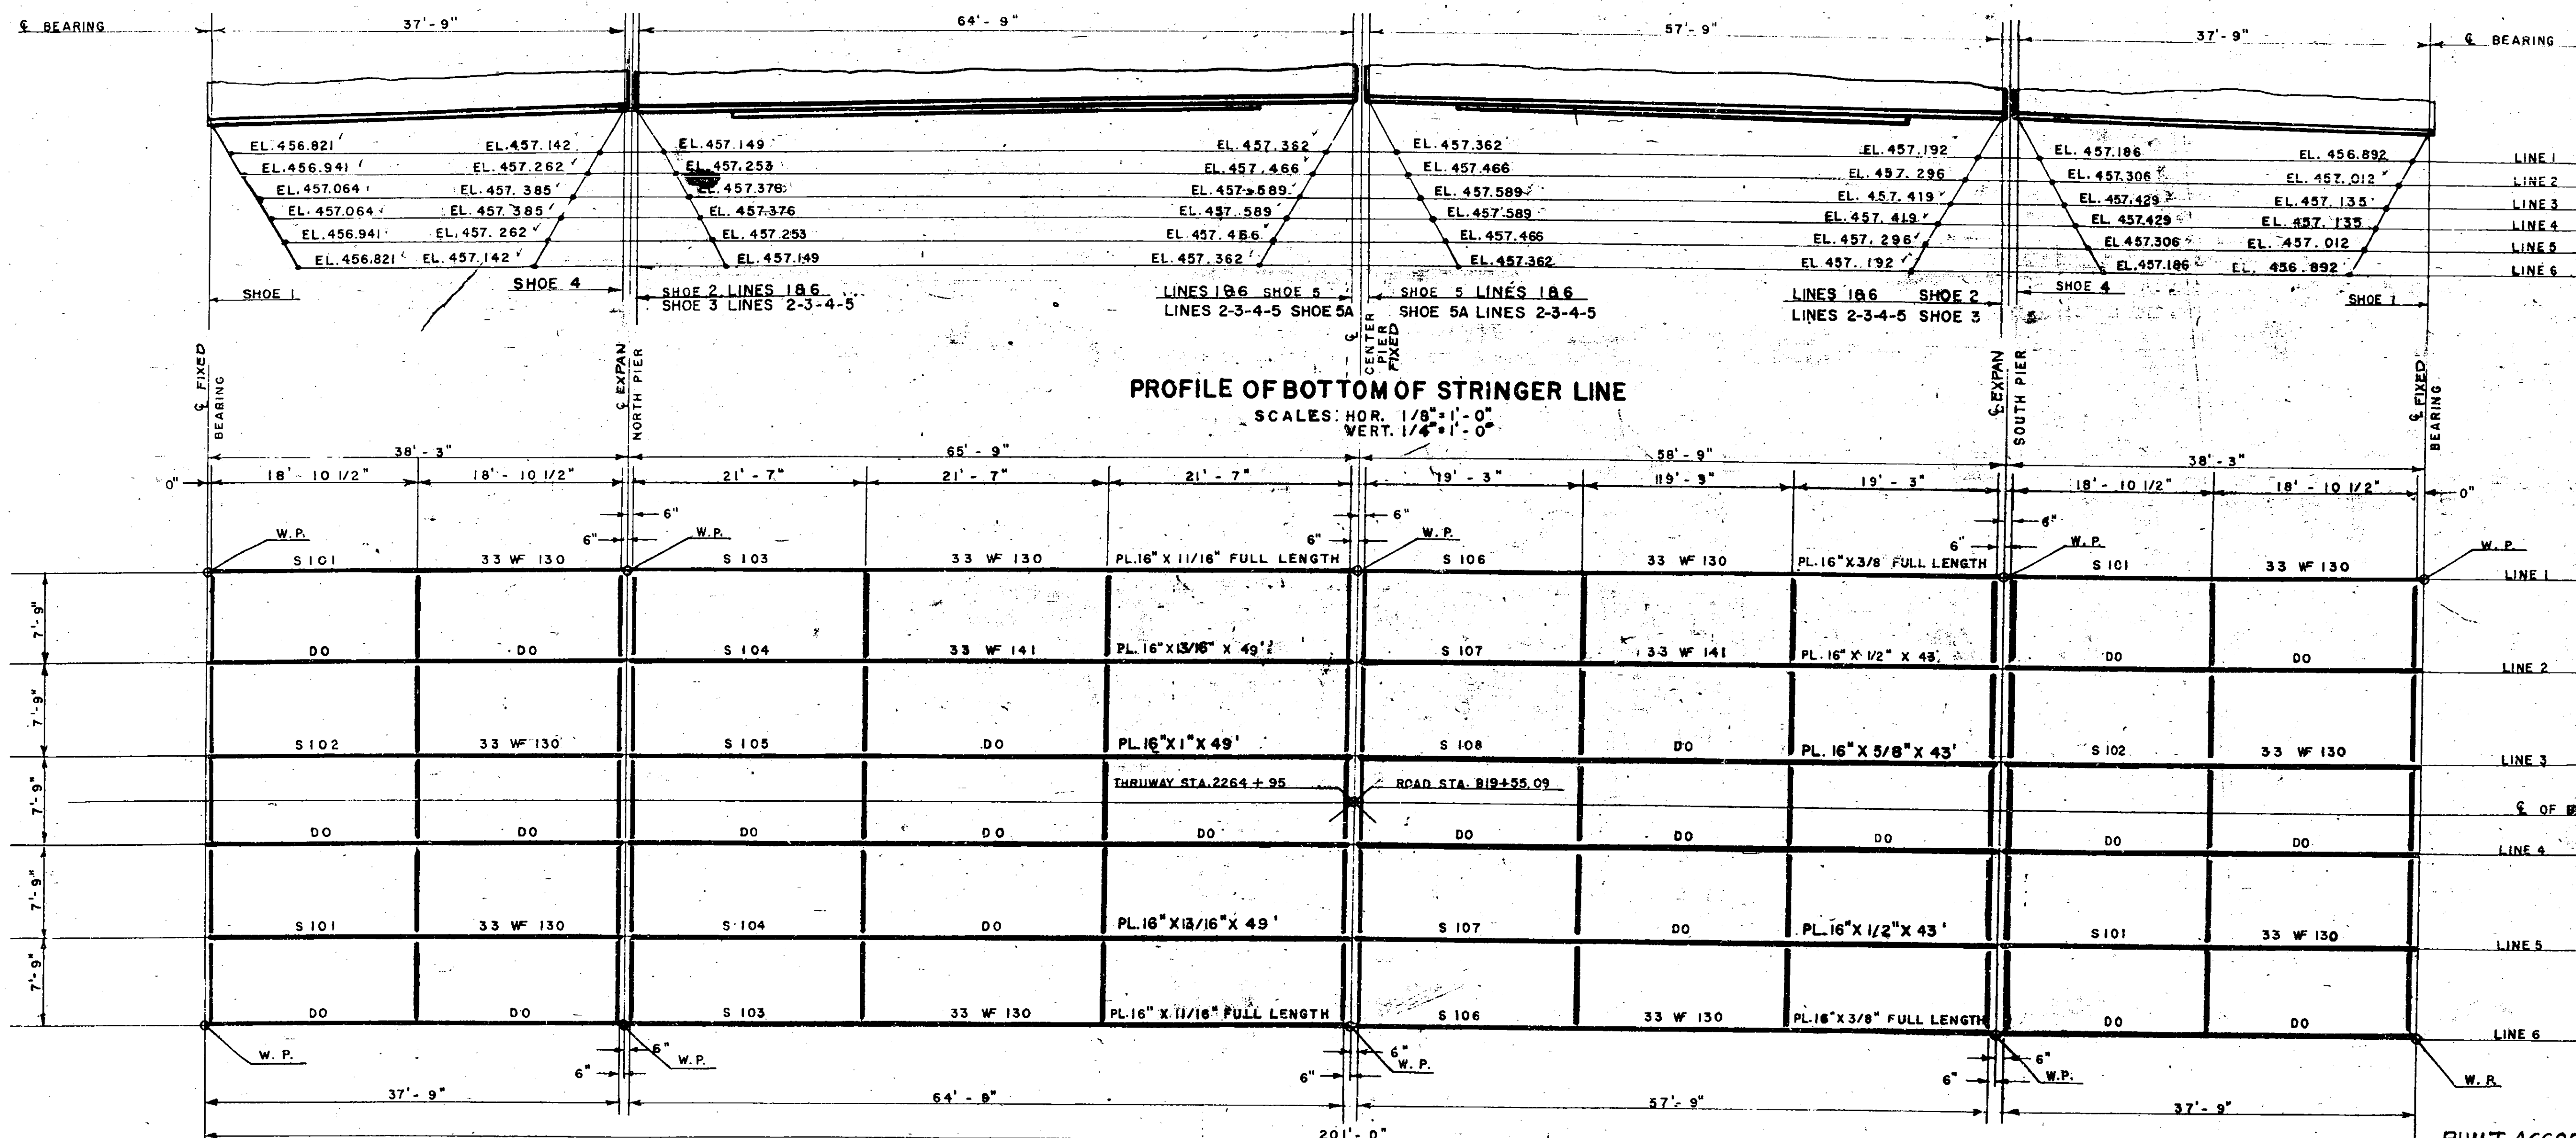



STEEL PLAN
SCALE: 1/8" = 1'-0"

BUILT ACCORDING TO PLAN.
SUPERSTRUCTURE DETAILS
NEW YORK STATE THRUWAY AND HOPKINS ROAD
TRAFFIC INTERCHANGE


PREPARED AND RECOMMENDED:

URQUHART & DOYLE, CONSULTING ENGINEERS
NEW YORK STATE PROFESSIONAL ENGINEERS LICENSE NO. 5667
DATE Feb 19-53


COUNTY	SHEET NO.	TOTAL SHEETS
ONONDAGA	17	66
N.Y. STATE THRUWAY-ONTARIO SECTION SUB DIV 8A		
INTERCHANGE AT ELECTRONICS PARKWAY (HOPKINS ROAD)		

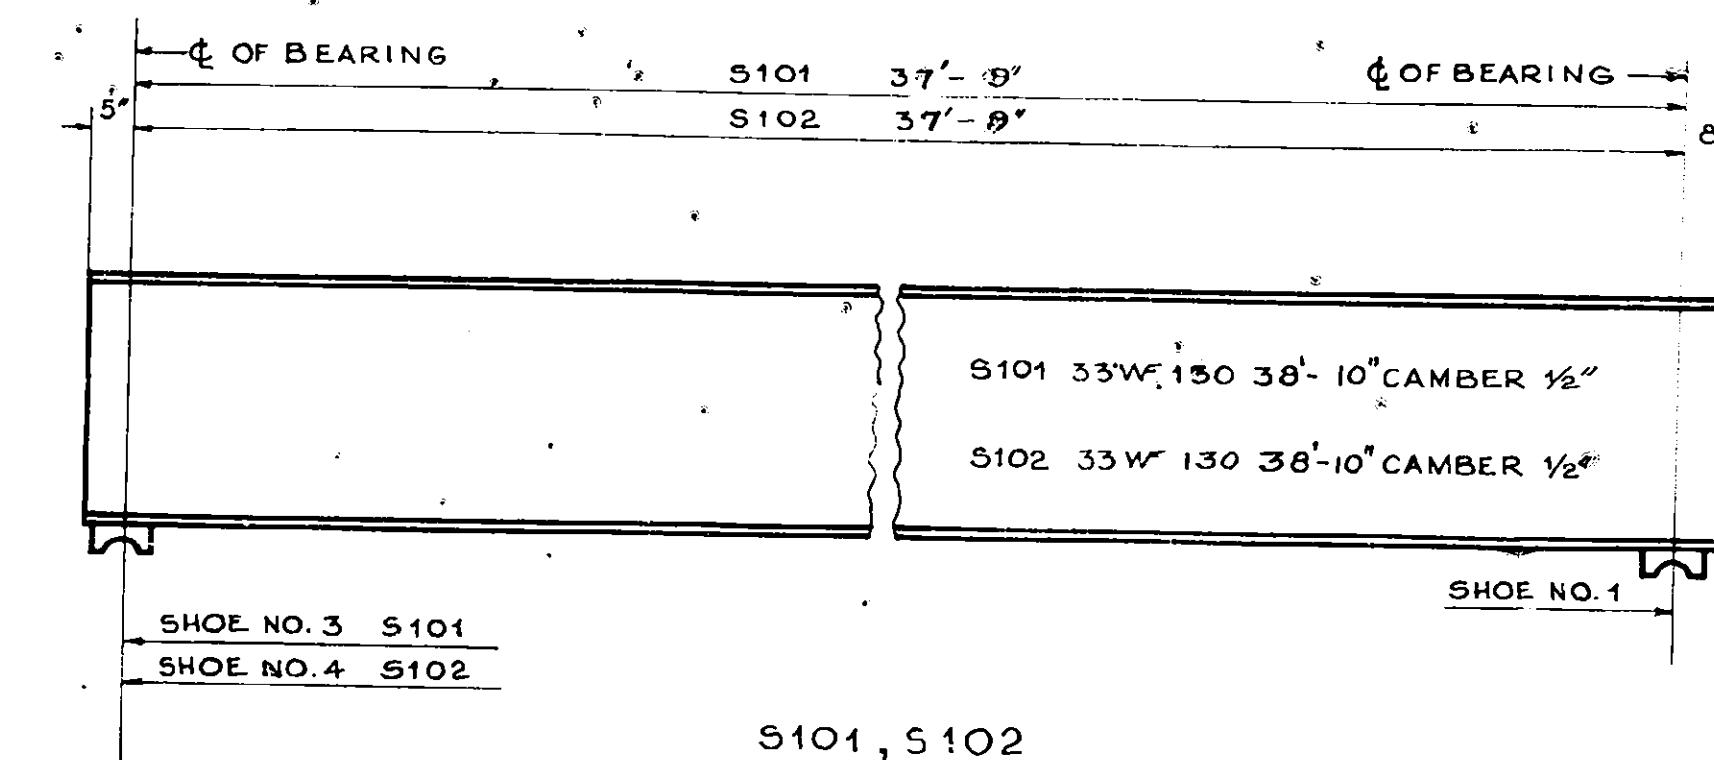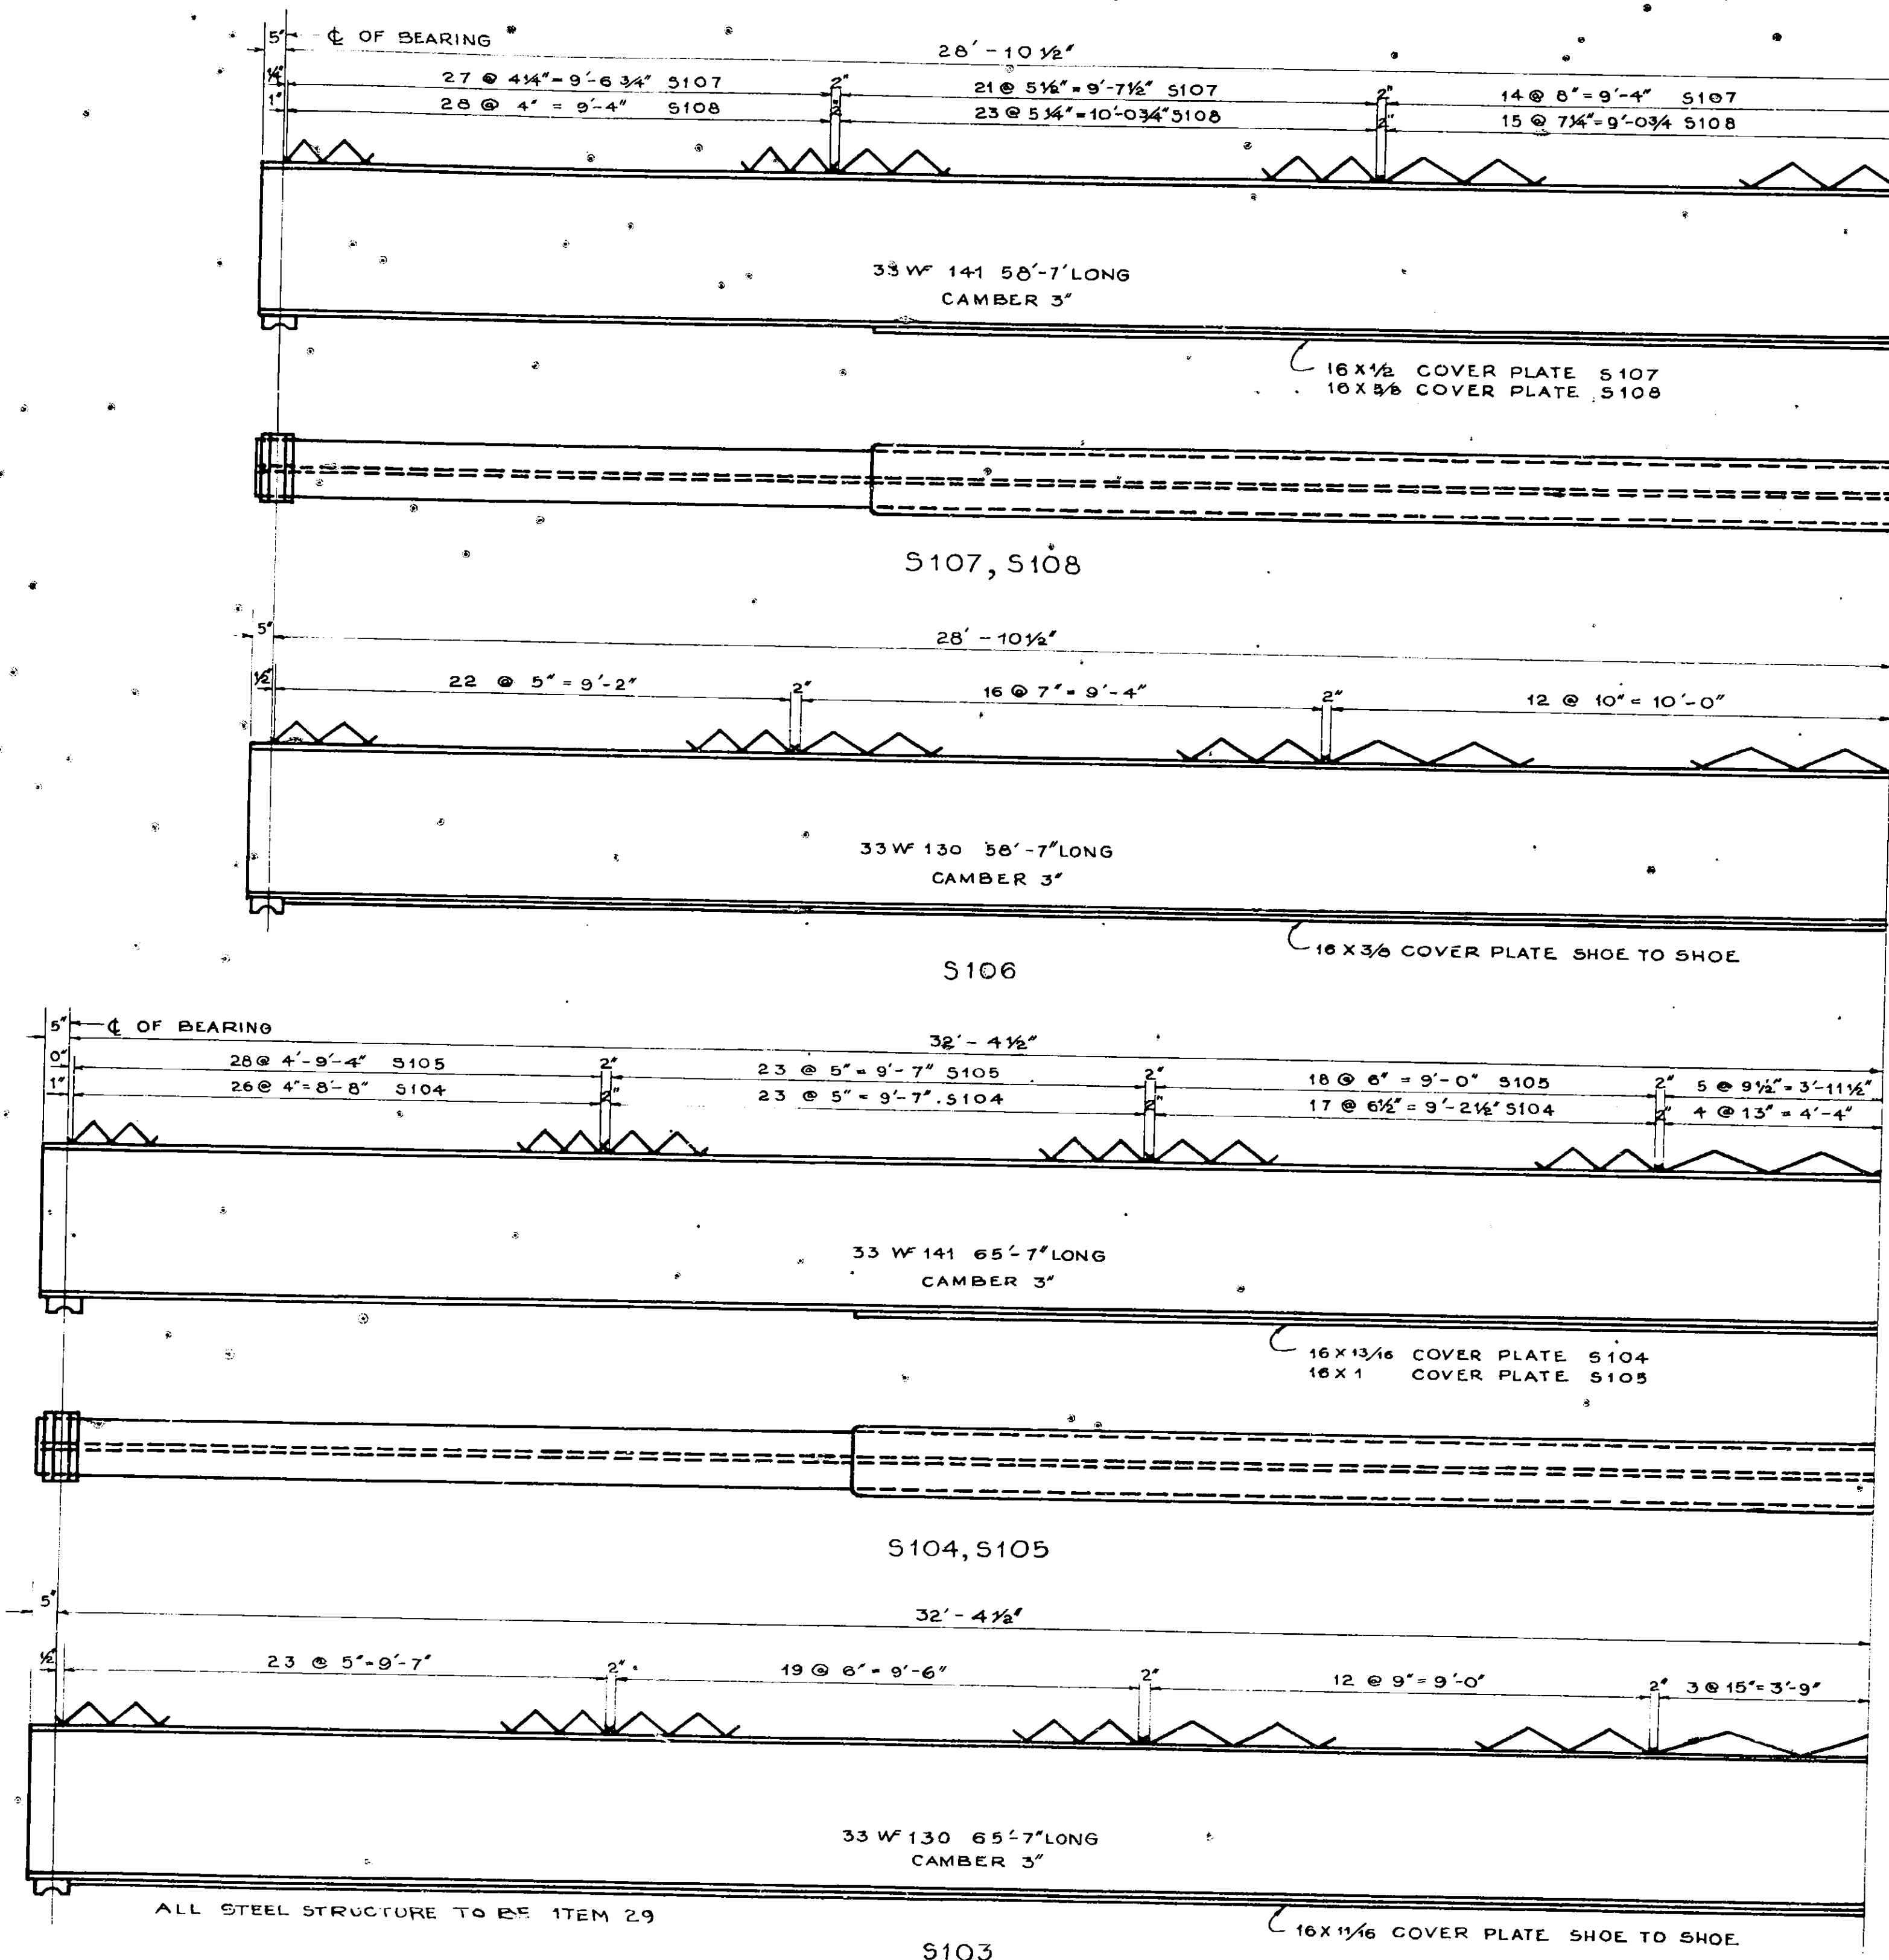


DO NOT PAINT SURFACE OF TOP FLANGE ON WHICH WELDS ARE MADE.

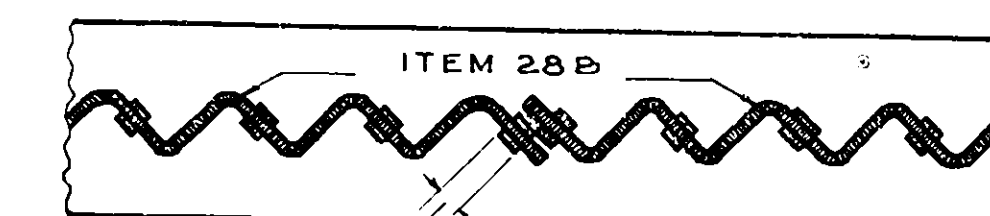

1/2" SPIRAL ROD 5/16" FILLET WELD 1 1/2" LONG ON EACH SIDE OF ROD.

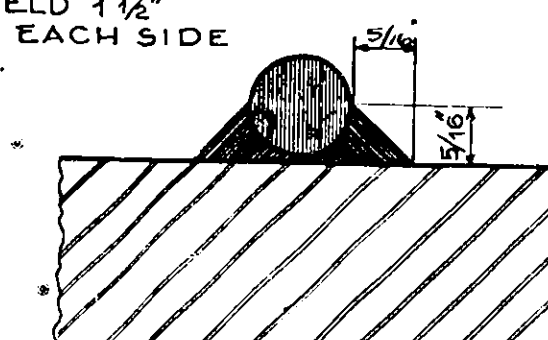

5" MEAN DIAMETER OF 1/2" SPIRALS

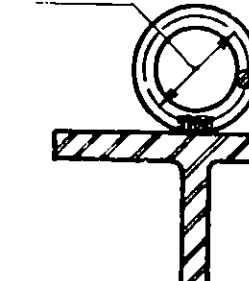

NOTE: EXTEND BAR 14" TURN BEYOND END WELDS OF UNIT.

SPIRAL DETAILS

NOT TO SCALE
ALL SPIRAL SHEAR BARS ARE ITEM 28B

SPECIAL NOTES FOR SPIRAL REINFORCEMENTS

THE CONTRACTOR'S AND ENGINEER'S ATTENTION IS CALLED TO THE POSSIBILITY OF INTERFERENCE BETWEEN THE REINFORCING STEEL IN THE SLAB AND THE BEAM SPIRALS. WHILE STEEL SPACING IS GIVEN AS 5 1/2 INCHES, IT IS TO BE UNDERSTOOD THAT 2 BARS IN EACH OFT. 11IN. WILL FULFILL THIS REQUIREMENT IF NO TWO BARS ARE CLOSER THAN 1" LESS THAN REQUIRED SPACING OR FURTHER APART THAN 1" MORE THAN REQUIRED SPACING. IF NECESSARY, SOME BARS MAY BE THREADED THRU ONE OR MORE SPIRALS. ALL SPIRALS MUST HAVE TWO STRUCTURAL WELDS 5/16" X 1 1/2" LONG, AT EACH SIDE OF THE BAR AS SHOWN. 5/32" OR 3/16" DIAMETER ELECTRODES SHALL BE USED IN WELDING THE SPIRAL BAR REINFORCEMENT. SPECIAL PRECAUTIONS MUST BE EXERCISED WHERE WELDING CROSSES EDGE OF FLANGE TO AVOID ANY POSSIBILITY OF UNDERCUT OR NICKS IN THE

NOTE:

ALL COVER PLATES TO BE WELDED WITH 5/16" CONTINUOUS FILLET WELDS.

SCALE: 1/2" = 1'-0"; EXCEPT AS SHOWN

FOR SHOE DETAILS SEE SHEET 19
FOR FRAMING PLAN SEE SHEET 16




PREPARED AND RECOMMENDED:

URQUHART & DOYLE, CONSULTING ENGINEERS
NEW YORK STATE PROFESSIONAL ENGINEERS LICENSE NO. 5667

DATE

SUPERSTRUCTURE DETAILS
NEW YORK STATE THRUWAY AND HOPKINS ROAD
TRAFFIC INTERCHANGE


INTERCHANGE AT ELECTRONICS PARKWAY (HOPKINS ROAD)

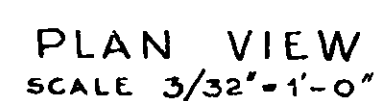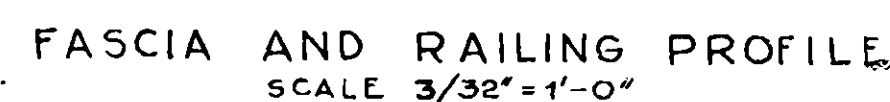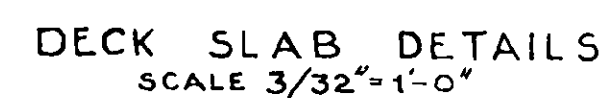

SUPERSTRUCTURE DETAILS
NEW YORK STATE THRUWAY AND HOPKINS ROAD
TRAFFIC INTERCHANGE

URQUHART & DOYLE, CONSULTING ENGINEERS
NEW YORK STATE PROFESSIONAL ENGINEERS LICENSE NO. 5667[®] DATE


COUNTY	SHEET NO.	TOTAL SHEETS
ONONDAGA	19	66
N. Y. STATE THRUWAY ONTARIO SECTION SUBDIV. 8A		
INTERCHANGE AT ELECTRONICS PARKWAY (HOPKINS ROAD)		

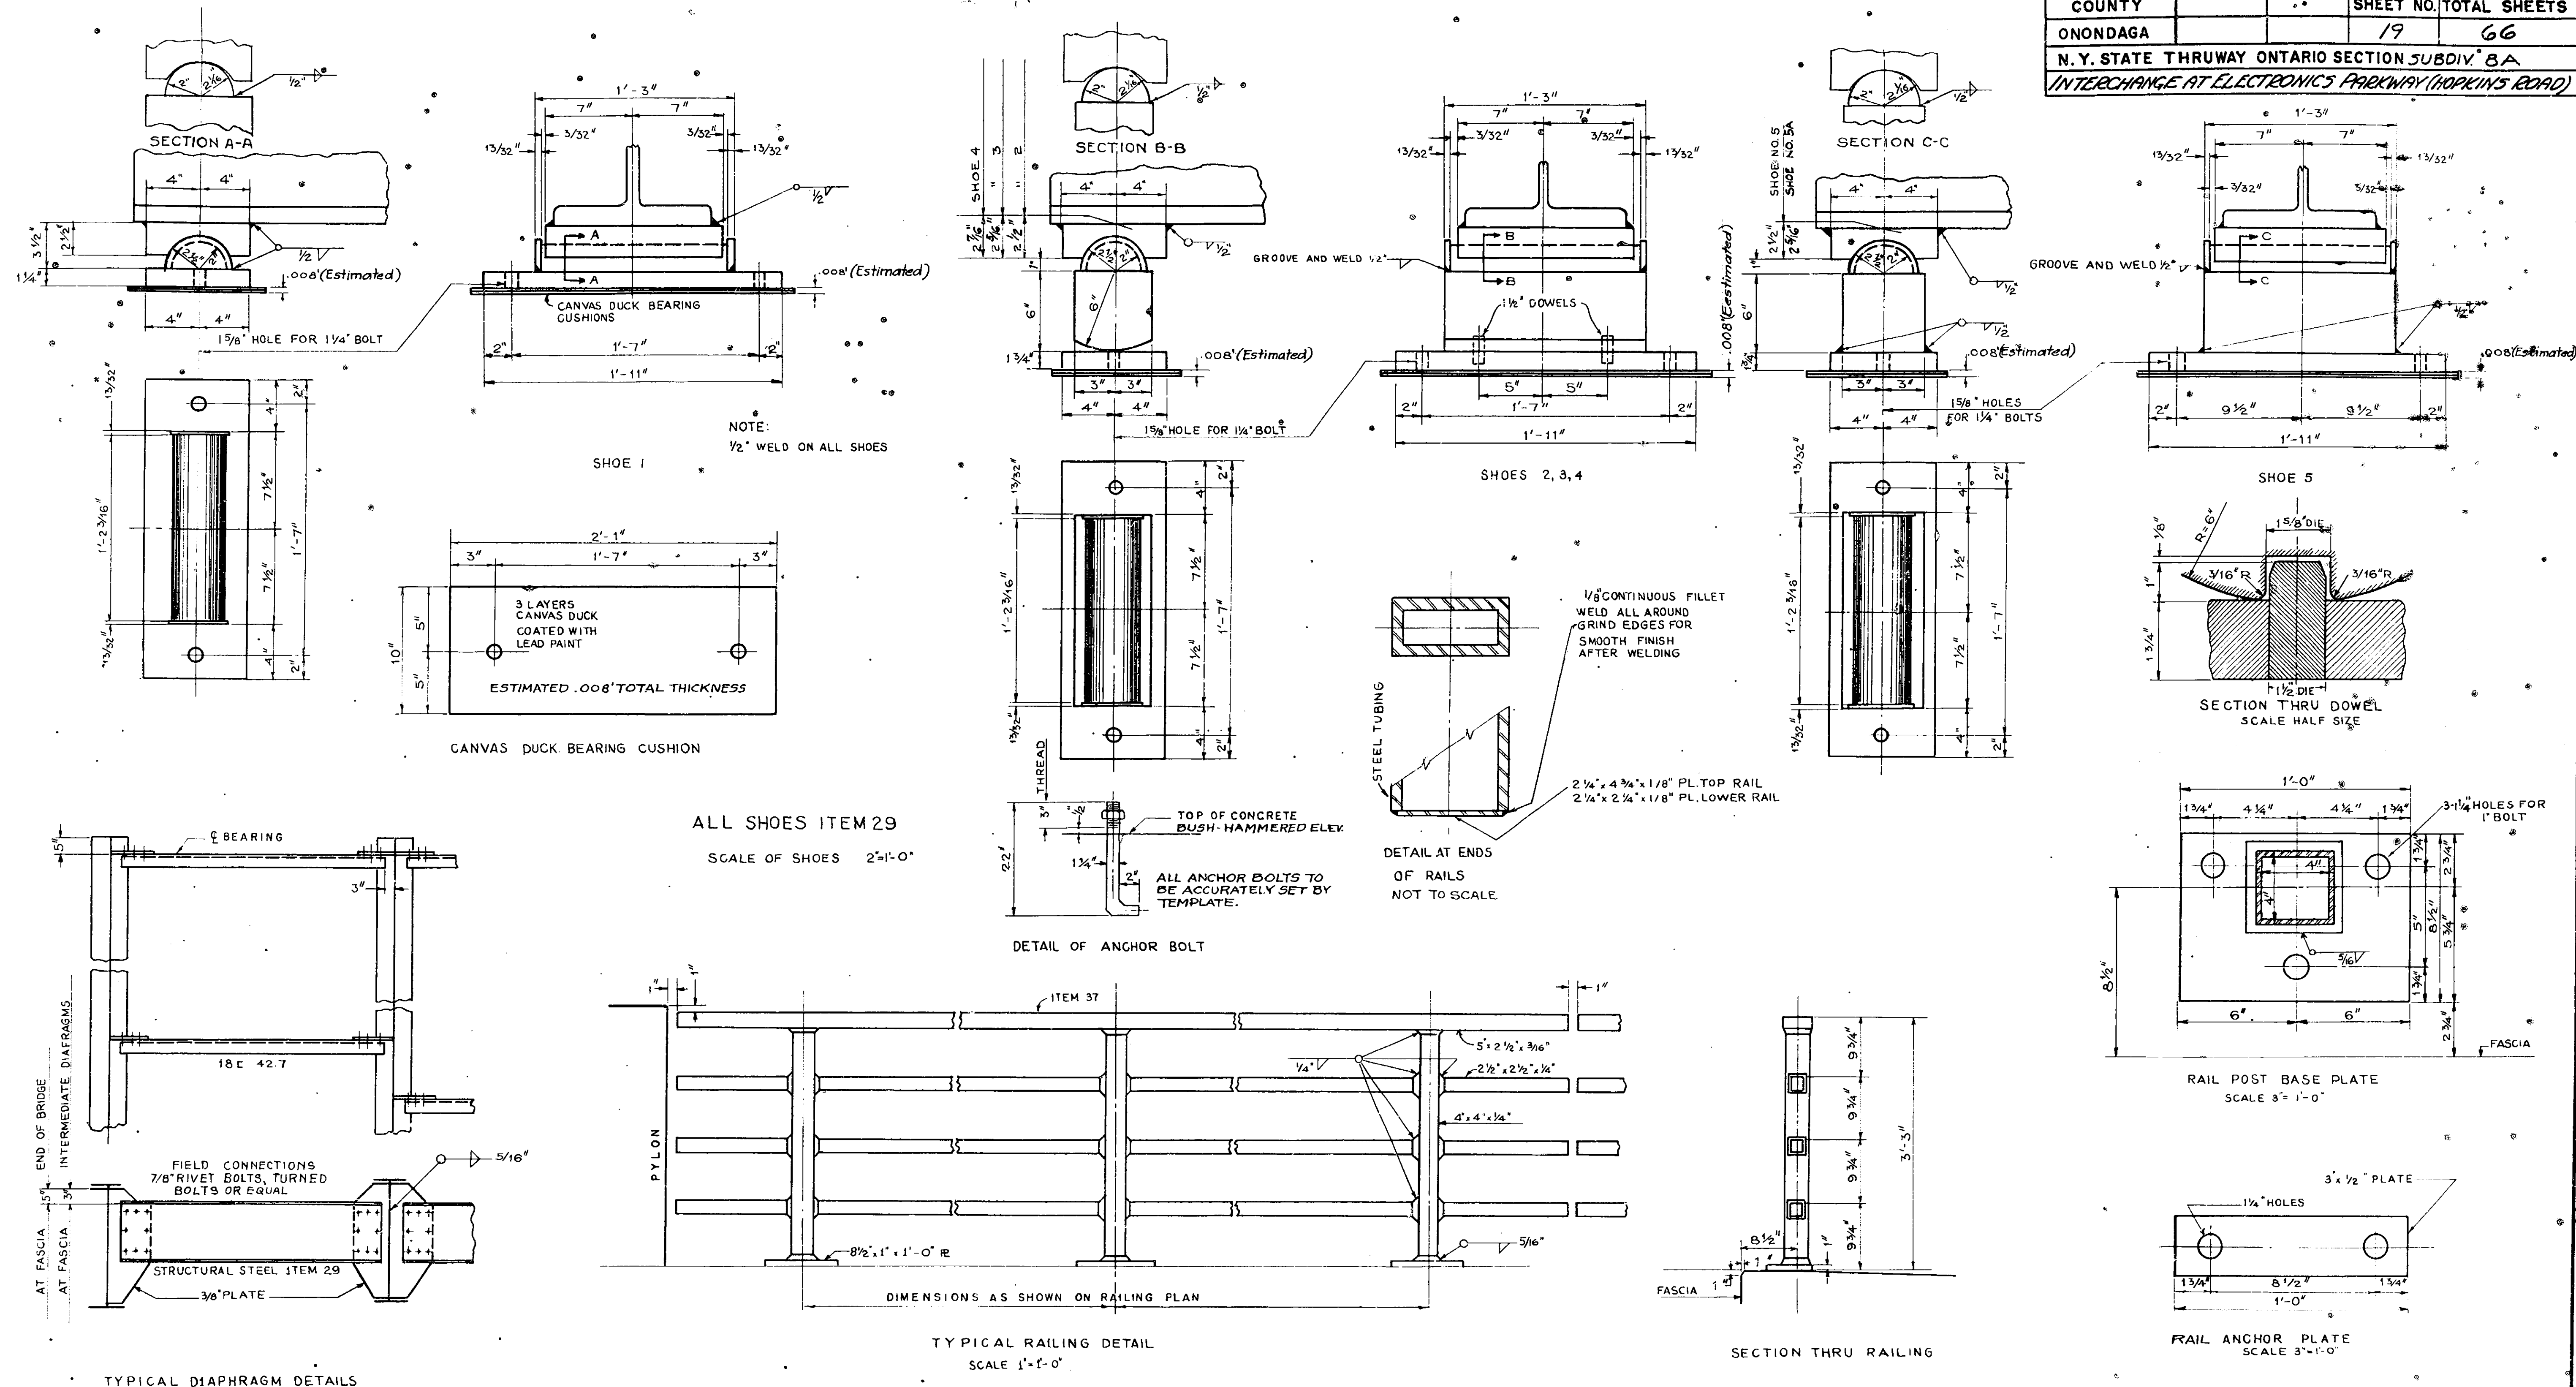

SUPERSTRUCTURE DETAILS
NEW YORK STATE THRUWAY AND HOPKINS ROAD
TRAFFIC INTERCHANGE

PREPARED AND RECOMMENDED: *E. J. Doyle* Feb 16-53
URQUHART & DOYLE CONSULTING ENGINEERS
NEW YORK STATE PROFESSIONAL ENGINEERS LICENSE NO. 5667


COUNTY	SHEET NO.	TOTAL SHEETS
ONONDAGA	20	66
N.Y. STATE THRUWAY-ONTARIO SECTION SUB DIV. 8A		
INTERCHANGE AT ELECTRONICS PARKWAY (HOPKINS ROAD)		

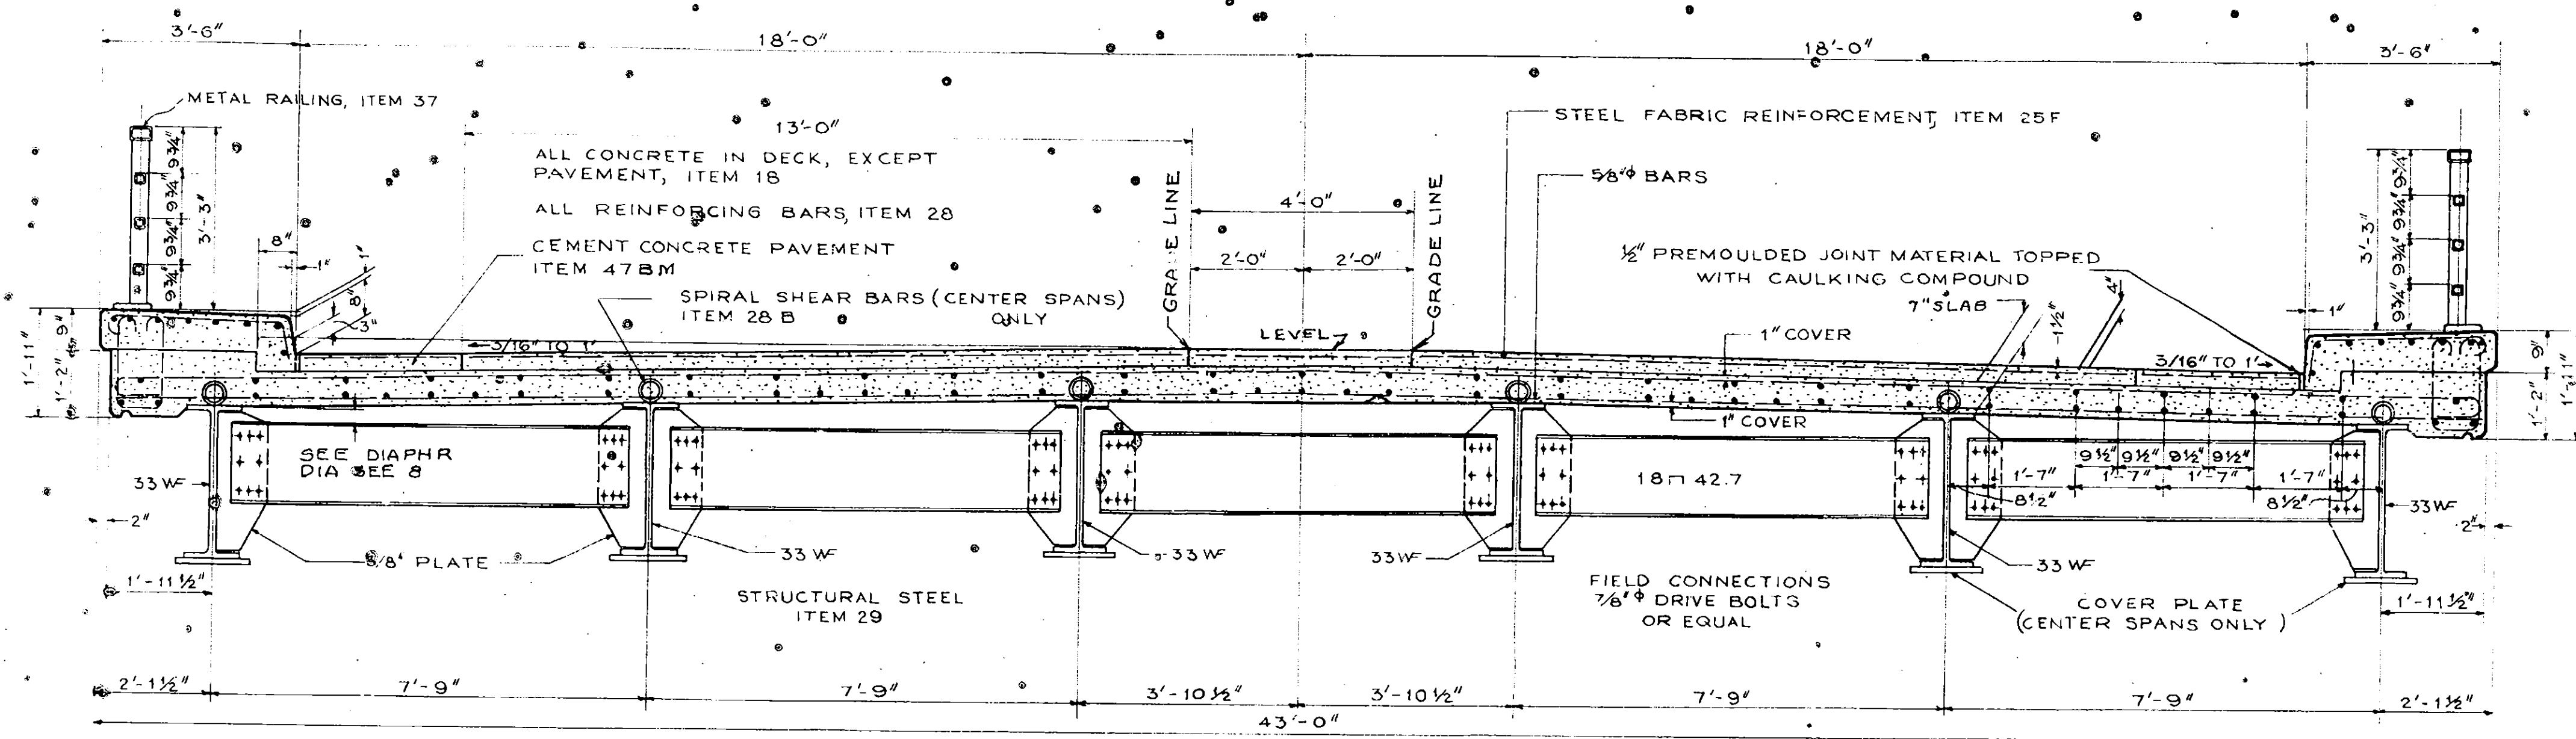

TRANSVERSE SECTION
SCALE 1/2" = 1'-0"

NOTE:
IMMEDIATELY BEFORE PLACING CONCRETE PAVEMENT, THE CONCRETE SURFACE OR SURFACES UPON WHICH IT IS TO BE PLACED SHALL BE THOROUGHLY WETTED DOWN CONTINUOUSLY FOR ONE HOUR IF THE AIR TEMPERATURE IS ABOVE 50°F. COST OF SAME TO BE UNDER


CEMENT IN ITEM 47BM TO BE PORTLAND CEMENT TYPE 1A, ITEM 15-BA
CEMENT IN ITEMS 18 & 19 TO BE 7 PARTS PORTLAND CEMENT TYPE 2, ITEM 15-2 AND ONE PART NATURAL CEMENT TYPE N- ITEM 15N.

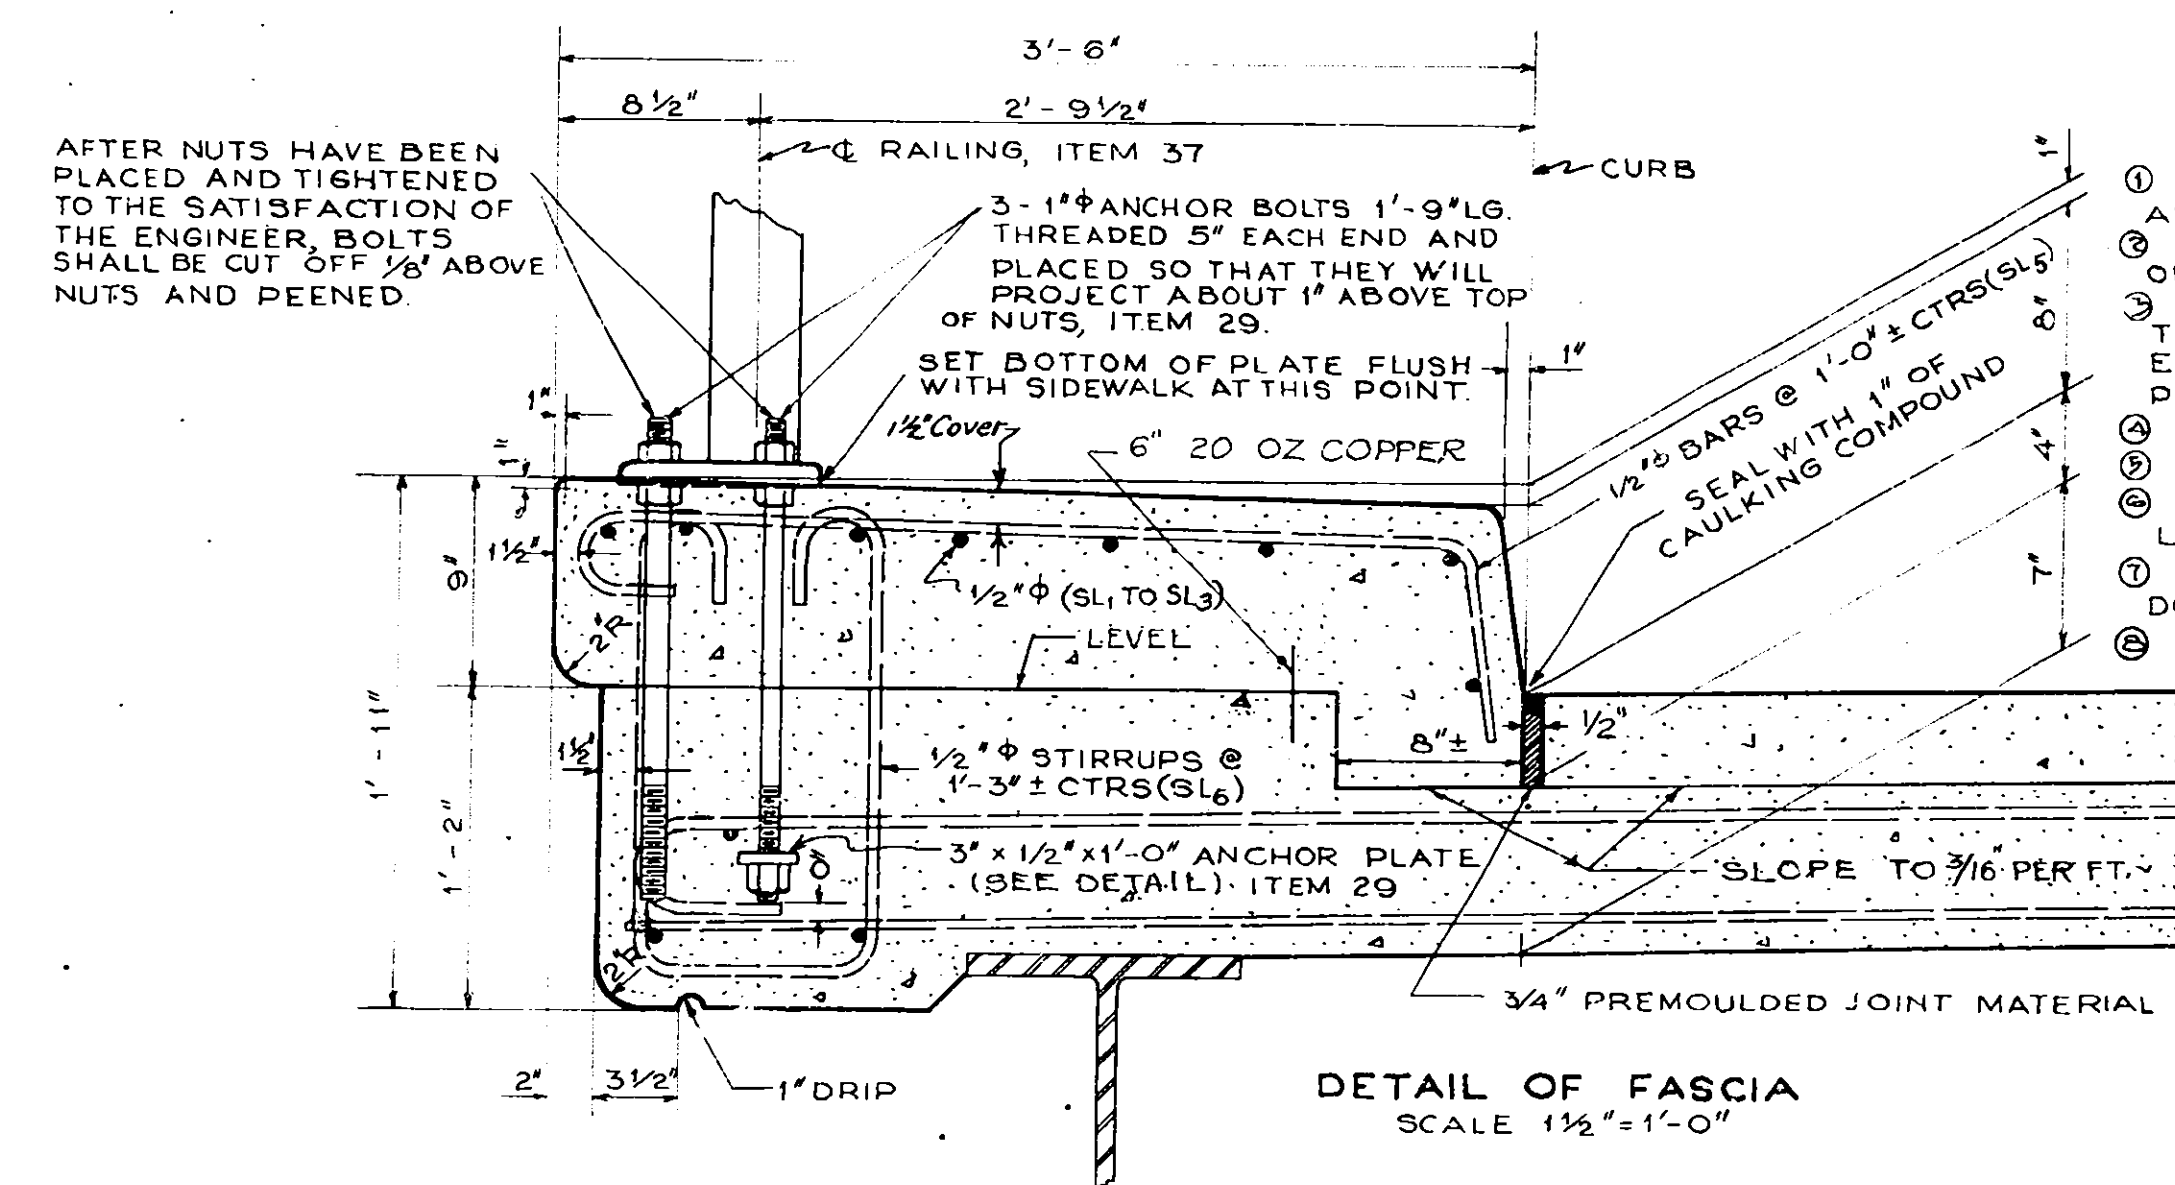

DETAIL OF FASCIA
SCALE 1 1/2" = 1'-0"


CONSTRUCTION PROCEDURE

1. SET ANCHOR BOLTS BY MEANS OF TEMPLATE AND POUR SLAB.
2. MAKE TWO APPLICATIONS OF WATER-PROOFING OIL TREATMENT M41-W TO TOP OF SLAB.
3. THE TOP OF THE SLAB SHALL BE CONTINUOUSLY AND THOROUGHLY WETTED DOWN, AS DIRECTED BY THE ENGINEER FOR AT LEAST ONE HOUR, IMMEDIATELY PRIOR TO THE PLACING OF THE ROADWAY PAVEMENT.
4. POUR ROADWAY PAVEMENT.
5. PLACE LOWER NUTS ON UPPER END OF ANCHOR BOLTS
6. PLACE RAILING ON LOWER NUTS AND ADJUST TO LINE AND GRADE.
7. PLACE UPPER NUTS ON ANCHOR BOLTS TO TIGHTEN DOWN ON PLATES
8. POUR SIDEWALK TO PROPER LINE AND GRADE.

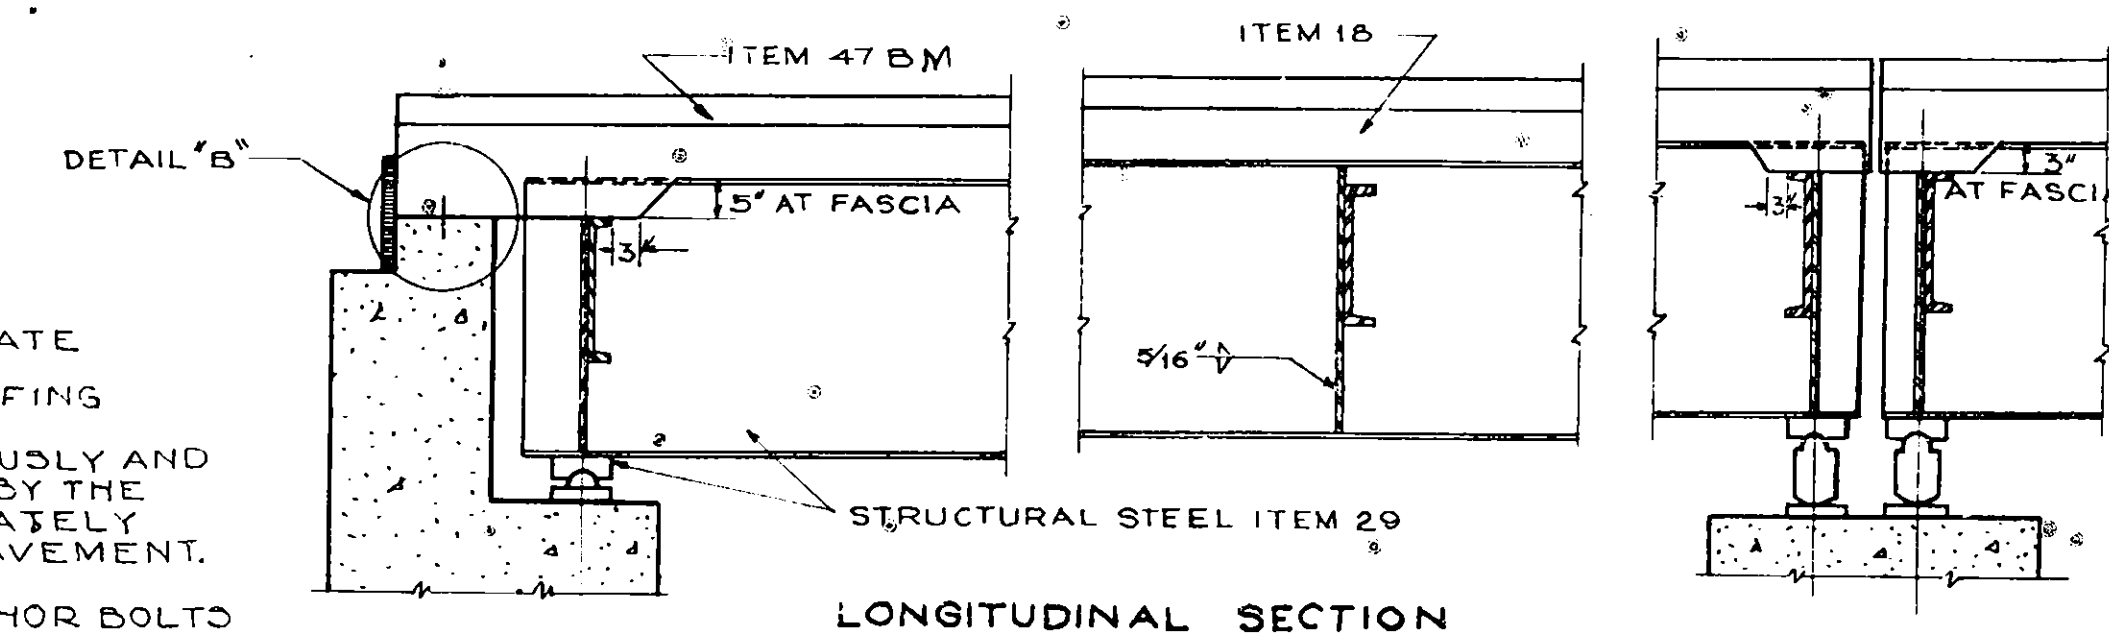


LONGITUDINAL SECTION
SCALE 1/2" = 1'-0"

NOTE:
ALL DIAPHRAGMS SET LEVEL INTERMEDIATE DIAPHRAGMS PERPENDICULAR TO GIRDERS WITH TOPS 3" BELOW TOP OF FASCIA GIRDERS TOPS OF END DIAPHRAGMS 5" BELOW TOP OF FASCIA GIRDERS.

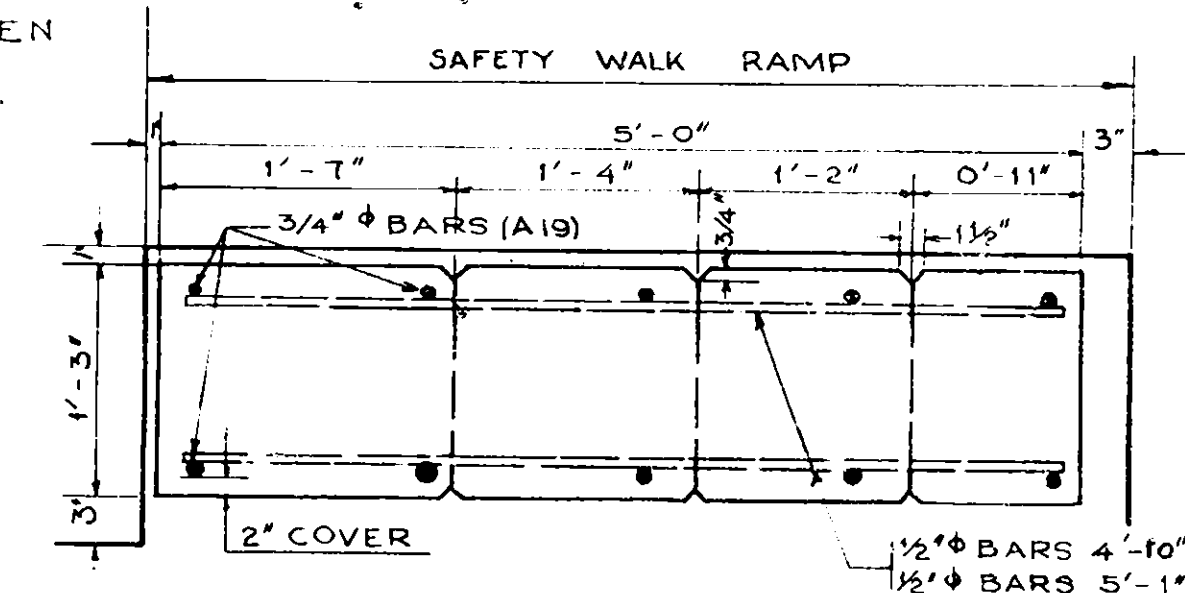


PLAN
SCALE 1" = 1'-0"

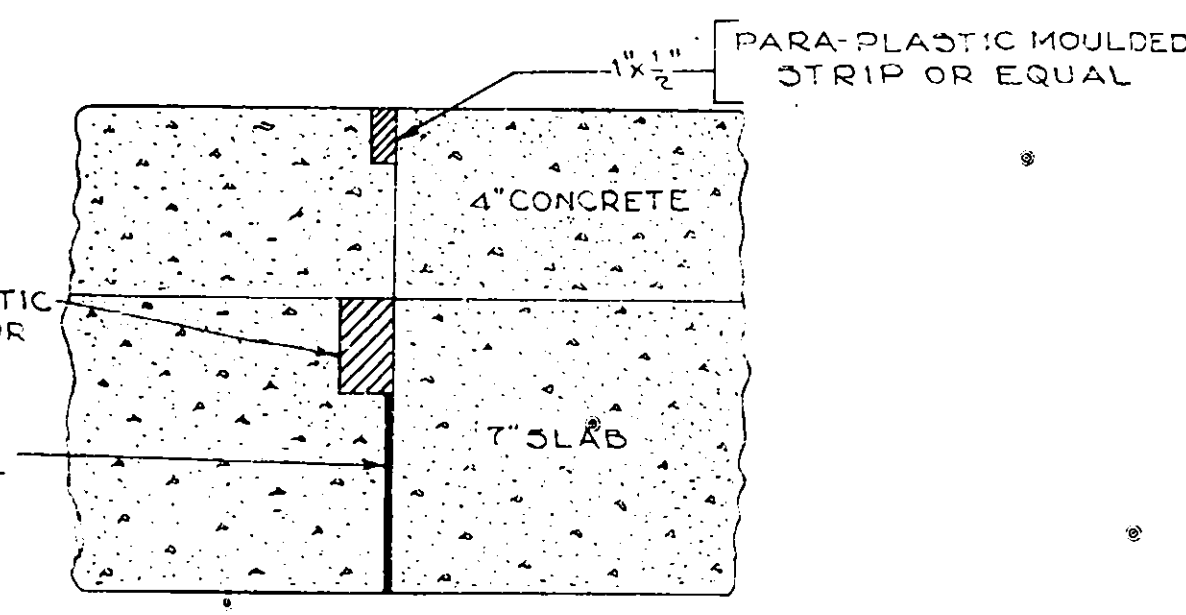


DETAIL OF JOINT OVER CENTER PIER
SCALE 3" = 1'-0"

NOTE:
FLASHINGS OR WATERSTOPS ARE TO BE PROTECTED FROM DAMAGE DURING THE COURSE OF CONSTRUCTION AS ORDERED BY THE ENGINEER. BENDING OR ALTERING THE SHAPE AS SHOWN IN ANY MANNER WILL NOT BE ALLOWED.

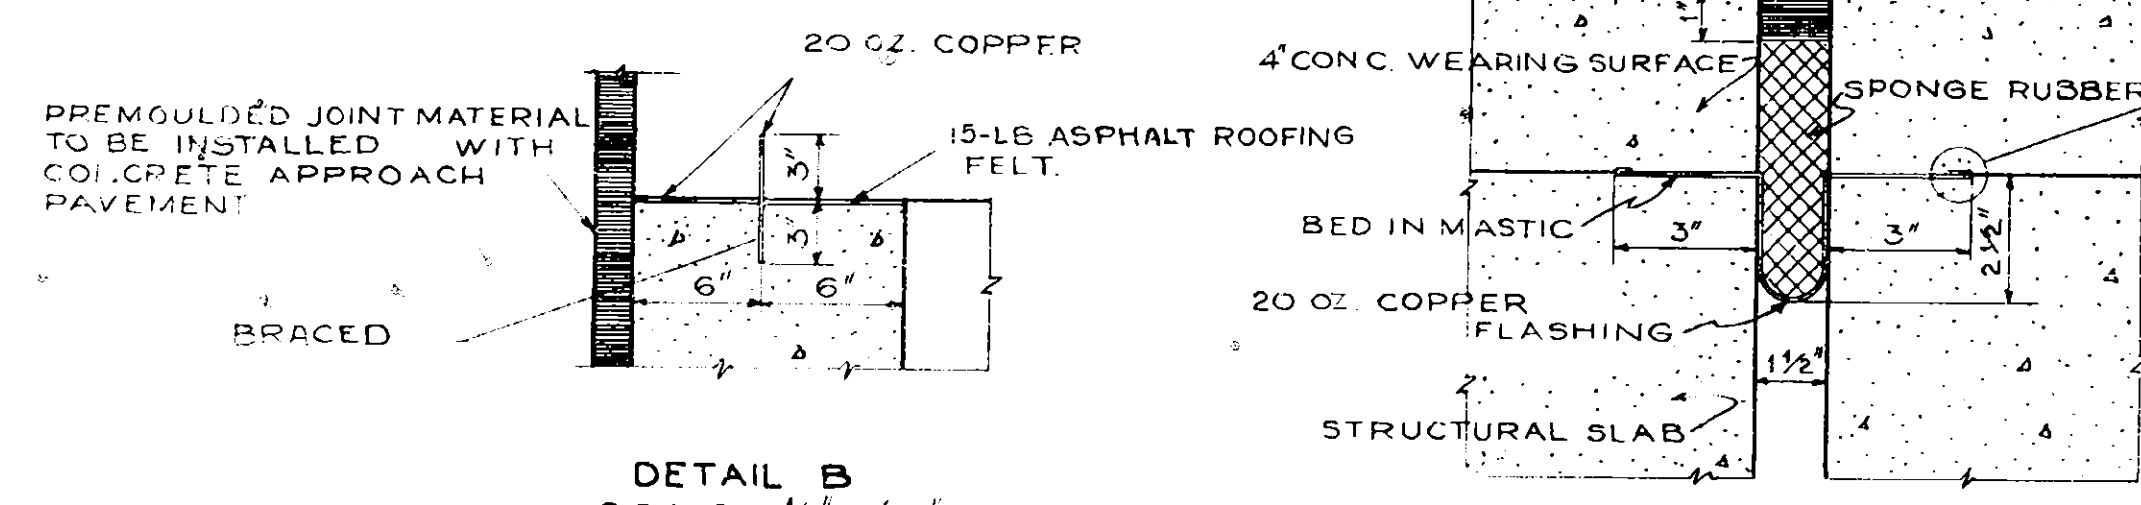


DETAIL B
SCALE 1 1/2" = 1'-0"

DETAIL OF JOINT OVER N-S PIERS
SCALE 3" = 1'-0"

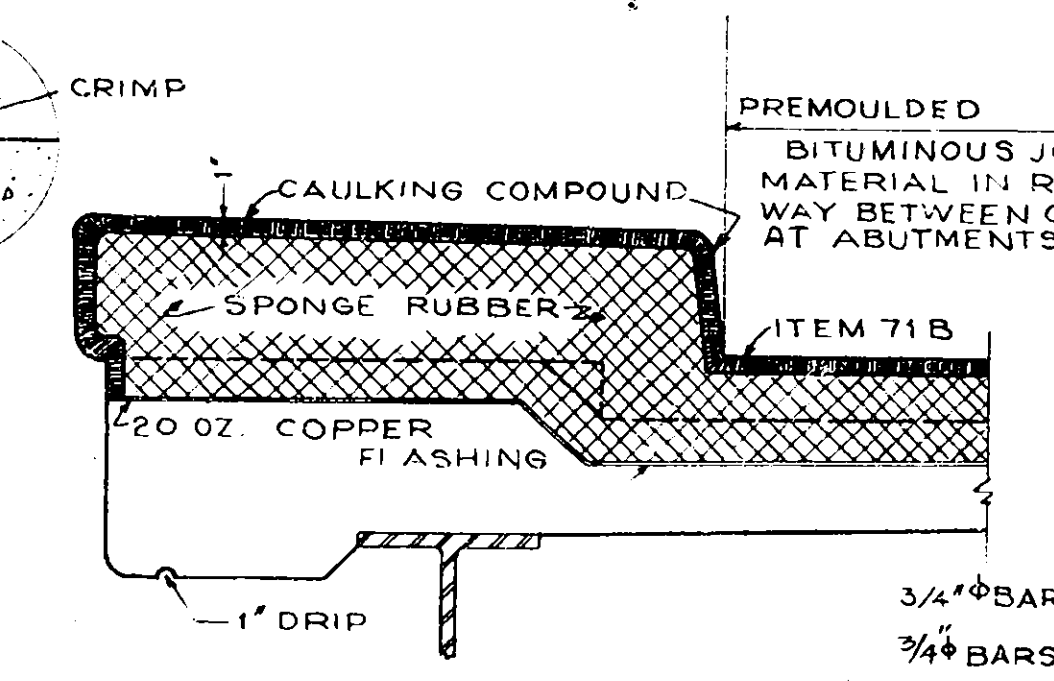

SECTION THRU SAFETY WALK AT JOINT
SCALE 1" = 1'-0"

NOTE:
SPONGE RUBBER SHALL COMPLY WITH THE REQUIREMENTS FOR PREFORMED EXPANSION JOINT FILLERS FOR CONCRETE, A.S.T.M. DESIGNATION D 544.
ASPHALT ROOFING FELT SHALL COMPLY WITH THE REQUIREMENTS OF THE STANDARD SPECIFICATIONS OF A.S.T.M. DESIGNATION D 2266.

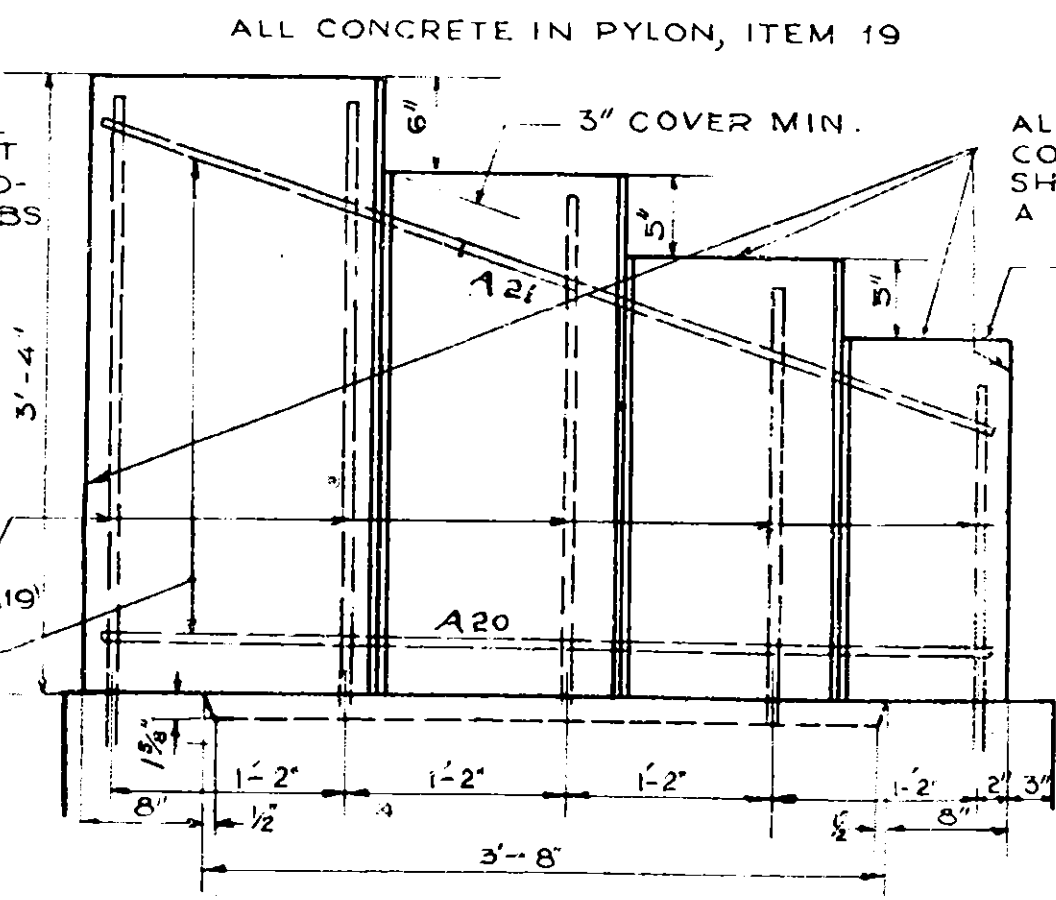

ELEVATION OF PYLON
SCALE 1" = 1'-0"

ALL UNCHAMFERED CORNERS OF PYLONS SHALL BE RUBBED TO A 1/4" RADIUS.
TOP SURFACE OF PYLONS SHALL BE PLACED PARALLEL TO GRADE.


SUPERSTRUCTURE DETAILS

NEW YORK STATE THRUWAY AND HOPKINS ROAD
TRAFFIC INTERCHANGE

PREPARED AND RECOMMENDED:

JOHN HART & DOYLE, CONSULTING ENGINEERS
NEW YORK STATE PROFESSIONAL ENGINEERS LICENSE NO. 5667
DATE Feb 19-53


20R

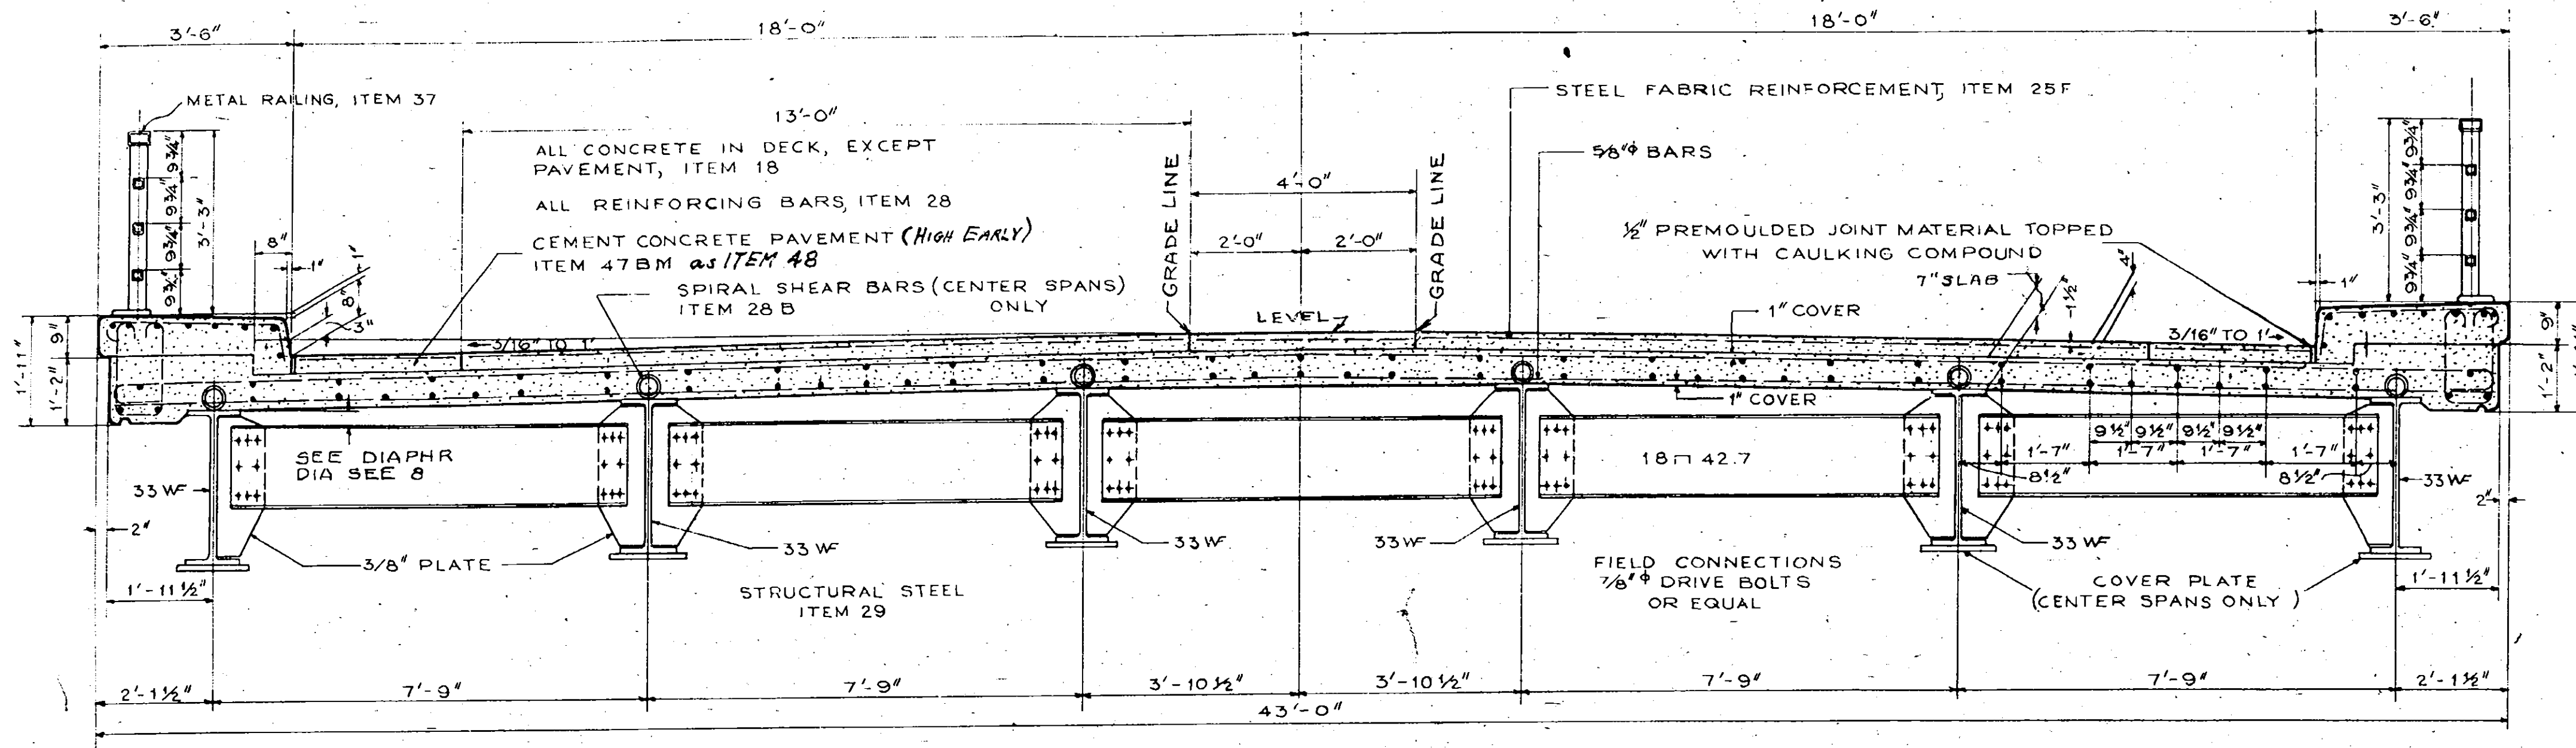

TRANSVERSE SECTION
SCALE 1/2" = 1'-0"

NOTE:
IMMEDIATELY BEFORE PLACING CONCRETE PAVEMENT, THE CONCRETE SURFACE OR SURFACES UPON WHICH IT IS TO BE PLACED SHALL BE THOROUGHLY WETTED DOWN CONTINUOUSLY FOR ONE HOUR IF THE AIR TEMPERATURE IS ABOVE 50°F. COST OF SAME TO BE UNDER


CEMENT IN ITEM 47 BM TO BE PORTLAND CEMENT TYPE 1A, ITEM 13-BA
CEMENT IN ITEMS 18 & 19 TO BE 7 PARTS PORTLAND CEMENT, TYPE 2, ITEM 13-2 AND ONE PART NATURAL CEMENT TYPE N - ITEM 13N.

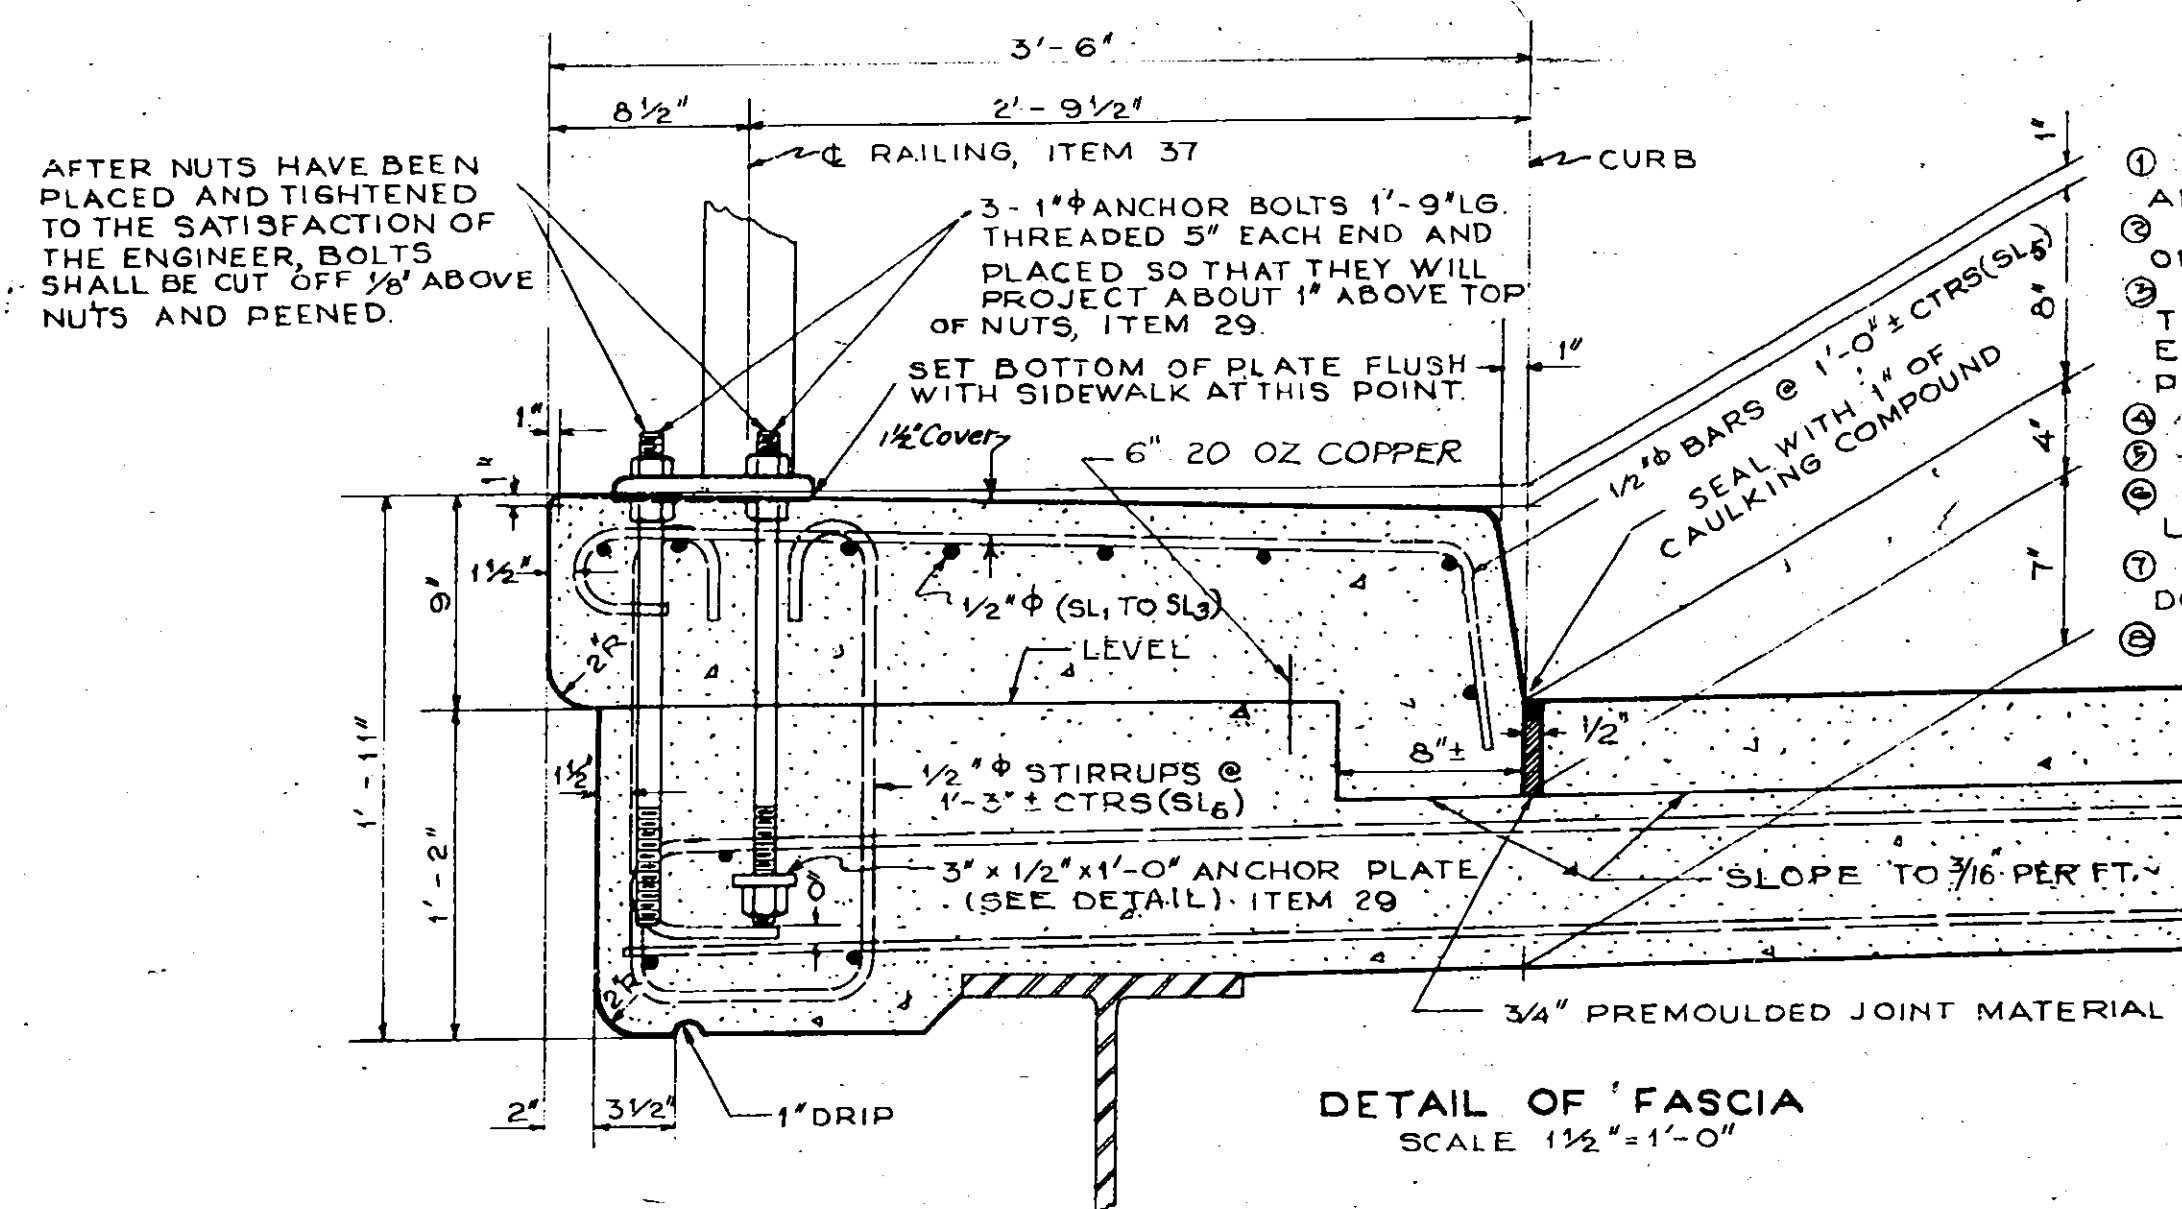

DETAIL OF FASCIA
SCALE 1 1/2" = 1'-0"


CONSTRUCTION PROCEDURE

1. SET ANCHOR-BOLTS BY MEANS OF TEMPLATE AND POUR SLAB.
2. MAKE TWO APPLICATIONS OF WATER-PROOFING OIL TREATMENT M-41-W TO TOP OF SLAB.
3. THE TOP OF THE SLAB SHALL BE CONTINUOUSLY AND THOROUGHLY WETTED DOWN, AS DIRECTED BY THE ENGINEER FOR AT LEAST ONE HOUR, IMMEDIATELY PRIOR TO THE PLACING OF THE ROADWAY PAVEMENT.
4. POUR ROADWAY PAVEMENT.
5. PLACE LOWER NUTS ON UPPER END OF ANCHOR BOLTS.
6. PLACE RAILING ON LOWER NUTS AND ADJUST TO LINE AND GRADE.
7. PLACE UPPER NUTS ON ANCHOR BOLTS TIGHTEN DOWN ON PLATES.
8. POUR SIDEWALK TO PROPER LINE AND GRADE.

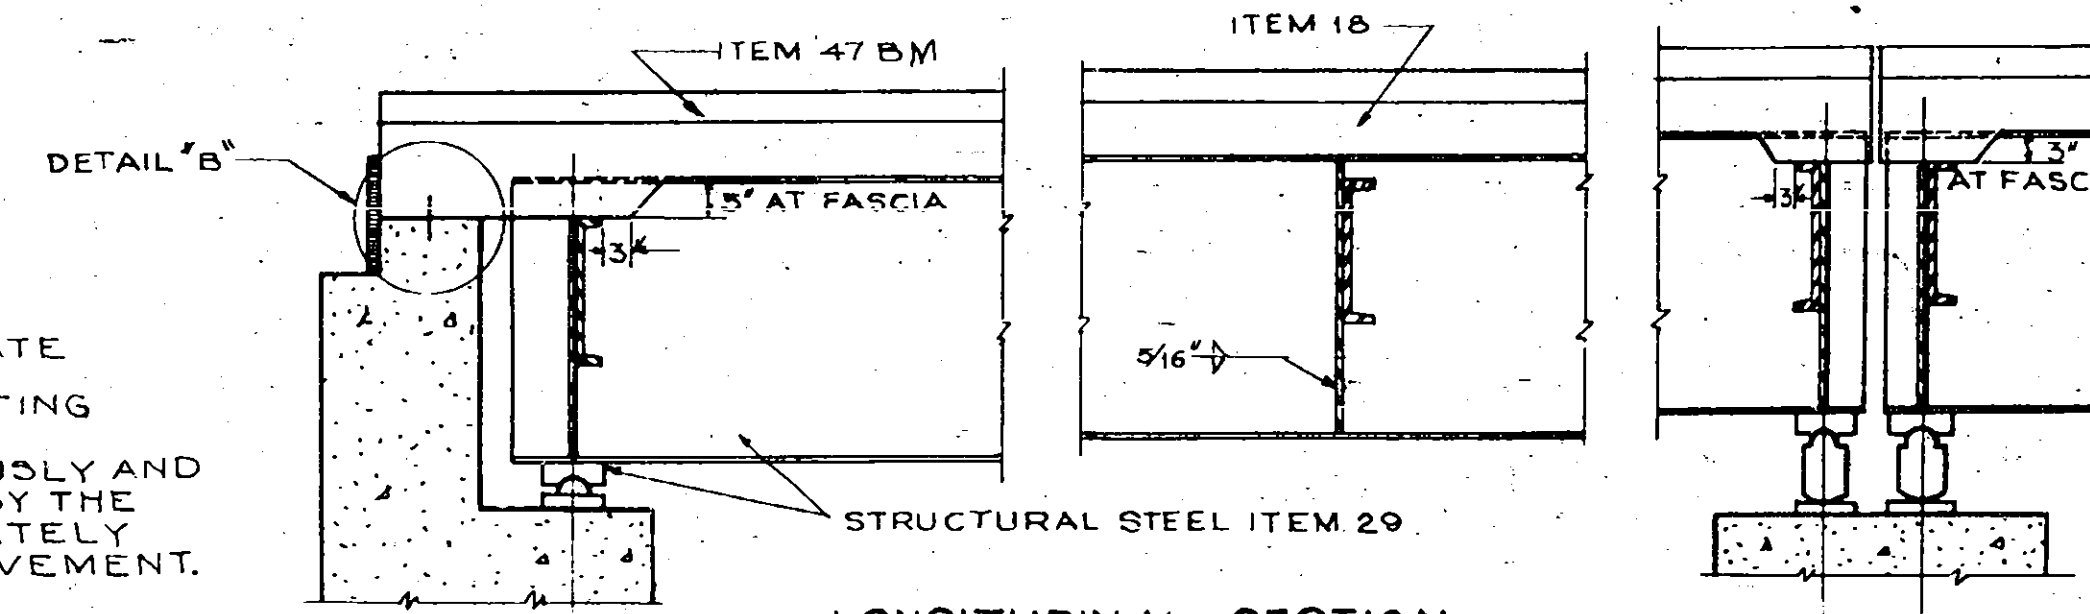


LONGITUDINAL SECTION
SCALE 1/2" = 1'-0"

NOTE:
ALL DIAPHRAGMS SET LEVEL INTERMEDIATE DIAPHRAGMS PERPENDICULAR TO GIRDERS WITH TOPS 3" BELOW TOP OF FASCIA GIRDERS. TOPS OF END DIAPHRAGMS 5" BELOW TOP OF FASCIA GIRDERS.

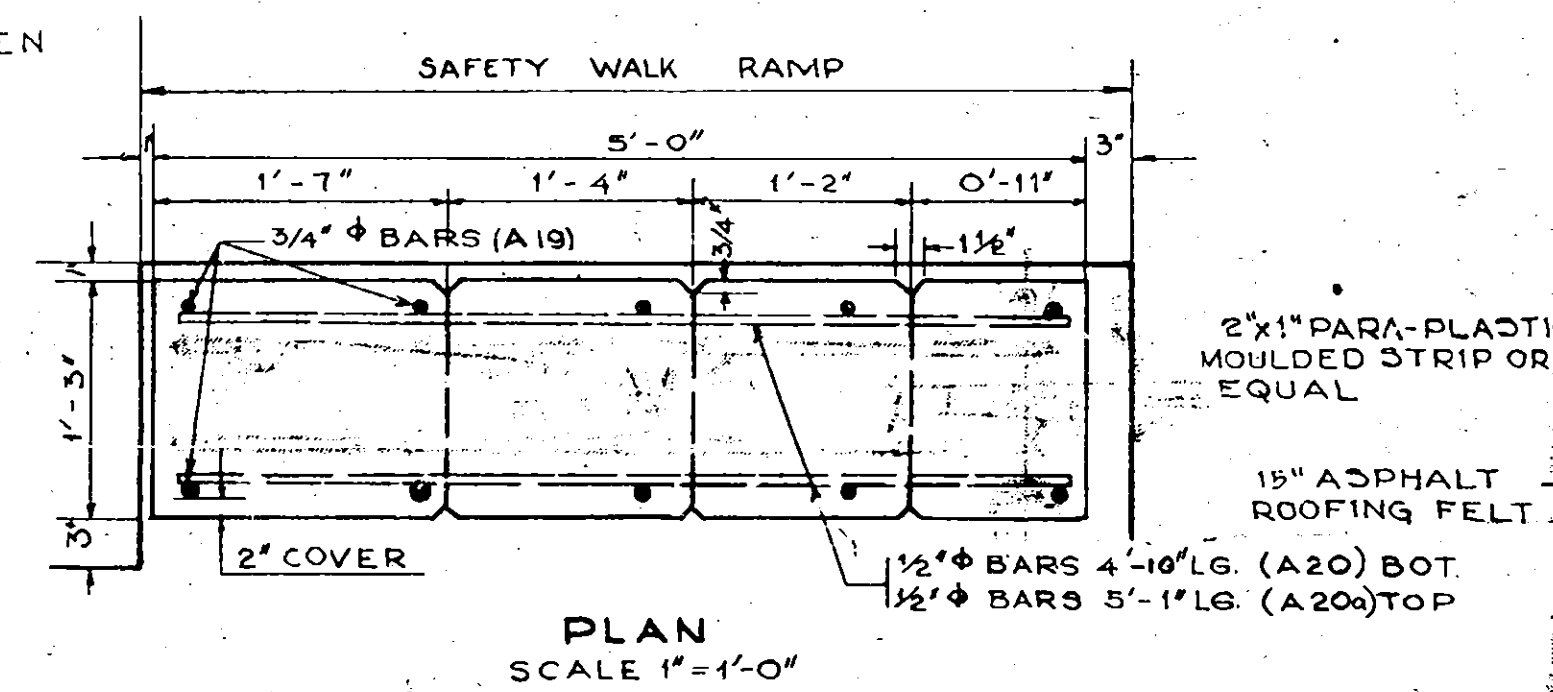


PLAN
SCALE 1" = 1'-0"

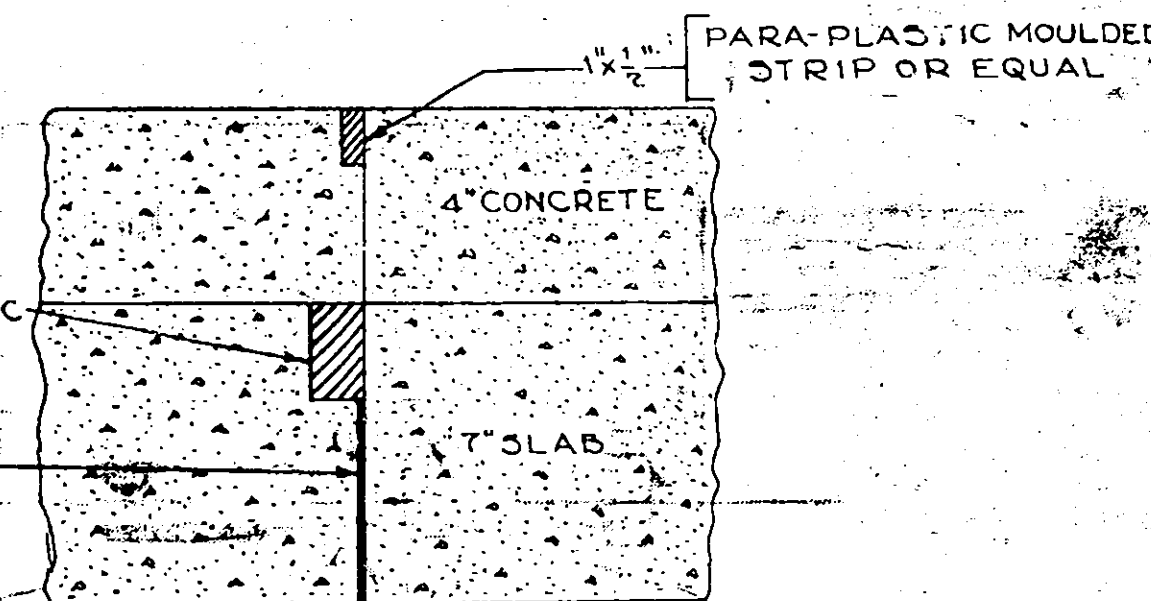


DETAIL OF JOINT OVER CENTER PIER
SCALE 3" = 1'-0"


NOTE:
FLASHINGS OR WATERSTOPS ARE TO BE PROTECTED FROM DAMAGE DURING THE COURSE OF CONSTRUCTION AS ORDERED BY THE ENGINEER. BENDING OR ALTERING THE SHAPE AS SHOWN IN ANY MANNER WILL NOT BE ALLOWED.

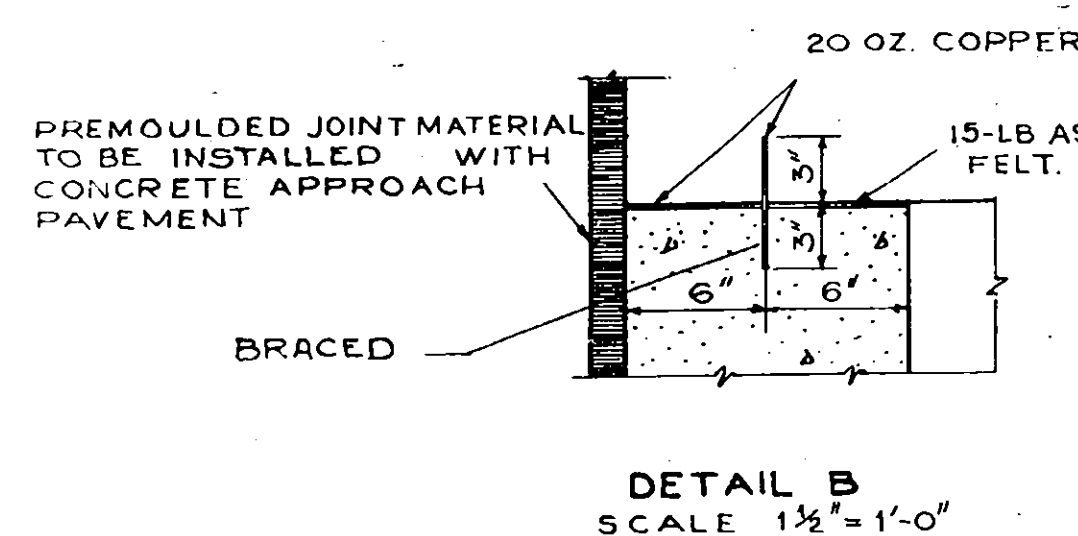

DETAIL B
SCALE 1 1/2" = 1'-0"

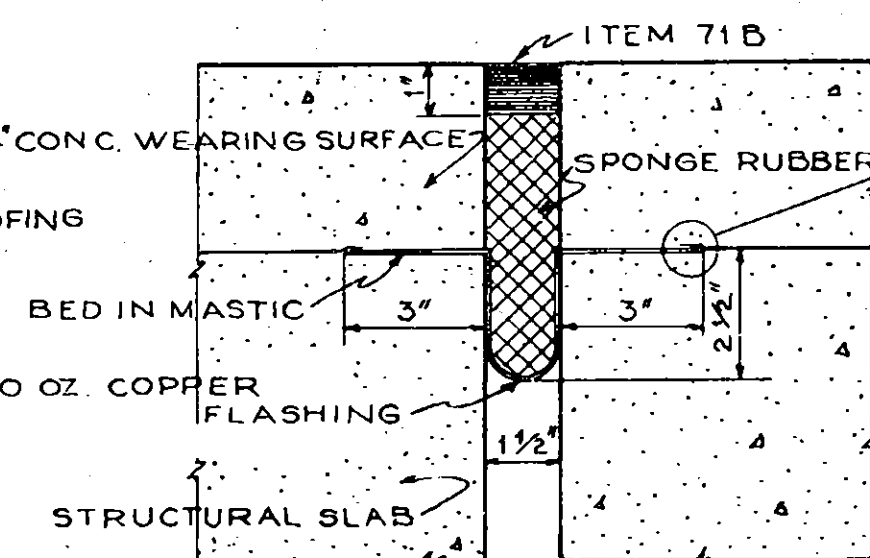


DETAIL OF JOINT OVER N-S PIERS
SCALE 3" = 1'-0"

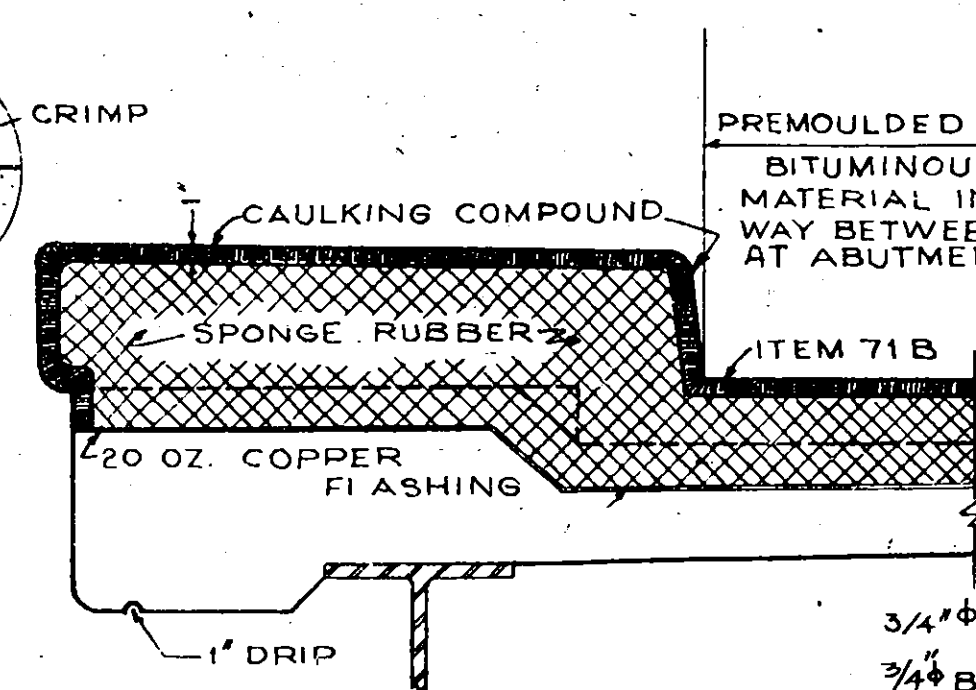

SECTION THRU SAFETY WALK AT JOINT
SCALE 1" = 1'-0"

NOTE:
SPONGE RUBBER SHALL COMPLY WITH THE REQUIREMENTS FOR PREFORMED EXPANSION JOINT FILLERS FOR CONCRETE, A.S.T.M. DESIGNATION D 544.
ASPHALT ROOFING FELT SHALL COMPLY WITH THE REQUIREMENTS OF THE STANDARD SPECIFICATIONS OF A.S.T.M., DESIGNATION D 2266

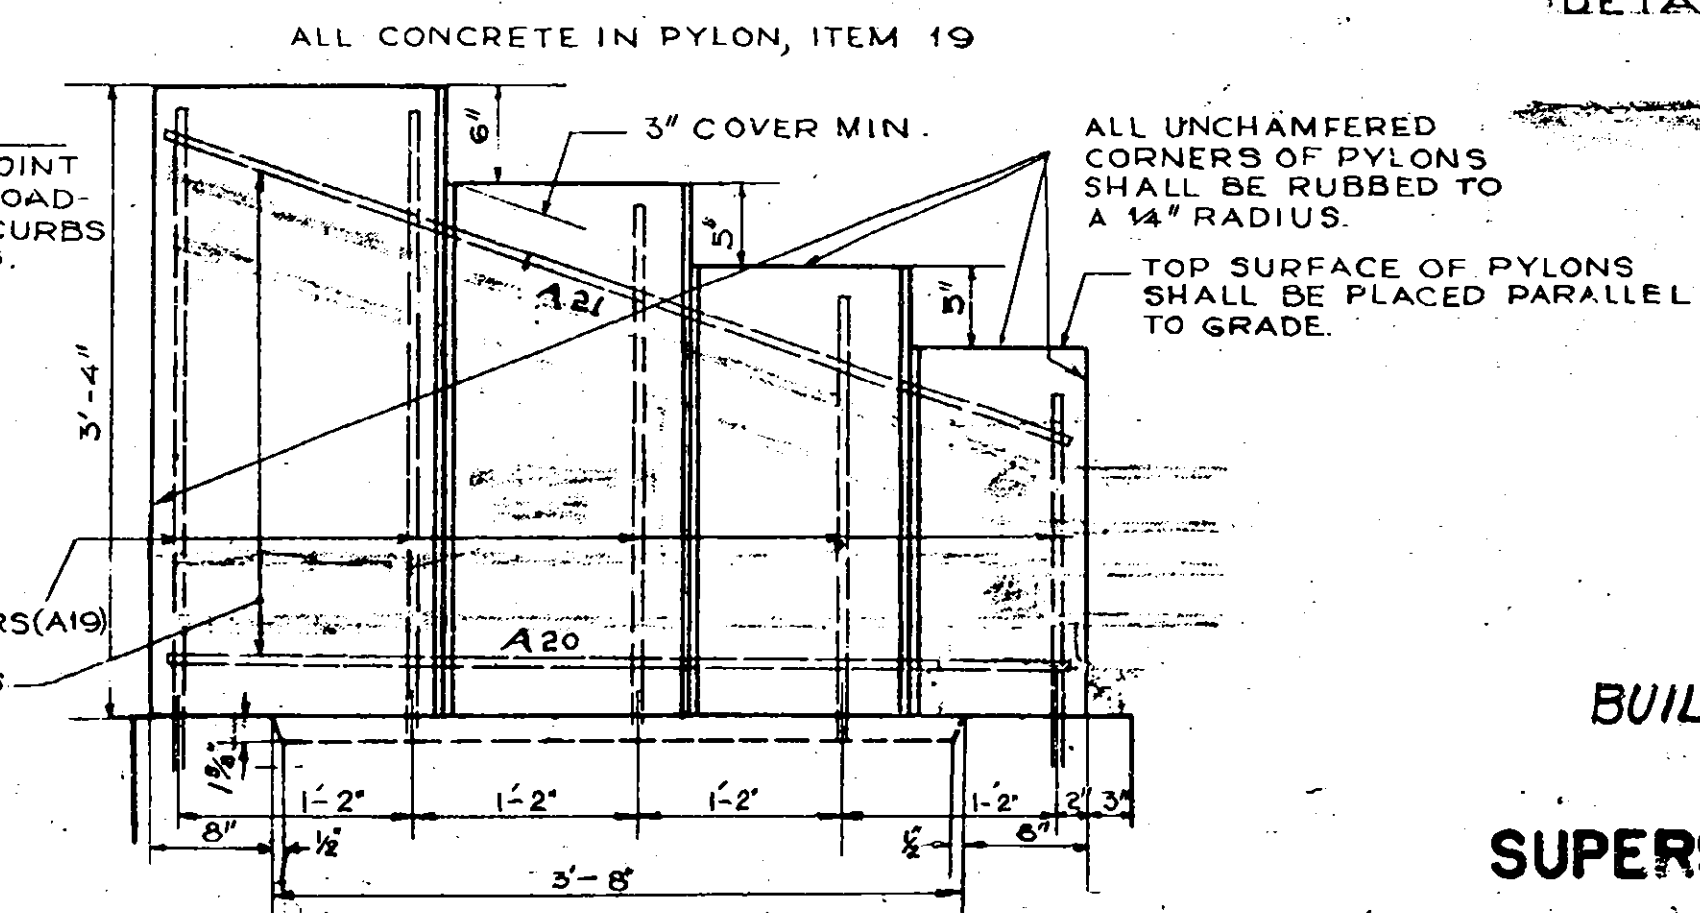

ELEVATION OF PYLON
SCALE 1" = 1'-0"

BUILT ACCORDING TO PLAN

SUPERSTRUCTURE DETAILS

NEW YORK STATE THRUWAY AND HOPKINS ROAD
TRAFFIC INTERCHANGE

PREPARED AND RECOMMENDED:

J. P. Doyle, Consulting Engineers
NEW YORK STATE PROFESSIONAL ENGINEERS LICENSE NO. 5667
DATE Feb 19-53

COUNTY	ONONDAGA	SHEET NO.	21	TOTAL SHEETS	66
NY STATE THRUWAY ONTARIO SECTION SUB DIV. 8 A					
INTERCHANGE AT ELECTRONICS PARKWAY, (HOPKINS ROAD)					


SUPERSTRUCTURE BAR LIST

MARK	SIZE	NO.	LENGTH	TYPE	A	B	C	LOCATION	MARK	SIZE	NO.	LENGTH	TYPE	A	B	C	LOCATION
L1	5/8"	420	43-8	I	42-5	0-5	0-0	DECK SLAB (TRANS) TOP									
L2	"	439	42-5	STR				" (TRANS) BOTT									
L30	5/8"	132	33-9	STR				DECK SLAB (LONG) TOP & BOTT									
L51	"	132	30-3					" " " " " "									
L52	"	132	39-10					" " " " " "									
T1	5/8"	32	25-8	III	22-3	0-0	3-6	DECK SLAB (END) TOP & BOTT									
SL1	1/2"	32	33-9	STR				SIDEWALK (LONG) LONG CTR SPAN									
SL2	"	32	30-3					(LONG) SHORT " "									
SL3	"	32	39-10					(LONG) END SPANS									
SL4	"	408	4-6	VI				(TRANS) ALL									
SL5	"	336	4-7	VI	0-10	0-3	1-7	TO SLAB " stirrups									
A21	3/4"	8	4-8	STR				PYLONS LONG									
A20	3/4"	8	5-1					"									

SUBSTRUCTURE BAR LIST

MARK	SIZE	NO.	LENGTH	TYPE	A	B	C	LOCATION
AF1	3/4"	80	9-3	STR				ABUT FOOTINGS
AF2	"	48	8-8					"
AF3	"	72	11-4					"
AF4	"	24	4-0					"
AF5	"	48	17-0					"
AF6	1/2"	11-4	5-2					"
PF1	1"	108	8-0	II	7-0	0-8	1-4	PIER FOUNDATION
PF2	3/4"	48	7-0	I	5-6	0-6	1-0	"
PF3	1/2"	40	10-3	I	8-6	0-7	1-2	"
PF4	3/4"	28	7-6	I	6-0	0-6	1-0	"
PF5	1/2"	22	10-9	I	9-0	0-7	1-2	"
A1	3/4"	16	45-6	STR				ABUT BACKWALLS
A2	"	12	18-1	III	15-0	2-6	0-6 1/2	WING WALLS
A2.2	"	4	19-5	III	15-0	0-0	4-8	"
A3	"	16	19-6	III	11-10	3-0	4-6 1/2	"
A6	1/2"	28	4-8	STR				"
A7	"	8	6-10					"
A8	"	8	12-0					"
A4	"	48	9-2	VI	2-4	0-4	3-2	BRIDGE SEATS
A19	3/4"	40	6-0	STR				VERT. PYLONS
P1	1"	36	18-3	STR				N. PIER VERT. IN COLS.
P2	"	36	19-10					C " " "
P3	"	36	20-8					S " " "
P4	1/4"	60	30-0	X	14-4			N " SPIRALS IN COLS.
P5	"	64	30-0		16-1			C " " "
P6	"	68	30-0		16-10			S " " "
P7	1 1/8"	24	11-0	STR				PIER BEAM BOTT.
P8	"	6	48-4	II	42-2	2-10		PIER GDRS
P8A	"	6	39-0	STR				"
P9	"	12	29-9	XI	25-1	1-6	2-3	TOP
P9A	"	12	30-6		25-10	1-6	2-3	"
P10	"	12	9-4		4-9	1-6	2-3	"
P11	"	6	9-8		5-1	1-6	2-3	"
P17	5/8"	18	39-0	STR				"
P18	"	30	10-3	VII	2-11	2-10	4-5	"
P19	"	168	13-8	V	2-1	0-3	3-8	"
P15	1/2"	72	1-6	STR				"
P16	"	36	10-0	I	2-0	0-3	2-8	PADS
P1-1	1"	160	3-10	II	2-10	0-8	1-4	ALL PILES

BAR DETAILS

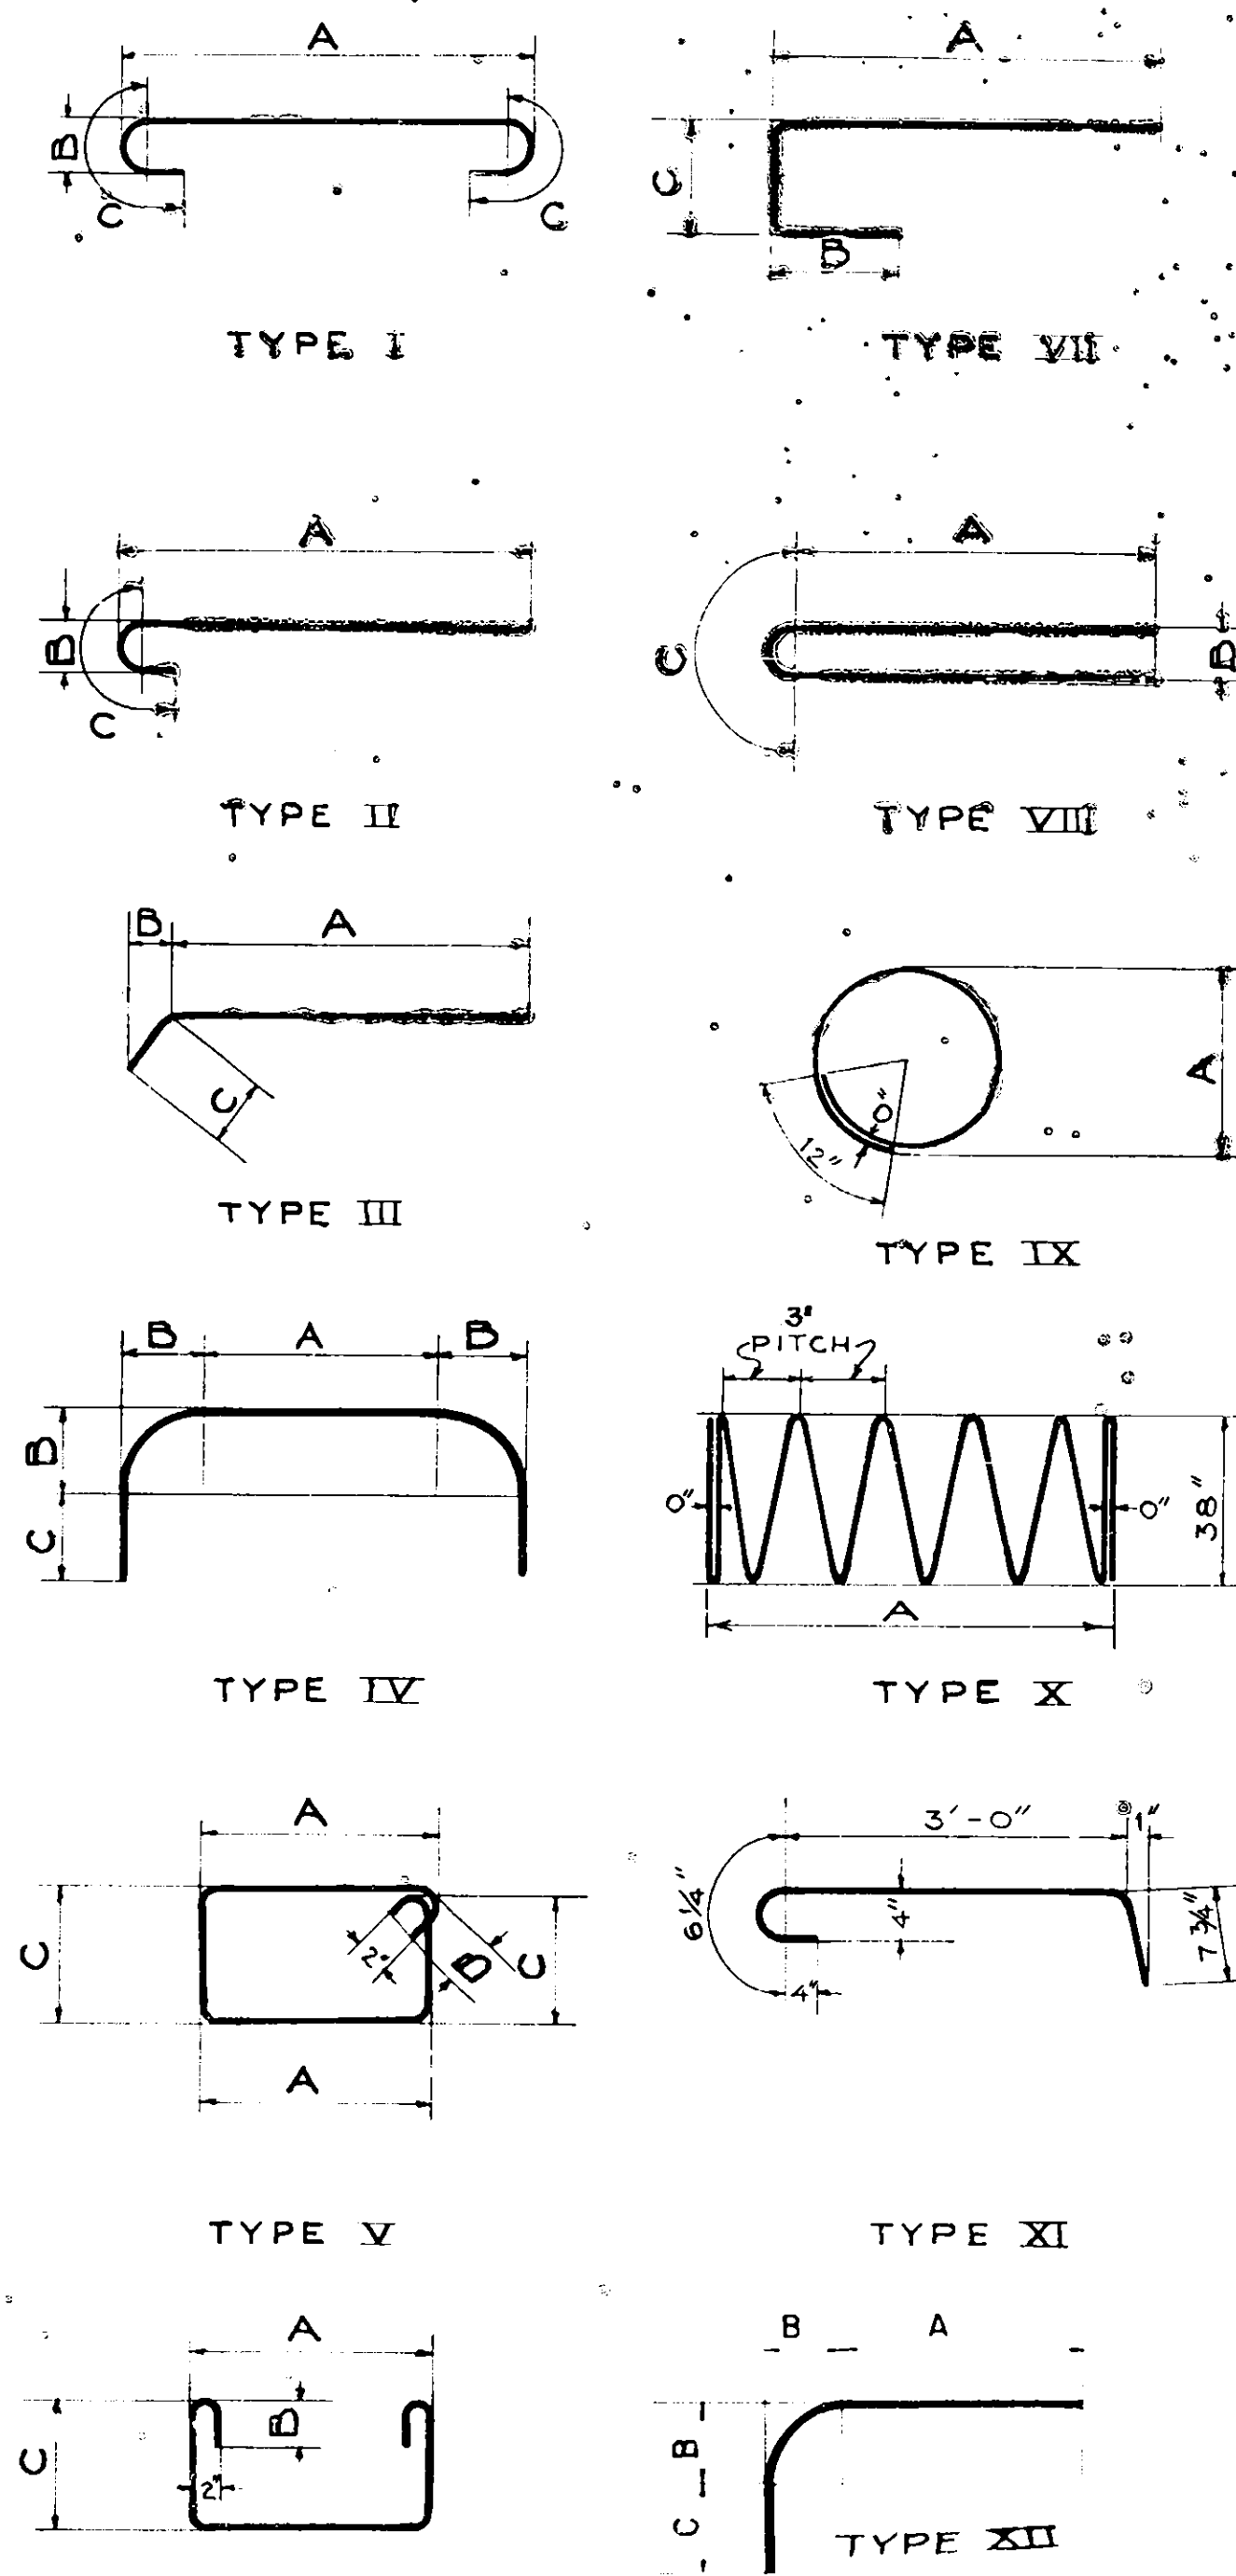

TYPE VI ALL REINFORCING BARS ITEM 28

BAR LIST

NEW YORK STATE THRUWAY AND HOPKINS ROAD
TRAFFIC INTERCHANGE

PREPARED AND RECOMMENDED:


URQUHART & DOYLE, CONSULTING ENGINEERS
NEW YORK STATE PROFESSIONAL ENGINEERS LICENSE NO. 5667

DATE

COUNTY		SHEET NO.	TOTAL SHEETS
ONONDAGA		21	66
N.Y. STATE THRUWAY ONTARIO SECTION SUB DIV. 8 A			
INTERCHANGE AT ELECTRONICS PARKWAY (HOPKINS ROAD)			

21R

BAR DETAILS

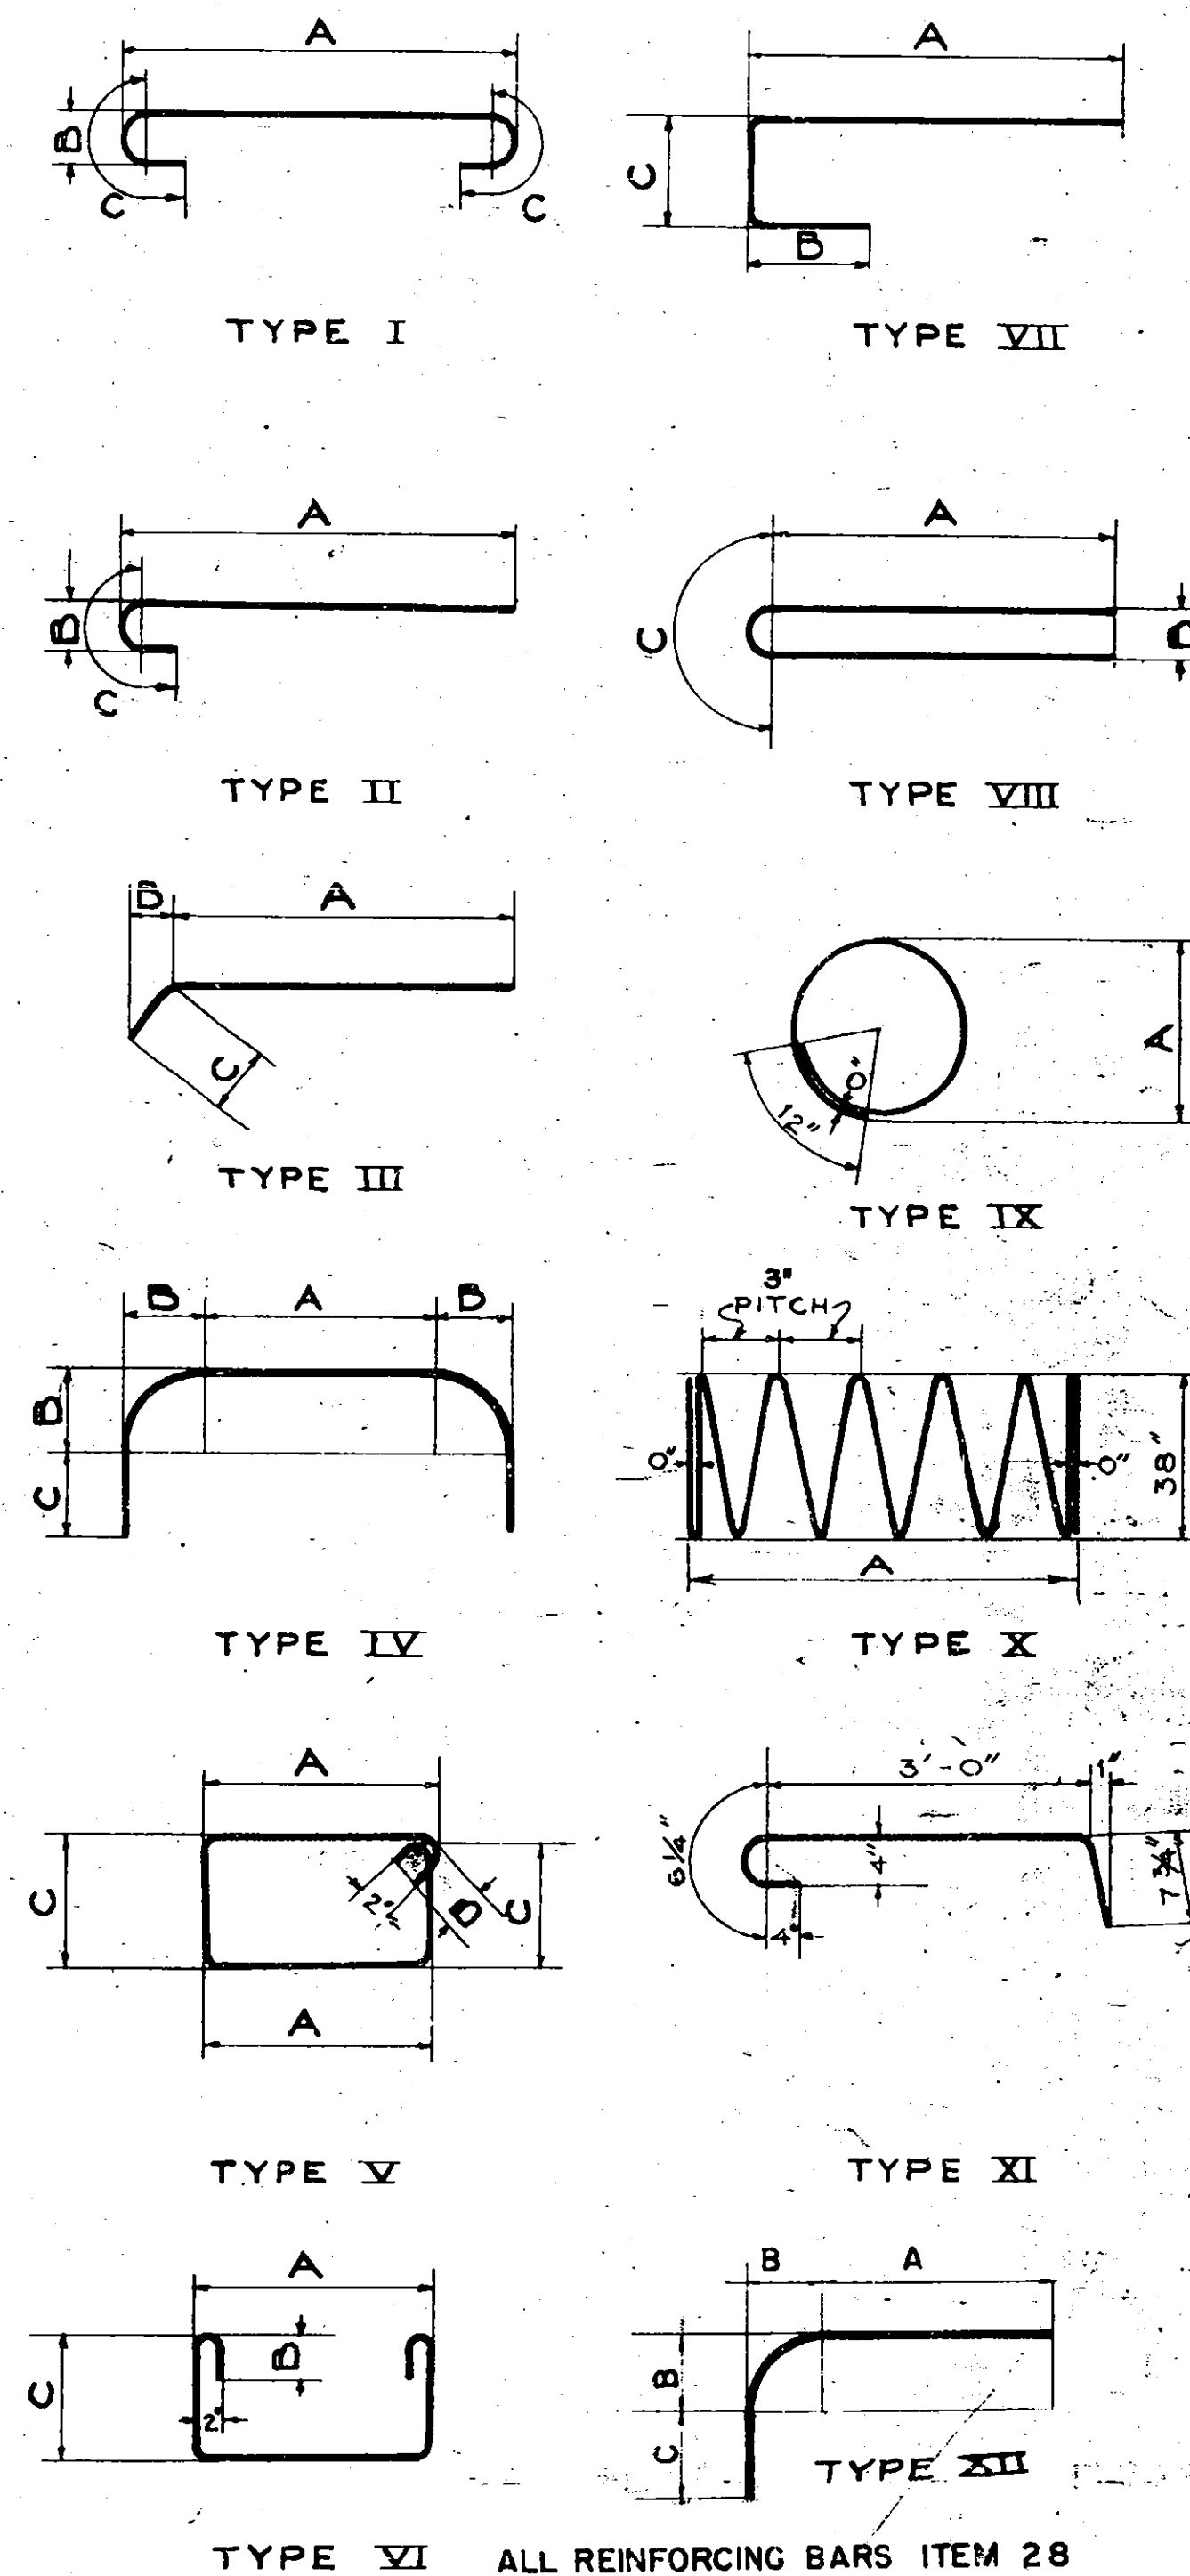

TYPE VI ALL REINFORCING BARS ITEM 28

BAR LIST

NEW YORK STATE THRUWAY AND HOPKINS ROAD
TRAFFIC INTERCHANGE

SUPERSTRUCTURE BAR LIST

MARK	SIZE	NO.	LENGTH	TYPE	A	B	C	LOCATION	MARK	SIZE	NO.	LENGTH	TYPE	A	B	C	LOCATION
L1	5/8"	400	43-8	I	42-5	0-5	0-10	DECK SLAB (TRANS) TOP									
L2	"	139	42-5	STR				" " (TRANS) BOTT									
L30	5/8"	132	33-9	STR				DECK SLAB (LONG) TOP & BOTT									
L51	"	132	30-3					" " " " " "									
L52	"	132	39-10					" " " " " "									
T1	5/8"	32	25-9	III	22-3	0-0	3-6	DECK SLAB (END) TOP & BOTT									
SL1	1/2"	32	33-9	STR				SIDEWALK (LONG) LONG CTR SPAN									
SL2	"	32	30-3					(LONG) SHORT " "									
SL3	"	32	39-10					(LONG) END SPANS									
SL5	"	408	4-6	XI				(TRANS) ALL									
SL6	"	336	4-8	VI	0-10	0-3	1-7	TO SLAB " "									
A21	3/4"	8	4-8	STR				PYLONS LONG									
A20	3/4"	8	5-1	"				"									


SUBSTRUCTURE BAR LIST

MARK	SIZE	NO.	LENGTH	TYPE	A	B	C	LOCATION
AF1	3/4"	80	9-3	STR				ABUT FOOTINGS
AF2	"	48	6-8					
AF3	"	72	11-4					
AF4	"	24	4-0					
AF5	"	48	17-0					
AF6	1/2"	112	5-2					
PF1	1"	108	8-0	II	7-0	0-8	1-4	PIER FOUNDATION
PF2	3/4"	48	7-0	I	5-6	0-6	1-0	
PF3	7/8"	40	10-3	I	8-6	0-7	1-2	
PF4	3/4"	28	7-6	I	6-0	0-6	1-0	
PF5	1/8"	22	10-9	I	9-0	0-7	1-2	
A1	3/4"	16	45-6	STR				ABUT BACKWALLS
A2	"	12	18-1	VII	15-0	2-6	0-6 1/2	WING WALLS
A2.2	"	4	19-8	III	15-0	0-0	4-8	
A3	"	16	19-4 1/2	XII	11-10	3-0	4-6 1/2	
A6	1/2"	28	4-8	STR				
A7	"	8	6-10					
A8	"	8	12-0					
A4	"	48	9-4	XI	2-4	0-4	3-2	BRIDGE SEATS
A19	3/4"	40	6-0	STR				VERT. PYLONS
P1	1"	36	18-3	STR				N. PIER VERT. IN COLS.
P2	"	36	19-10					C " " "
P3	"	36	20-8					S " " "
P4	1/4"	60	30-0	X	14-4			N SPIRALS IN COLS.
P5	"	64	30-0		18-1			C " " "
P6	"	68	30-0		18-10			S " " "
P7	1/8"	24	11-0	STR				PIER BEAM BOTT.
P8	"	6	48-4	II	42-2	2-10		PIER GDRS
P8A	"	6	39-0	STR				"
P9	"	12	29-9	XII	25-1	1-6	2-3	TOP
P9A	"	12	30-6		25-10	1-6	2-3	"
P10	"	12	9-5		4-9	1-6	2-3	"
P11	"	6	9-9		5-1	1-6	2-3	"
P17	5/8"	18	39-0	STR				
P18	"	30	10-3	VIII	2-11	2-10	4-3	
P13	"	168	12-0	V	2-1	0-3	3-8	
P15	1/2"	72	1-6	STR				
P16	"	36	9-10	X	2-0	0-3	2-8	PADS
P1-1	1"	160	3-10	II	2-10	0-8	1-4	ALL PILES

PREPARED AND RECOMMENDED: *[Signature]* Feb 19-53
URQUHART & DOYLE, CONSULTING ENGINEERS
NEW YORK STATE PROFESSIONAL ENGINEERS LICENSE NO. 5667
DATE

COUNTY	SHEET NO.	TOTAL SHEETS
ONONDAGA	22	66

NY STATE THRUWAY, MOHAWK SECTION SUBDIV. B B
INTERCHANGE AT THOMPSON ROAD

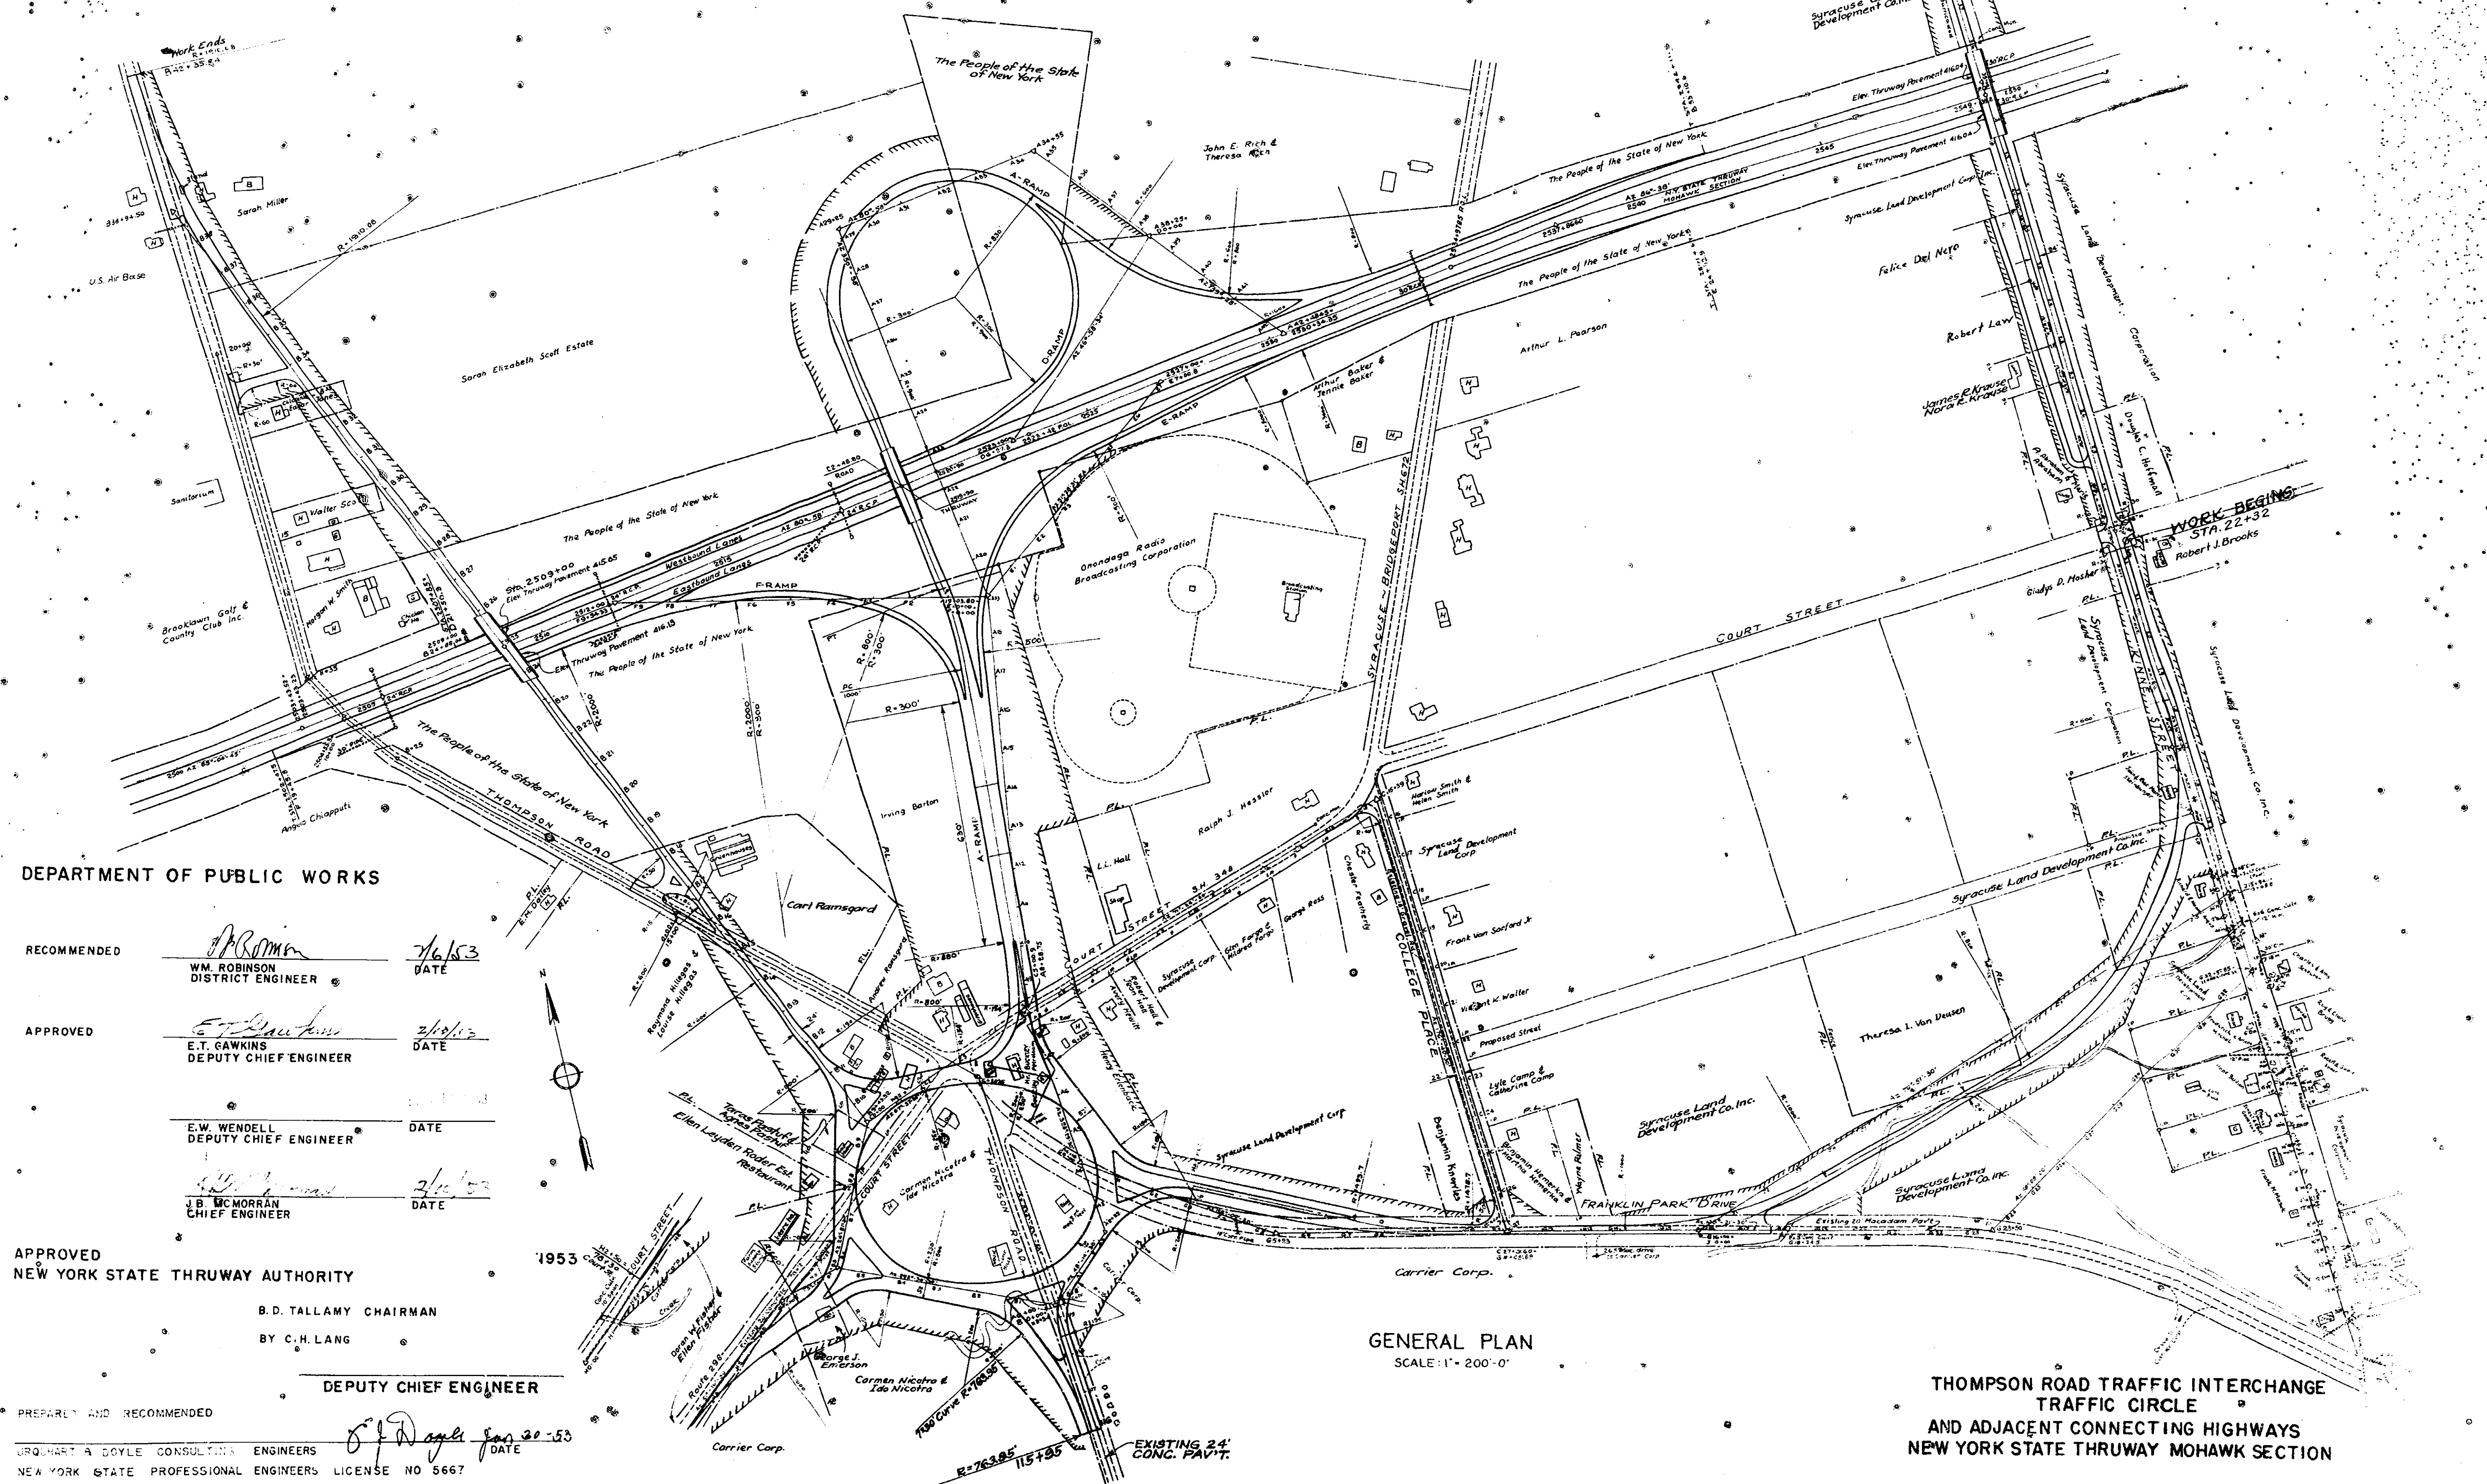

DEPARTMENT OF PUBLIC WORKS

RECOMMENDED
WM. ROBINSON
DISTRICT ENGINEER
DATE 7/6/53

APPROVED
E.T. GAWKINS
DEPUTY CHIEF ENGINEER
DATE 2/10/53

E.W. WENDELL
DEPUTY CHIEF ENGINEER
DATE 7/6/53

J.B. MC MORRAN
CHIEF ENGINEER
DATE 7/6/53

APPROVED
NEW YORK STATE THRUWAY AUTHORITY
B.D. TALLAMY CHAIRMAN
BY C.H. LANG
DEPUTY CHIEF ENGINEER


PREPARED AND RECOMMENDED
GEORGE A. DOYLE CONSULTING ENGINEERS
NEW YORK STATE PROFESSIONAL ENGINEERS LICENSE NO 5667
DATE 8/1/53

GENERAL PLAN
SCALE: 1" = 200'-0"

THOMPSON ROAD TRAFFIC INTERCHANGE
TRAFFIC CIRCLE
AND ADJACENT CONNECTING HIGHWAYS
NEW YORK STATE THRUWAY MOHAWK SECTION

COUNTY	SHEET NO.	TOTAL SHEETS
ONONDAGA	22	66
N.Y. STATE THRUWAY, MOHAWK SECTION SUBDIV. 6B		
INTERCHANGE AT THOMPSON ROAD		

22R

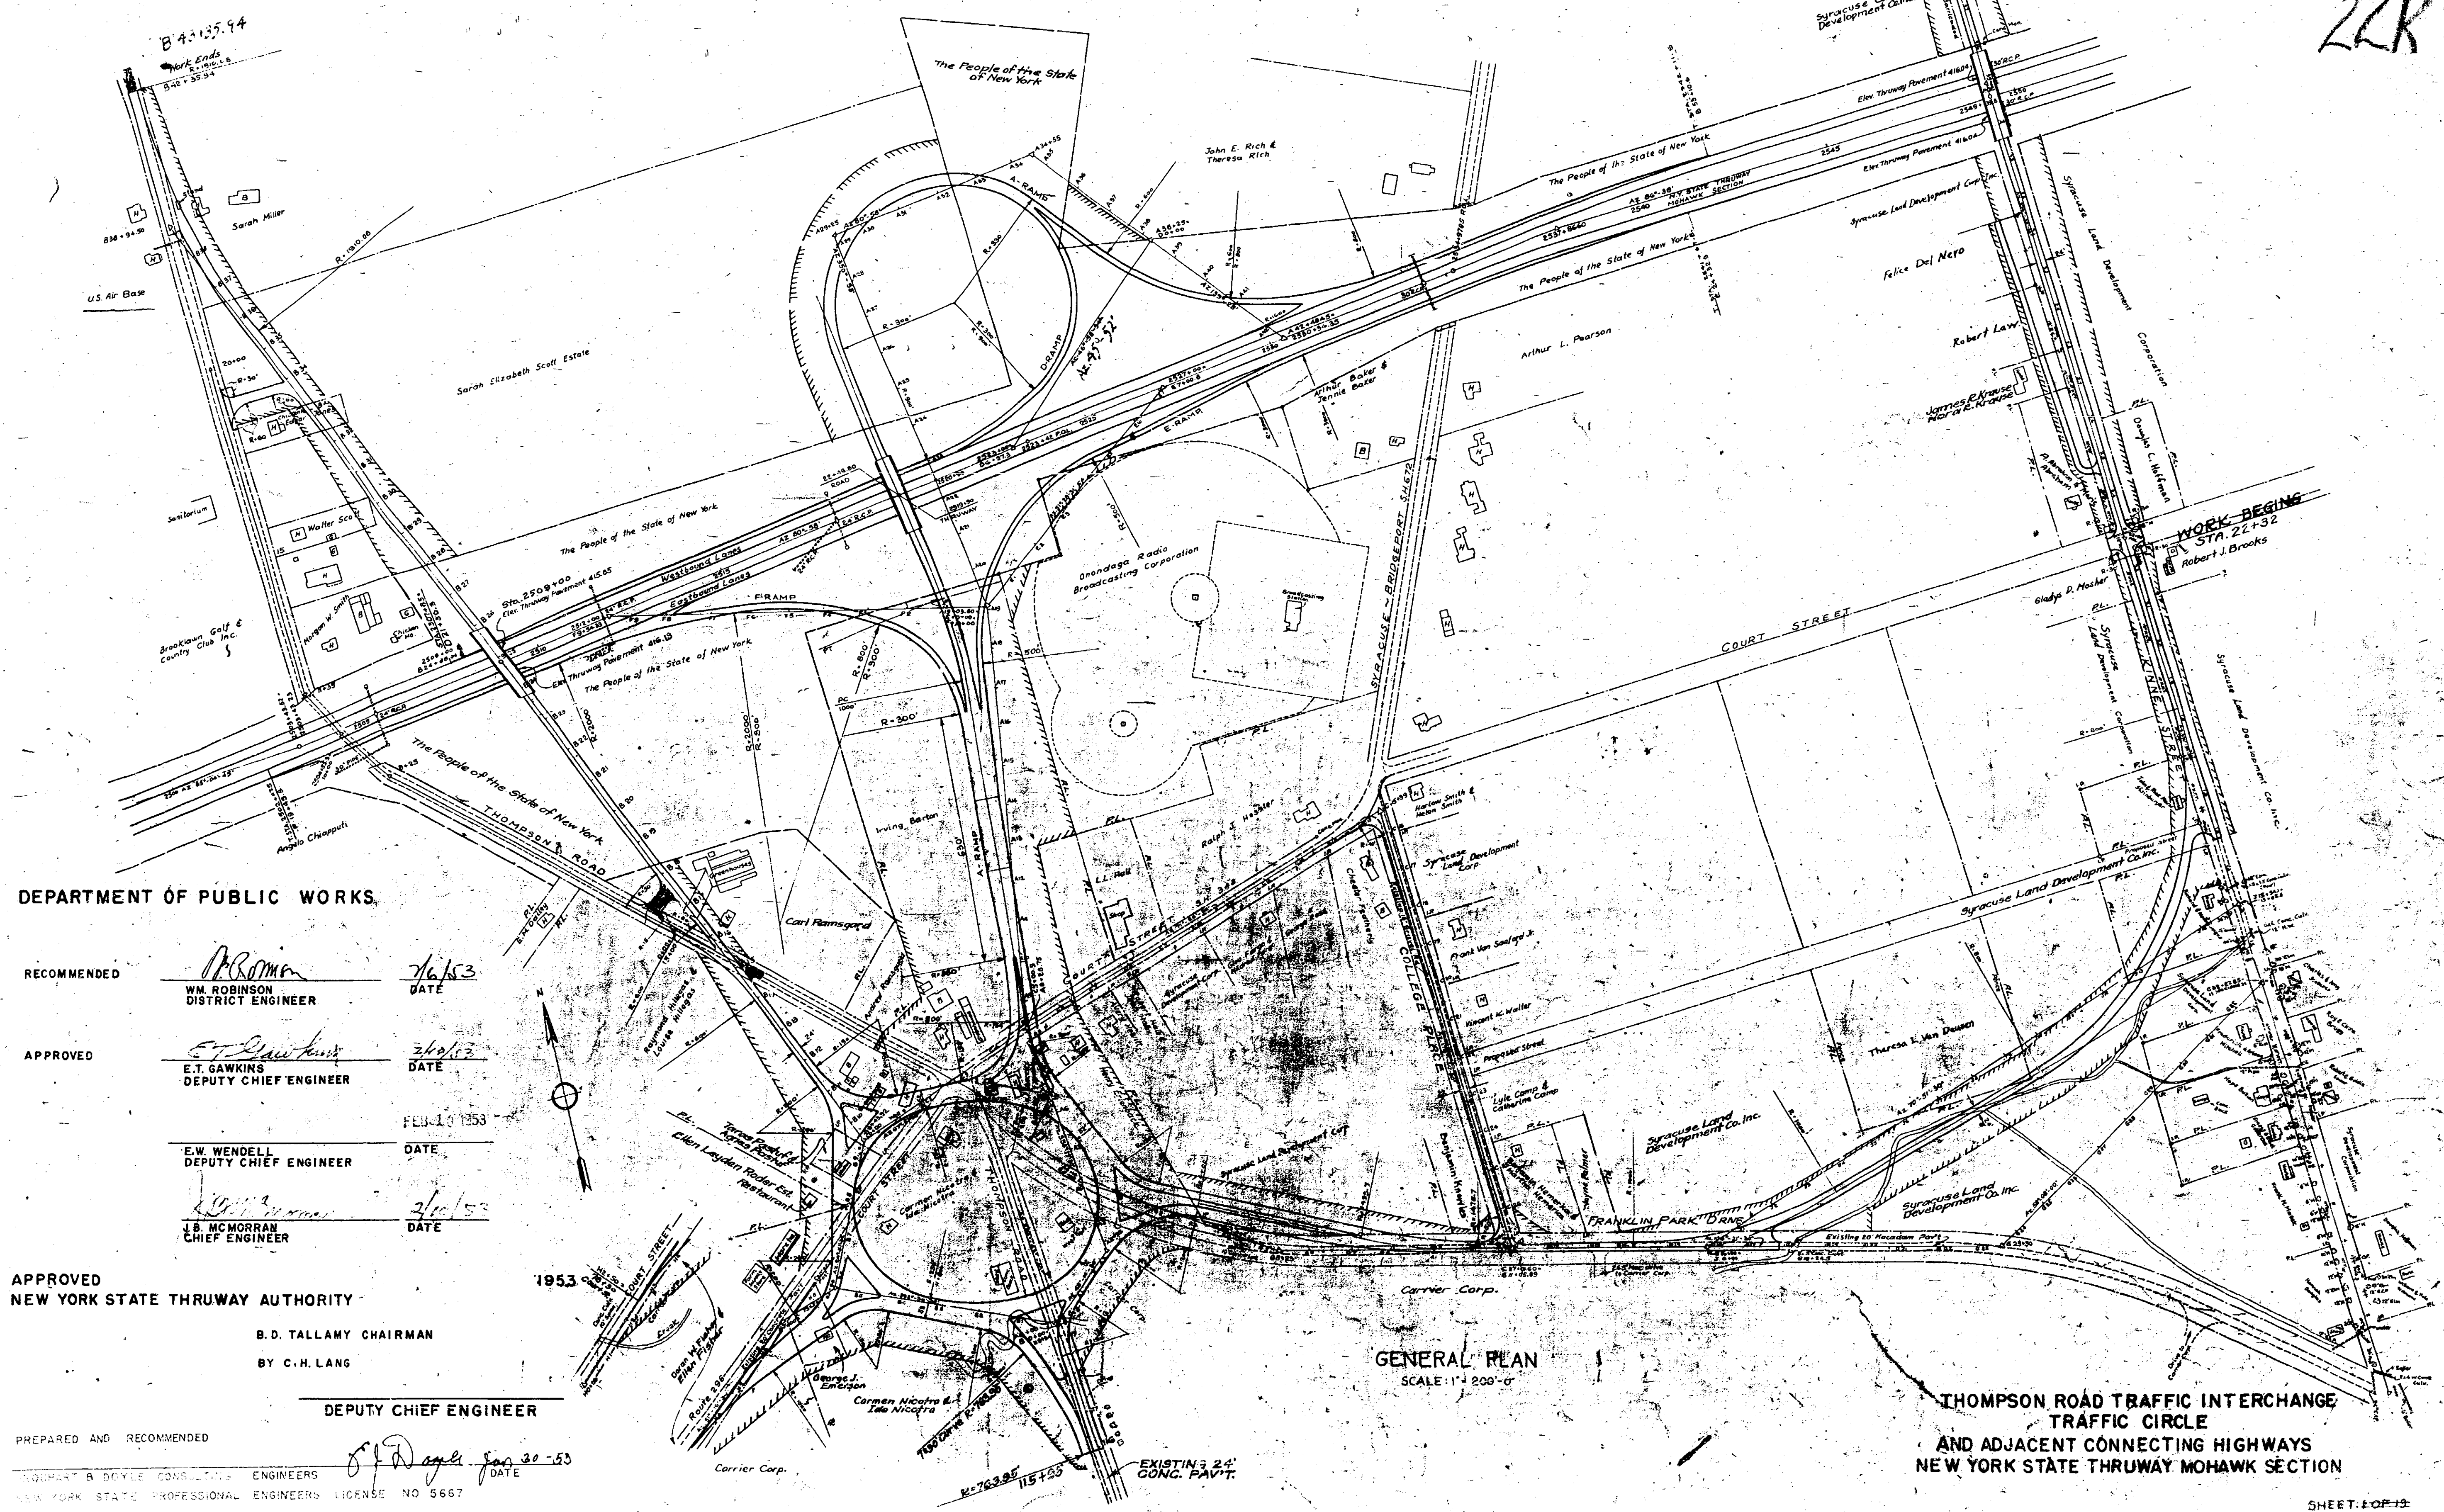

DEPARTMENT OF PUBLIC WORKS.

RECOMMENDED
WM. ROBINSON
DISTRICT ENGINEER
DATE 7/6/53

APPROVED
E.T. GAWKINS
DEPUTY CHIEF ENGINEER
DATE 3/6/53

FEB. 10 1953

E.W. WENDELL
DEPUTY CHIEF ENGINEER
DATE

J.B. MCMORRAN
CHIEF ENGINEER
DATE 3/6/53

APPROVED
NEW YORK STATE THRUWAY AUTHORITY


B.D. TALLAMY CHAIRMAN
BY C.H. LANG

DEPUTY CHIEF ENGINEER

PREPARED AND RECOMMENDED
ROBERT B. BOYLE CONSULTING ENGINEERS
NEW YORK STATE PROFESSIONAL ENGINEERS LICENSE NO 5667
DATE 5-20-53

THOMPSON ROAD TRAFFIC INTERCHANGE
TRAFFIC CIRCLE
AND ADJACENT CONNECTING HIGHWAYS
NEW YORK STATE THRUWAY MOHAWK SECTION

COUNTY		SHEET NO	TOTAL SHEETS
ONONDAGA		23	66
NY STATE THRUWAY, MOHAWK SECTION SUB DIV. B B INTERCHANGE AT THOMPSON ROAD			

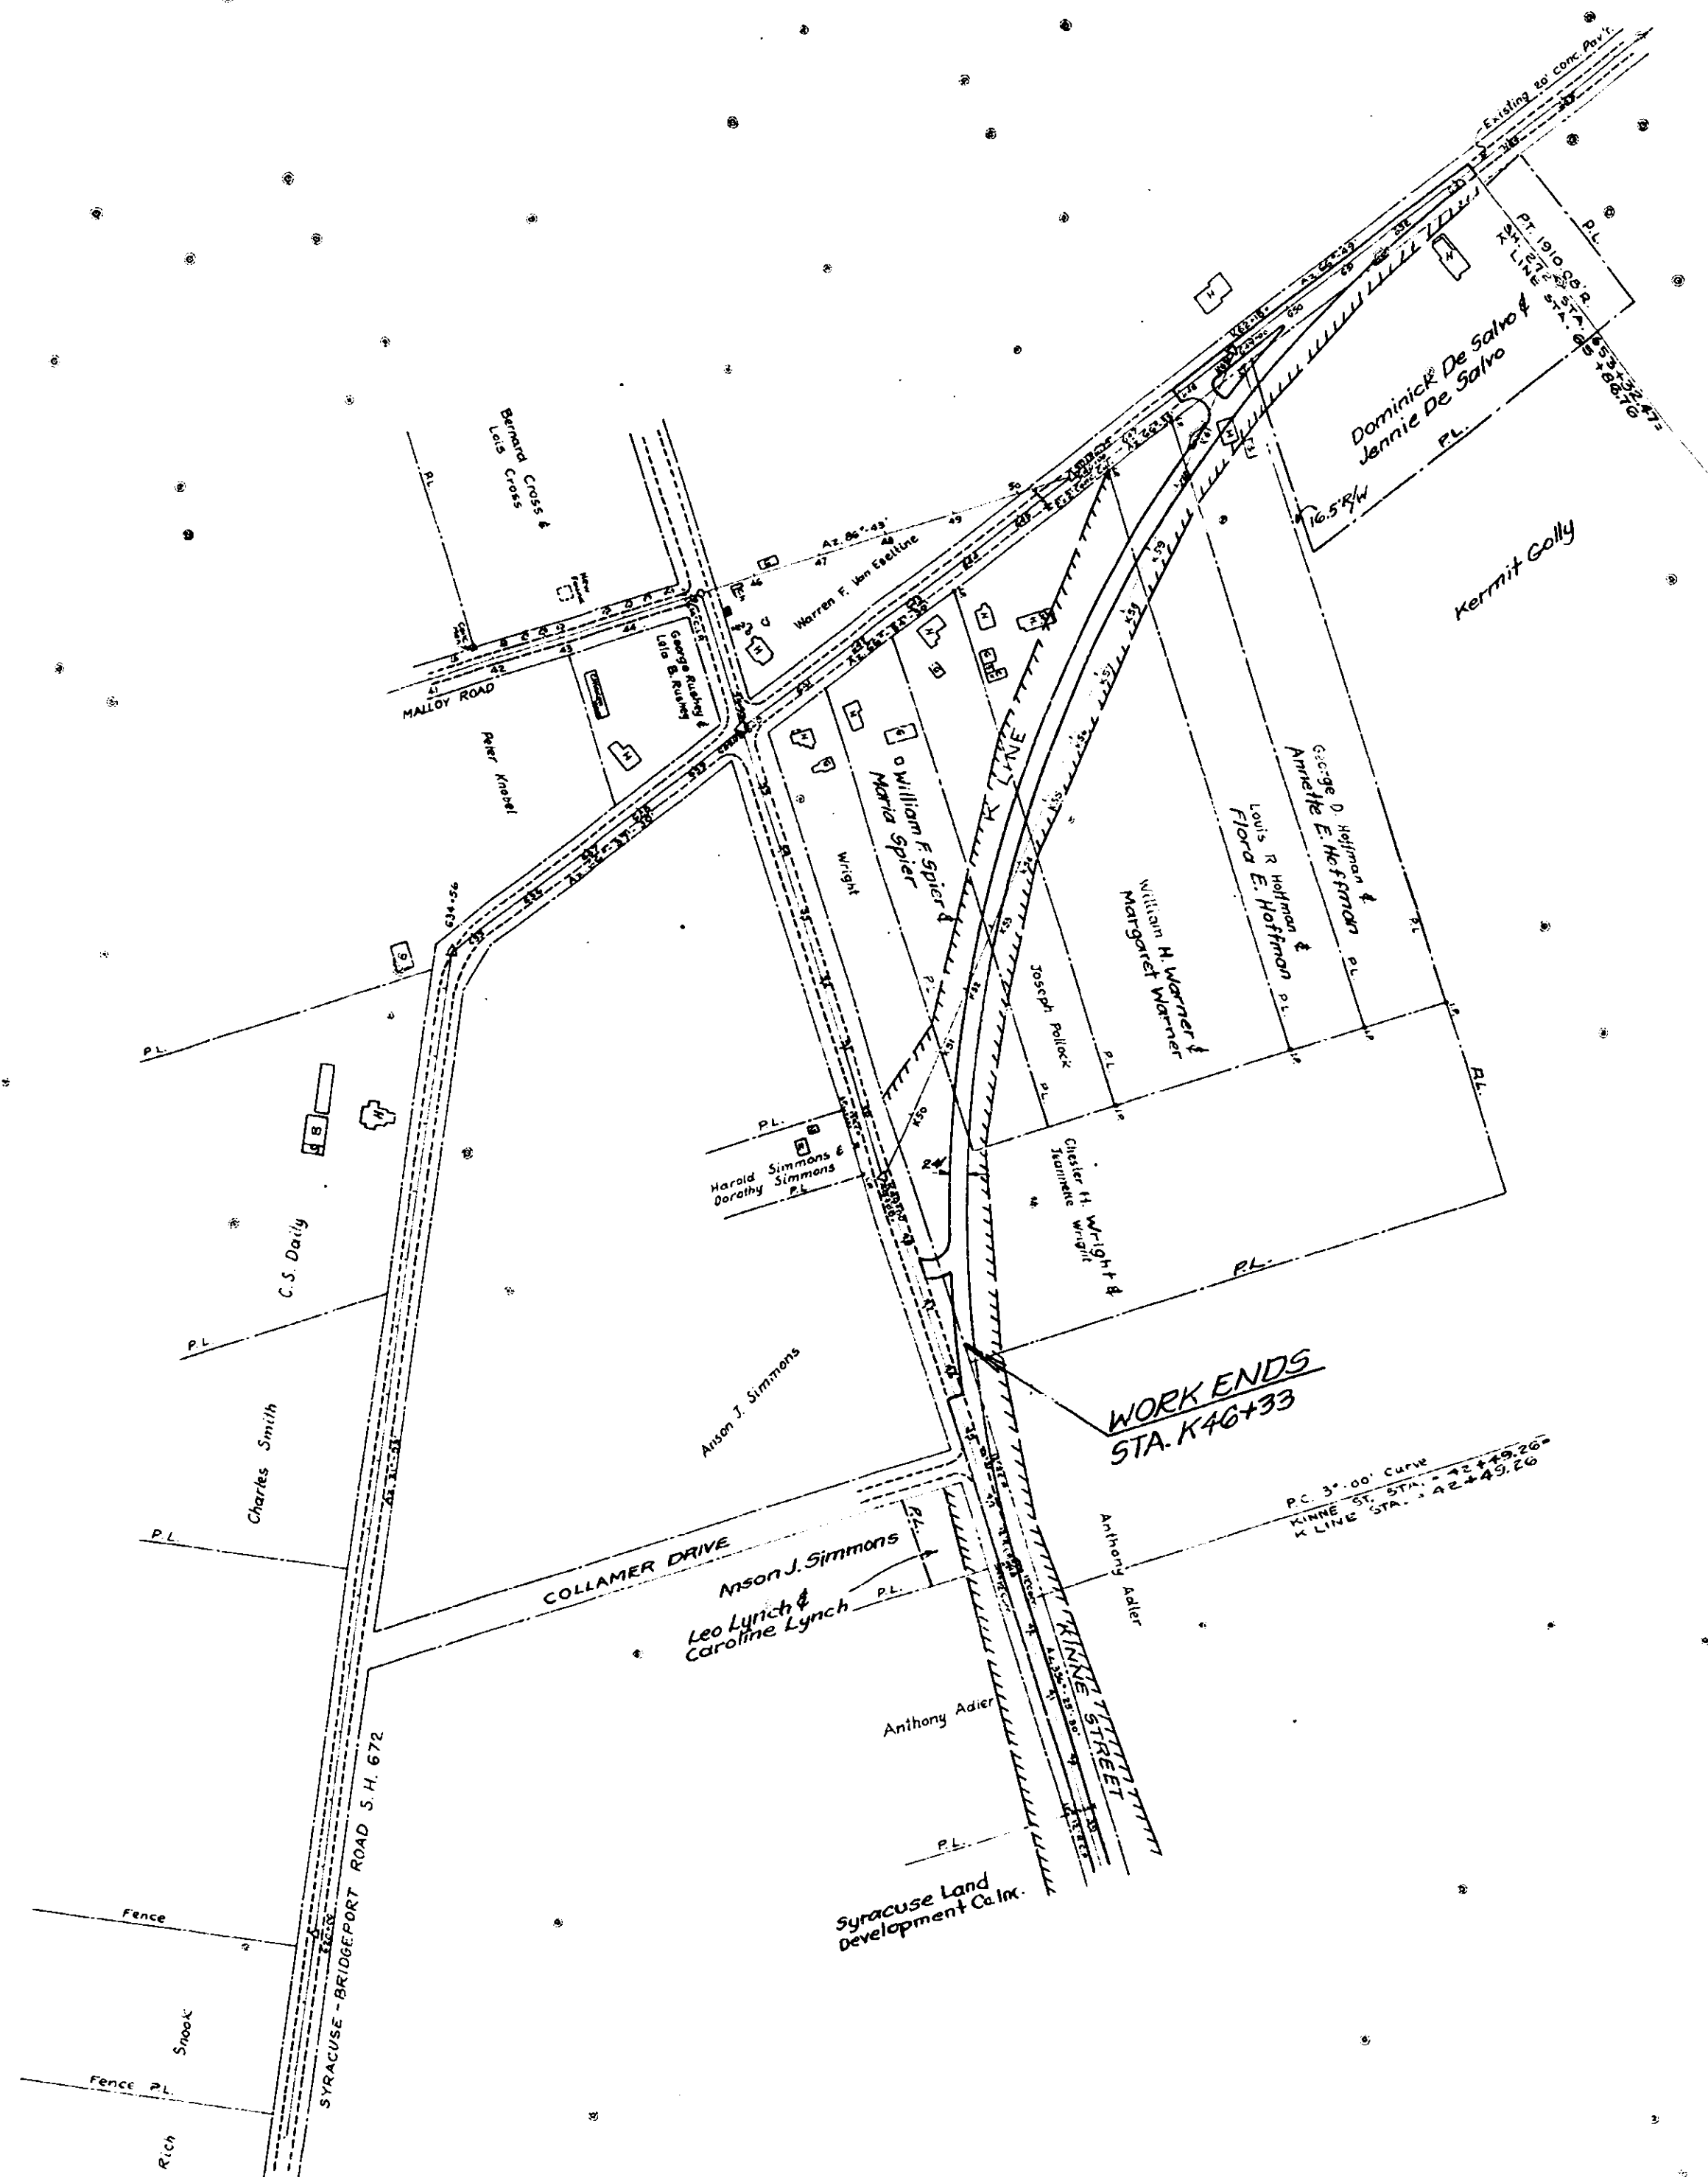

GENERAL PLAN
SCALE: 1" = 200'-0"

PREPARED AND RECOMMENDED *W. J. Doyle* Jan 30 - 53
URQUHART & DOYLE CONSULTING ENGINEERS
NEW YORK STATE PROFESSIONAL ENGINEERS LICENSE NO. 5667
DATE

DEPARTMENT OF PUBLIC WORKS

RECOMMENDED

WM. ROBINSON
DISTRICT ENGINEER

DATE 7/6/53

APPROVED

E.T. GAWKINS
DEPUTY CHIEF ENGINEER

DATE _____

E.W. WENDELL
DEPUTY CHIEF ENGINEER

DATE _____

J.B. McMorran
J.B. MC MORRAN
CHIEF ENGINEER

DATE 6/6/80

APPROVED

January 16

1953

NEW YORK STATE THRUWAY AUTHORITY


B. D. TALLAMY CHAIRMAN

BY C. H. LANG

DEPUTY CHIEF ENGINEER

THOMPSON ROAD TRAFFIC INTERCHANGE
TRAFFIC CIRCLE
AND ADJACENT CONNECTING HIGHWAYS
NEW YORK STATE THRUWAY MOHAWK SECTION

COUNTY	SHEET NO.	TOTAL SHEETS
ONONDAGA	24	66
N.Y. STATE THRUWAY, MOHAWK SECTION SUBDIV. 8B		
INTERCHANGE AT THOMPSON ROAD		

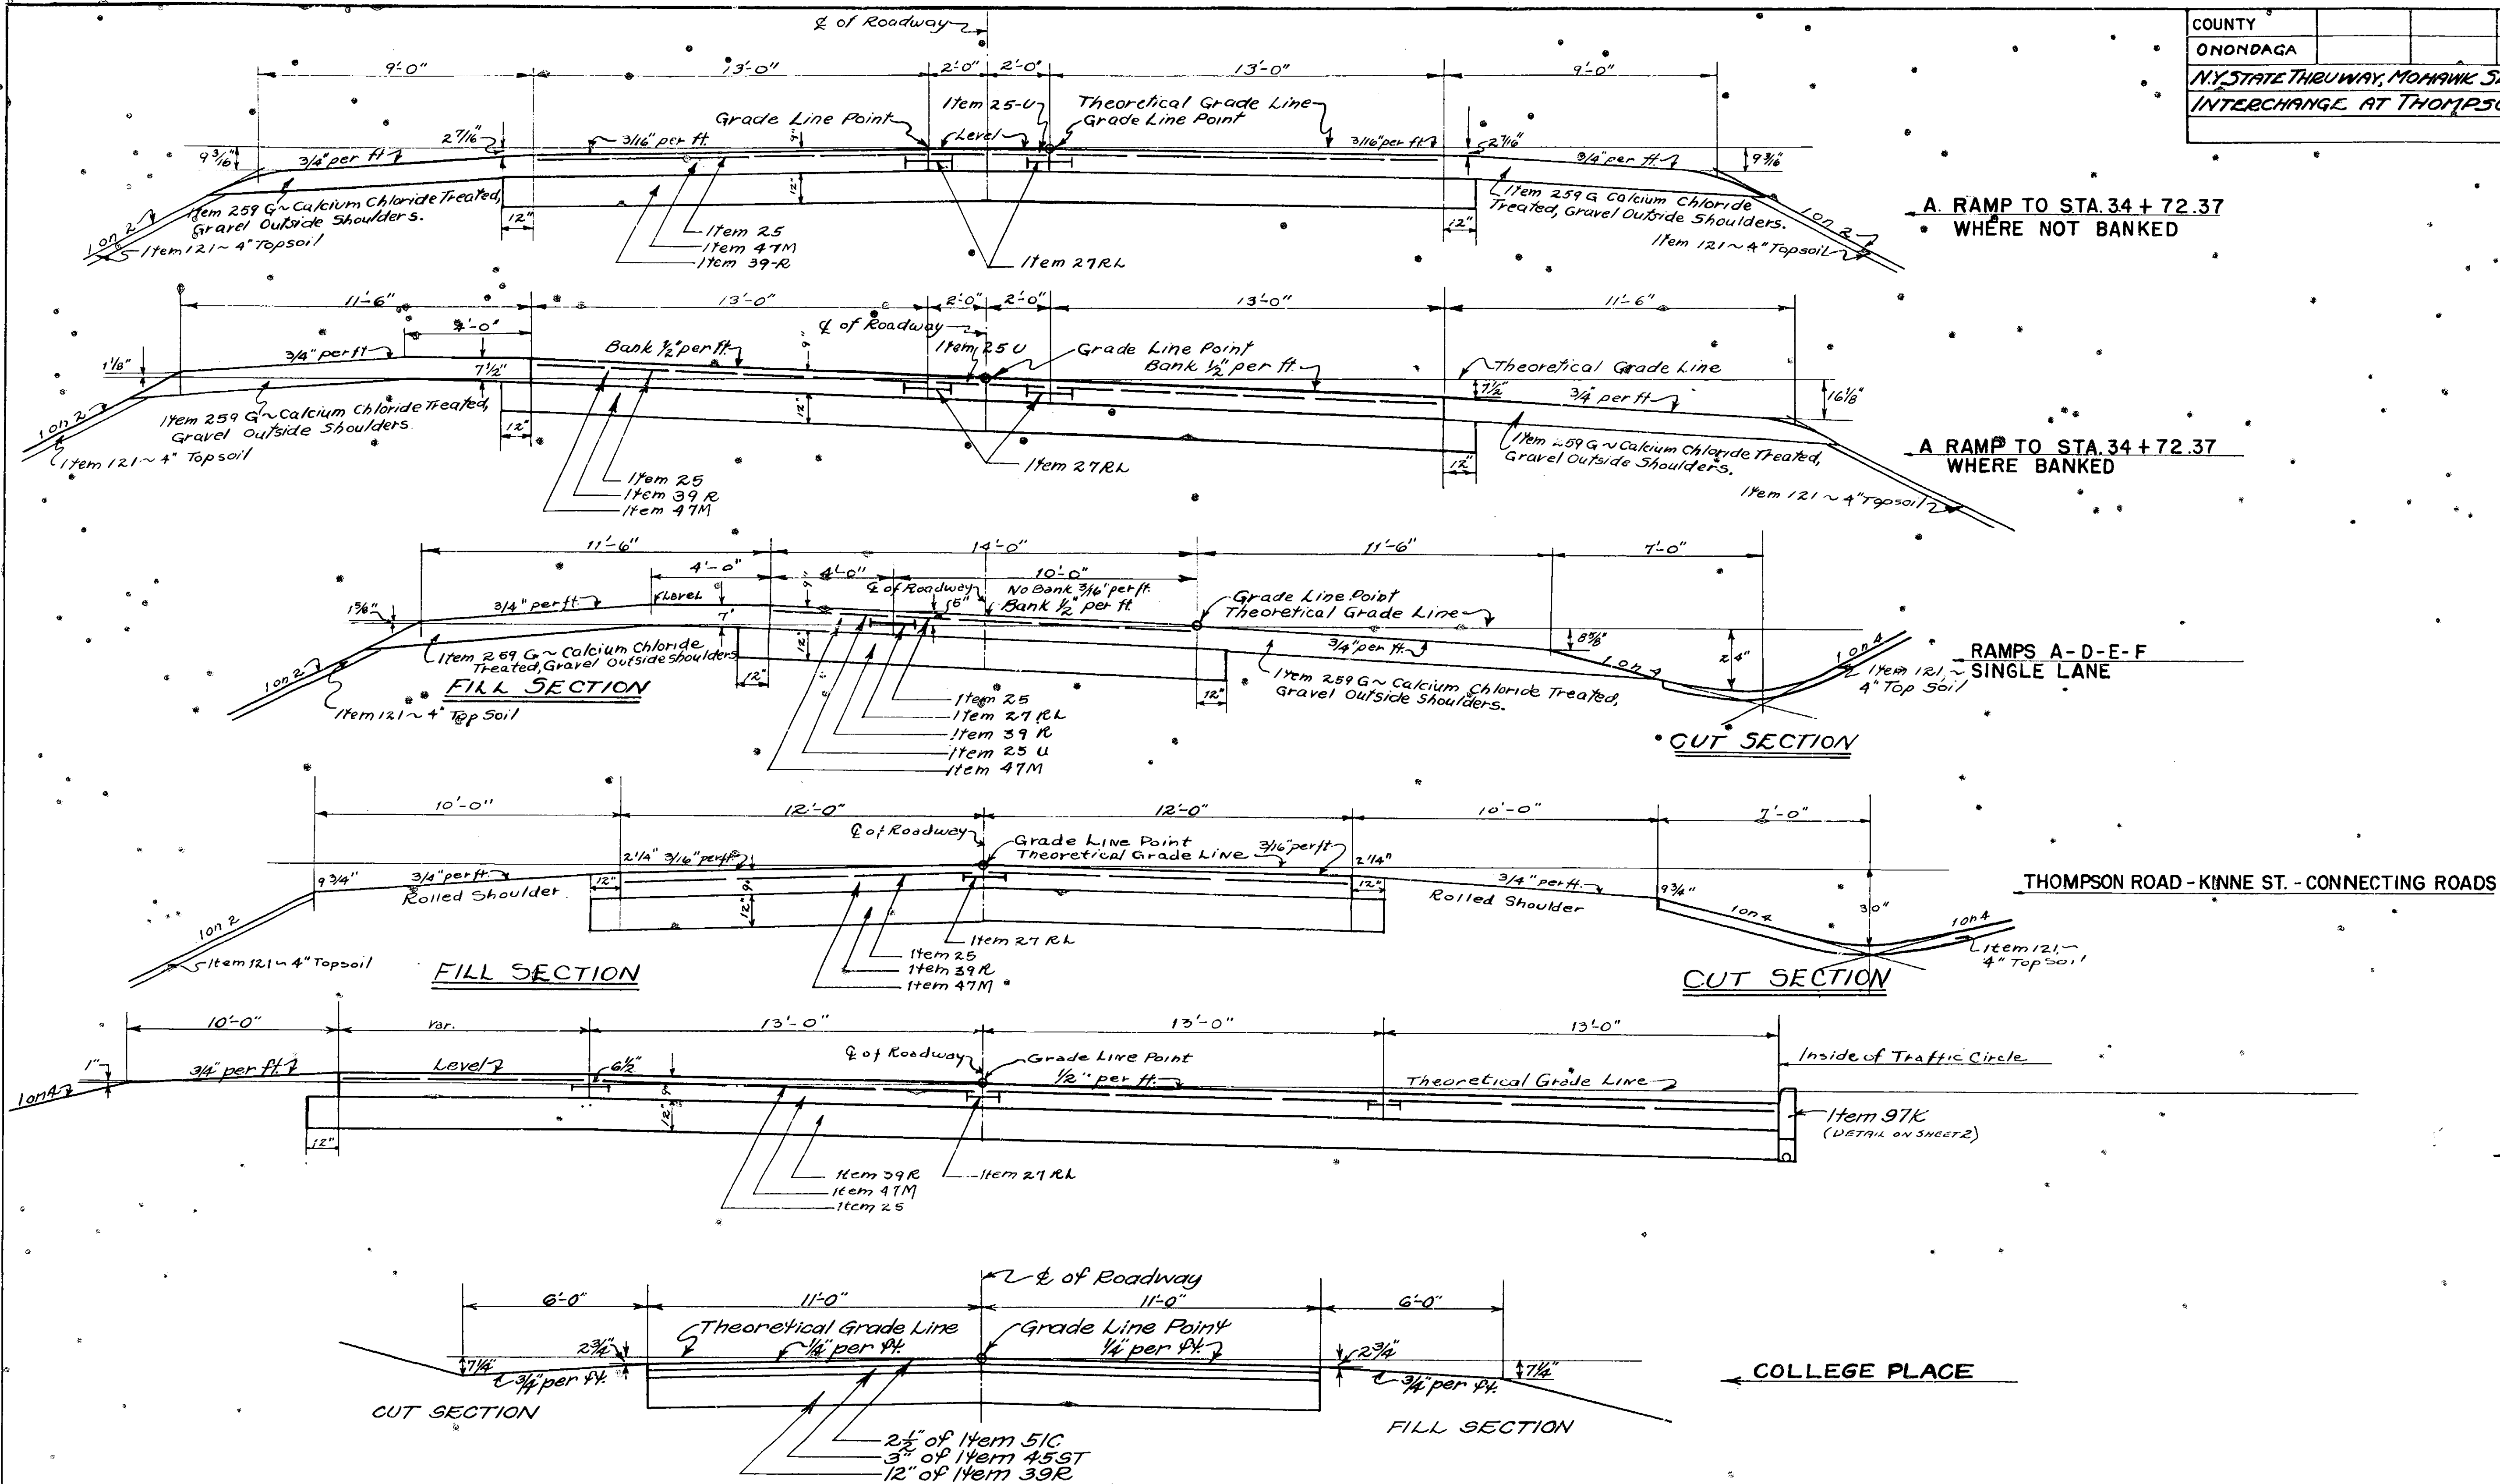

PREPARED AND RECOMMENDED:


John Doyle Feb 16 - 63

URQUHART & DOYLE CONSULTING ENGINEERS
NEW YORK STATE PROFESSIONAL ENGINEERS LICENSE NO. 5667

THOMPSON ROAD TRAFFIC INTERCHANGE
TRAFFIC CIRCLE
AND ADJACENT CONNECTING HIGHWAYS
NEW YORK STATE THRUWAY MOHAWK SECTION

SHEET

COUNTY	ONONDAGA	SHEET NO.	25	TOTAL SHEETS	66
N.Y. STATE THRUWAY, MOHAWK SECTION SUB DIV.					
INTERCHANGE AT THOMPSON ROAD					

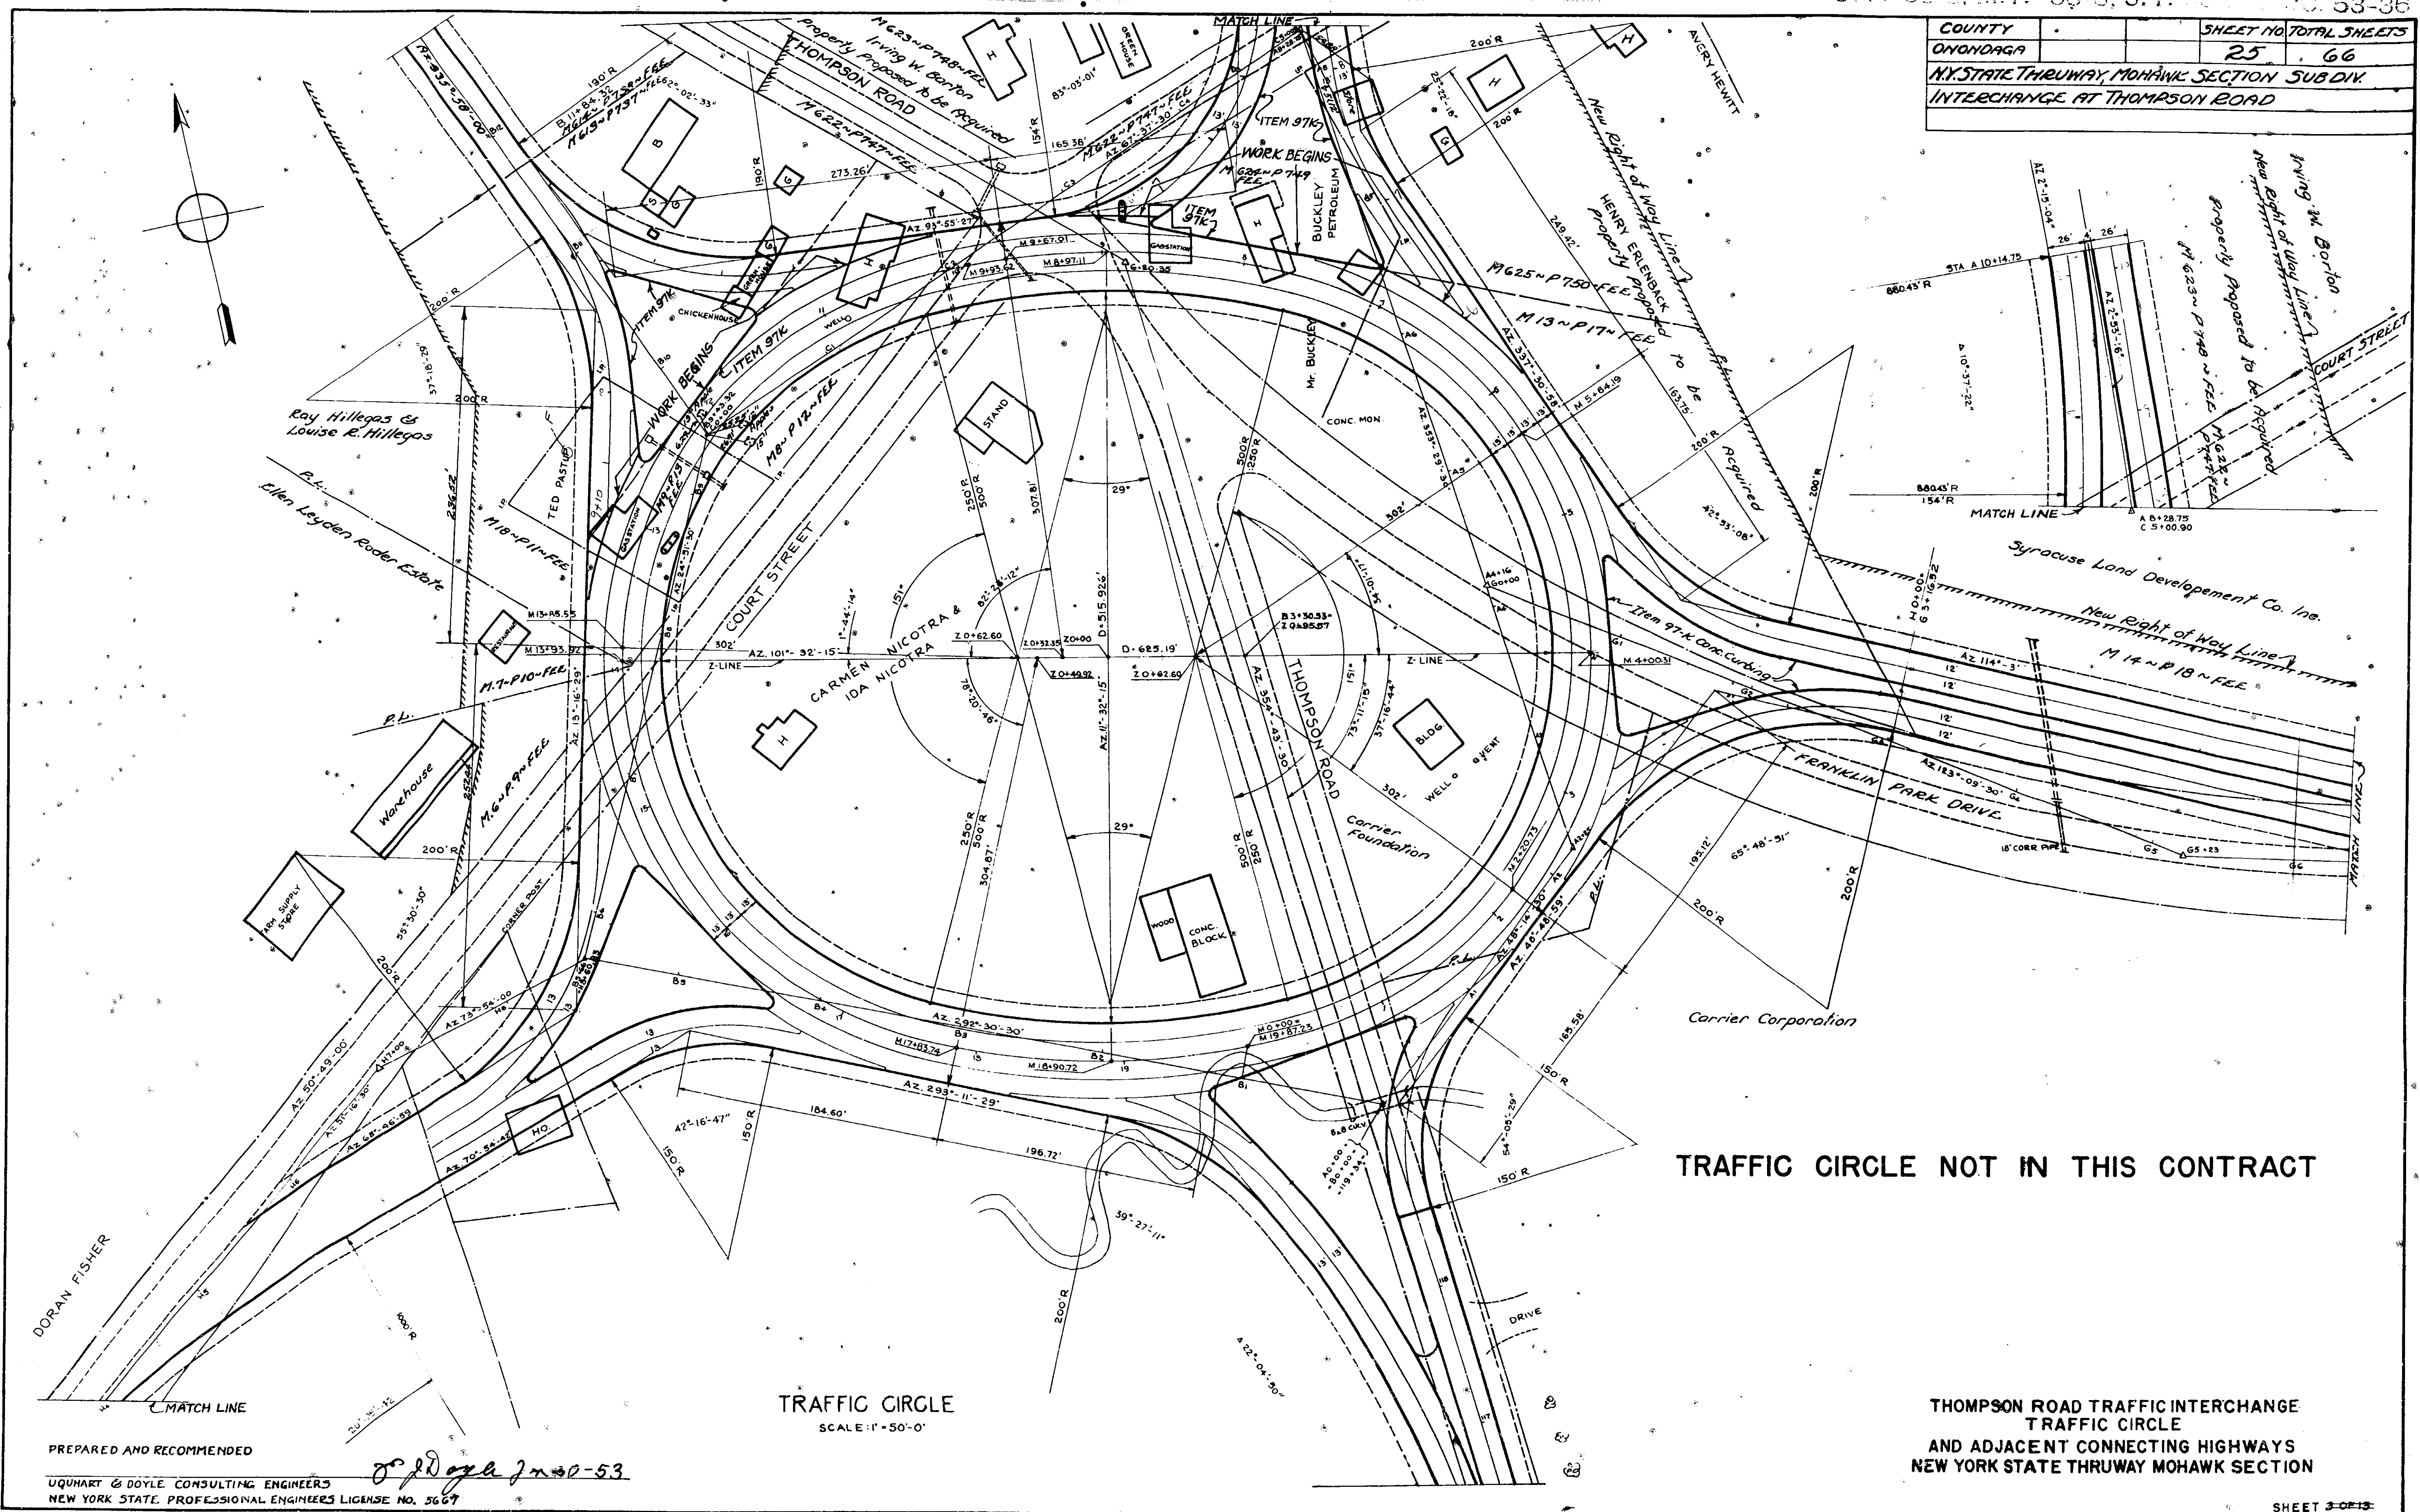


TRAFFIC CIRCLE
SCALE: 1" = 50'-0"

TRAFFIC CIRCLE NOT IN THIS CONTRACT

THOMPSON ROAD TRAFFIC INTERCHANGE
TRAFFIC CIRCLE
AND ADJACENT CONNECTING HIGHWAYS
NEW YORK STATE THRUWAY MOHAWK SECTION

PREPARED AND RECOMMENDED
UQUHART & DOYLE CONSULTING ENGINEERS
NEW YORK STATE PROFESSIONAL ENGINEERS LICENSE NO. 5667
J. J. Doyle 7-10-53

COUNTY	SHEET NO.	TOTAL SHEETS
ONONDAGA	25	66
N.Y. STATE THRUWAY, MOHAWK SECTION SUB DIV.		
INTERCHANGE AT THOMPSON ROAD		

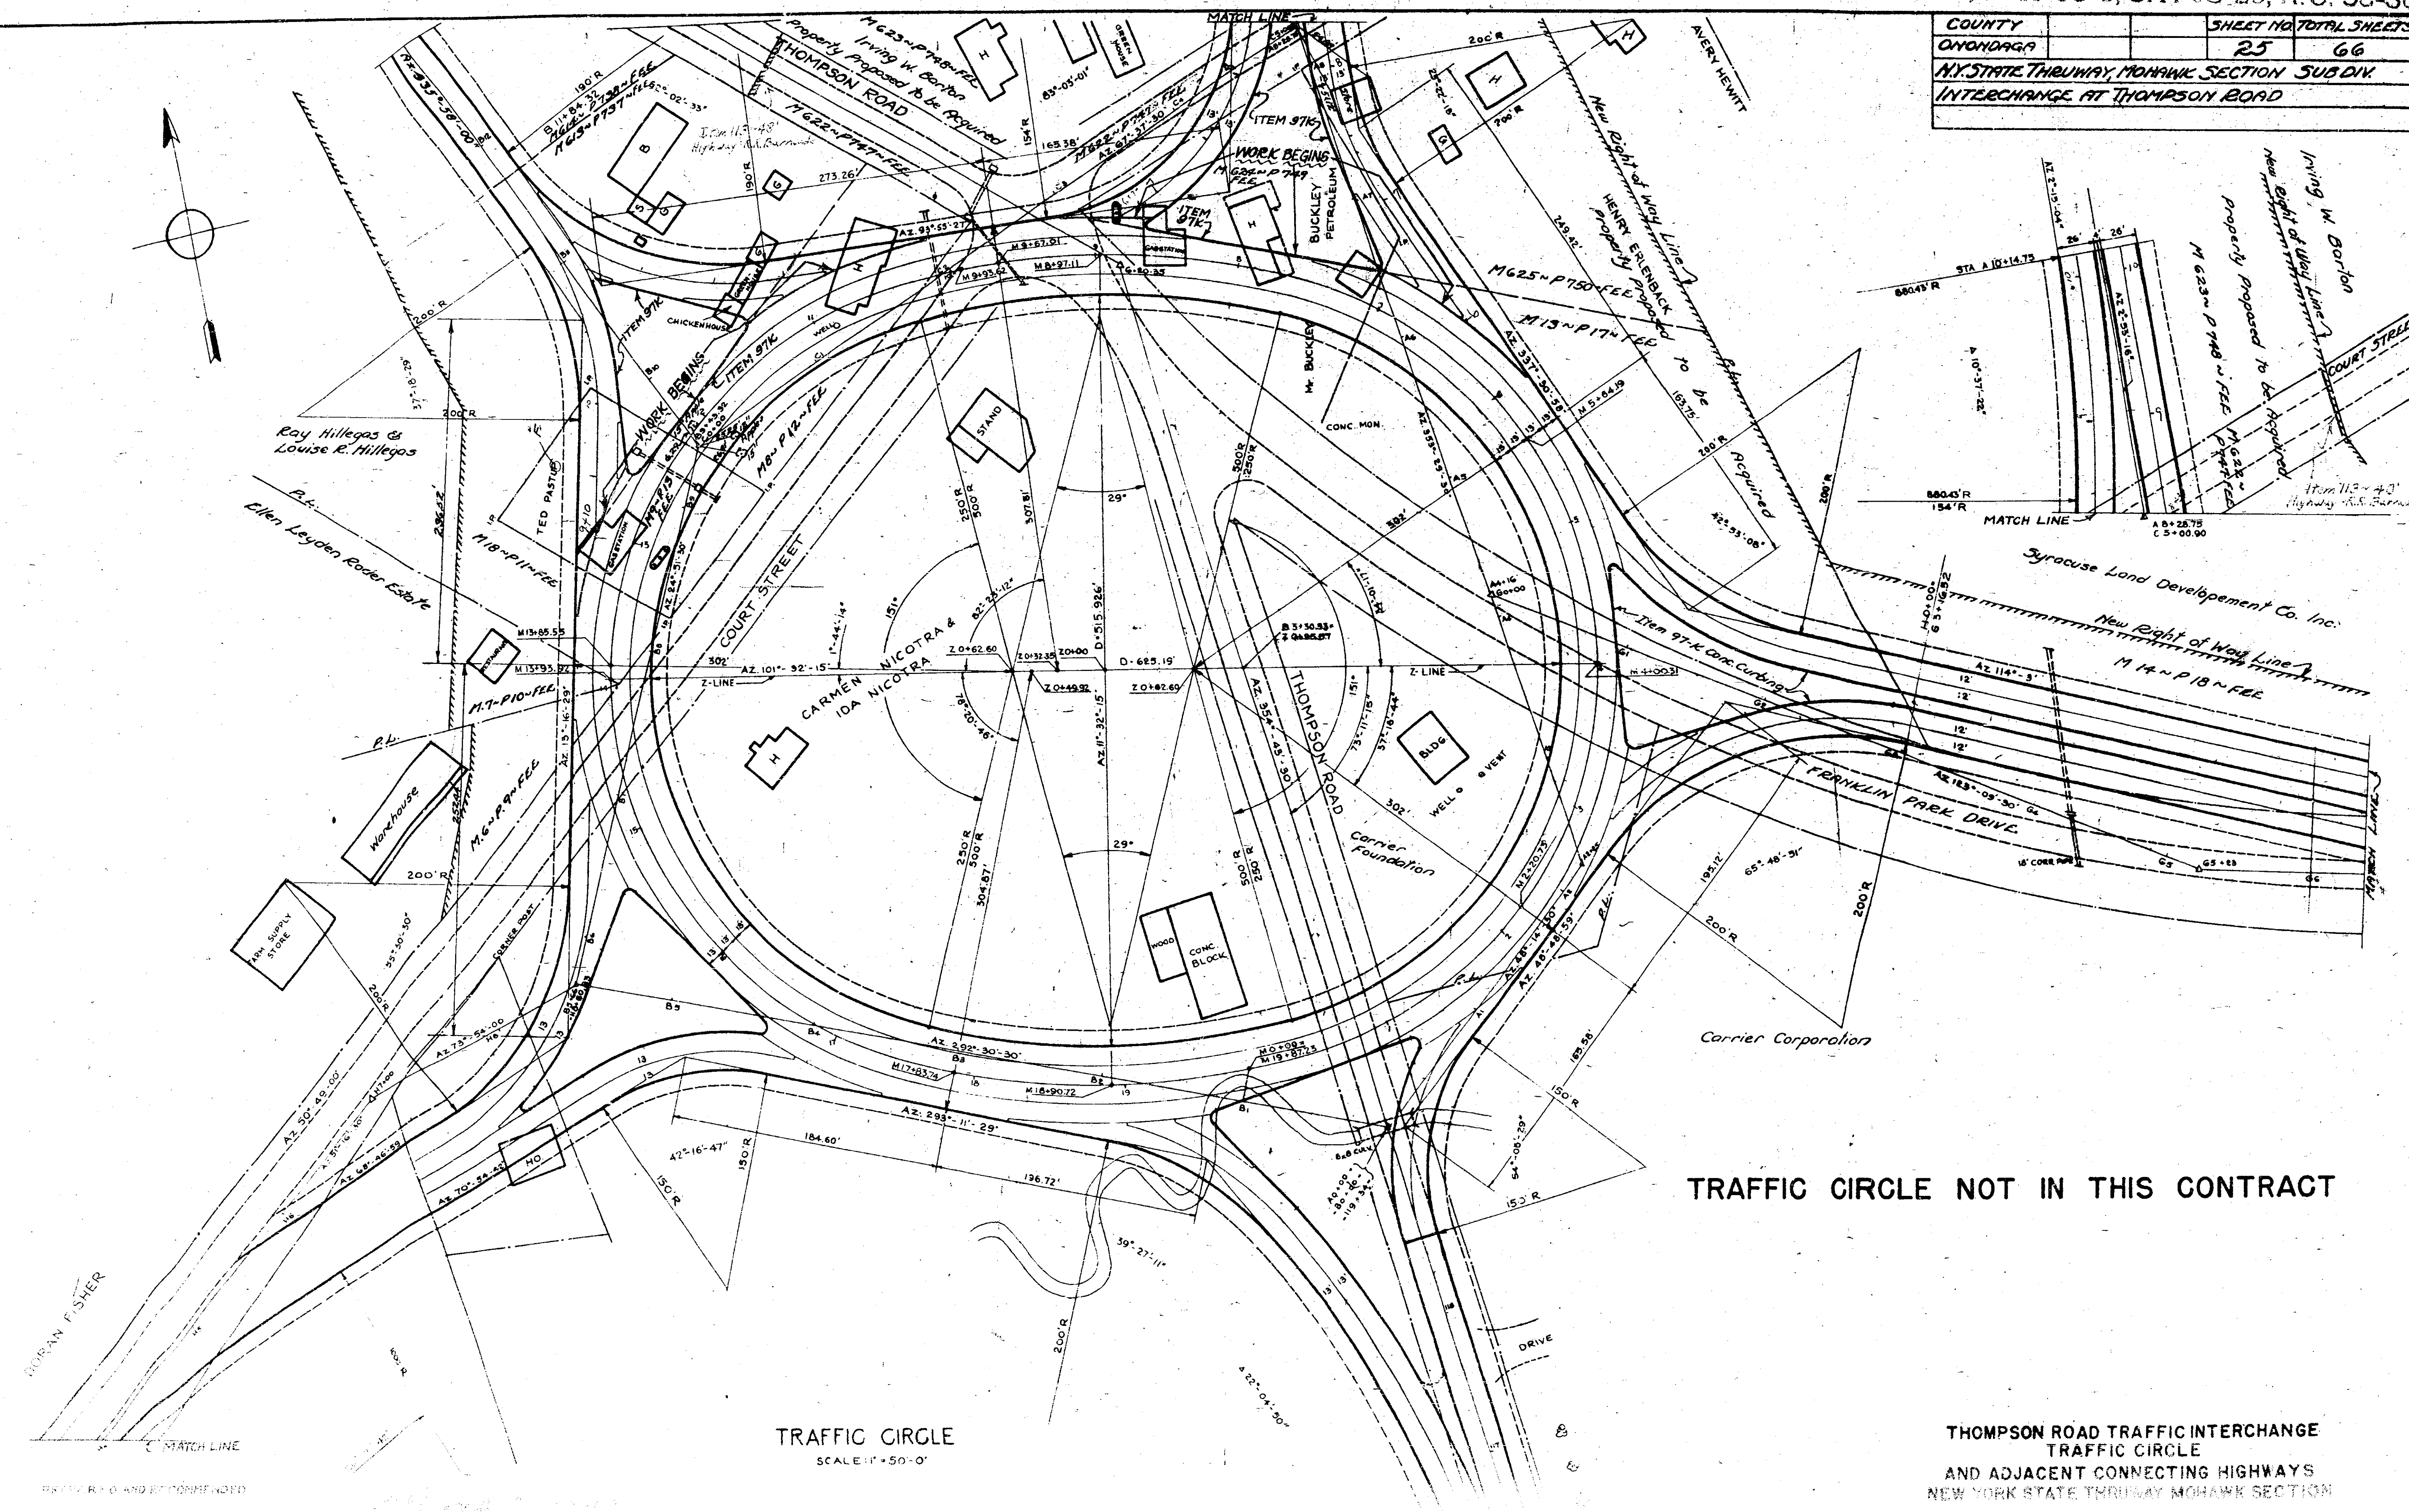


TRAFFIC CIRCLE
SCALE 1" = 50'-0"

TRAFFIC CIRCLE NOT IN THIS CONTRACT

THOMPSON ROAD TRAFFIC INTERCHANGE
TRAFFIC CIRCLE
AND ADJACENT CONNECTING HIGHWAYS
NEW YORK STATE THRUWAY MOHAWK SECTION


130' left Sta. B34+00. Build 18" RCP Culv. 60' long. Dig
necessary inlet & outlet ditches.
B38+00, Build 18" RCP Culv. 60' long with "L"
shape headwall on inlet end.
B38+58 E. Remove existing box culv. under road
and build 24" RCP Culv. 88' long. Connect outlet
end to existing 20" Conc. Pipe.

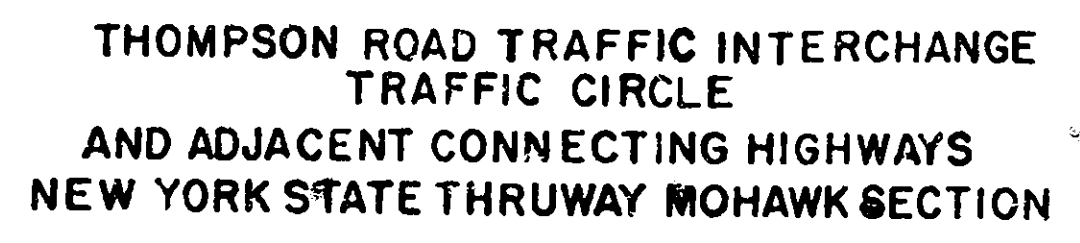

See prints of Maps 497 and 623 for offsets

COUNTY	SHEET NO.	TOTAL SHEETS
ONONDAGA	26	66
N.Y. STATE THRUWAY, MOHAWK SECTION SUB DIV. B B		
INTERCHANGE AT THOMPSON ROAD		

26R

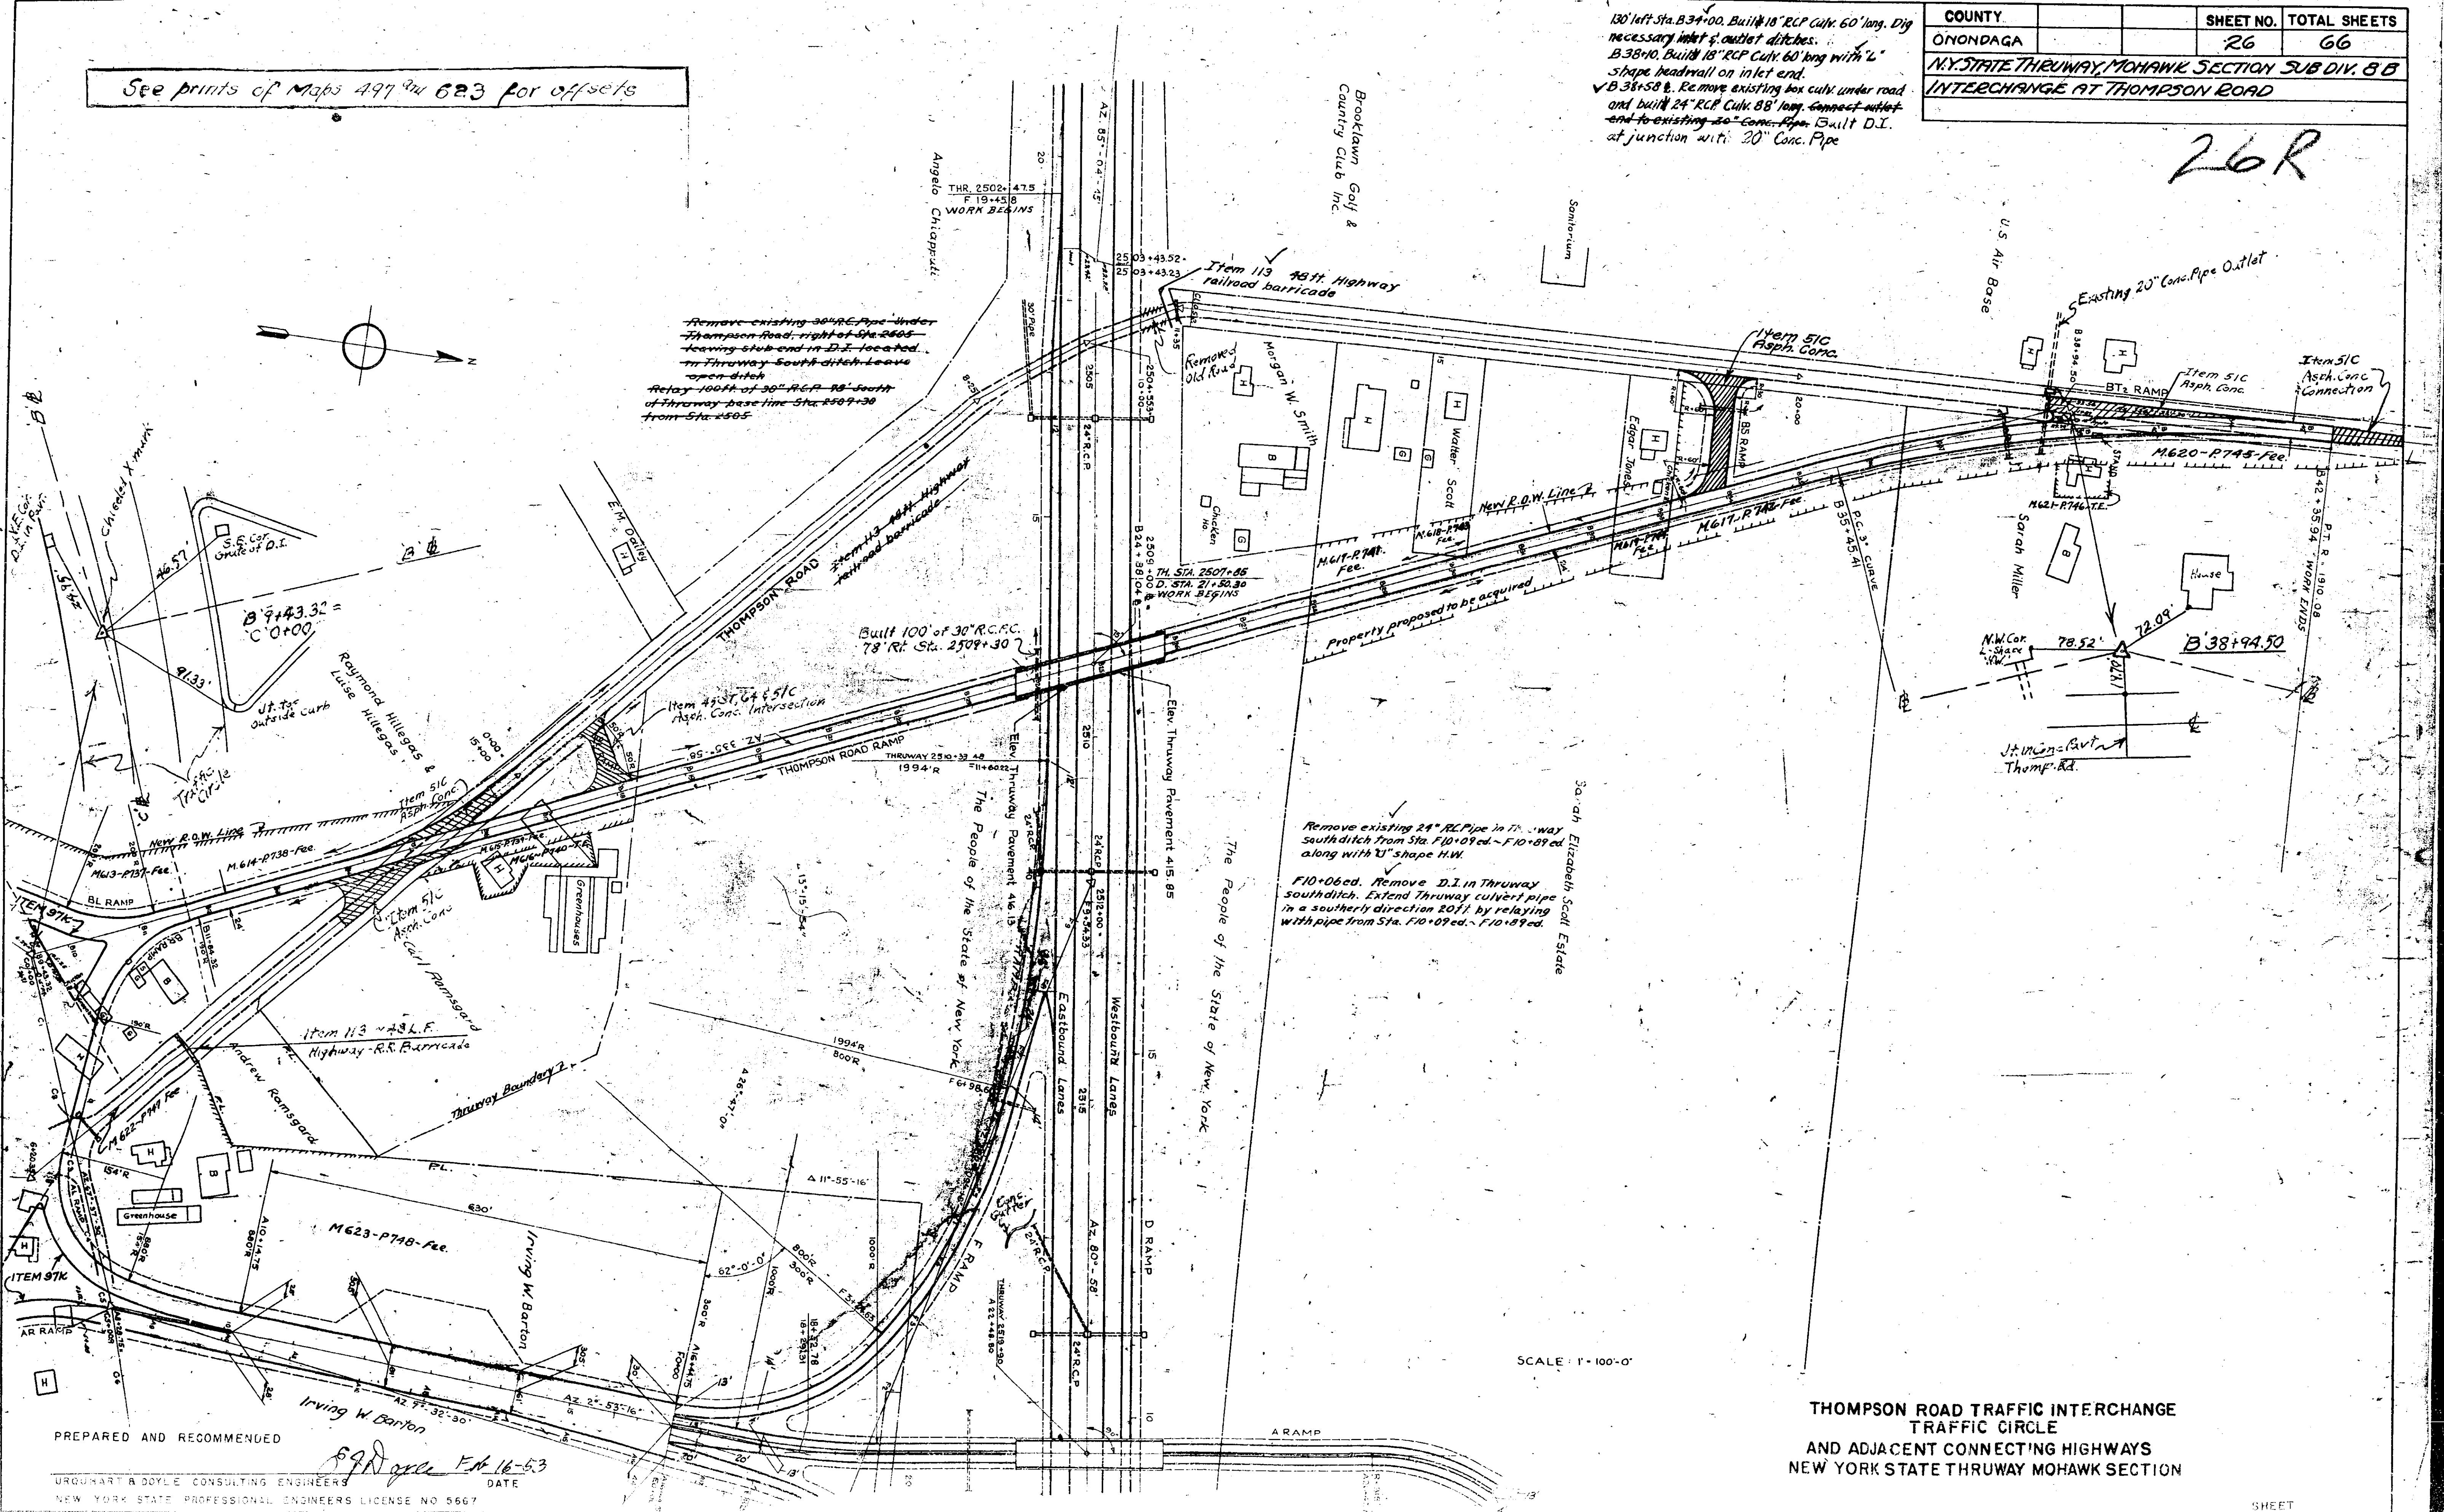

SCALE: 1" = 100'-0"


THOMPSON ROAD TRAFFIC INTERCHANGE
TRAFFIC CIRCLE
AND ADJACENT CONNECTING HIGHWAYS
NEW YORK STATE THRUWAY MOHAWK SECTION

PREPARED AND RECOMMENDED

URGENT & DOYLE CONSULTING ENGINEERS
NEW YORK STATE PROFESSIONAL ENGINEERS LICENSE NO 5667
DATE 10-16-53

SHEET

COUNTY	SHEET NO.	TOTAL SHEETS
ONONDAGA	27	66
N.Y. STATE THRUWAY, MOHAWK SECTION, SUBDIV. B8		
INTERCHANGE AT THOMPSON ROAD		
COLLEGE PLACE		

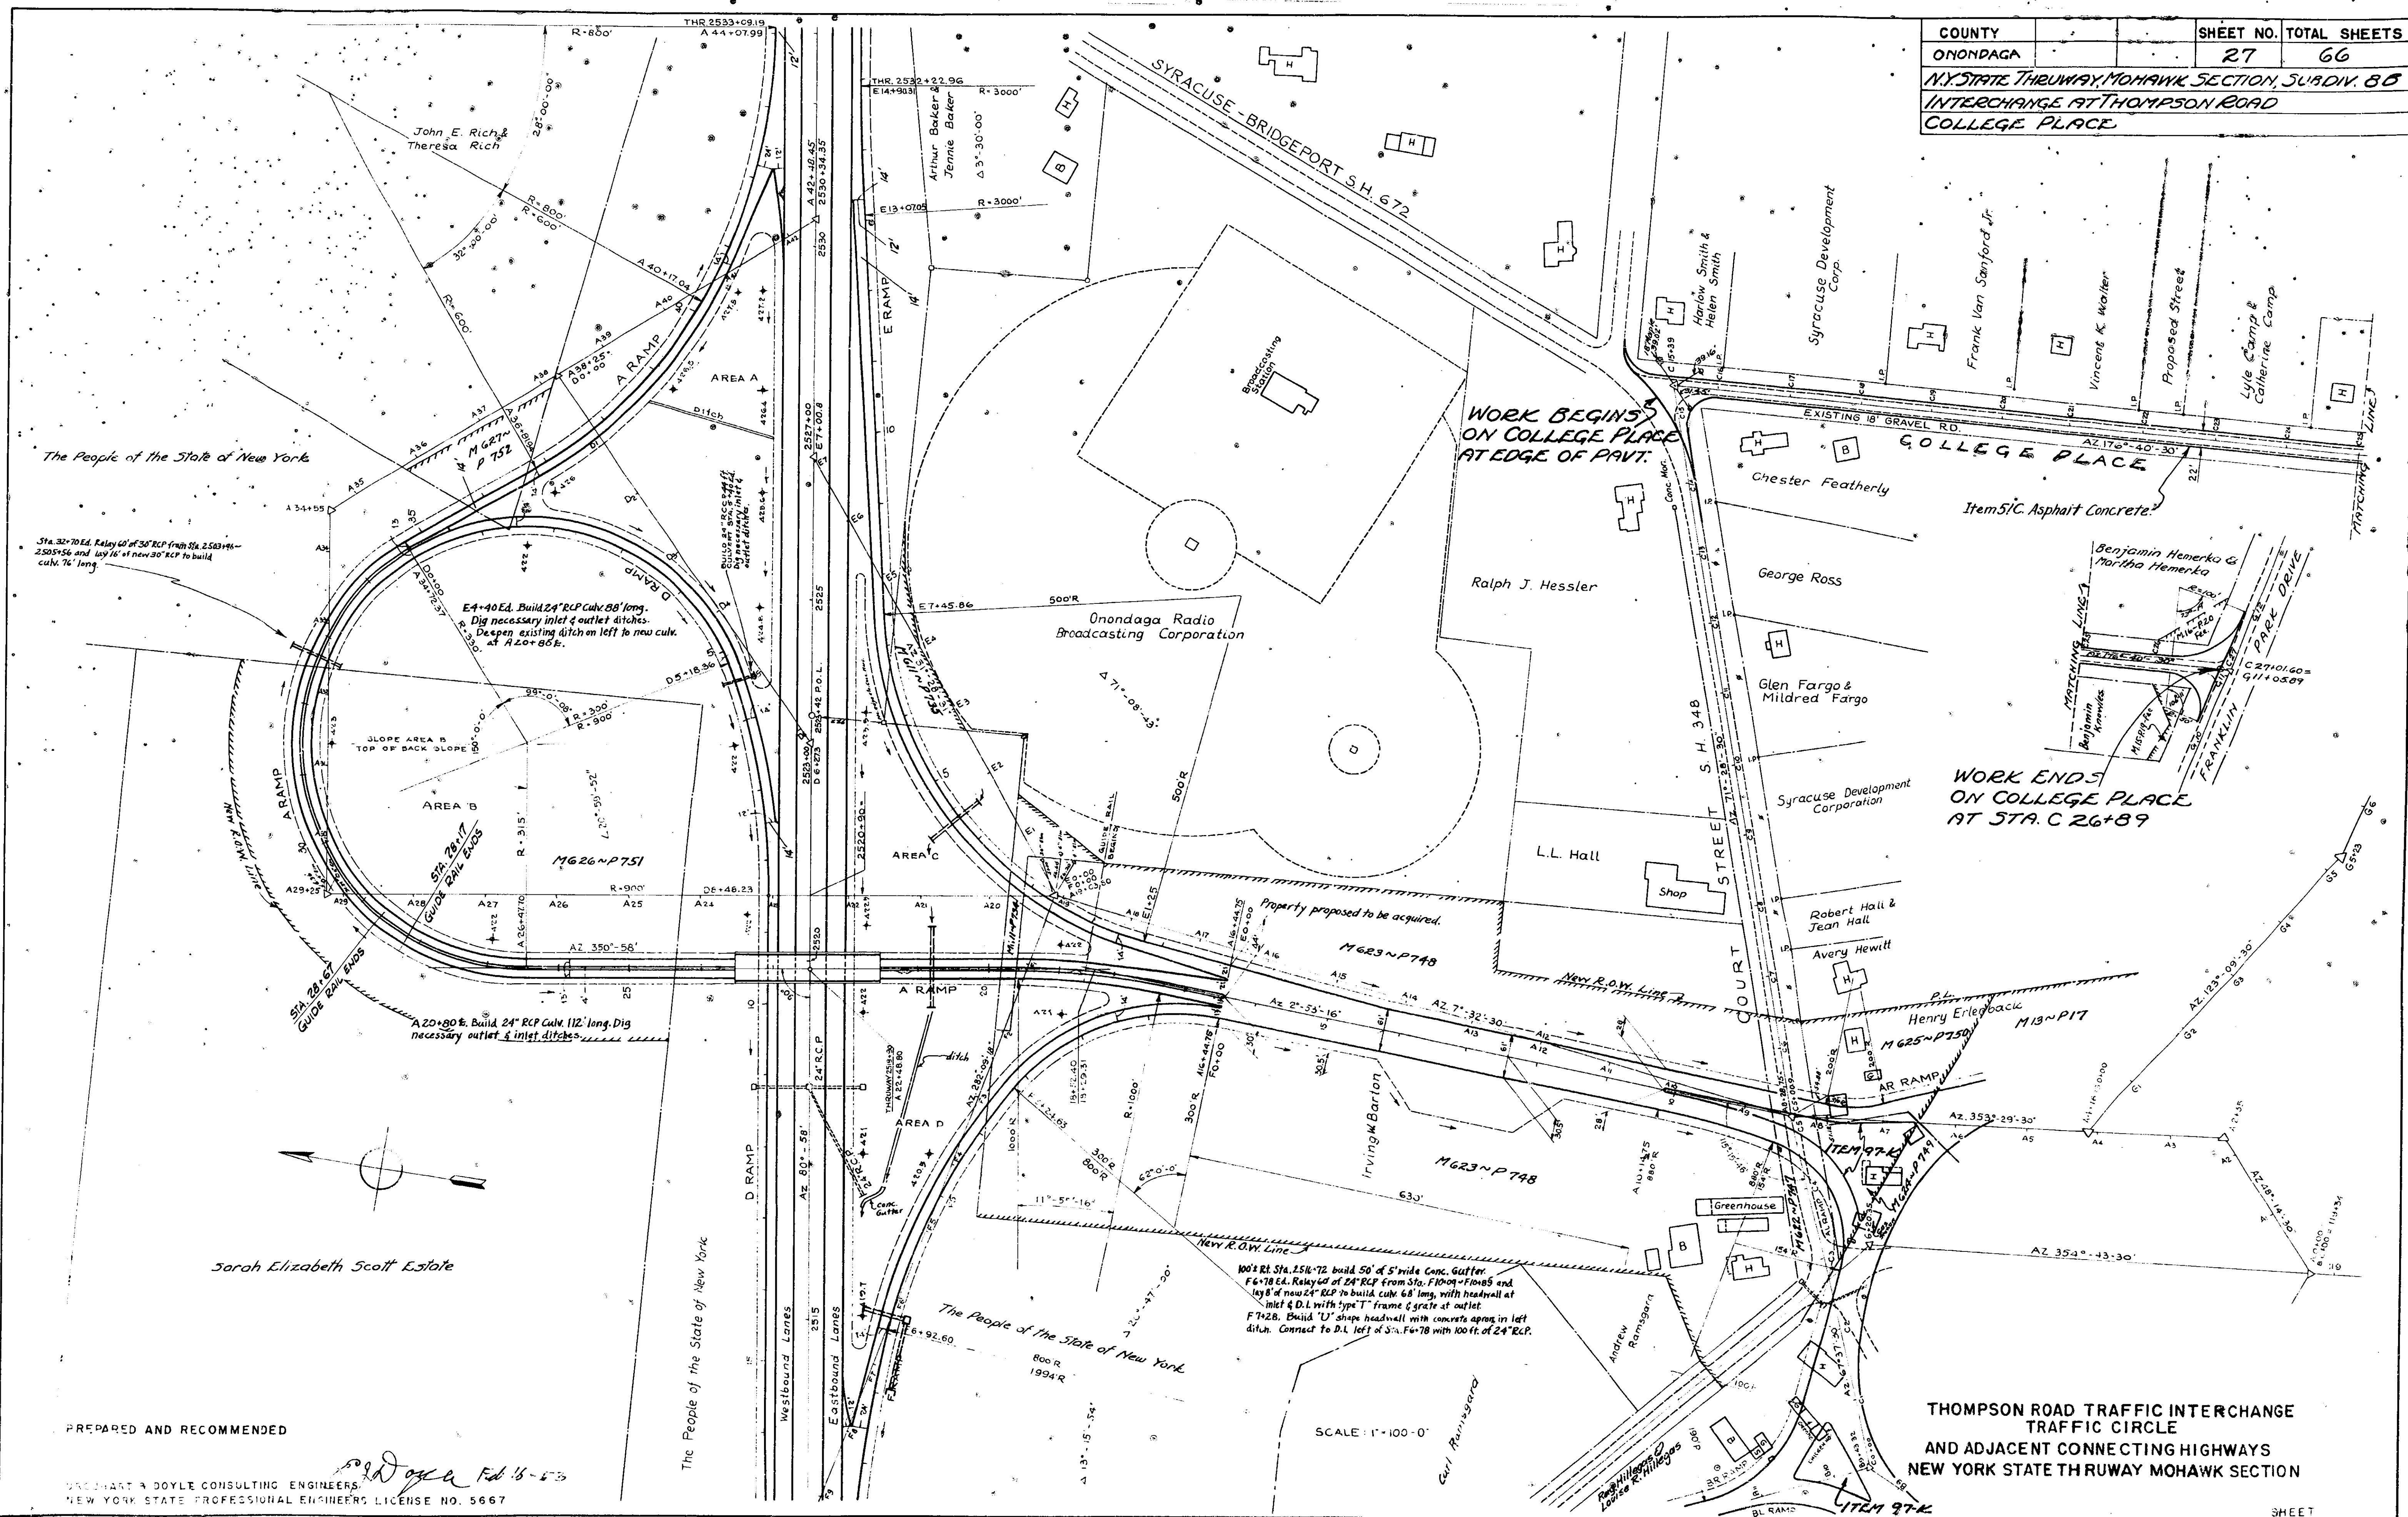


PREPARED AND RECOMMENDED

W. D. Doyle & Co. Inc. Feb 15 - 53
 NEW YORK STATE PROFESSIONAL ENGINEERS LICENSE NO. 5667

THOMPSON ROAD TRAFFIC INTERCHANGE
 TRAFFIC CIRCLE
 AND ADJACENT CONNECTING HIGHWAYS
 NEW YORK STATE THRUWAY MOHAWK SECTION

SHEET


27R

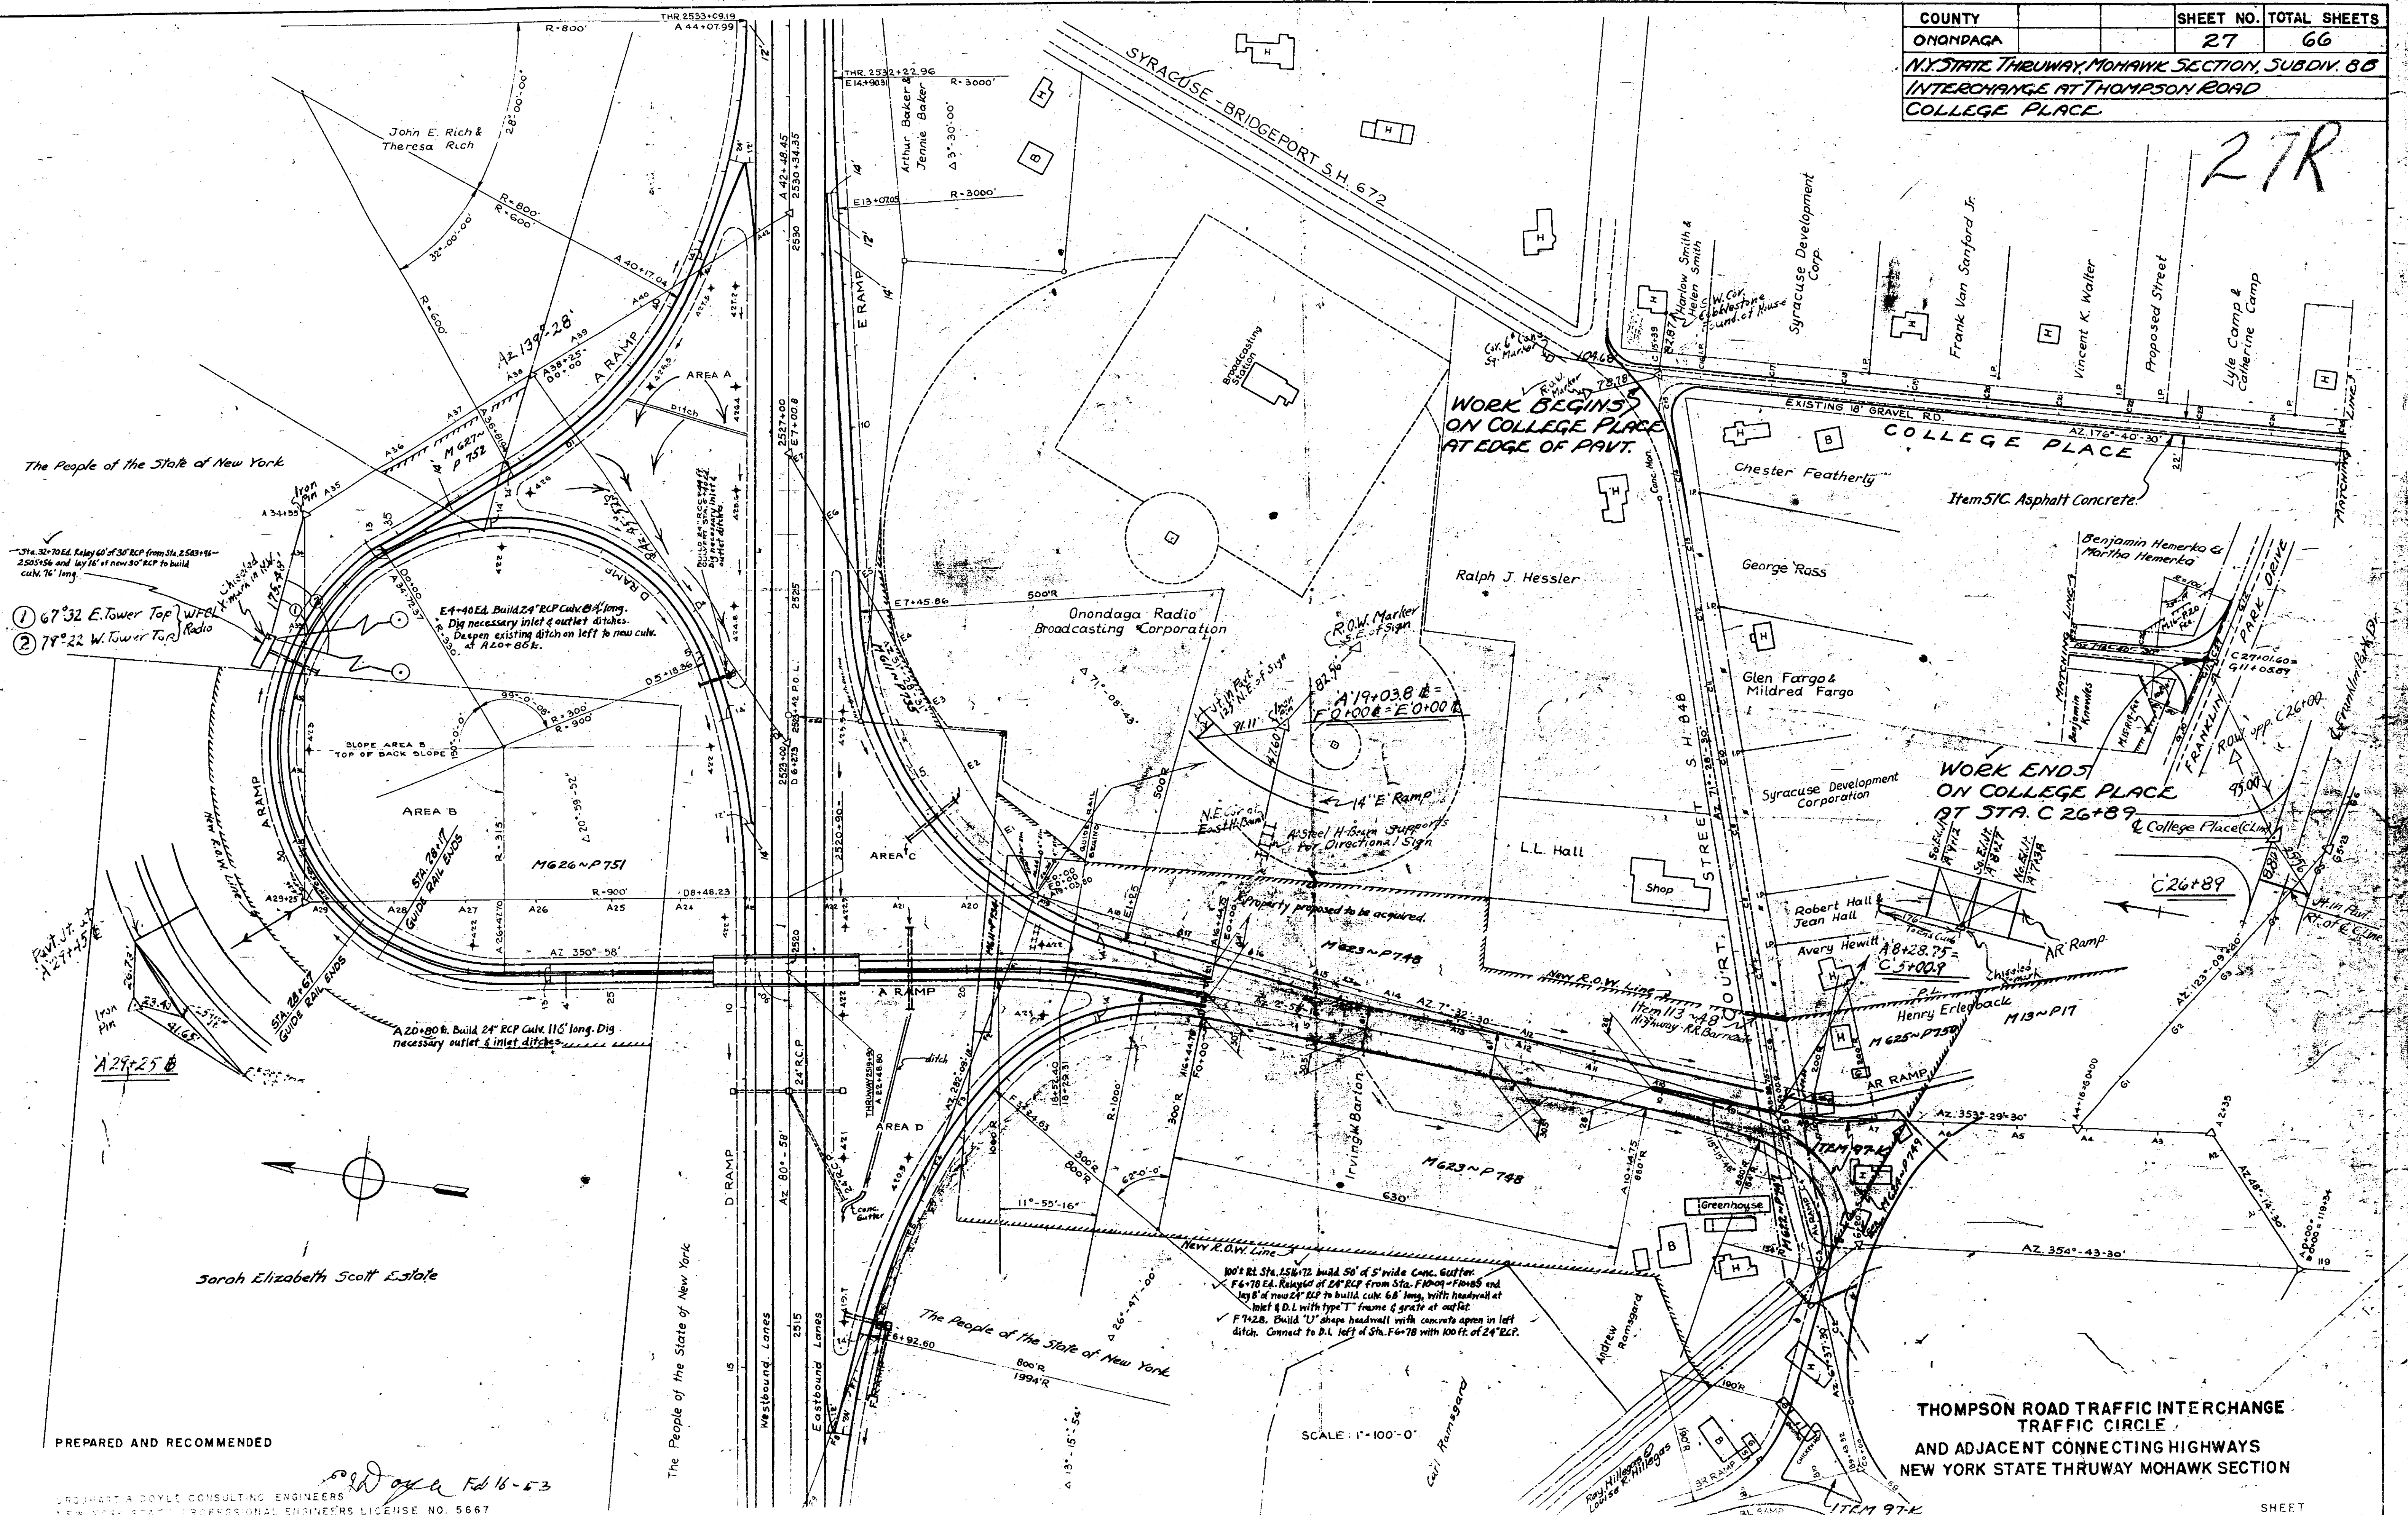

THOMPSON ROAD TRAFFIC INTERCHANGE
TRAFFIC CIRCLE
AND ADJACENT CONNECTING HIGHWAYS
NEW YORK STATE THRUWAY MOHAWK SECTION

SHFF


COUNTY	SHEET NO.	TOTAL SHEETS
ONONDAGA	28	66
N.Y. STATE THRUWAY, MOHAWK SECTION SUBDIV. B B		
INTERCHANGE AT THOMPSON ROAD		

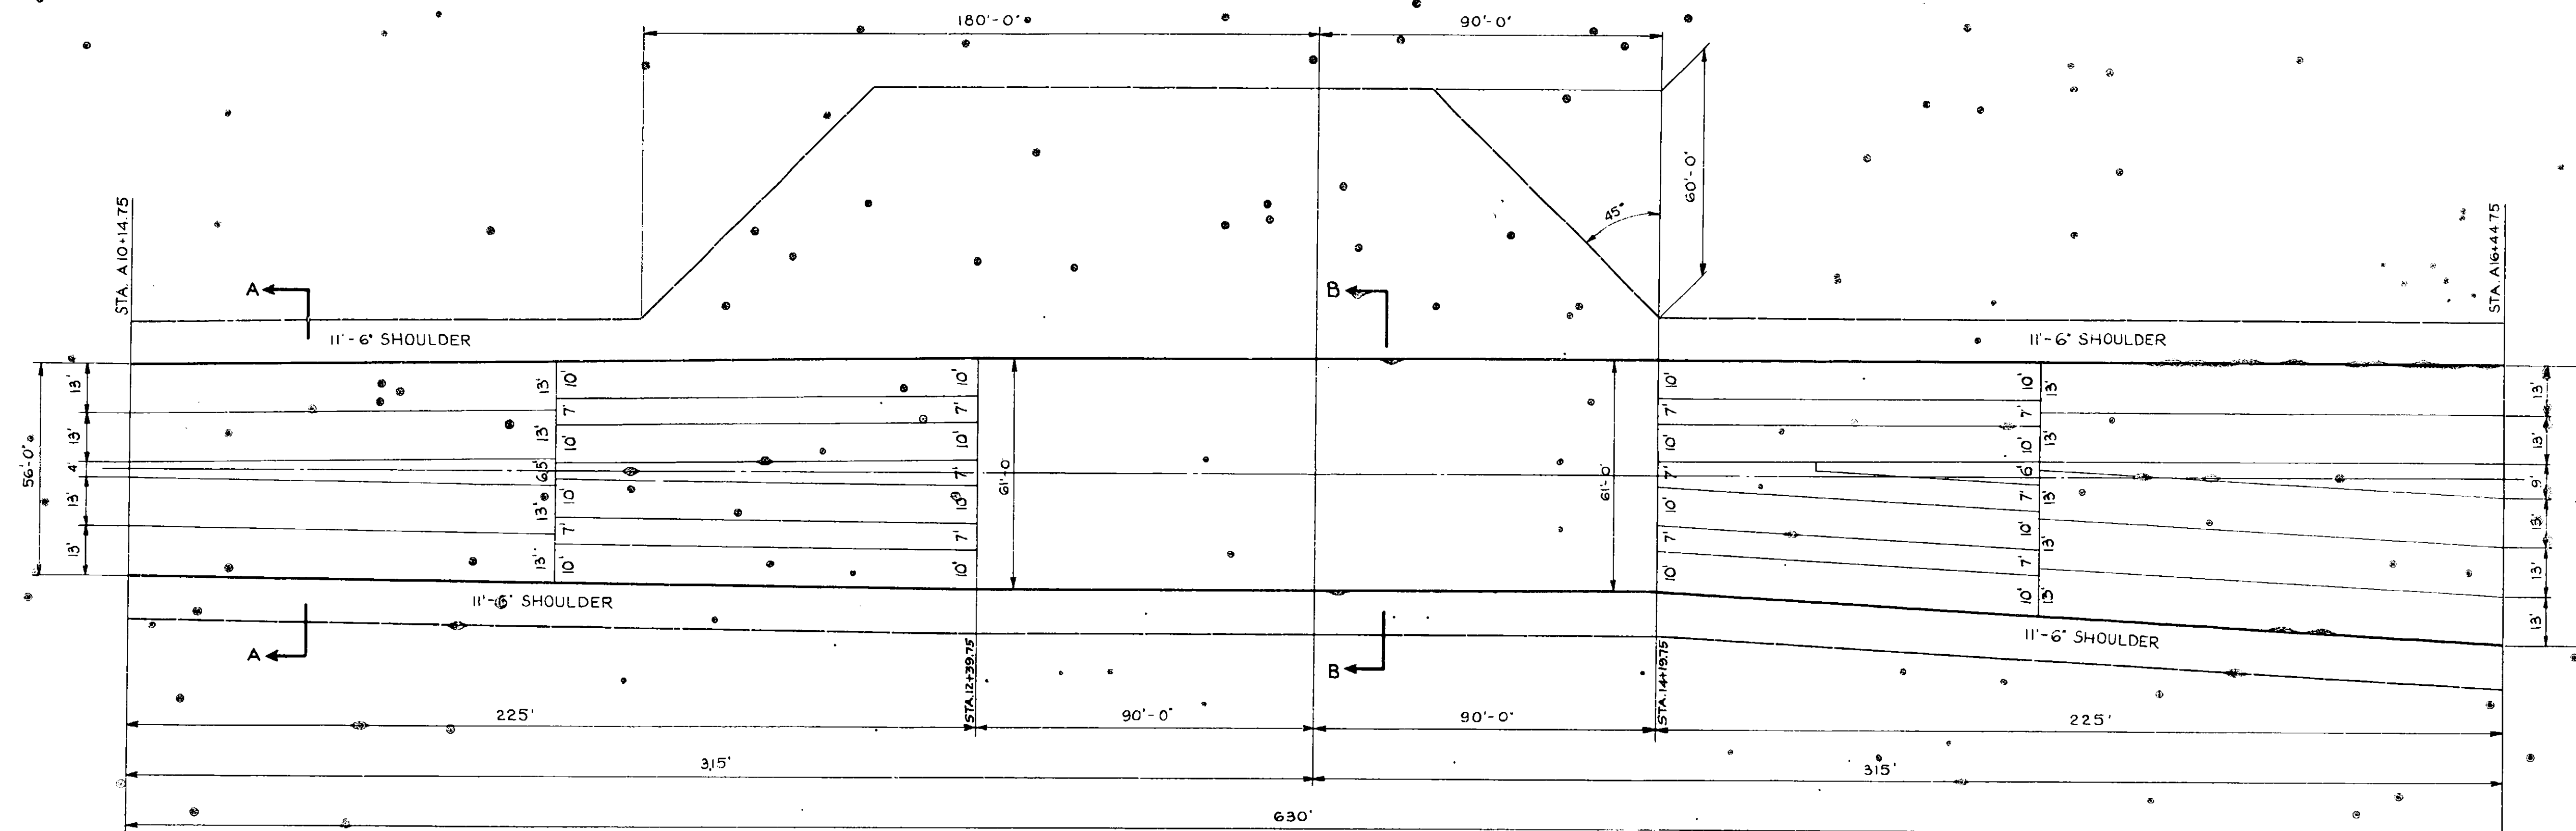

CONTROL AREA PLAN


SCALE: 1" = 25'

STA. 12+39.75 Gravel Foundation Course Item 39R, 12" deep
to
STA. 14+19.75 is to be placed. Cement Concrete Pavement
Item 41M is to be omitted in this section.

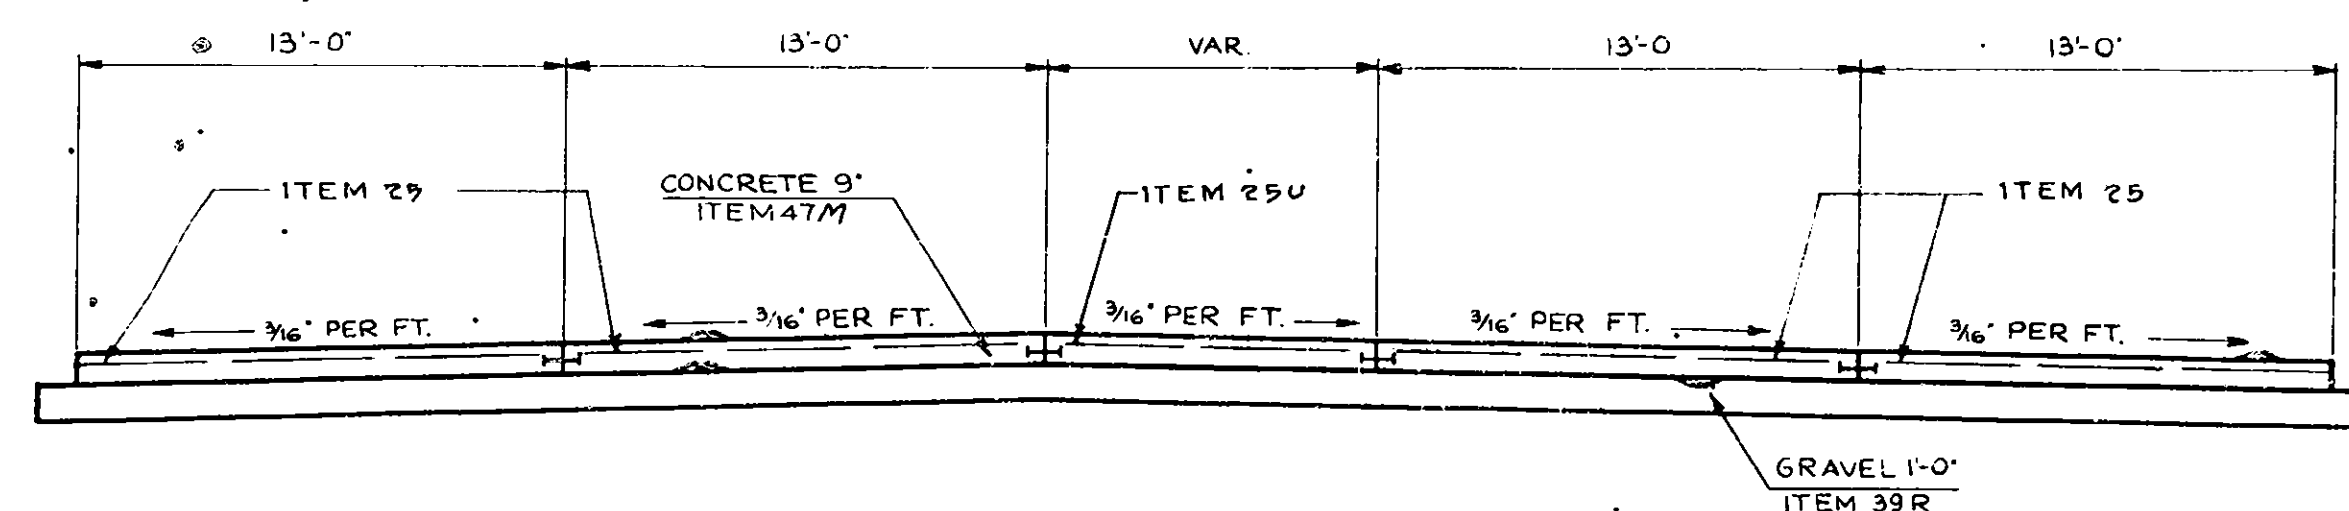

SECTION A-A

SCALE: 1" = 5'-0"

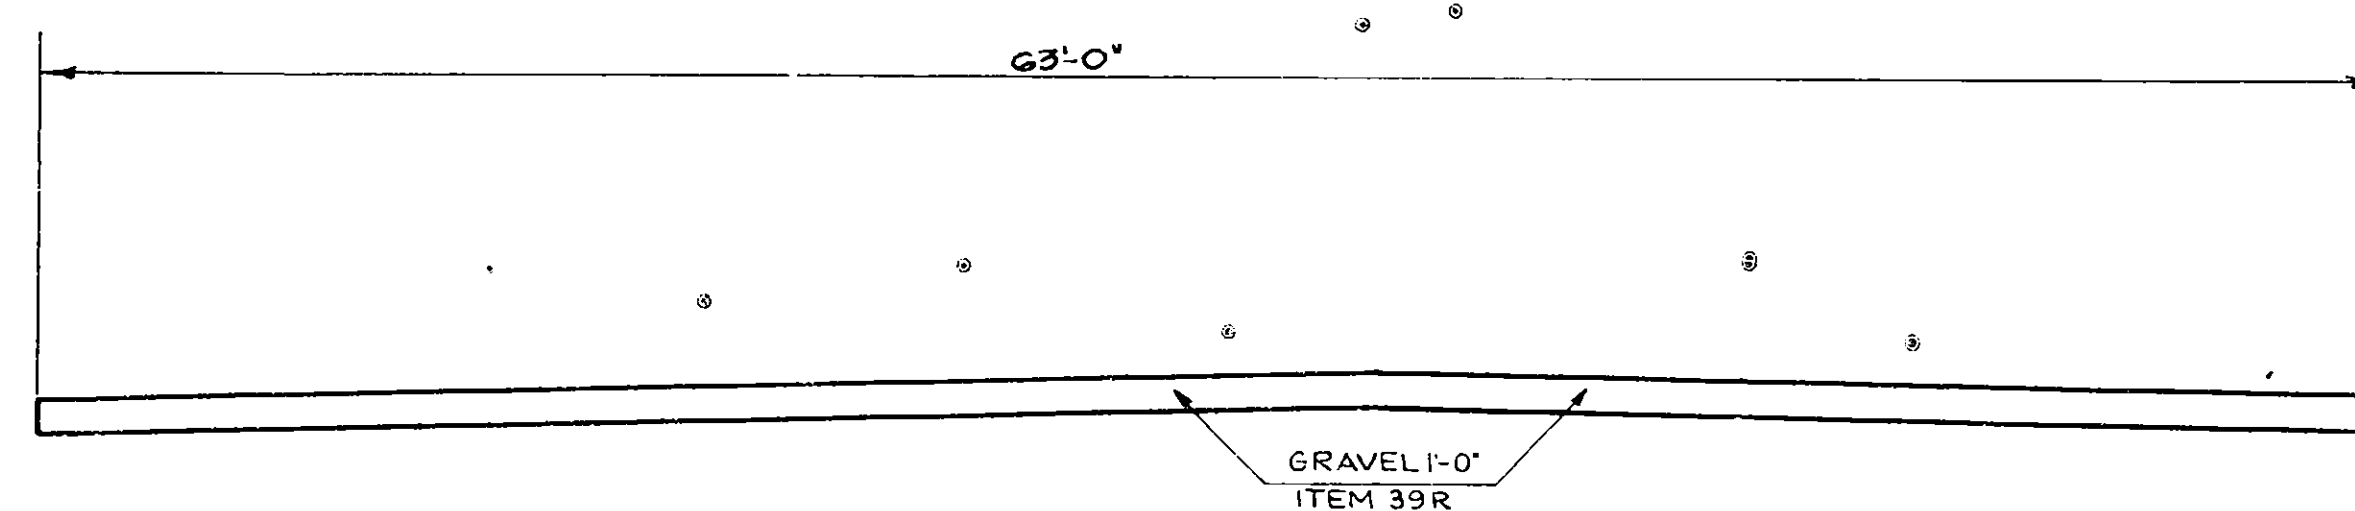

SECTION B-B

SCALE: 1" = 5'-0"

CONTROL AREA PLAN

THOMPSON ROAD INTERCHANGE

MOHAWK SECTION

NEW YORK STATE THRUWAY

SHEET


PREPARED AND RECOMMENDED

URQUHART & COYLE CONSULTING ENGINEERS
NEW YORK STATE PROFESSIONAL ENGINEERS LICENSE NO. 5667

Feb 16-53

COUNTY	SHEET NO.	TOTAL SHEETS
ONONDAGA	28	66
N.Y. STATE THRUWAY, MOHAWK SECTION SUBDIV. 80		
INTERCHANGE AT THOMPSON ROAD		


28R

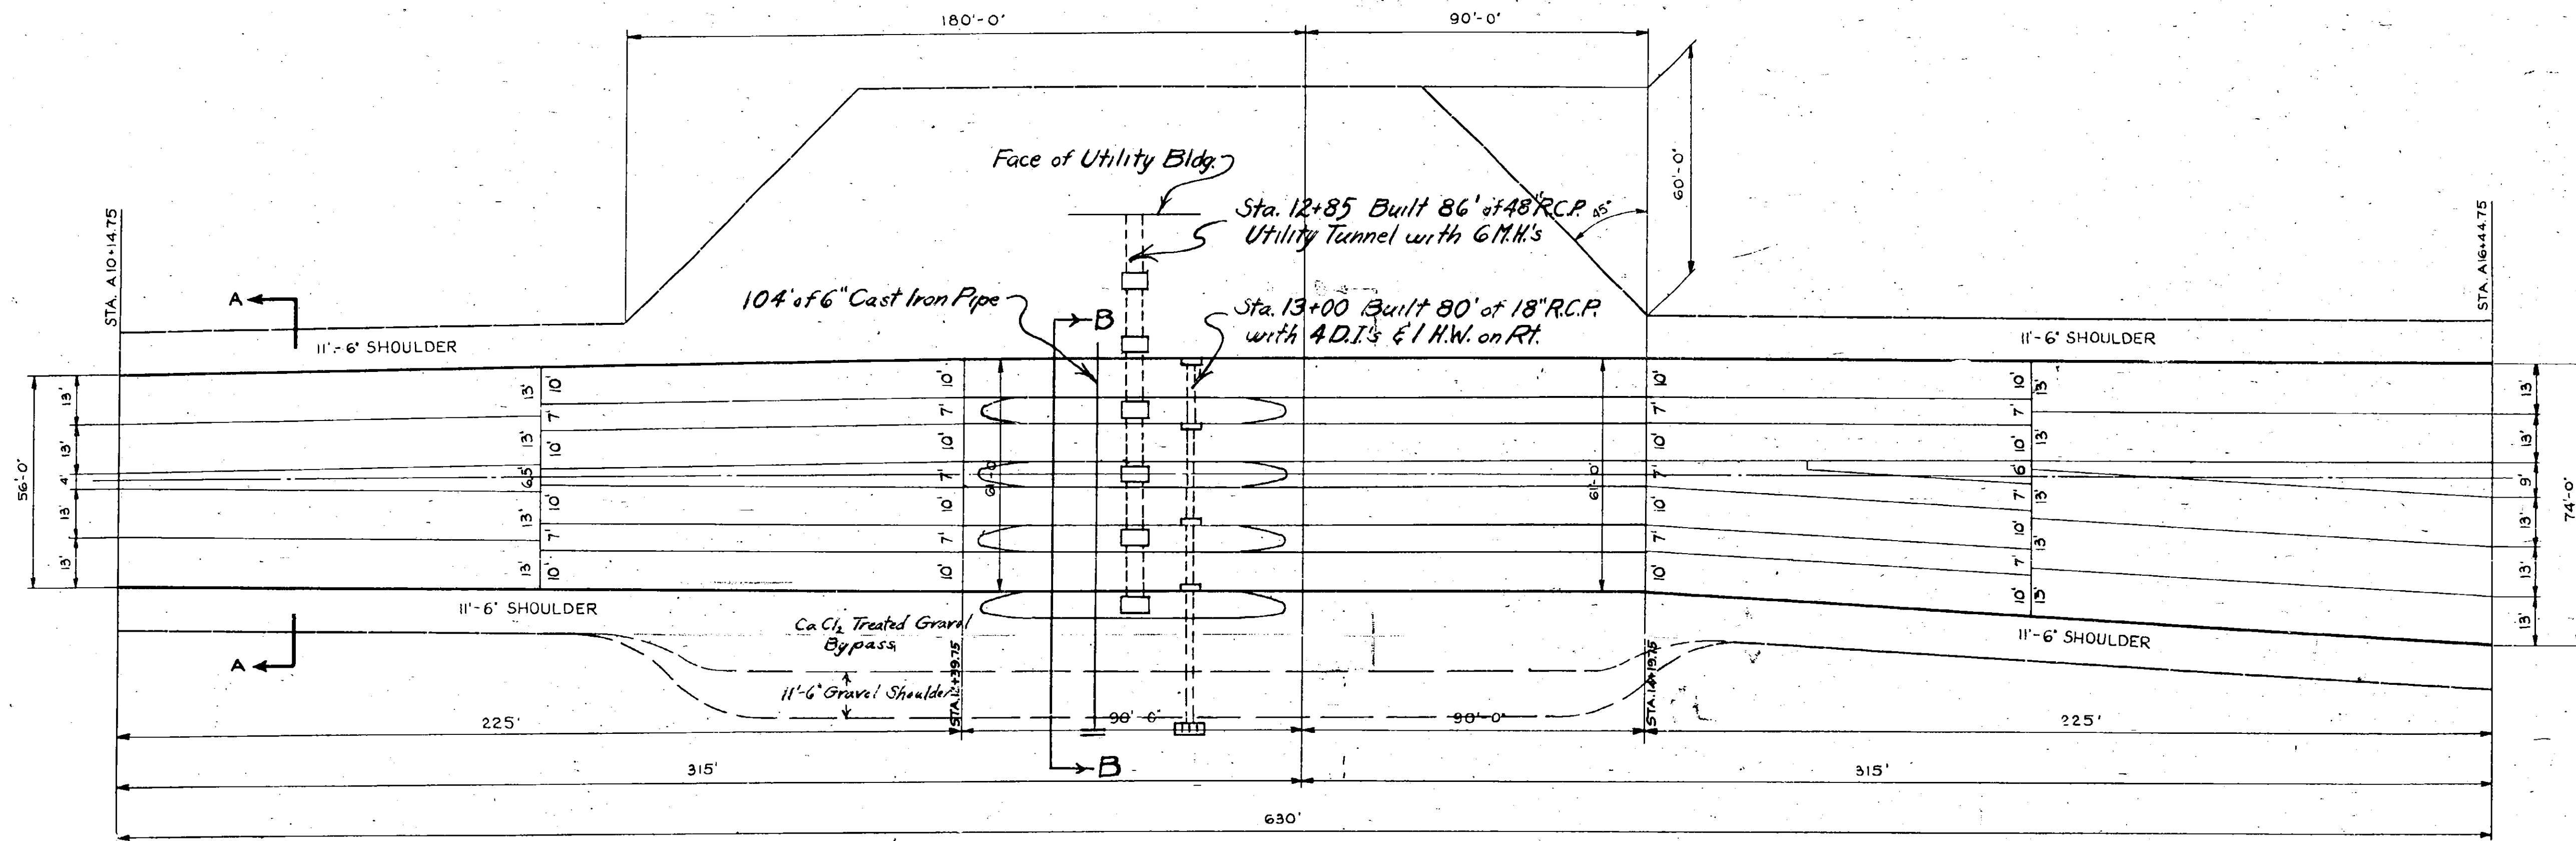


CONTROL AREA PLAN

SCALE: 1"=25'

STA. 12+39.75 to STA. 14+19.75 Gravel Foundation Course Item 39R, 12" deep is to be placed. Cement Concrete Pavement Item 47M is to be omitted in this section.

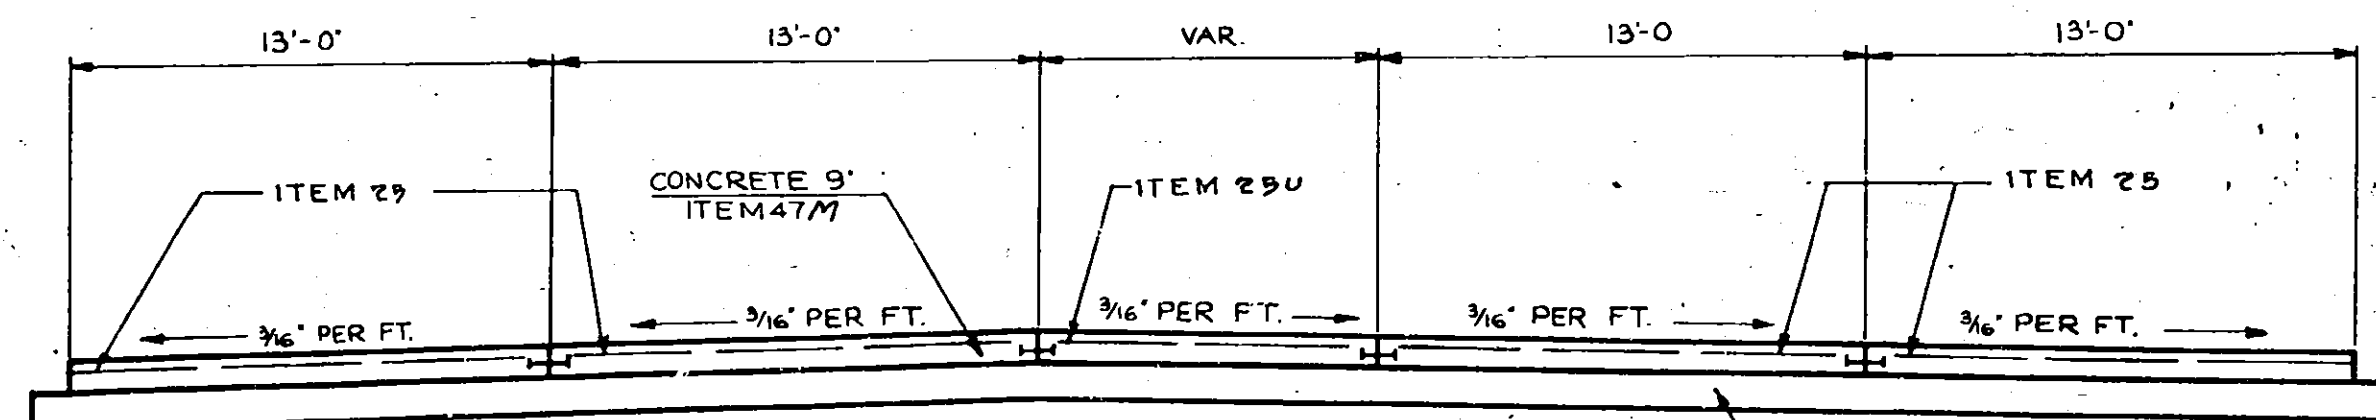

SECTION A-A
SCALE: 1"=5'-0"

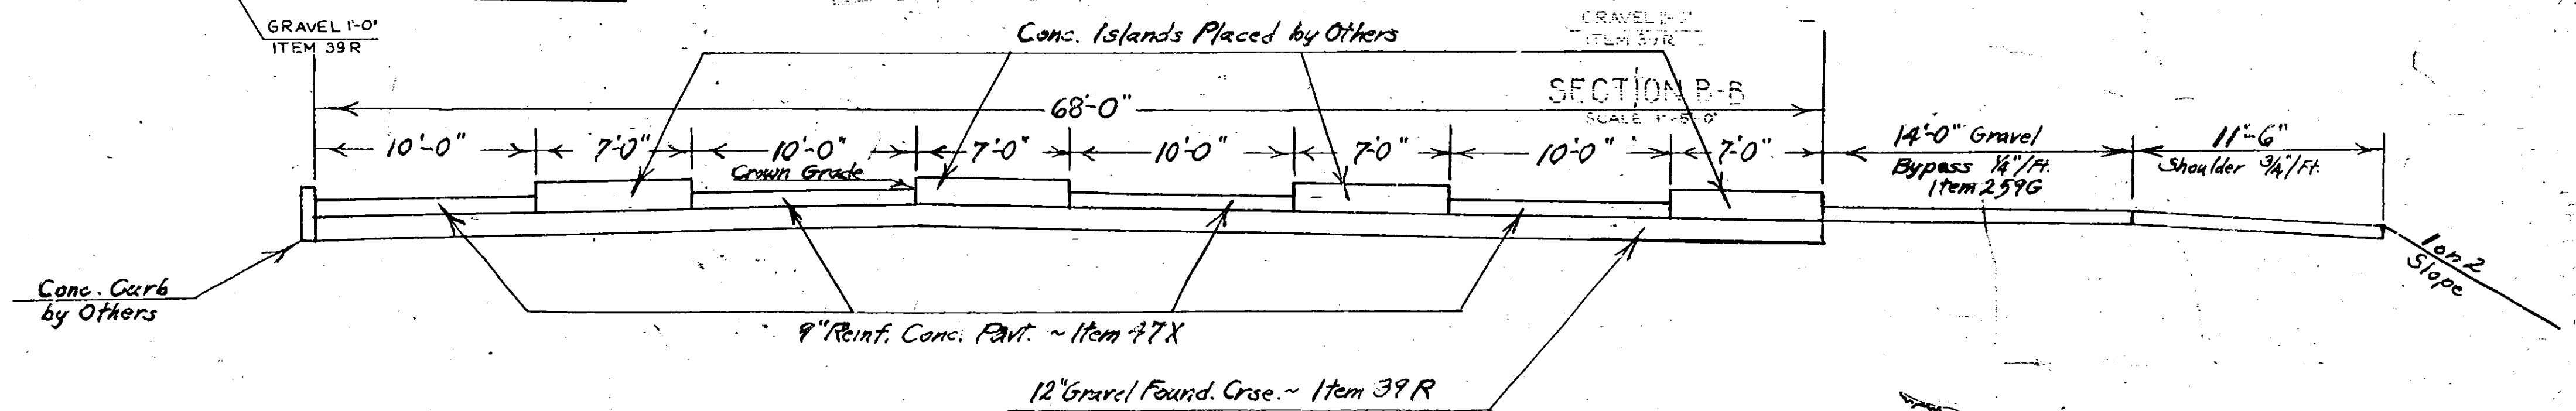

SECTION B-B
SCALE: 1"=5'-0"

CONTROL AREA PLAN
THOMPSON ROAD INTERCHANGE
MOHAWK SECTION
NEW YORK STATE THRUWAY
SHEET


PREPARED AND RECOMMENDED

URQUHART & DOYLE CONSULTING ENGINEERS
NEW YORK STATE PROFESSIONAL ENGINEERS LICENSE NO. 5667


DATE
Feb 16-53

COUNTY	SHEET NO.	TOTAL SHEETS
ONONDAGA	29	66

N.Y. STATE THRUWAY, MOHAWK SECTION SUB DIV. 8 B
INTERCHANGE AT THOMPSON ROAD
SYRACUSE - BRIDGEPORT, PT. 1 S.H. 672.

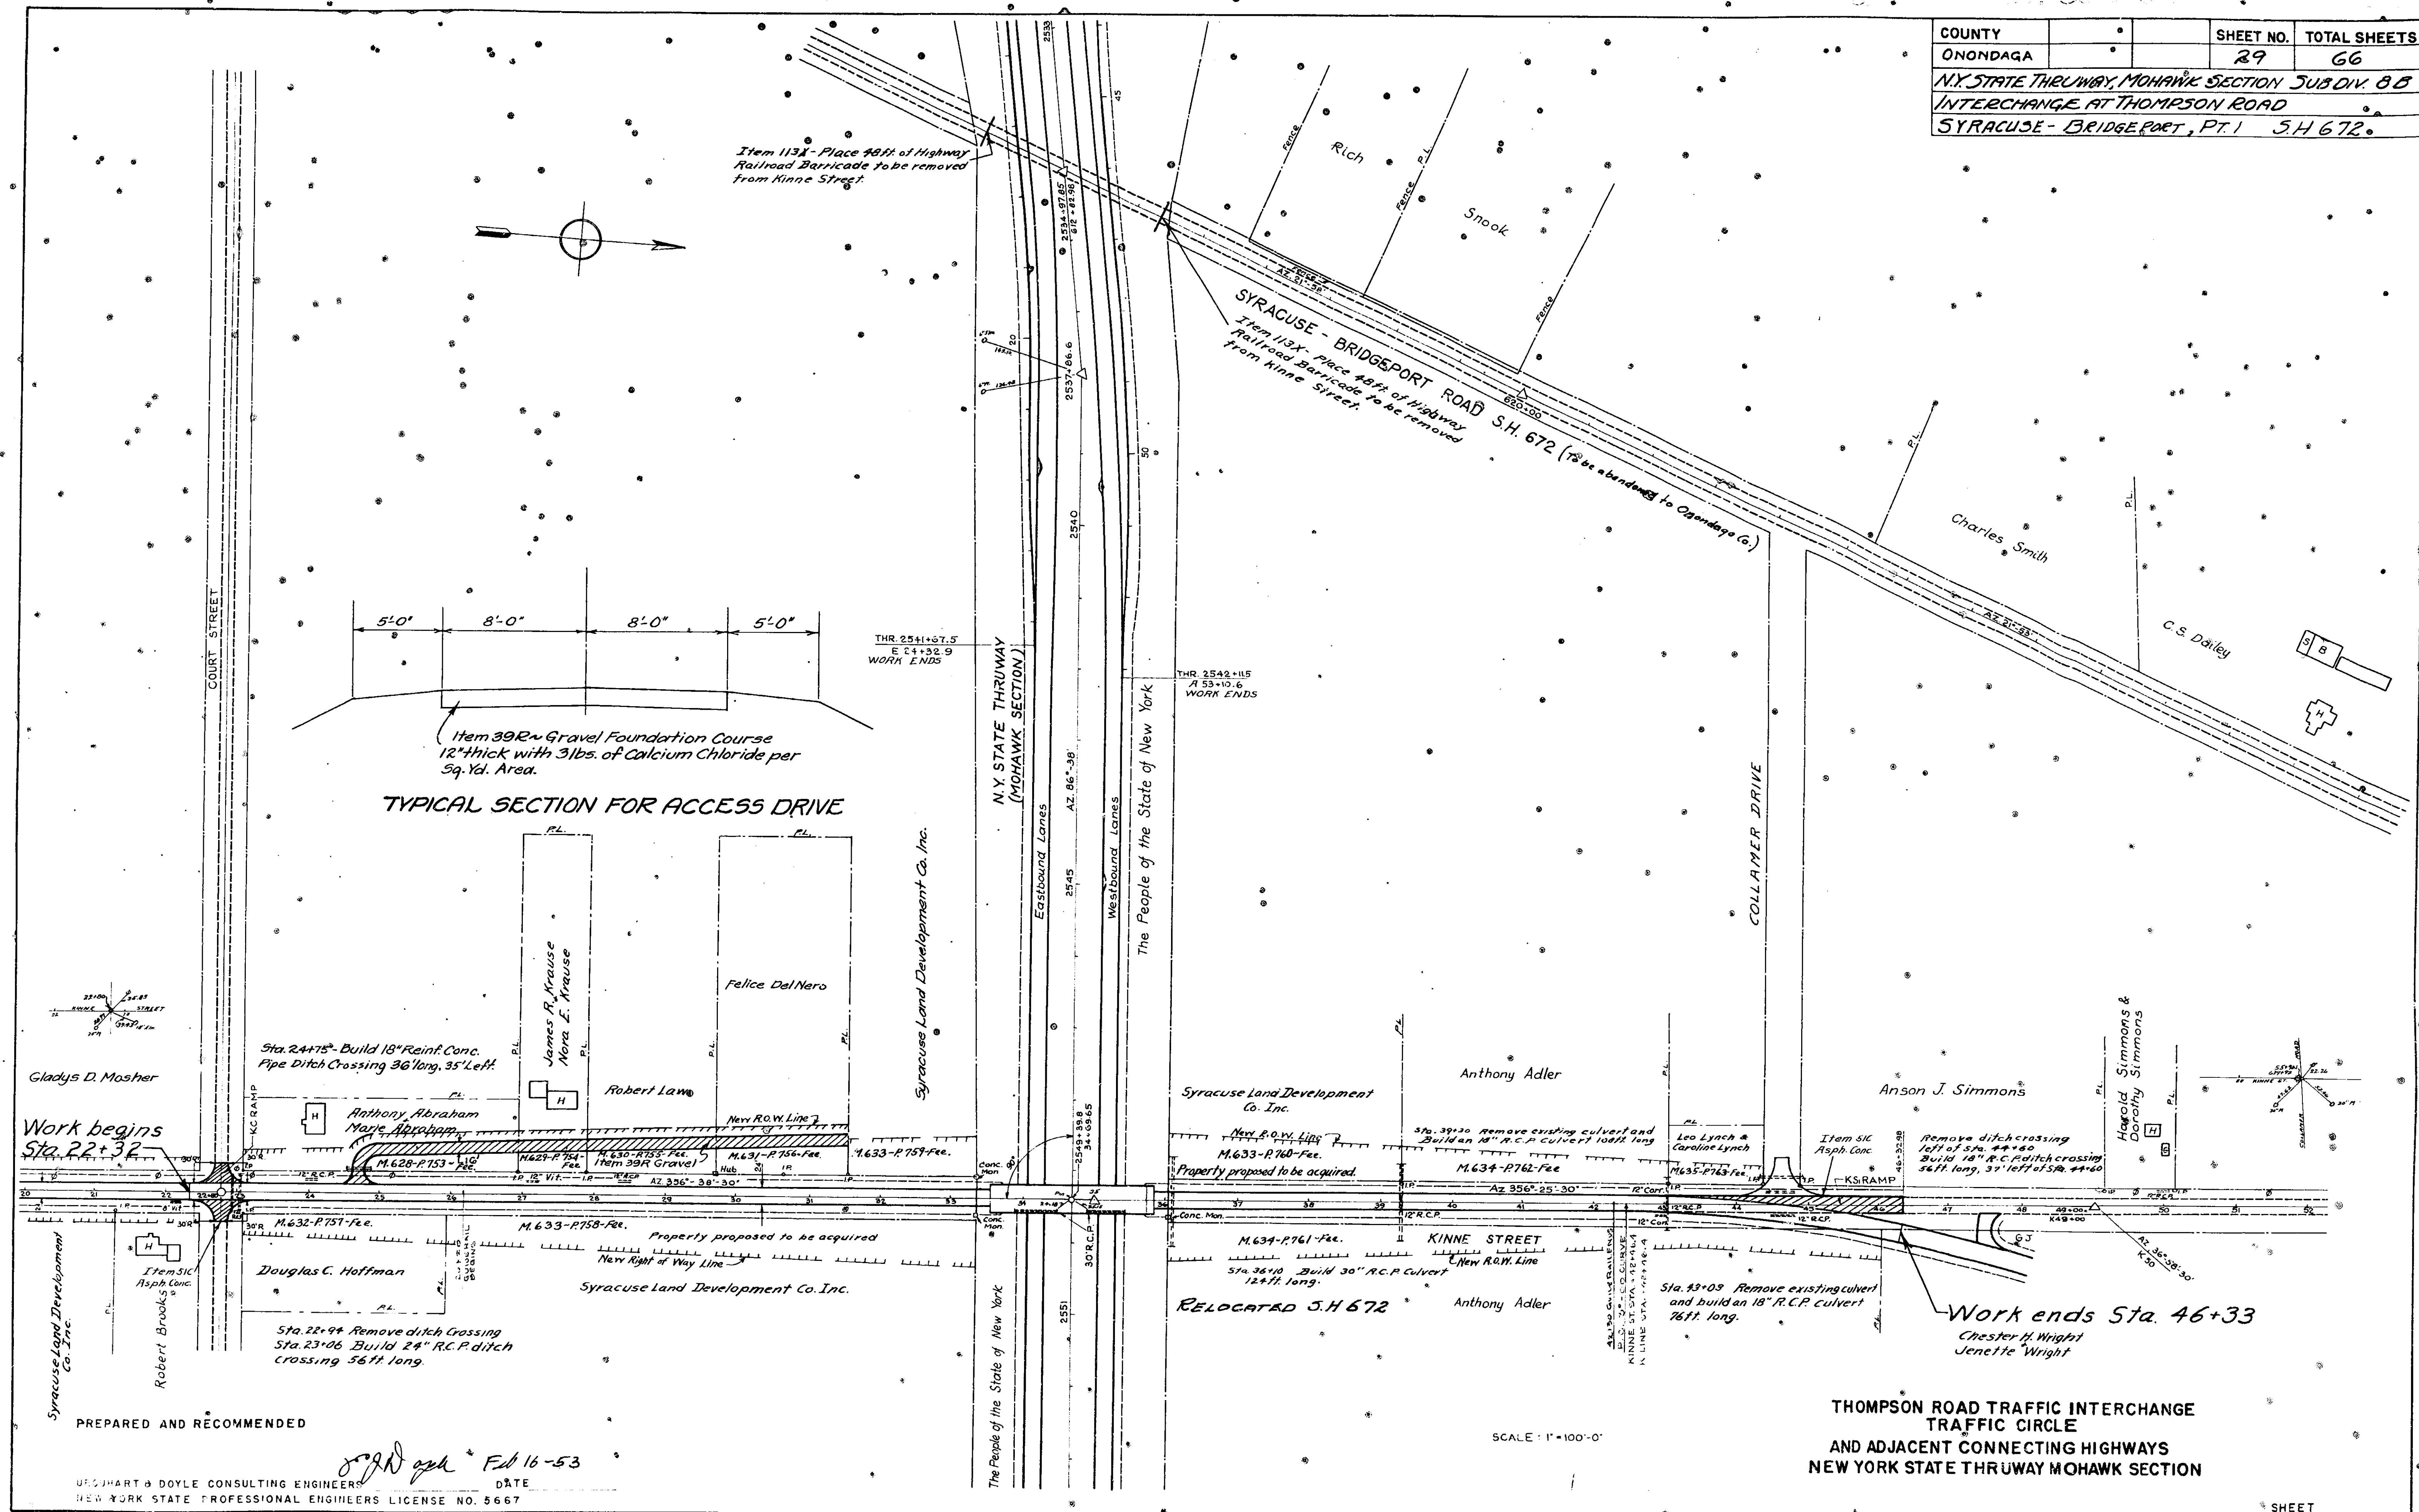






29R

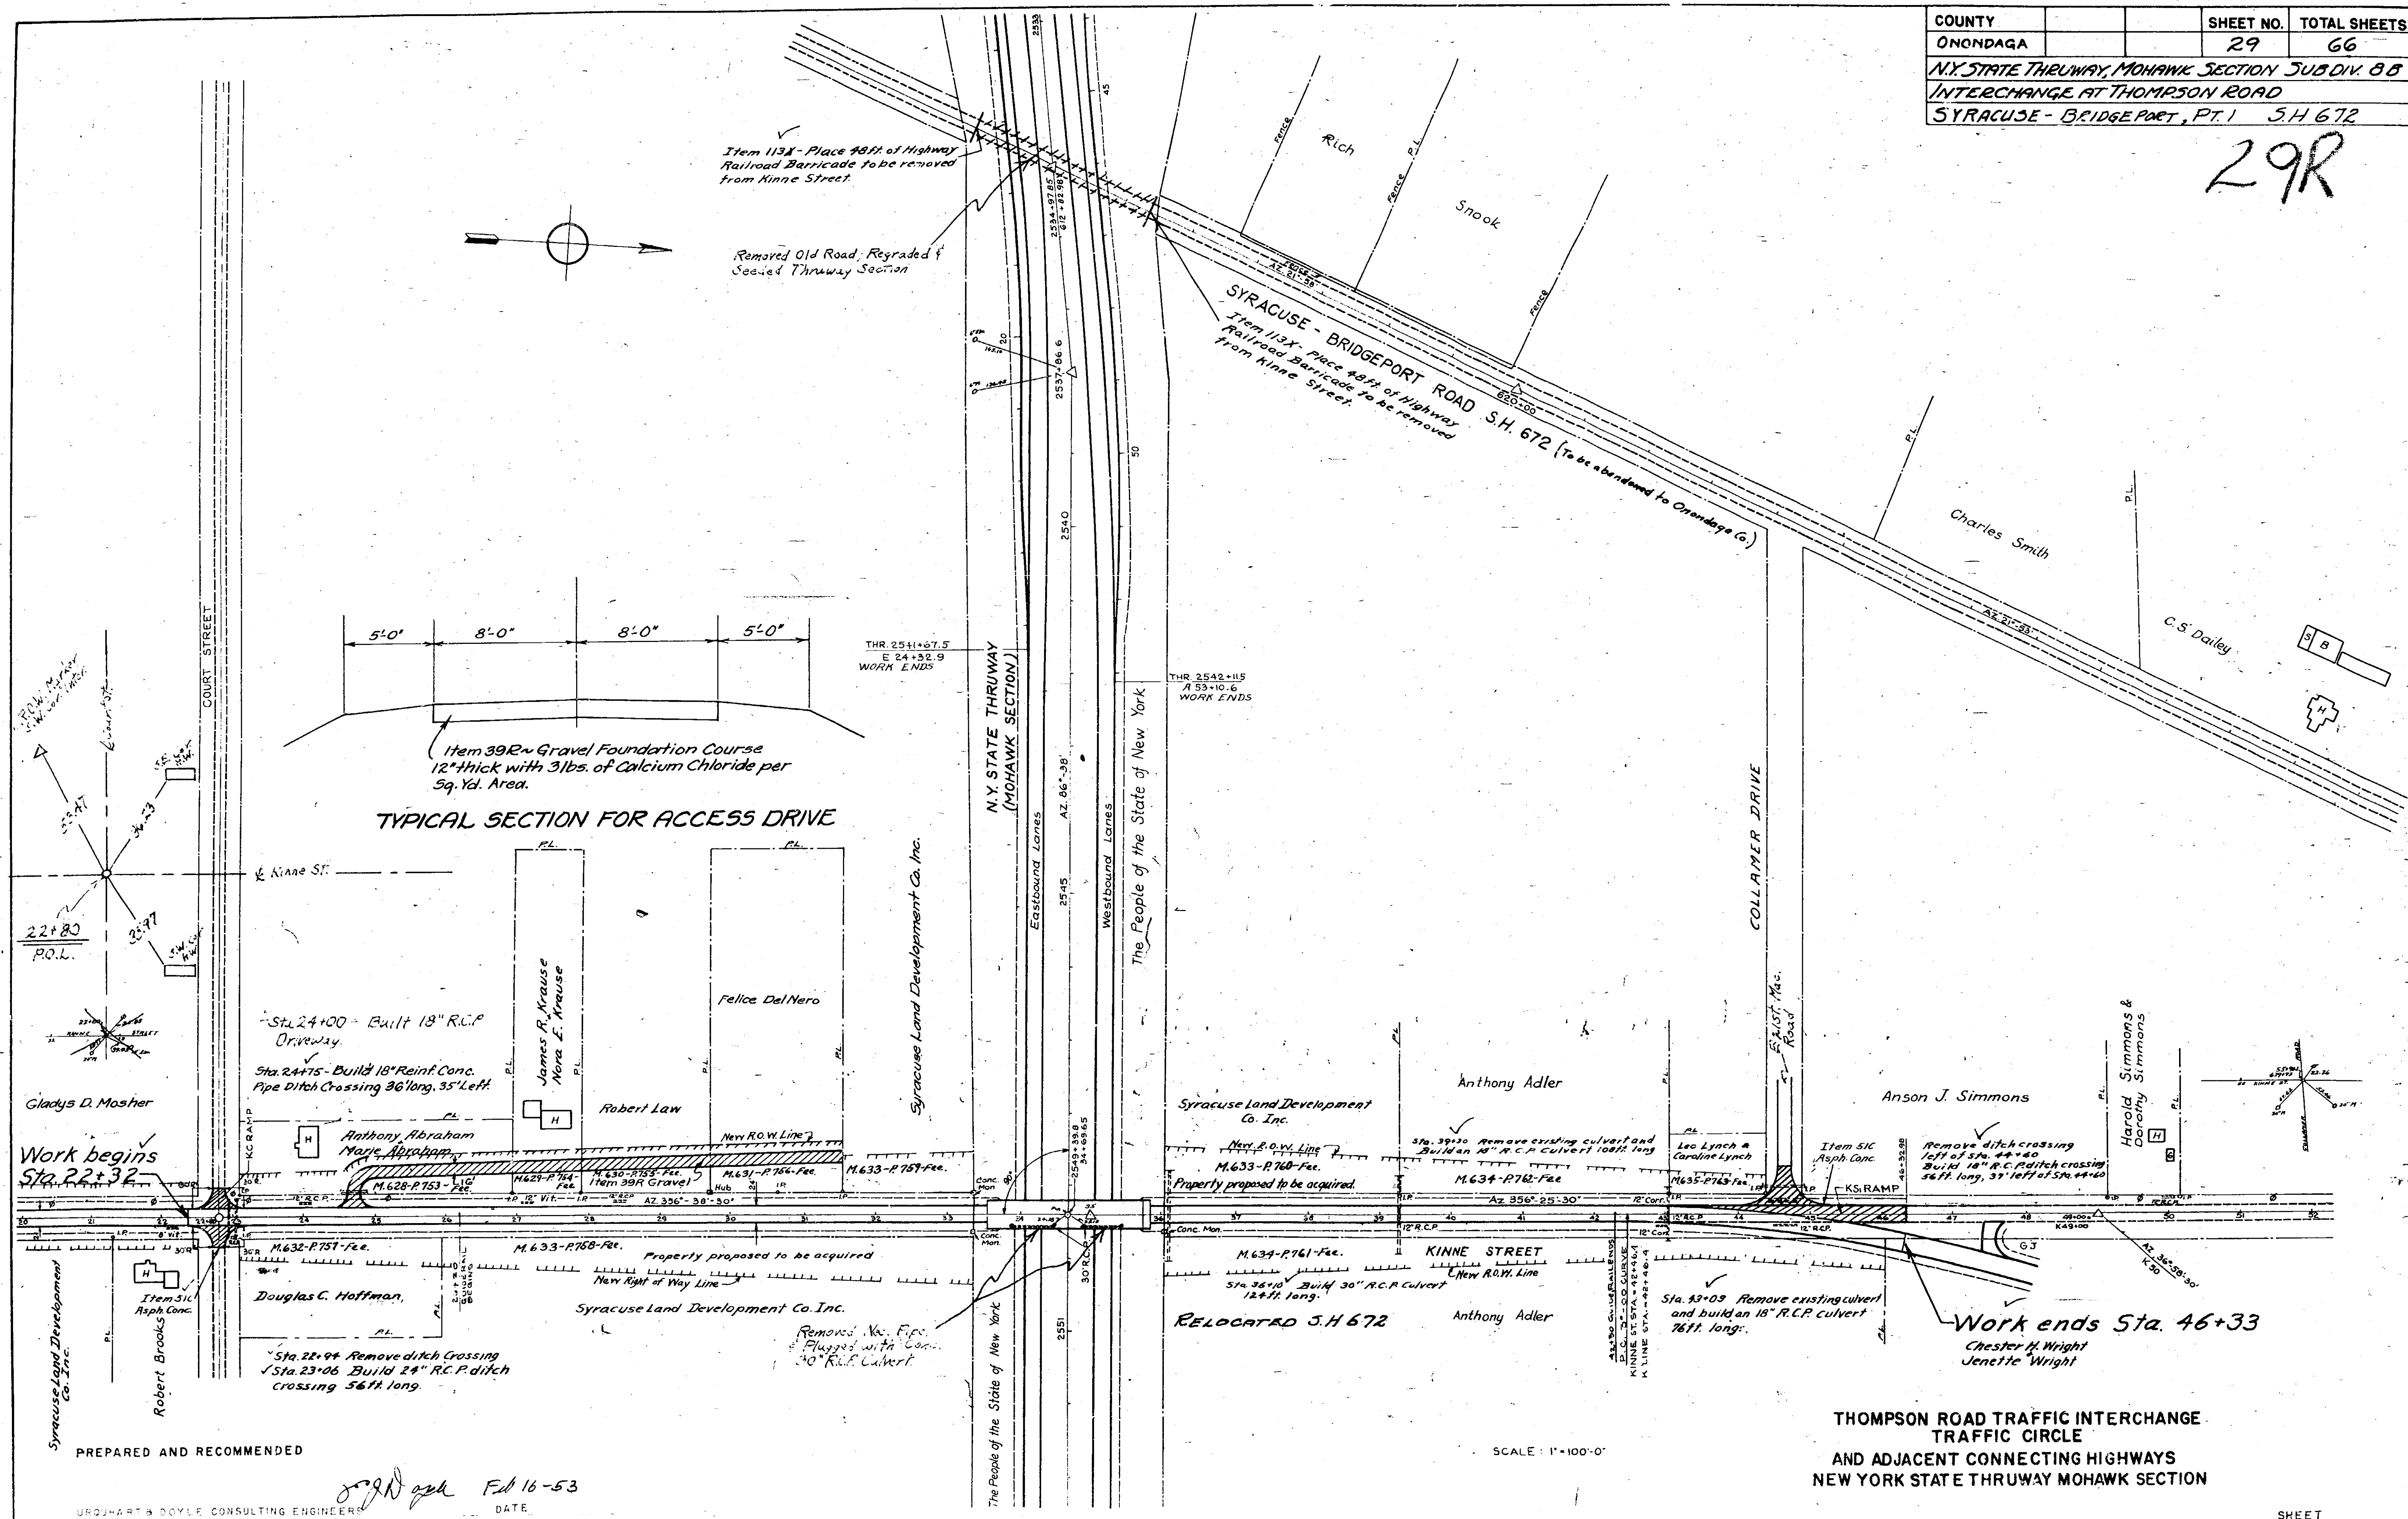

THOMPSON ROAD TRAFFIC INTERCHANGE
TRAFFIC CIRCLE
AND ADJACENT CONNECTING HIGHWAYS
NEW YORK STATE THRUWAY MOHAWK SECTION

PREPARED AND RECOMMENDED

COUNTY	SHEET NO.	TOTAL SHEETS
ONONDAGA	30	66
N.Y. STATE THRUWAY, MOHAWK SECTION SUB DIV. 8B		
INTERCHANGE AT THOMPSON ROAD		

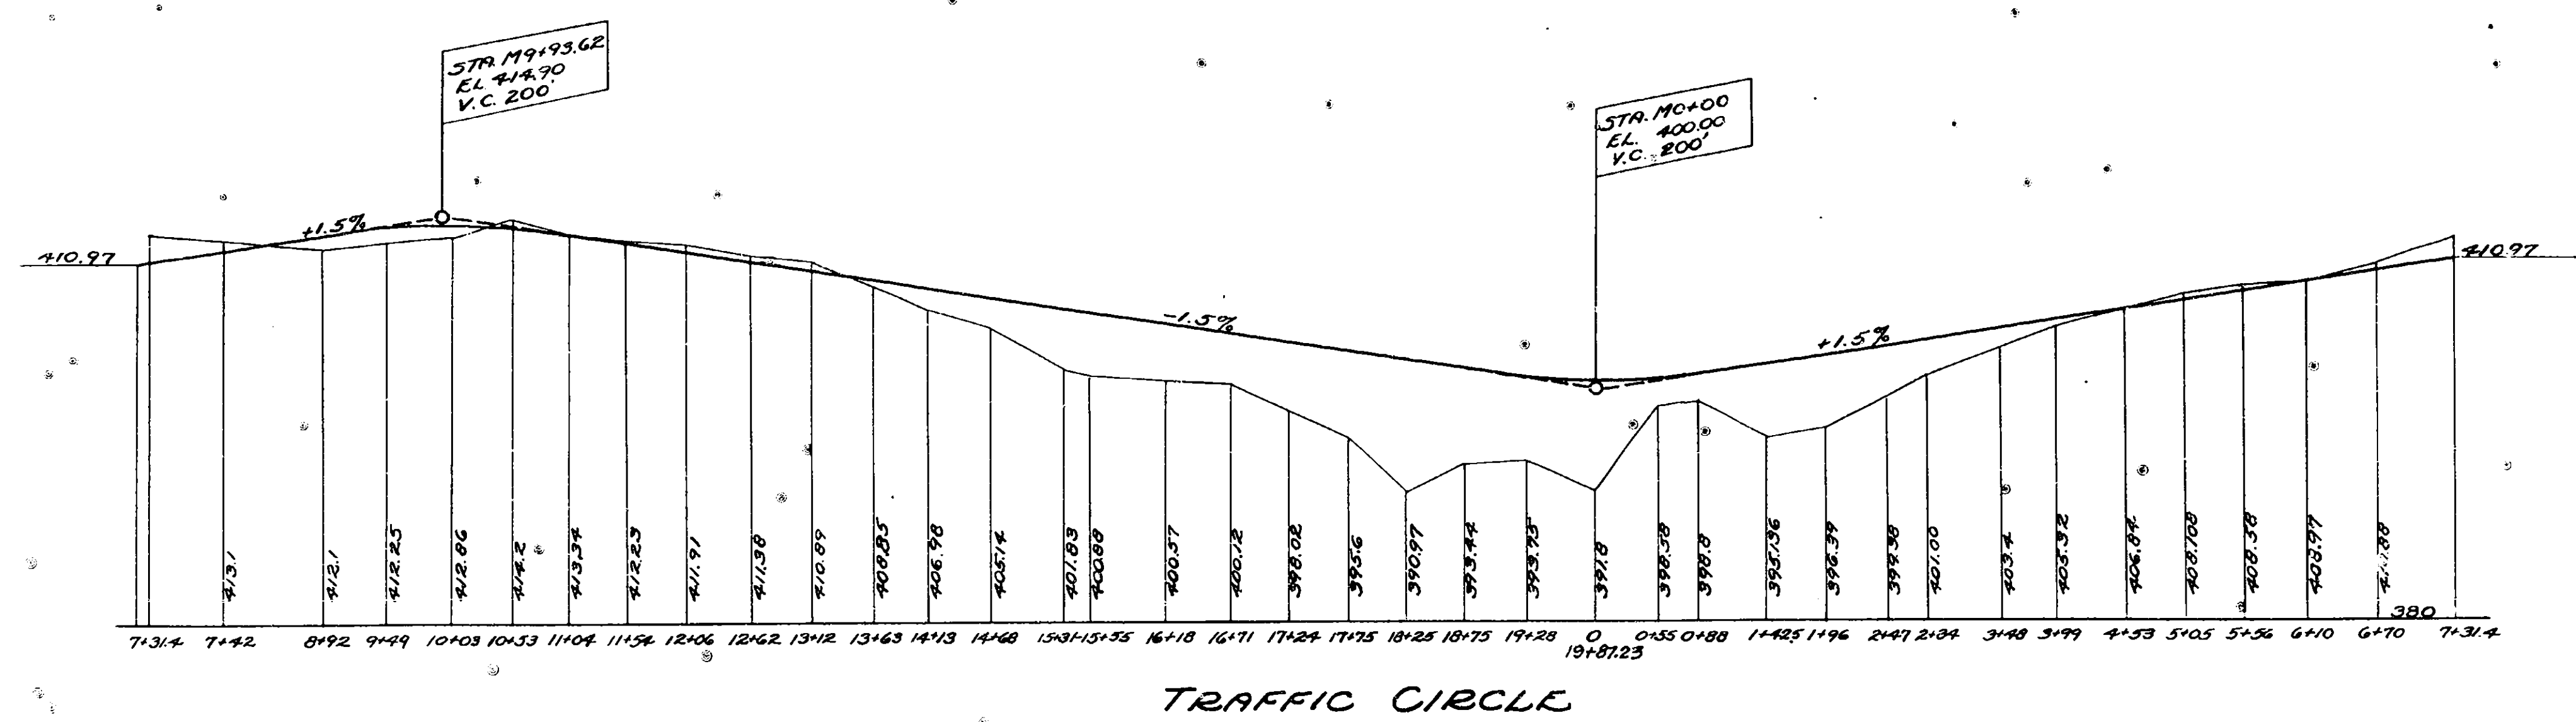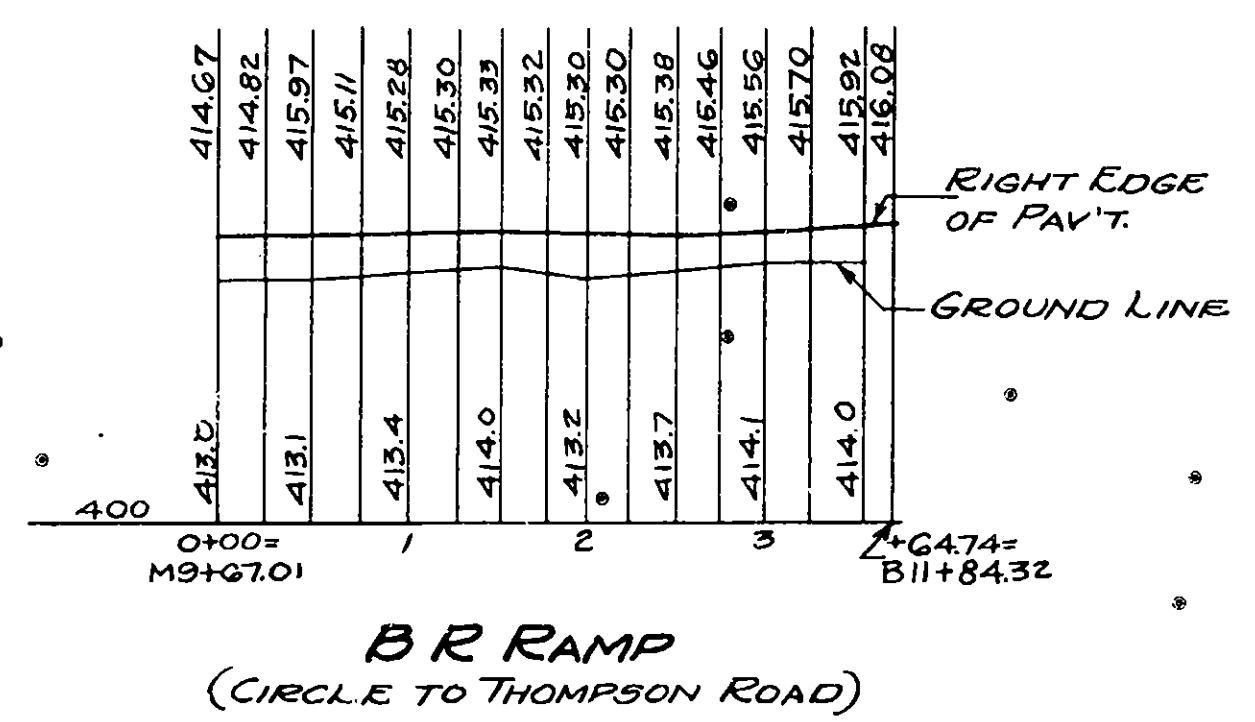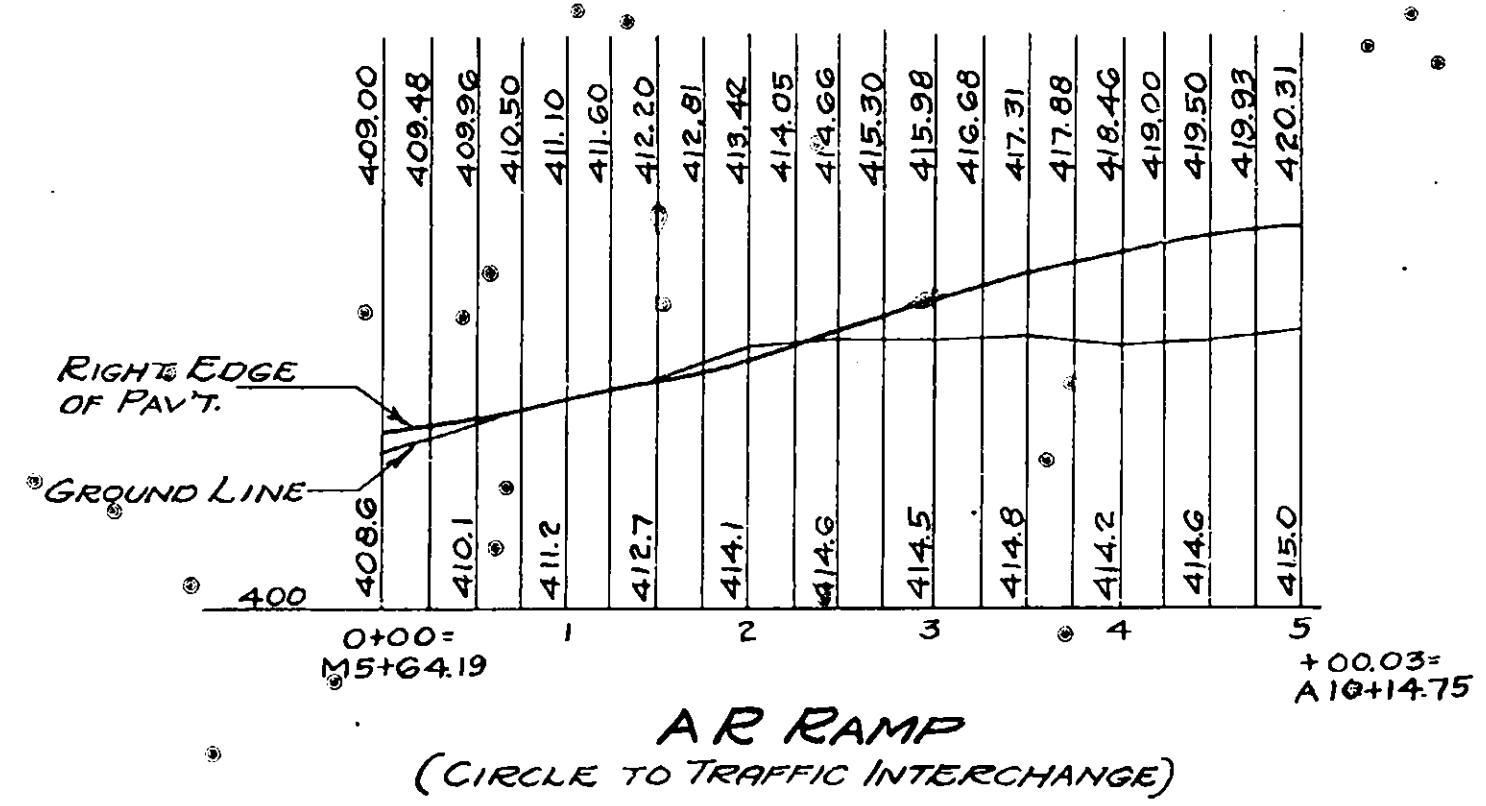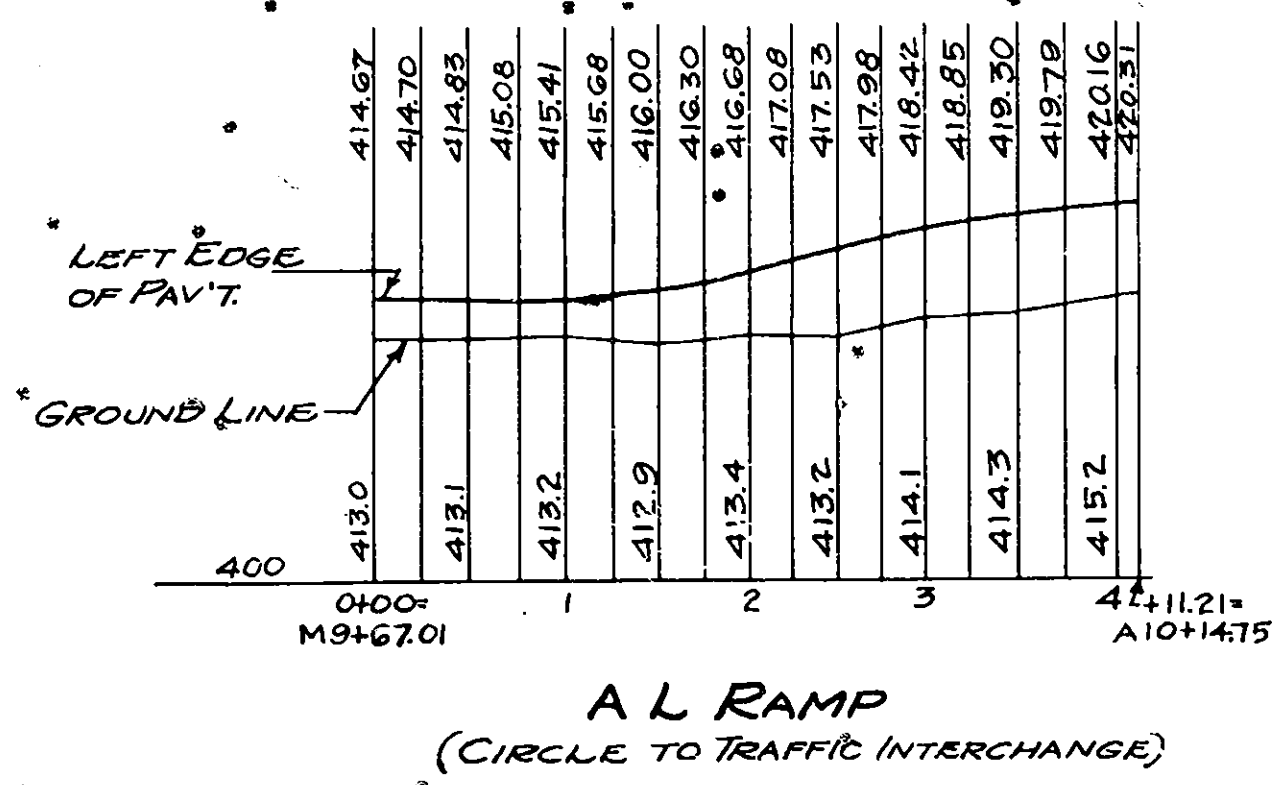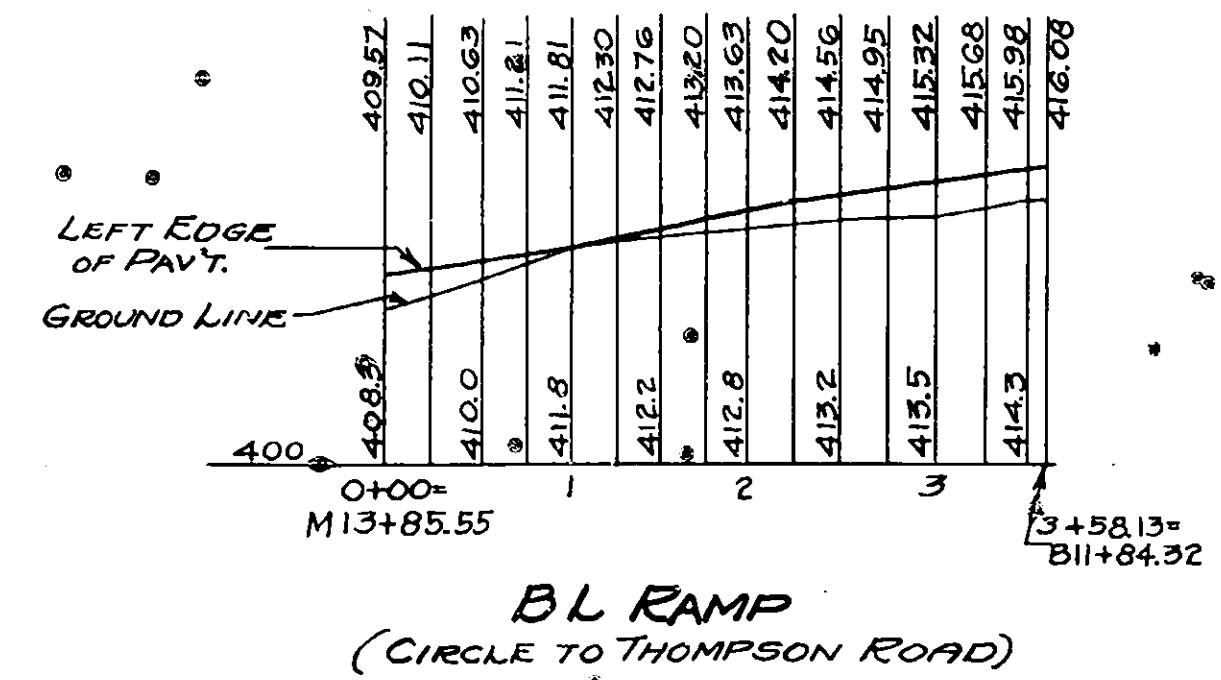


PROFILES
THOMPSON ROAD PROJECT
TRAFFIC CIRCLE
AND ADJACENT CONNECTING HIGHWAYS
NEW YORK STATE THRUWAY MOHAWK SECTION

PREPARED AND RECOMMENDED
URQUHART & DOYLE CONSULTING ENGINEERS
NEW YORK STATE PROFESSIONAL ENGINEERS LICENSE NO. 5667
DATE 8/1/52


SCALE: Hor. 1"=100'
Vert. 1"=10'

COUNTY		SHEET NO.	TOTAL SHEETS
ONONDAGA		30	66
N.Y. STATE THRUWAY, MOHAWK SECTION SUBDIV. 8B			
INTERCHANGE AT THOMPSON ROAD			


30R

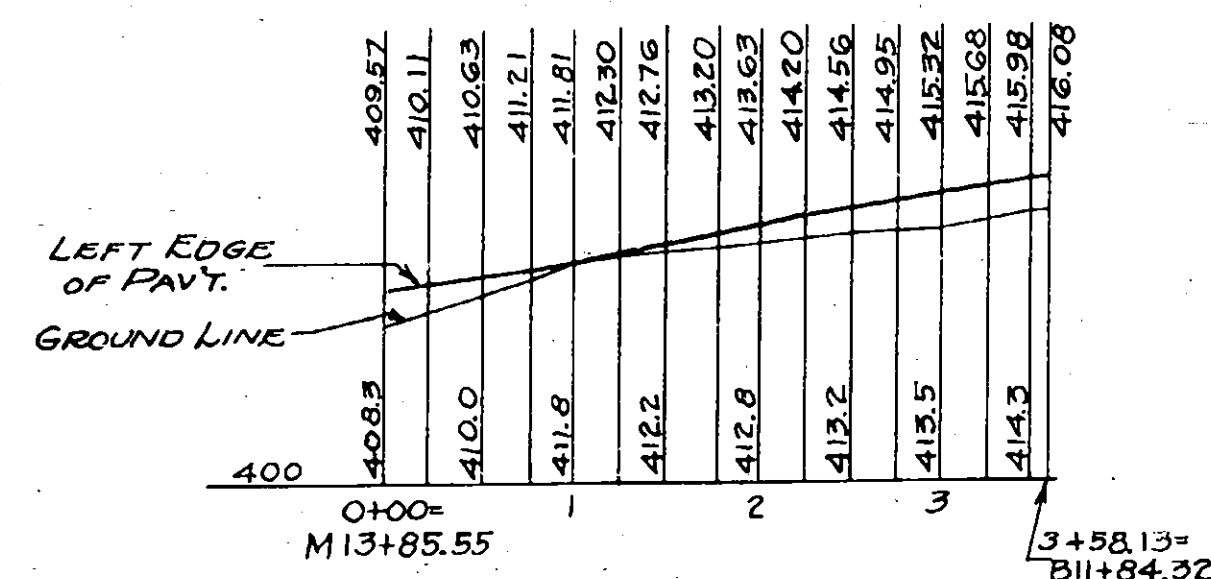


BL RAMP
(CIRCLE TO THOMPSON ROAD)

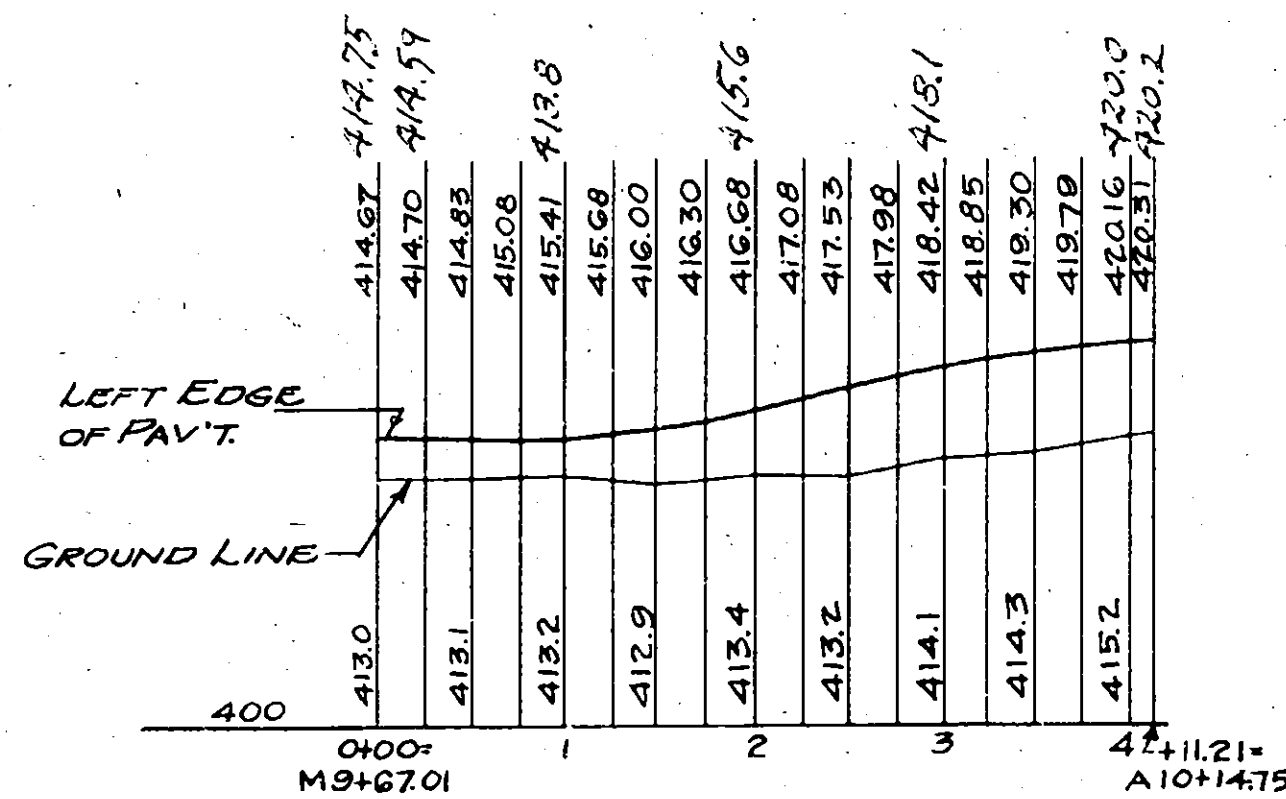


AL RAMP
(CIRCLE TO TRAFFIC INTERCHANGE)

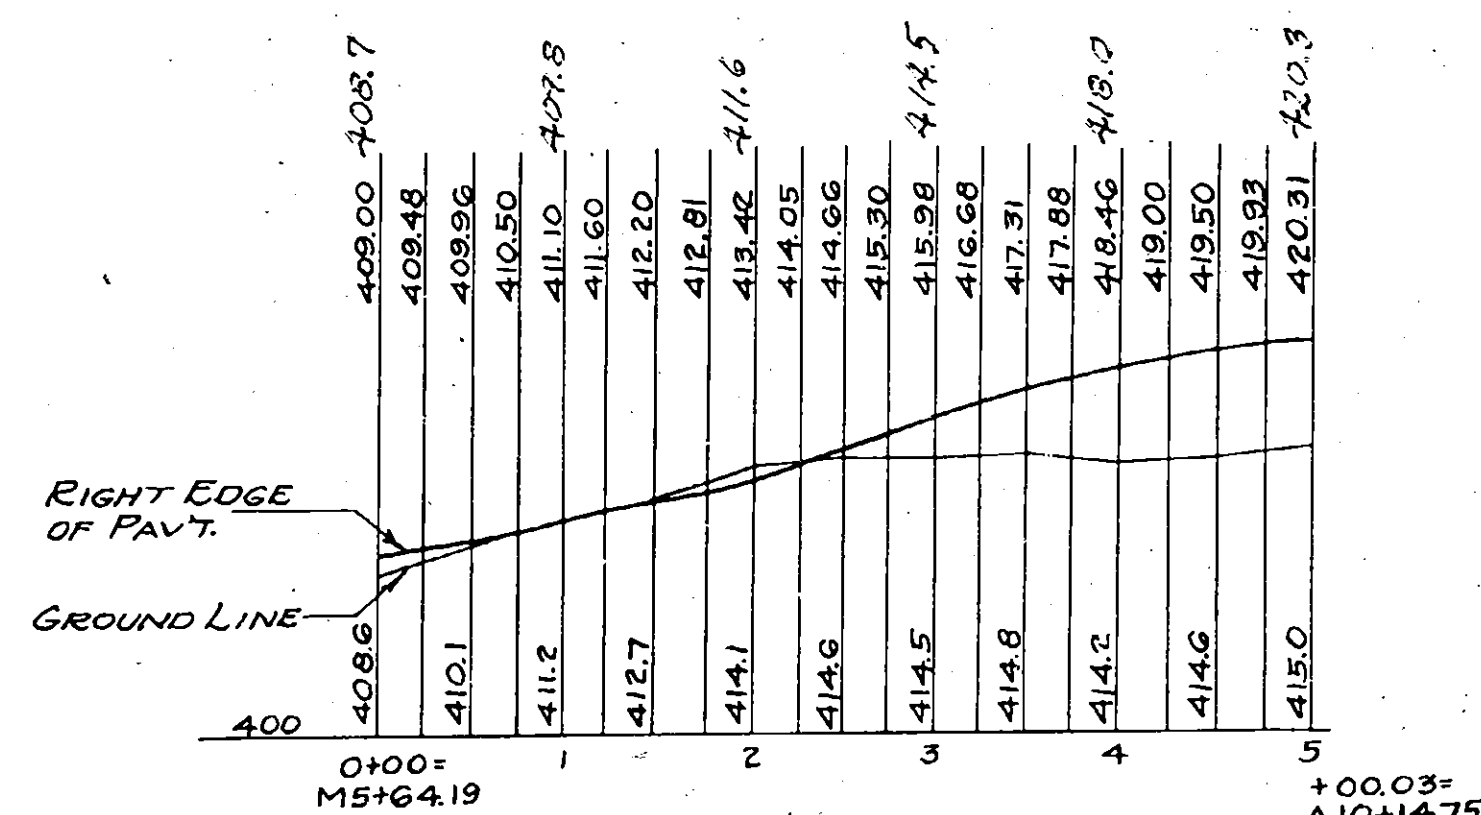

AR RAMP
(CIRCLE TO TRAFFIC INTERCHANGE)

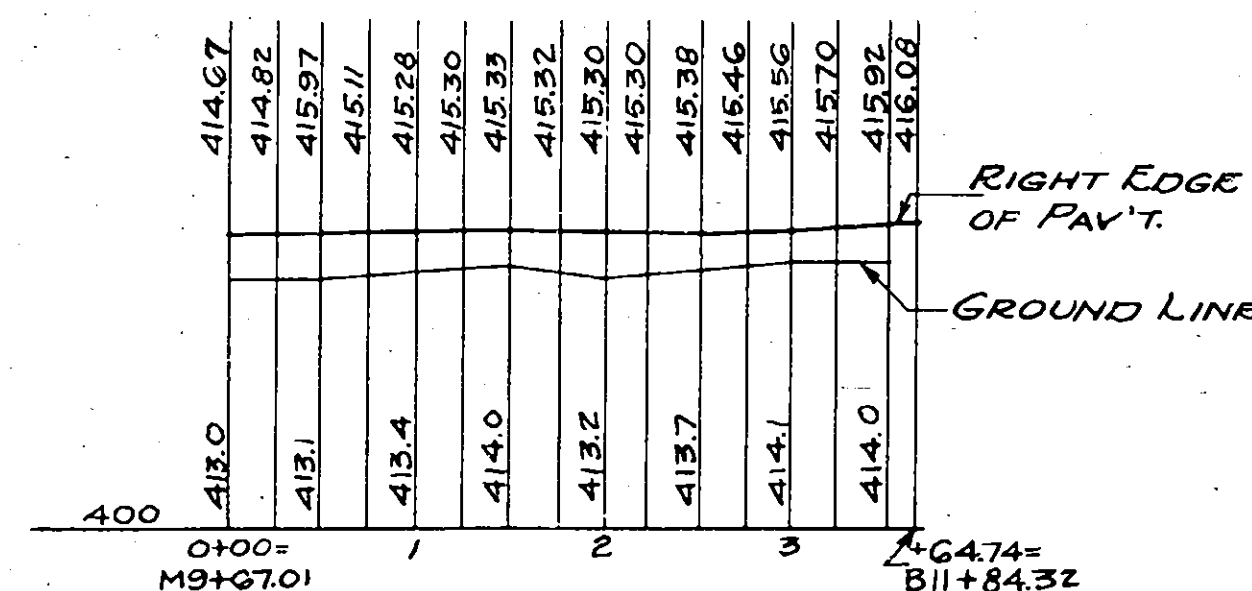

BR RAMP
(CIRCLE TO THOMPSON ROAD)

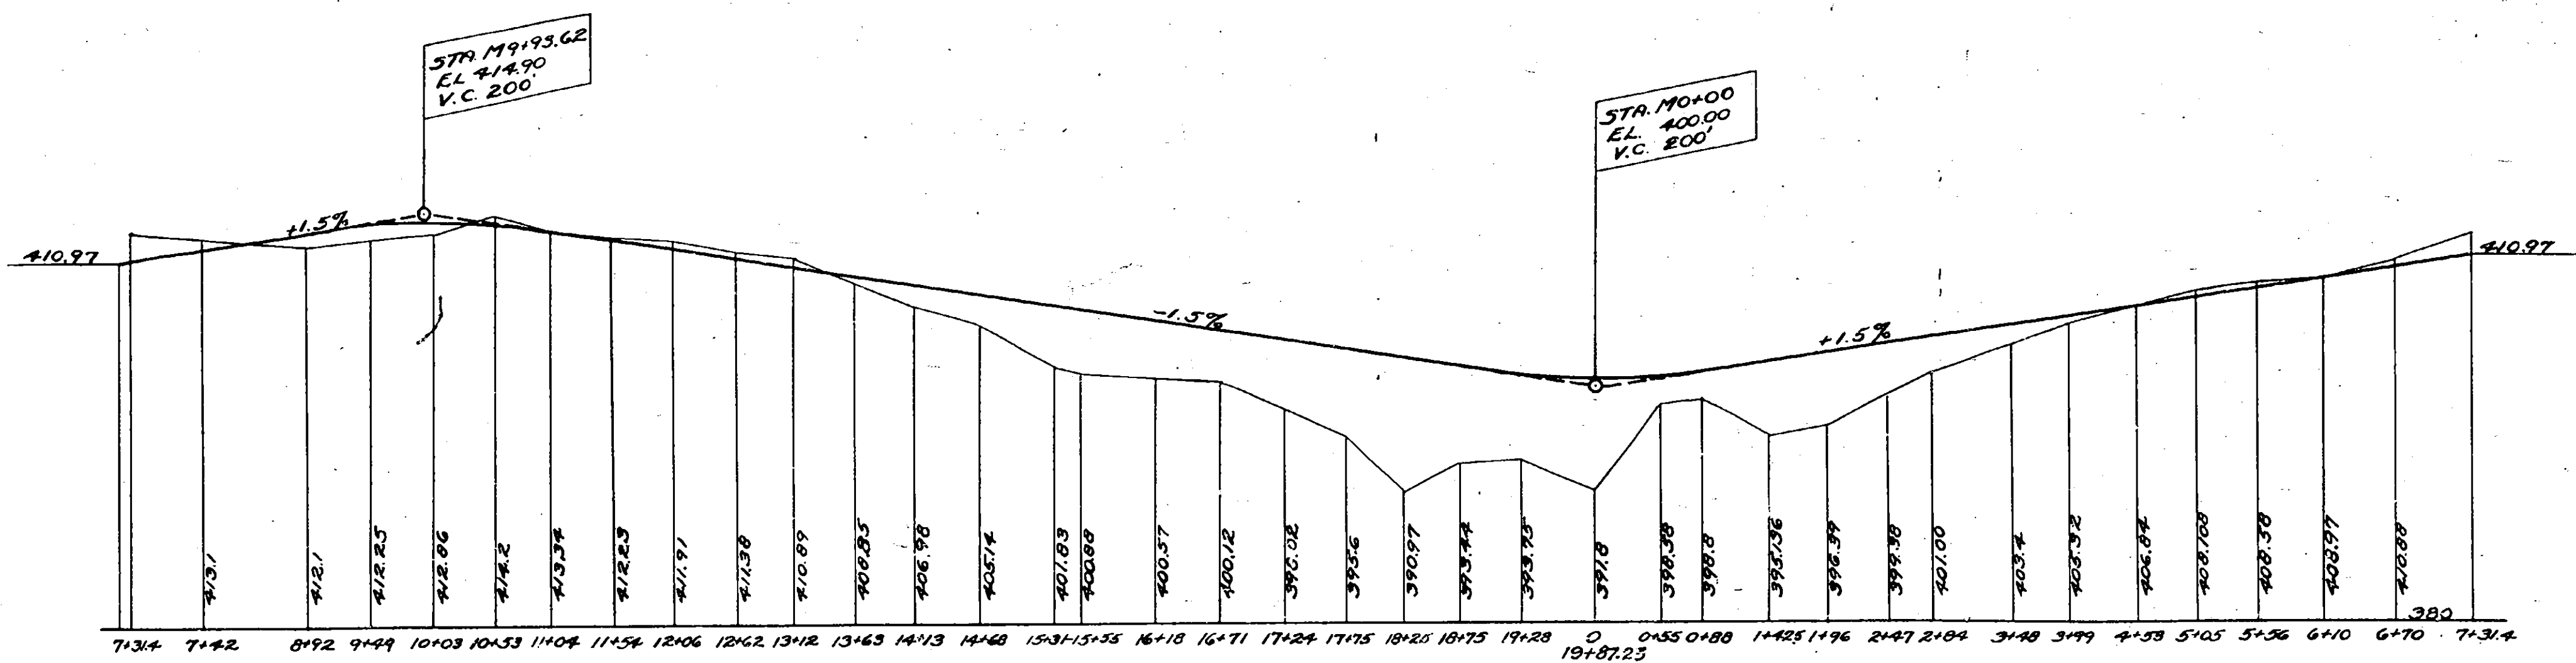

TRAFFIC CIRCLE

SCALE: Hor. 1"=100'
Vert. 1"=10'

PROFILES
THOMPSON ROAD PROJECT
TRAFFIC CIRCLE
AND ADJACENT CONNECTING HIGHWAYS
NEW YORK STATE THRUWAY MOHAWK SECTION

PREPARED AND RECOMMENDED


URQUHART & DOYLE CONSULTING ENGINEERS
NEW YORK STATE PROFESSIONAL ENGINEERS LICENSE NO. 5667

8/1/52 Doyle Jan 30-52
DATE


SHEET

文


COUNTY			SHEET NO.	TOTAL SHEETS
ONONDAGA			31	66
N.Y. STATE THRUWAY, MONIAWK SECTION SUBDIV. 8B				
INTERCHANGE AT THOMPSON ROAD				

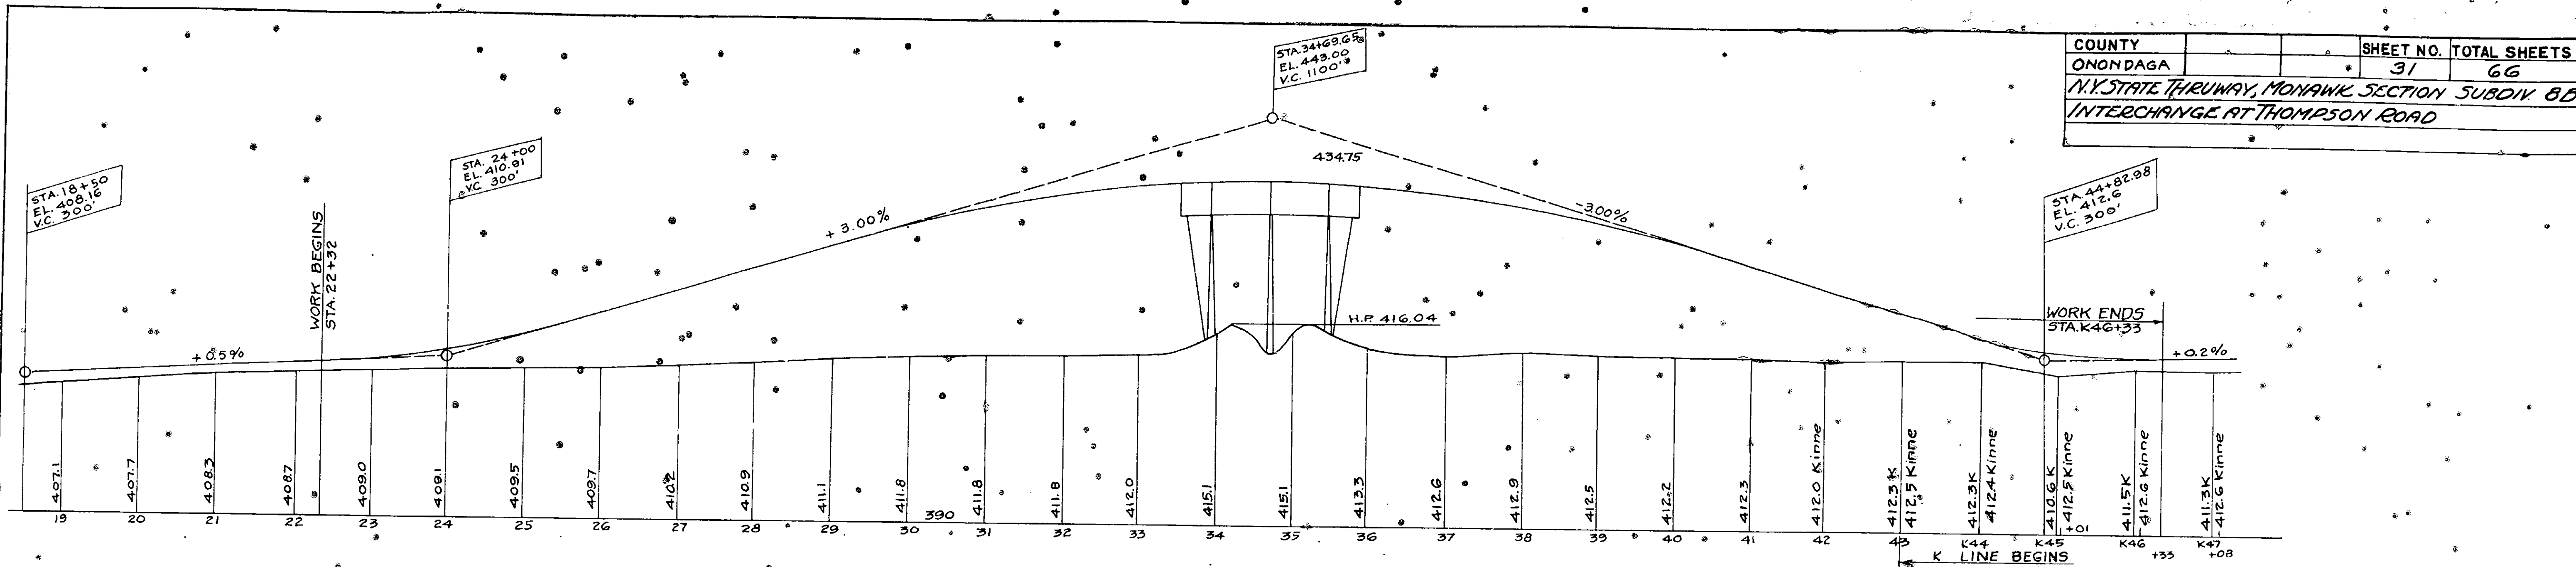


KINNE STREET PROFILE

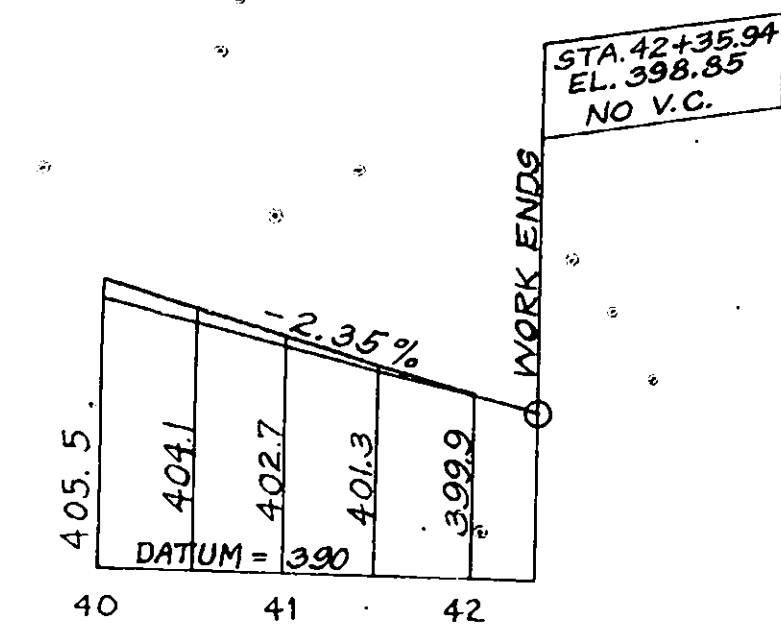

BT. RAMP

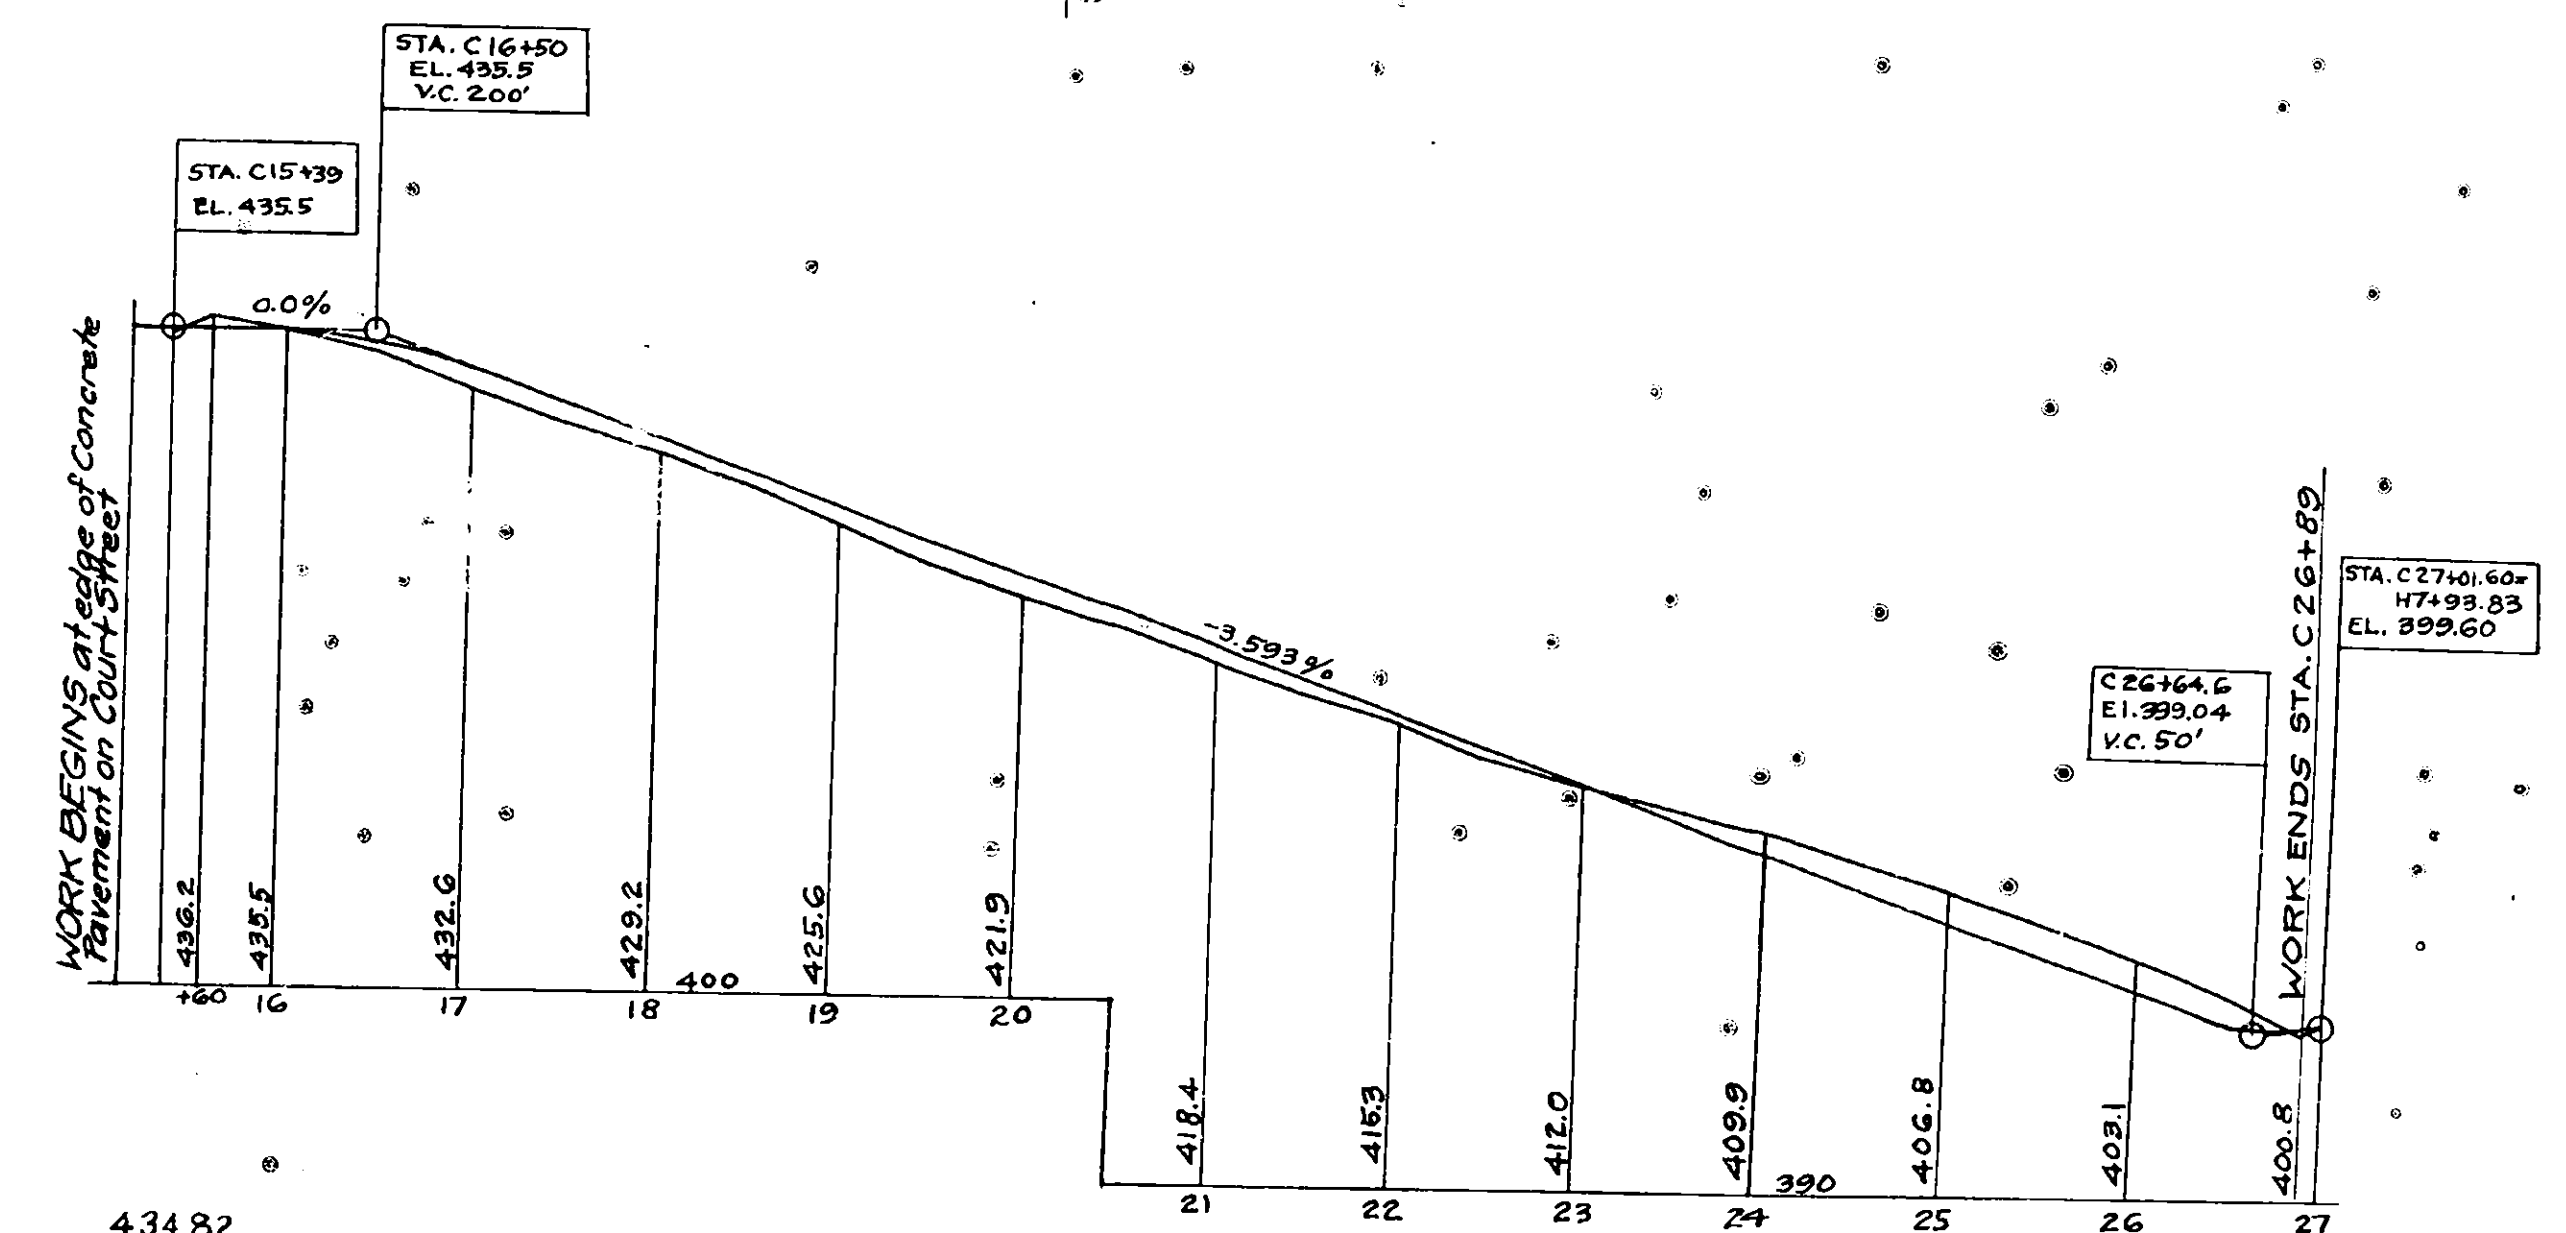

COLLEGE PLACE PROFILE
C LINE

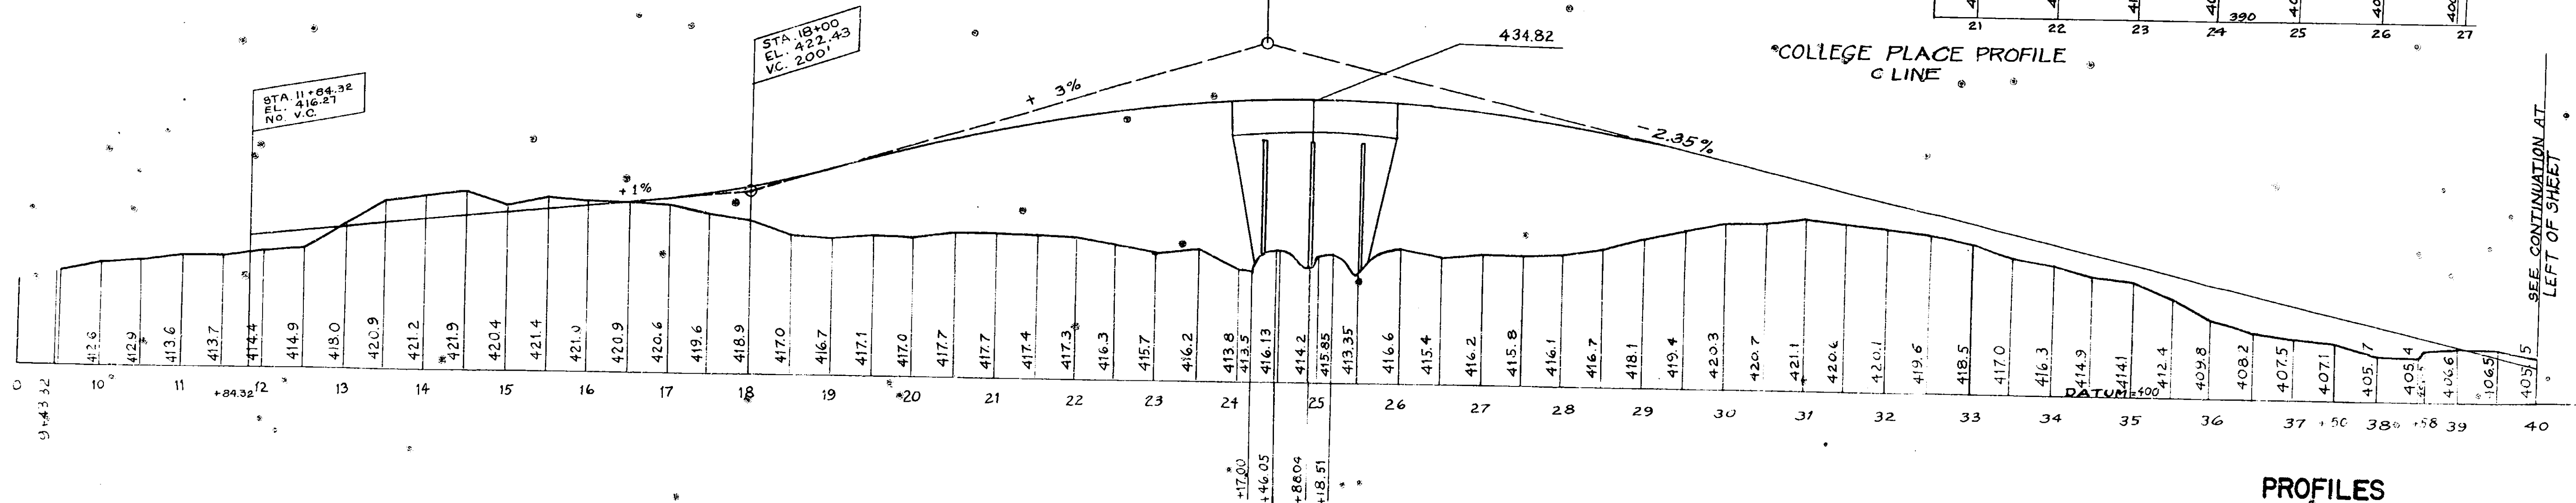

THOMPSON ROAD PROFILE
B LINE


W. D. Wager Jan 30-53

SCALE: HOR. 1" = 100'-0"
VERT. 1" = 10'-0"


PROFILES
THOMPSON ROAD-KINNE STREET-COLLEGE PLACE
MOHAWK SECTION
NEW YORK STATE THRUWAY

COUNTY	SHEET NO.	TOTAL SHEETS
ONONDAGA	31	66
N.Y. STATE THRUWAY, MOHAWK SECTION SUBDIV. 8D		
INTERCHANGE AT THOMPSON ROAD		


31R

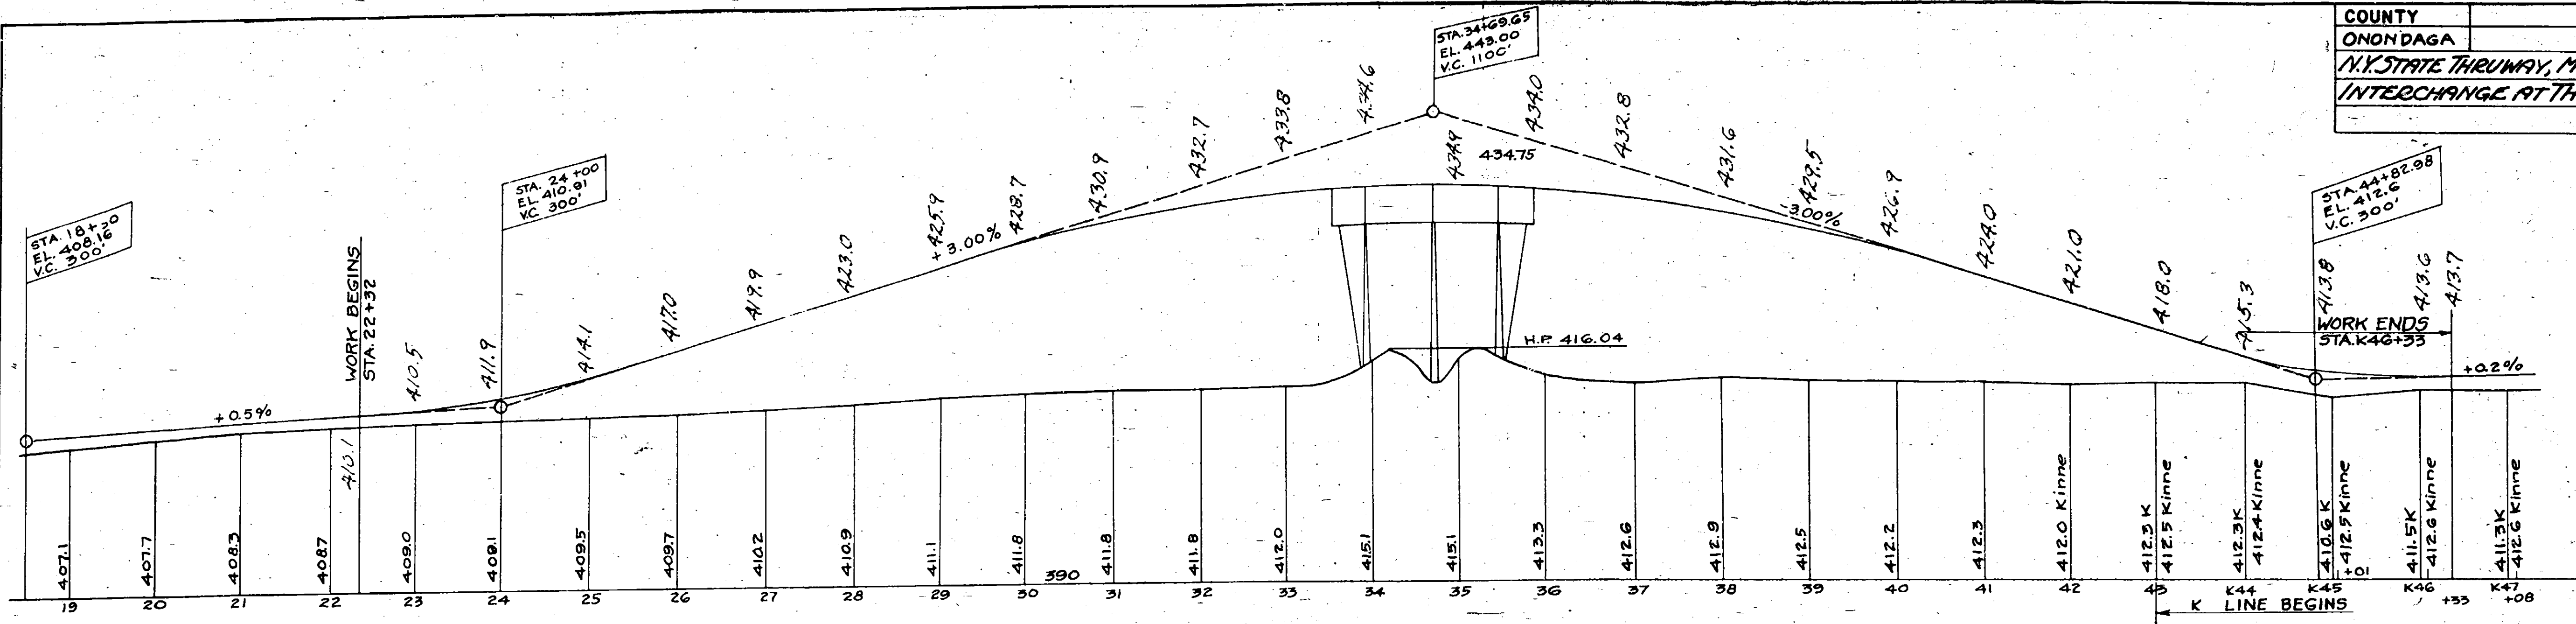


KINNE STREET PROFILE

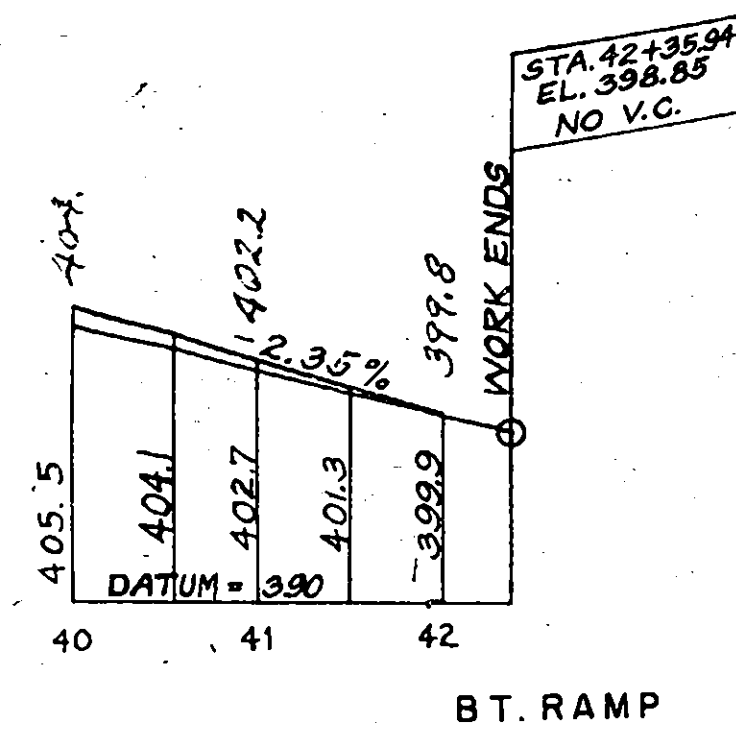

BT. RAMP

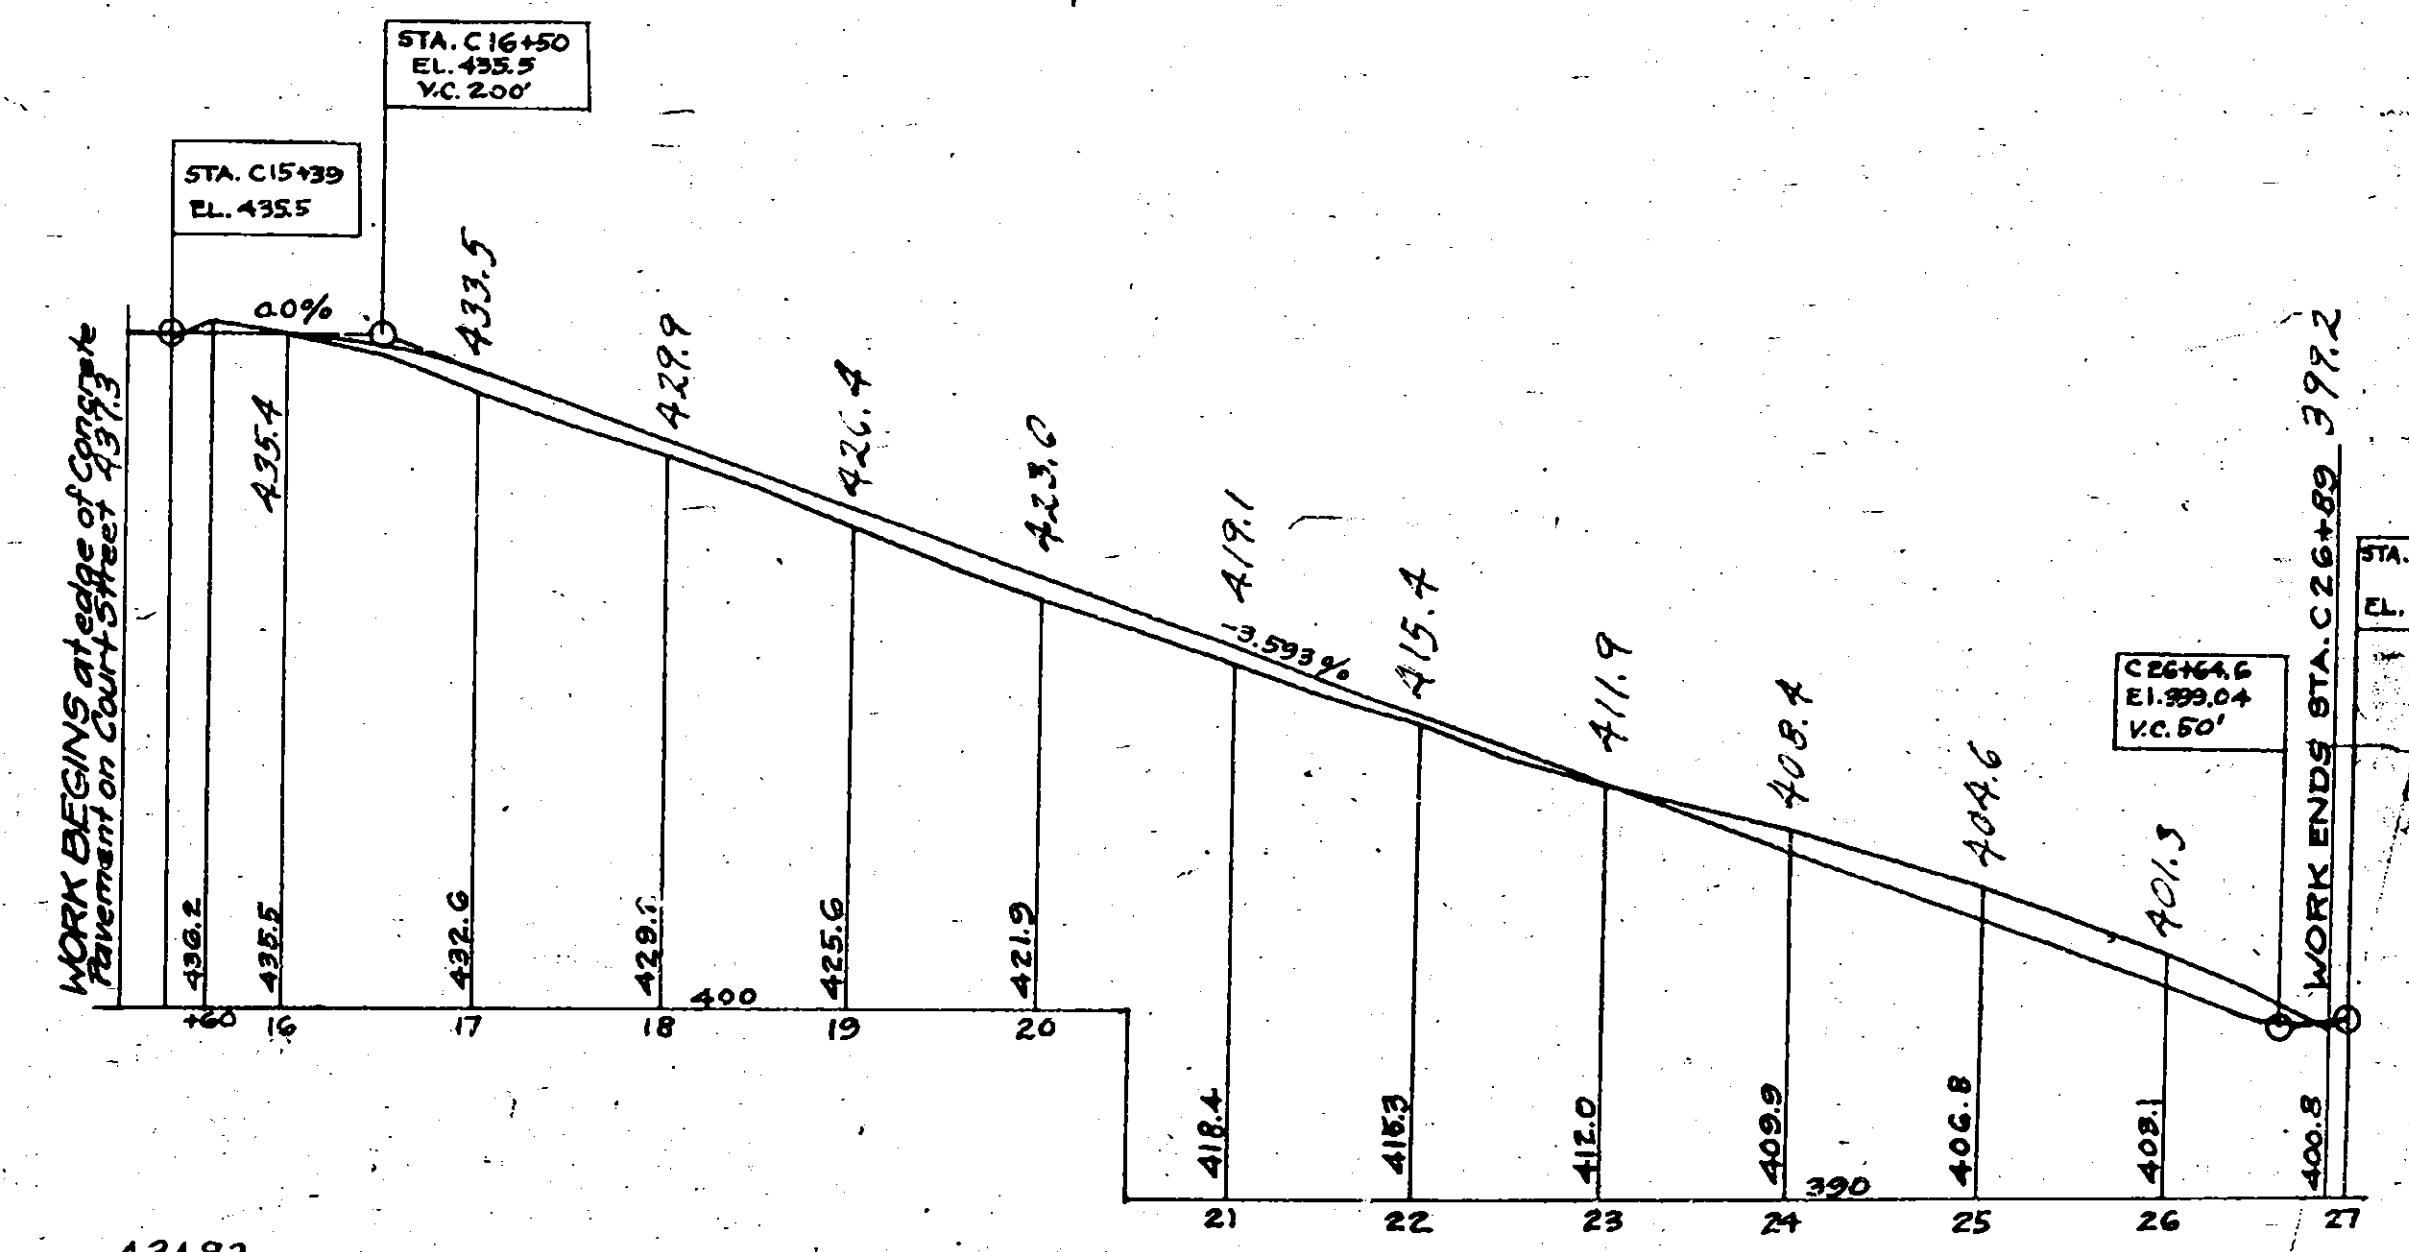

COLLEGE PLACE PROFILE
C LINE

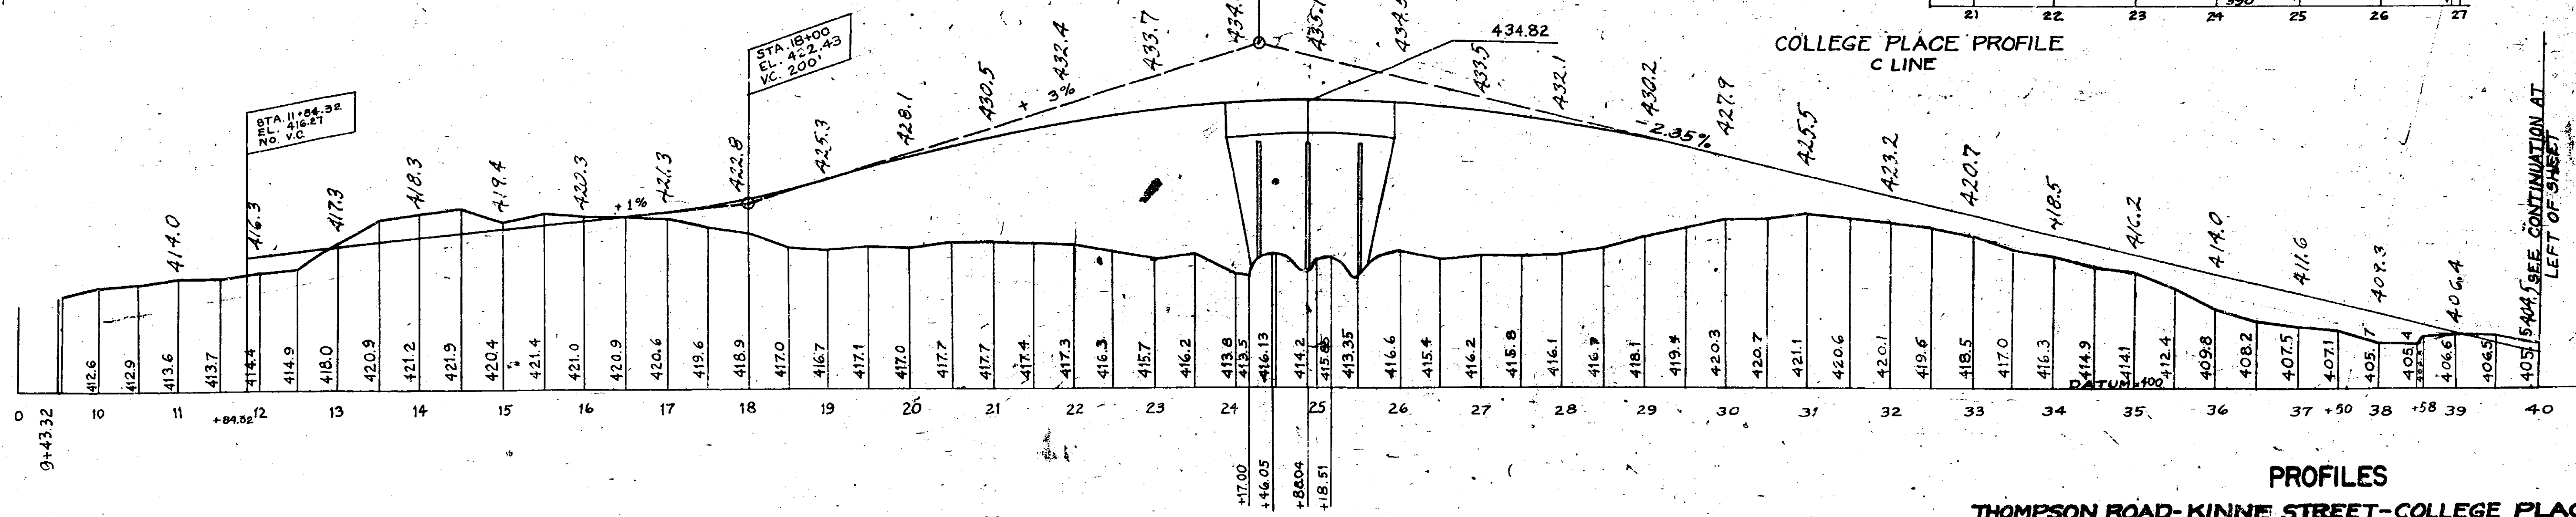


THOMPSON ROAD PROFILE
B LINE

PROFILES
THOMPSON ROAD-KINNE STREET-COLLEGE PLACE
MOHAWK SECTION
NEW YORK STATE THRUWAY

HOR. 1" = 100'-0"
SCALE: VERT. 1" = 10'-0"

for 30-53

COUNTY	SHEET NO.	TOTAL SHEETS
ONONDAGA	32	66
NY STATE THRUWAY, MOWAWK SECTION SUB DIV. B-B		
INTERCHANGE AT THOMPSON ROAD		

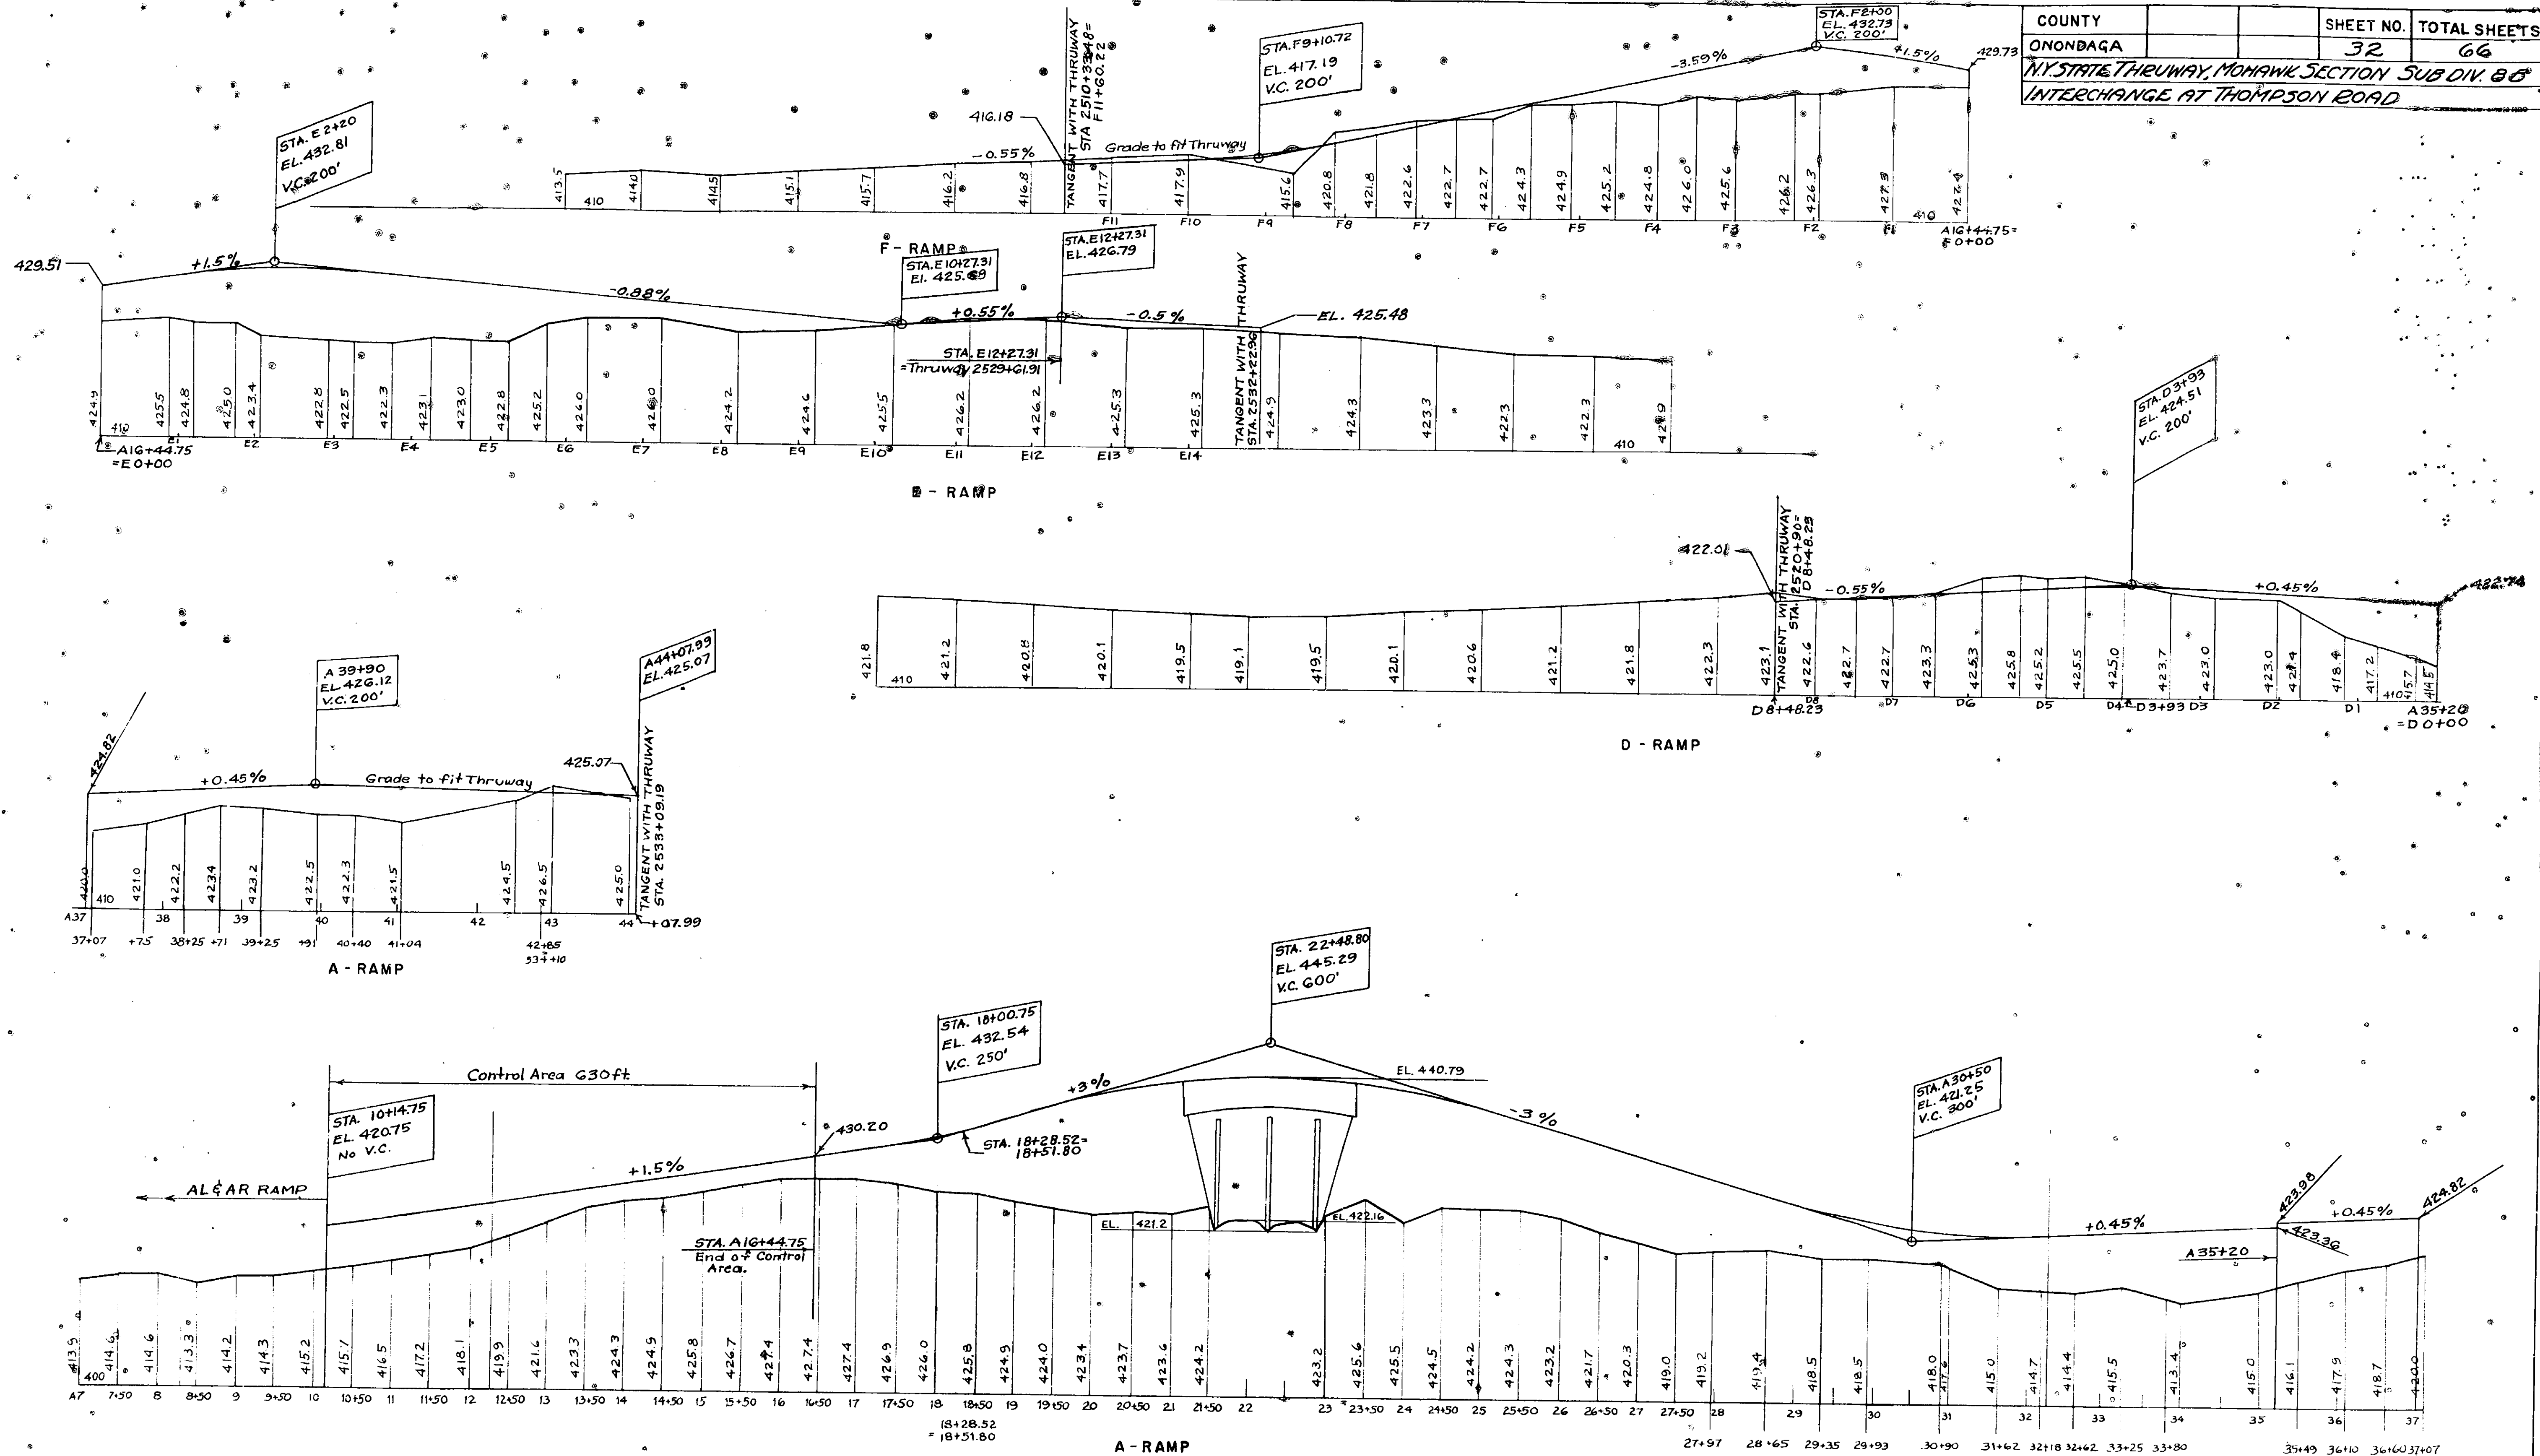


PREPARED AND RECOMMENDED:
 J. J. Doyle Jan 30-53
 URGUHART & DOYLE CONSULTING ENGINEERS
 NEW YORK STATE PROFESSIONAL ENGINEERS LICENSE NO 5667

SCALE: HOR. 1"=100'
 VERT. 1"=10'

PROFILES
 THOMPSON ROAD INTERCHANGE
 MOWAWK SECTION
 NEW YORK STATE THRUWAY

32R

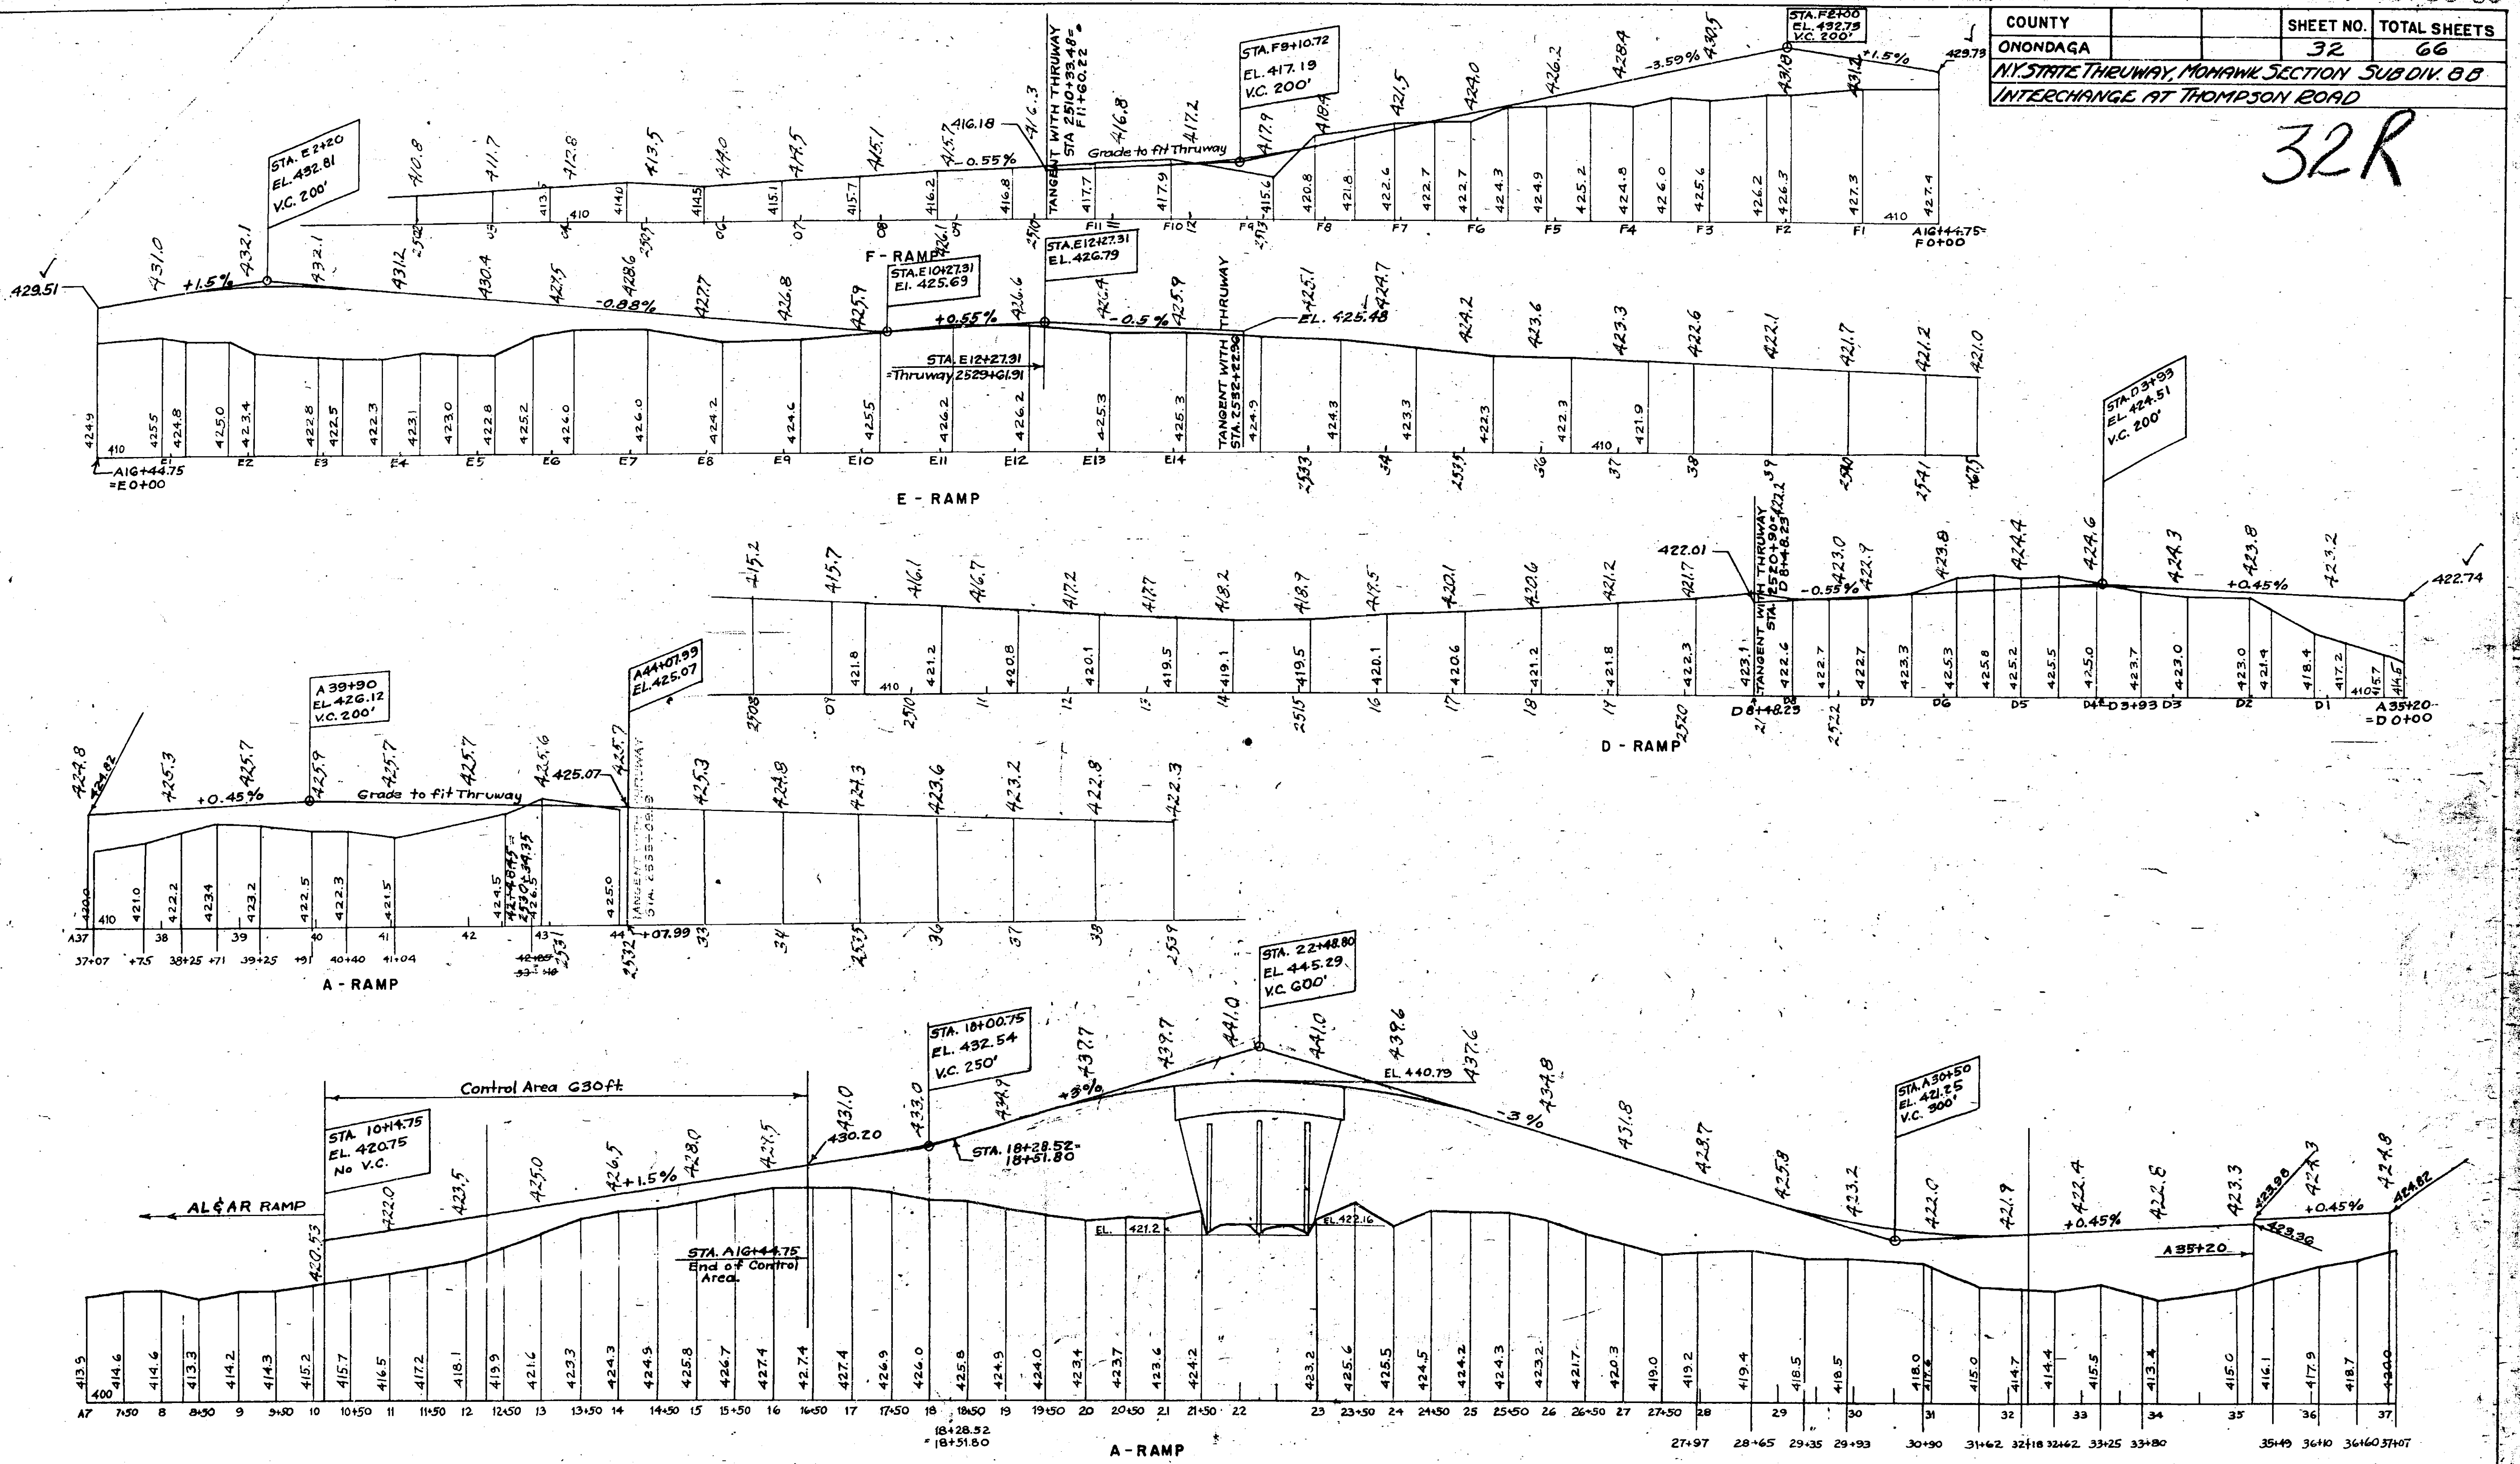



PROFILES

THOMPSON ROAD INTERCHANGE
 MOHAWK SECTION
 NEW YORK STATE THRUWAY


PREPARED AND RECOMMENDED:
 J. J. Doyle Jan 30-53
 HIRSHWART & DOYLE CONSULTING ENGINEERS
 NEW YORK STATE PROFESSIONAL ENGINEERS LICENSE NO 5667

SCALE: HOR. 1"=100'
 VERT. 1"=10'



COUNTY	SHEET NO.	TOTAL SHEETS
ONONDAGA	33	66
N.Y. STATE THRUWAY, MOHAWK SECTION, SUBDIV. B B		
INTERCHANGE AT THOMPSON ROAD		

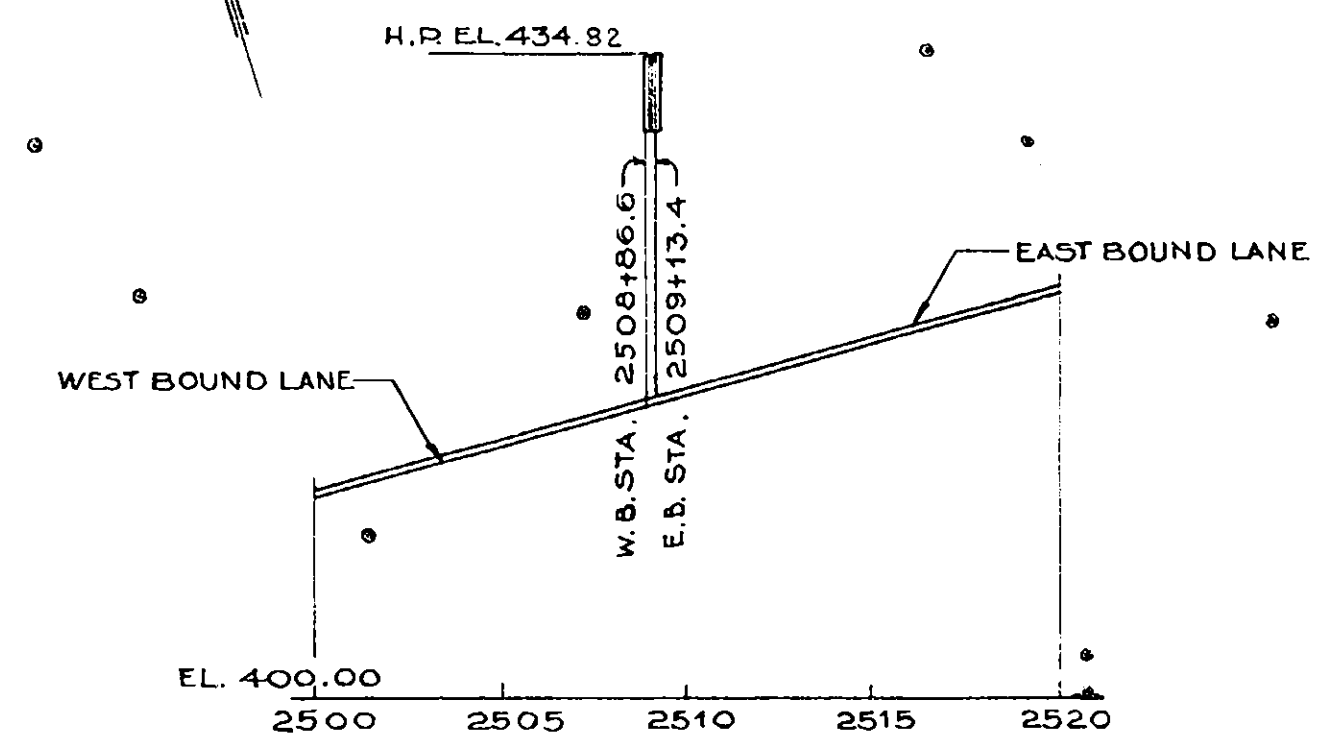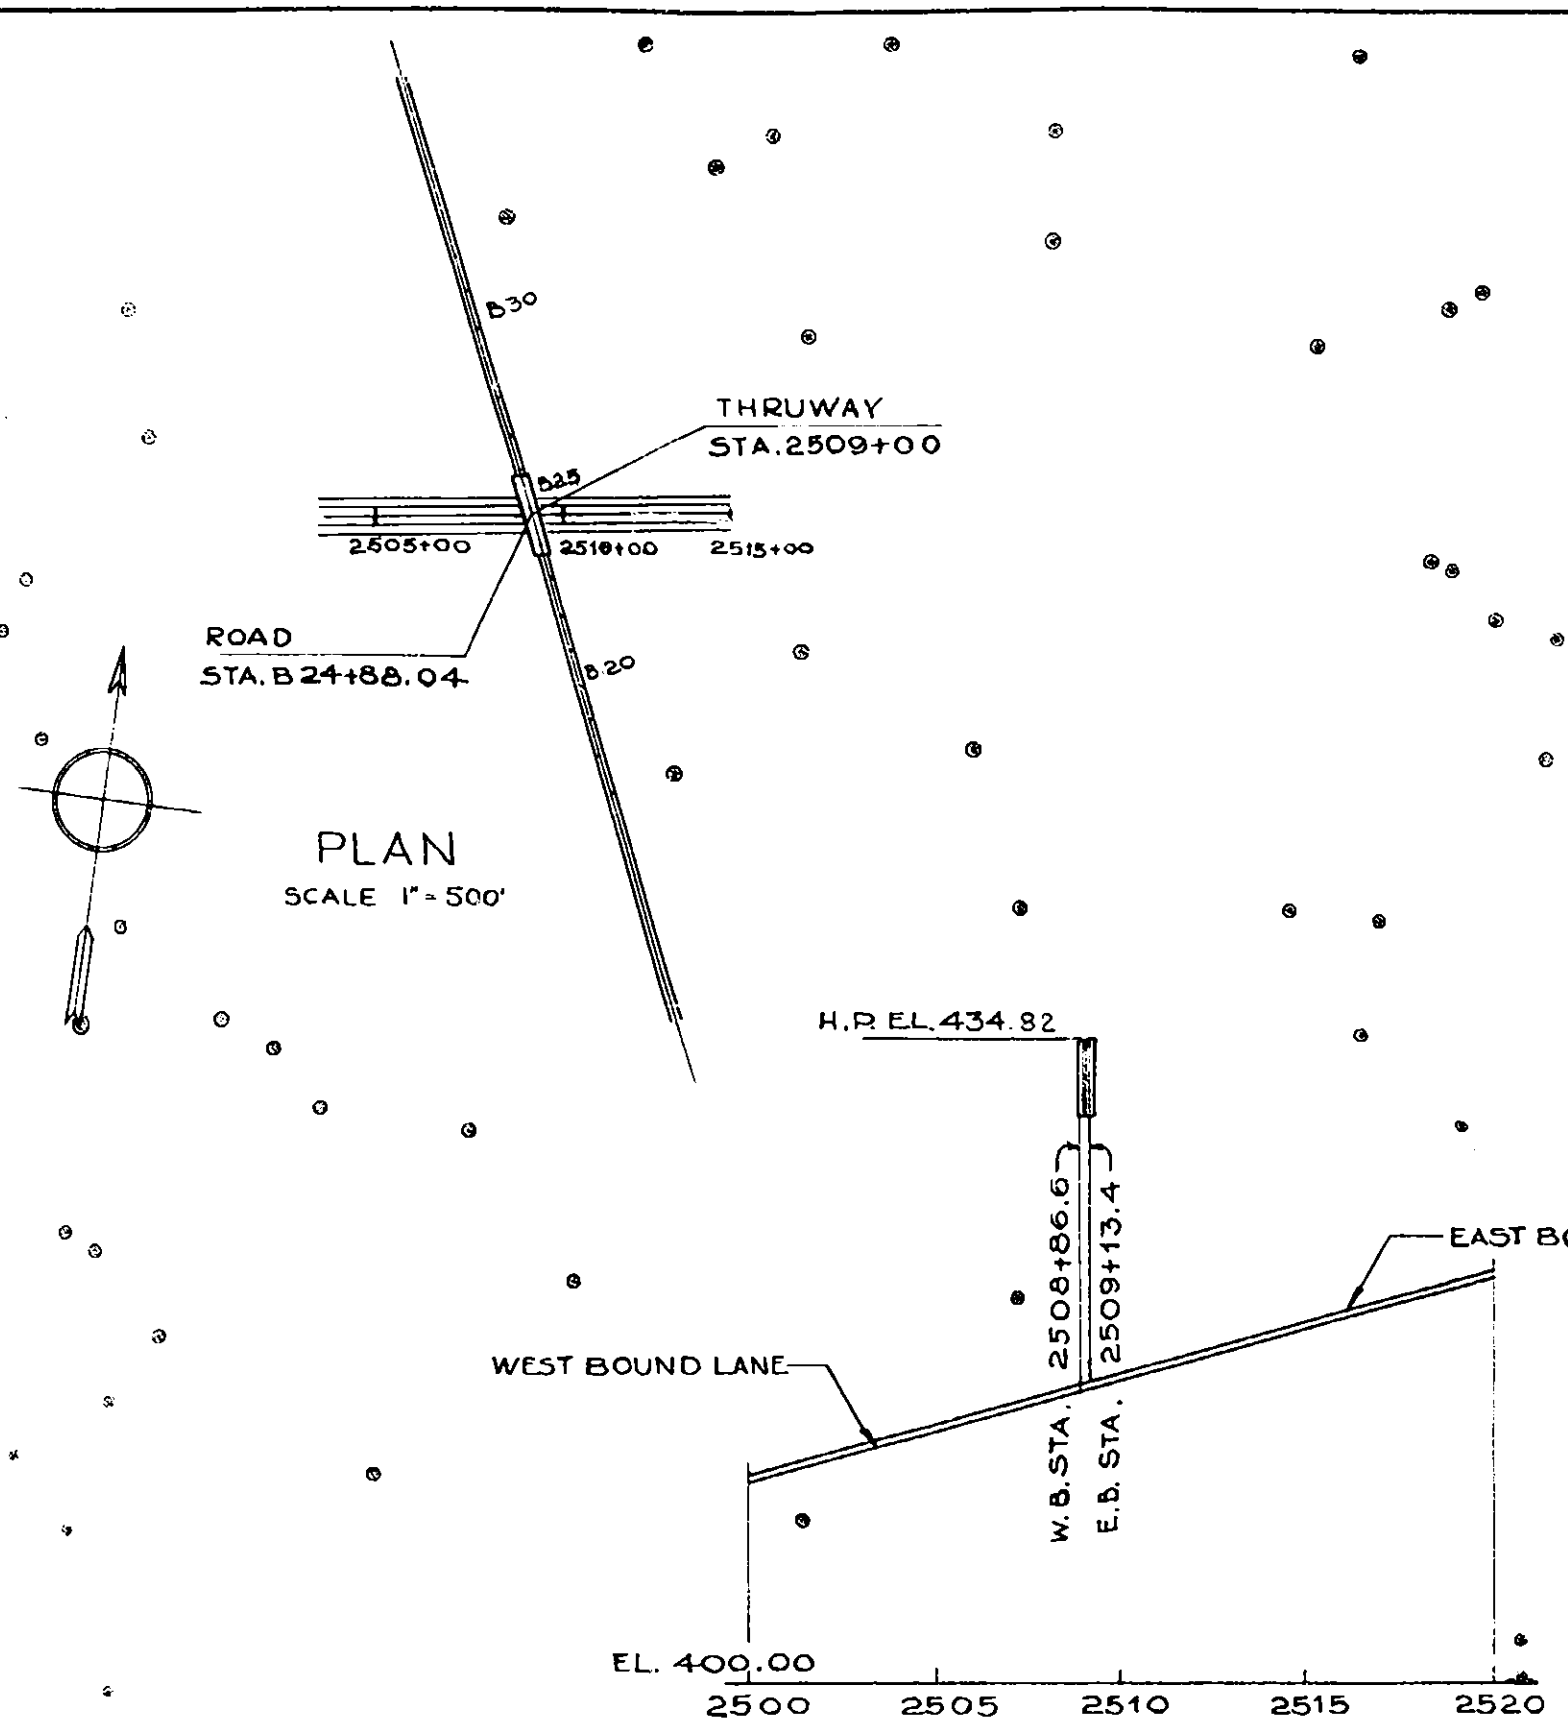

THRUWAY PROFILE
* SCALES: HOR. 1"=500'
VERT. 1"=10'

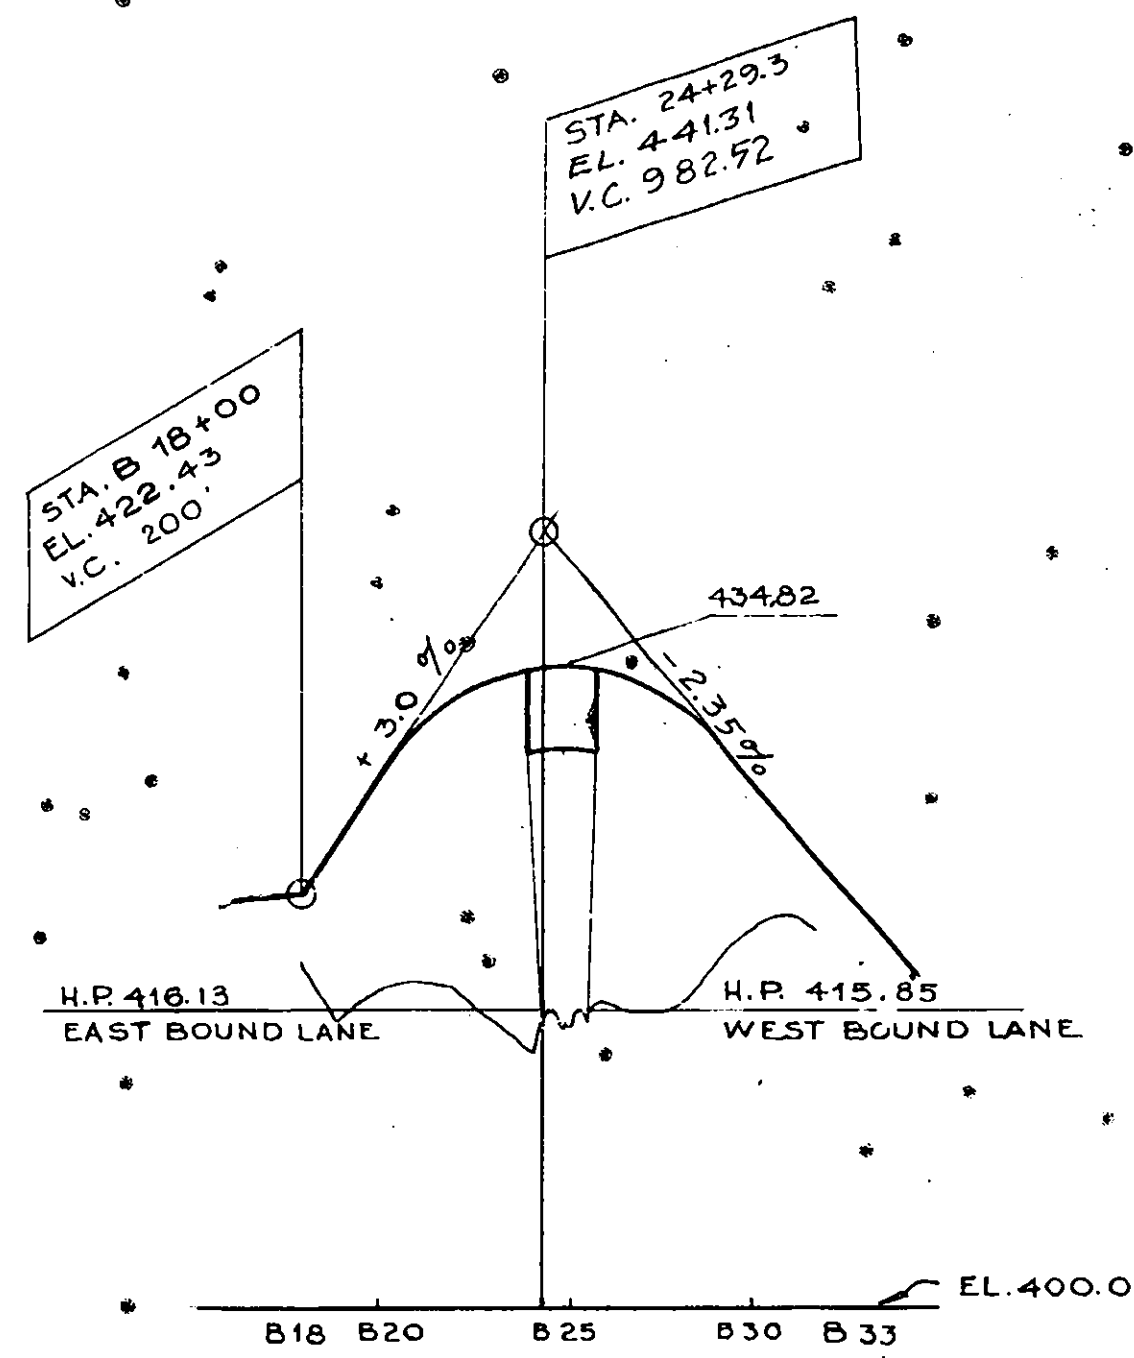

APPROACH PROFILE
SCALE: HOR. 1"=500'
VERT. 1"=10'

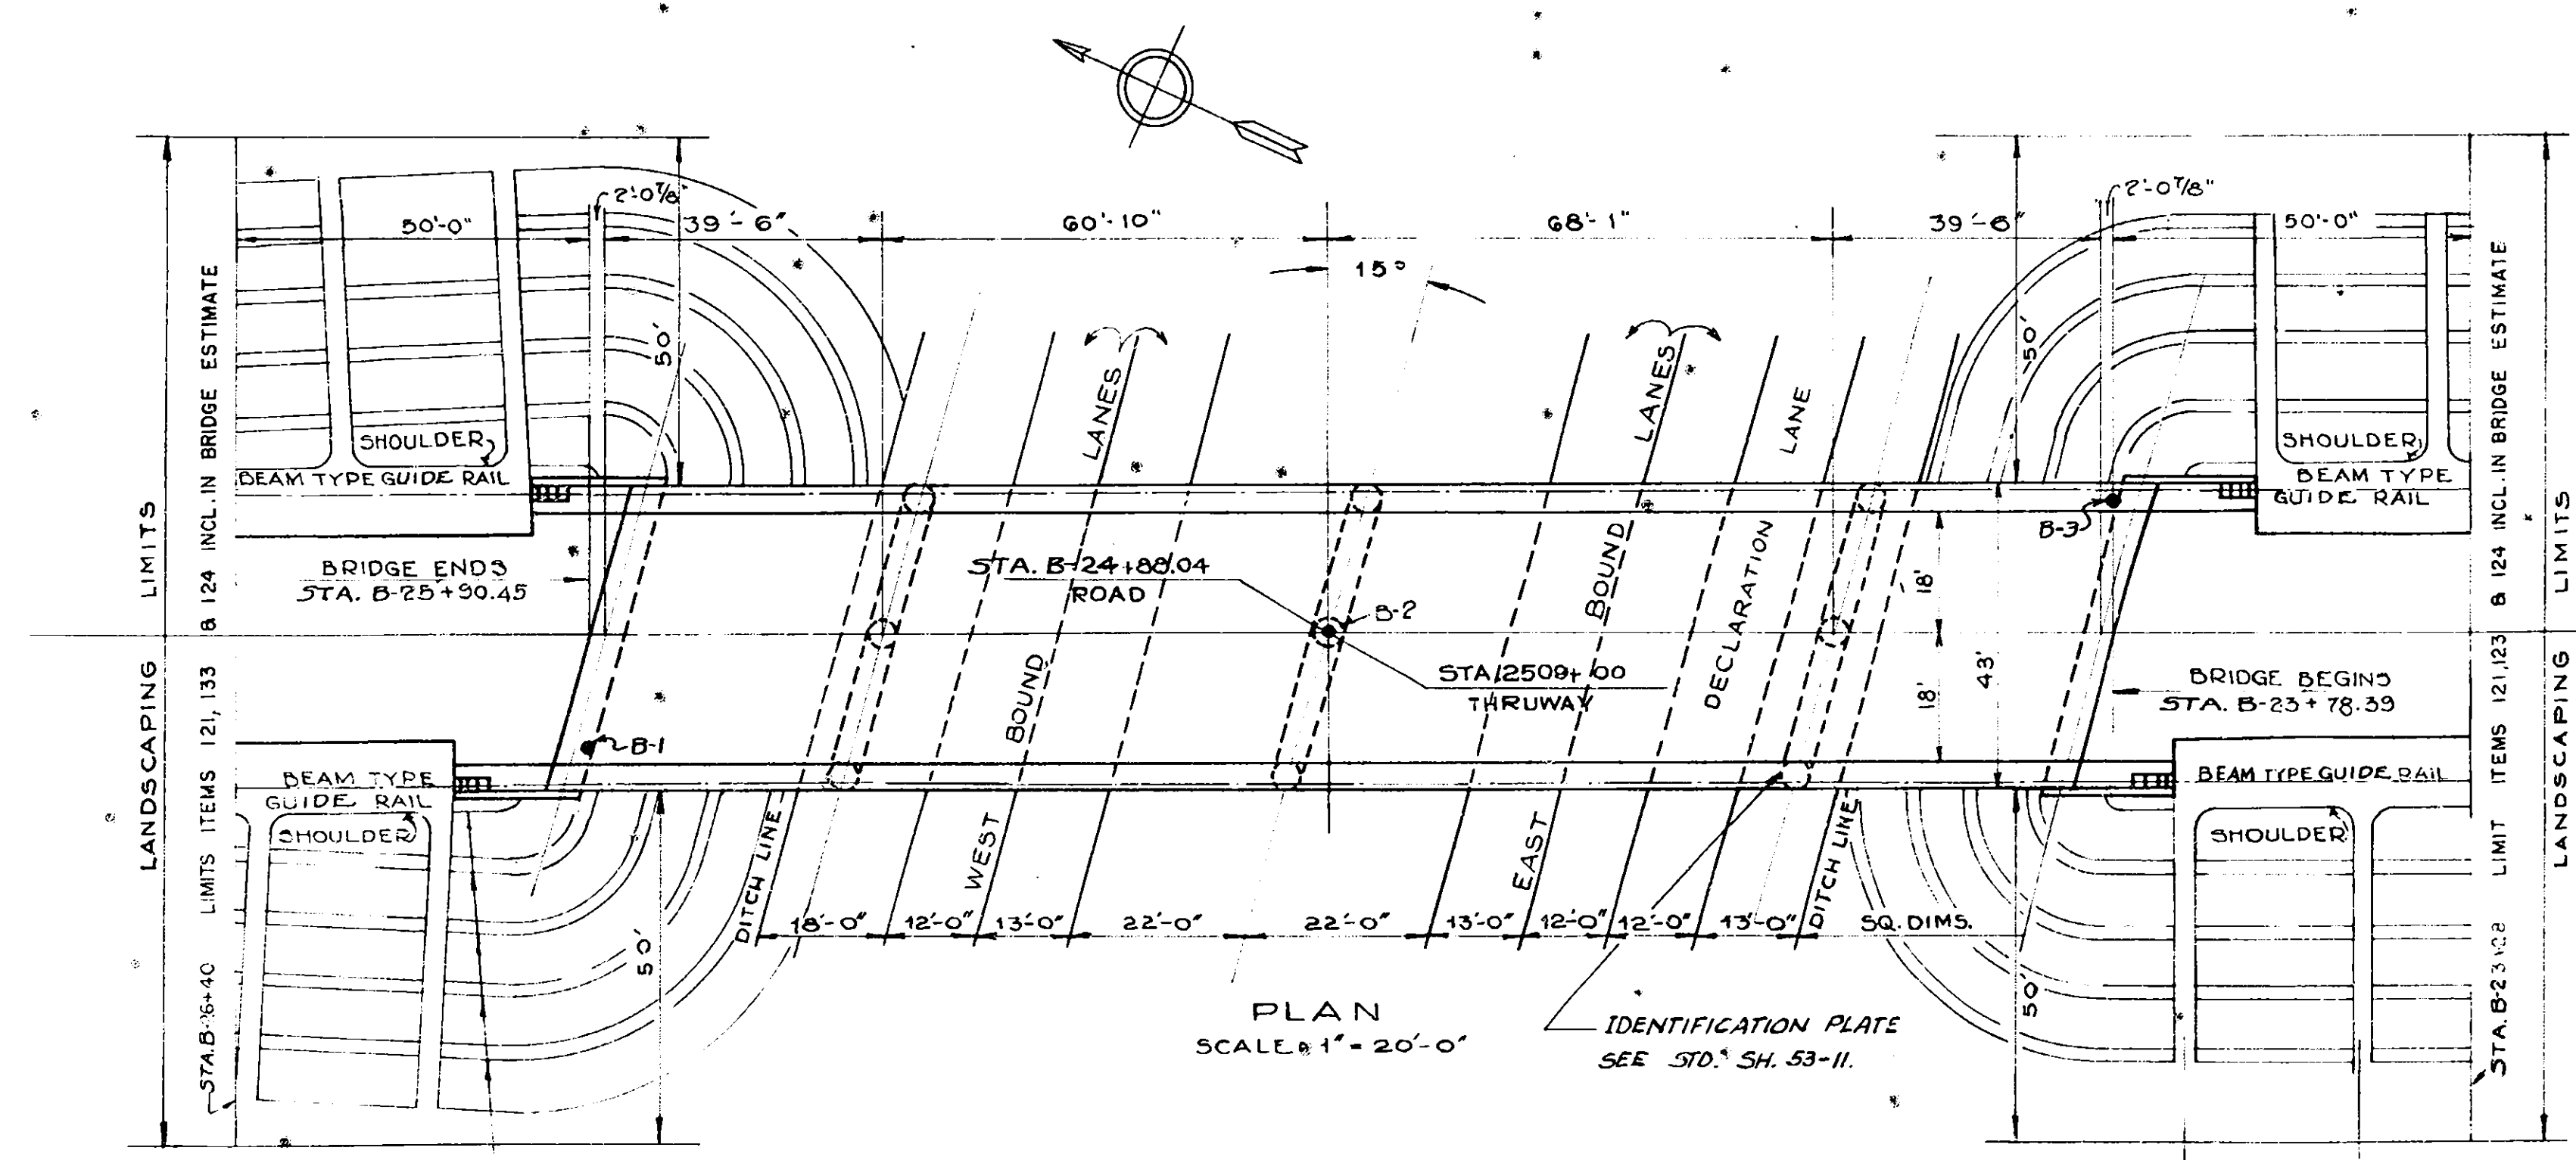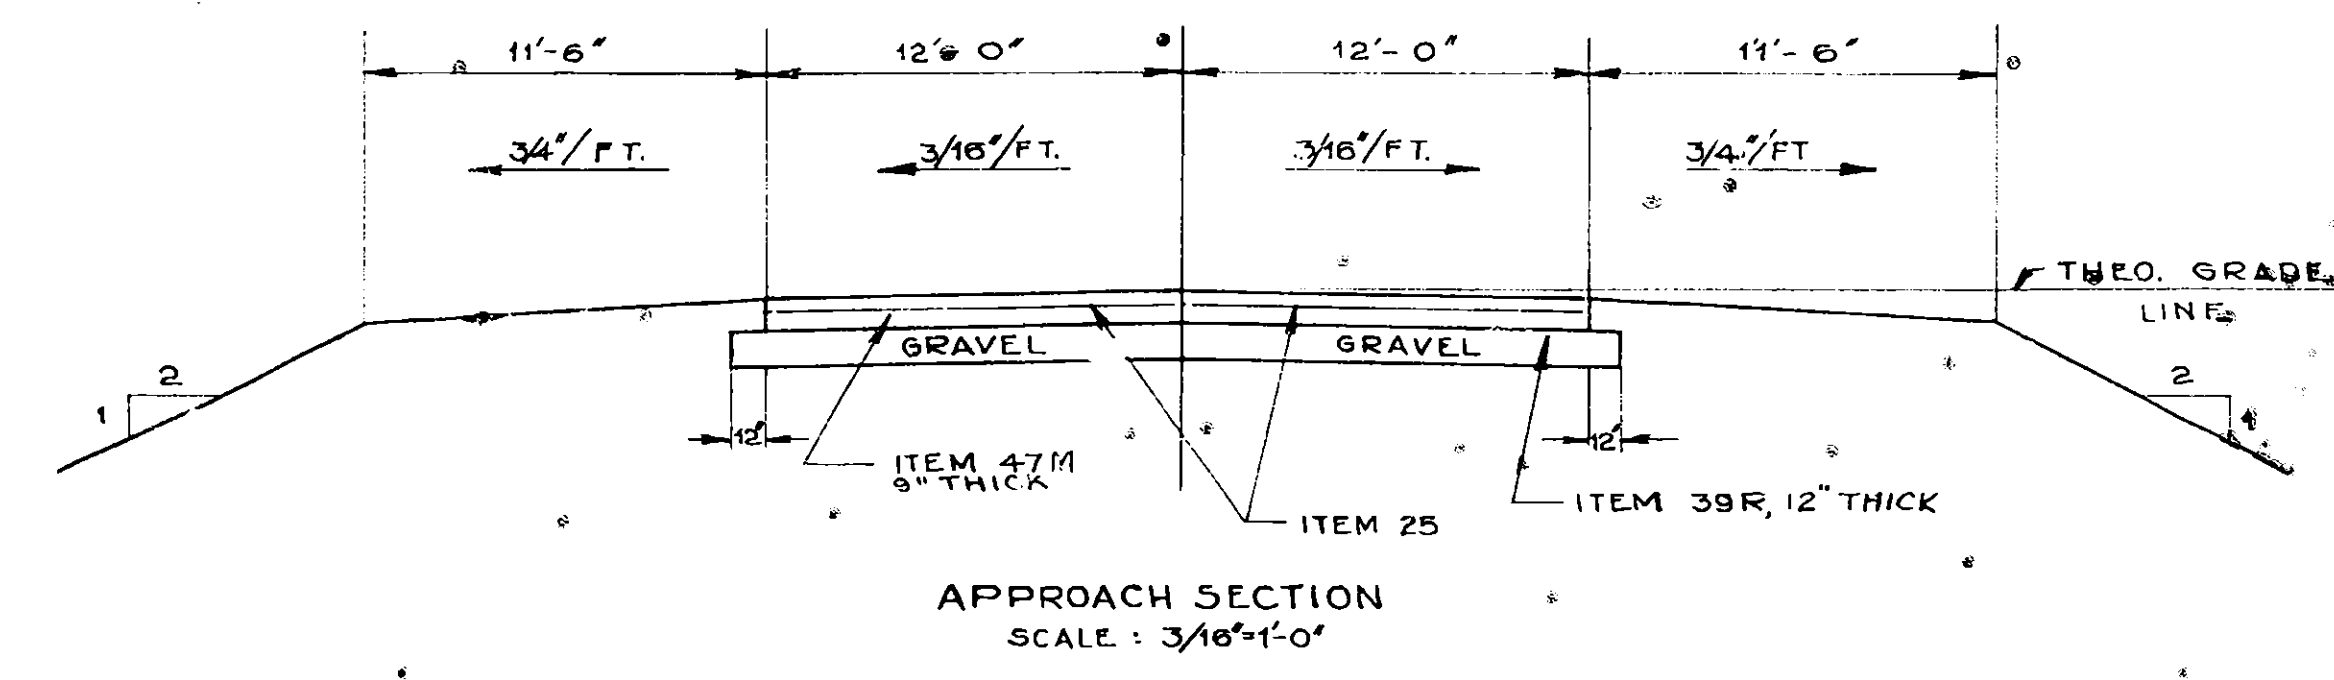

PLAN
SCALE 1"=20'-0"
IDENTIFICATION PLATE
SEE STD. SH. 53-11.

DEPARTMENT OF PUBLIC WORKS

RECOMMENDED *Wm Robinson* 7/6/53
WM. ROBINSON
DISTRICT ENGINEER
DATE

APPROVED *E.T. GAWKINS*
E.T. GAWKINS
DEPUTY CHIEF ENGINEER
DATE

E.W. WENDELL
DEPUTY CHIEF ENGINEER
DATE

J.B. McMorran
J.B. MCMORRAN
CHIEF ENGINEER
DATE

APPROVED *February 16* 1953
NEW YORK STATE THRUWAY AUTHORITY


B.D. TALLAM, CHAIRMAN
BY C. H. LANG
DEPUTY CHIEF ENGINEER

PRELIMINARY LAYOUT
THOMPSON ROAD
MOHAWK SECTION
NEW YORK STATE THRUWAY


PREPARED AND RECOMMENDED
URQUHART & DOYLE CONSULTING ENGINEERS
NEW YORK STATE PROFESSIONAL ENGINEERS LICENSE NO. 5667
DATE 12-29-52
2 FT SOD STRIP SET ON CONTOURS

3 FT SOD STRIP AT RIGHT
ANGLE TO CONTOURS

COUNTY	SHEET NO.	TOTAL SHEETS
ONONDAGA	34	66
N.Y. STATE THRUWAY, MOHAWK SECTION, SUBDIV. B B		
INTERCHANGE AT THOMPSON ROAD		

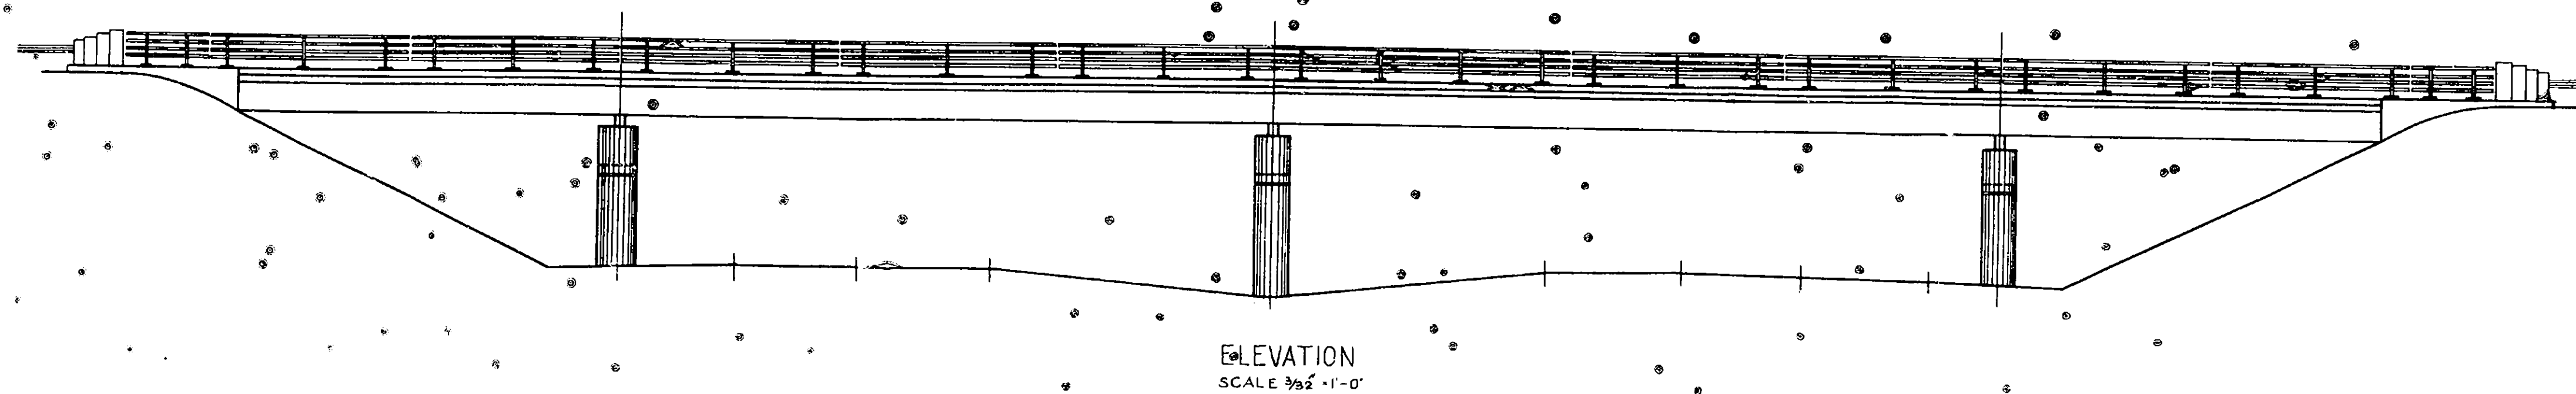


ELEVATION
SCALE $\frac{3}{32}'' = 1'-0''$

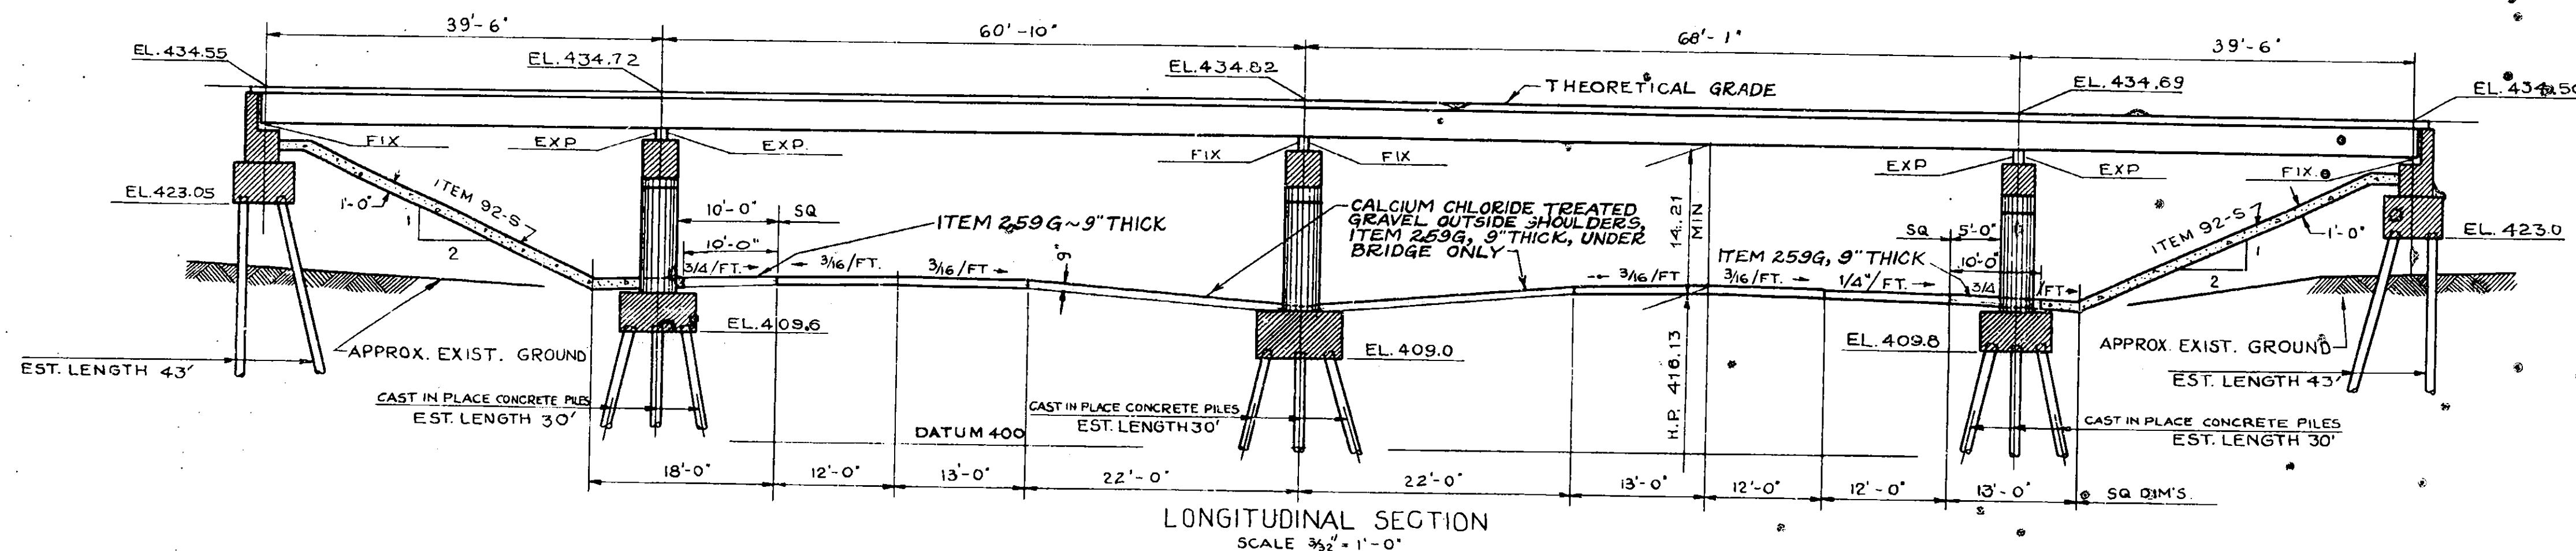

LONGITUDINAL SECTION
SCALE $\frac{3}{32}'' = 1'-0''$

NOTES:
DESIGN SPECIFICATIONS, A.A.S.H.O. 1949, H-20-S16 LOADING MODIFIED.
MATERIAL AND FABRICATION SPECIFICATIONS N.Y.S.D.P.W. JAN. 2, 1951 SUPERSTRUCTURE WF BEAMS,
COMPOSITE CONSTRUCTION CENTER SPANS ONLY.
FOUNDATION TREATMENT OF ABUTMENTS ON PILES: FOR DESIGN PURPOSES, THE ASSUMED
LOAD PER PILE DOES NOT EXCEED 30 TONS.
PIERS ON PILE FOUNDATIONS: FOR DESIGN PURPOSES, THE ASSUMED LOAD PER PILE DOES NOT
EXCEED 30 TONS.
TOP SOILING SODDING AND SEEDING TO BE SHOWN ON BRIDGE CONTRACT PLANS AND INCLUDED IN
BRIDGE ESTIMATE FOR BOTH APPROACHES TO EXTENT NOTED IN PLAN.

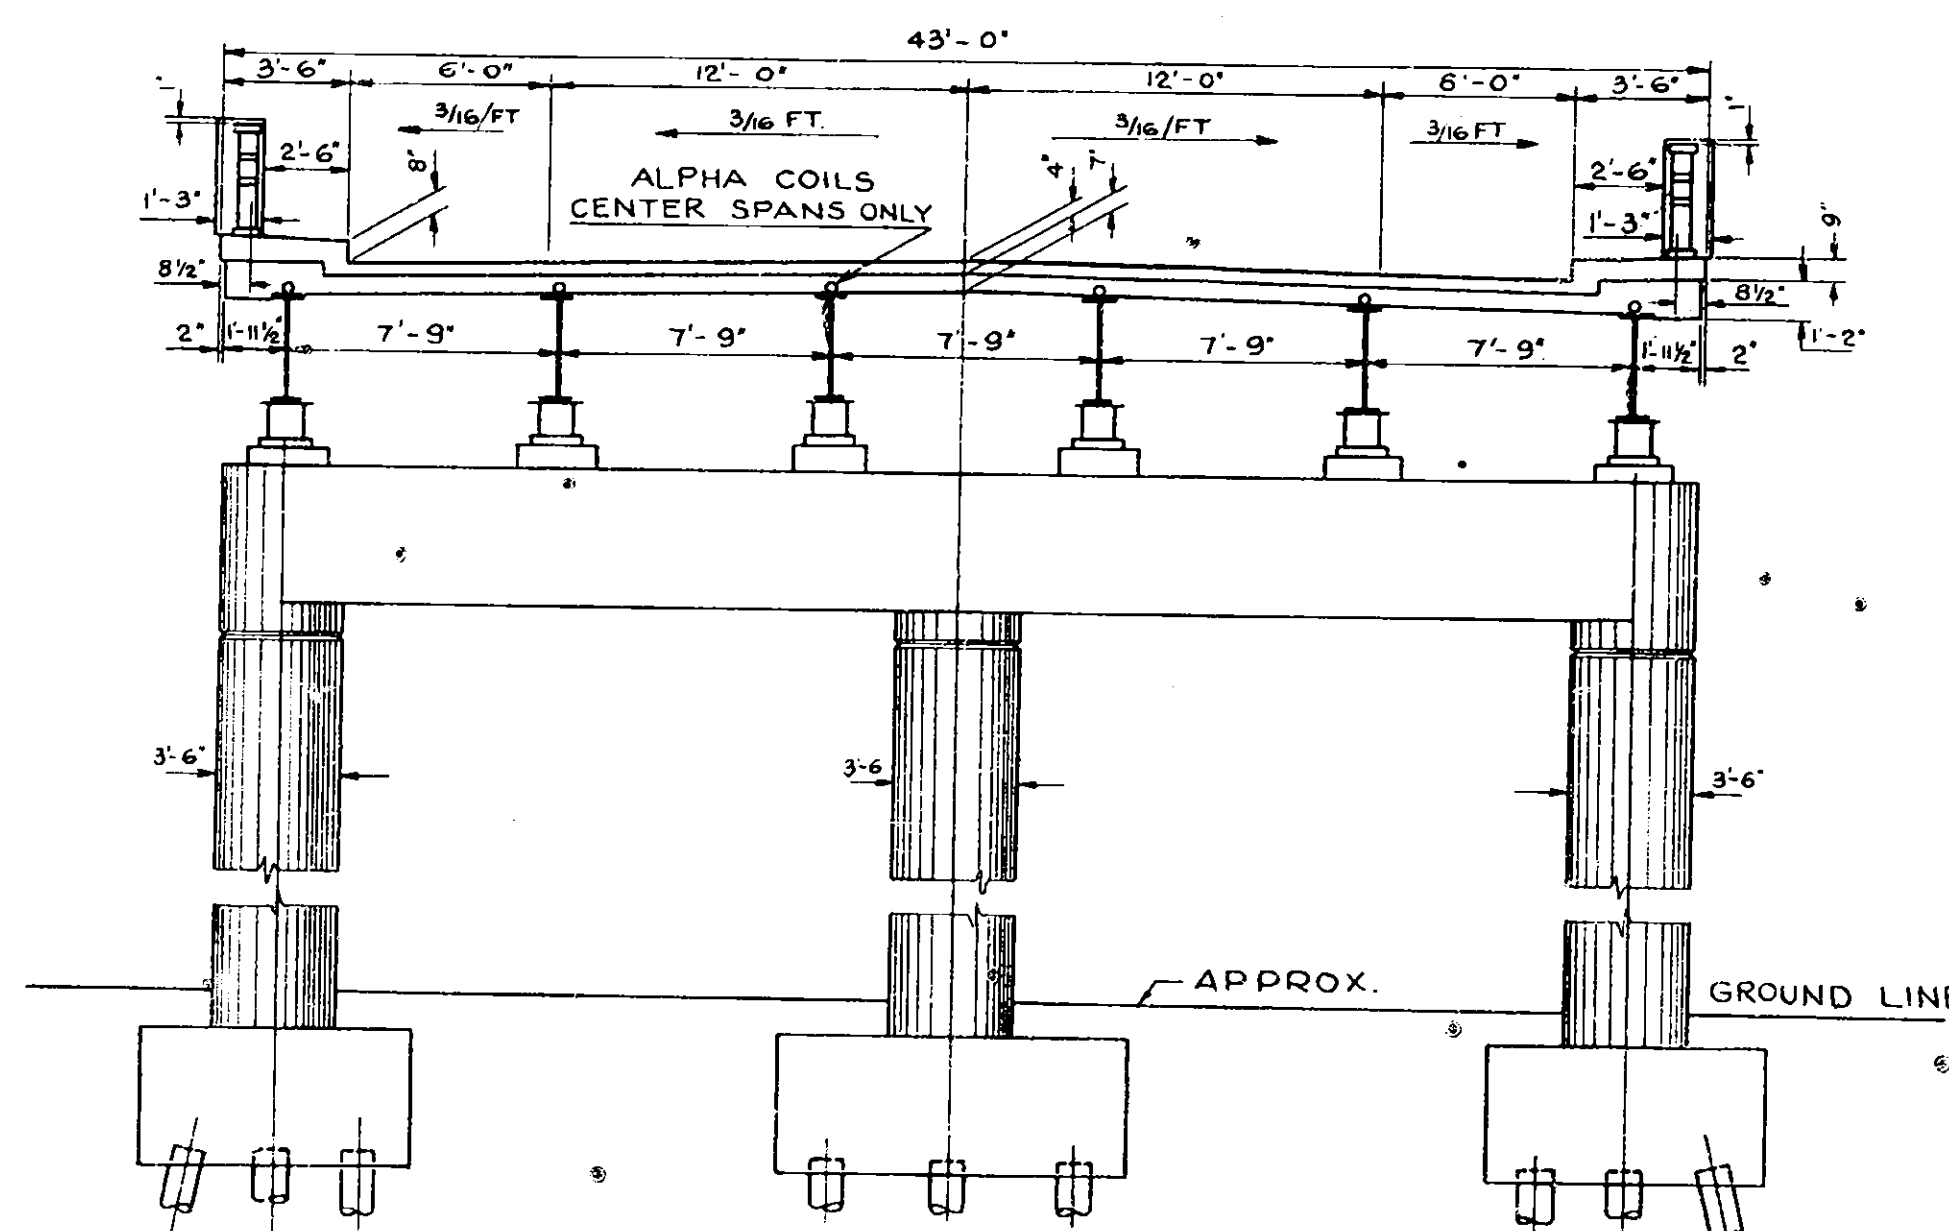



TRANSVERSE SECTION
SCALE $\frac{3}{16}'' = 1'-0''$

PREPARED AND RECOMMENDED

URQUHART & DOYLE CONSULTING ENGINEERS
NEW YORK STATE PROFESSIONAL ENGINEERS LICENSE NO. 5667



PRELIMINARY LAYOUT
THOMPSON ROAD
MOHAWK SECTION
NEW YORK STATE THRUWAY

COUNTY	SHEET NO.	TOTAL SHEETS
ONONDAGA	35	66
NEW YORK STATE THRUWAY, MOHAWK SECTION SUBDIV. 8B		
INTERCHANGE AT THOMPSON ROAD		

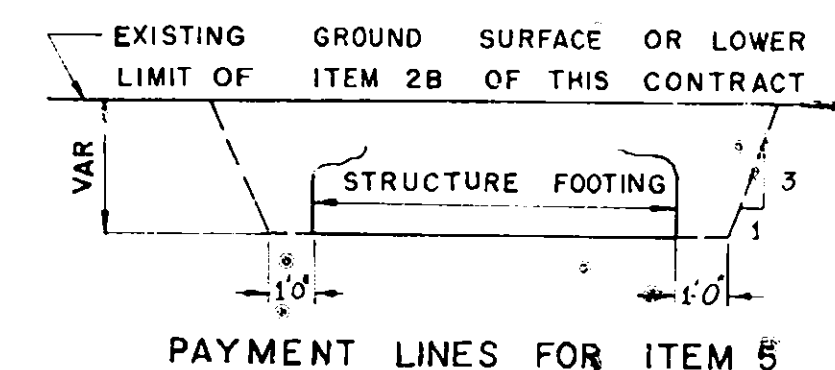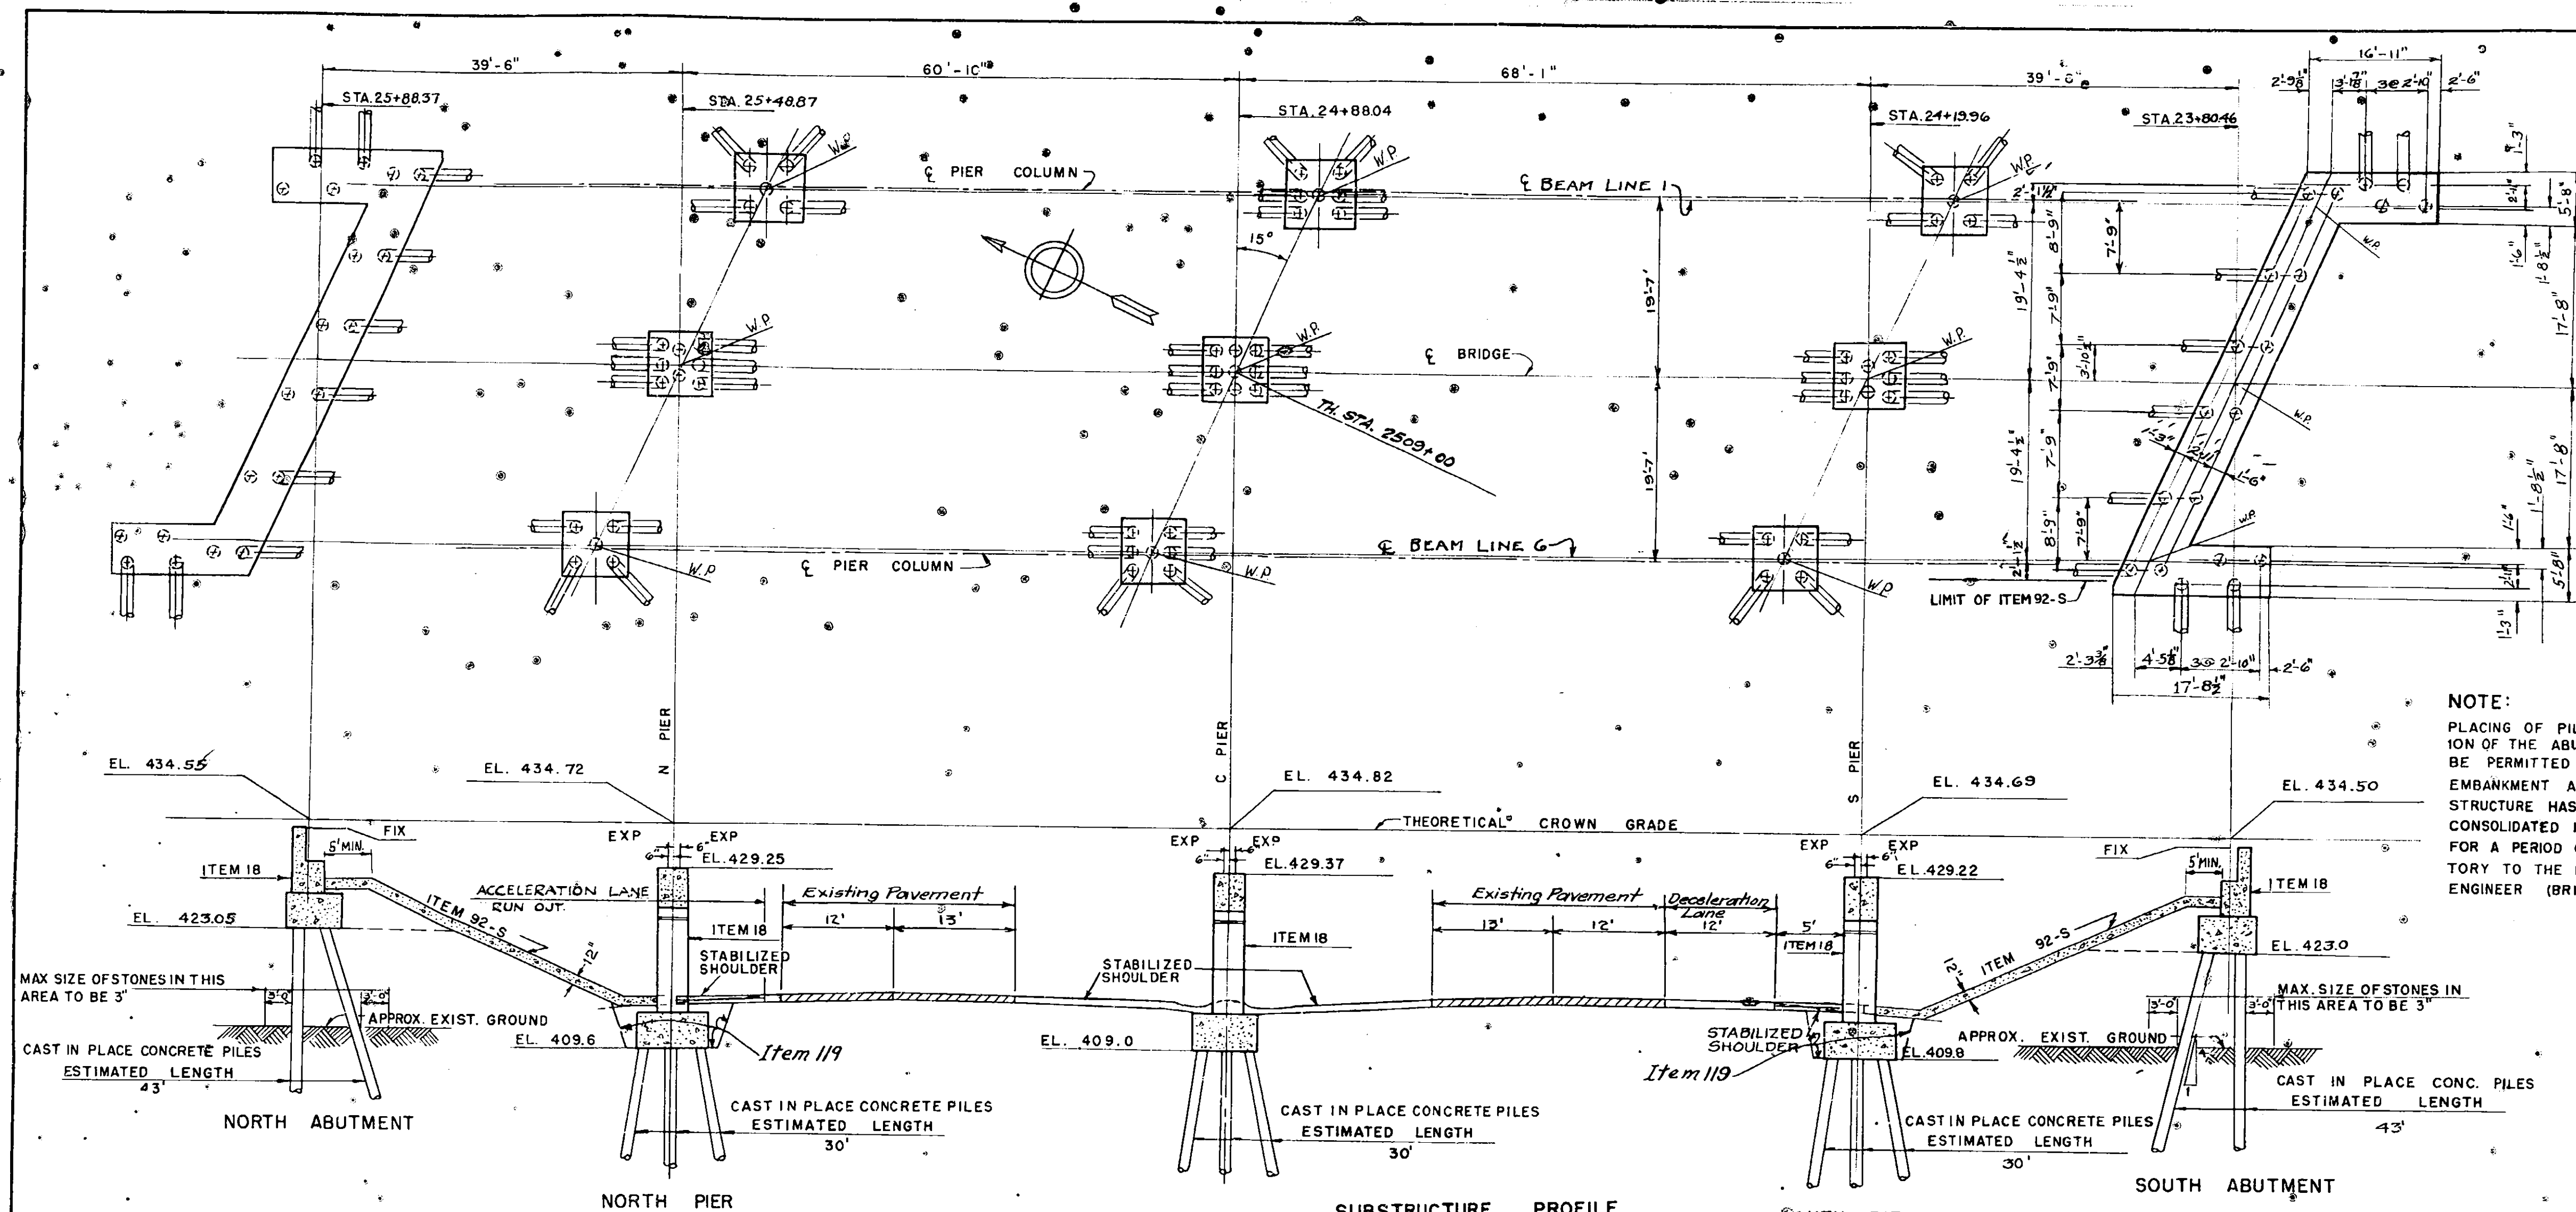


NOTE:

PLACING OF PILES AND CONSTRUCTION OF THE ABUTMENTS WILL NOT BE PERMITTED UNTIL THE HIGHWAY EMBANKMENT ADJACENT TO THE STRUCTURE HAS BEEN PLACED AND CONSOLIDATED IN A MANNER AND FOR A PERIOD OF TIME SATISFACTORY TO THE DEPUTY CHIEF ENGINEER (BRIDGES).

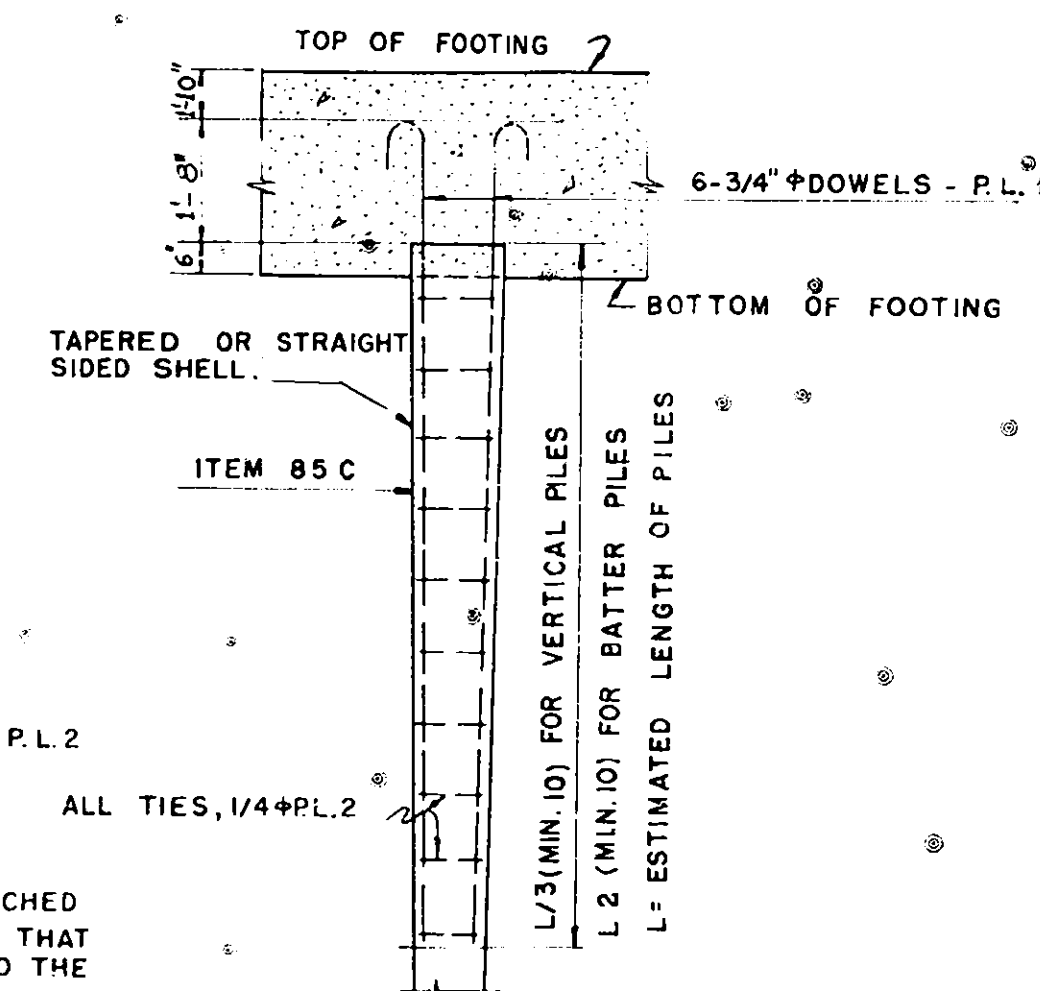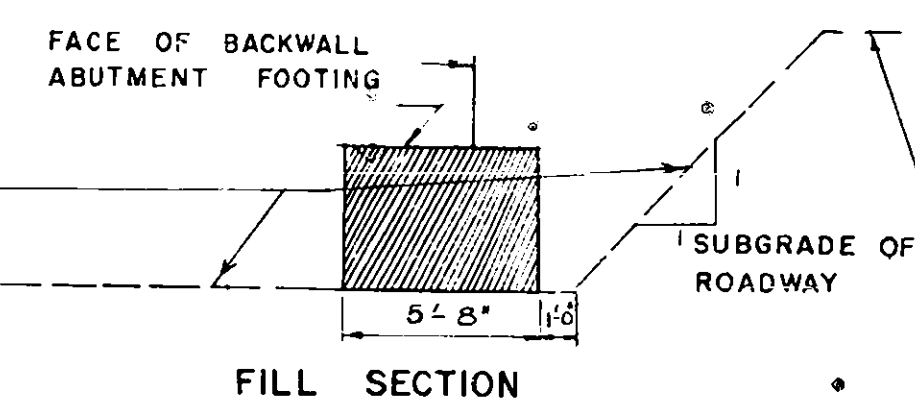SUBSTRUCTURE PROFILE
SCALE 1/32" = 1'-0"

NOTE:
SHEET NUMBERS IN THE LOWER RIGHT-HAND CORNER OF THE SHEETS ARE TO BE USED FOR CROSS REFERENCE OF THE STRUCTURAL DETAILS.

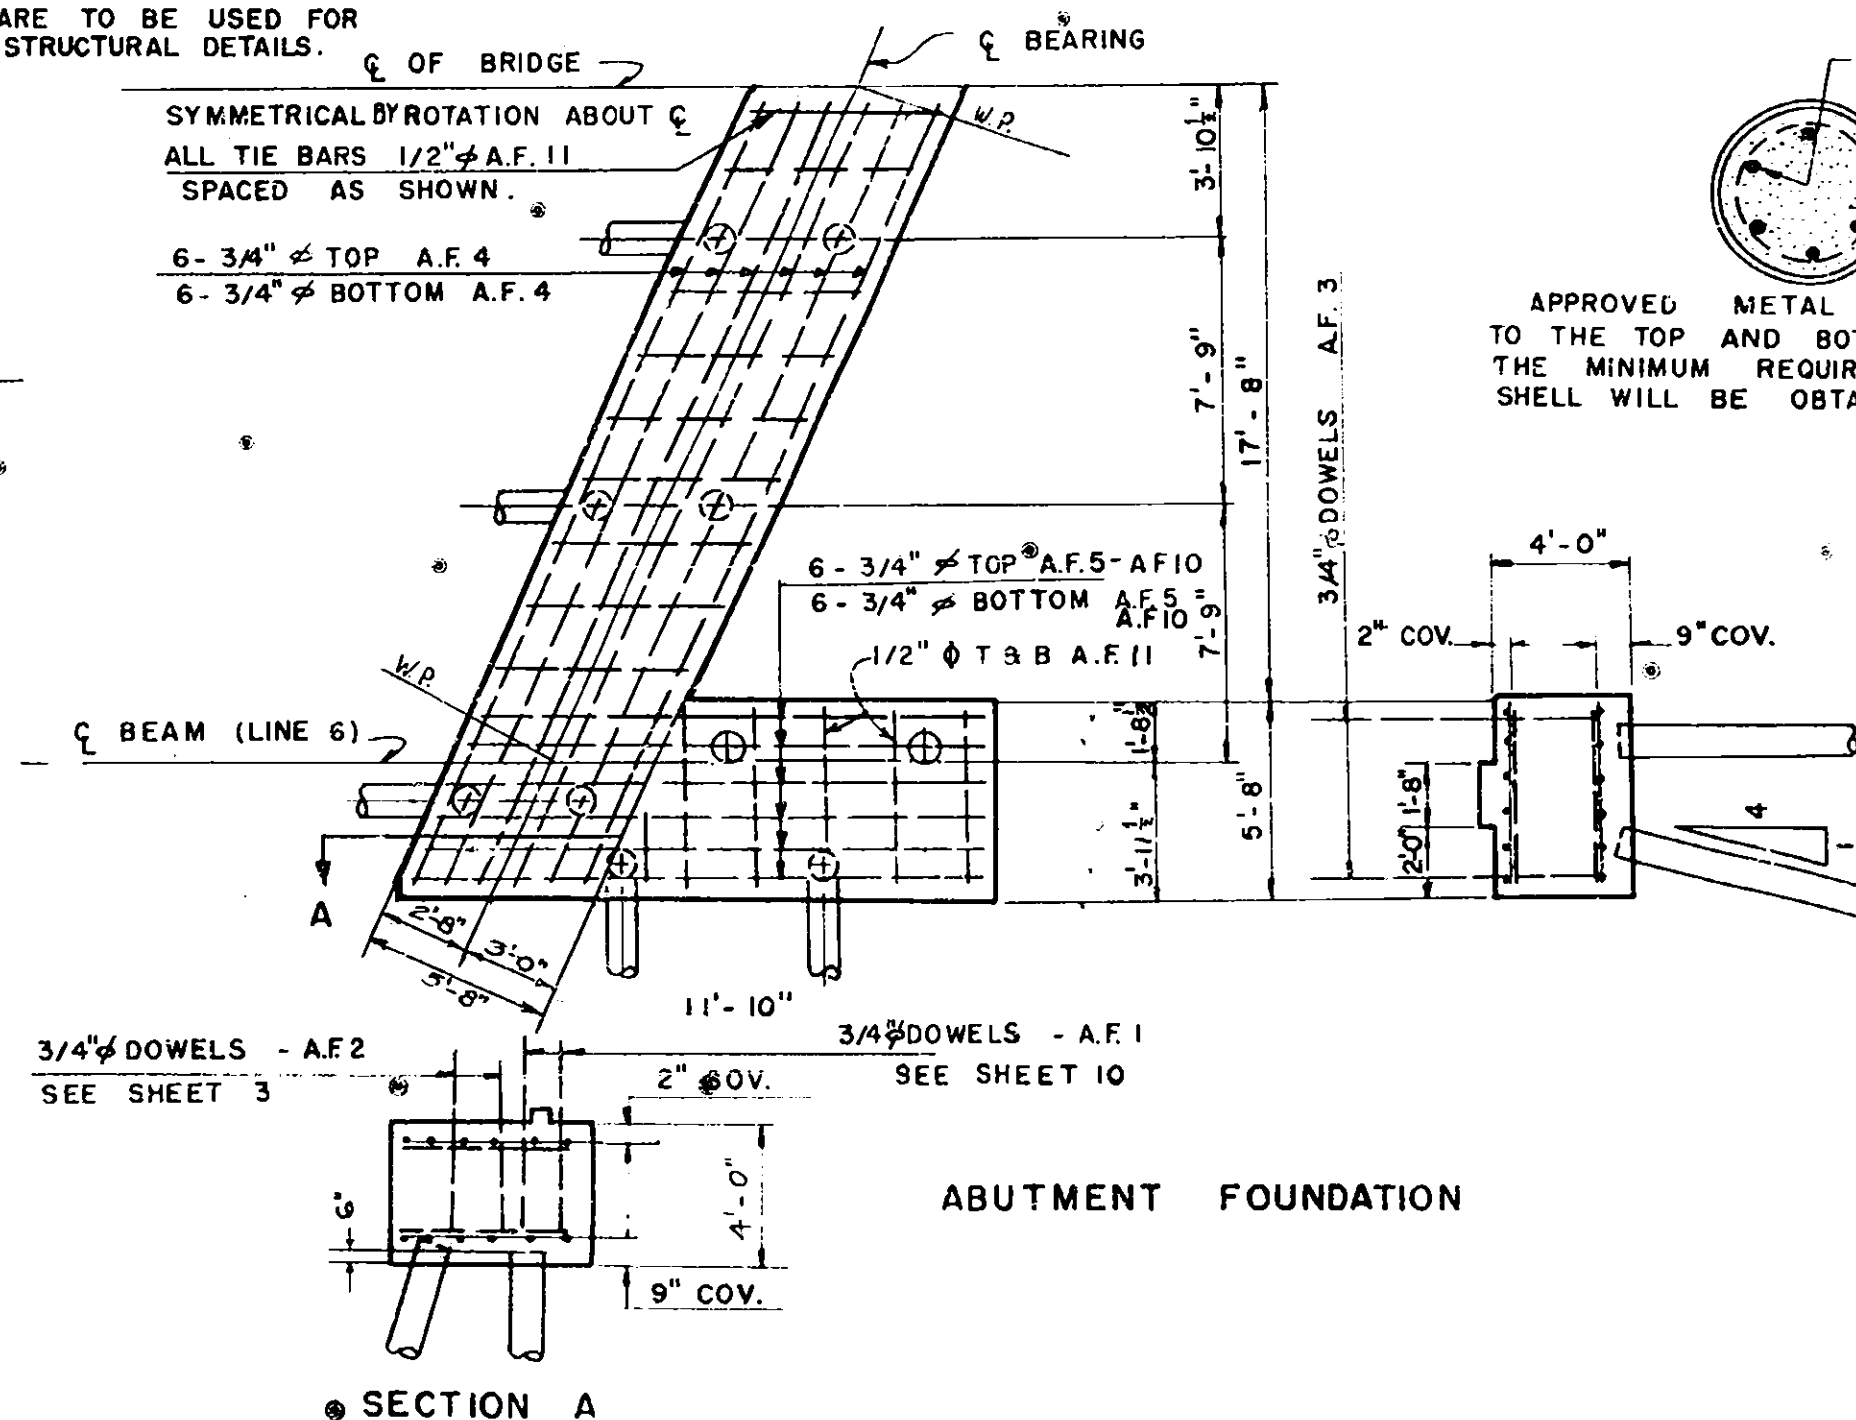

SECTION

CAST IN PLACE CONC. PILE REINFORCEMENT

CROSS REFERENCE

FOR DETAILS OF ABUTMENTS SEE SHEET 36
FOR DETAILS OF PIERS SEE SHEET 37
FOR DETAILS OF BARS SEE SHEET 43


NOTE:

CROSS REFERENCE SHEET NUMBERS ARE THOSE SHOWN IN THE LOWER RIGHT HAND CORNER OF THE SHEETS.


SUBSTRUCTURE DETAILS

THOMPSON ROAD
MOHAWK SECTION
NEW YORK STATE THRUWAY


COUNTY *	SHEET NO.	TOTAL SHEETS
ONONDAGA	36	66
N.Y. STATE THRUWAY, MOHAWK SECTION SUB DIV. B B		
INTERCHANGE AT THOMPSON ROAD		

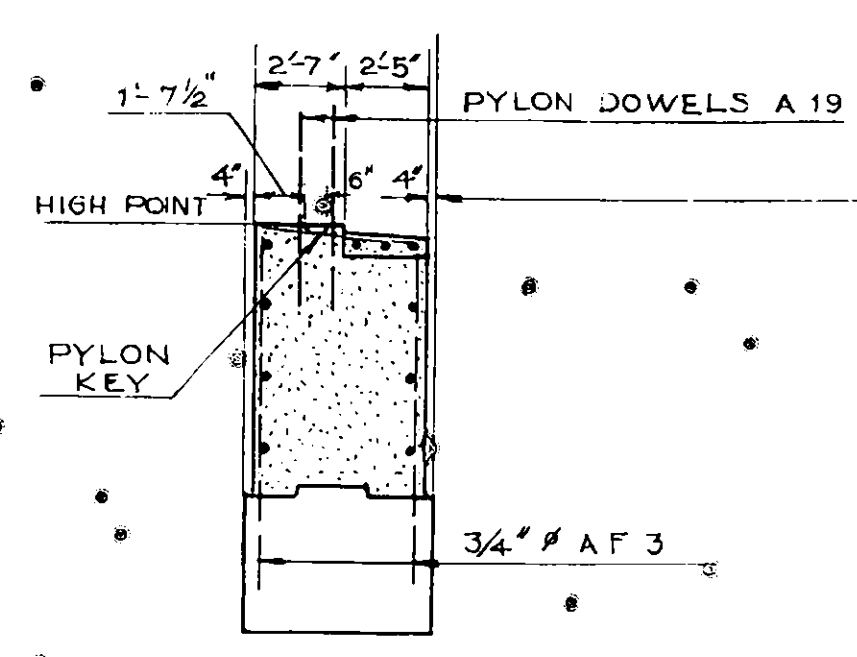

SECTION 4-4

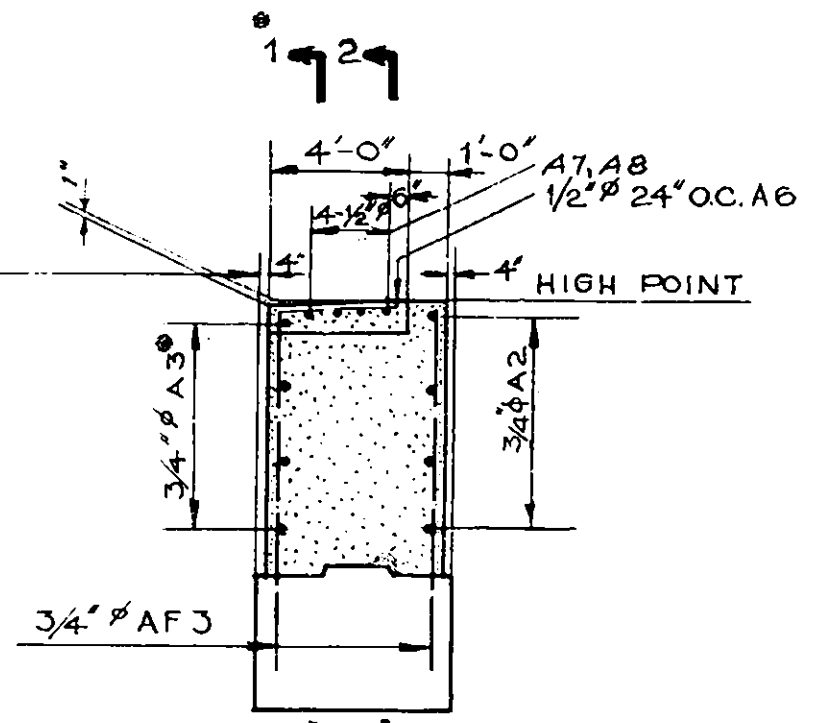


SECTION 3-3

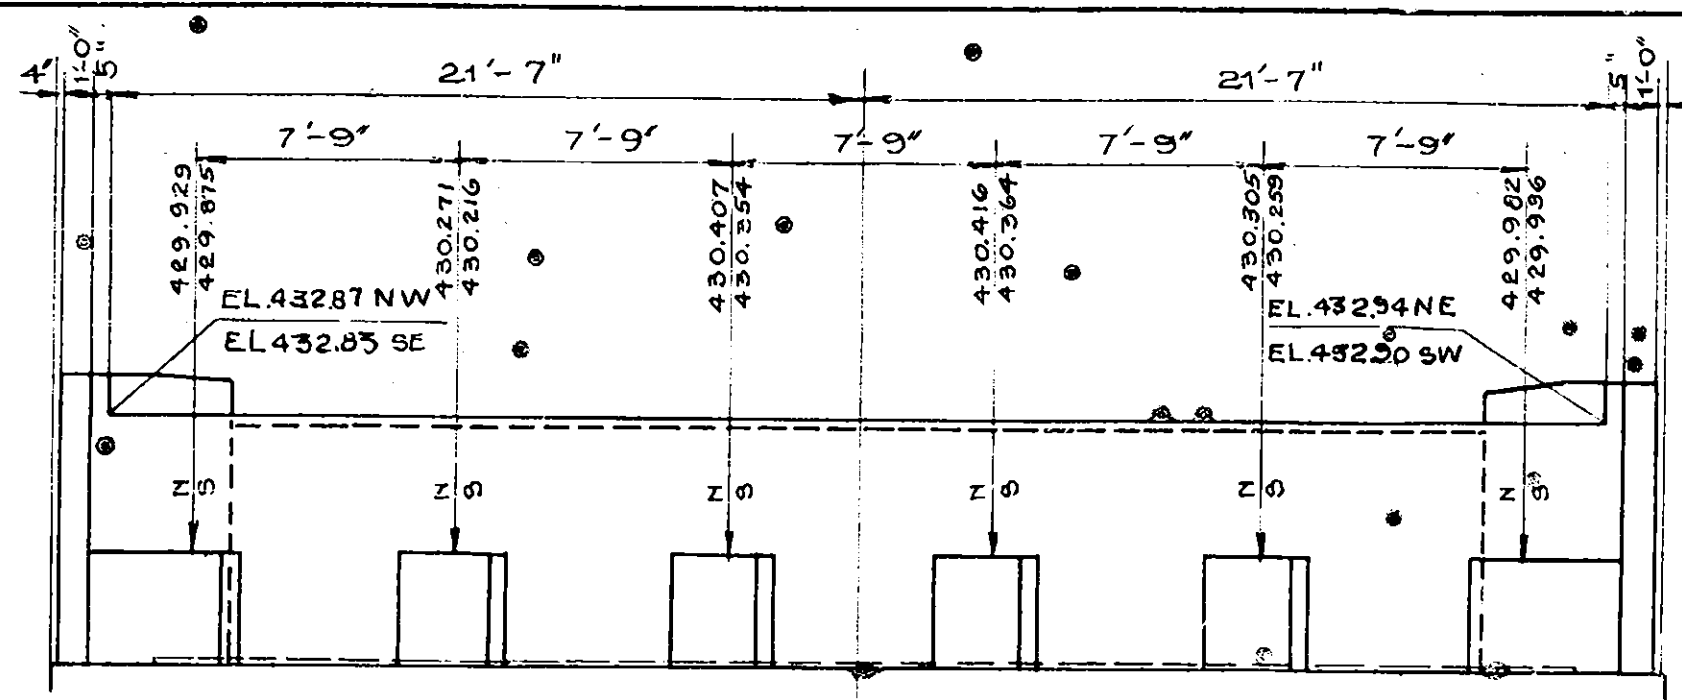


ABUTMENT ELEVATION

EL. 435.07 NE
EL. 435.02 SW

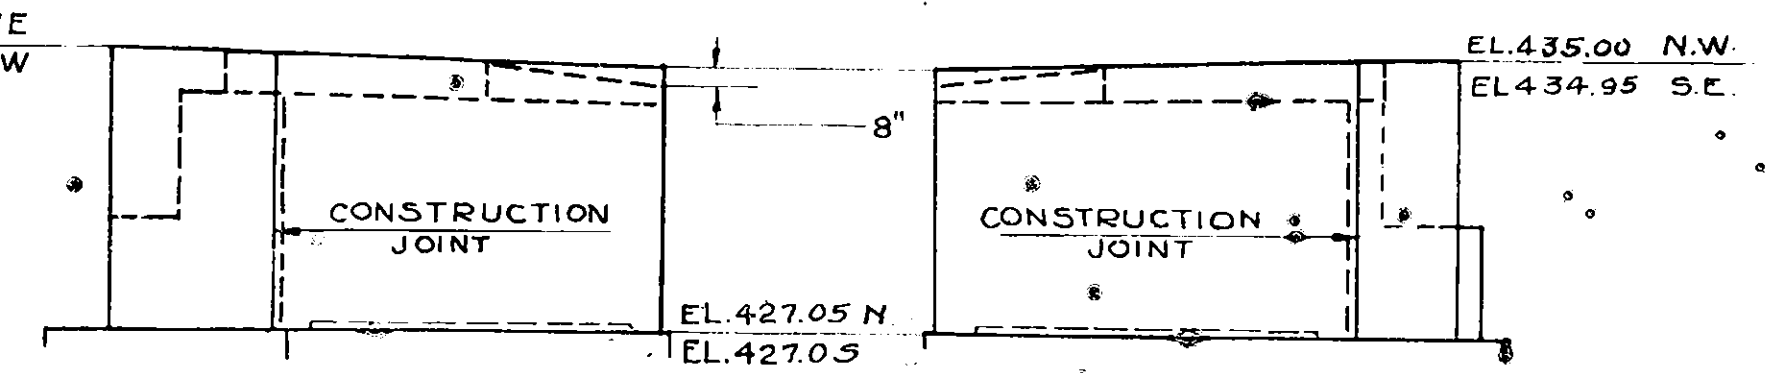


WING WALL


WING WALL

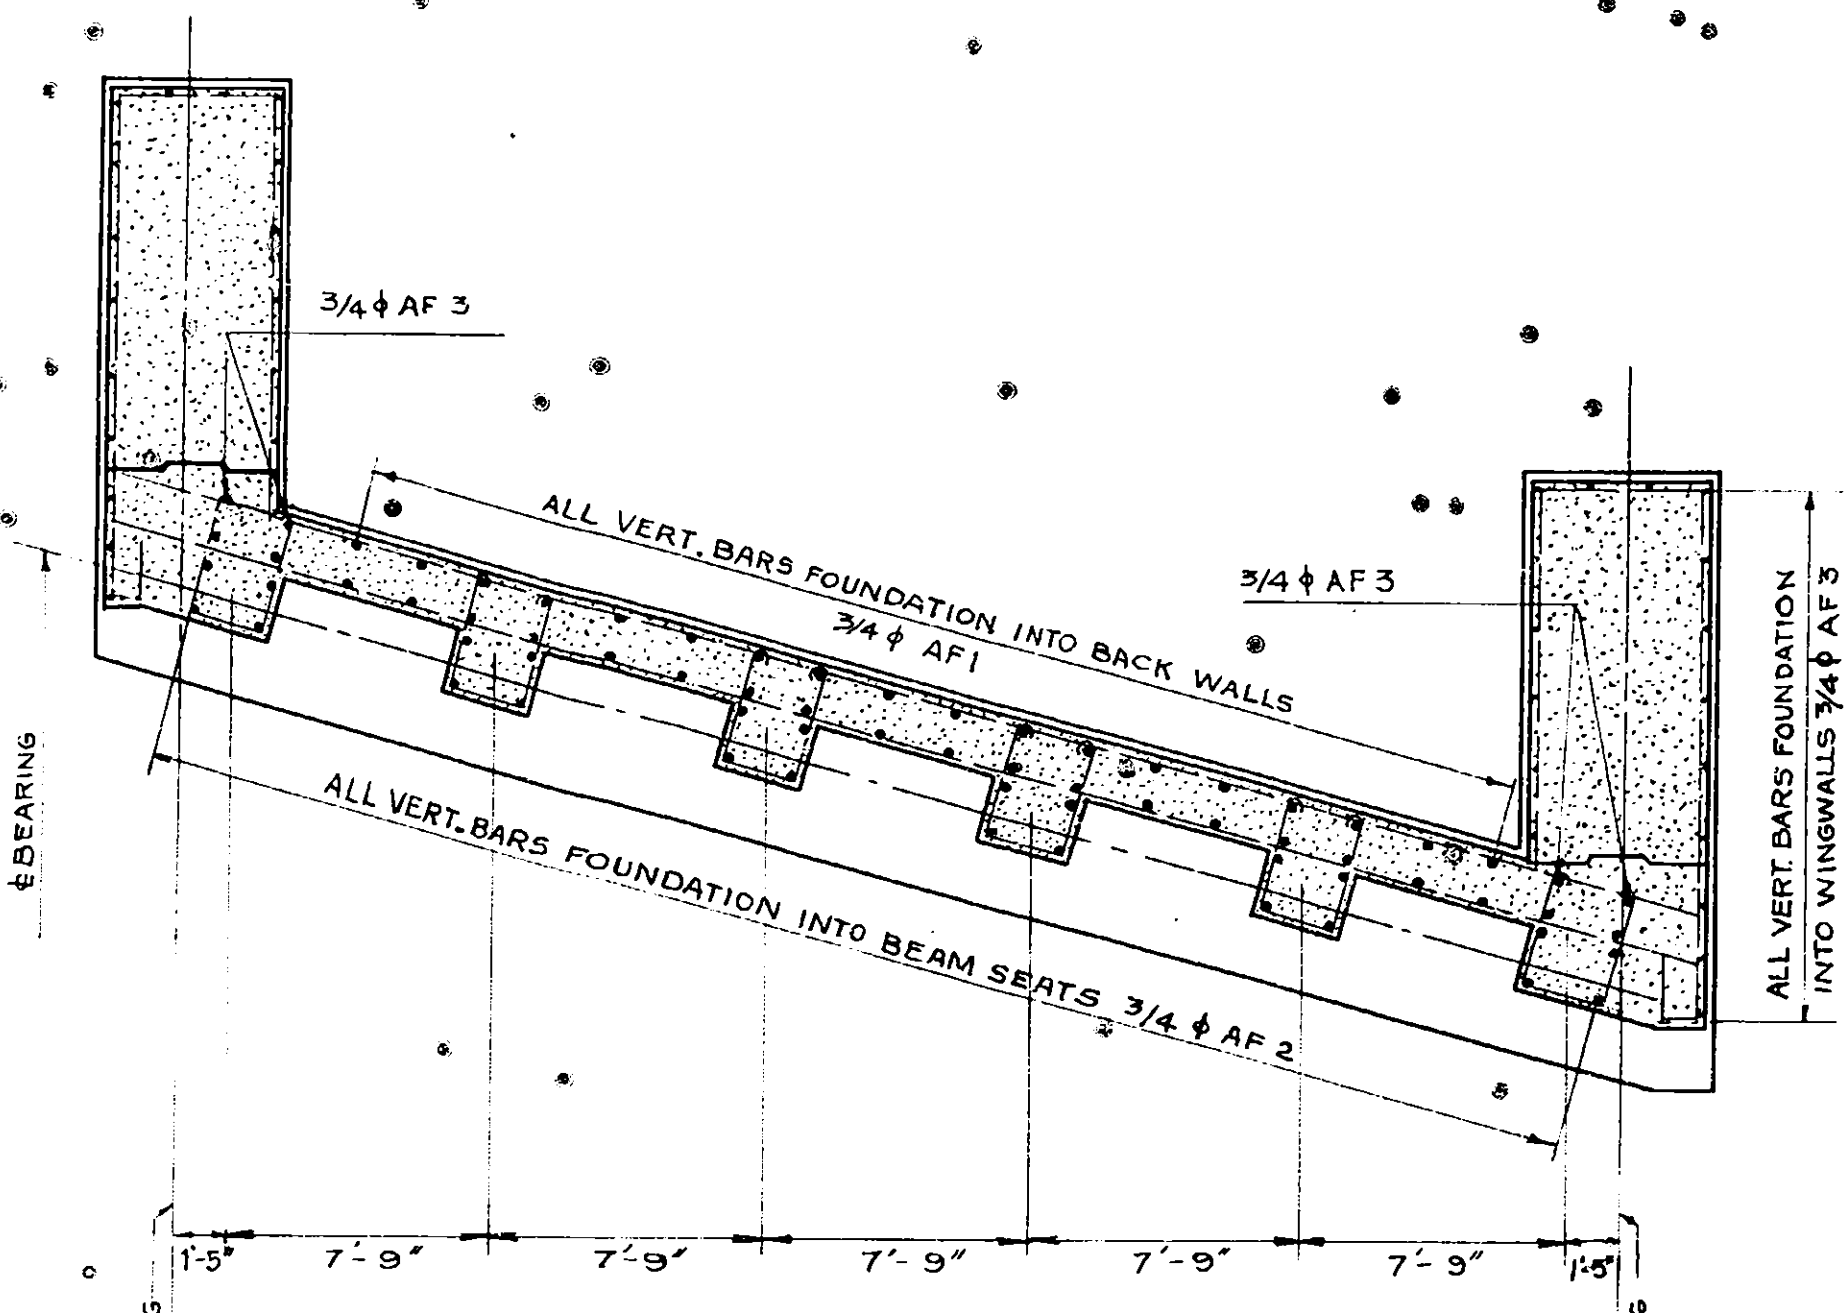


SECTIONAL PLAN UNDER BRIDGE SEAT

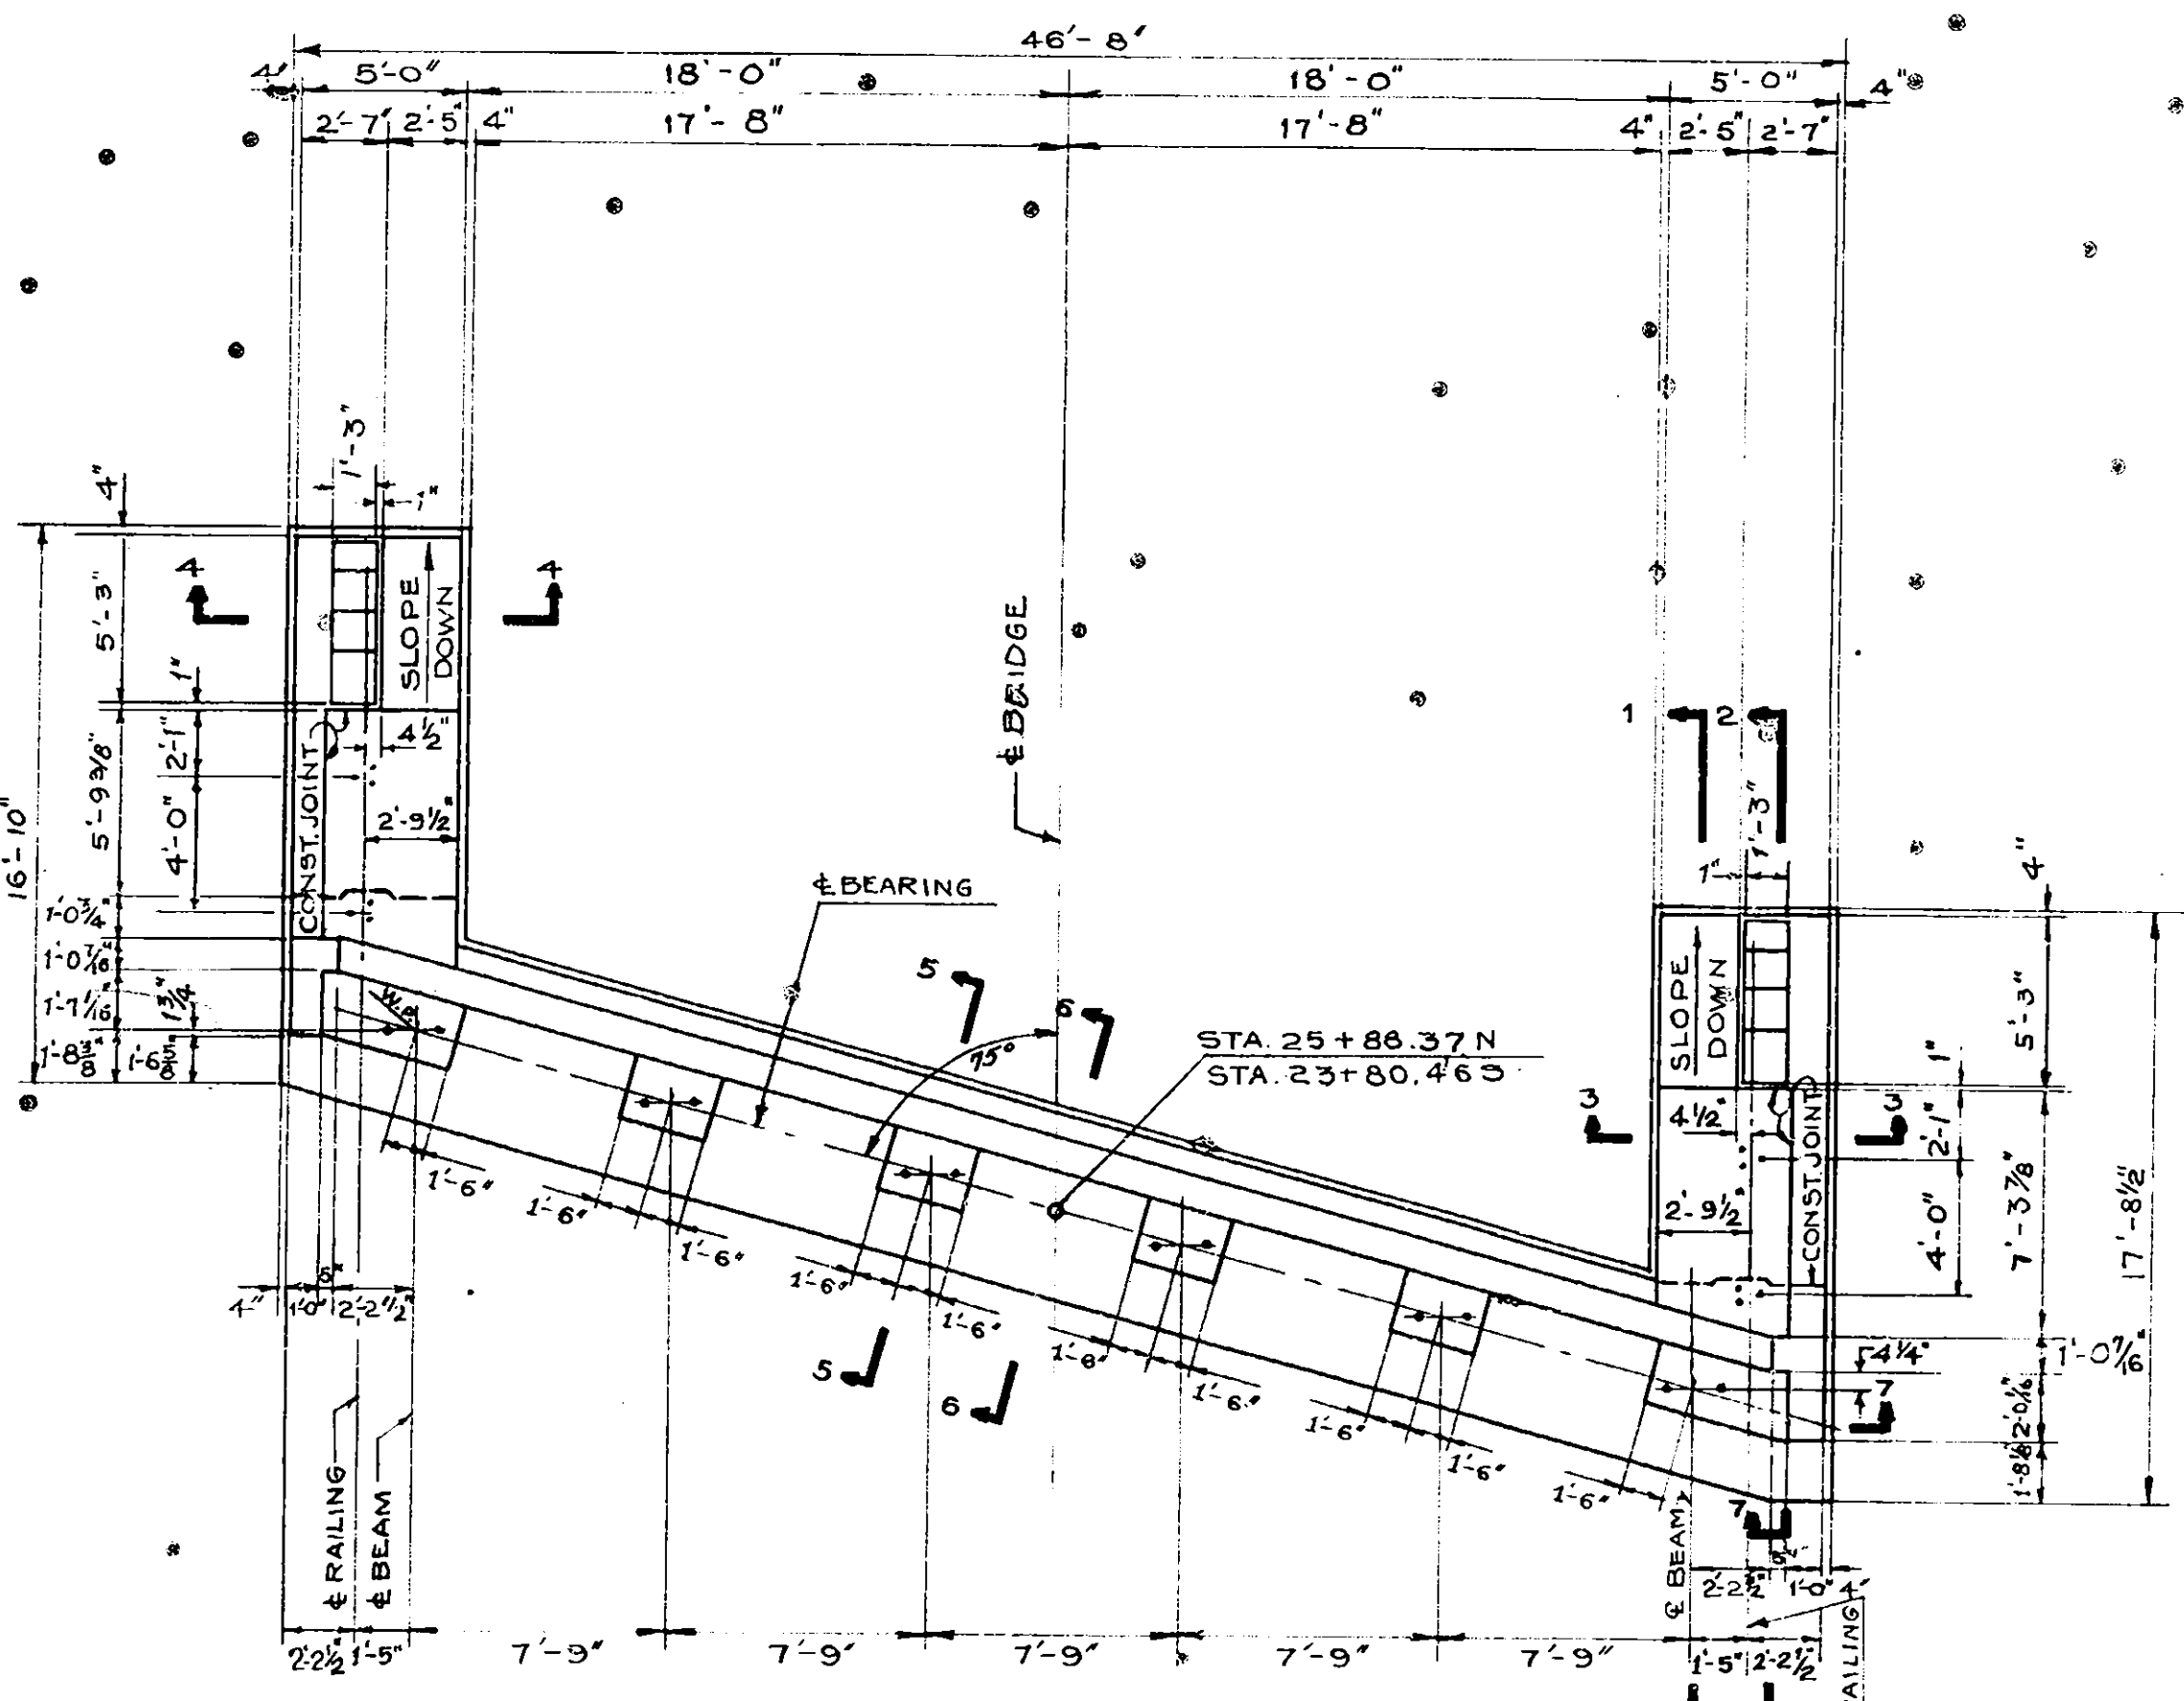

ABUTMENT PLAN

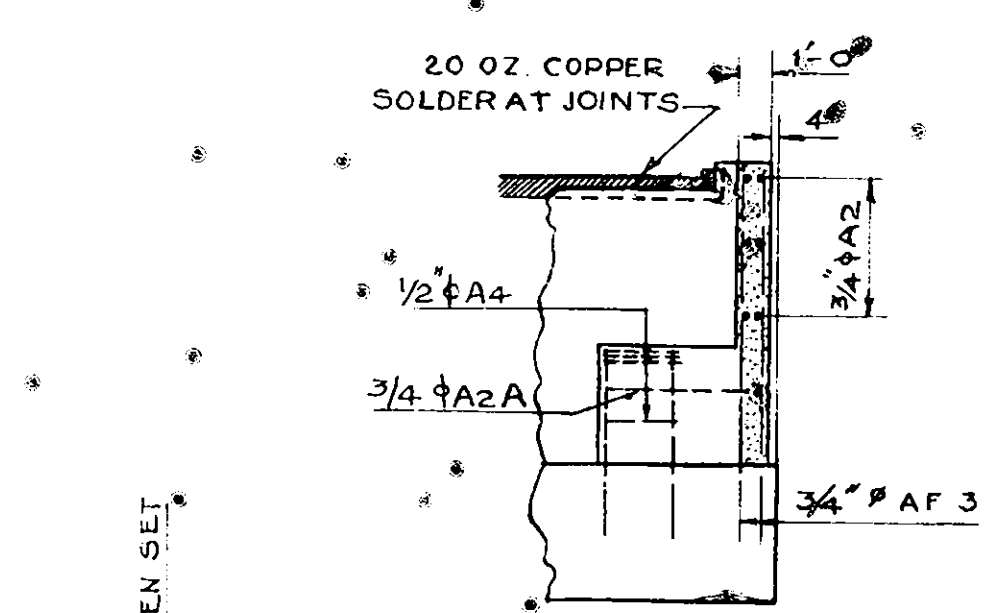


SECTION 7-7

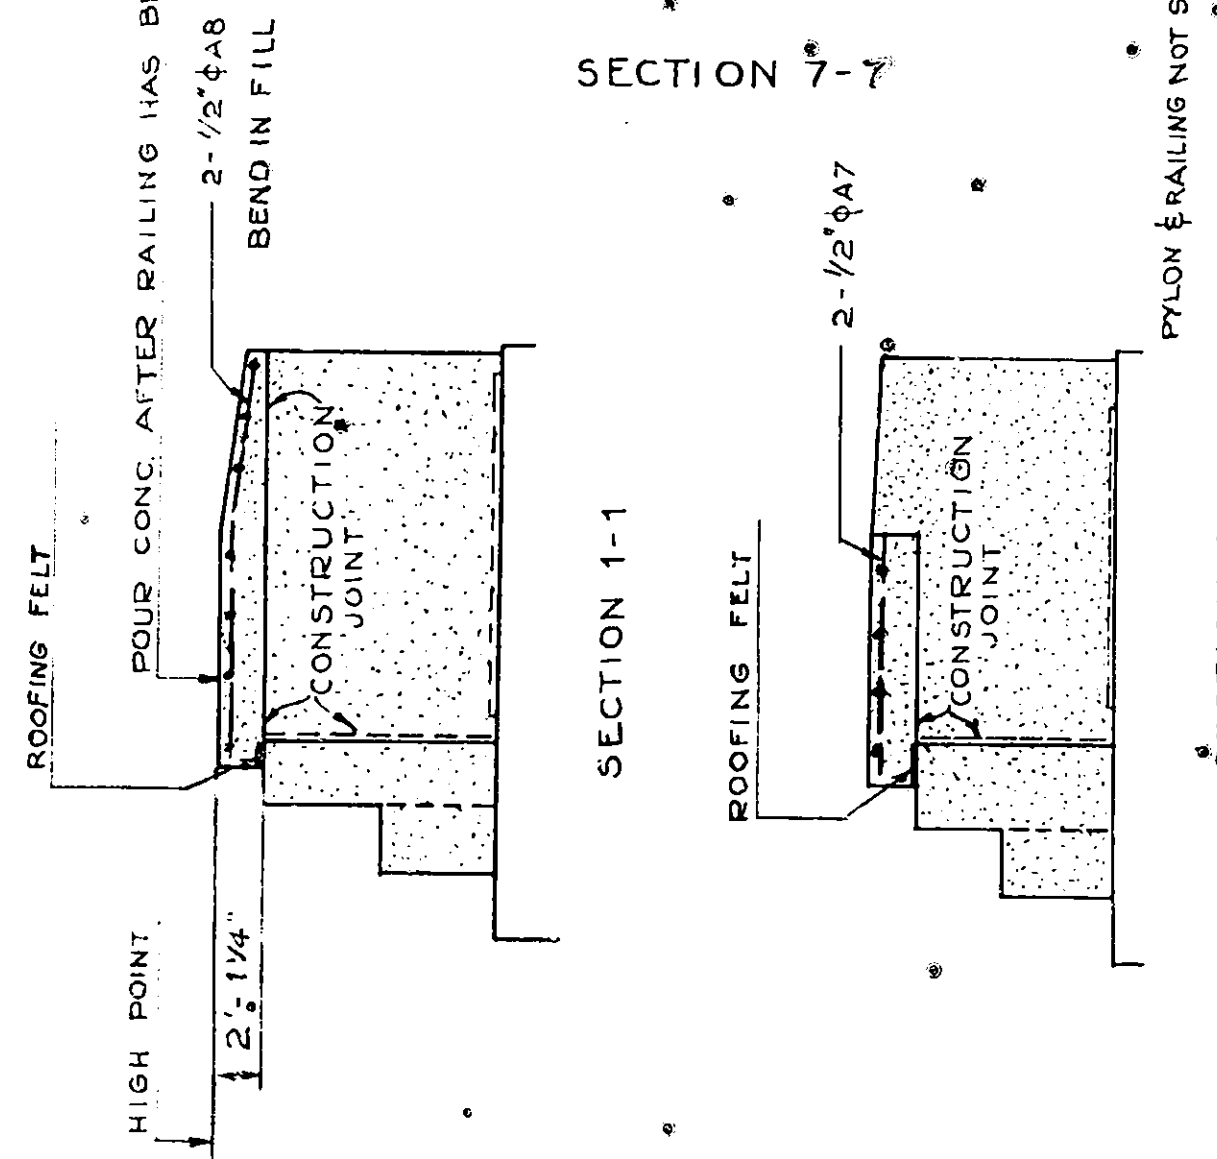


SECTION 1-1

SECTION 2-2

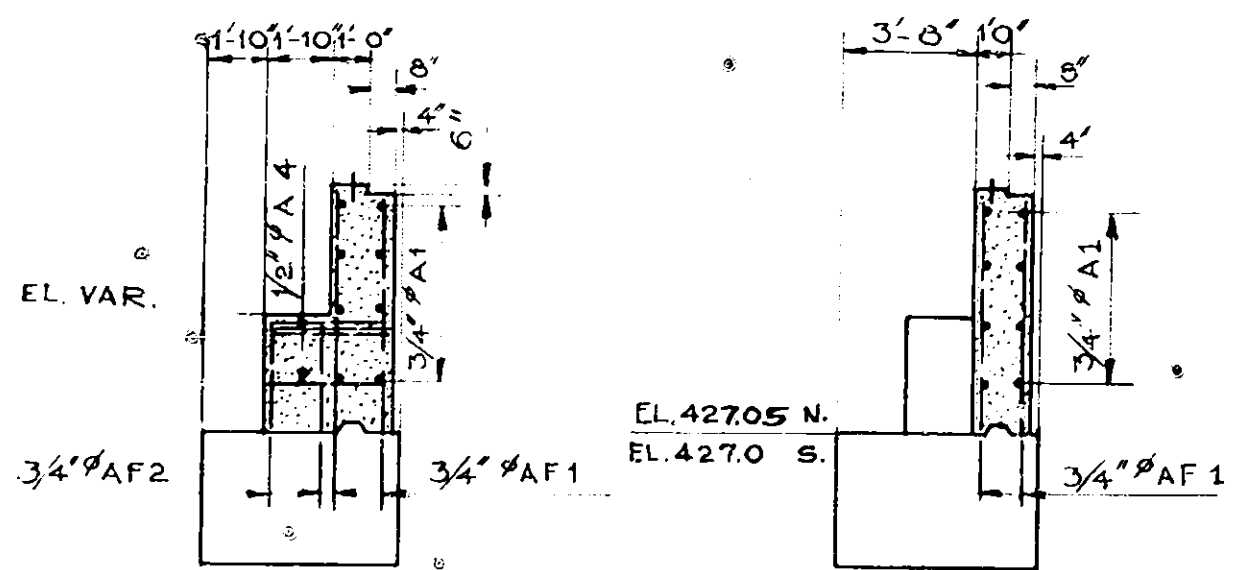

SECTION 5-5

SECTION 6-6

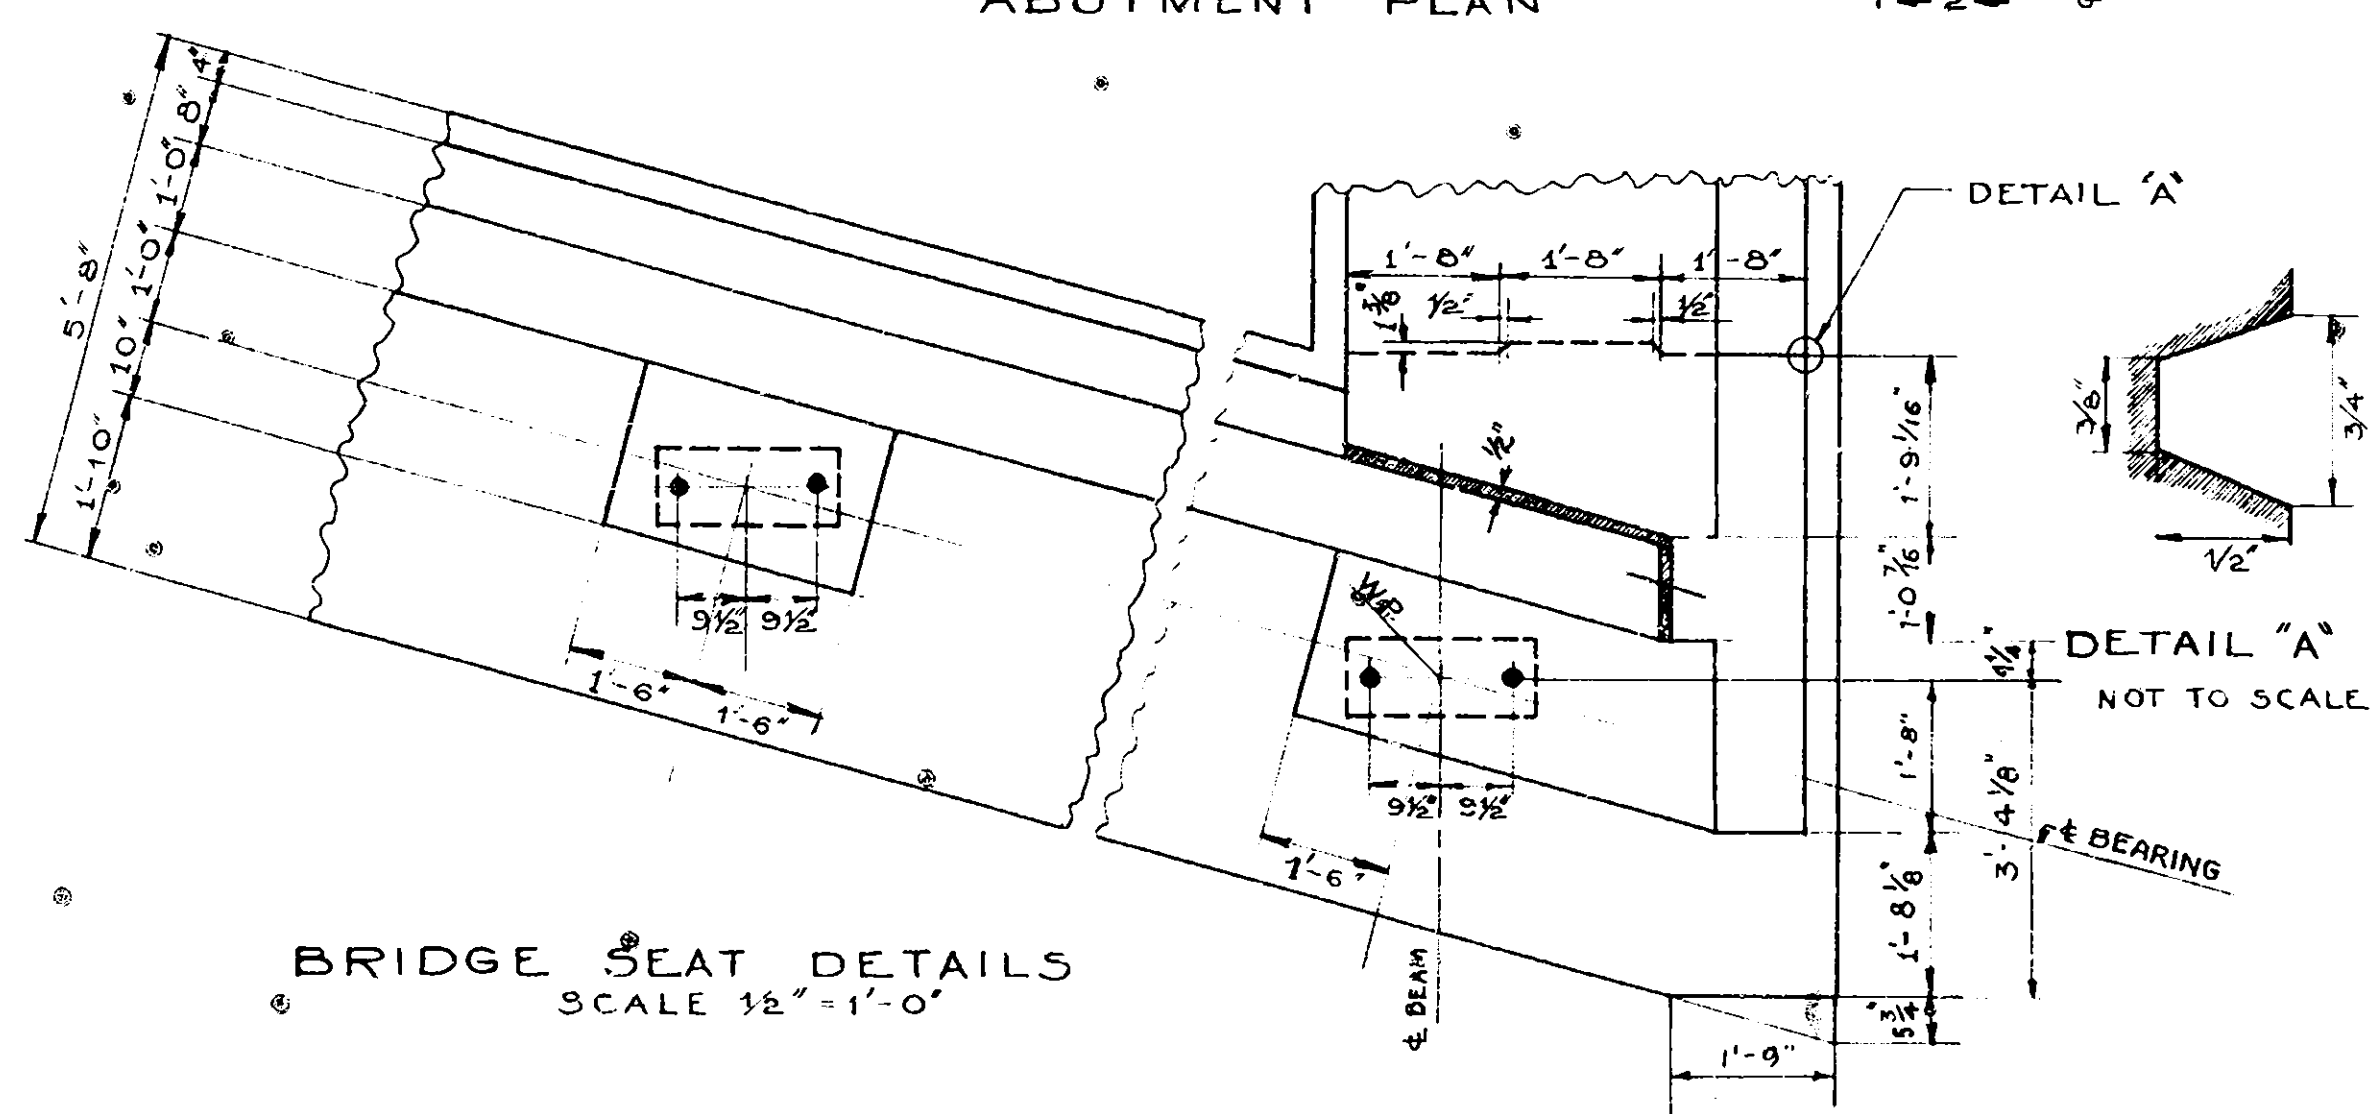

BRIDGE SEAT DETAILS
SCALE 1/2" = 1'-0"

SCALE 3/16" = 1'-0", EXCEPT AS SHOWN

CROSS REFERENCE
FOR LAYOUT OF ABUTMENTS SEE SHEET 35
FOR DETAILS OF REINFORCING BARS SEE SHEET 43
FOR DETAILS OF ANCHOR BOLTS SEE SHEET 41
FOR DETAILS OF ABUTMENT FOUNDATION SEE SHEET 35
FOR DETAILS OF RAILING SEE SHEET 41
FOR STRINGER DETAILS SEE SHEET 38

SUBSTRUCTURE DETAILS
THOMPSON ROAD
MOHAWK SECTION
NEW YORK STATE THRUWAY

PREPARED AND RECOMMENDED: *J. P. Doyle* Feb 16-53
J. P. DOYLE CONSULTING ENGINEERS
NEW YORK STATE PROFESSIONAL ENGINEERS LICENSE NO. 5667

COUNTY	SHEET NO	TOTAL SHEETS
ONONDAGA	37	66
N.Y. STATE THRUWAY, MOHAWK SECTION SUBDIV. B B INTERCHANGE AT THOMPSON ROAD		

SUBSTRUCTURE QUANTITIES				
ITEM NO.	DESCRIPTION	UNIT	NEAT	ROUNDED
5	TRENCH, CULVERT & BRIDGE EXCAVATION ^B	CY.	260	300
15-2	PORTLAND CEMENT, TYPE 2	BBL.	717	732
15-N	NATURAL CEMENT, TYPE N	BBL.	83	84
18	CLASS 1A CONCRETE FOR STRUCTURES	CY.	412	420
28	BAR REINFORCEMENT FOR STRUCTURES	LB.	45,000	47,000
85-C	CAST IN PLACE CONCRETE PILES	L.F.	3490	3600
87	FURNISHING EQUIPMENT FOR DRIVING PILES	L.S.	NEC	NEC
92S	SCREENED GRAVEL - LOOSE MEASURE	CY.	145	158
121	TOP SOIL PLACED FROM STOCK PILES	CY.	360	380
123	SEEDING	ACRE	.35	.4
124	SODDING	SY.	400	420
119	RUN OF BANK GRAVEL FILL	CY.	185	190

SUBSTRUCTURE GENERAL NOTES

CONSTRUCTION JOINTS SHALL BE PLACED ONLY AS AND WHERE SHOWN ON THE PLANS, EXCEPT WHERE PERMISSION IN WRITING IS GIVEN BY THE DEPUTY CHIEF ENGINEER (BRIDGES), IN WHICH CASE, HIS SUPPLEMENTAL INSTRUCTIONS SHALL BE STRICTLY FOLLOWED.





AFTER THE CONCRETE IS CURED, THE CONTRACTOR SHALL APPLY A WATER-PROOFING OIL TREATMENT, AS DESCRIBED IN THE SPECIFICATIONS FOR M-41W TO ALL EXPOSED SURFACES.

ALL SHOE BEARING SURFACES SHALL BE CAST 1/4" ABOVE ELEVATIONS SHOWN ON THE PLANS, AND AFTER THE CONCRETE IS CURED, SHALL BE BUSH-HAMMERED TO THE REQUIRED ELEVATIONS.

THE CONTRACTOR'S ATTENTION IS DIRECTED TO THE SPECIAL NOTES FOR THIS STRUCTURE WHICH APPEAR IN THE PROPOSAL. PARTICULAR ATTENTION SHOULD BE GIVEN TO THE FOUNDATION NOTE WHICH BRIEFLY OUTLINES THE ANTICIPATED SUBSURFACE CONDITIONS AT THE SITE OF THE STRUCTURE, AND WHICH SPECIFIES CERTAIN REQUIREMENTS RELATIVE TO THE CONSTRUCTION.

SUBSTRUCTURE DETAILS

THOMPSON ROAD
MOHAWK SECTION
NEW YORK STATE THRUWAY

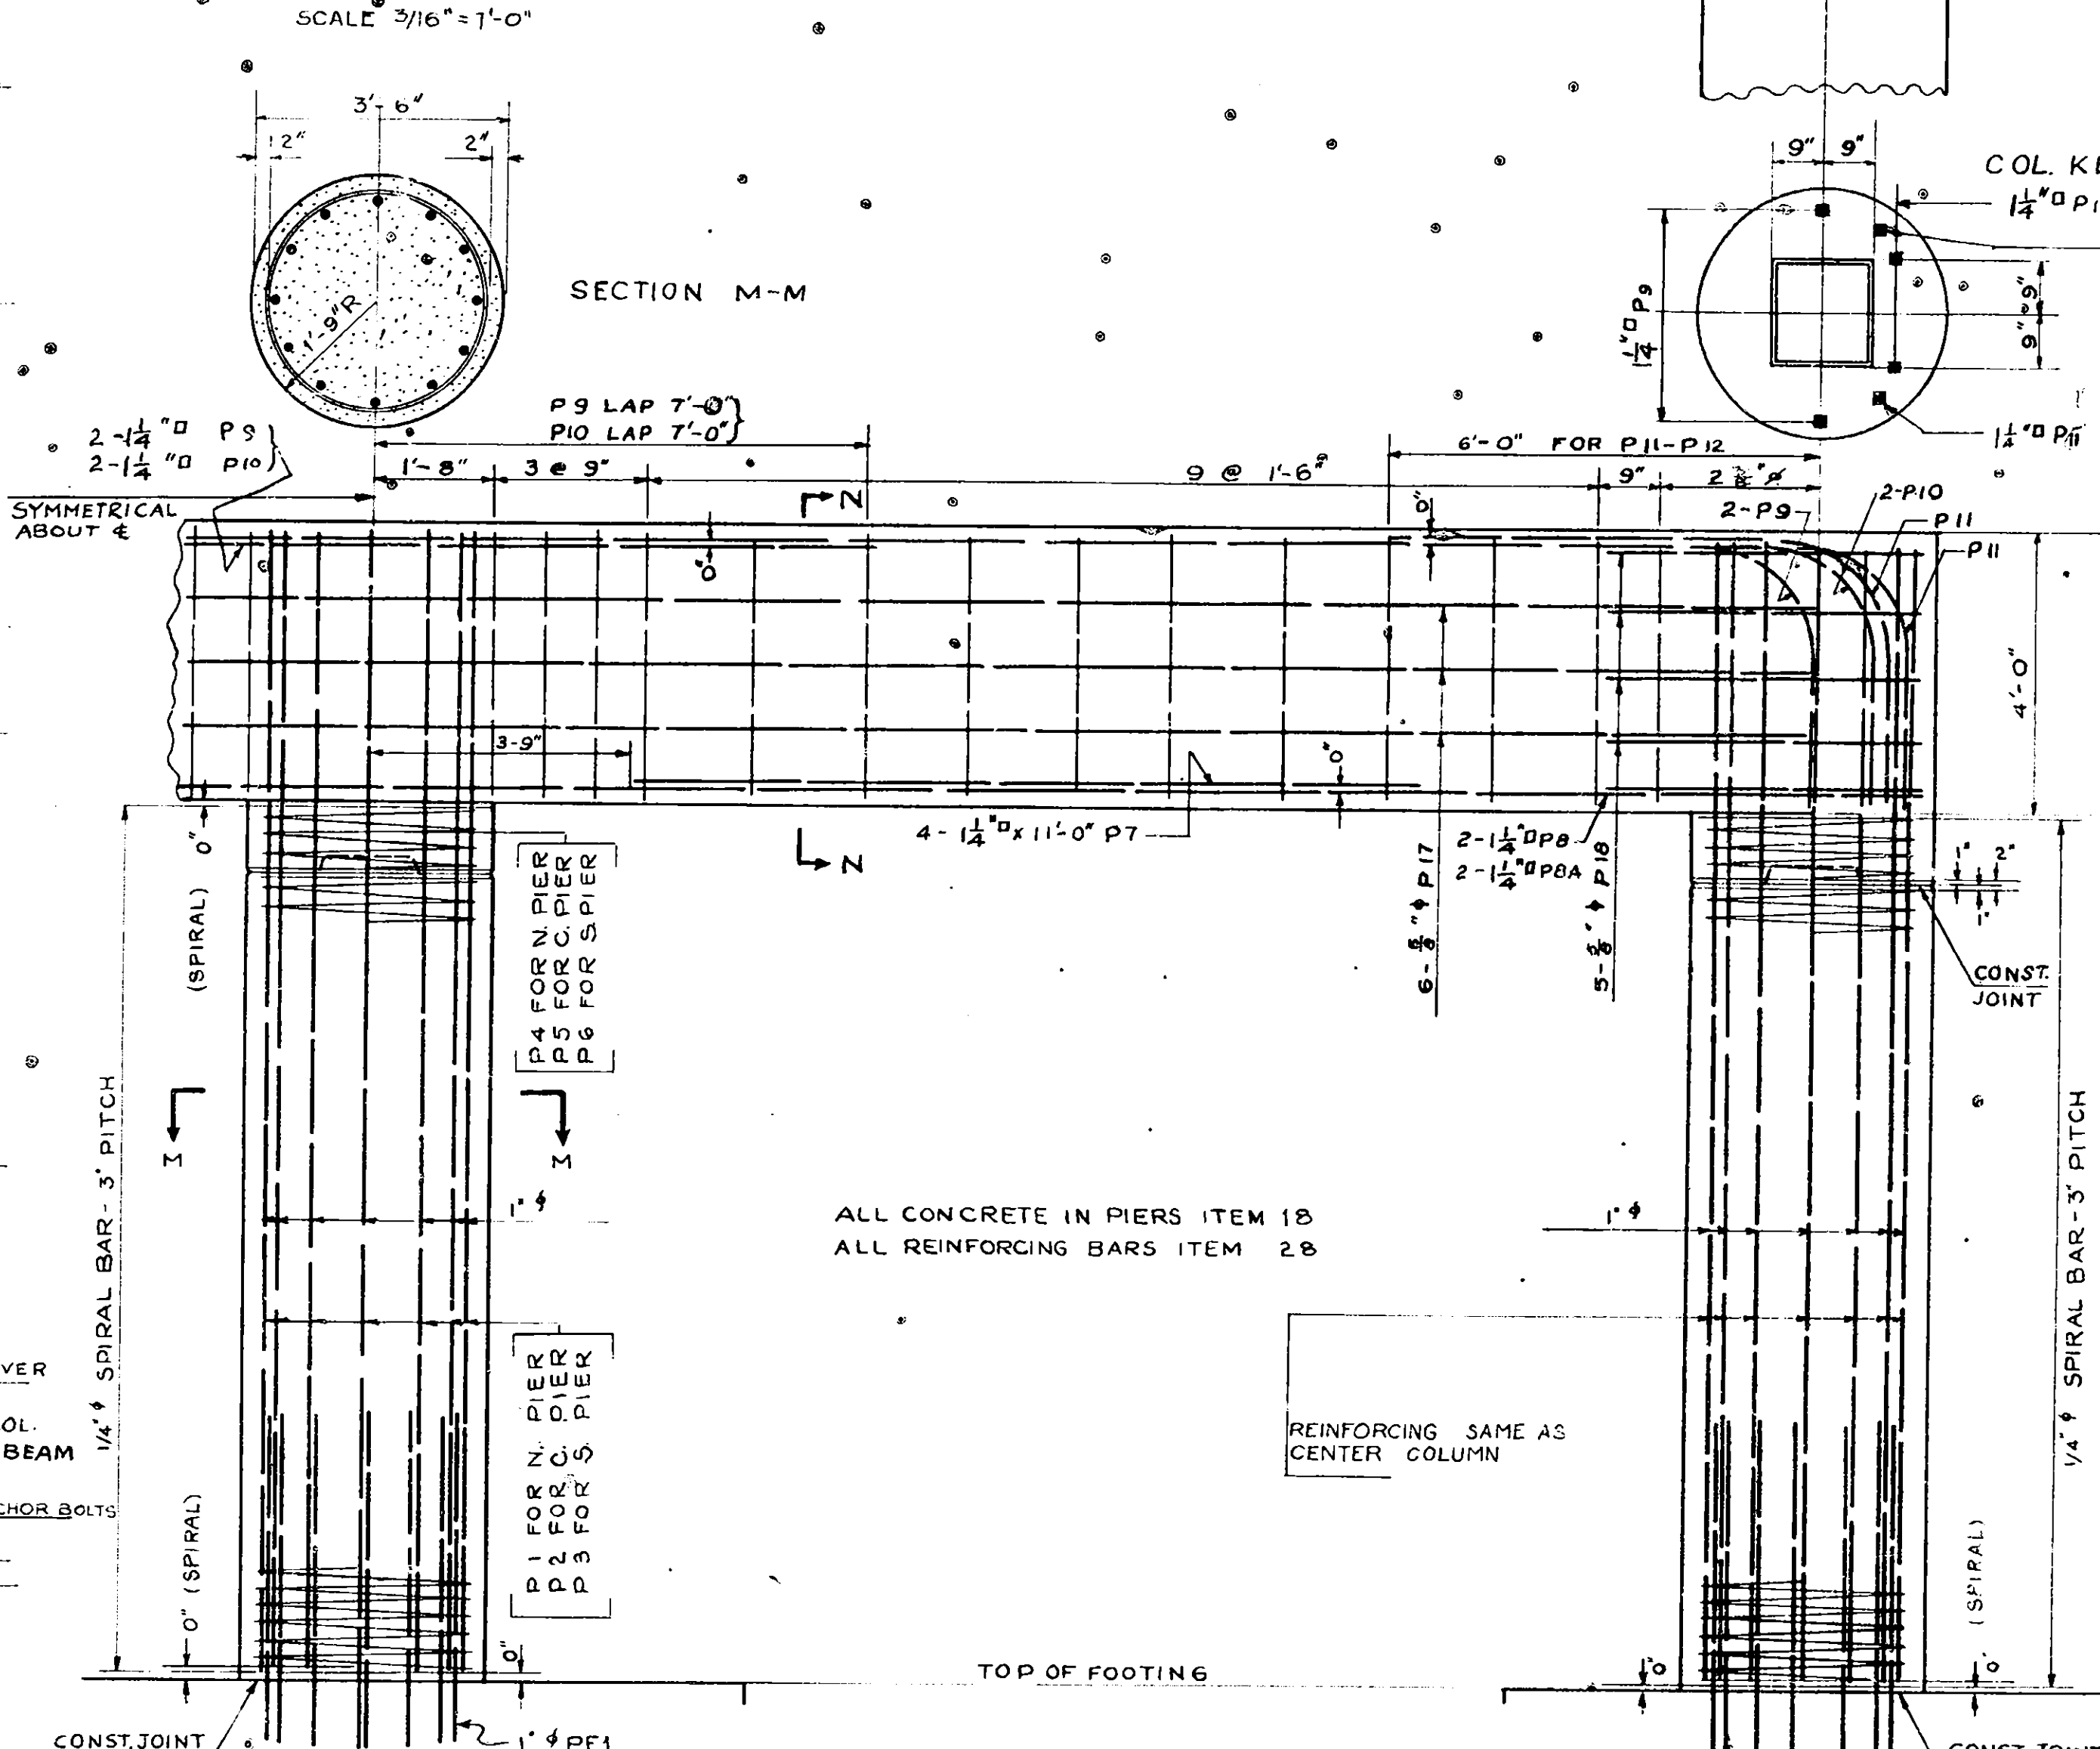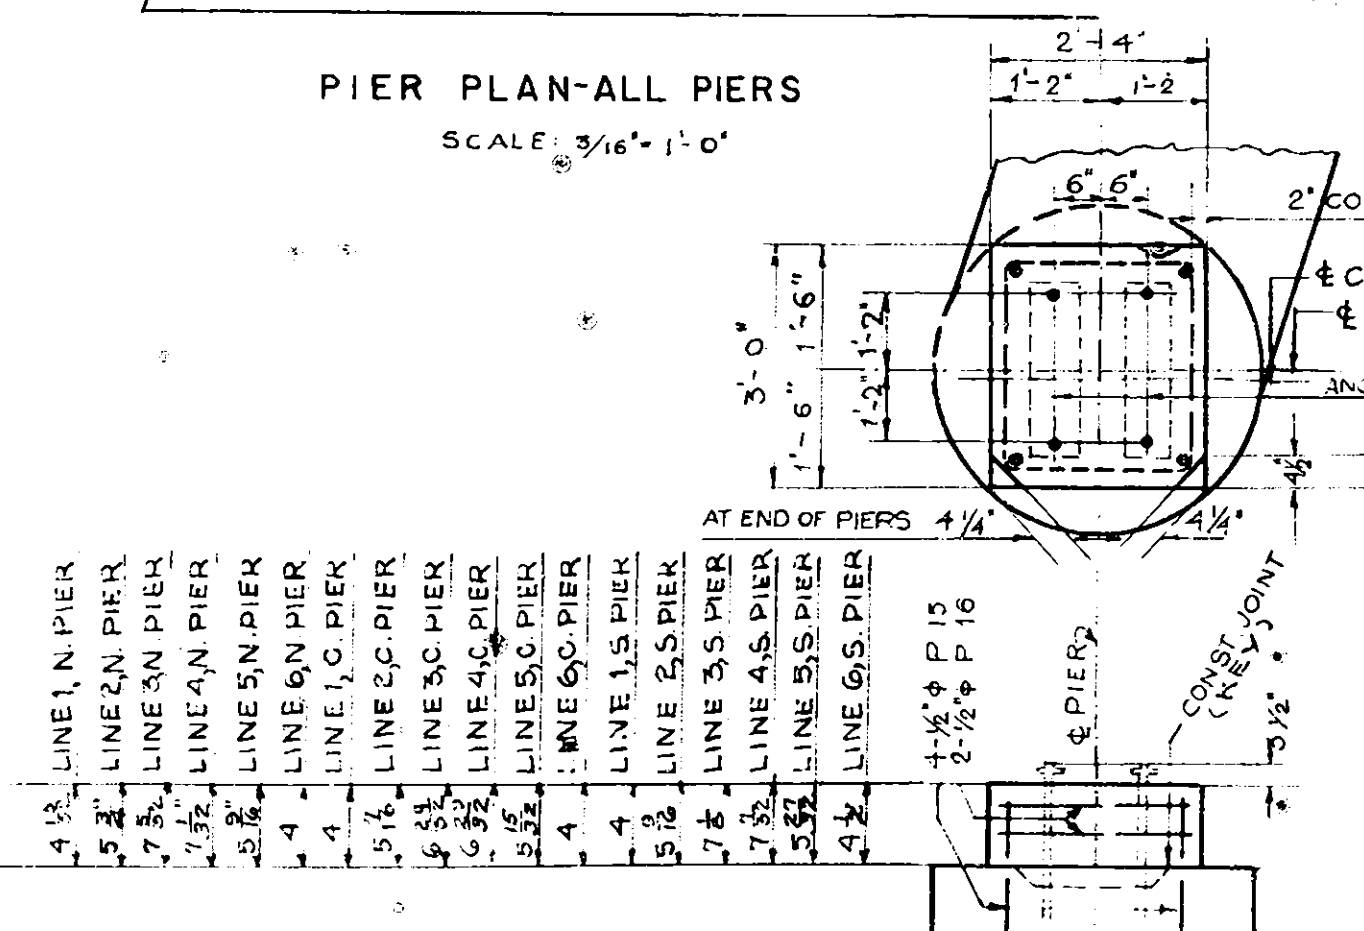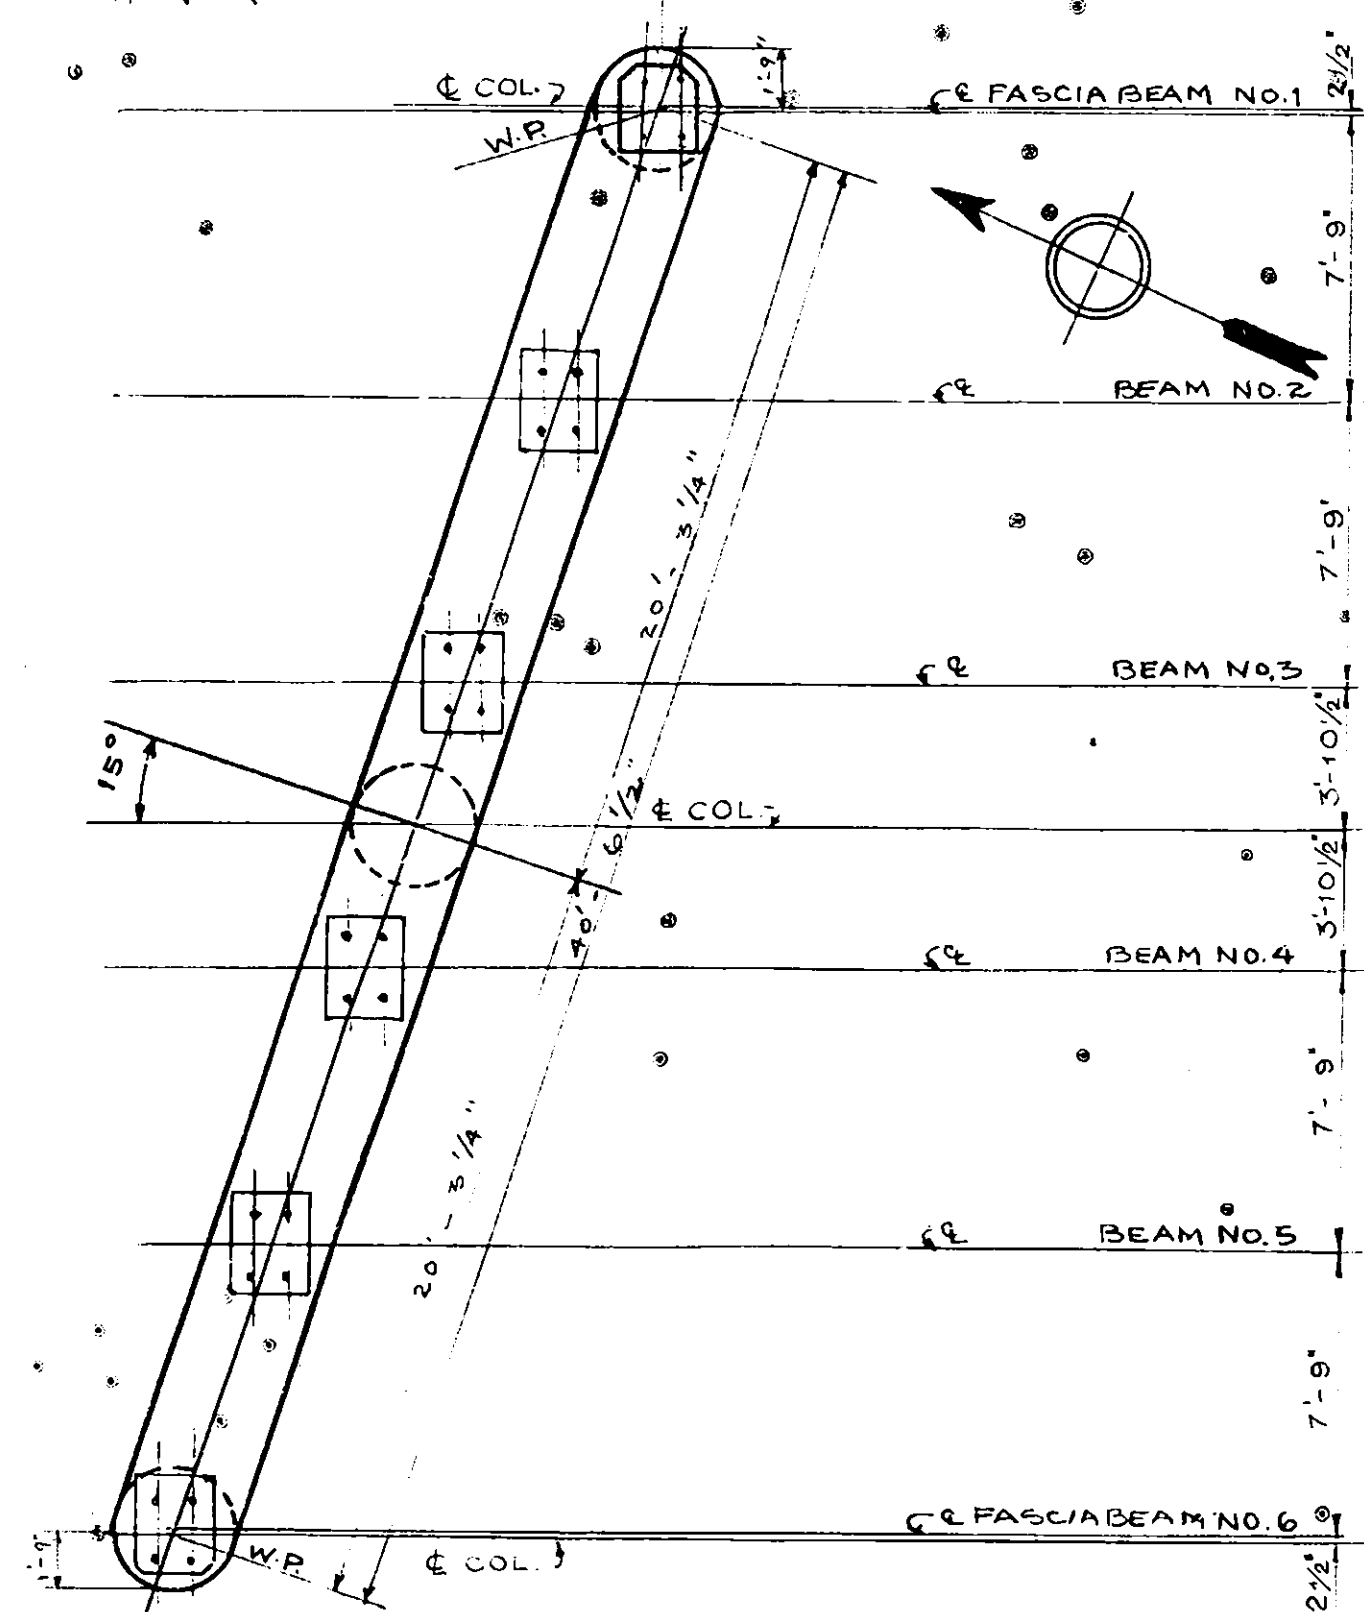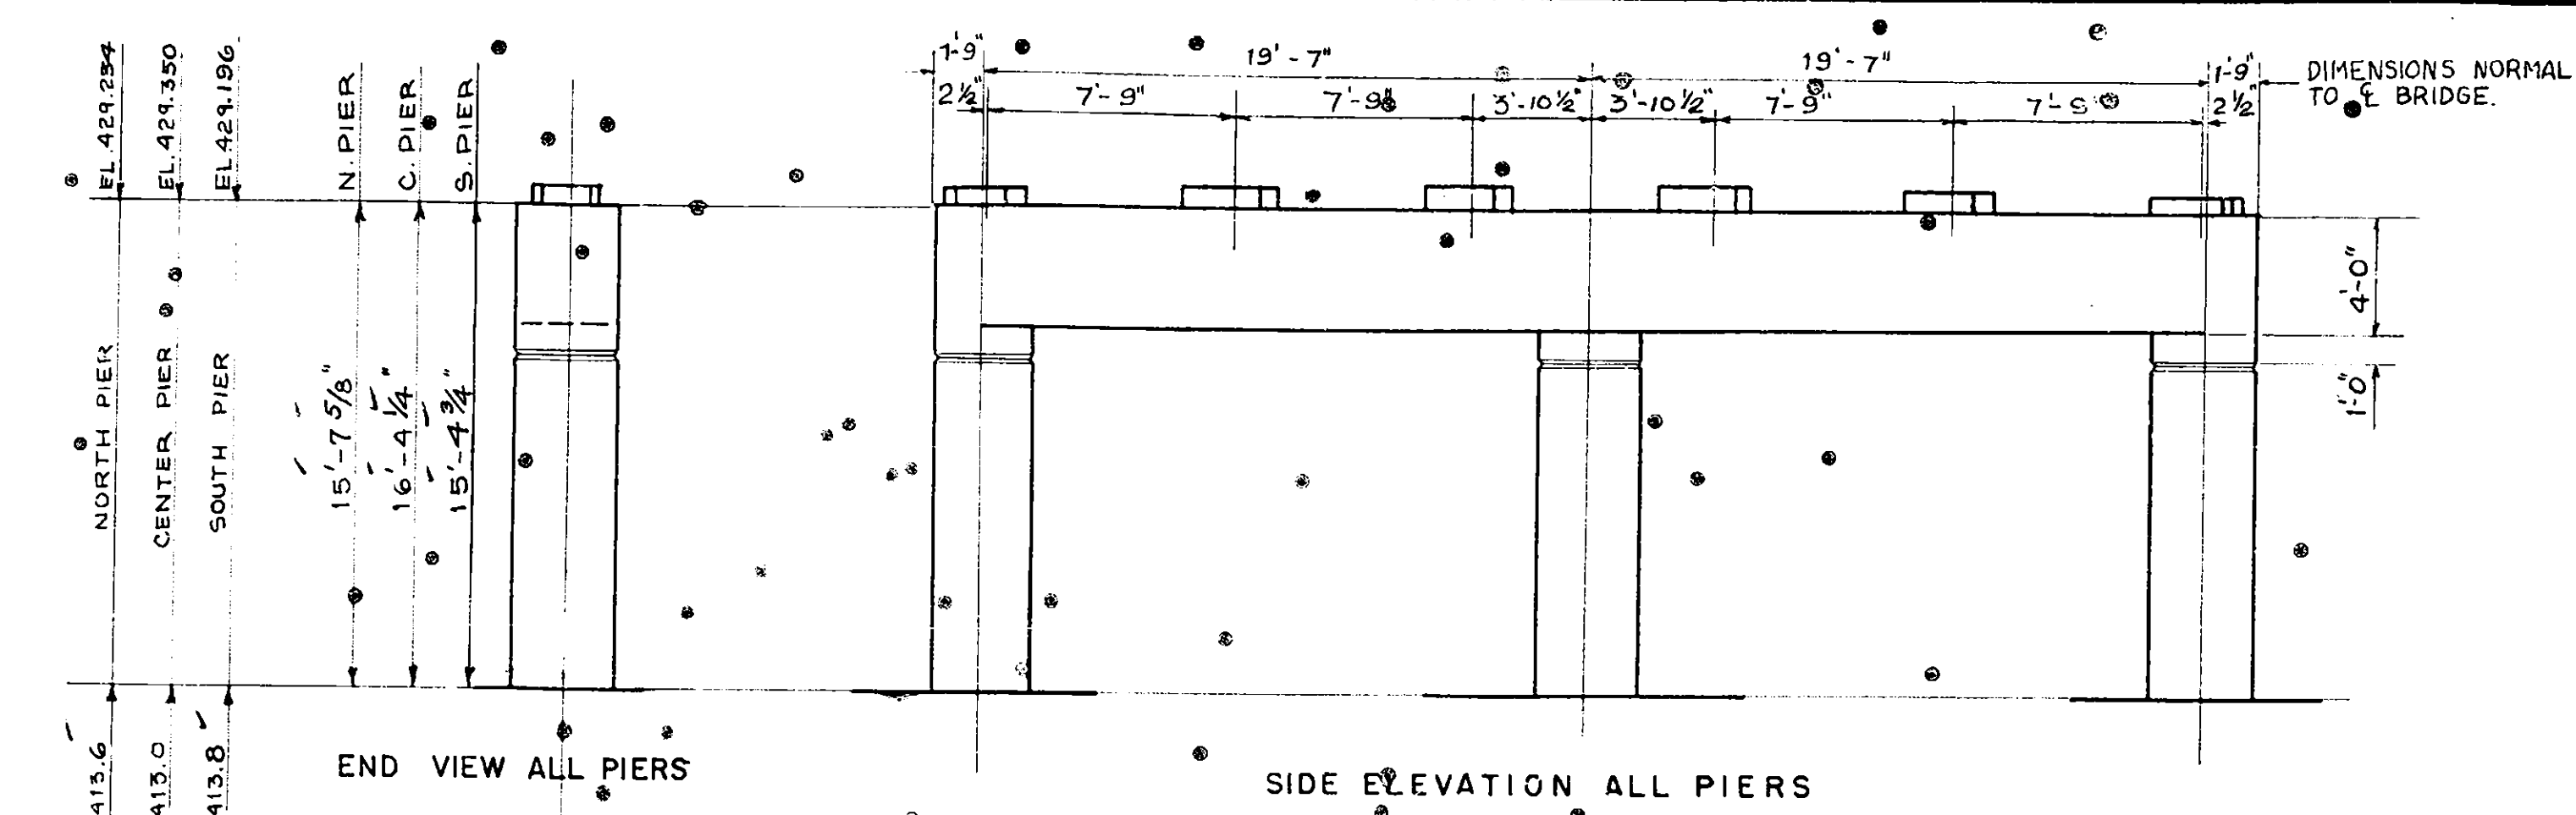

PIER DETAILS - ALL PIERS SCALE 1/2" = 1'-0"

CROSS REFERENCE

FOR LAYOUT OF PIERS SEE SHEET 35
FOR DETAILS OF REINFORCING BARS SEE SHEET 43
FOR DETAILS OF PIER FOUNDATION SEE SHEET 35
FOR DETAILS OF ANCHOR BOLTS SEE SHEET 41

NOTE - FOR LOCATION OF IDENTIFICATION PLATE, SEE STANDARD SHEET 53-41.

PREPARED AND RECOMMENDED:




URQUHART & DOYLE, CONSULTING ENGINEERS
NEW YORK STATE PROFESSIONAL ENGINEERS LICENSE NO. 5667

DATE

COUNTY	SHEET NO	TOTAL SHEETS
ONONDAGA	37	66
N.Y. STATE THRUWAY, MOHAWK SECTION SUBDIV. B.D.		
INTERCHANGE AT THOMPSON ROAD		

37R

SUBSTRUCTURE QUANTITIES				
ITEM NO.	DESCRIPTION	UNIT	NEAT	ROUNDED
5	TRENCH, CULVERT & BRIDGE EXCAVATION	CY.	260	300
13-2	PORTLAND CEMENT, TYPE 2	BBL.	717	732
15-N	NATURAL CEMENT, TYPE N	BBL.	83	84
18	CLASS 1A CONCRETE FOR STRUCTURES	CY.	412	420
28	BAR REINFORCEMENT FOR STRUCTURES	LB.	45,000	47,000
85-C	CAST IN PLACE CONCRETE PILES	L.F.	3,430	3,600
87	FURNISHING EQUIPMENT FOR DRIVING PILES	L.S.	NEC	NEC
88-S	SCREENED GRAVEL - LOOSE MEASURE	CY.	45	55
121	TOP SOIL PLACED FROM STOCK PILES	CY.	360	380
123	SEEDING	ACRE.	.35	.4
124	SODDING	SQ.	400	420
119	RUN OF BANK GRAVEL FILL	CY.	185	190

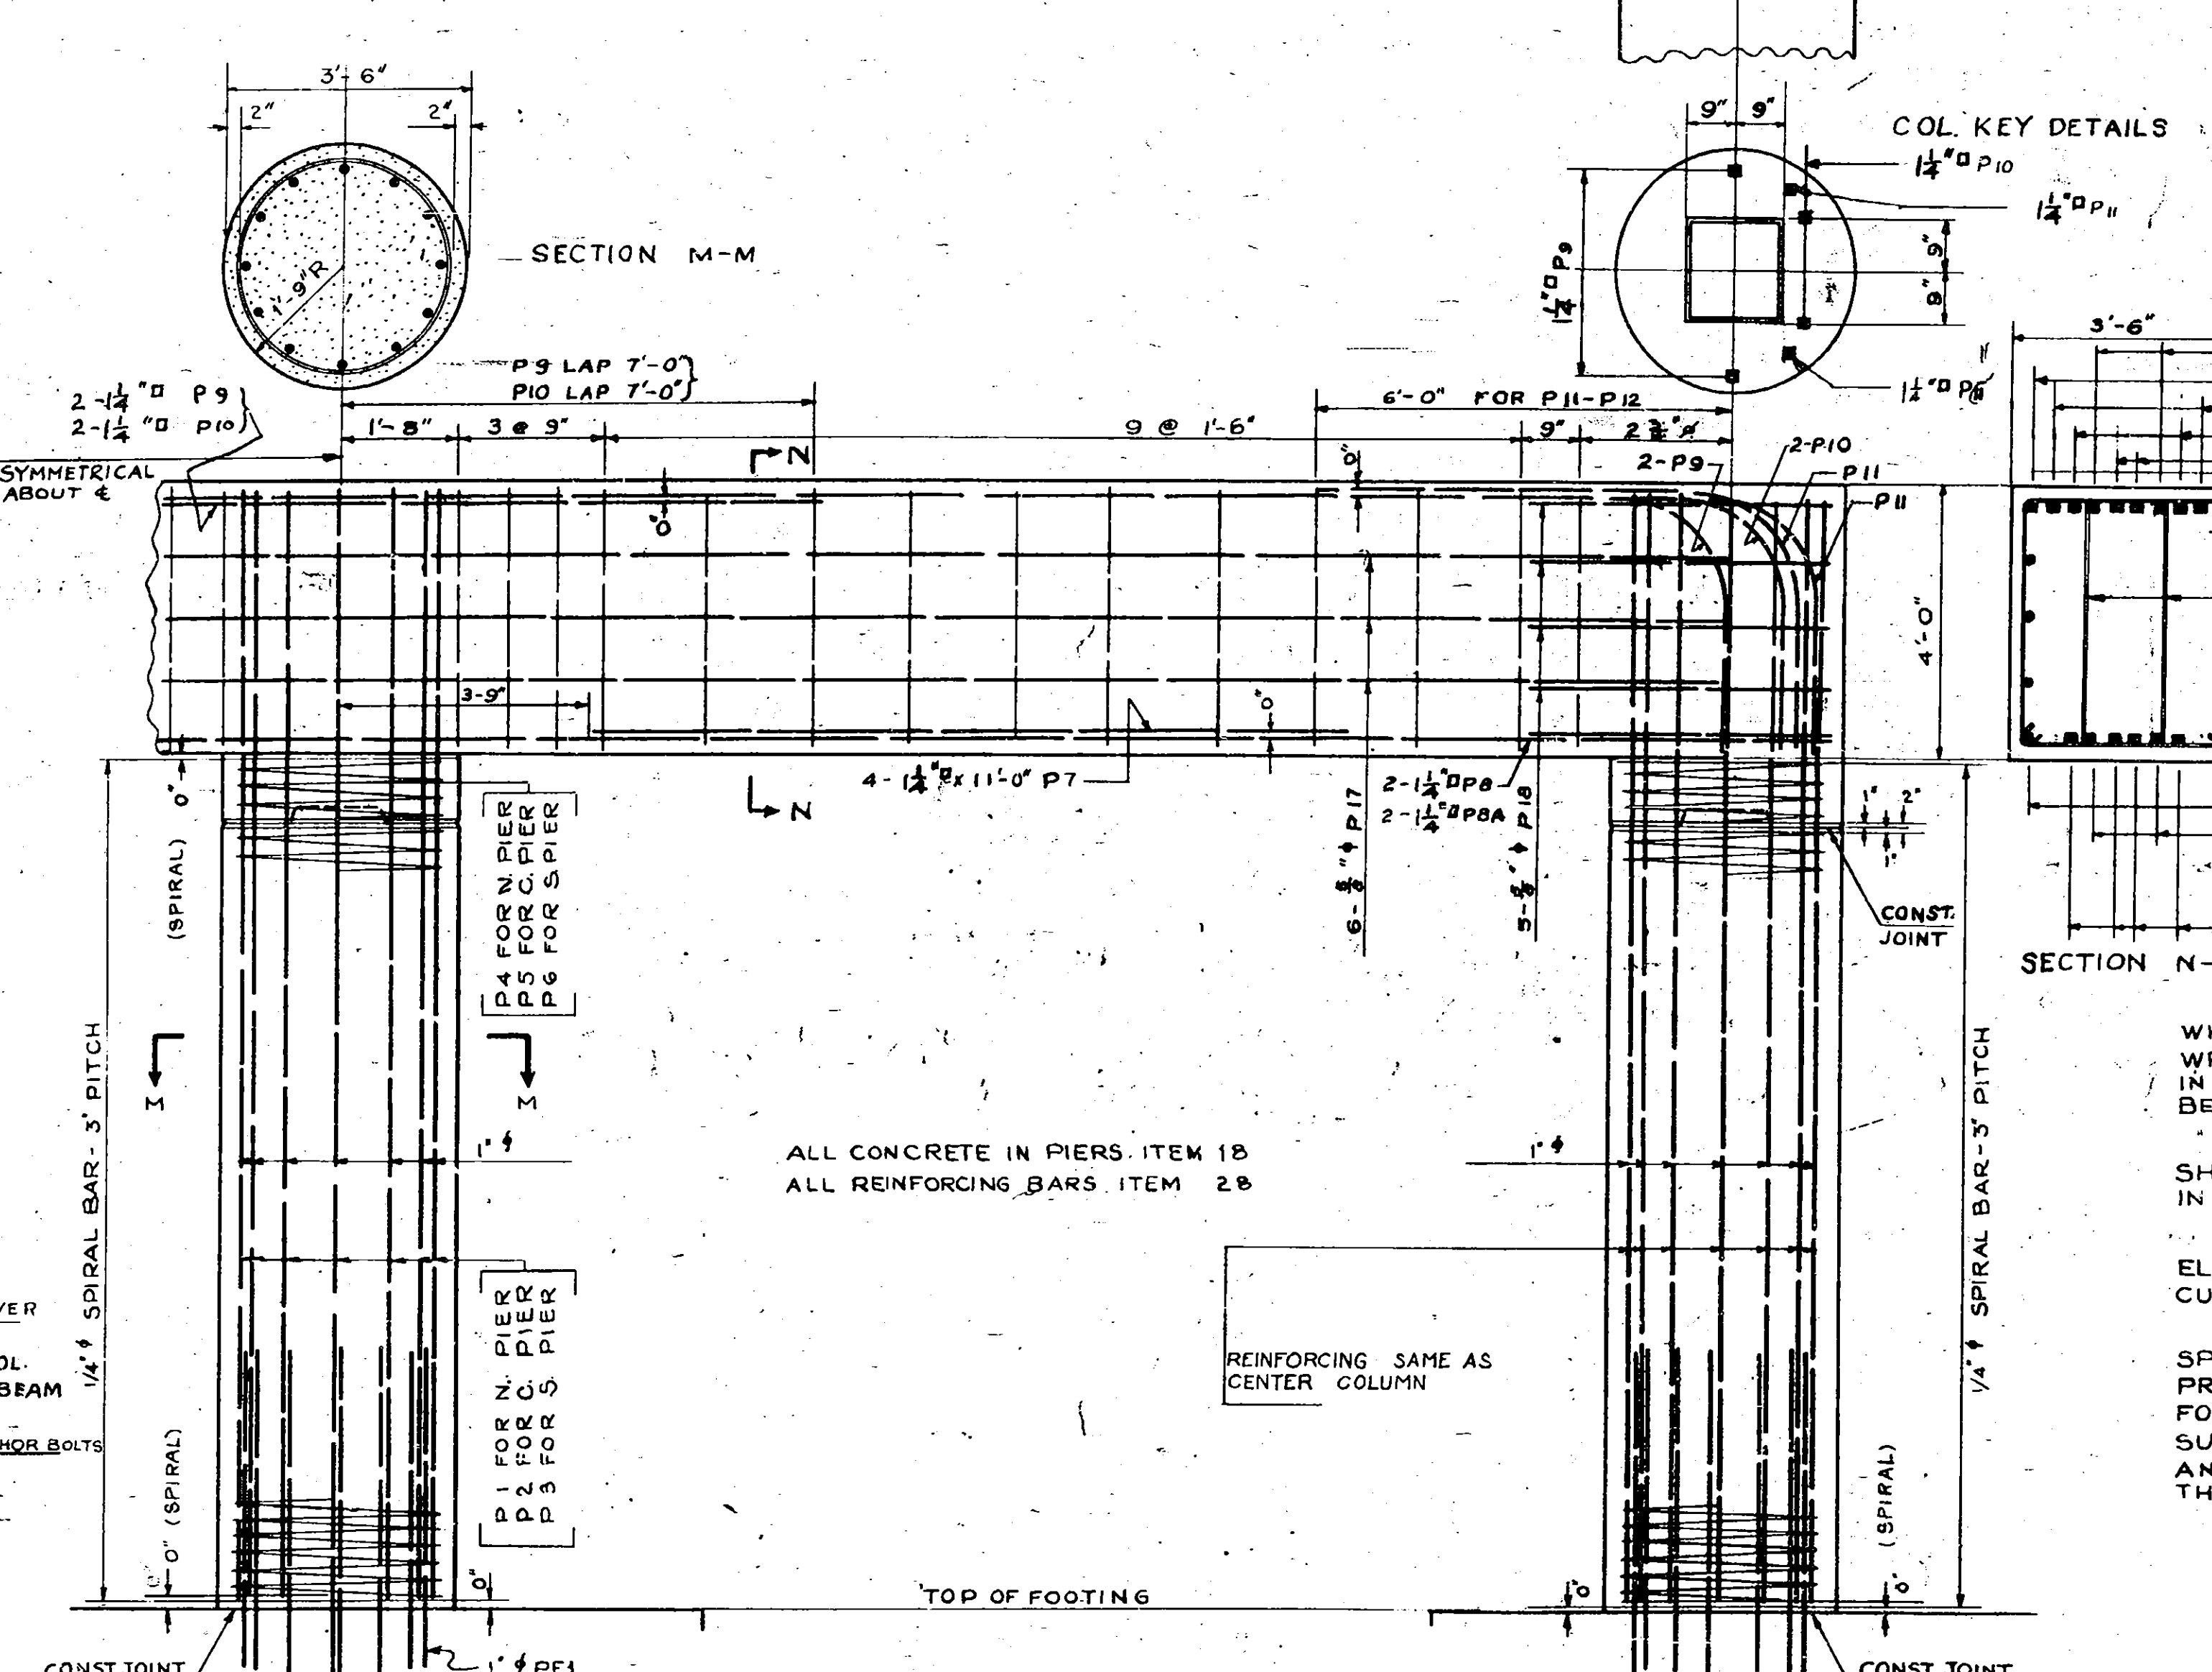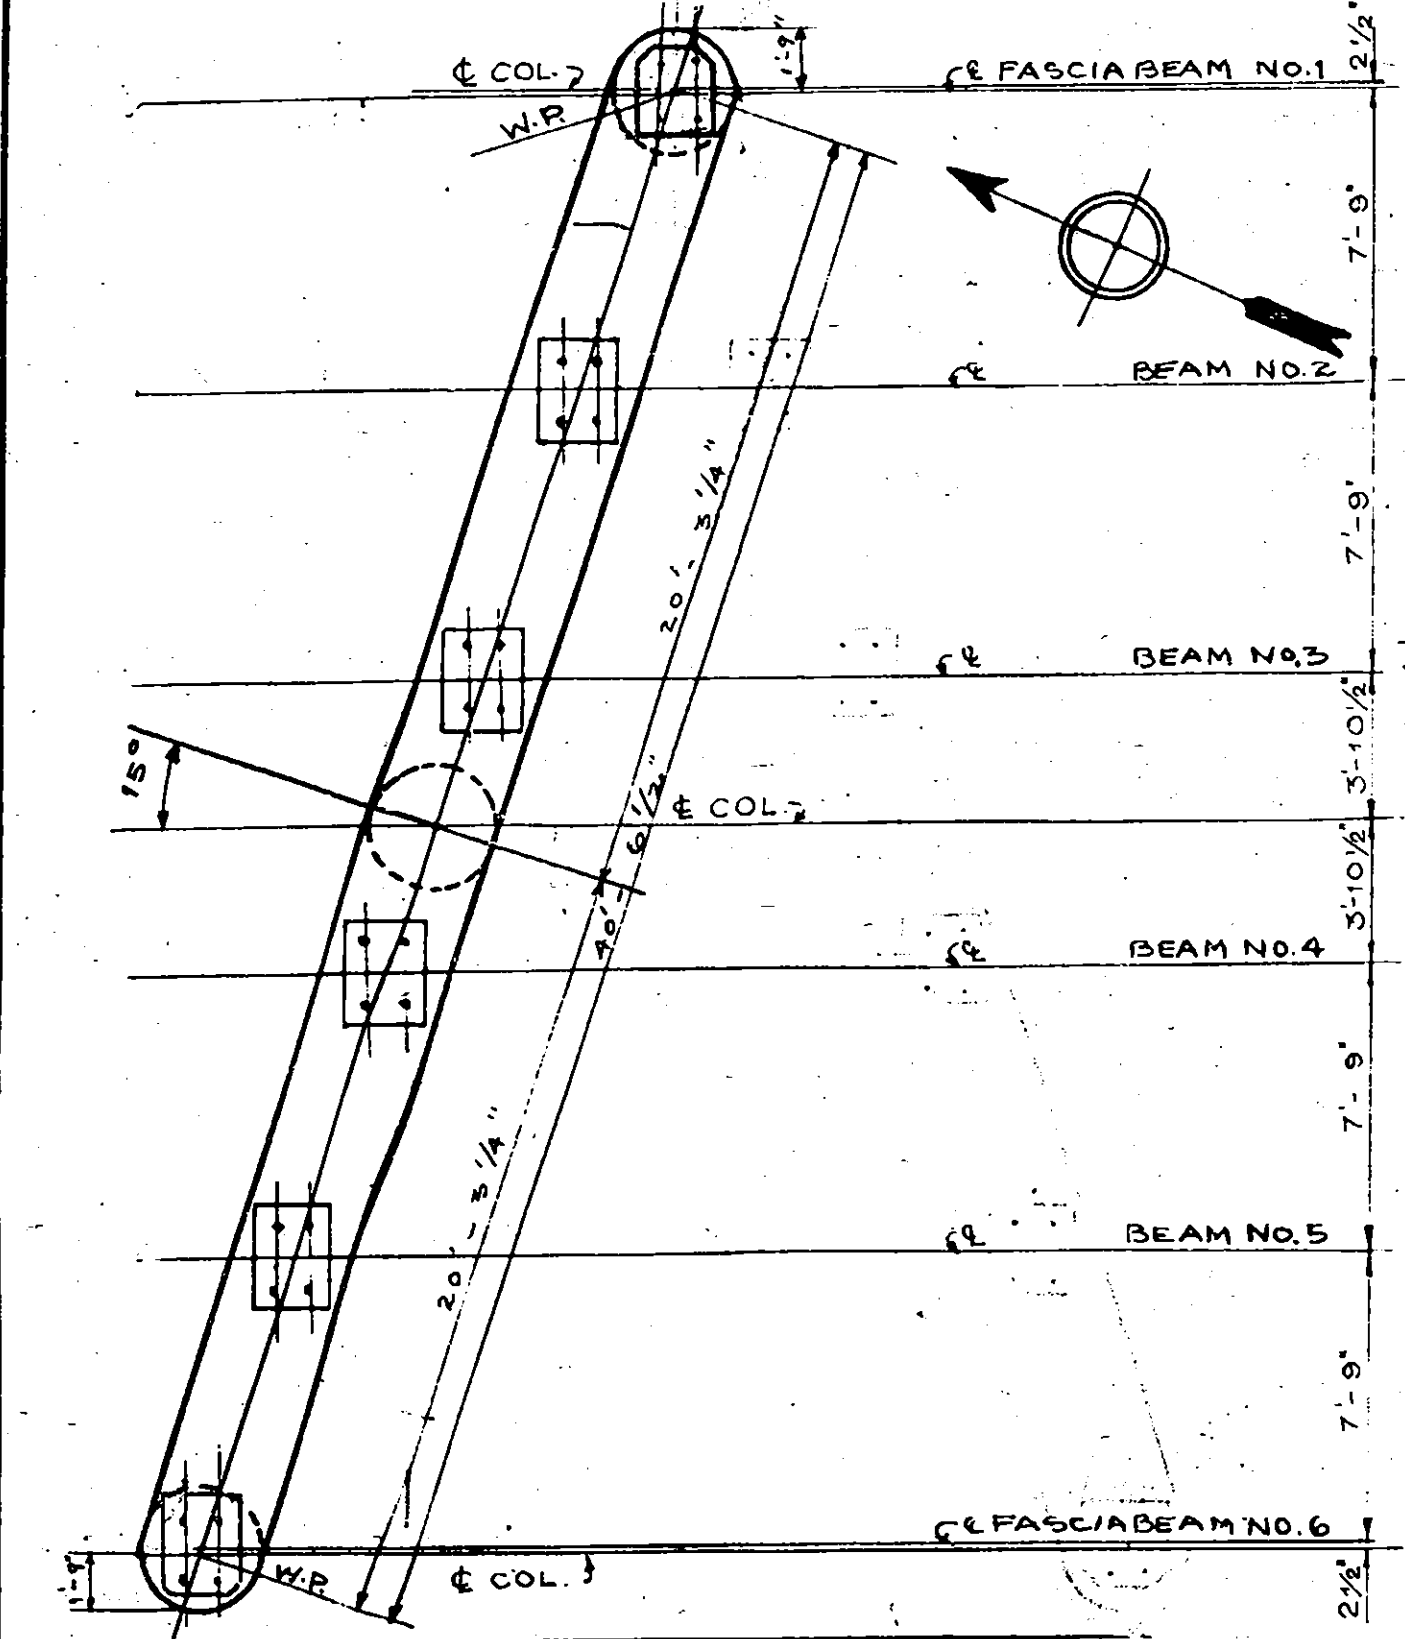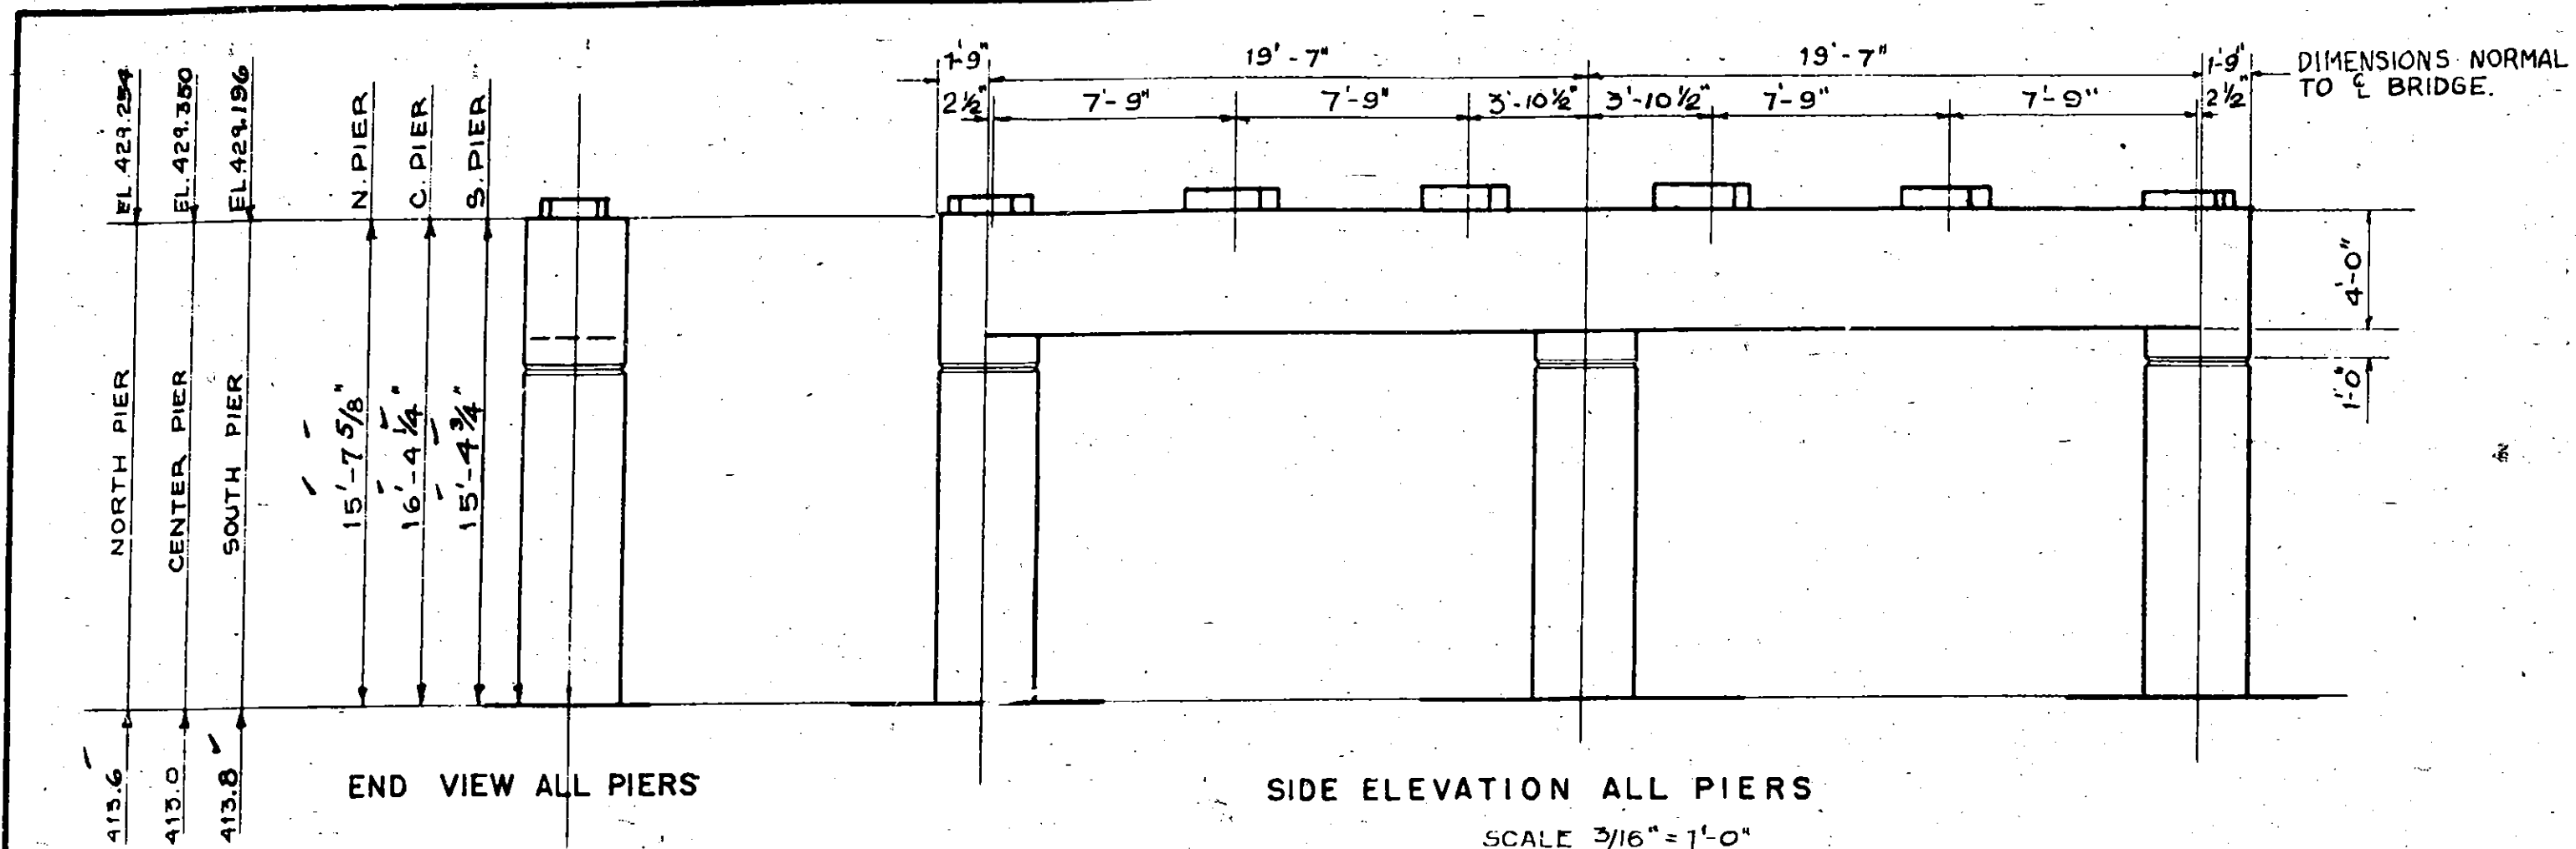

SUBSTRUCTURE
GENERAL NOTES

CONSTRUCTION JOINTS SHALL BE PLACED ONLY AS AND WHERE SHOWN ON THE PLANS, EXCEPT WHERE PERMISSION IN WRITING IS GIVEN BY THE DEPUTY CHIEF ENGINEER (BRIDGES), IN WHICH CASE, HIS SUPPLEMENTAL INSTRUCTIONS SHALL BE STRICTLY FOLLOWED.

AFTER THE CONCRETE IS CURED, THE CONTRACTOR SHALL APPLY A WATER-PROOFING OIL TREATMENT, AS DESCRIBED IN THE SPECIFICATIONS FOR M-41W TO ALL EXPOSED SURFACES.

ALL SHOE BEARING SURFACES SHALL BE CAST 1/4" ABOVE ELEVATIONS SHOWN ON THE PLANS, AND AFTER THE CONCRETE IS CURED, SHALL BE BUSH-HAMMERED TO THE REQUIRED ELEVATIONS.

THE CONTRACTOR'S ATTENTION IS DIRECTED TO THE SPECIAL NOTES FOR THIS STRUCTURE WHICH APPEAR IN THE PROPOSAL. PARTICULAR ATTENTION SHOULD BE GIVEN TO THE FOUNDATION NOTE WHICH BRIEFLY OUTLINES THE ANTICIPATED SUBSURFACE CONDITIONS AT THE SITE OF THE STRUCTURE, AND WHICH SPECIFIES CERTAIN REQUIREMENTS RELATIVE TO THE CONSTRUCTION.

BUILT ACCORDING TO PLAN

SUBSTRUCTURE DETAILS

THOMPSON ROAD
MOHAWK SECTION
NEW YORK STATE THRUWAY

CROSS REFERENCE
FOR LAYOUT OF PIERS SEE SHEET 35
FOR DETAILS OF REINFORCING BARS SEE SHEET 43
FOR DETAILS OF PIER FOUNDATION SEE SHEET 35
FOR DETAILS OF ANCHOR BOLTS SEE SHEET 41

PREPARED AND RECOMMENDED:
URQUHART & DOYLE, CONSULTING ENGINEERS
NEW YORK STATE PROFESSIONAL ENGINEERS LICENSE NO. 5657
DATE: 10/16/53

SUPERSTRUCTURE **GENERAL NOTES**

THE DESIGN OF THE STRUCTURE IS BASED ON A.A.S.H.O. SPECIFICATIONS, 1949 H20-516-44 LOADING AND CURRENT MODIFICATIONS AND ADDITIONS. ALL CONCRETE OF SUPERSTRUCTURE SHALL BE ITEM 18, EXCEPT CONCRETE OF PYLONS WHICH SHALL BE ITEM 19 AND CEMENT CONCRETE PAVEMENT WHICH SHALL BE ITEM 47-BM.

THE COST OF FURNISHING AND INSTALLING METAL EXPANSION MATERIAL, METAL WATER STOP, PREMOULDED BITUMINOUS JOINT MATERIAL, CAULKING COMPOUND, PARA-PLASTIC, SPONGE RUBBER, ASPHALT ROOFING FELT, SHALL BE INCLUDED IN THE BID PRICES OF THE RESPECTIVE CONCRETE ITEMS OF THE CONTRACT.

ALL MATERIALS, WORKMANSHIP AND FABRICATION SHALL CONFORM TO NEW YORK STATE DEPARTMENT OF PUBLIC WORKS SPECIFICATIONS, JANUARY 2, 1951, AND CURRENT MODIFICATIONS AND ADDITIONS.

WHERE CAULKING COMPOUND IS TO CONTACT CONCRETE SURFACES, SUCH CONCRETE SHALL BE THOROUGHLY CLEANED AND DRY, AND PRIMED WITH AND THE COMPLETE OPERATION SHALL BE SPECIALLY DIRECTED BY THE ENGINEER.

CONSTRUCTION JOINTS SHALL BE PLACED ONLY AS AND WHERE SHOWN IN THE PLANS, EXCEPT WHEN PERMISSION IN WRITING IS GIVEN BY THE DEPUTY CHIEF ENGINEER OF BRIDGES, IN WHICH CASE HIS SUPPLEMENTAL INSTRUCTION SHALL BE STRICTLY FOLLOWED.

AFTER THE CONCRETE IS CURED, THE CONTRACTOR SHALL APPLY A WATERPROOFING OIL TREATMENT AS DESCRIBED IN THE SPECIFICATIONS FOR M-41 W TO ALL EXPOSED SURFACES EXCEPT THE UNDERSIDE OF SLABS. TWO APPLICATIONS OF WATERPROOFING OIL TREATMENT SHALL BE APPLIED IMMEDIATELY BEFORE PLACING PAVEMENT CONCRETE. THE CONCRETE SURFACE OR SURFACES UPON WHICH IT IS TO BE PLACED SHALL BE THOROUGHLY WETTED DOWN CONTINUOUSLY FOR ONE HOUR, IF THE AIR TEMPERATURE IS 50°F. PAYMENT FOR THIS WORK WILL BE INCLUDED IN THE BID PRICE FOR ITEM 47-BM.

THE CONTRACTOR'S ATTENTION IS DIRECTED TO THE SPECIAL NOTES FOR THIS STRUCTURE WHICH APPEAR IN THE PROPOSAL. PARTICULAR ATTENTION SHOULD BE GIVEN TO THE FOUNDATION NOTE WHICH BRIEFLY OUTLINES THE ANTICIPATED SUBSURFACE CONDITIONS OF THE STRUCTURE, AND WHICH SPECIFIES CERTAIN REQUIREMENTS RELATIVE TO CONSTRUCTION.


SUPERSTRUCTURE QUANTITIES

ITEM NO.	DESCRIPTION	UNIT	NEAT	ROUNDED
15-2B	PORTLAND CEMENT, TYPE 2	BBL.	390	411
15-N	NATURAL CEMENT, TYPE N	BBL.	76	80
18	CLASS 1A CONCRETE FOR STRUCTURES	C.Y.	276	290
19	CLASS 1A CONCRETE FOR RAILINGS	C.Y.	23	3
28	BAR REINFORCEMENT FOR STRUCTURES	LB.	65,200	69,000
28-B	SPIRAL BAR SHEAR CONNECTORS	LB.	2,150	2,250
29	STRUCTURAL STEEL	LB.	252,200	259,800
37	METAL RAILINGS	LF.	458	460
47-BM	CEMENT CONCRETE PAVEMENT	C.Y.	95	100
*25-F	STEEL FABRIC REINFORCEMENT	SY.	855	900
15-3A	PORTLAND CEMENT, TYPE 1A	BBL.	142	149

*STEEL FABRIC REINFORCEMENT TO BE FURNISHED IN FLAT SHEETS.

COUNTY	SHEET NO.	TOTAL SHEETS
ONONDAGA	38	66

N.Y. STATE THRUWAY, MOHAWK SECTION SUBDIV. B.B.
INTERCHANGE AT THOMPSON ROAD

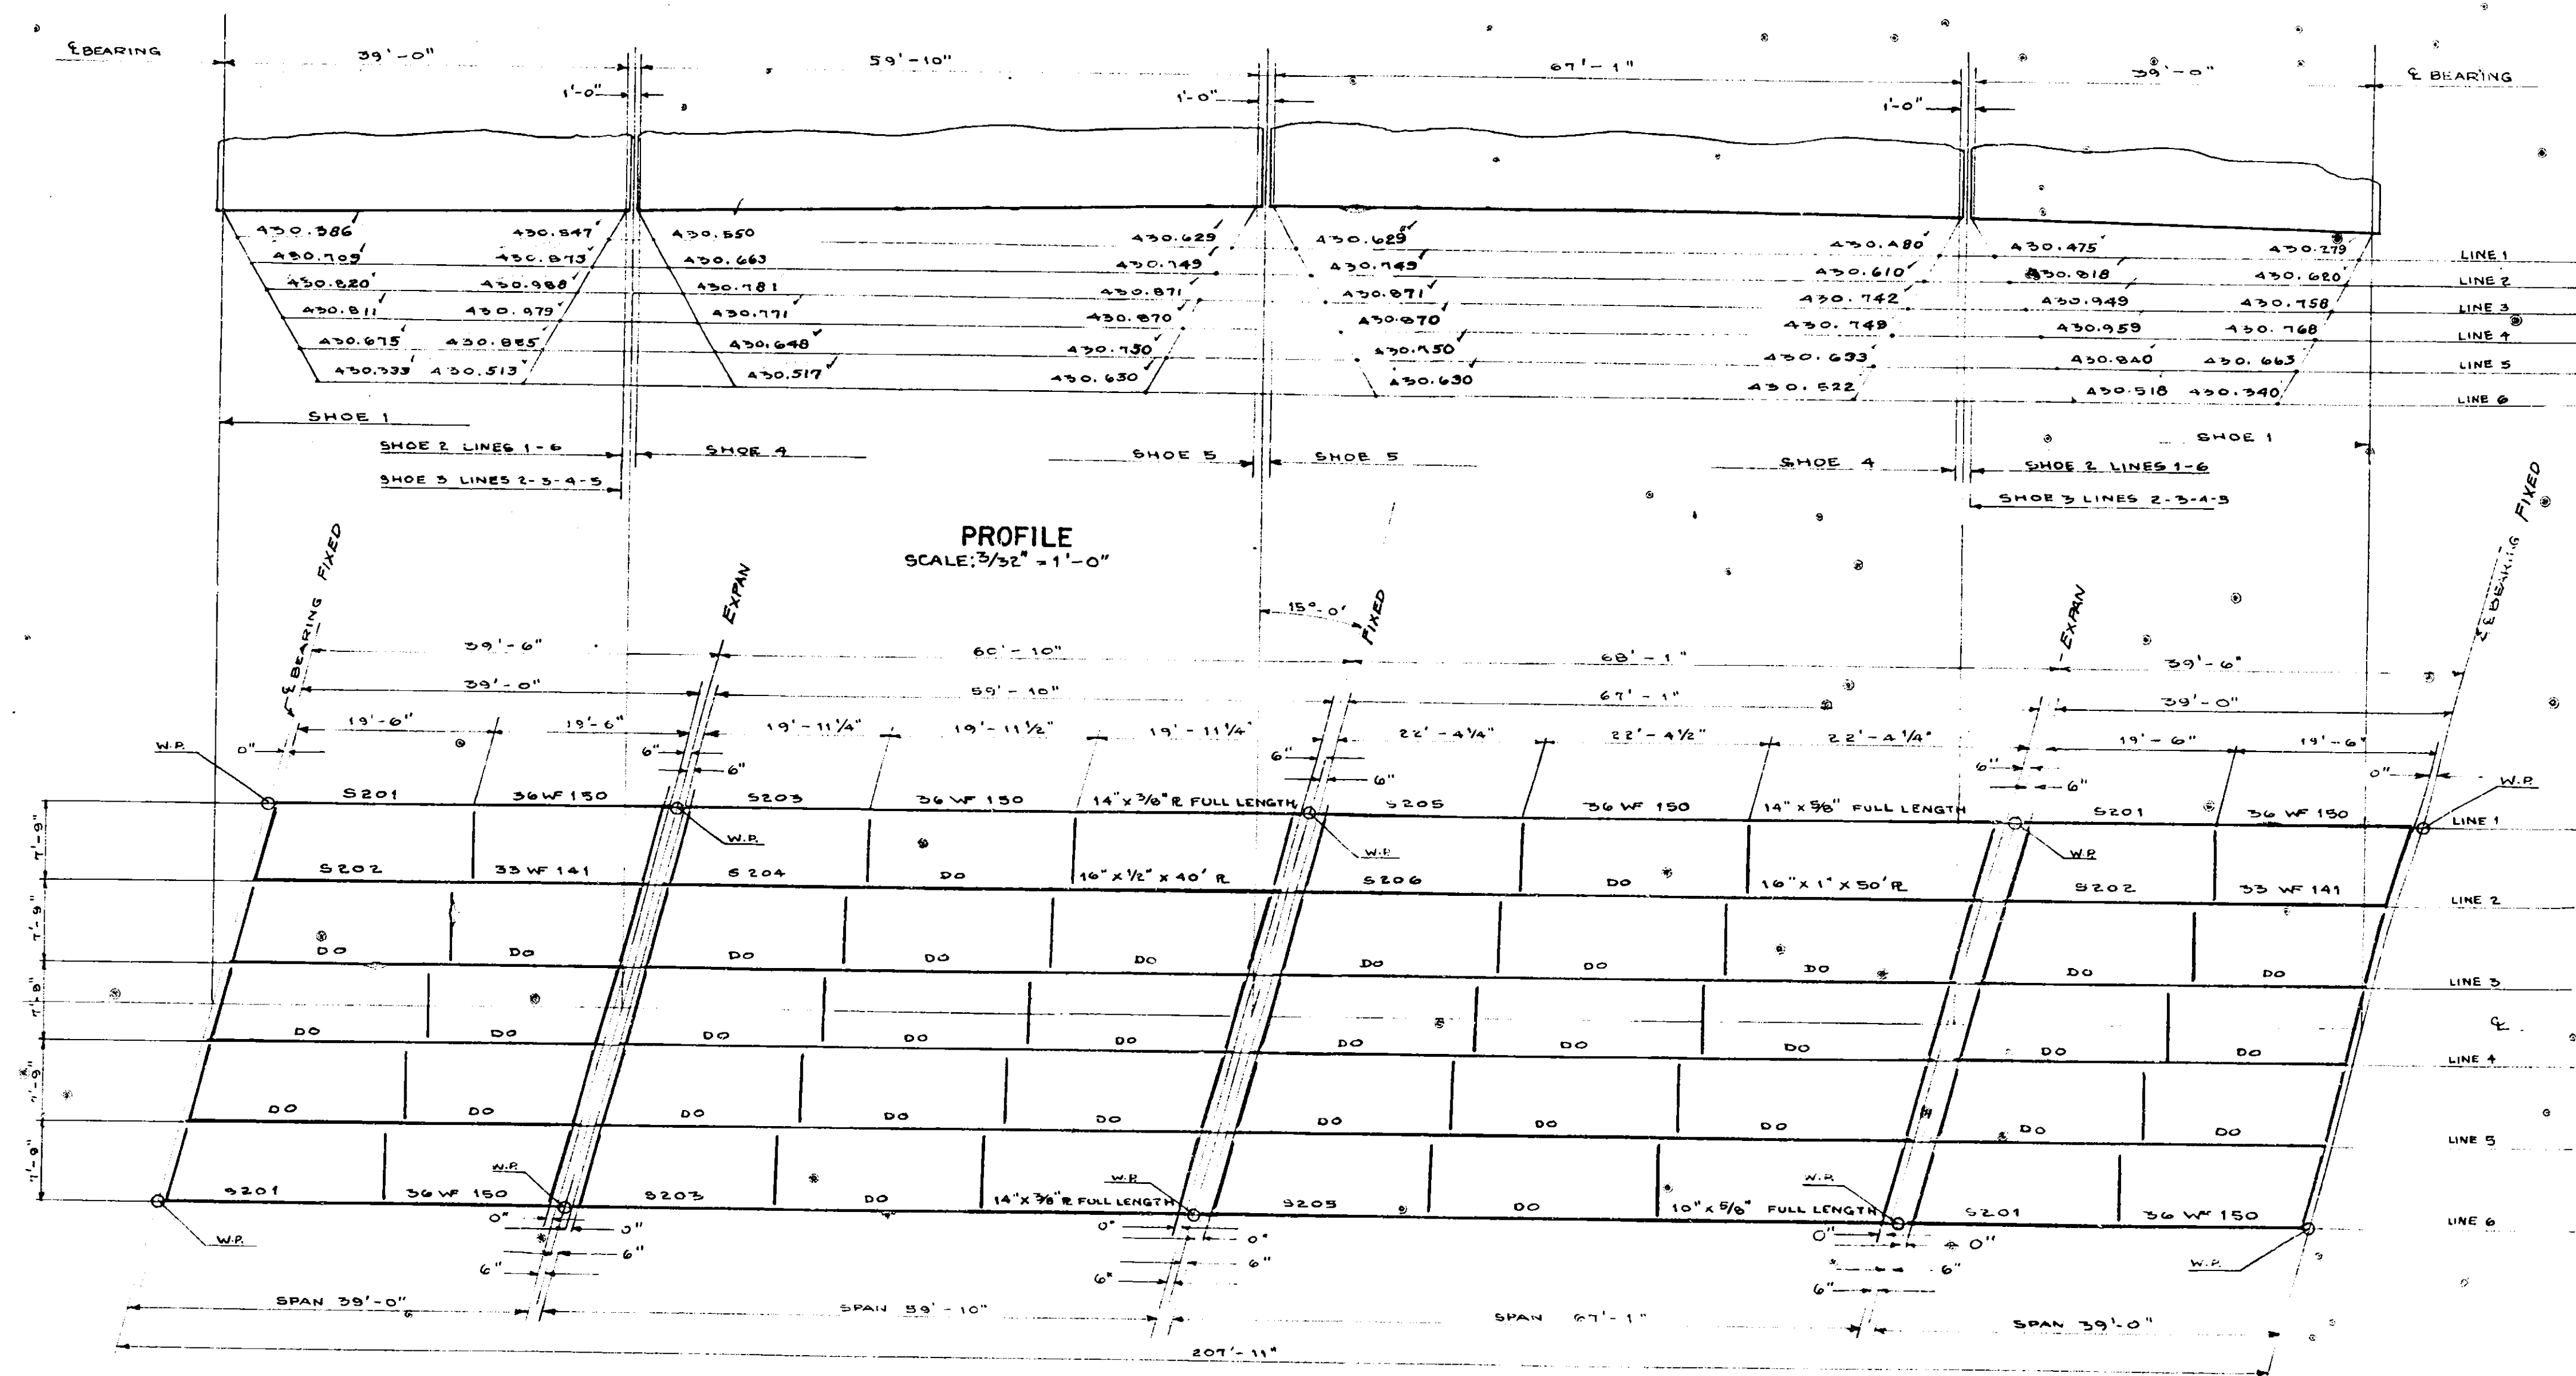

SUPERSTRUCTURE DETAILS

THOMPSON ROAD
MOHAWK SECTION

NEW YORK STATE THRUWAY

SHEET 38

PREPARED AND RECOMMENDED

URQUHART & DOYLE, CONSULTING ENGINEERS
NEW YORK STATE PROFESSIONAL ENGINEERS LICENSE NO. 5667

DATE

SUPERSTRUCTURE **GENERAL NOTES**

THE DESIGN OF THE STRUCTURE IS BASED ON A.A.S.H.O. SPECIFICATIONS, 1949 H20-S16-44 LOADING AND CURRENT MODIFICATIONS AND ADDITIONS. ALL CONCRETE OF SUPERSTRUCTURE SHALL BE ITEM 18, EXCEPT CONCRETE OF PYLONS WHICH SHALL BE ITEM 19 AND CEMENT CONCRETE PAVEMENT WHICH SHALL BE ITEM 47-BM.

THE COST OF FURNISHING AND INSTALLING METAL EXPANSION MATERIAL, METAL WATER STOP, PREMOULDED BITUMINOUS JOINT MATERIAL, CAULKING COMPOUND, PARA-PLASTIC, SPONGE RUBBER, ASPHALT ROOFING FELT, SHALL BE INCLUDED IN THE BID PRICES OF THE RESPECTIVE CONCRETE ITEMS OF THE CONTRACT.

ALL MATERIALS, WORKMANSHIP AND FABRICATION SHALL CONFORM TO NEW YORK STATE DEPARTMENT OF PUBLIC WORKS SPECIFICATIONS, JANUARY 2, 1951, AND CURRENT MODIFICATIONS AND ADDITIONS.

WHERE CAULKING COMPOUND IS TO CONTACT CONCRETE SURFACES, SUCH CONCRETE SHALL BE THOROUGHLY CLEANED AND DRY AND PRIMED WITH A PRIMING COAT AT LEAST 30 MINUTES BEFORE THE APPLICATION OF CAULKING COMPOUND. THIS WORK SHALL BE DONE BY EXPERIENCED MEN, AND THE COMPLETE OPERATION SHALL BE SPECIALLY DIRECTED BY THE ENGINEER.

CONSTRUCTION JOINTS SHALL BE PLACED ONLY AS AND WHERE SHOWN THE PLANS, EXCEPT WHEN PERMISSION IN WRITING IS GIVEN BY THE DEPUTY CHIEF ENGINEER OF BRIDGES, IN WHICH CASE HIS SUPPLEMENTAL INSTRUCTION SHALL BE STRICTLY FOLLOWED.

AFTER THE CONCRETE IS CURED, THE CONTRACTOR SHALL APPLY A WATERPROOFING OIL TREATMENT AS DESCRIBED IN THE SPECIFICATIONS FOR M-41 W TO ALL EXPOSED SURFACES EXCEPT THE UNDERSIDE OF SLABS. TWO APPLICATIONS OF WATERPROOFING OIL TREATMENT SHALL BE APPLIED AT THE TOP OF THE SLAB. THE SECOND APPLICATION SHALL BE APPLIED TWO DAYS PRIOR TO THE PLACING OF THE PAVEMENT OR SIDEWALK.

IMMEDIATELY BEFORE PLACING PAVEMENT CONCRETE, THE CONCRETE SURFACE OR SURFACES UPON WHICH IT IS TO BE PLACED SHALL BE THOROUGHLY WETTED DOWN CONTINUOUSLY FOR ONE HOUR, IF THE AIR TEMPERATURE IS 50°F. PAYMENT FOR THIS WORK WILL BE INCLUDED IN THE BID PRICE FOR ITEM 47-BM.

THE CONTRACTOR'S ATTENTION IS DIRECTED TO THE SPECIAL NOTES FOR THIS STRUCTURE WHICH APPEAR IN THE PROPOSAL. PARTICULAR ATTENTION SHOULD BE GIVEN TO THE FOUNDATION NOTE WHICH BRIEFLY OUTLINES THE ANTICIPATED SUBSURFACE CONDITIONS OF THE STRUCTURE, AND WHICH SPECIFIES CERTAIN REQUIREMENTS RELATIVE TO CONSTRUCTION.


COUNTY	SHEET NO.	TOTAL SHEETS
ONONDAGA	38	66

N.Y. STATE THRUWAY, MOHAWK SECTION SUBDIV. B.B.
INTERCHANGE AT THOMPSON ROAD

SUPERSTRUCTURE QUANTITIES				
ITEM NO.	DESCRIPTION	UNIT	NEAT	ROUNDED
15-2	PORTLAND CEMENT, TYPE 2	BBL.	390	411
15-N	NATURAL CEMENT, TYPE N	BBL.	76	80
18	CLASS 1A CONCRETE FOR STRUCTURES	C.Y.	276	290
19	CLASS 1A CONCRETE FOR RAILINGS	C.Y.	23	24
28	BAR REINFORCEMENT FOR STRUCTURES	LB.	63,200	63,000
28-B	SPIRAL BAR SHEAR CONNECTORS	LB.	2,150	2,250
29	STRUCTURAL STEEL	LB.	252,300	259,300
37	METAL RAILINGS	LF.	458	460
47-BM	CEMENT CONCRETE PAVEMENT	CY.	35	100
*25-F	STEEL FABRIC REINFORCEMENT	SY.	855	900
15-BA	PORTLAND CEMENT, TYPE 1A	BBL.	142	143

*STEEL FABRIC REINFORCEMENT TO BE FURNISHED IN FLAT SHEETS.

38R

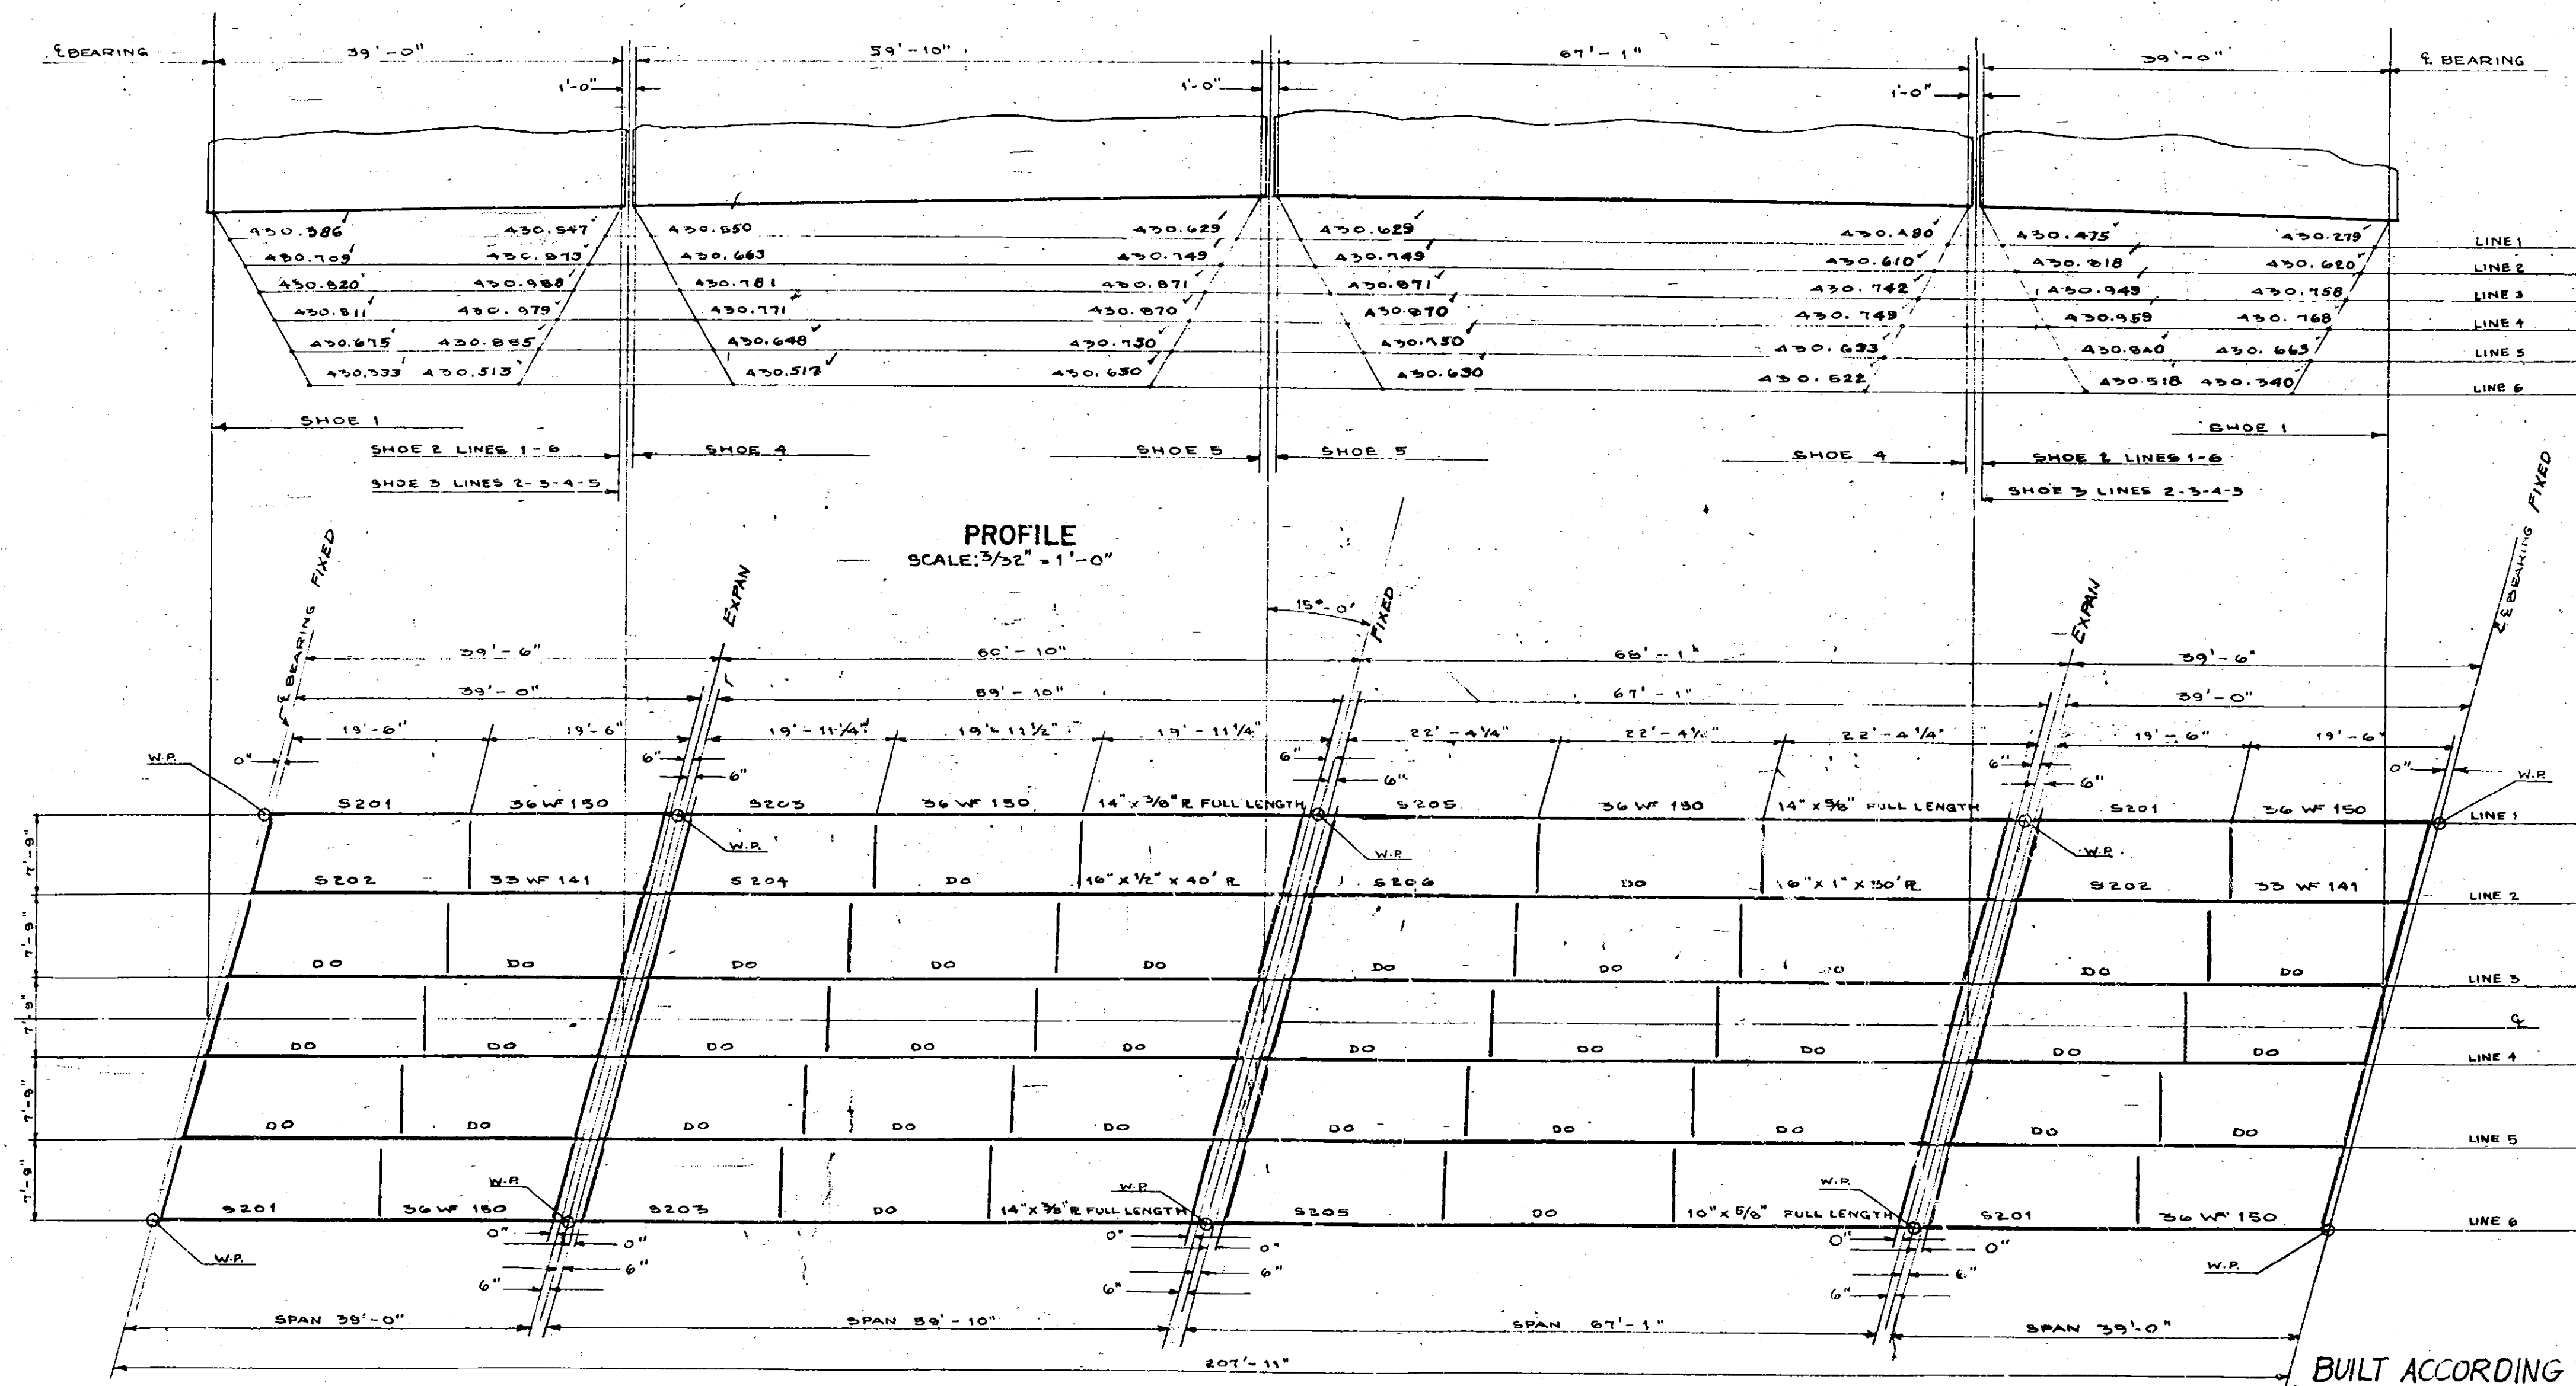



NOTE:
ELEVATIONS ARE TO
BOTTOM OF BOTTOM
FLANGE.

STEEL PLAN
SCALE: 3/32" = 1'-0"


SUPERSTRUCTURE DETAILS

THOMPSON ROAD
MOHAWK SECTION
NEW YORK STATE THRUWAY


COUNTY	SHEET NO	TOTAL SHEETS
ONONDAGA	39	66
N.Y. STATE THRUWAY, MOHAWK SECTION SUBDIV. 8B		
INTERCHANGE AT THOMPSON ROAD		

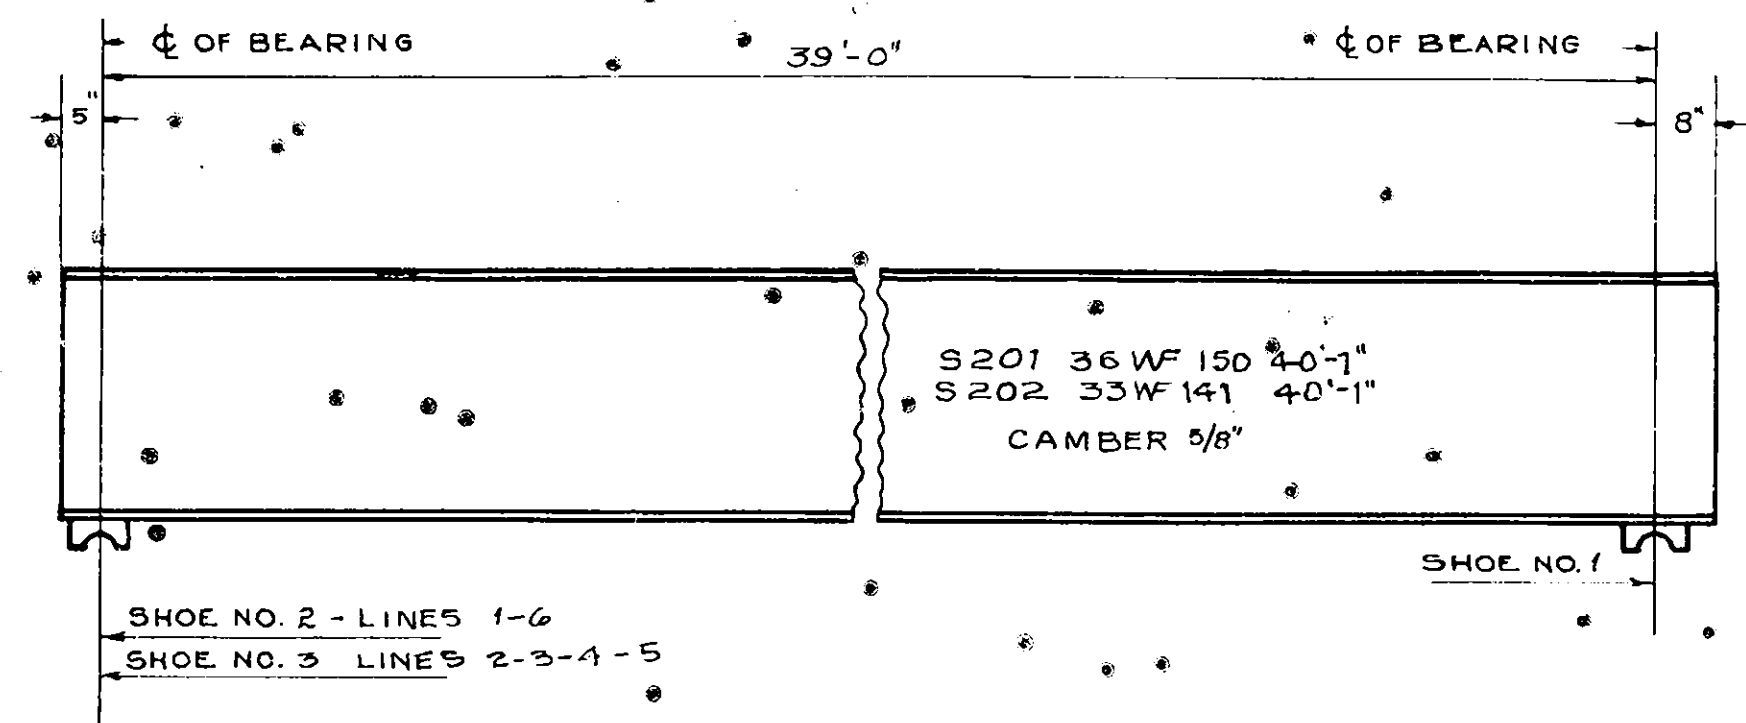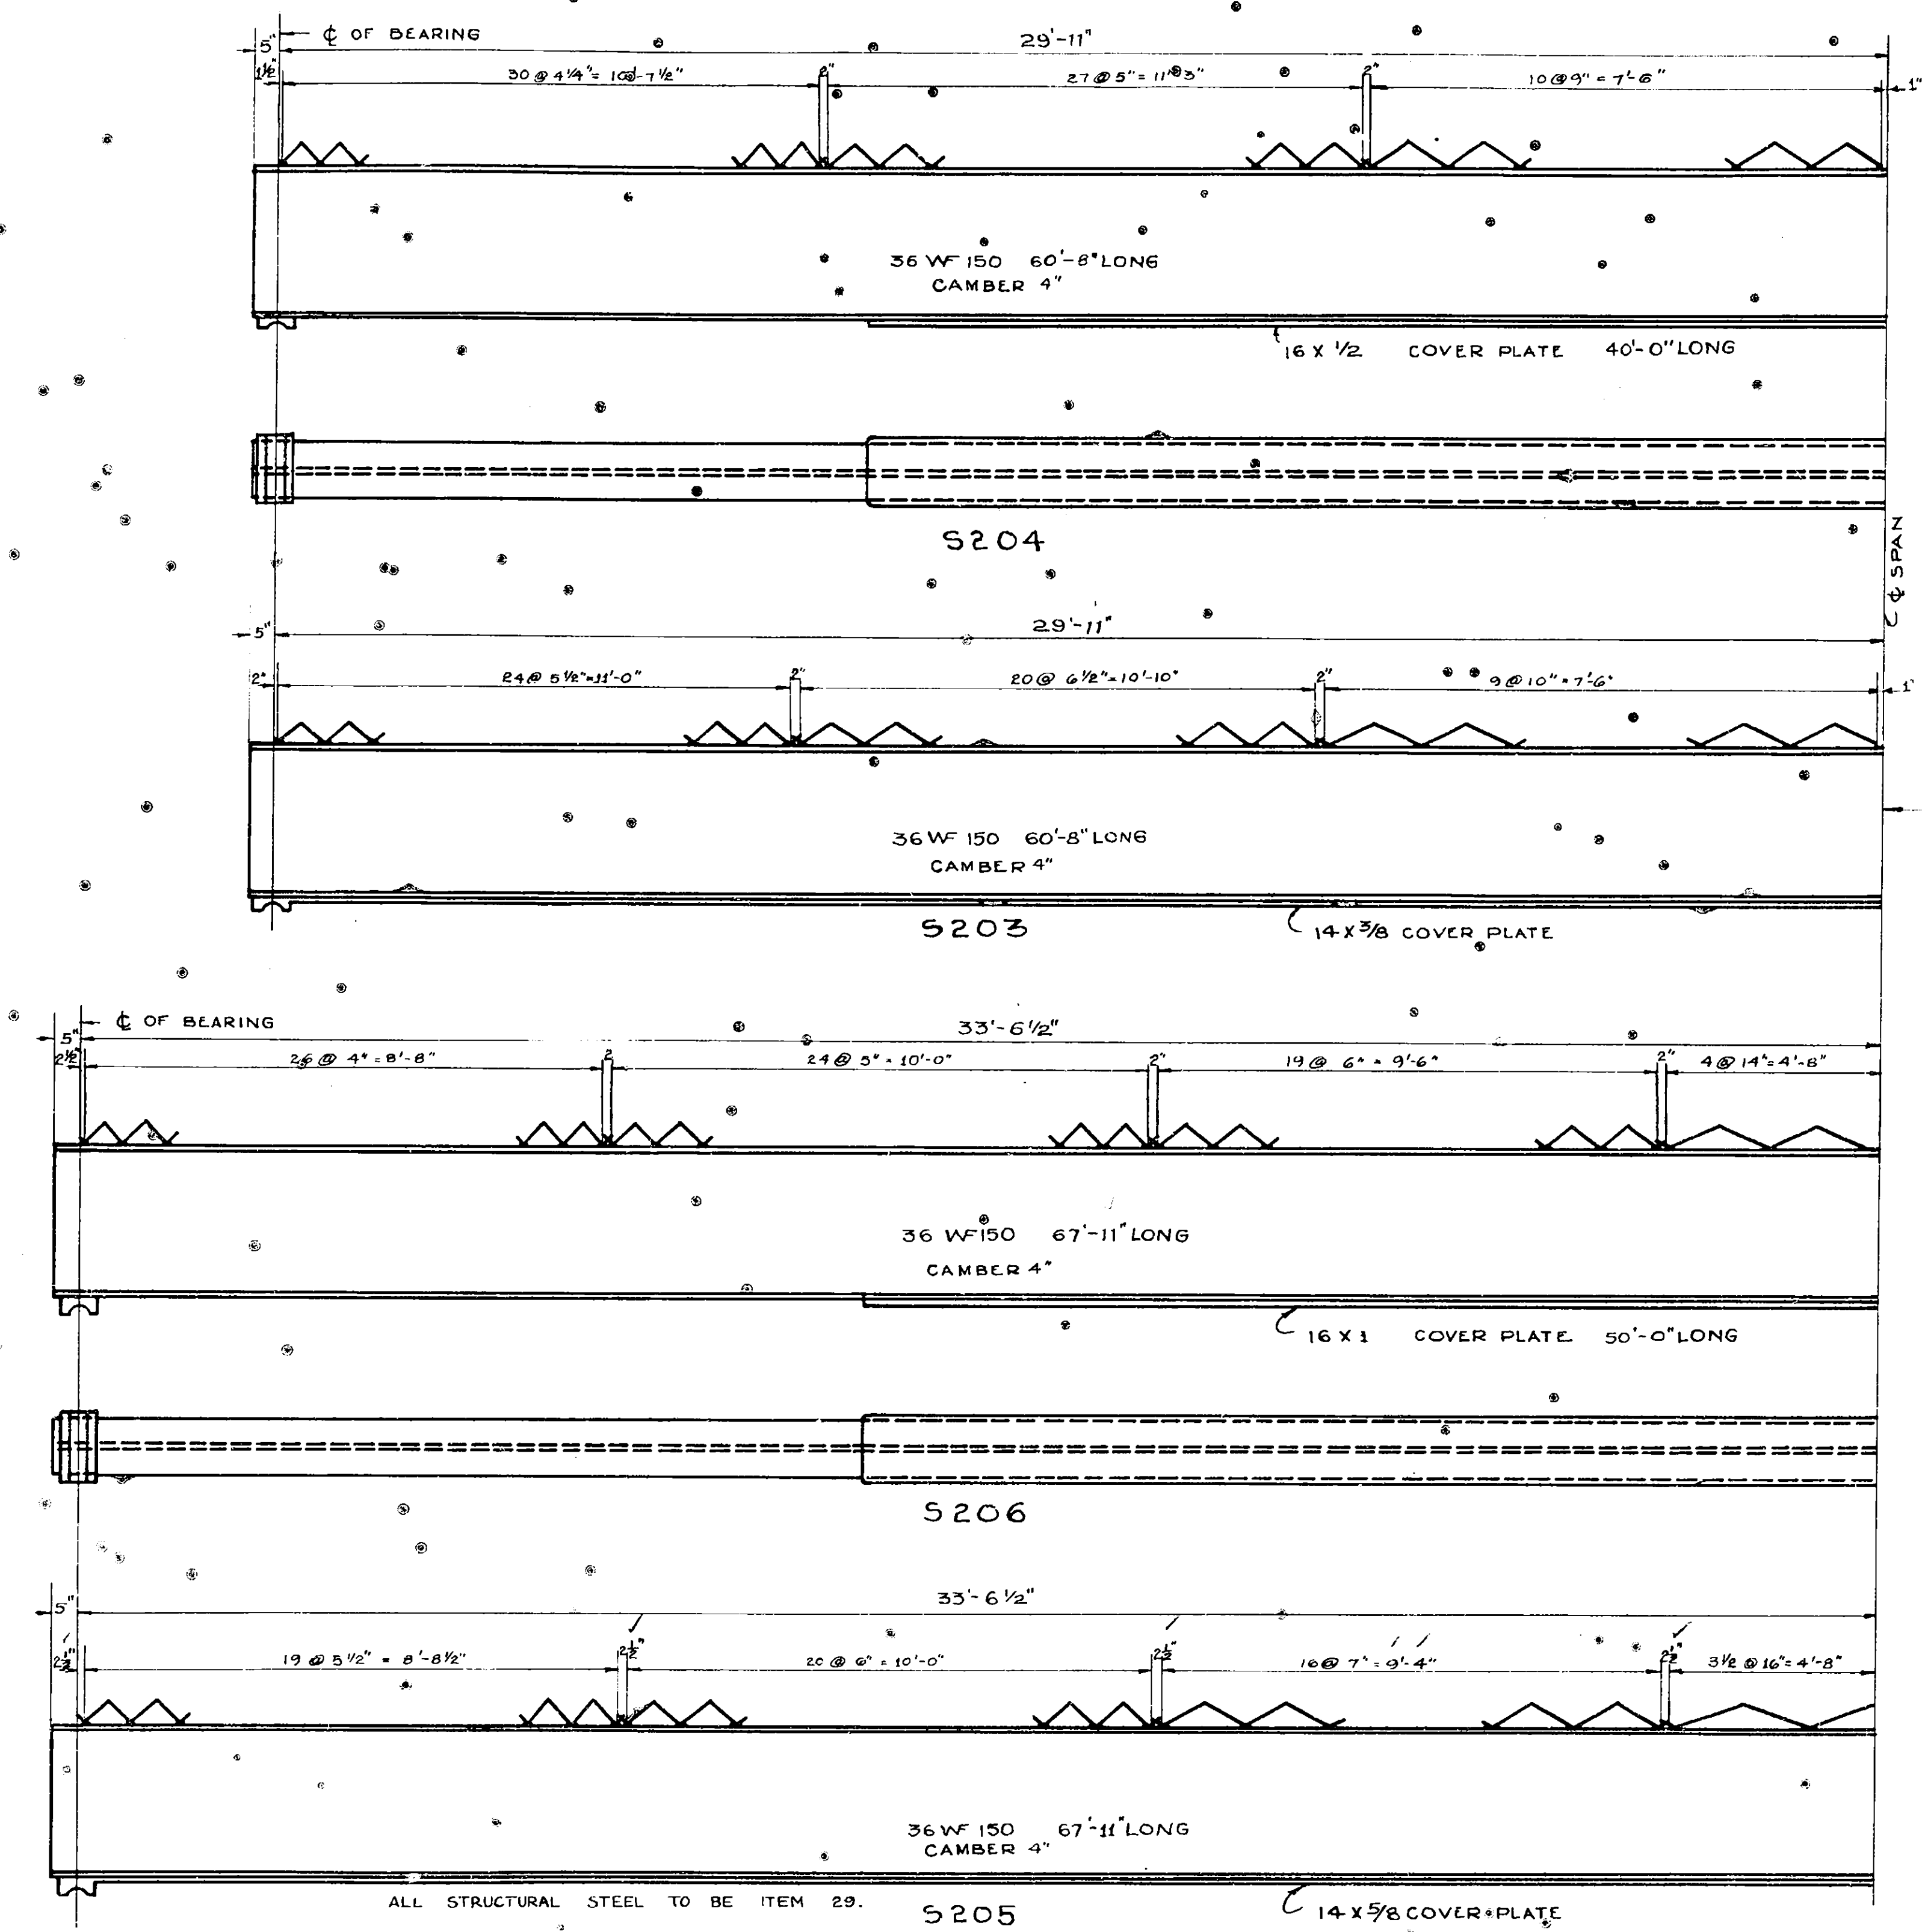


DONOT PAINT SURFACE OF TOP FLANGE ON WHICH WELDS ARE MADE

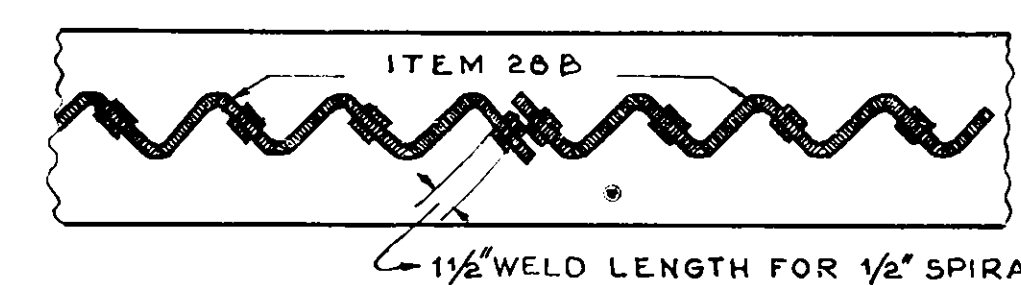

1/2" SPIRAL ROD 5/16" FILLET WELD 1 1/2" LONG ON EACH SIDE OF ROD.

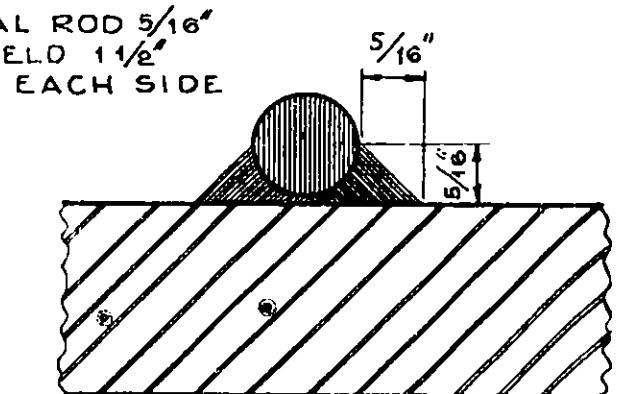

5" MEAN DIAMETER OF 1/2" SPIRALS

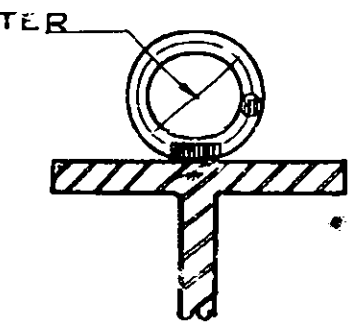

NOTE: EXTEND BAR 1/4 TURN BEYOND END WELDS OF UNIT.

SPIRAL DETAILS NOT TO SCALE

ALL SPIRAL SHEAR BARS ARE ITEM 28B

SPECIAL NOTES FOR SPIRALS

THE CONTRACTOR'S AND ENGINEER'S ATTENTION IS CALLED TO THE POSSIBILITY OF INTERFERENCE BETWEEN THE REINFORCING STEEL IN THE SLAB AND THE BEAM SPIRALS. WHILE STEEL SPACING IS GIVEN AS 5/8" INCHES, IT IS TO BE UNDERSTOOD THAT 2 BARS IN EACH OFT. 11 IN. WILL FULFILL THIS REQUIREMENT IF NO TWO BARS ARE CLOSER THAN 1" LESS THAN REQUIRED SPACING OR FURTHER APART THAN 1" MORE THAN REQUIRED SPACING. IF NECESSARY, SOME BARS MAY BE THREADED THRU ONE OR MORE SPIRALS. ALL SPIRALS MUST HAVE TWO STRUCTURAL WELDS 5/16" X 1 1/2" LONG, AT EACH SIDE OF THE BAR AS SHOWN. 3/32" OR 3/16" DIAMETER ELECTRODES SHALL BE USED IN WELDING THE SPIRAL BAR REINFORCEMENT. SPECIAL PRECAUTIONS MUST BE EXERCISED WHERE WELDING CROSS-ES EDGE OF FLANGE TO AVOID ANY POSSIBILITY OF UNDERCUT OR NICKS IN THE EDGE OF FLANGE.




NOTE: ALL COVER PLATES TO BE WELDED WITH 3/16" CONTINUOUS FILLET WELDS.

SCALE: 1/2" = 1'-0" EXCEPT AS SHOWN FOR SHOE DETAILS SEE SHEET 41 FOR FRAMING PLAN SEE SHEET 38

PREPARED AND RECOMMENDED: *URQUHART & DOYLE* *FW 16-53*
URQUHART & DOYLE, CONSULTING ENGINEERS
NEW YORK STATE PROFESSIONAL ENGINEERS LICENSE NO. 5667
DATE

SUPERSTRUCTURE DETAILS
THOMPSON ROAD
MOHAWK SECTION
NEW YORK STATE THRUWAY

COUNTY	SHEET NO	TOTAL SHEETS
ONONDAGA	40	66
N.Y. STATE THRUWAY, MOHAWK SECTION SUBDIV. 8B		
INTERCHANGE AT THOMPSON ROAD		

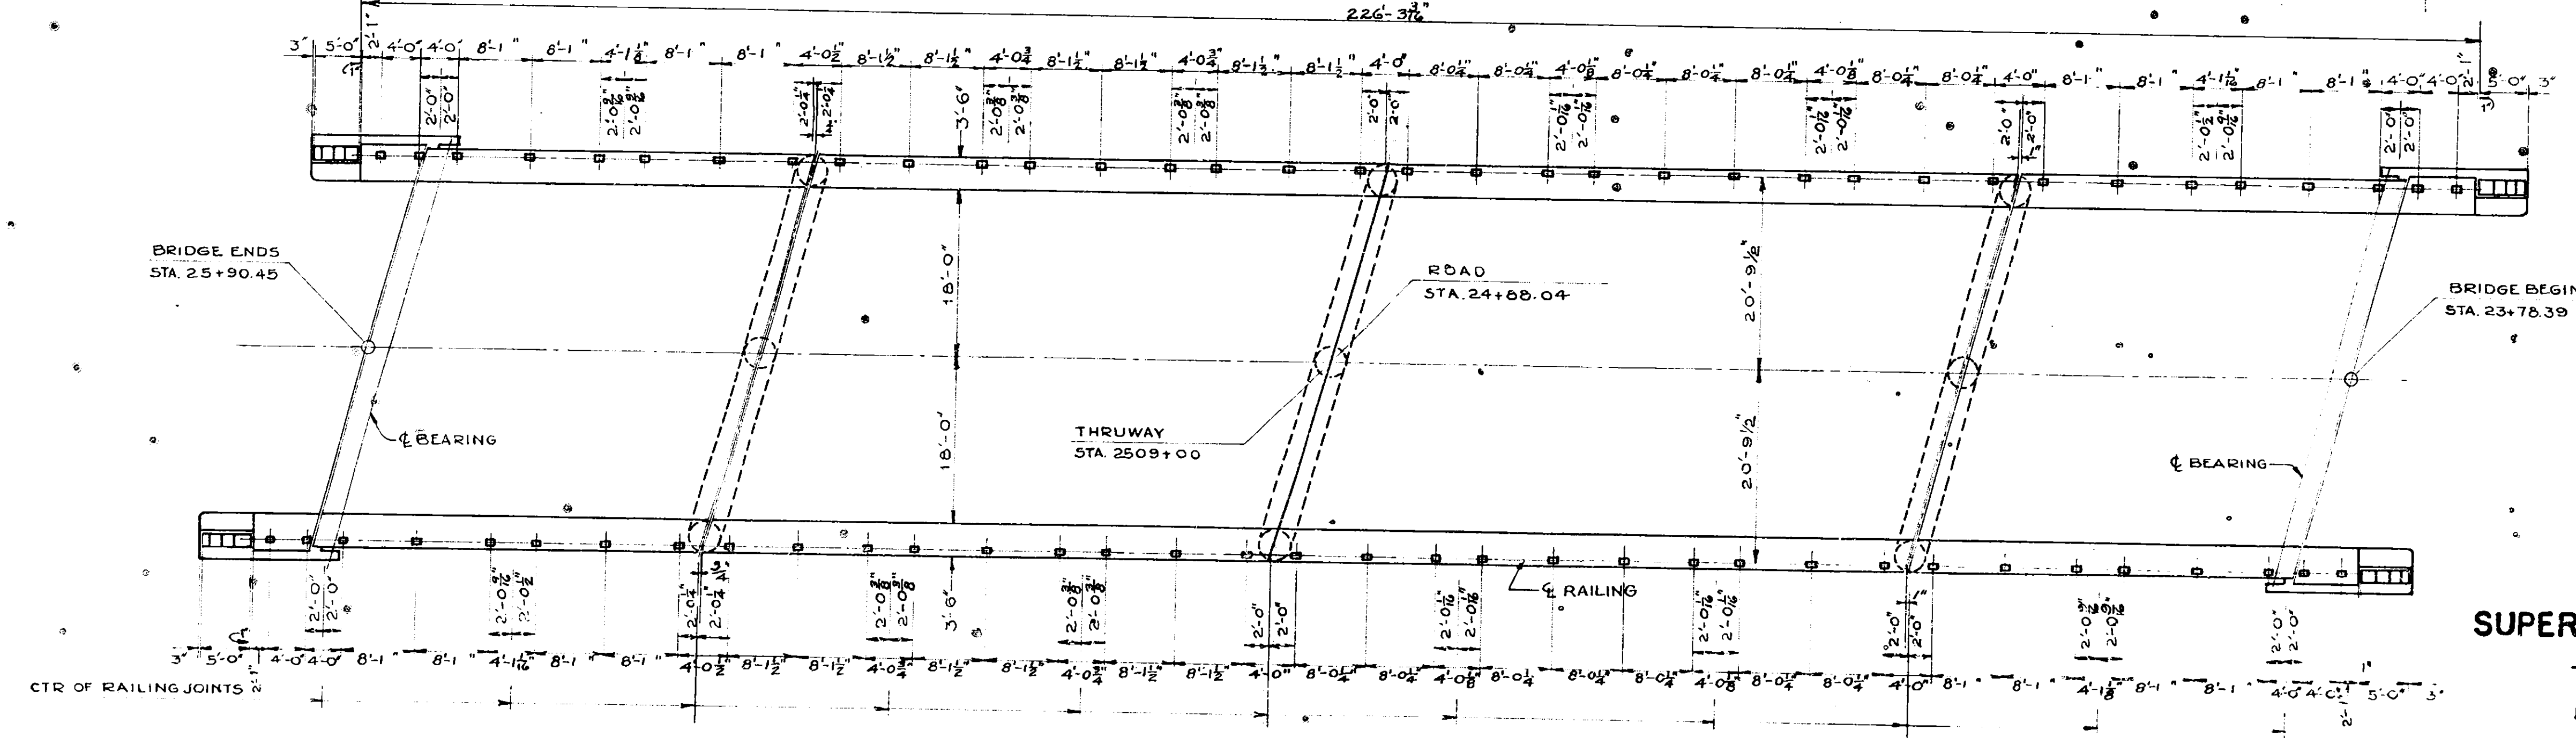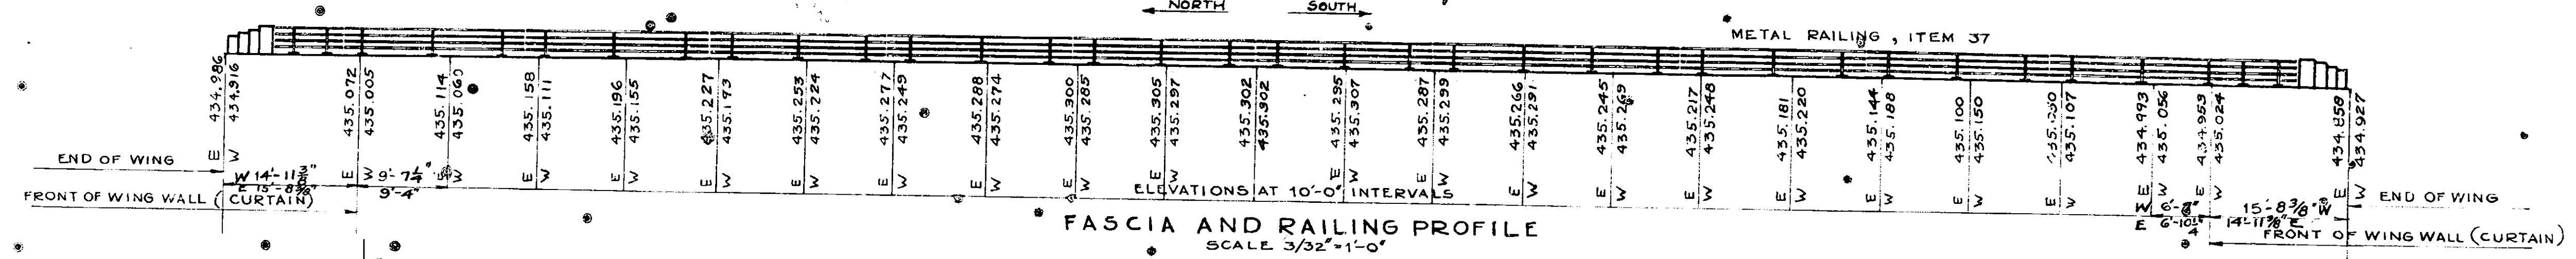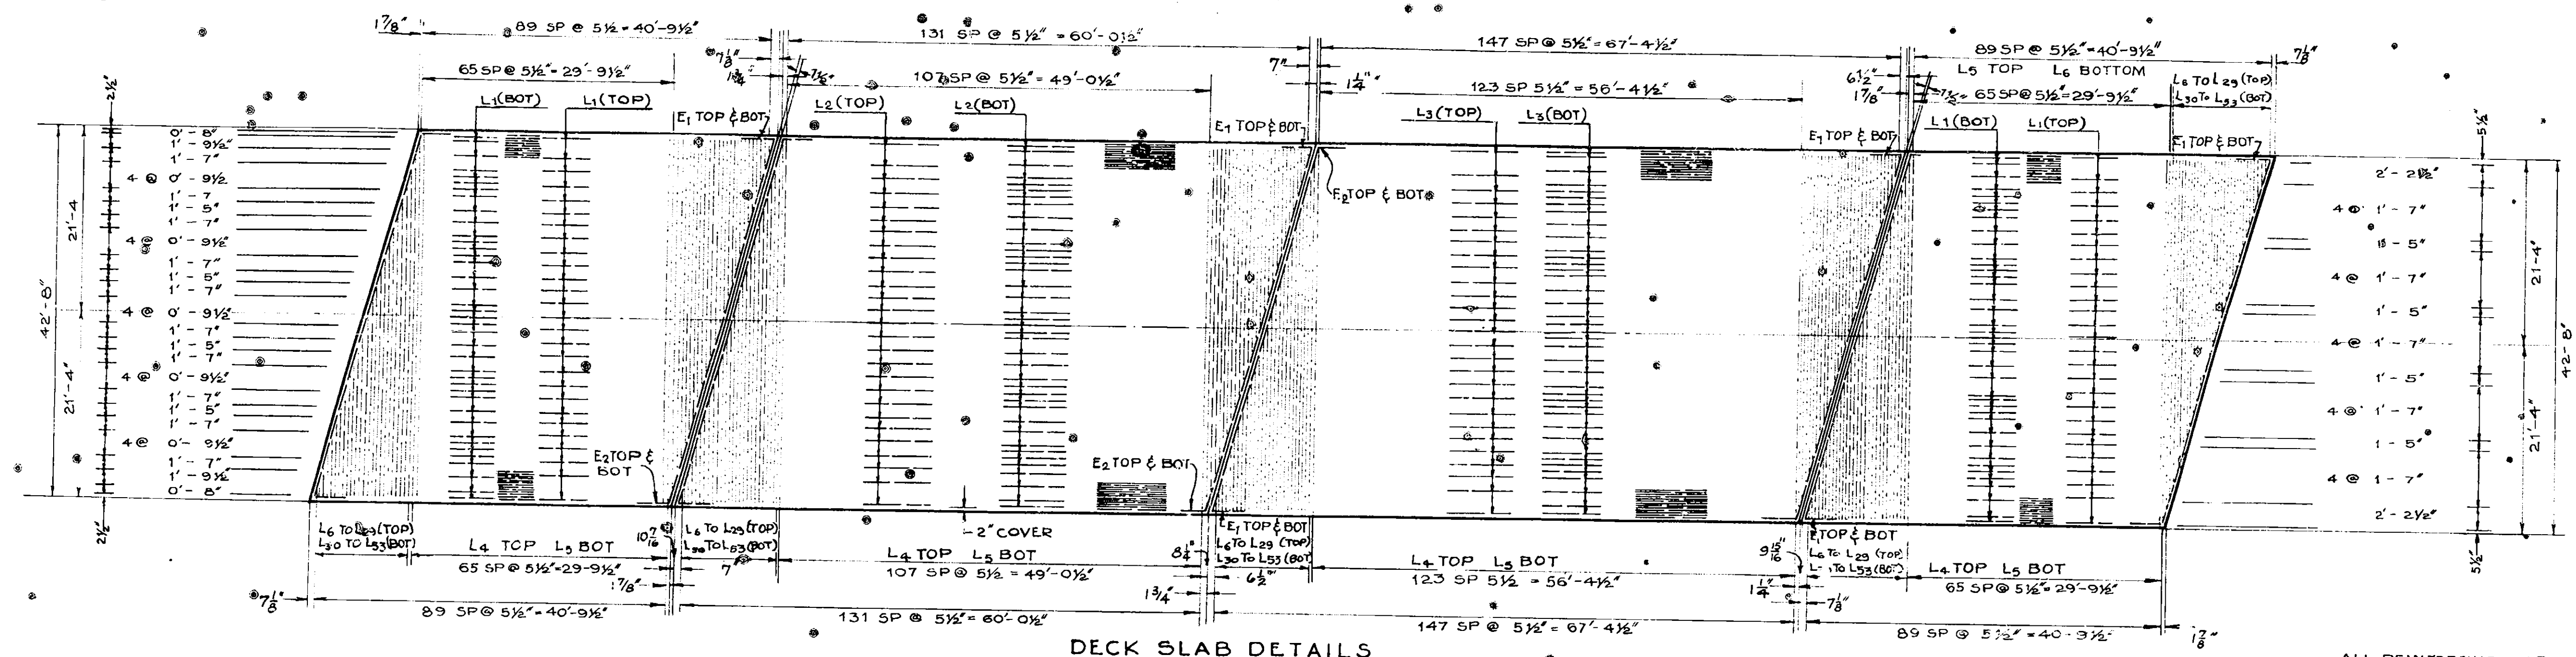


SUPERSTRUCTURE DETAILS
THOMPSON ROAD
MOHAWK SECTION
NEW YORK STATE THRUWAY

PREPARED AND RECOMMENDED
J. J. Doyle
J. J. Doyle & Doyle Consulting Engineers
NEW YORK STATE PROFESSIONAL ENGINEERS LICENSE NO. 5667

CROSS REFERENCE
FOR DETAILS OF METAL RAILING SEE SHEET 41
FOR DETAILS OF REINFORCING BARS SEE SHEET 43
FOR DETAILS OF DECK SEE SHEET 42
FOR DETAILS OF SLAB JOINTS SEE SHEET 42


COUNTY	SHEET NO.	TOTAL SHEETS
ONONDAGA	41	66
NEW YORK STATE THRUWAY, MOHAWK SECTION SUBDIV. B B		
INTERCHANGE AT THOMPSON ROAD		

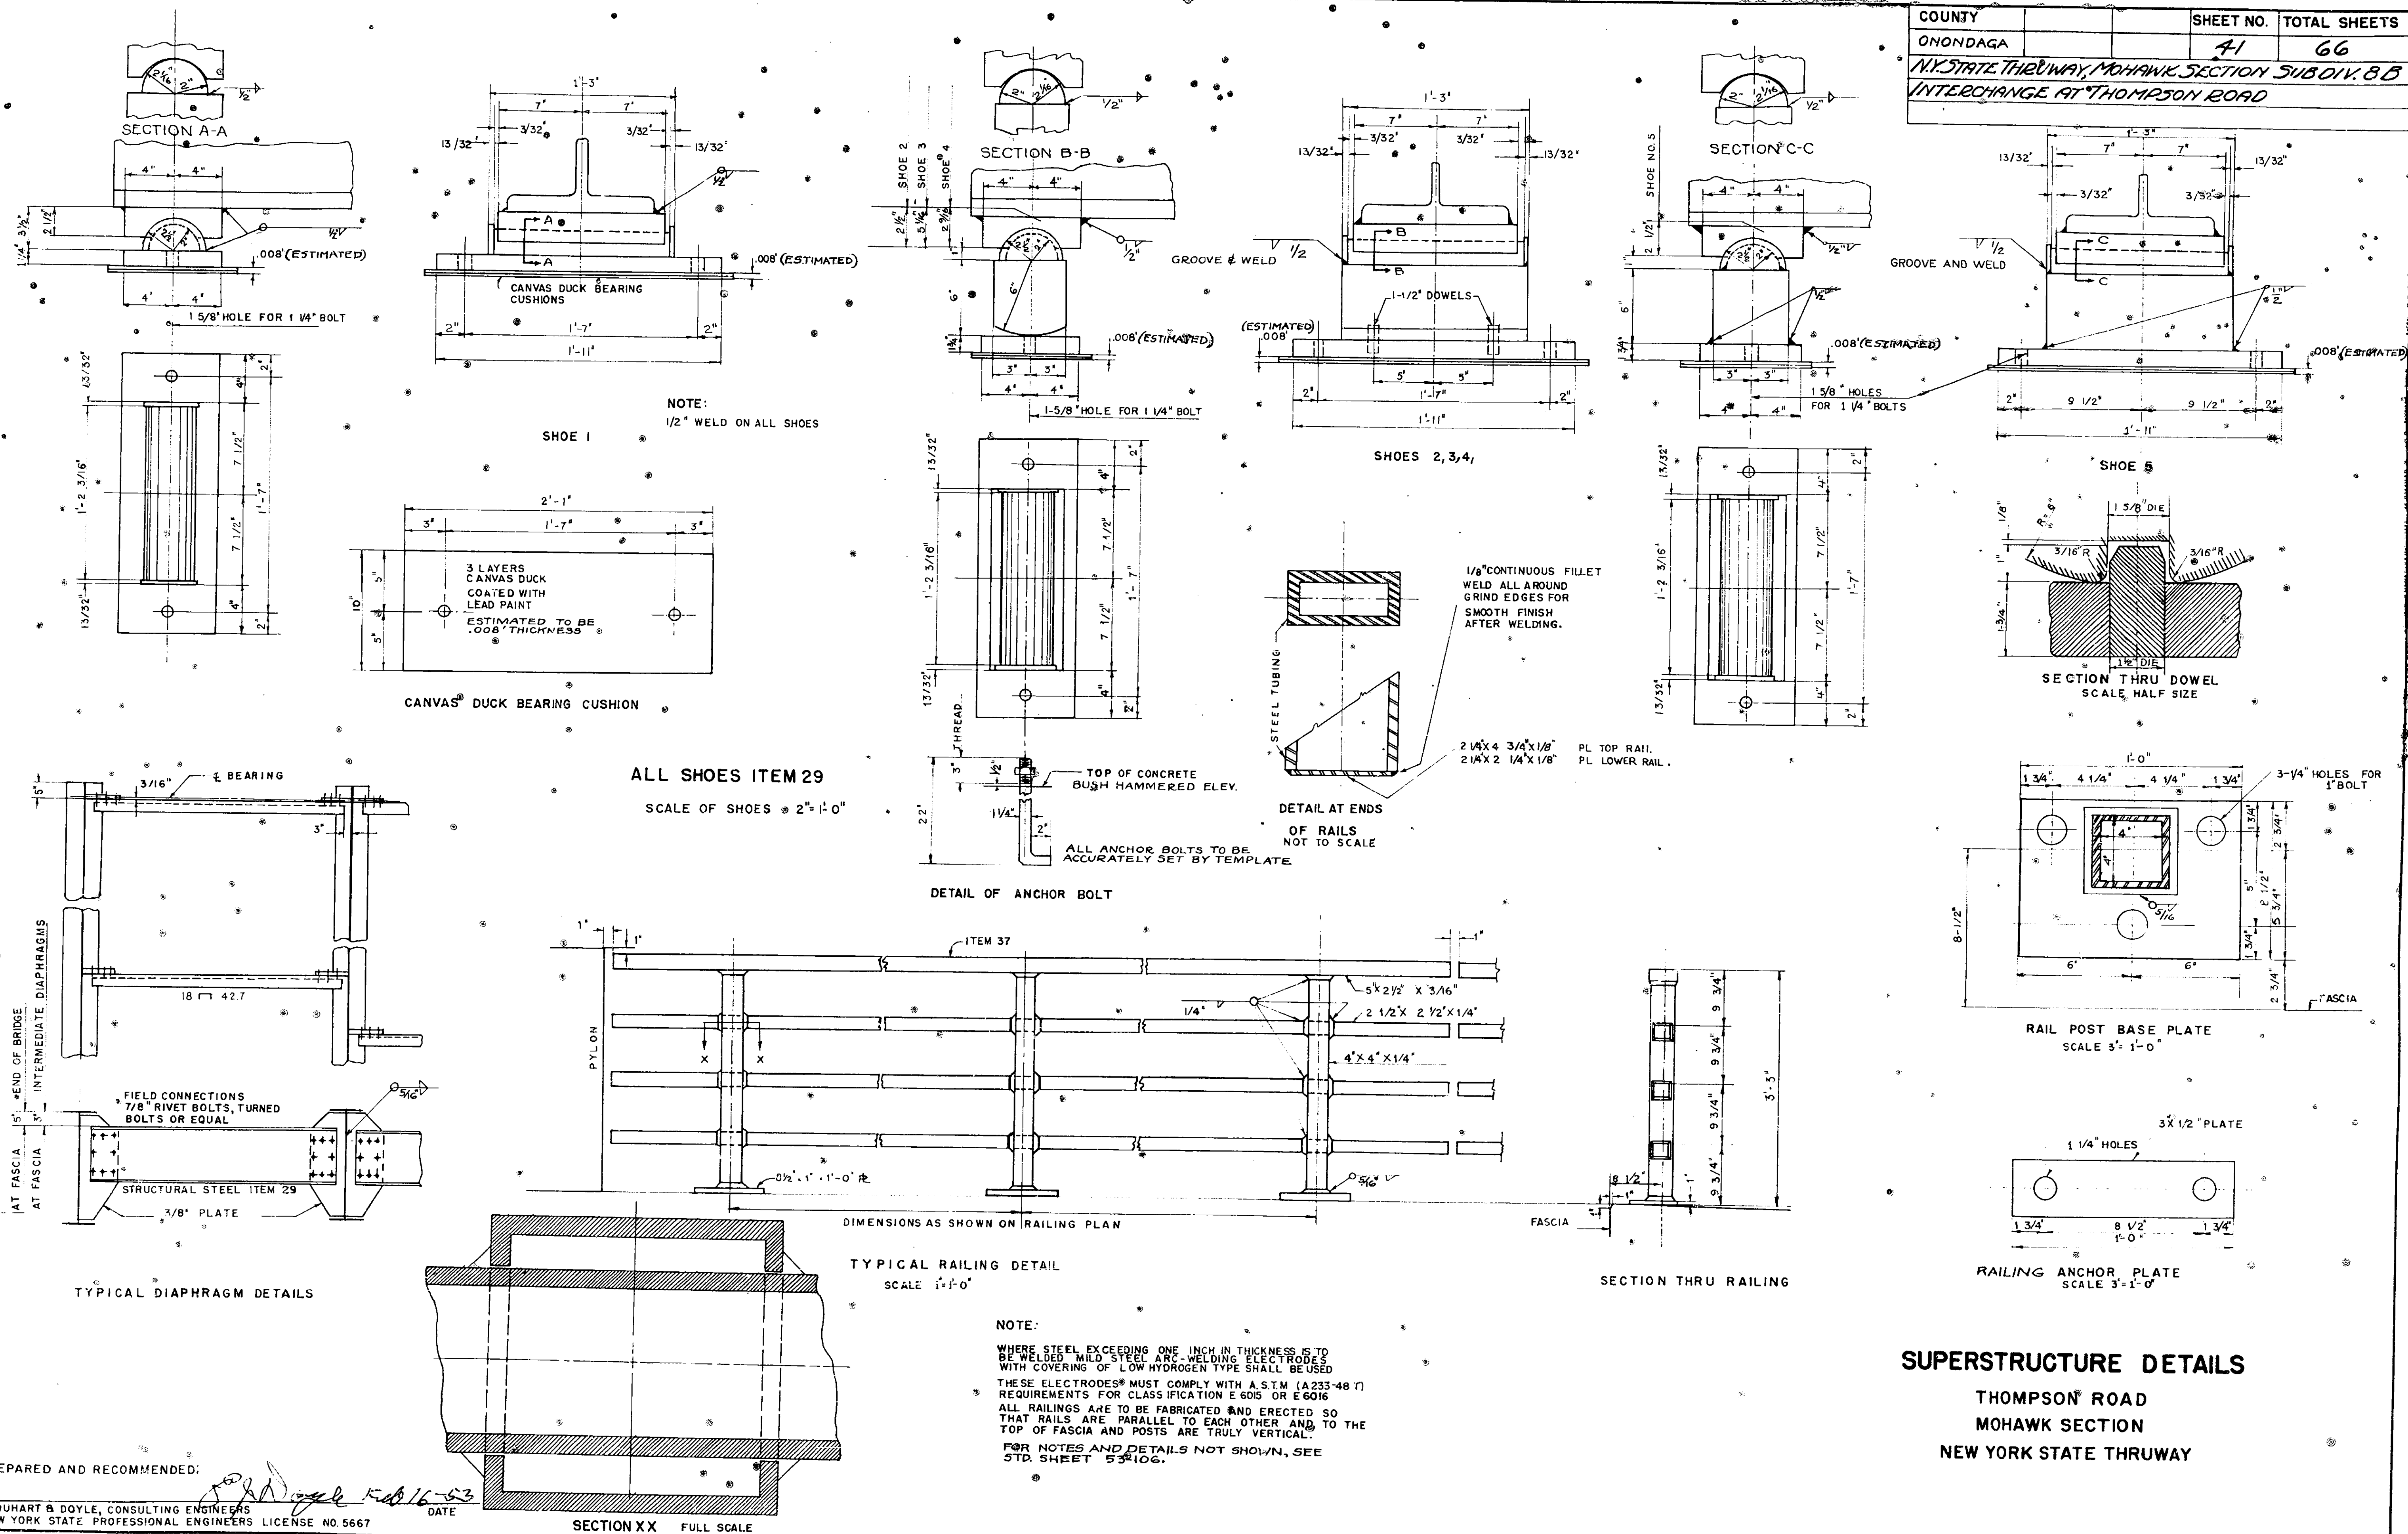

SUPERSTRUCTURE DETAILS

THOMPSON ROAD
MOHAWK SECTION
NEW YORK STATE THRUWAY

COUNTY	SHEET NO.	TOTAL SHEETS
ONONDAGA	42	66
N.Y. STATE THRUWAY, MOHAWK SECTION, SUBDIV. B.B.		
INTERCHANGE AT THOMPSON ROAD		

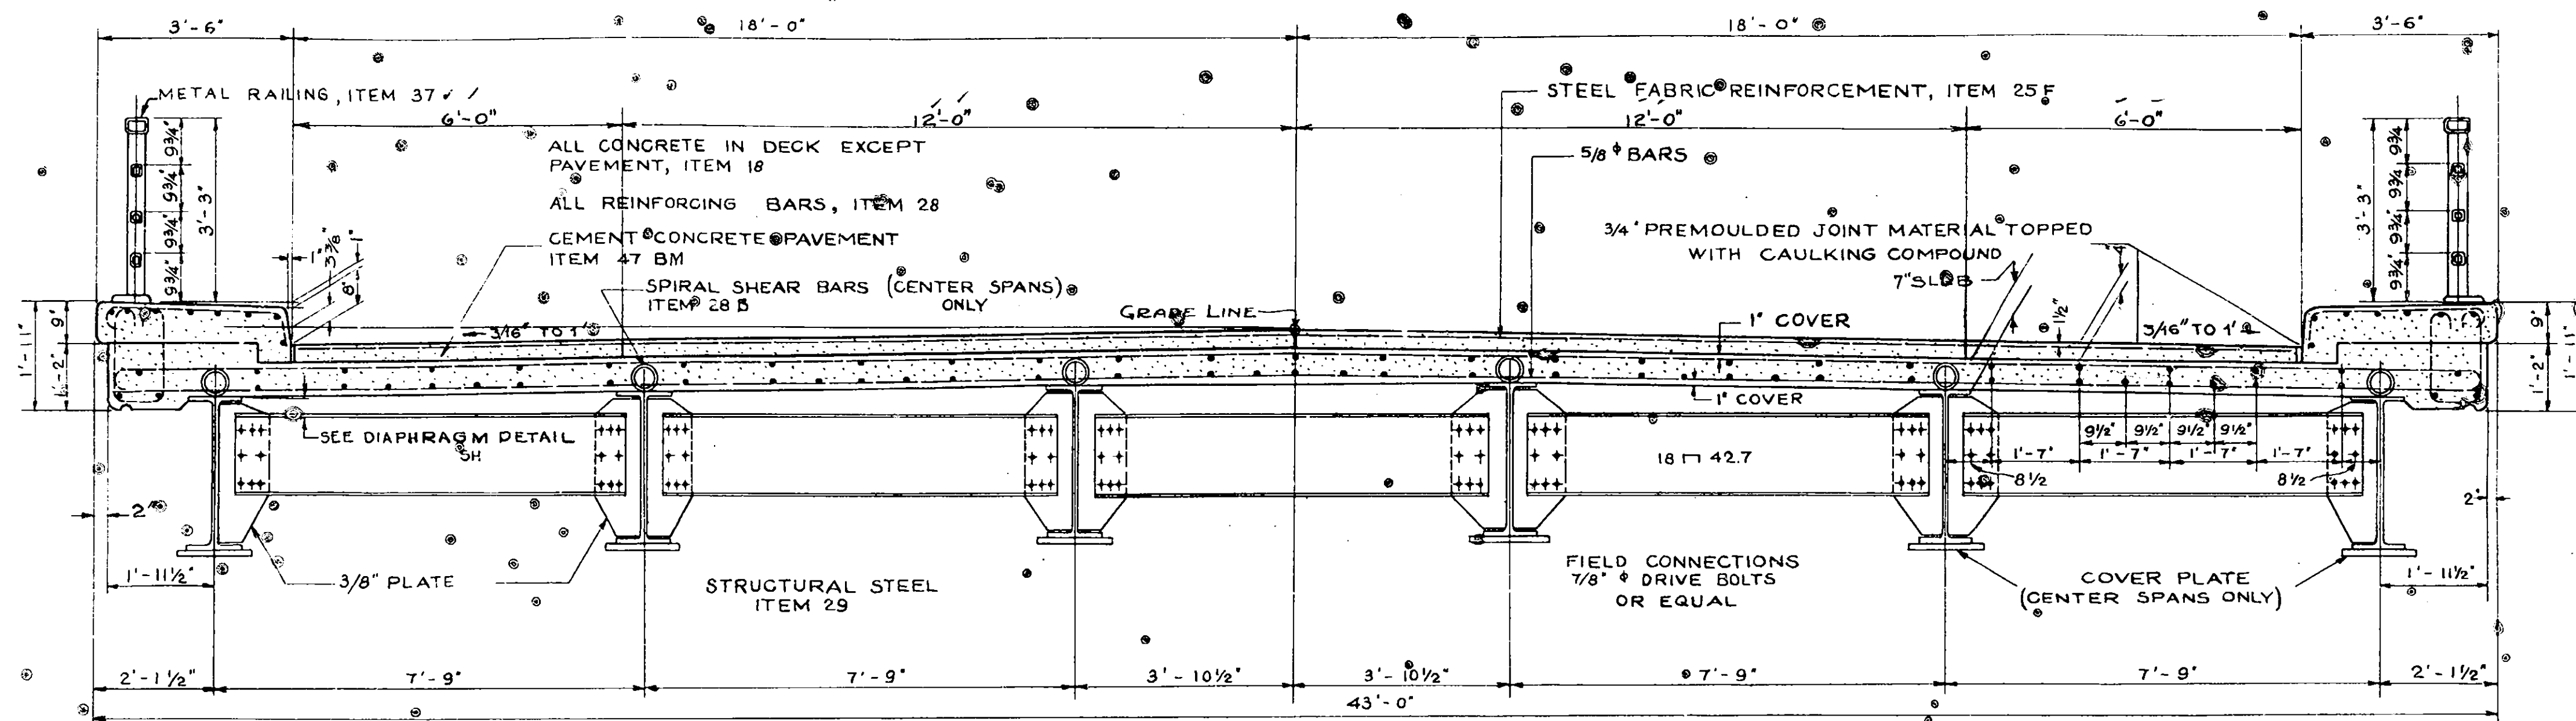


TRANSVERSE SECTION
SCALE 1/2\" = 1'-0"

NOTE:
IMMEDIATELY BEFORE PLACING CONCRETE PAVEMENT, THE CONCRETE SURFACE OR SURFACES UPON WHICH IT IS TO BE PLACED SHALL BE THOROUGHLY WETTED DOWN CONTINUOUSLY FOR ONE HOUR IF THE AIR TEMPERATURE IS ABOVE 50°F. COST OF SAME TO BE UNDER ITEM 1WA.

CEMENT IN ITEM 47BM TO BE PORTLAND CEMENT TYPE 1A, ITEM 15-BA.


CEMENT IN ITEMS 18 & 19 TO BE 7 PARTS PORTLAND CEMENT, TYPE 2, ITEM 15-2 AND ONE PART NATURAL CEMENT TYPE 1, ITEM 15-1.

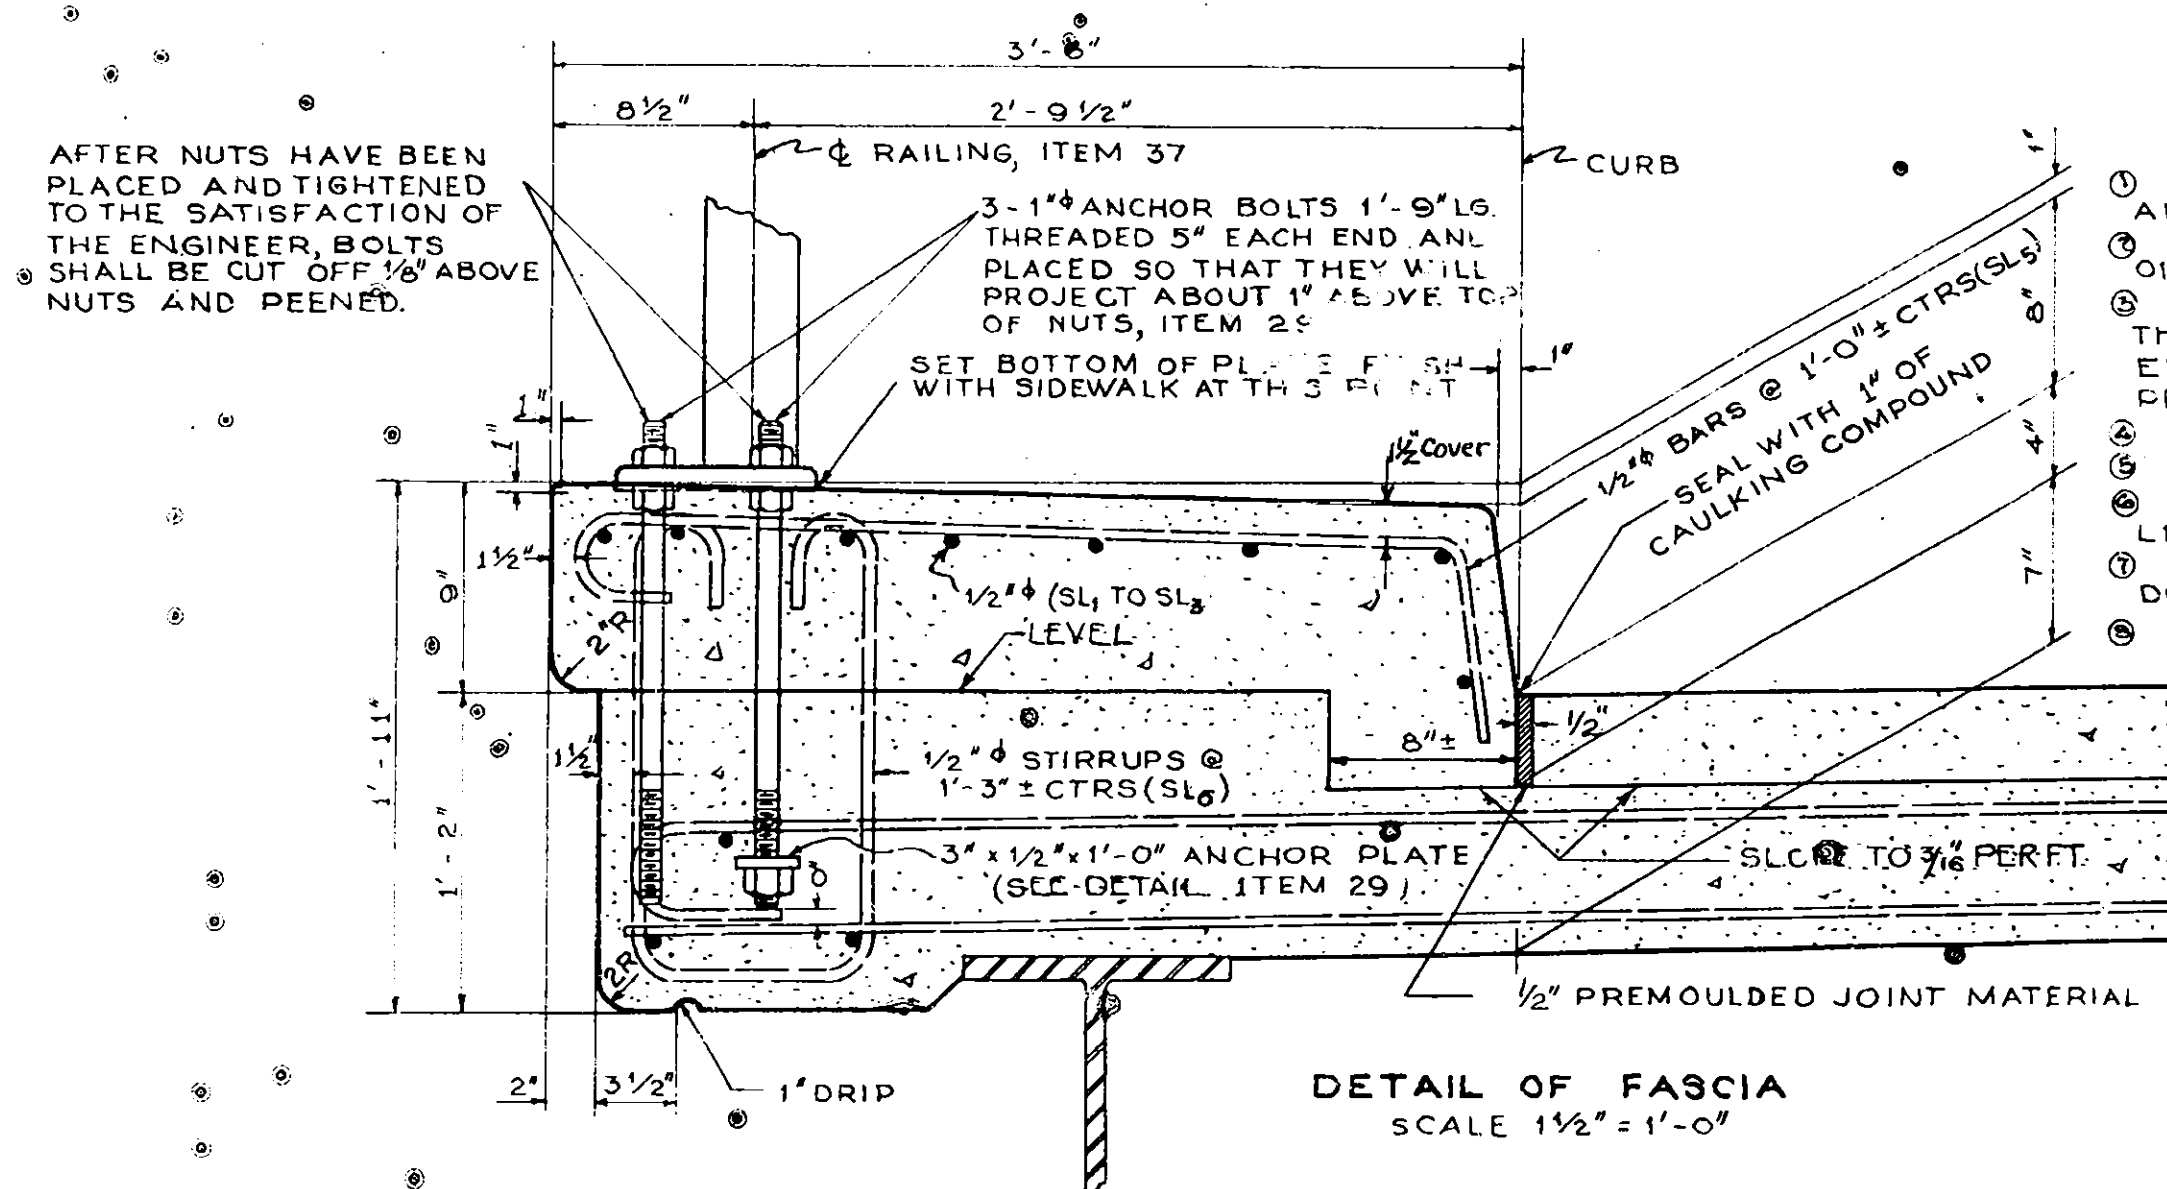

DETAIL OF FASCIA
SCALE 1 1/2\" = 1'-0"


CONSTRUCTION PROCEDURE

1. SET ANCHOR BOLTS BY MEANS OF TEMPLATE AND POUR SLAB.
2. MAKE TWO APPLICATIONS OF WATER-PROOFING OIL TREATMENT M-41-W TO THE TOP OF SLAB.
3. THE TOP OF THE SLAB SHALL BE CONTINUOUSLY AND THOROUGHLY WETTED DOWN, AS DIRECTED BY THE ENGINEER FOR AT LEAST ONE HOUR, IMMEDIATELY PRIOR TO THE PLACING OF THE ROADWAY PAVEMENT.
4. POUR ROADWAY PAVEMENT.
5. PLACE LOWER NUTS ON UPPER END OF ANCHOR BOLTS.
6. PLACE RAILING ON LOWER NUTS AND ADJUST TO LINE AND GRADE.
7. PLACE UPPER NUTS ON ANCHOR BOLTS TIGHTEN DOWN ON PLATES.
8. POUR SIDEWALK TO PROPER LINE AND GRADE.

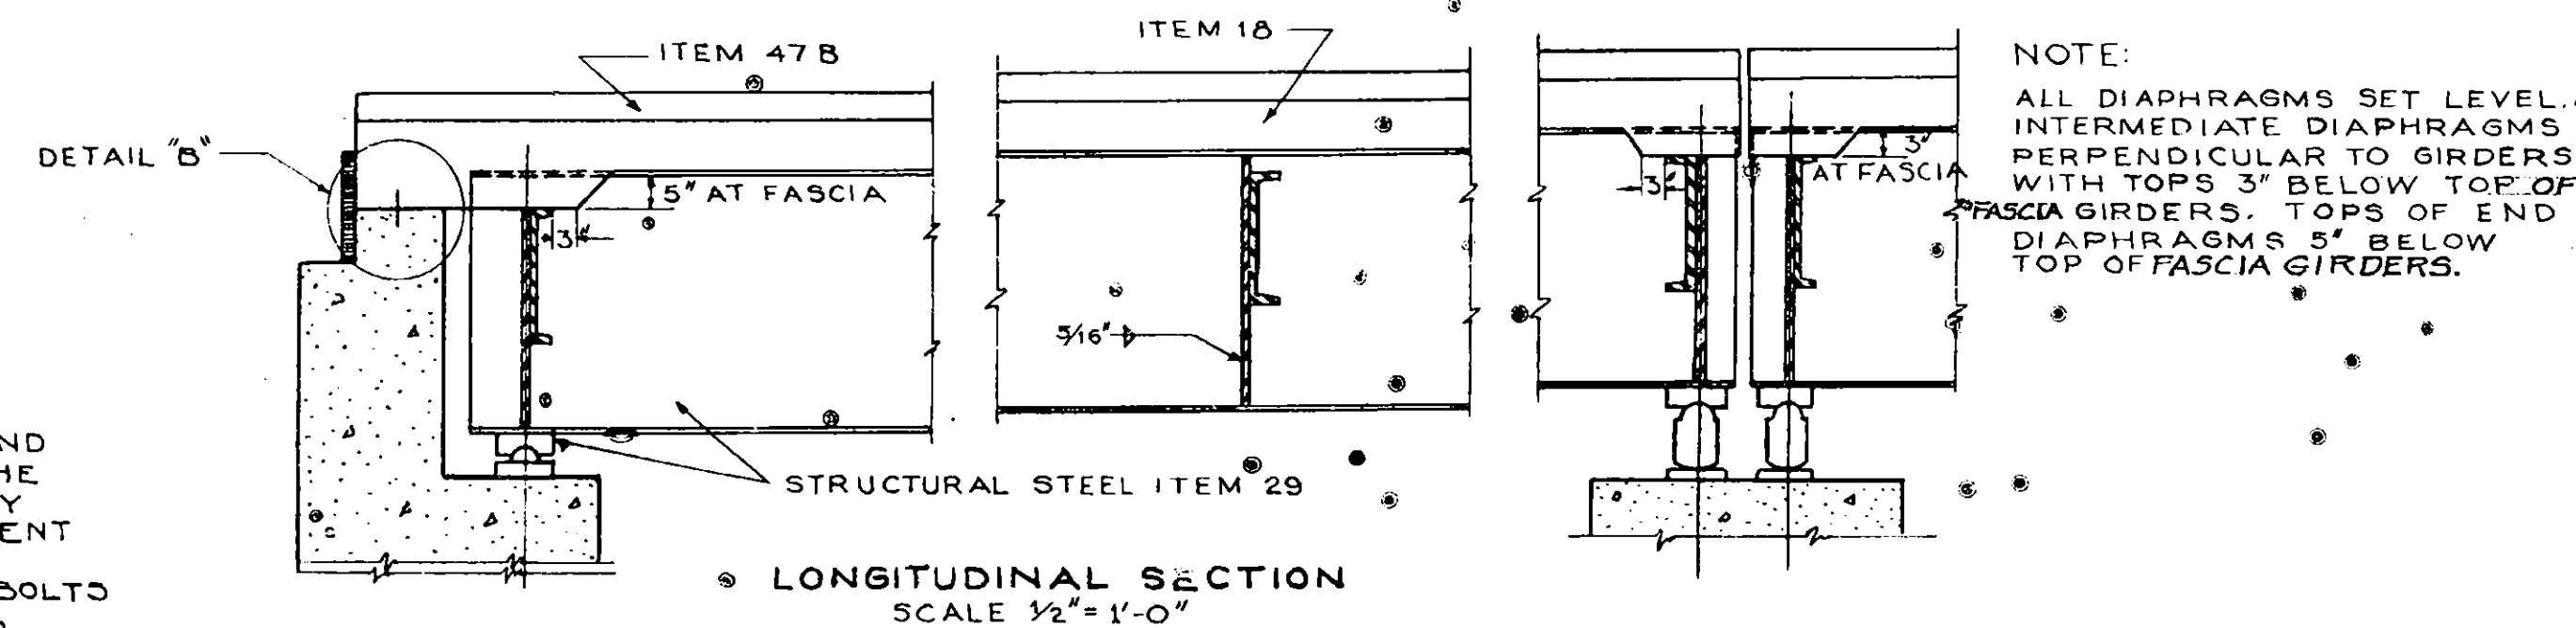


LONGITUDINAL SECTION
SCALE 1/2\" = 1'-0"

NOTE:
ALL DIAPHRAGMS SET LEVEL. INTERMEDIATE DIAPHRAGMS PERPENDICULAR TO GIRDERS WITH TOPS 3\"/>

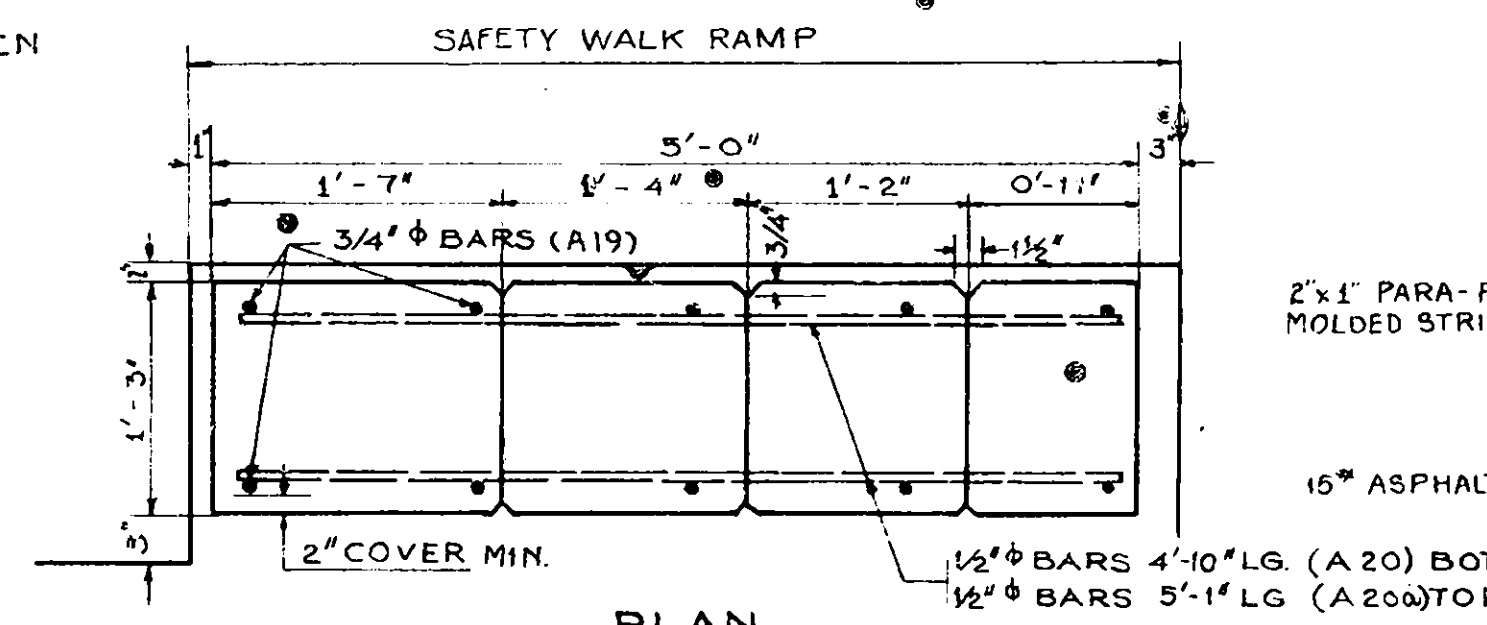


PLAN
SCALE 1\" = 1'-0"

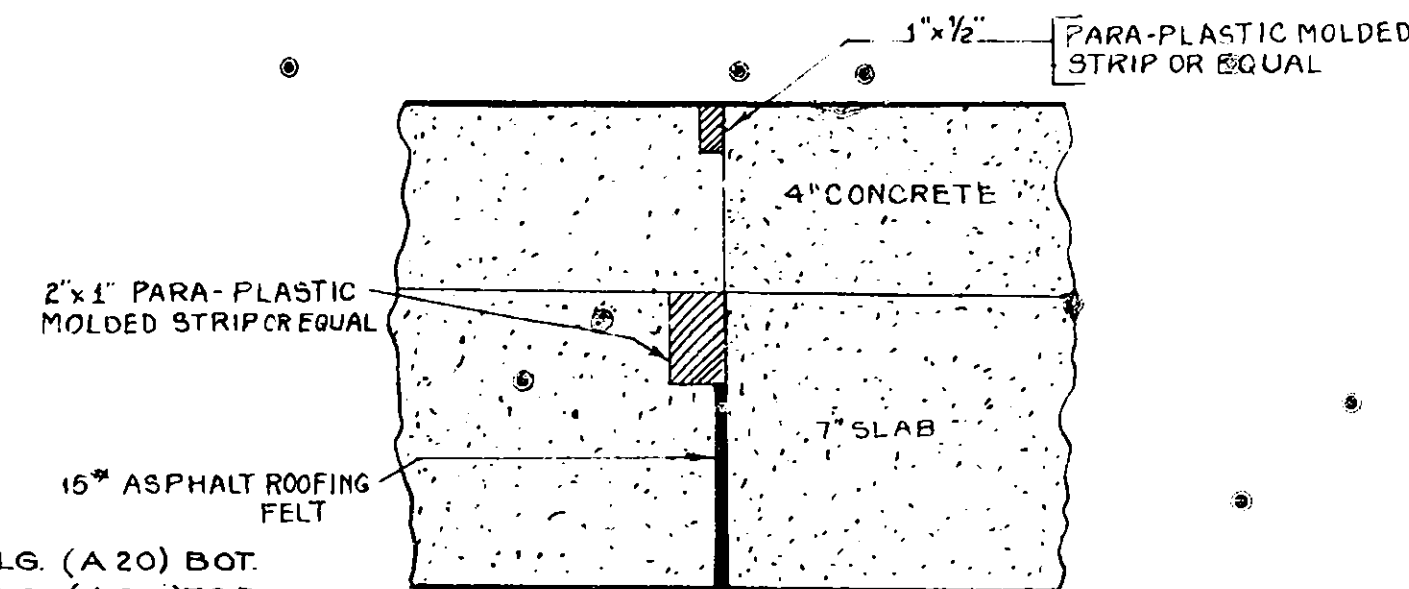


DETAIL OF JOINT OVER CENTER PIER
SCALE: 3\" = 1'-0"


NOTE:
FLASHINGS OR WATERSTOPS ARE TO BE PROTECTED FROM DAMAGE DURING THE COURSE OF CONSTRUCTION AS ORDERED BY THE ENGINEER. BENDING OR ALTERING THE SHAPE AS SHOWN IN ANY MANNER WILL NOT BE ALLOWED.

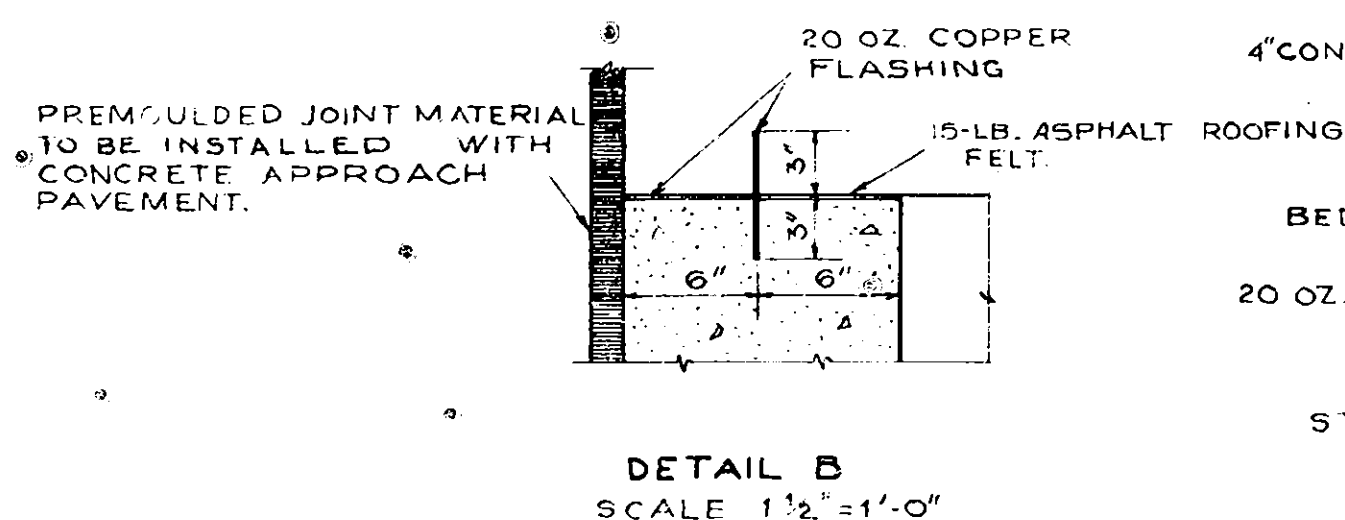

DETAIL B
SCALE 1 1/2\" = 1'-0"

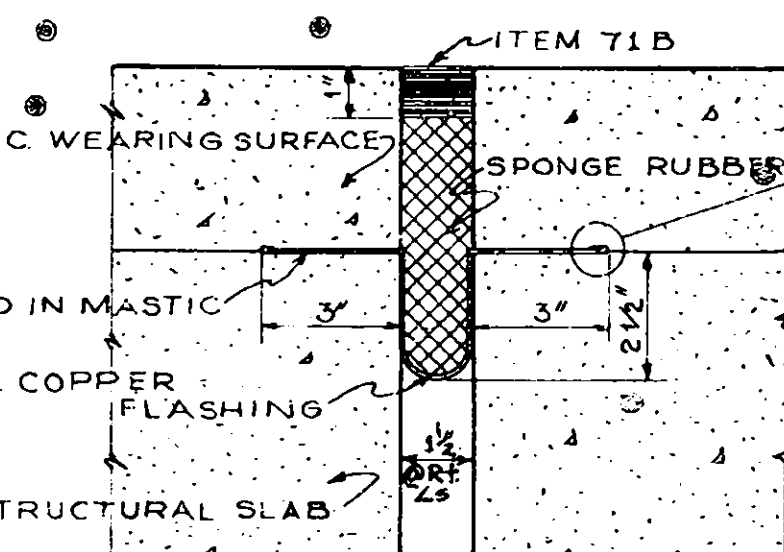


DETAIL OF JOINT OVER N-S PIERS
SCALE 3\" = 1'-0"

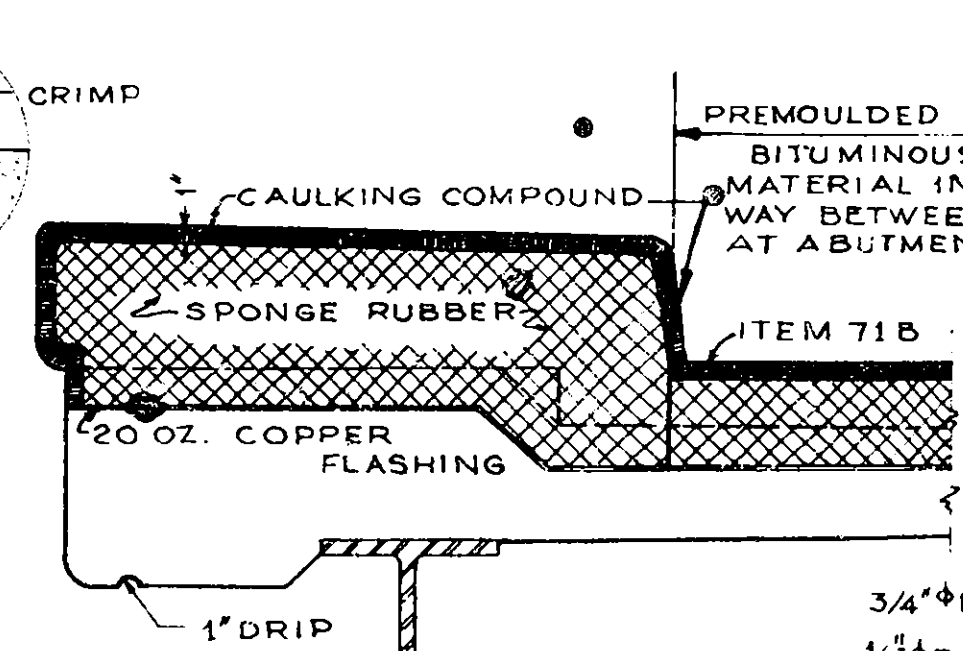

SECTION THRU SAFETY WALK AT JOINT
SCALE 1\" = 1'-0"

NOTE:
SPONGE RUBBER SHALL COMPLY WITH THE REQUIREMENTS FOR PREFORMED EXPANSION JOINT FILLERS FOR CONCRETE, A.S.T.M. DESIGNATION D 544.
ASPHALT ROOFING FELT SHALL COMPLY WITH THE REQUIREMENTS OF THE STANDARD SPECIFICATIONS OF A.S.T.M., DESIGNATION D 266.

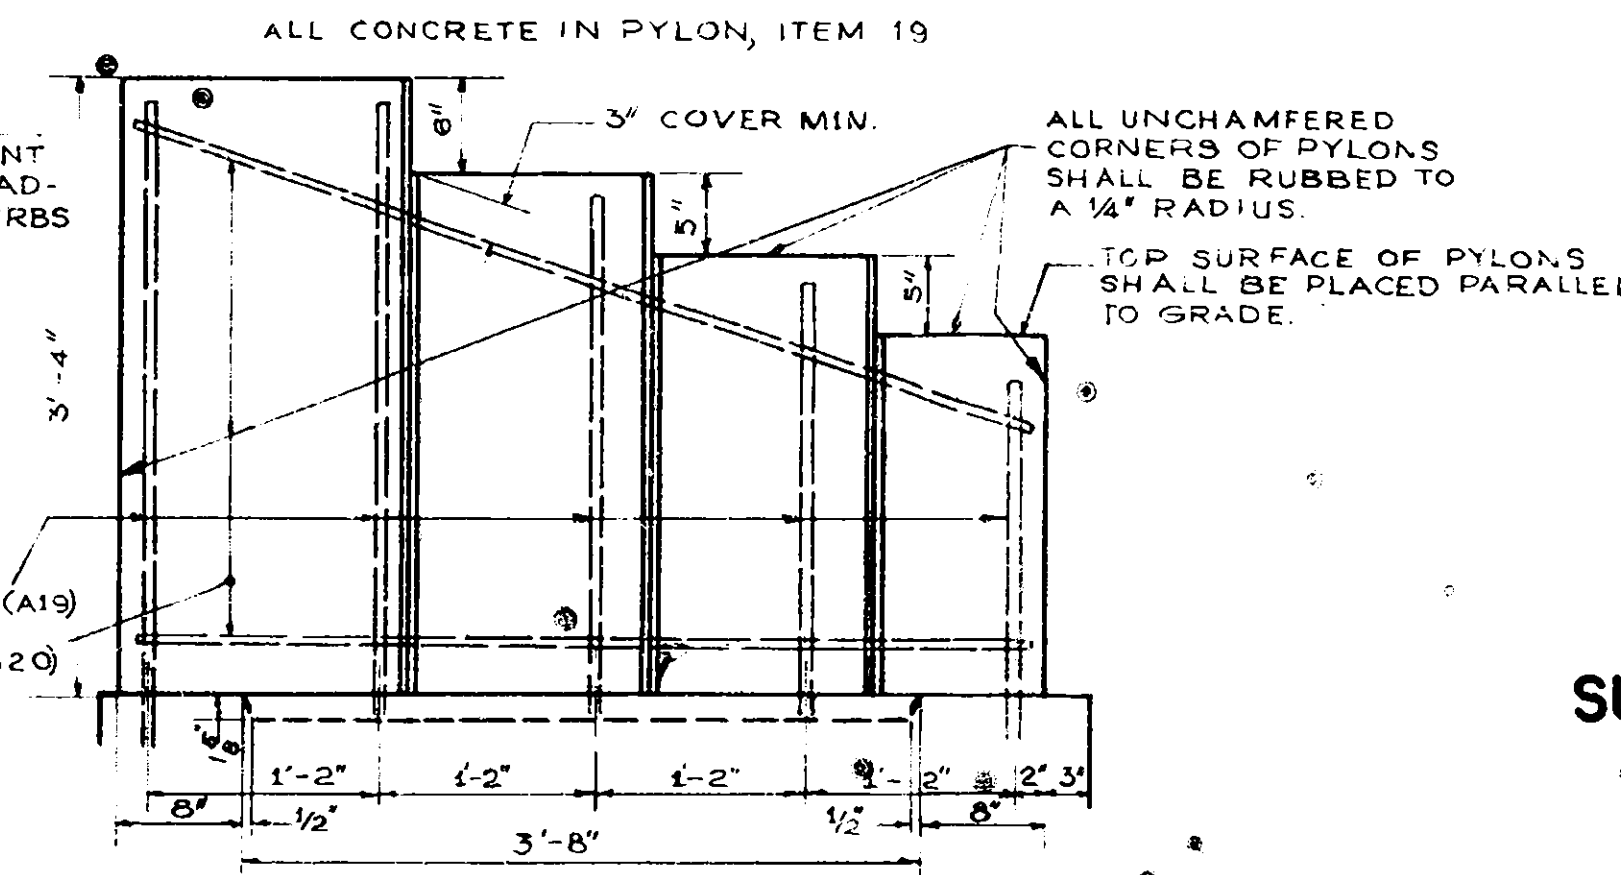

ELEVATION OF PYLON
SCALE 1\" = 1'-0"

SUPERSTRUCTURE DETAILS

THOMPSON ROAD

MOHAWK SECTION


NEW YORK STATE THRUWAY

PREPARED AND RECOMMENDED:

URDUHART & DOYLE, CONSULTING ENGINEERS
NEW YORK STATE PROFESSIONAL ENGINEERS LICENSE NO. 5667

DATE

SHEET 42

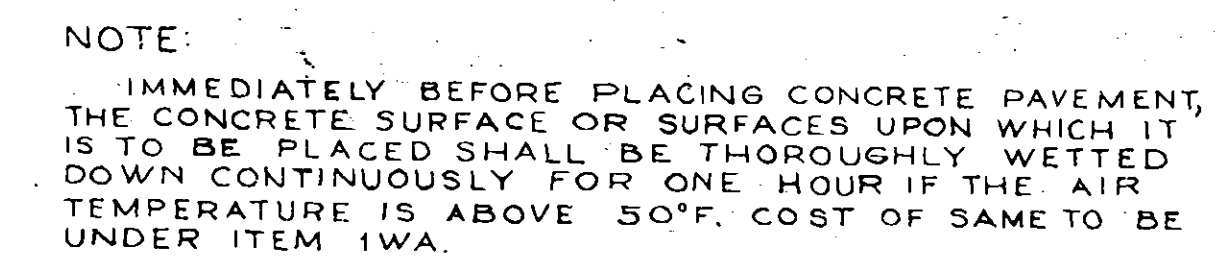

CEMENT IN ITEM 478M TO BE PORTLAND CEMENT
TYPE 1A, ITEM 15-BA.

CEMENT IN ITEMS 18 & 19 TO BE 7 PARTS PORTLAND CEMENT, TYPE 2, ITEM 15-2 AND ONE PART NATURAL CEMENT TYPE N, ITEM 15 N.

DETAIL "B"

ITEM 47 B

5' AT FASCIA

3"

STRUCTURAL STEEL ITEM 29


ITEM 16

5/16"


NOTE:
ALL DIAPHRAGMS SET LEVEL.
INTERMEDIATE DIAPHRAGMS
PERPENDICULAR TO GIRDERS
WITH TOPS 3" BELOW TOP OF
FASCIA GIRDERS. TOPS OF END
DIAPHRAGMS 5' BELOW
TOP OF FASCIA GIRDERS.

LONGITUDINAL SECTION
SCALE 1/2" = 1'


NOTE:
ALL DIAPHRAGMS SET LEVEL.
INTERMEDIATE DIAPHRAGMS
PERPENDICULAR TO GIRDERS
WITH TOPS 3' BELOW TOP OF
FASCIA GIRDERS. TOPS OF END
DIAPHRAGMS 5' BELOW
TOP OF FASCIA GIRDERS.

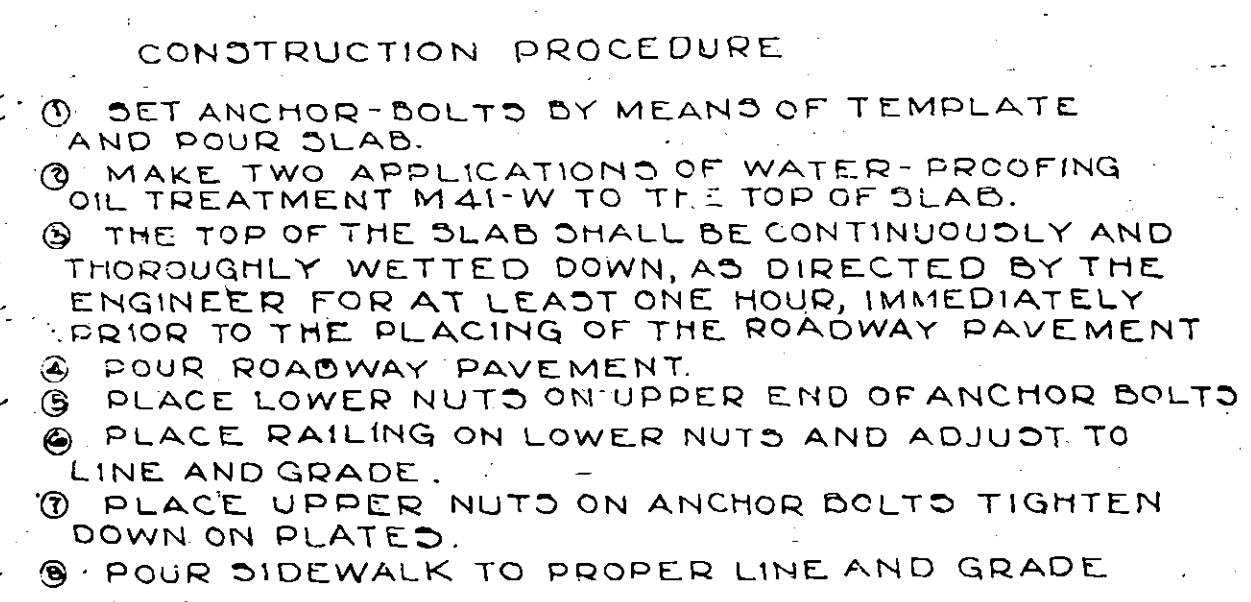

DETAIL OF FASCIA
SCALE 1 1/2" = 1'-0"

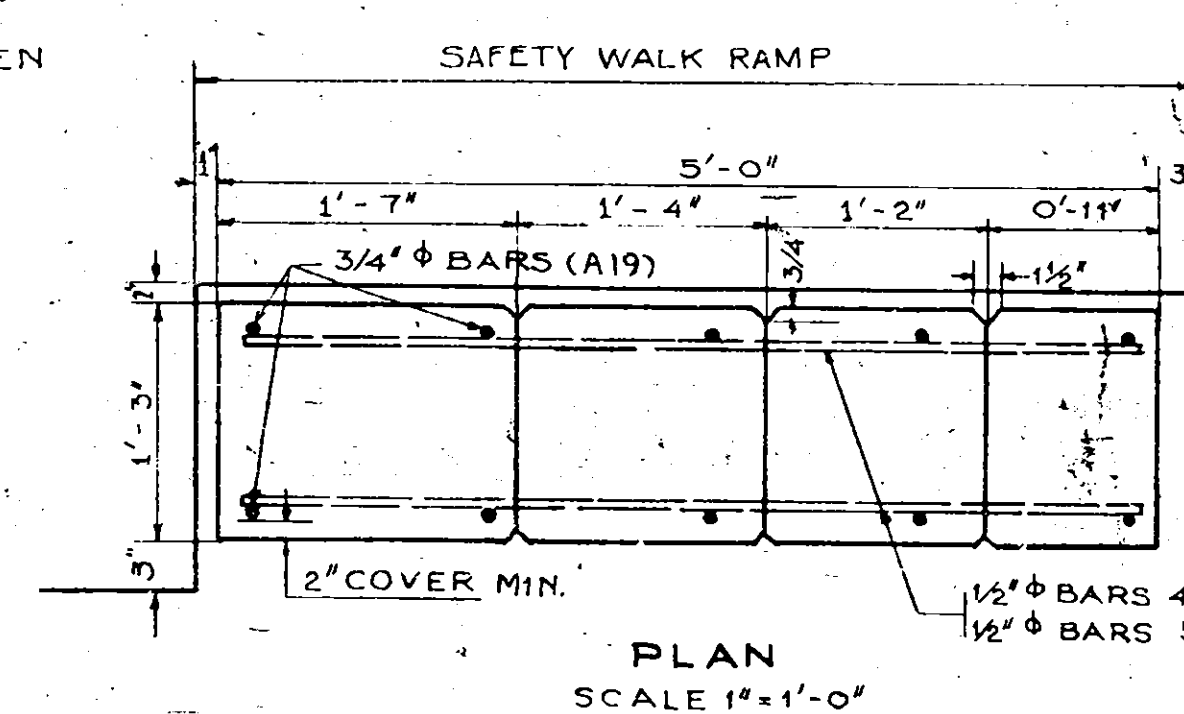


PLAN
SCALE 1" = 1'-0"

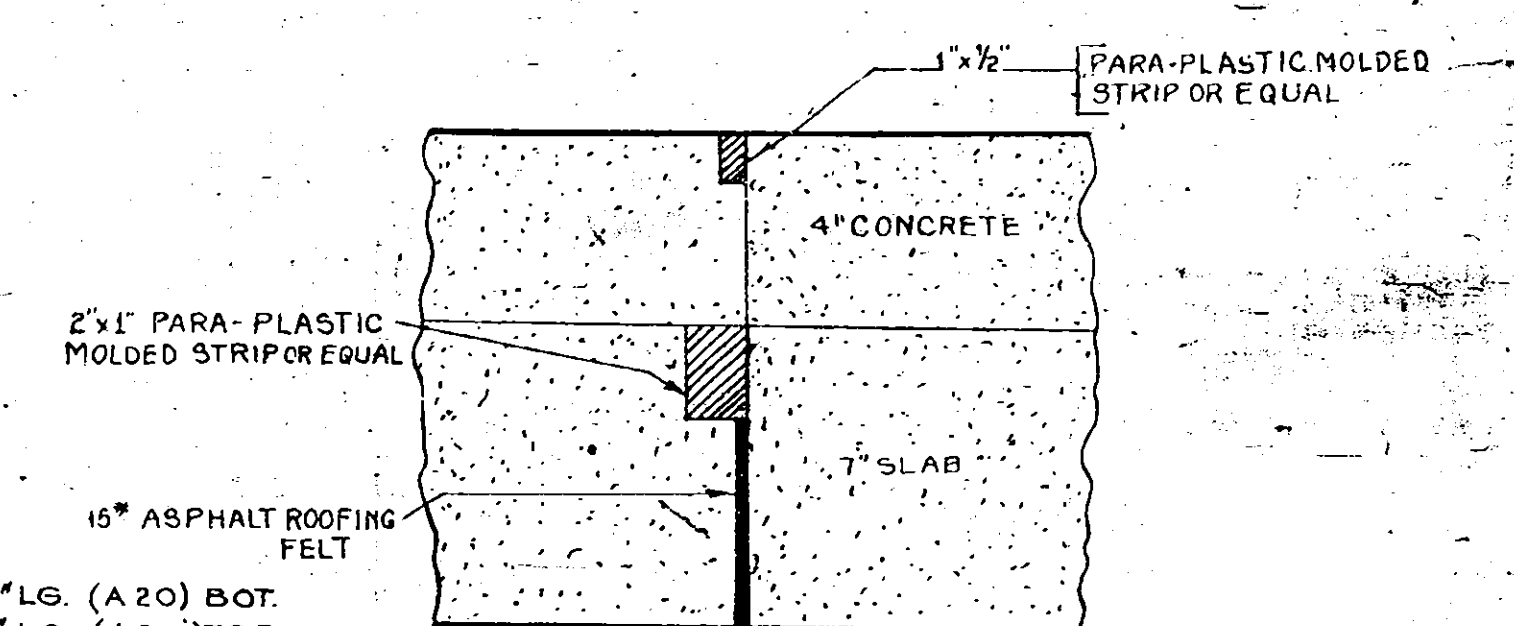


DETAIL OF JOINT OVER CENTER PIER
SCALE: 3" = 1'-0"

NOTE:
FLASHINGS OR WATERSTOPS ARE TO BE PROTECTED FROM DAMAGE DURING THE COURSE OF CONSTRUCTION AS ORDERED BY THE ENGINEER. BENDING OR ALTERING THE SHAPE AS SHOWN IN ANY MANNER WILL NOT BE ALLOWED.

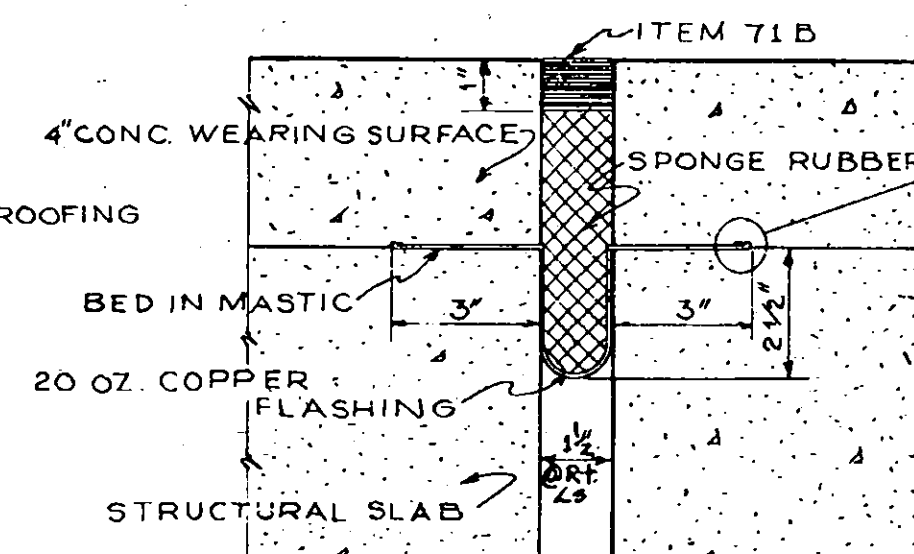

DETAIL B
SCALE 1 1/2" = 1'-0"

DETAIL OF JOINT OVER N-S PIERS
SCALE 3" = 1'-0"

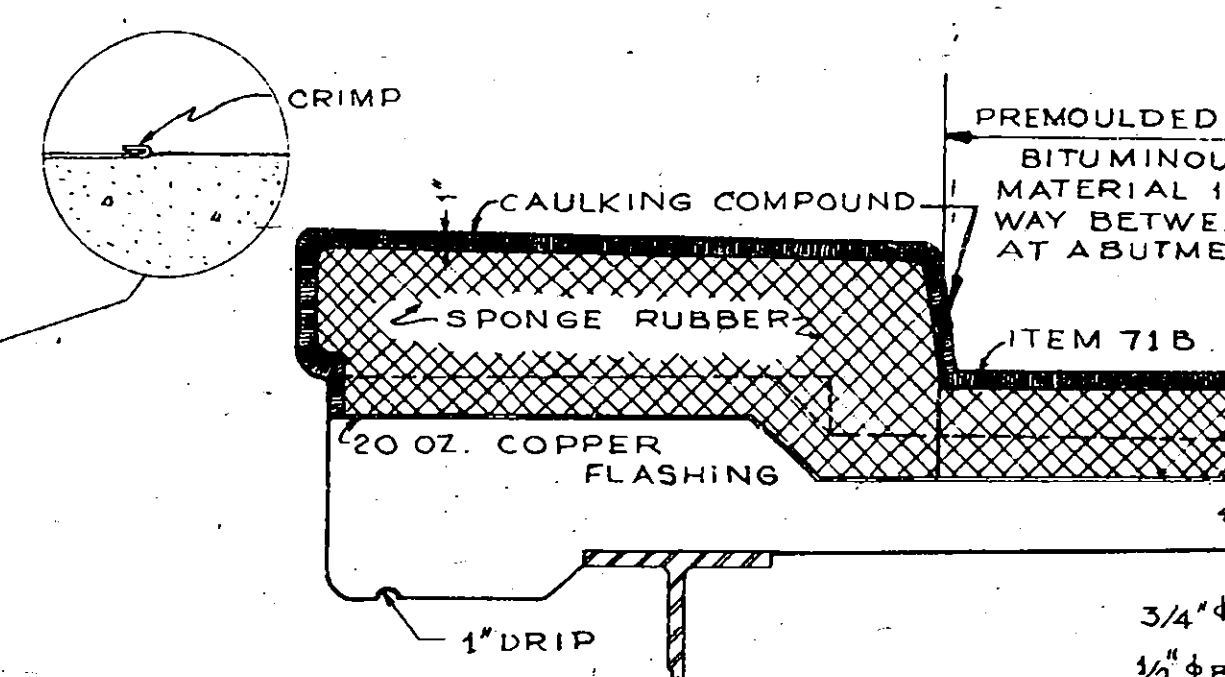


SECTION THRU SAFETY WALK AT JOINT
SCALE 1"=1'-0"

NOTE:

SPONGE RUBBER SHALL COMPLY WITH THE REQUIREMENTS FOR PREFORMED EXPANSION JOINT FILERS FOR CONCRETE, A S T M DESIGNATION D 544

ASPHALT ROOFING FELT SHALL COMPLY WITH THE REQUIREMENTS OF THE STANDARD SPECIFICATIONS OF A S T M DESIGNATION D 266.

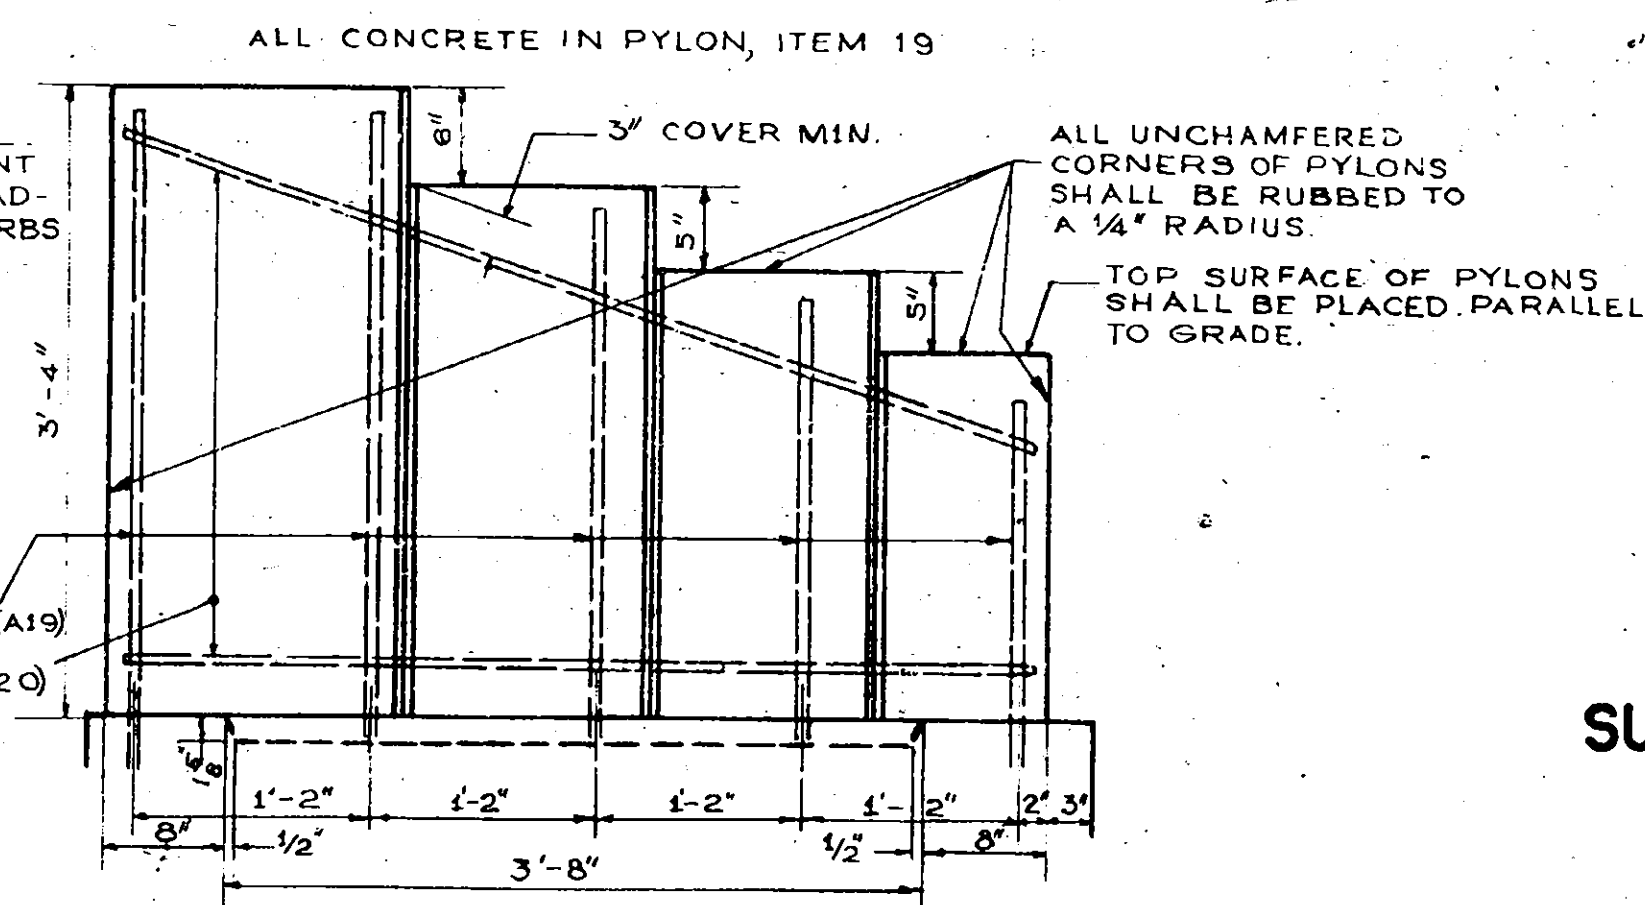

ELEVATION OF PYLON
SCALE 1" = 1'-0"

PREPARED AND RECOMMENDED:

UNOCHART & DOYLE, CONSULTING ENGINEERS
NEW YORK STATE PROFESSIONAL ENGINEERS LICENSE NO. 5663

COUNTY	SHEET NO.	TOTAL SHEETS
ONONDAGA	43	66
N.Y. STATE THRUWAY, MOHAWK SECTION SUBDIV. B B INTERCHANGE AT THOMPSON ROAD		


SUPERSTRUCTURE BAR LIST

MARK	SIZE	NO.	LENGTH	TYPE	A	B	C	LOCATION	MARK	SIZE	NO.	LENGTH	TYPE	A	B	C	LOCATION
L1	5/8	54	40-10	STR				TOP OF DECK SLAB (LONG)									
L1		78	40-10					BOTTOM									
L2		54	31-0					TOP									
L2		78	31-0					BOTTOM									
L3		54	34-9					TOP									
L3		78	34-9					BOTTOM									
L4		364	43-8	I	42-5	0-5	0-10	TOP									
L5		364	42-5	STR				BOTTOM									
L6		8	2-1	II	1-5 1/2	0-5	0-10	TOP									
L7			3-10		3-2												
L8			5-6		4-10												
L9			7-3		6-7												
L10			8-11		8-3 1/2												
L11			10-8		10-0												
L12			12-4		11-8 1/2												
L13			14-1		13-5												
L14			15-9		15-1 1/2												
L15			17-6		16-10												
L16			19-2		18-6 1/2												
L17			20-11		20-3												
L18			22-7		21-11 1/2												
L19			24-4		23-8												
L20			26-0		25-4 1/2												
L21			27-9		27-1												
L22			29-5		28-9 1/2												
L23			31-2		30-6												
L24			32-10		32-2 1/2												
L25			34-7		33-11												
L26			36-3		35-7 1/2												
L27			38-0		37-4												
L28			39-8		39-0												
L29			41-5		40-9												
L30			1-5 1/2	STR				BOTTOM									
L31			3-2														
L32			4-10														
L33			6-7														
L34			8-3														
L35			10-0														
L36			11-8														
L37			13-5														
L38			15-1 1/2														
L39			16-10														
L40			18-6 1/2														
L41			20-3														
L42			21-11 1/2														
L43			23-8														
L44			25-4														
L45			27-1														
L46			28-9														
L47			30-6														
L48			32-2														
L49			33-11														
L50			35-7														
L51			37-4														
L52			39-0														
L53			40-9														
E1			26-8	II	22-10 (1-0 1/2)	3-10		ACUTE CORNERS									
E2			26-8	III	22-10 (1-0 1/2)	3-10		OBTUSE "									
A20		8	4-10	STR				PYLONS									
A20		8	5-1														
SL1	1/2	32	40-10	STR				SIDEWALKS END SPANS									
SL2		32	31-0					NORTH CENTER SPAN									
SL3		32	34-9					SOUTH CENTER SPAN									
SL4		420	4-6	XI				ALL SPANS									
SL5		326	4-7	VII	0-10	0-3	1-7	ALL SPANS									

SUBSTRUCTURE BAR LIST

MARK	SIZE	NO.	LENGTH	TYPE	A	B	C	LOCATION
AF1	3/4	72	9-1	STR				ABUT. FOOTINGS & BACKWALL
AF2		48	6-7					" " & BRG. SEATS
AF3		84	11-3					WING WALLS
AF4		24	47-7					ABUT. FOOTINGS
AF11	1/2	40	5-3 1/2					WING WALL FOOTINGS
AF12	1/2	80	5-0					ABUT. FOOTINGS
PF1	1	108	9-0	II	8-0	0-8	1-4	PIER FOOTINGS
PF2	1 1/4	56	11-0	I	8-6	0-10	1-8	
PF3		8	9-10		7-6	0-10	1-8	
PF4		36	10-6		8-0	0-10	1-8	
PF5		20	10-4		7-10	0-10	1-8	
A1	3/4	16	47-0	STR				ABUT. BACKWALLS
A2		8	12-1	VII	12-0	2-6	0-6 1/2	WING WALLS SW-NE SE-NW
A3		8	18-0 1/2	VII	10-6	3-0	4-6 1/2	" " SE-NW SW-NE
A4	1/2	48	9-6	VII	2-4	0-4	3-2	BEARING SEATS
A6	1/2	28	4-6	STR				WING WALLS
A7		8	6-10					
A8		8	11-6					
A10	3/4	40	7-0	STR				PYLON DOWELS
P1	1	36	15-5	STR				PIER COLUMNS N PIER
P2			16-2					C "
P3			15-2					S "
P4	1/4	63	30-0	X	11-7			N "
P5		60			12-4			C "
P6		63			11-4			S "
P7	1 1/4	24	11-0	STR				PIER CAPS
P8		6	48-4	II	42-2	2-10		
P8A		6	39-0	STR				
P9		12	30-5	IV	25-9	1-6	2-3	
P10		12	31-4		26-8	1-6	2-3	
P11		12	10-8		6-0	1-6	2-3	
P15	1/2	72	1-6	STR				PIER PADS
P16	1/2	36	10-0	V	2-0	0-3	2-8	" "
P17	5/8	36	21-4	STR				PIER CAPS
P18	5/8	30	10-5	VIII	3-0	3-0	4-5	" "
P19	1/2	168	13-8	V	2-1	0-3	3-8	" "
PL1	3/4	60	16-11	II	16-2	0-6	1-0	N. ABUT. (VERT. PILES)
		60	23-11		23-2			" (BATT. PILES)
		114	12-5		11-8			N. & C. PIER & S. ABUT. (VERT. PILES)
		252	17-5		16-8			" " (BATT. PILES)
		24	9-1		8-4			S. PIER (VERT. PILES)
		84	12-5		11-8			" (BATT. PILES)
PL2	1/4	1780	3-0	IX	0-8			ALL PILES (EST. FOR 12" STR. PILES)
AF5	3/4	8	10-6	STR				WING WALL TO ABUT. FOOTINGS
AF6			10-9					
AF7			11-1					
AF8			11-4					
AF9			11-7					
AF10			11-10					

BAR DETAILS

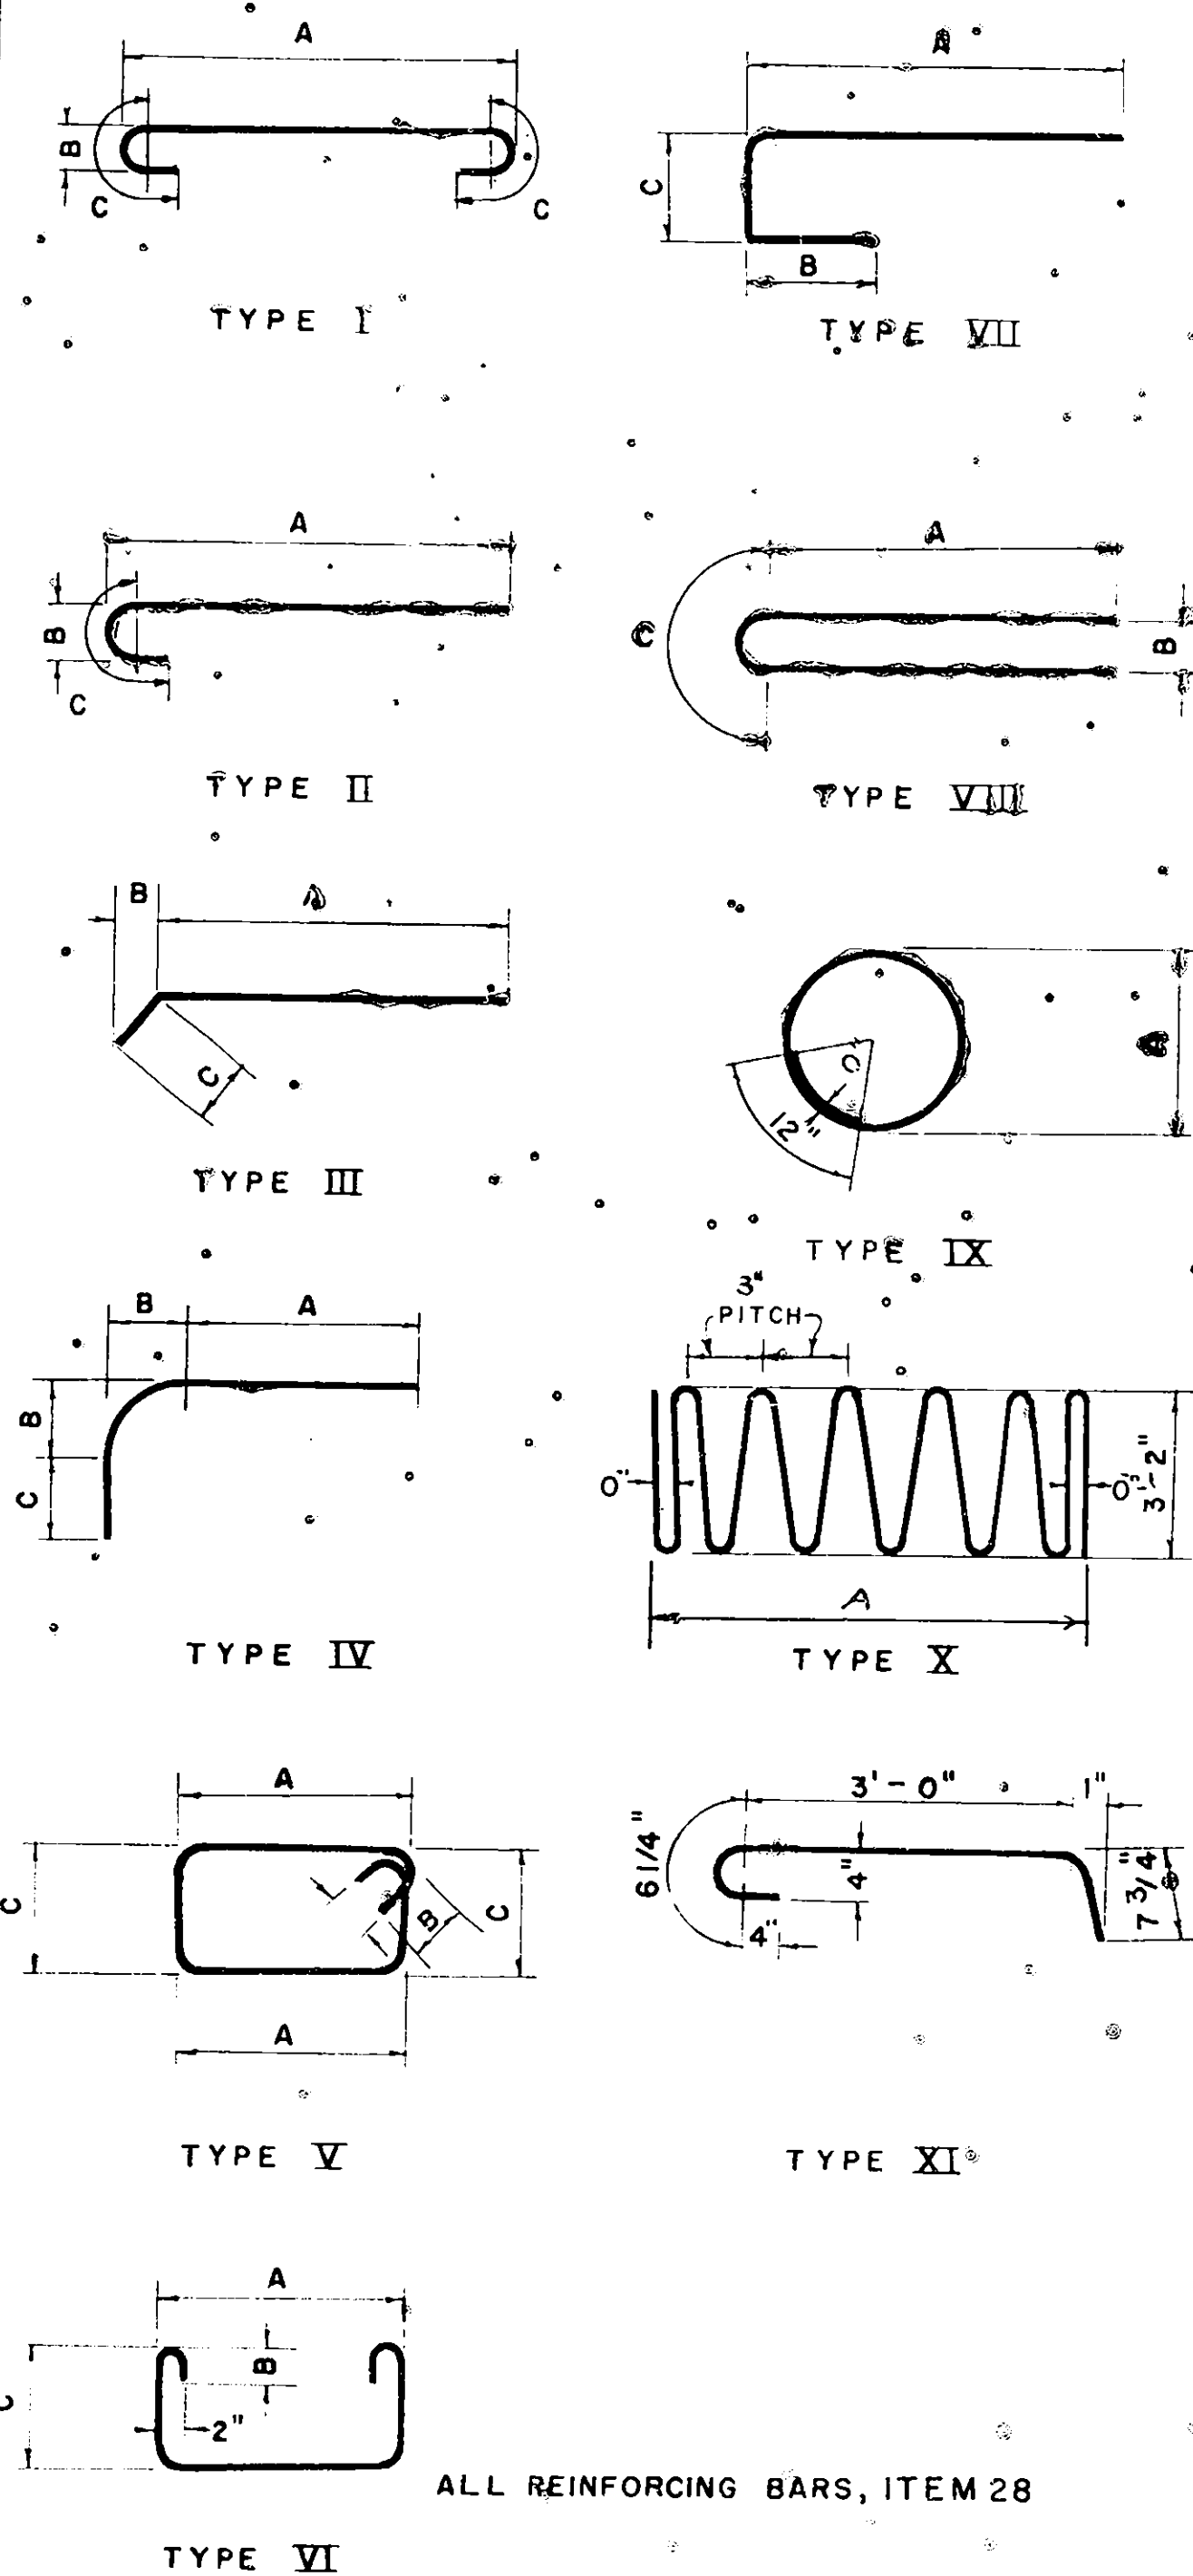

ALL REINFORCING BARS, ITEM 28

BAR LIST


THOMPSON ROAD
MOHAWK SECTION
NEW YORK STATE THRUWAY

PREPARED AND RECOMMENDED


UPCHART & DOYLE CONSULTING ENGINEERS
NEW YORK STATE PROFESSIONAL ENGINEERS LICENSE NO. 5667

DATE


COUNTY		SHEET NO.	TOTAL SHEETS
ONONDAGA		44	66
N.Y. STATE THRUWAY, MOHAWK SECTION, SUBDIV. 8B			
INTERCHANGE AT THOMPSON ROAD			

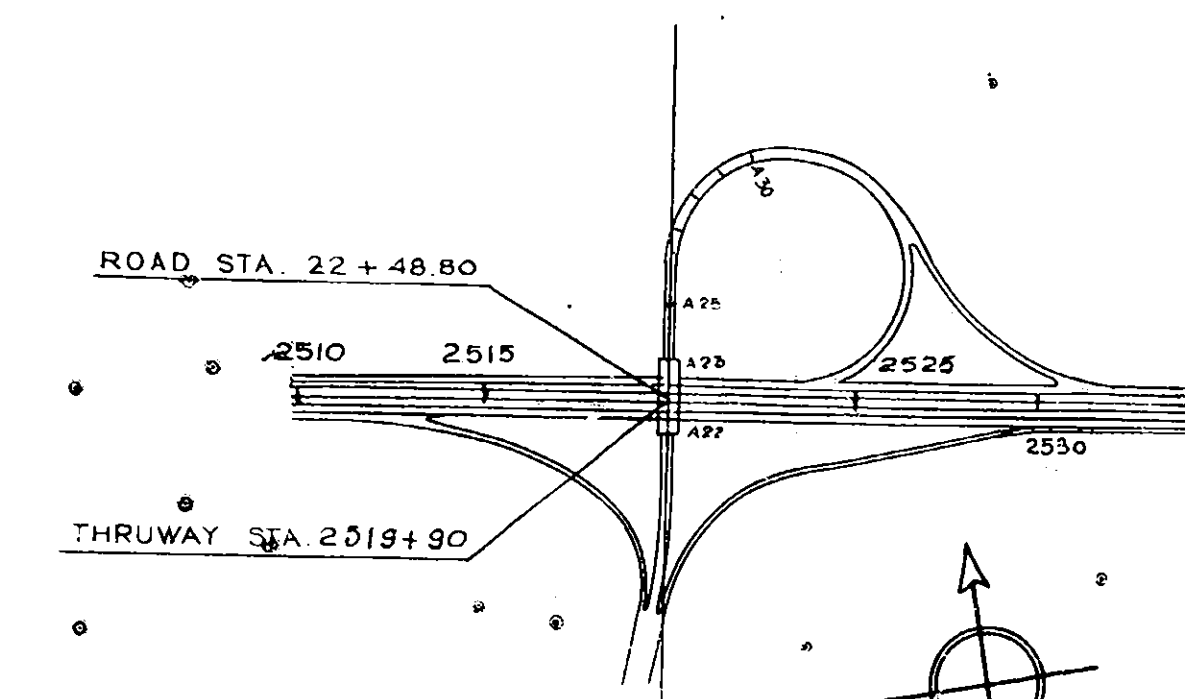


PLAN
SCALE 1"=500'

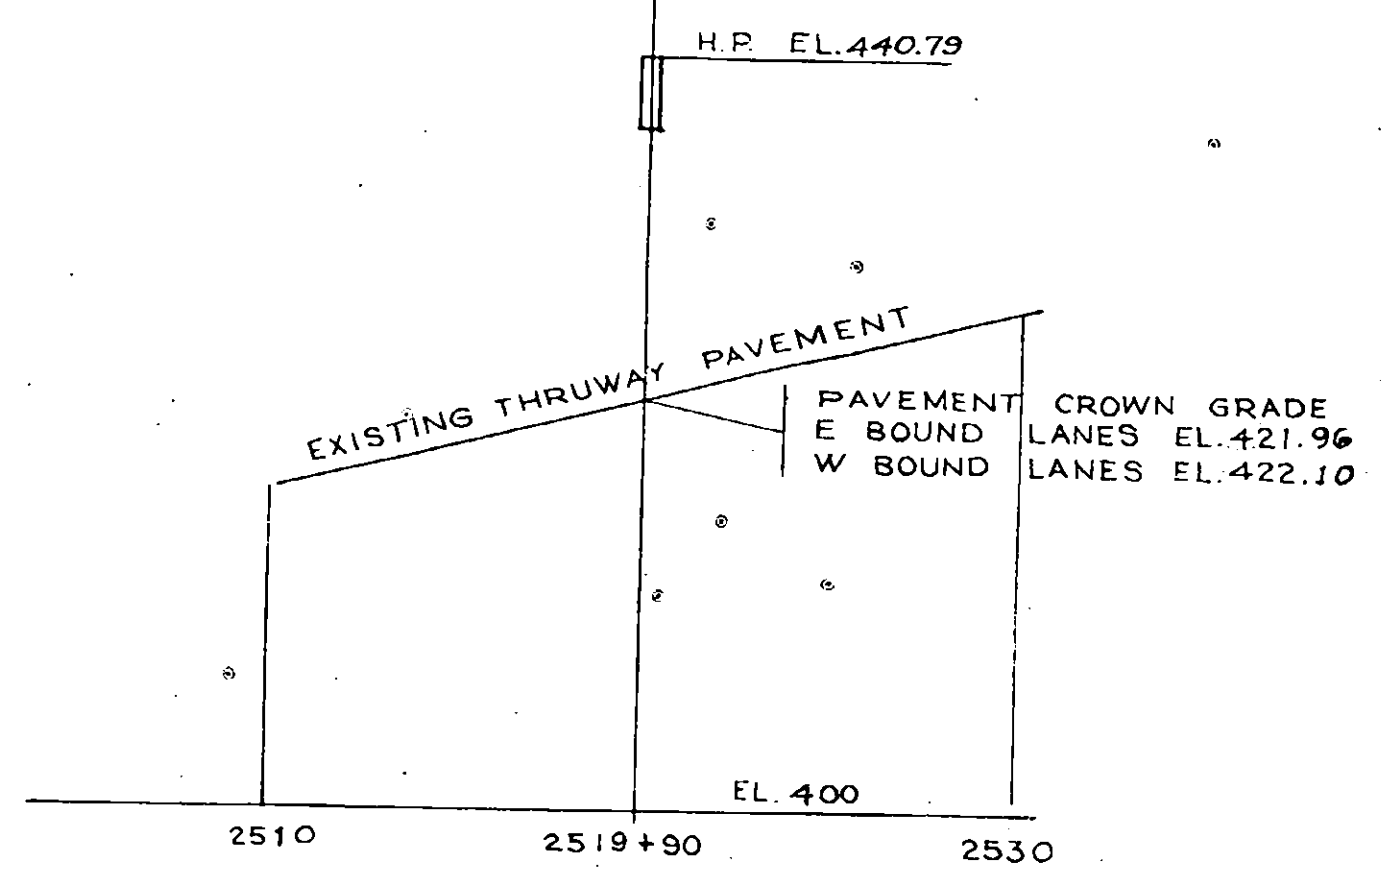


THRUWAY PROFILE
SCALES HOR 1"=500'
VERT 1"=10'

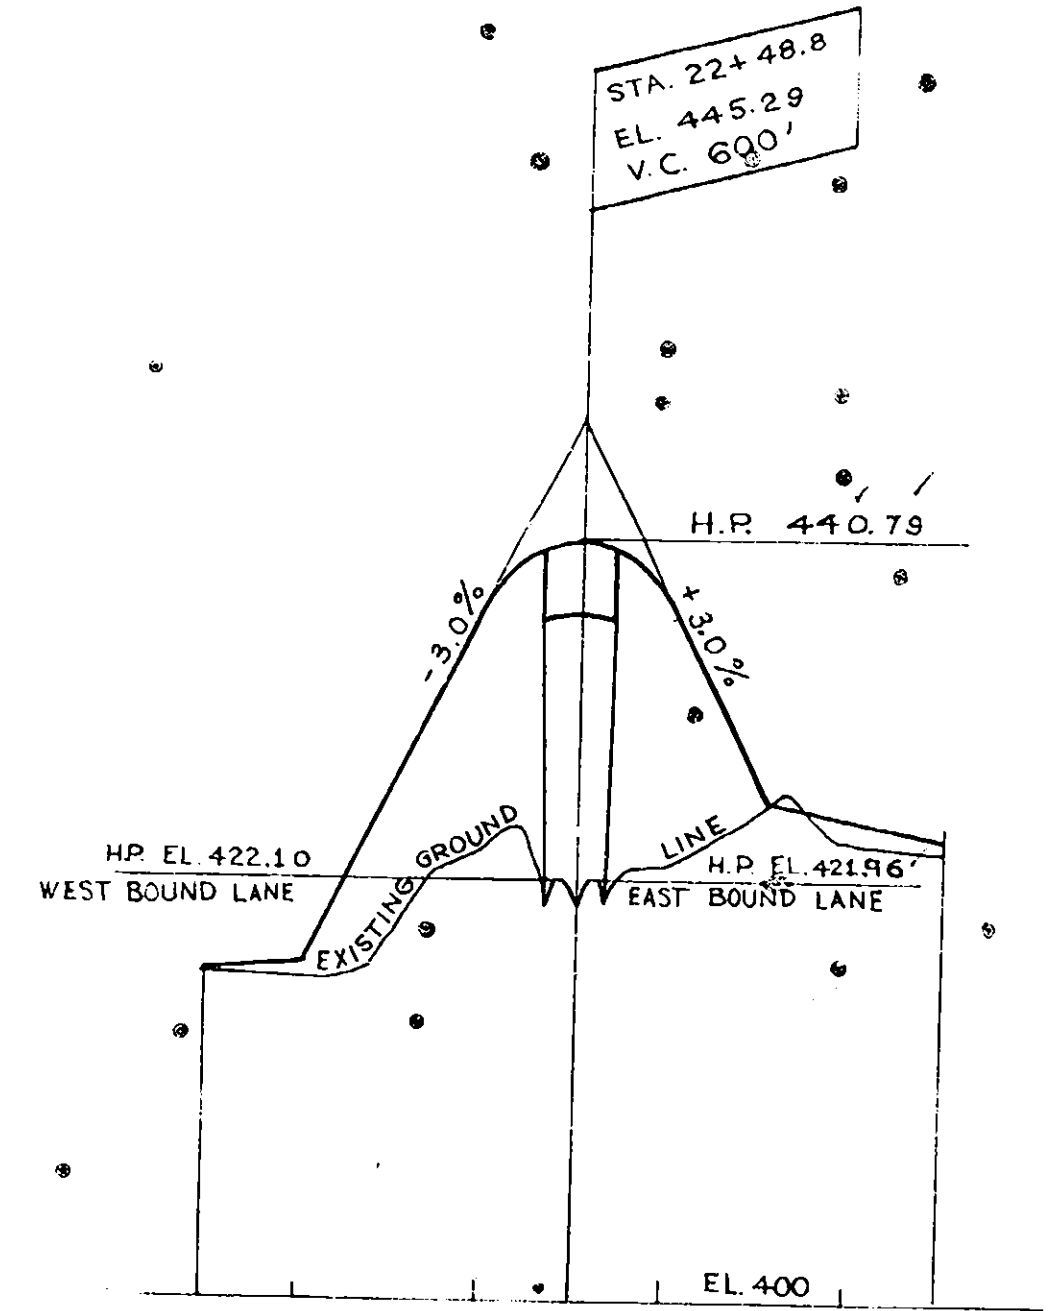

ROAD PROFILE
SCALES HOR 1"=500'
VERT 1"=10'

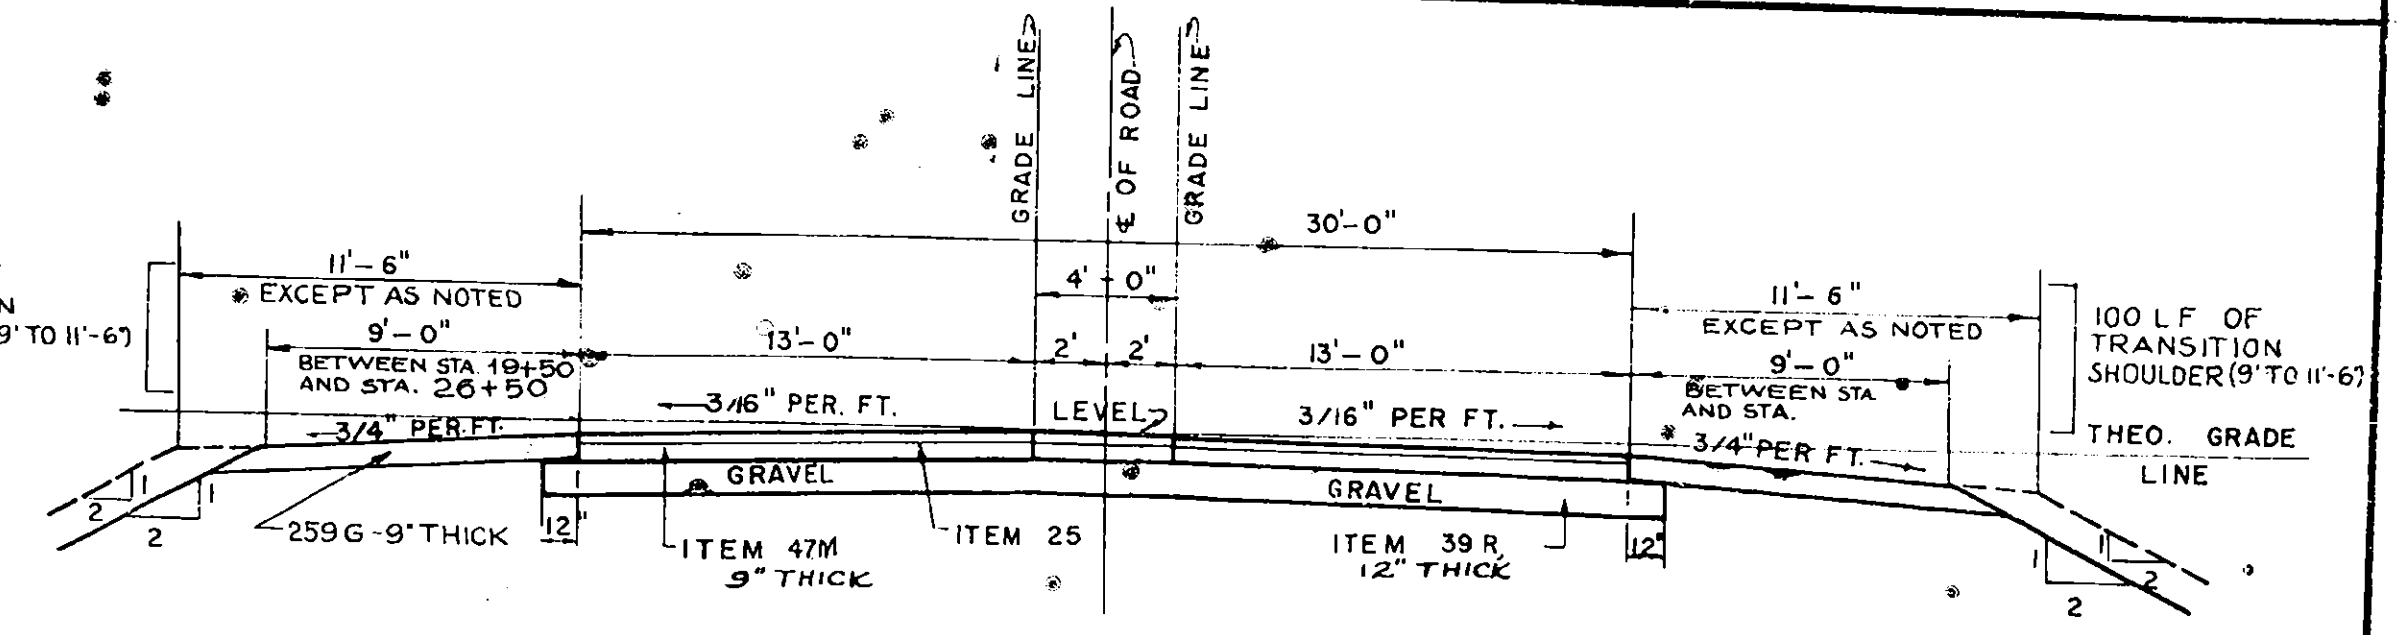

APPROACH SECTION
SCALE 3/16"=1'-0"

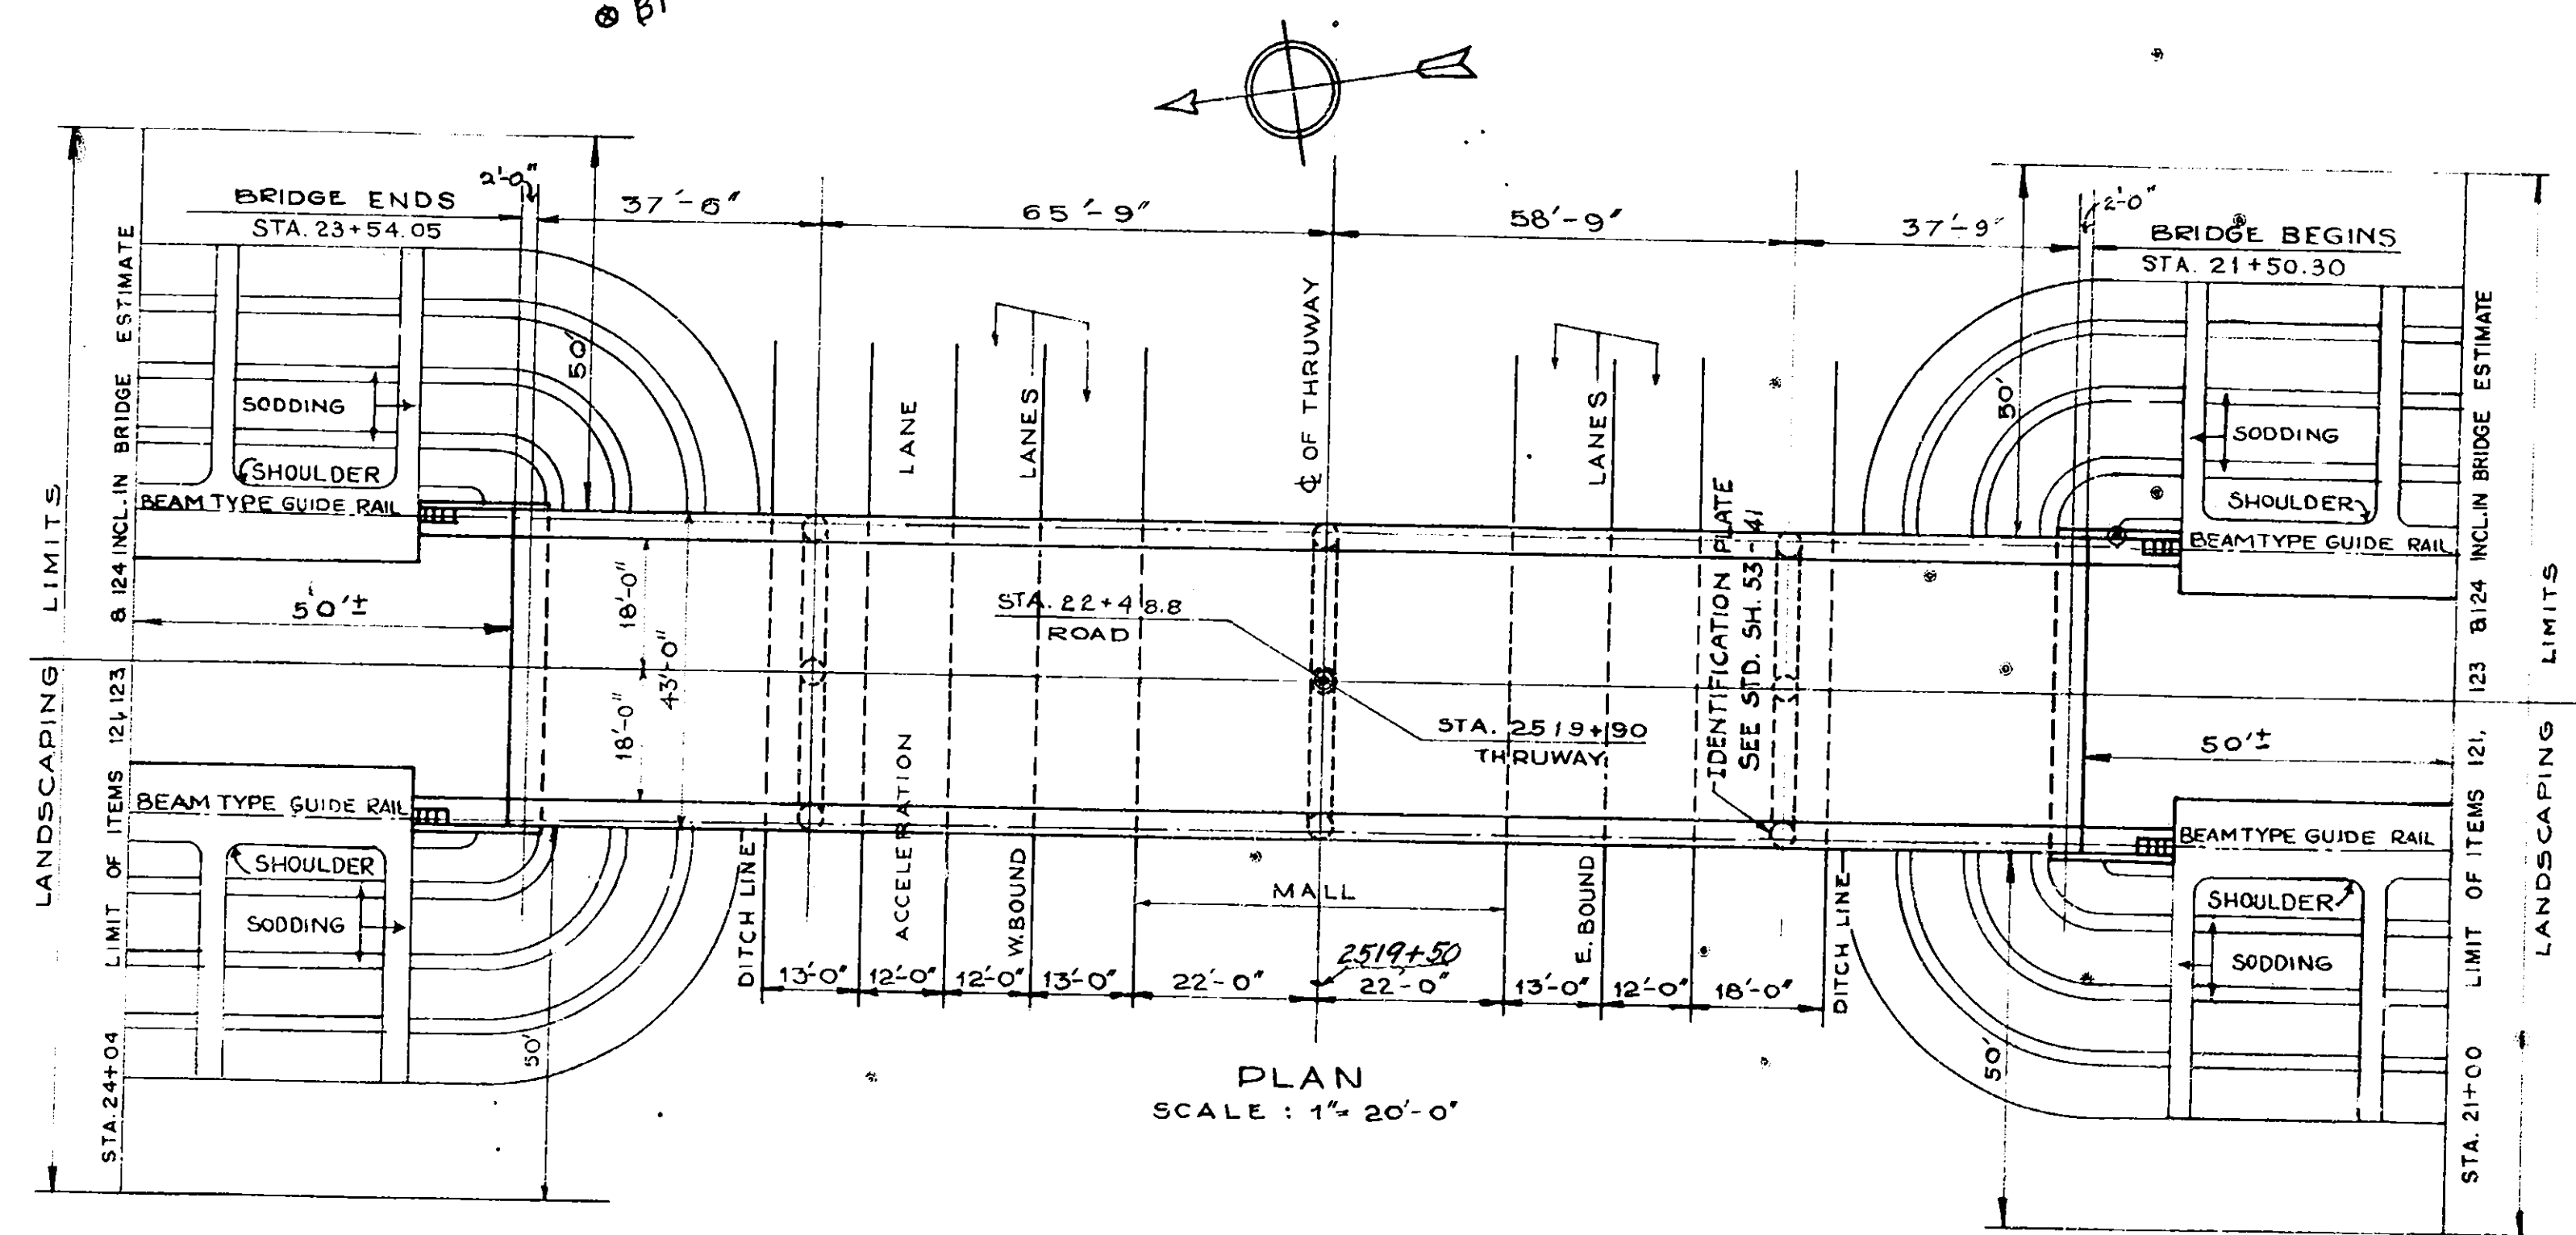

PLAN
SCALE 1"=20'-0"

DEPARTMENT OF PUBLIC WORKS

RECOMMENDED *W.M. Robinson* 7/1/53
WM. ROBINSON
DISTRICT ENGINEER DATE

APPROVED *E.T. Gawkins* 7/1/53
E.T. GAWKINS
DEPUTY CHIEF ENGINEER DATE

E.W. WENDELL
DEPUTY CHIEF ENGINEER DATE

J.B. McMorran 7/1/53
J.B. MCMORRAN
CHIEF ENGINEER DATE

APPROVED *February 16* 1953
NEW YORK STATE THRUWAY AUTHORITY


B.D. TALLAMY CHAIRMAN

BY C.H. LANG
C.H. Lang
DEPUTY CHIEF ENGINEER

PRELIMINARY LAYOUT
THOMPSON ROAD INTERCHANGE
MOHAWK SECTION
NEW YORK STATE THRUWAY


PREPARED AND RECOMMENDED *Urquhart & Doyle* 2/27-52
URQUHART & DOYLE, CONSULTING ENGINEERS
NEW YORK STATE PROFESSIONAL ENGINEERS LICENSE NO 5667 DATE

COUNTY	SHEET NO.	TOTAL SHEETS
ONONDAGA	45	66
N.Y. STATE THRUWAY, MOHAWK SECTION, SUBDIV. B.B.		
INTERCHANGE AT THOMPSON ROAD		

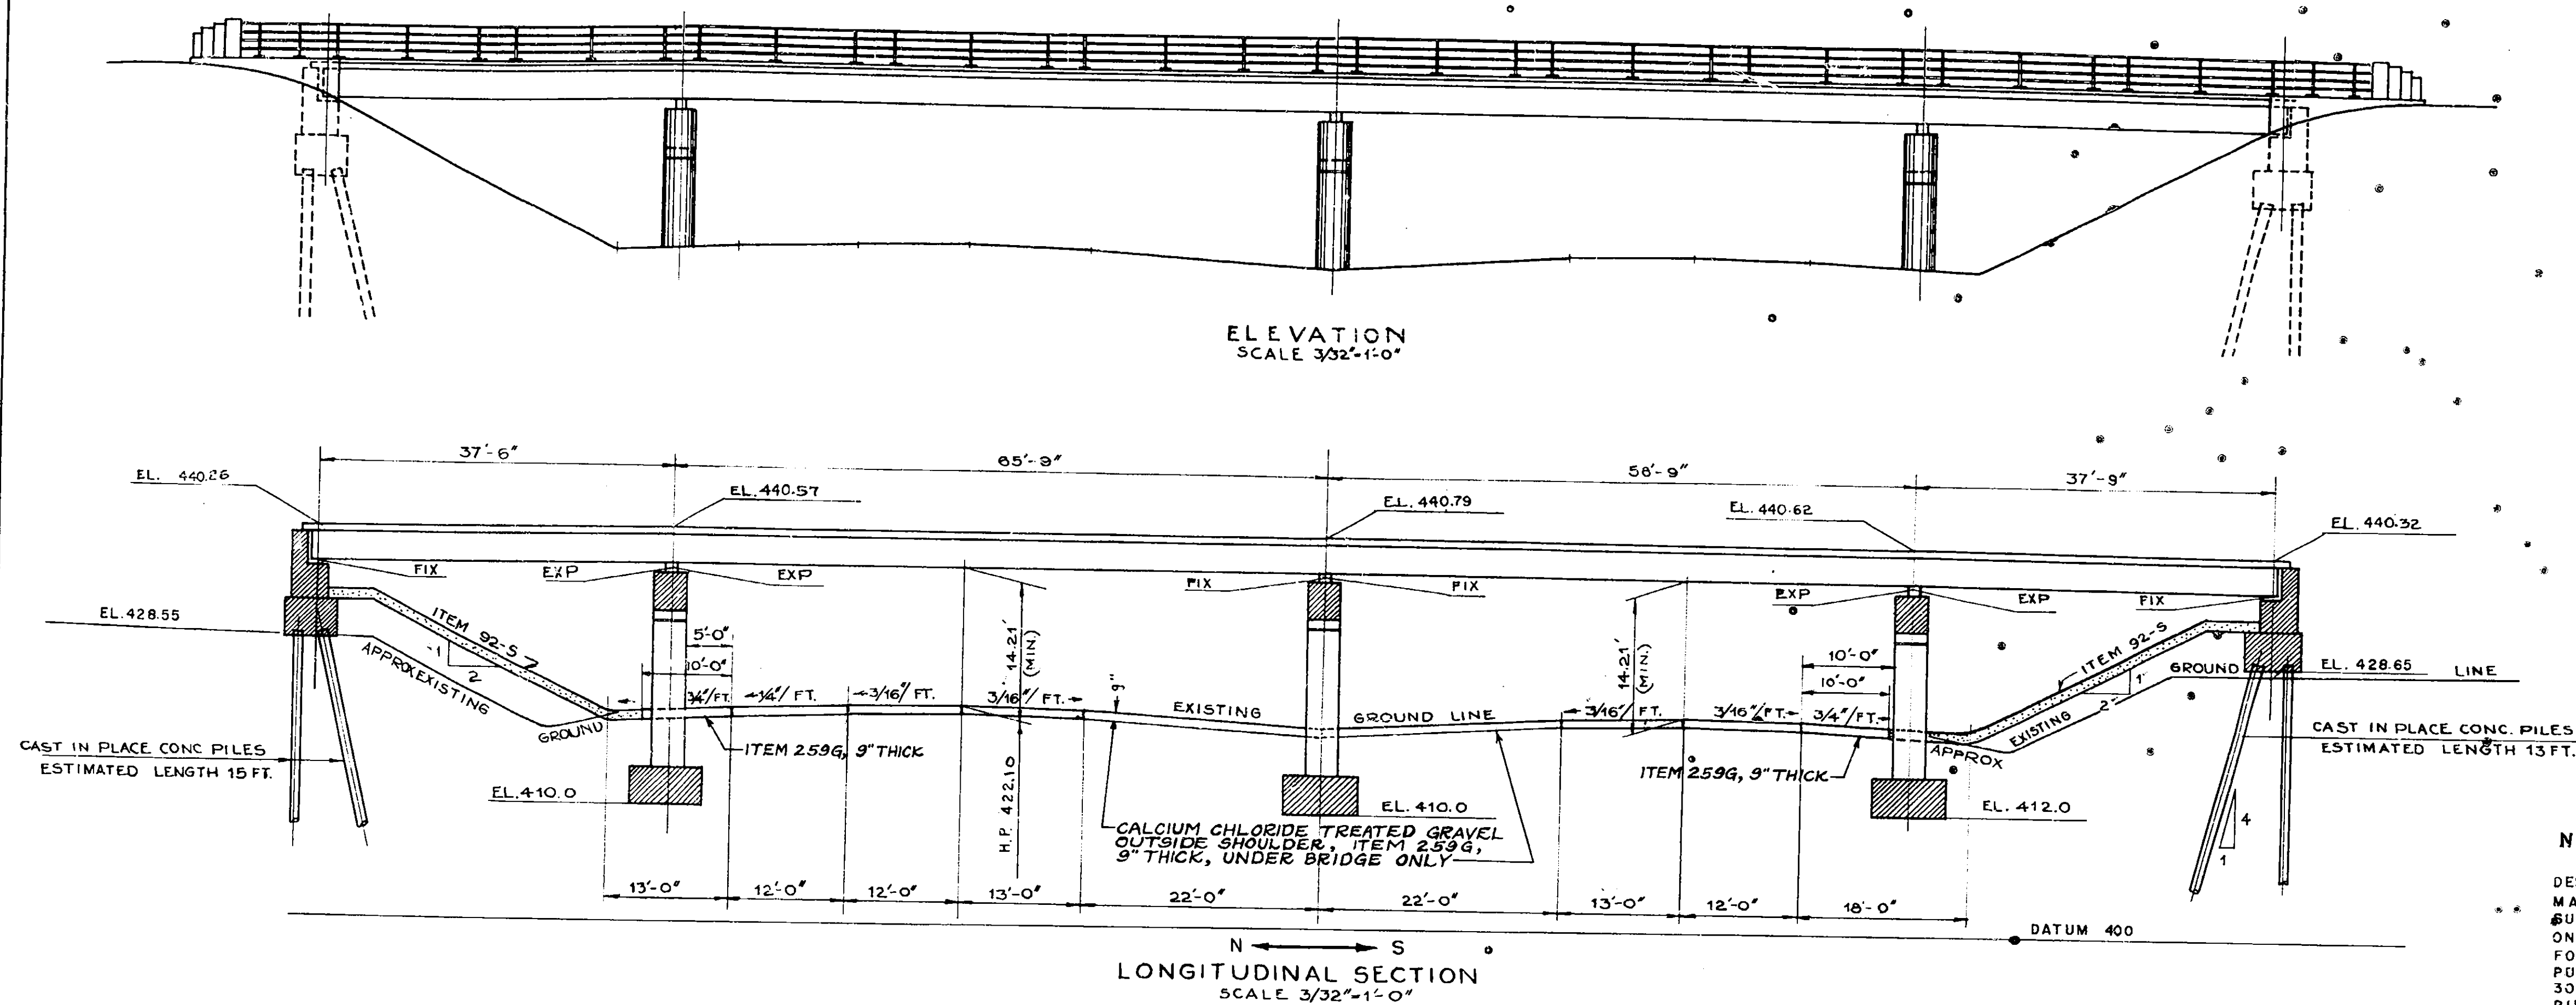

NOTE:

DESIGN SPECIFICATION A.A.S.H.O. 1949 - H20-S16 LOADING MODIFIED MATERIAL AND FABRICATION SPECIFICATIONS N.Y.S.D.P.W. JAN. 2, 1951. SUPERSTRUCTURE WF BEAMS, COMPOSITE CONSTRUCTION CENTER SPANS ONLY. FOUNDATION TREATMENT OF ABUTMENTS ON PILES; FOR DESIGN PURPOSES, THE ASSUMED LOAD PER PILE DOES NOT EXCEED 30 TONS. PIERS ON SPREAD FOOTINGS; FOR DESIGN PURPOSES, THE ASSUMED FOUNDATION PRESSURE DOES NOT EXCEED 2-1/2 TONS PER SQ. FT. TOP SOILING, SODDING AND SEEDING TO BE SHOWN ON BRIDGE CONTRACT PLANS, AND INCLUDED IN BRIDGE ESTIMATE FOR BOTH APPROACHES TO EXTENT NOTED IN PLAN.

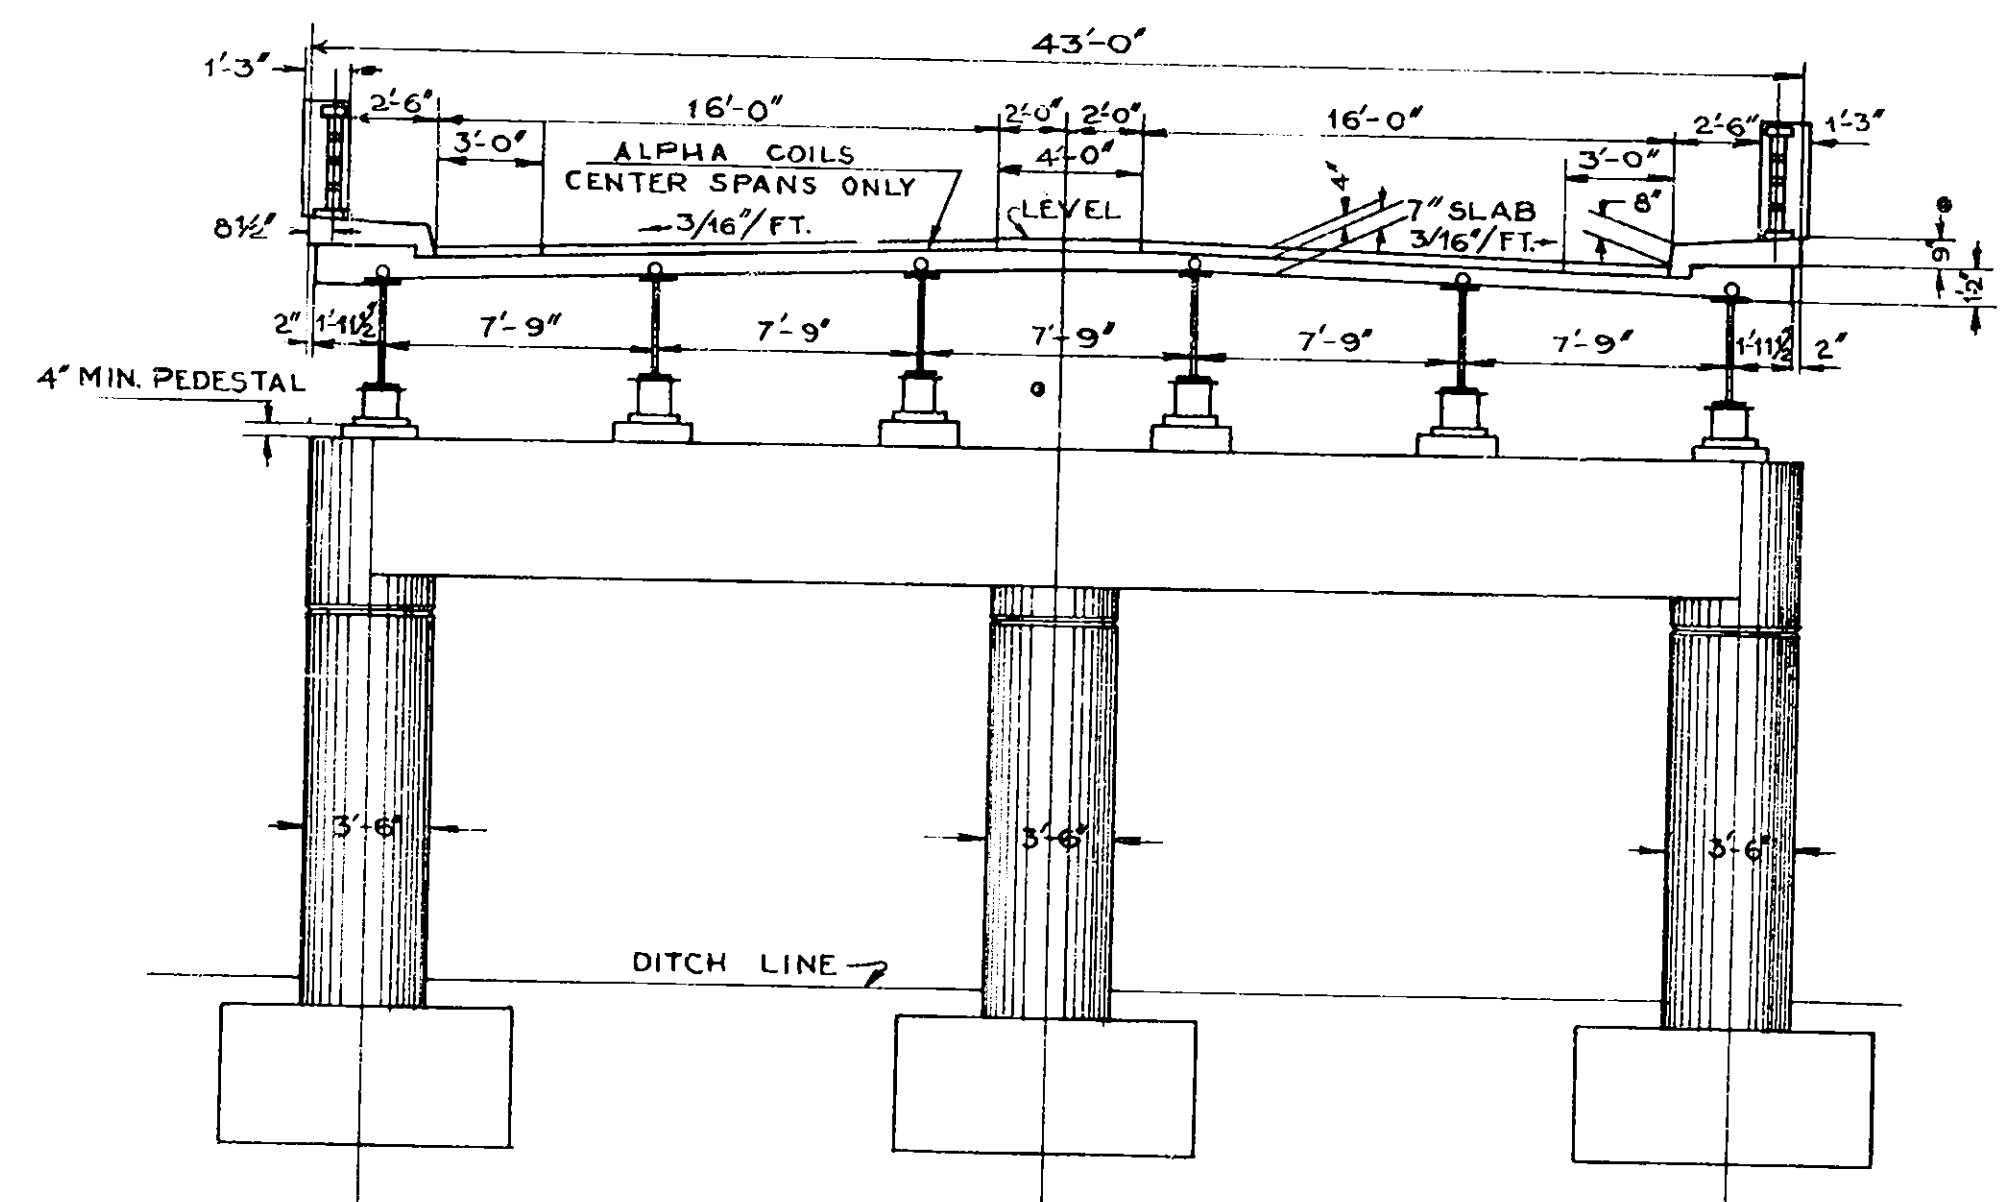

PREPARED AND RECOMMENDED






URQUHART & COYLE CONSULTING ENGINEERS
NEW YORK STATE PROFESSIONAL ENGINEERS LICENSE NO. 5667

DATE

PRELIMINARY LAYOUT
THOMPSON ROAD INTERCHANGE
MOHAWK SECTION
NEW YORK STATE THRUWAY

COUNTY	SHEET NO.	TOTAL SHEETS
ONONDAGA	46	66
N.Y. STATE THRUWAY, MOHAWK SECTION SUBDIV. 8B		
INTERCHANGE AT THOMPSON ROAD		

NOTE:
PLACING OF PILES AND CONSTRUCTION OF THE ABUTMENTS WILL NOT BE PERMITTED UNTIL THE HIGHWAY EMBANKMENT ADJACENT TO THE STRUCTURE HAS BEEN PLACED AND CONSOLIDATED IN A MANNER AND FOR A PERIOD OF TIME SATISFACTORY TO THE DEPUTY CHIEF ENGINEER (BRIDGES).

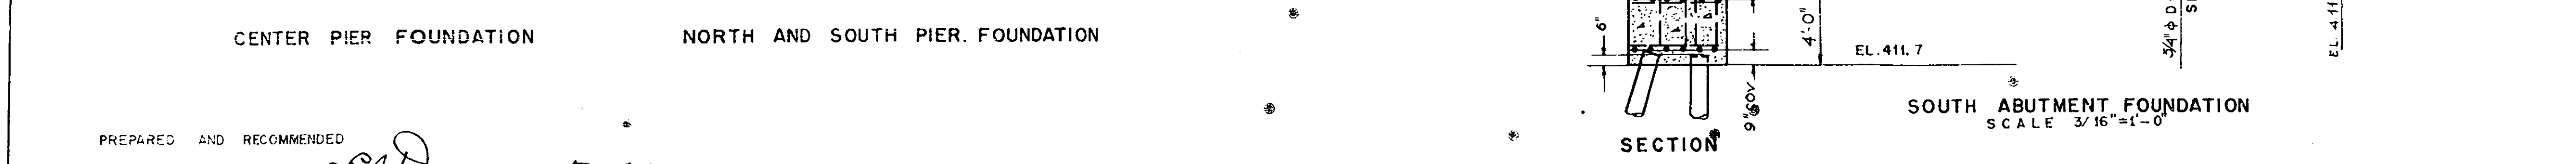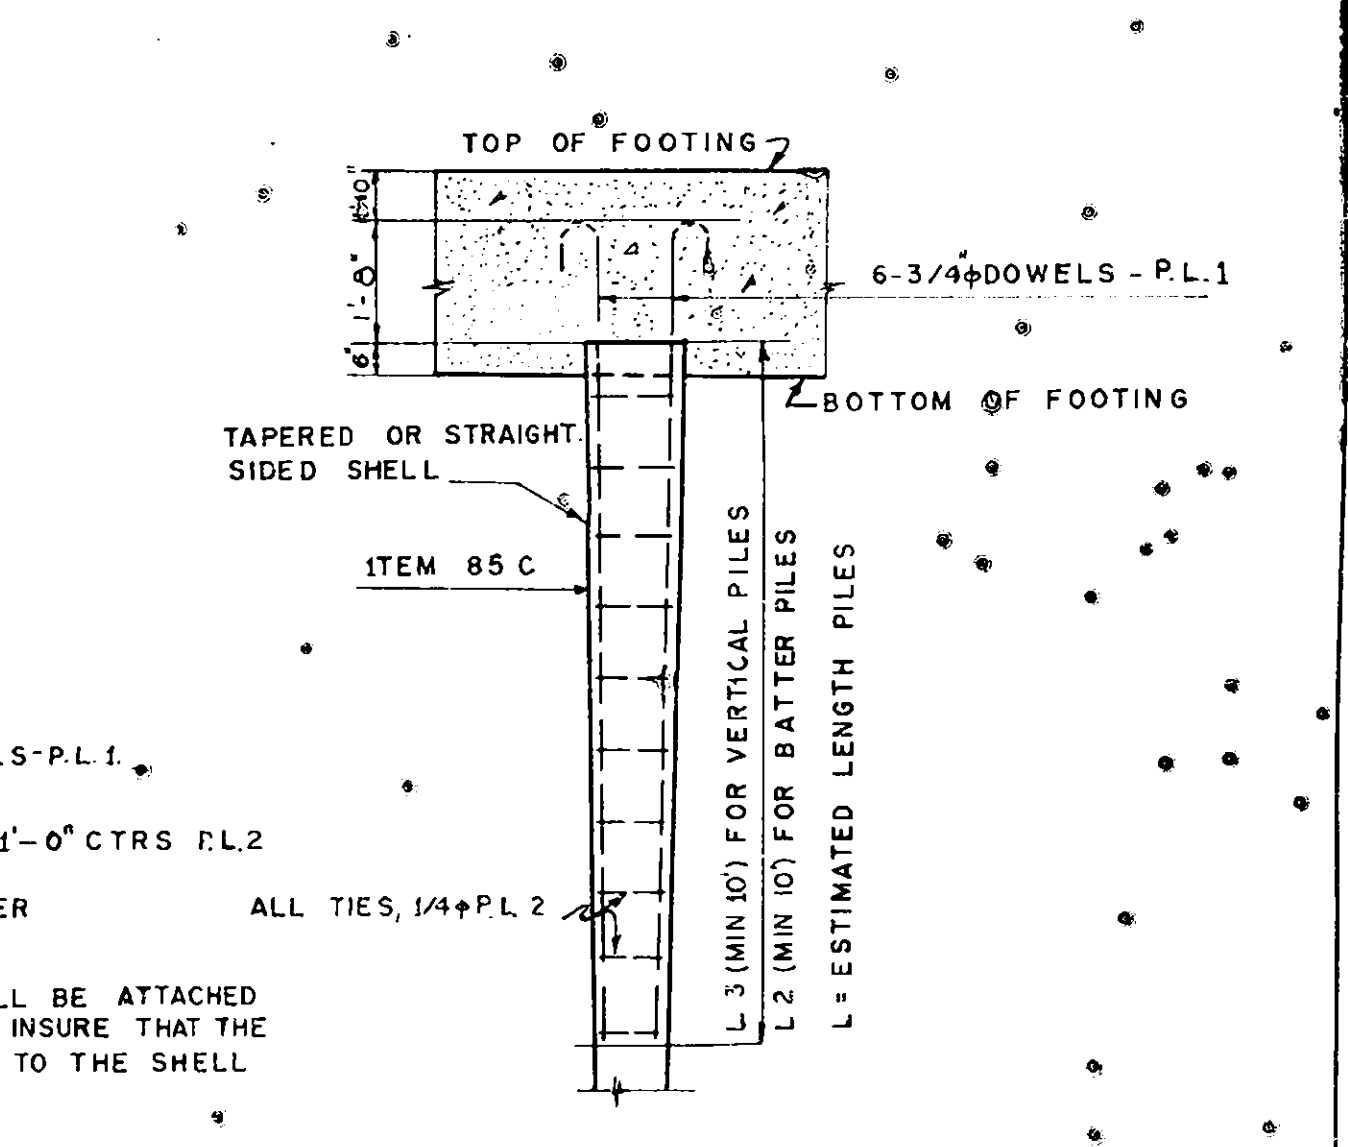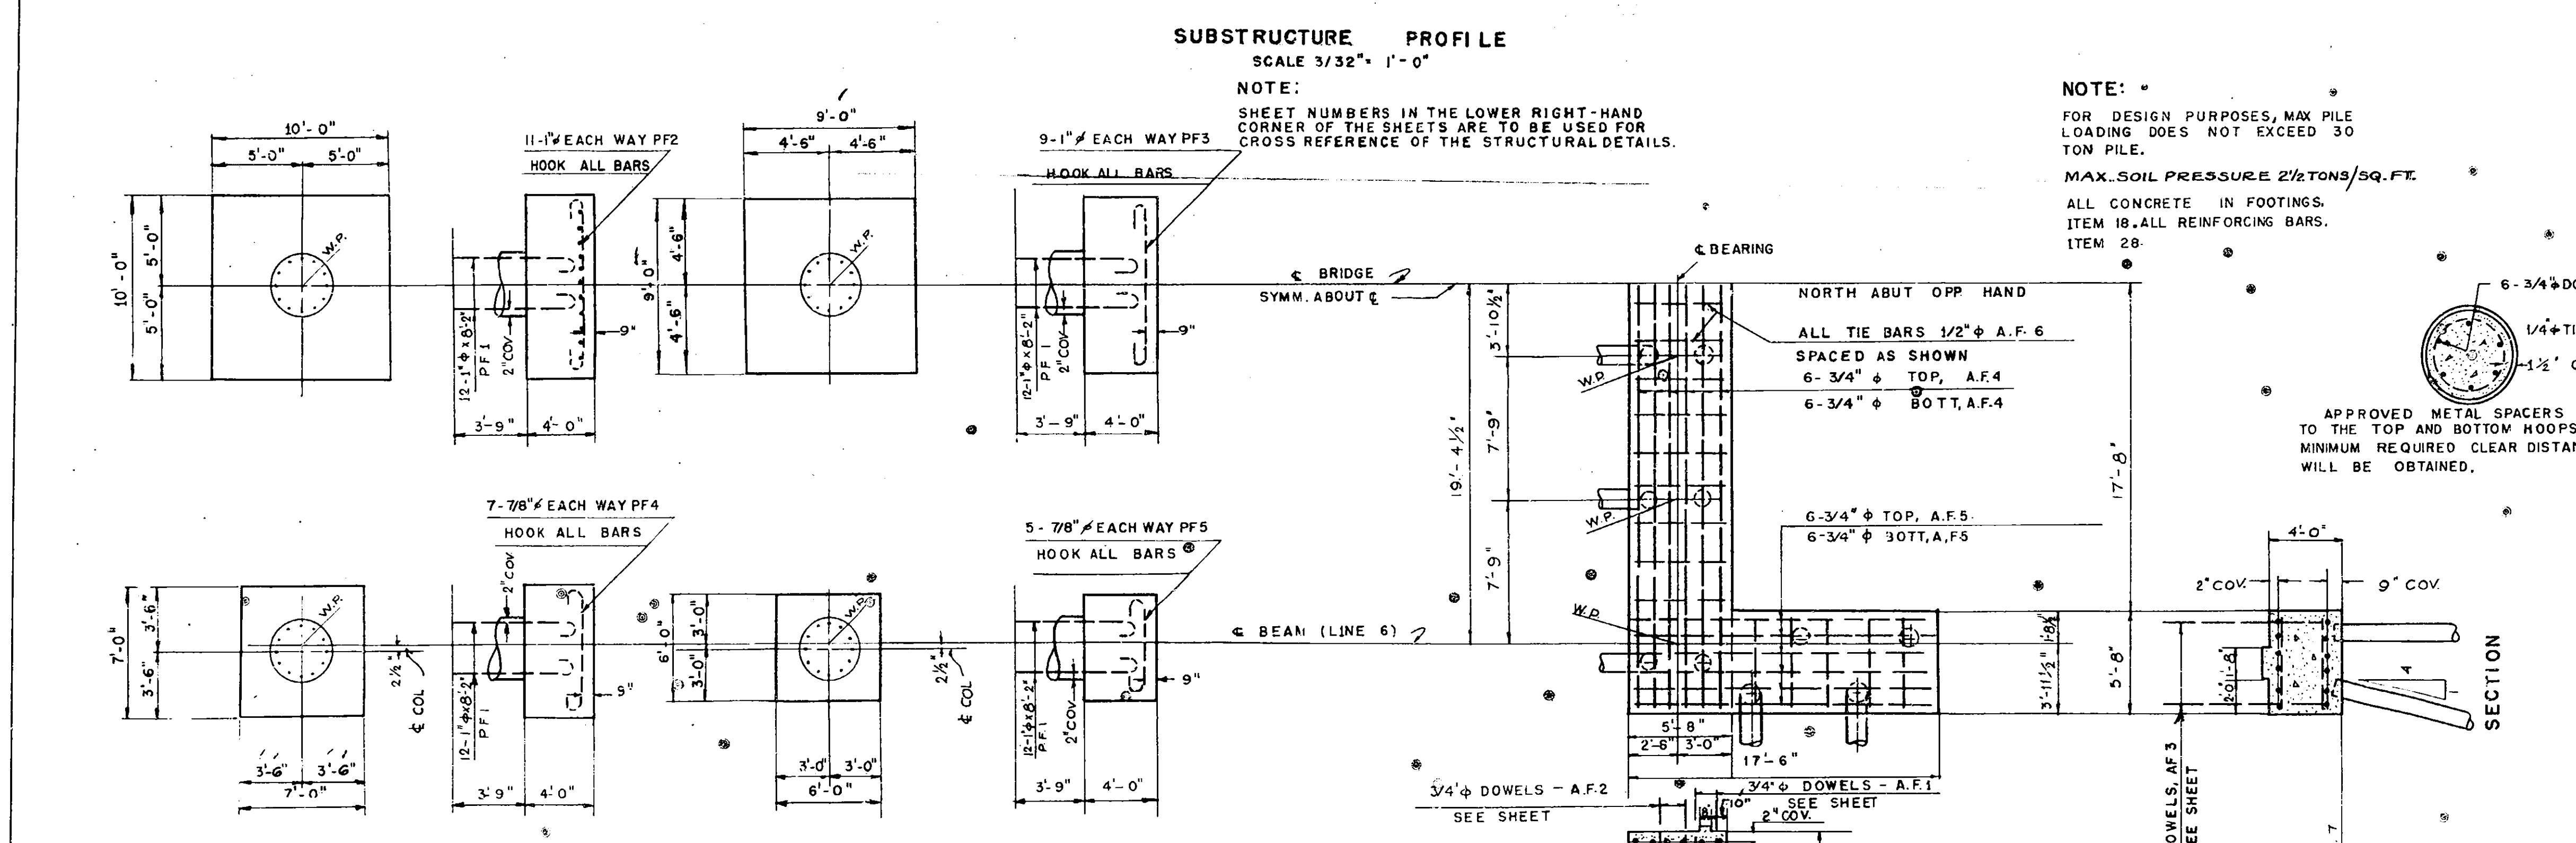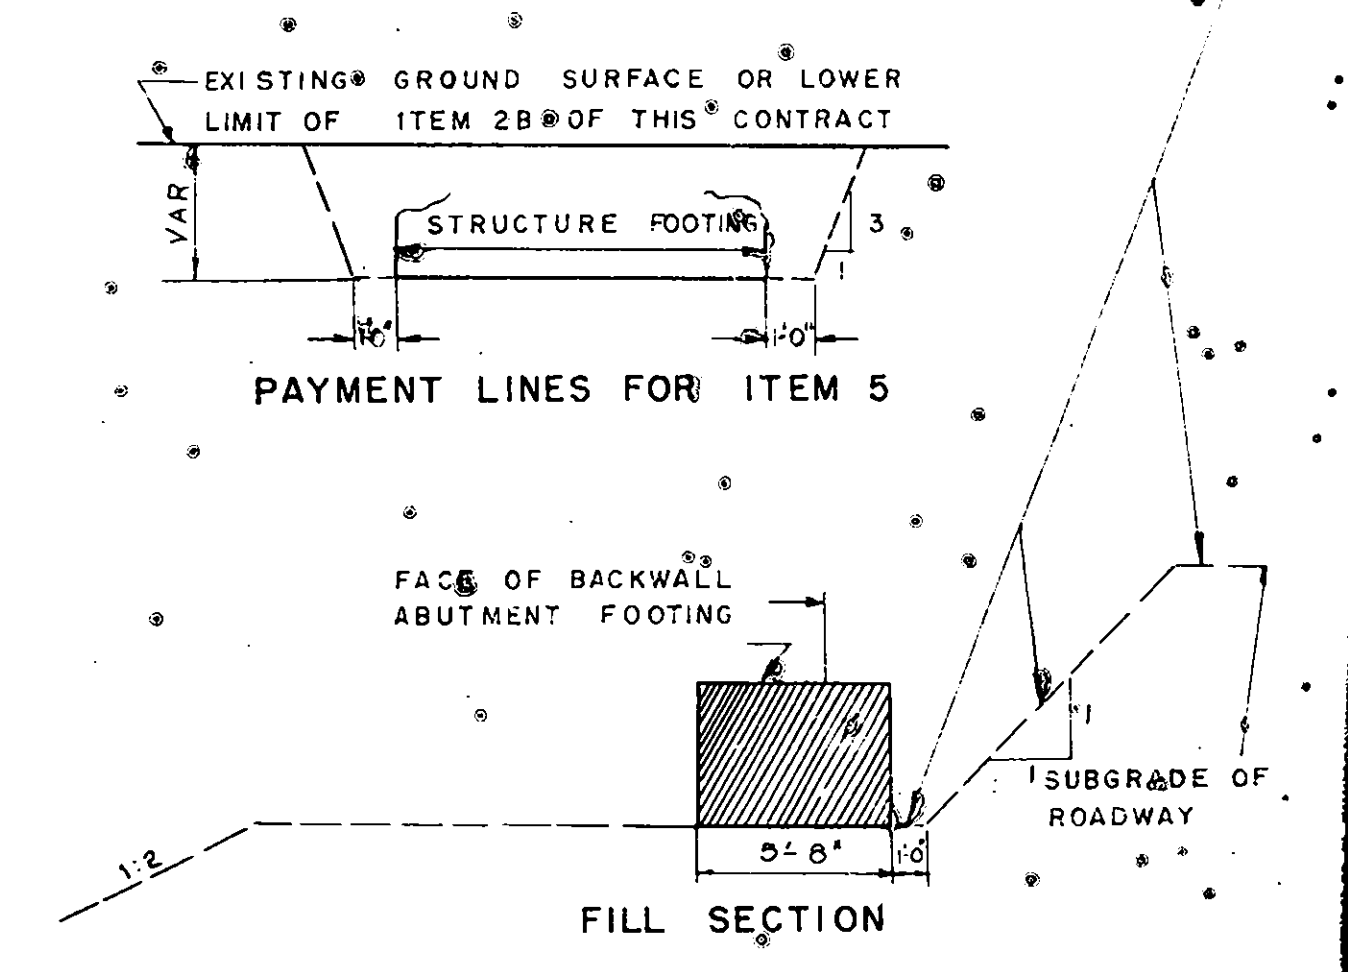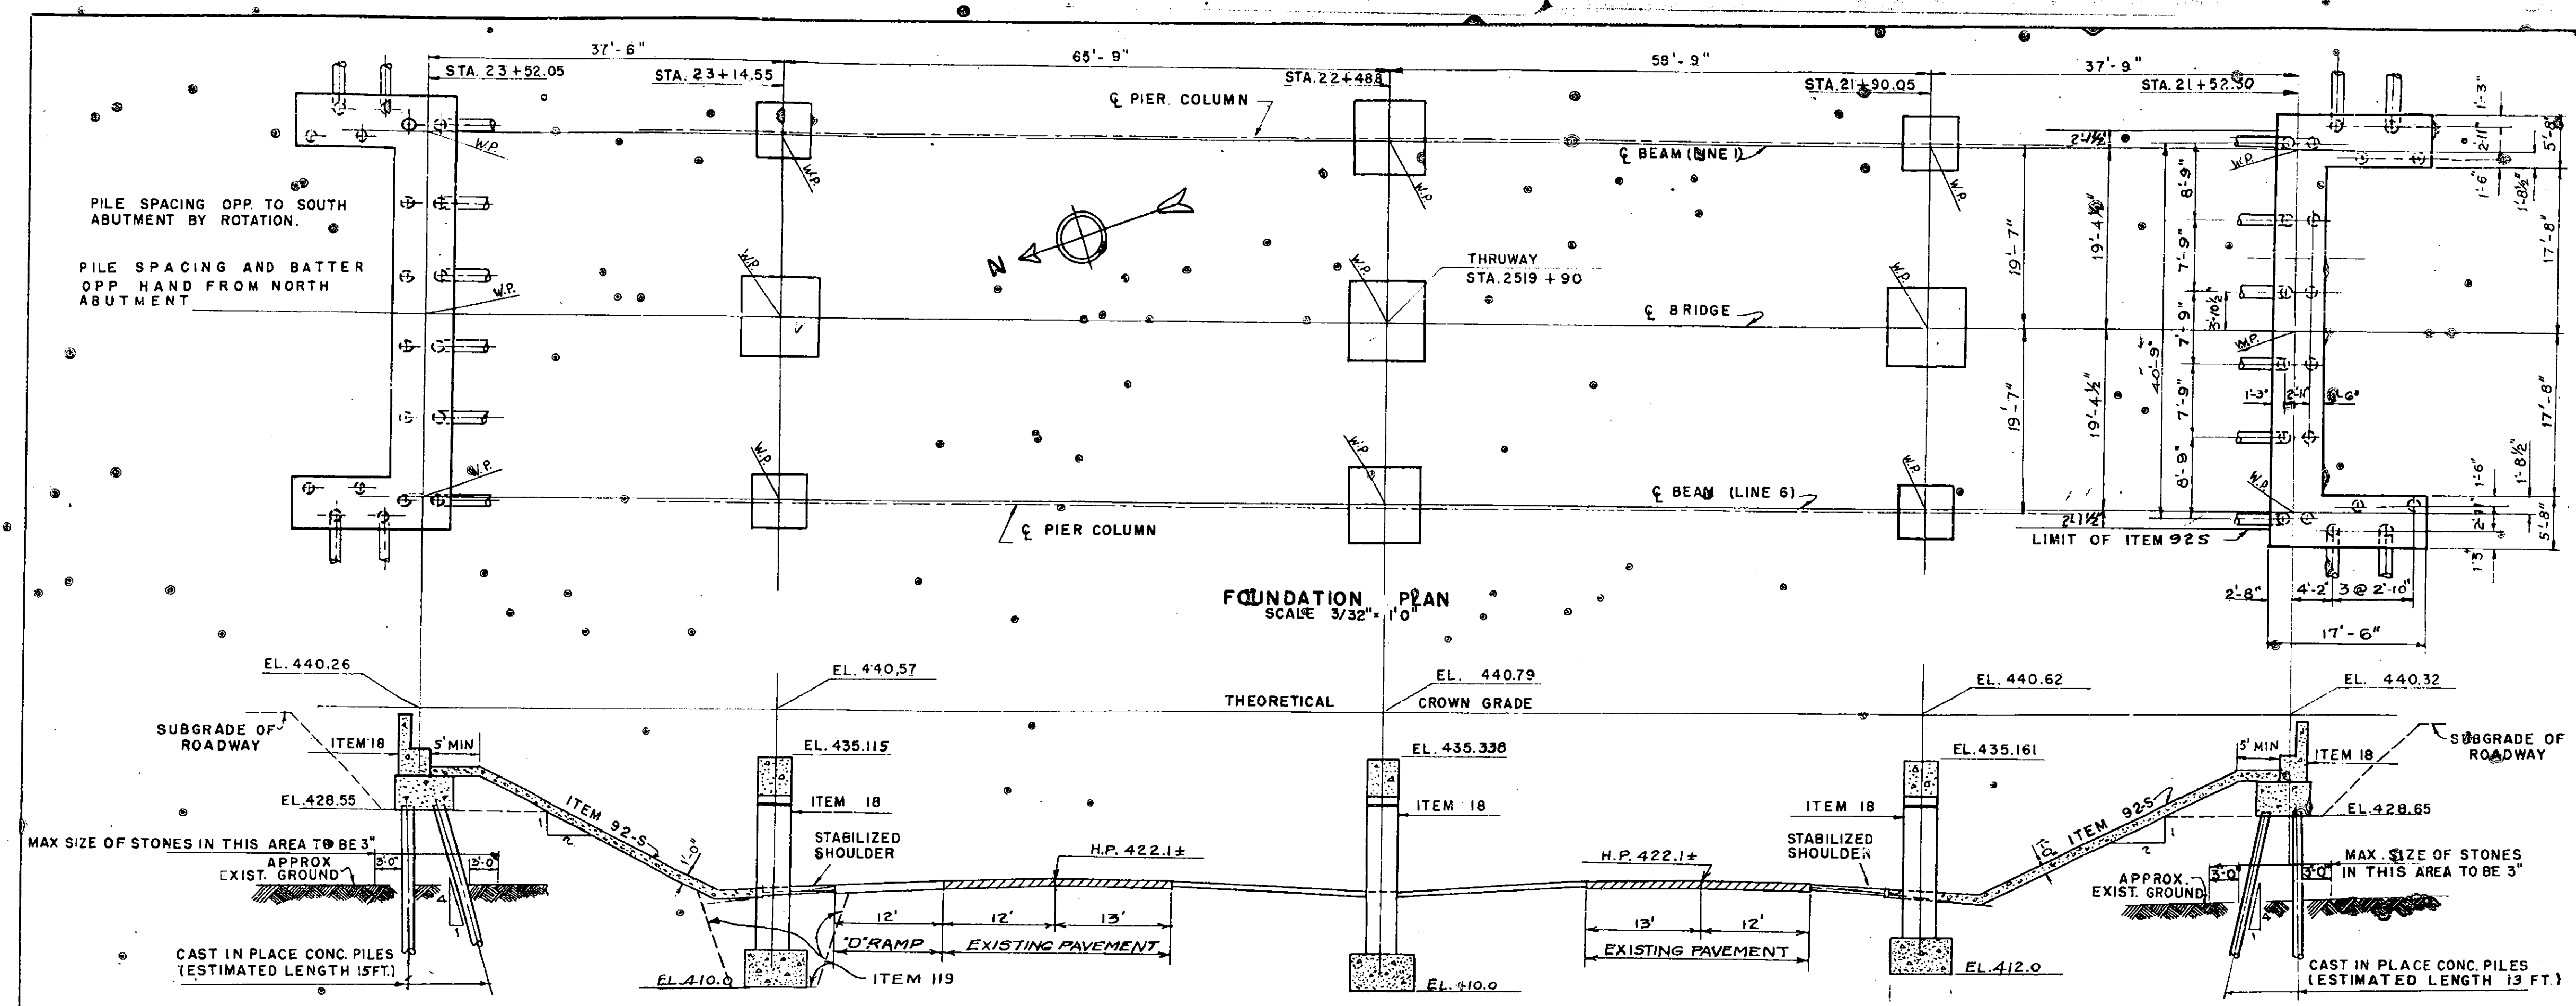

CROSS REFERENCE
FOR DETAILS OF ABUTMENTS SEE SHEET 47
FOR DETAILS OF PIERS SEE SHEET 48
FOR DETAILS OF BARS SEE SHEET 54


NOTE:
CROSS REFERENCE SHEET NUMBERS ARE THOSE SHOWN IN THE LOWER RIGHT HAND CORNER OF THE SHEETS.

SUBSTRUCTURE DETAILS
THOMPSON ROAD INTERCHANGE
MOHAWK SECTION
NEW YORK STATE THRUWAY

SHEET 46


PREPARED AND RECOMMENDED
URQUHART & DOYLE CONSULTING ENGINEERS
NEW YORK STATE PROFESSIONAL ENGINEERS LICENSE NO 5667
DATE FEB 16 1953

COUNTY	SHEET NO.	TOTAL SHEETS
ONONDAGA	47	66
N.Y. STATE THRUWAY, MOHAWK SECTION SUBDIV. 8B		
INTERCHANGE AT THOMPSON ROAD		

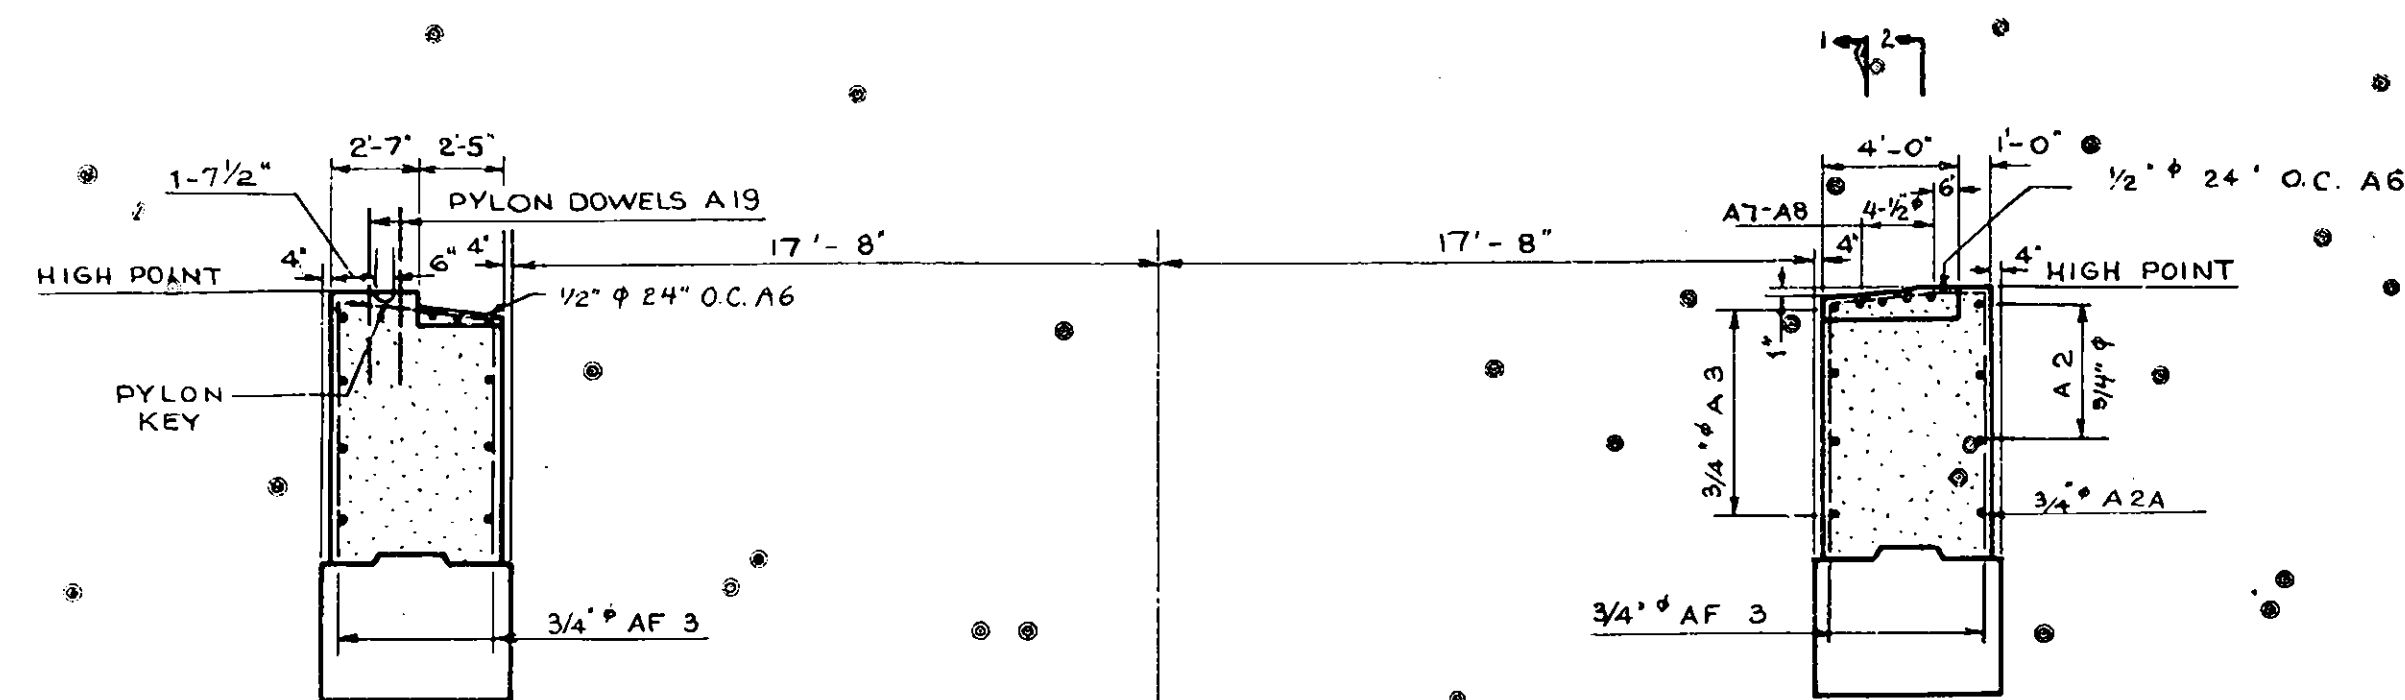


SECTION 4-4



SECTION 3-3

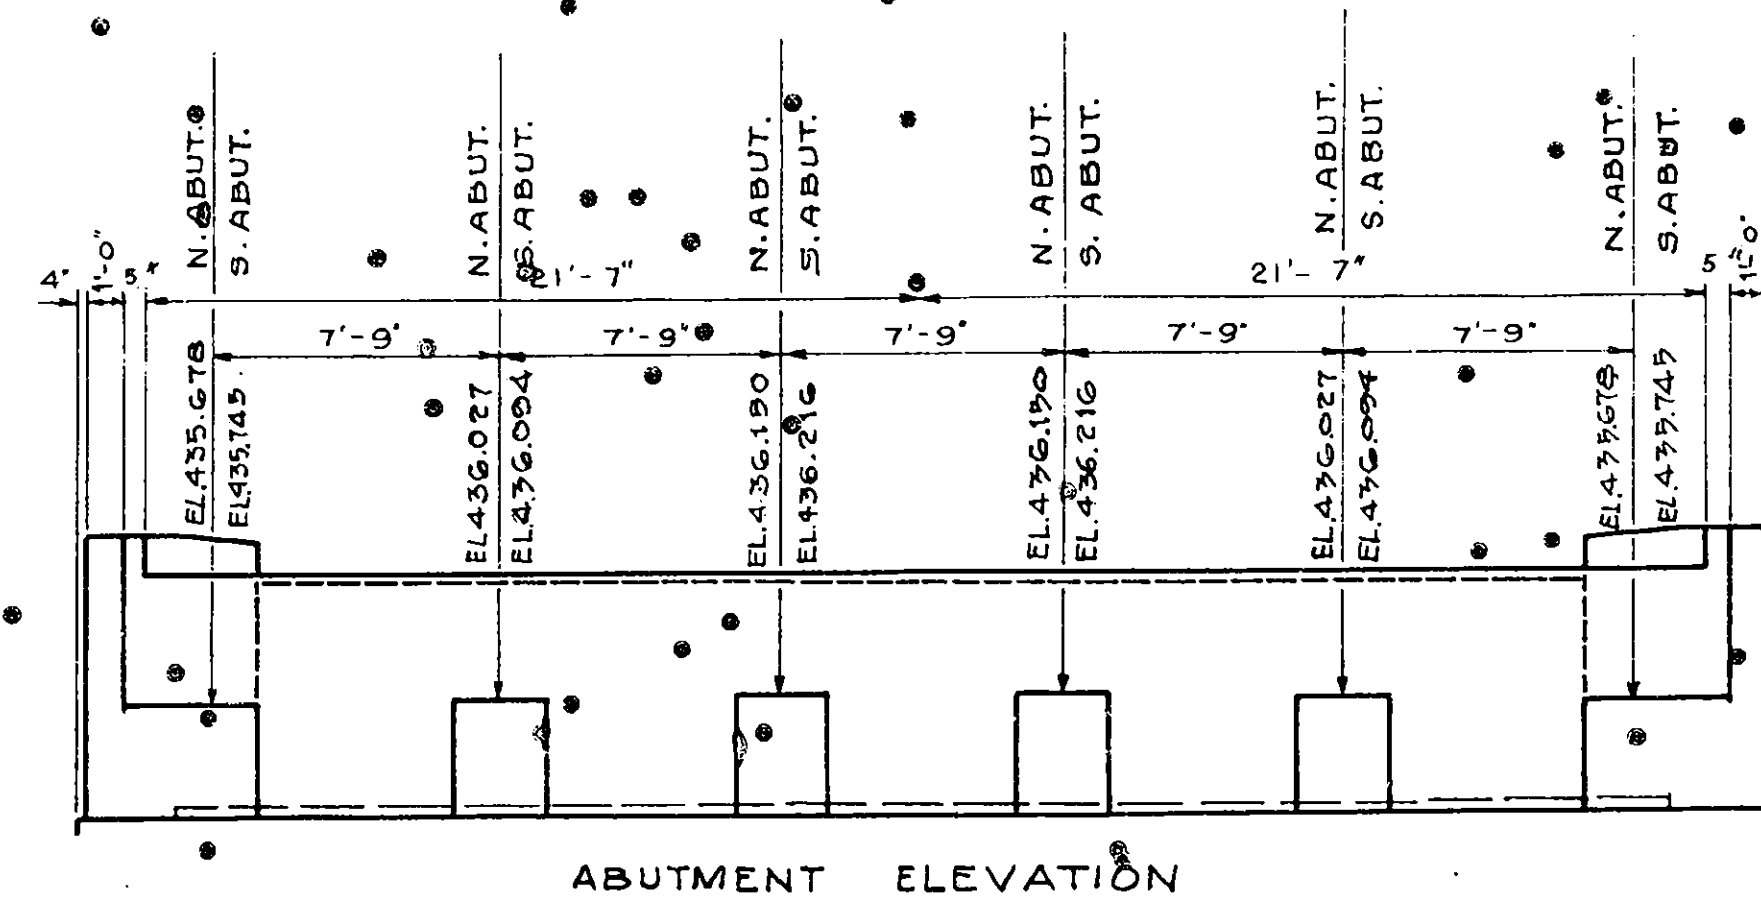


ABUTMENT ELEVATION

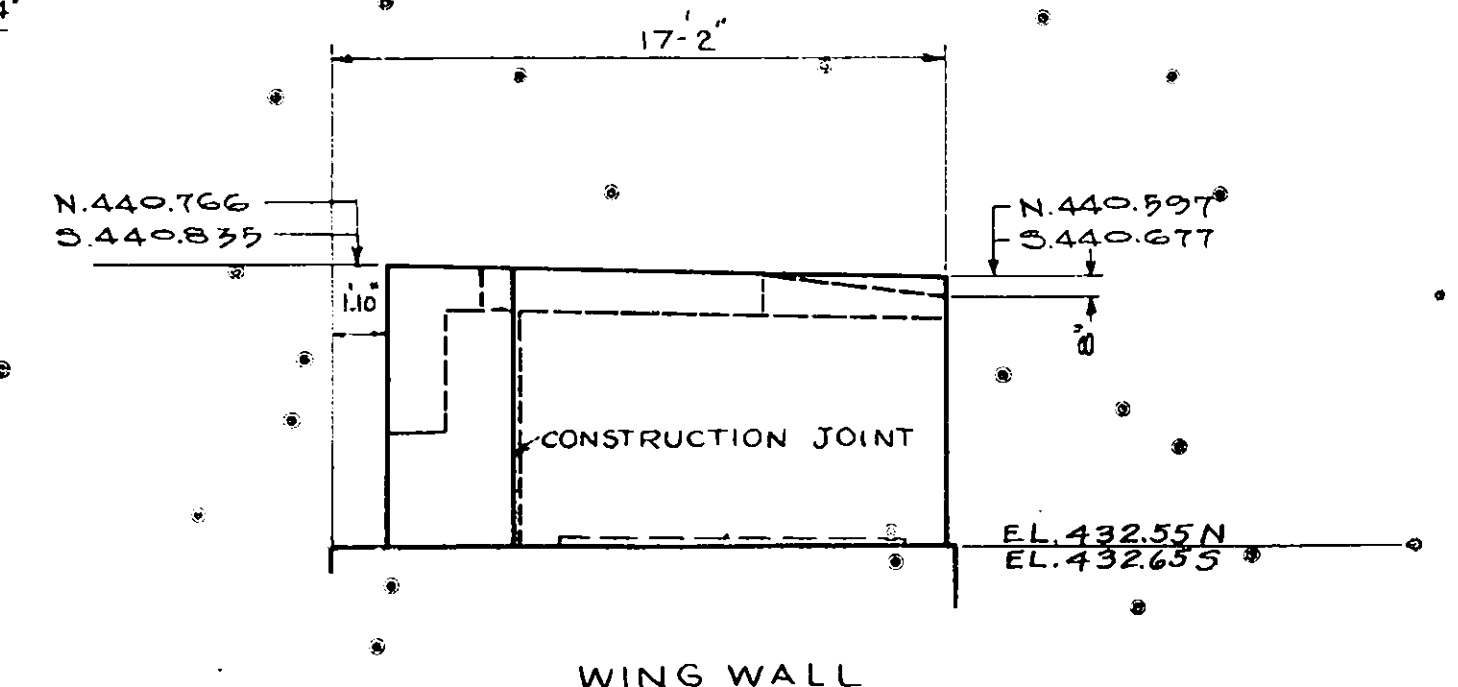

WING WALL

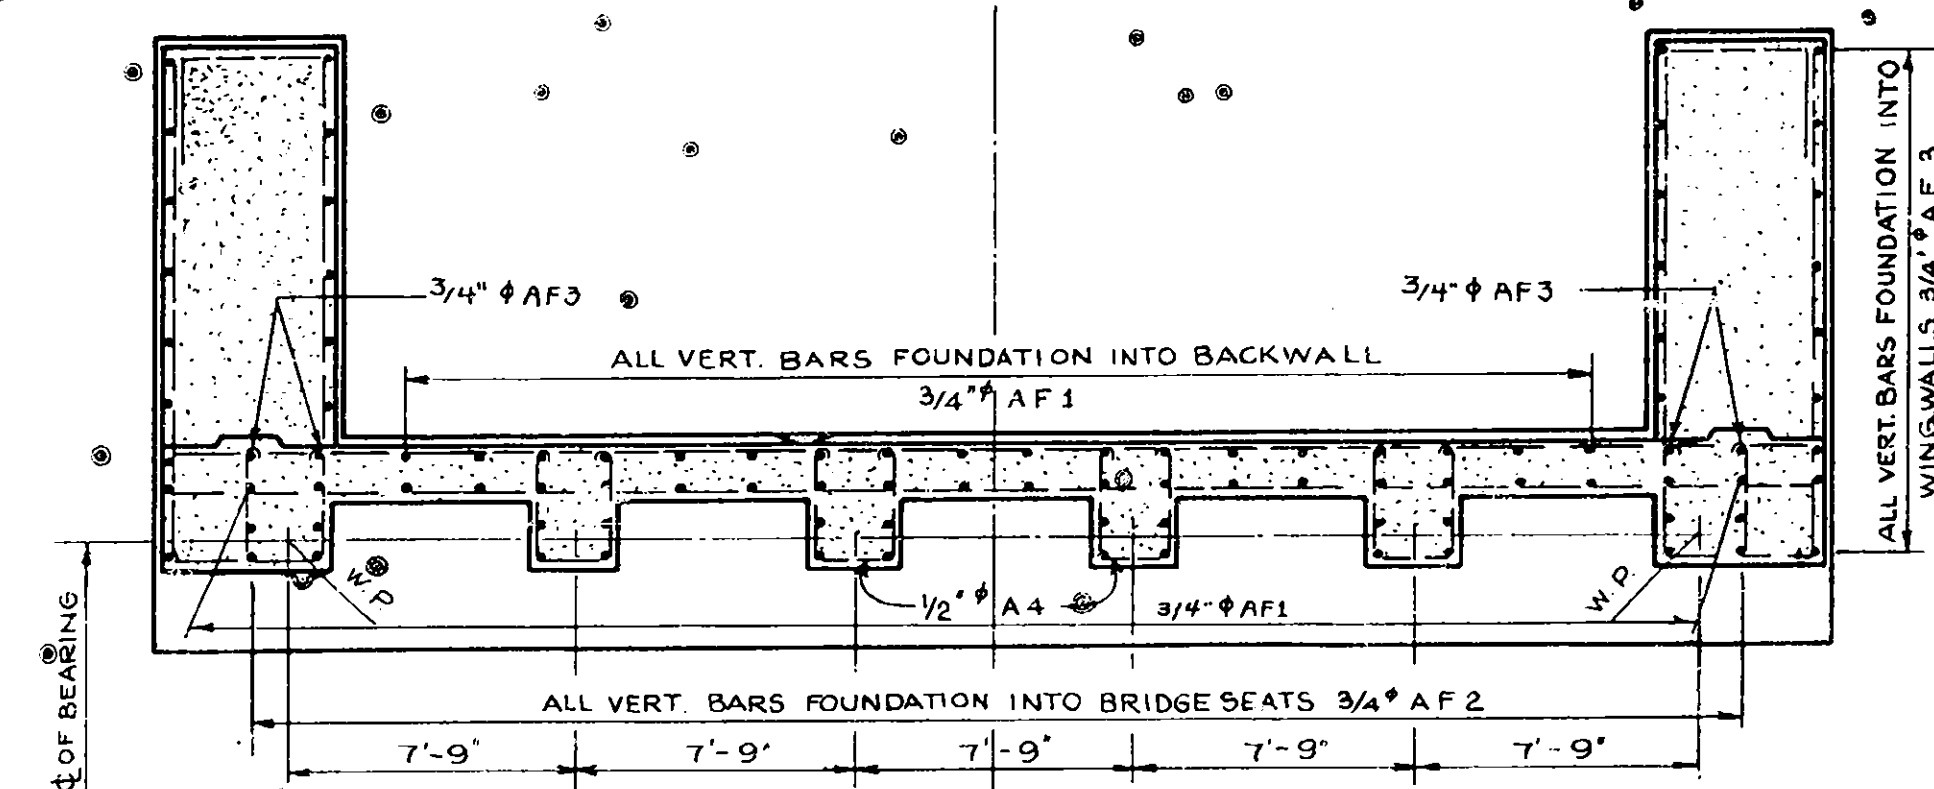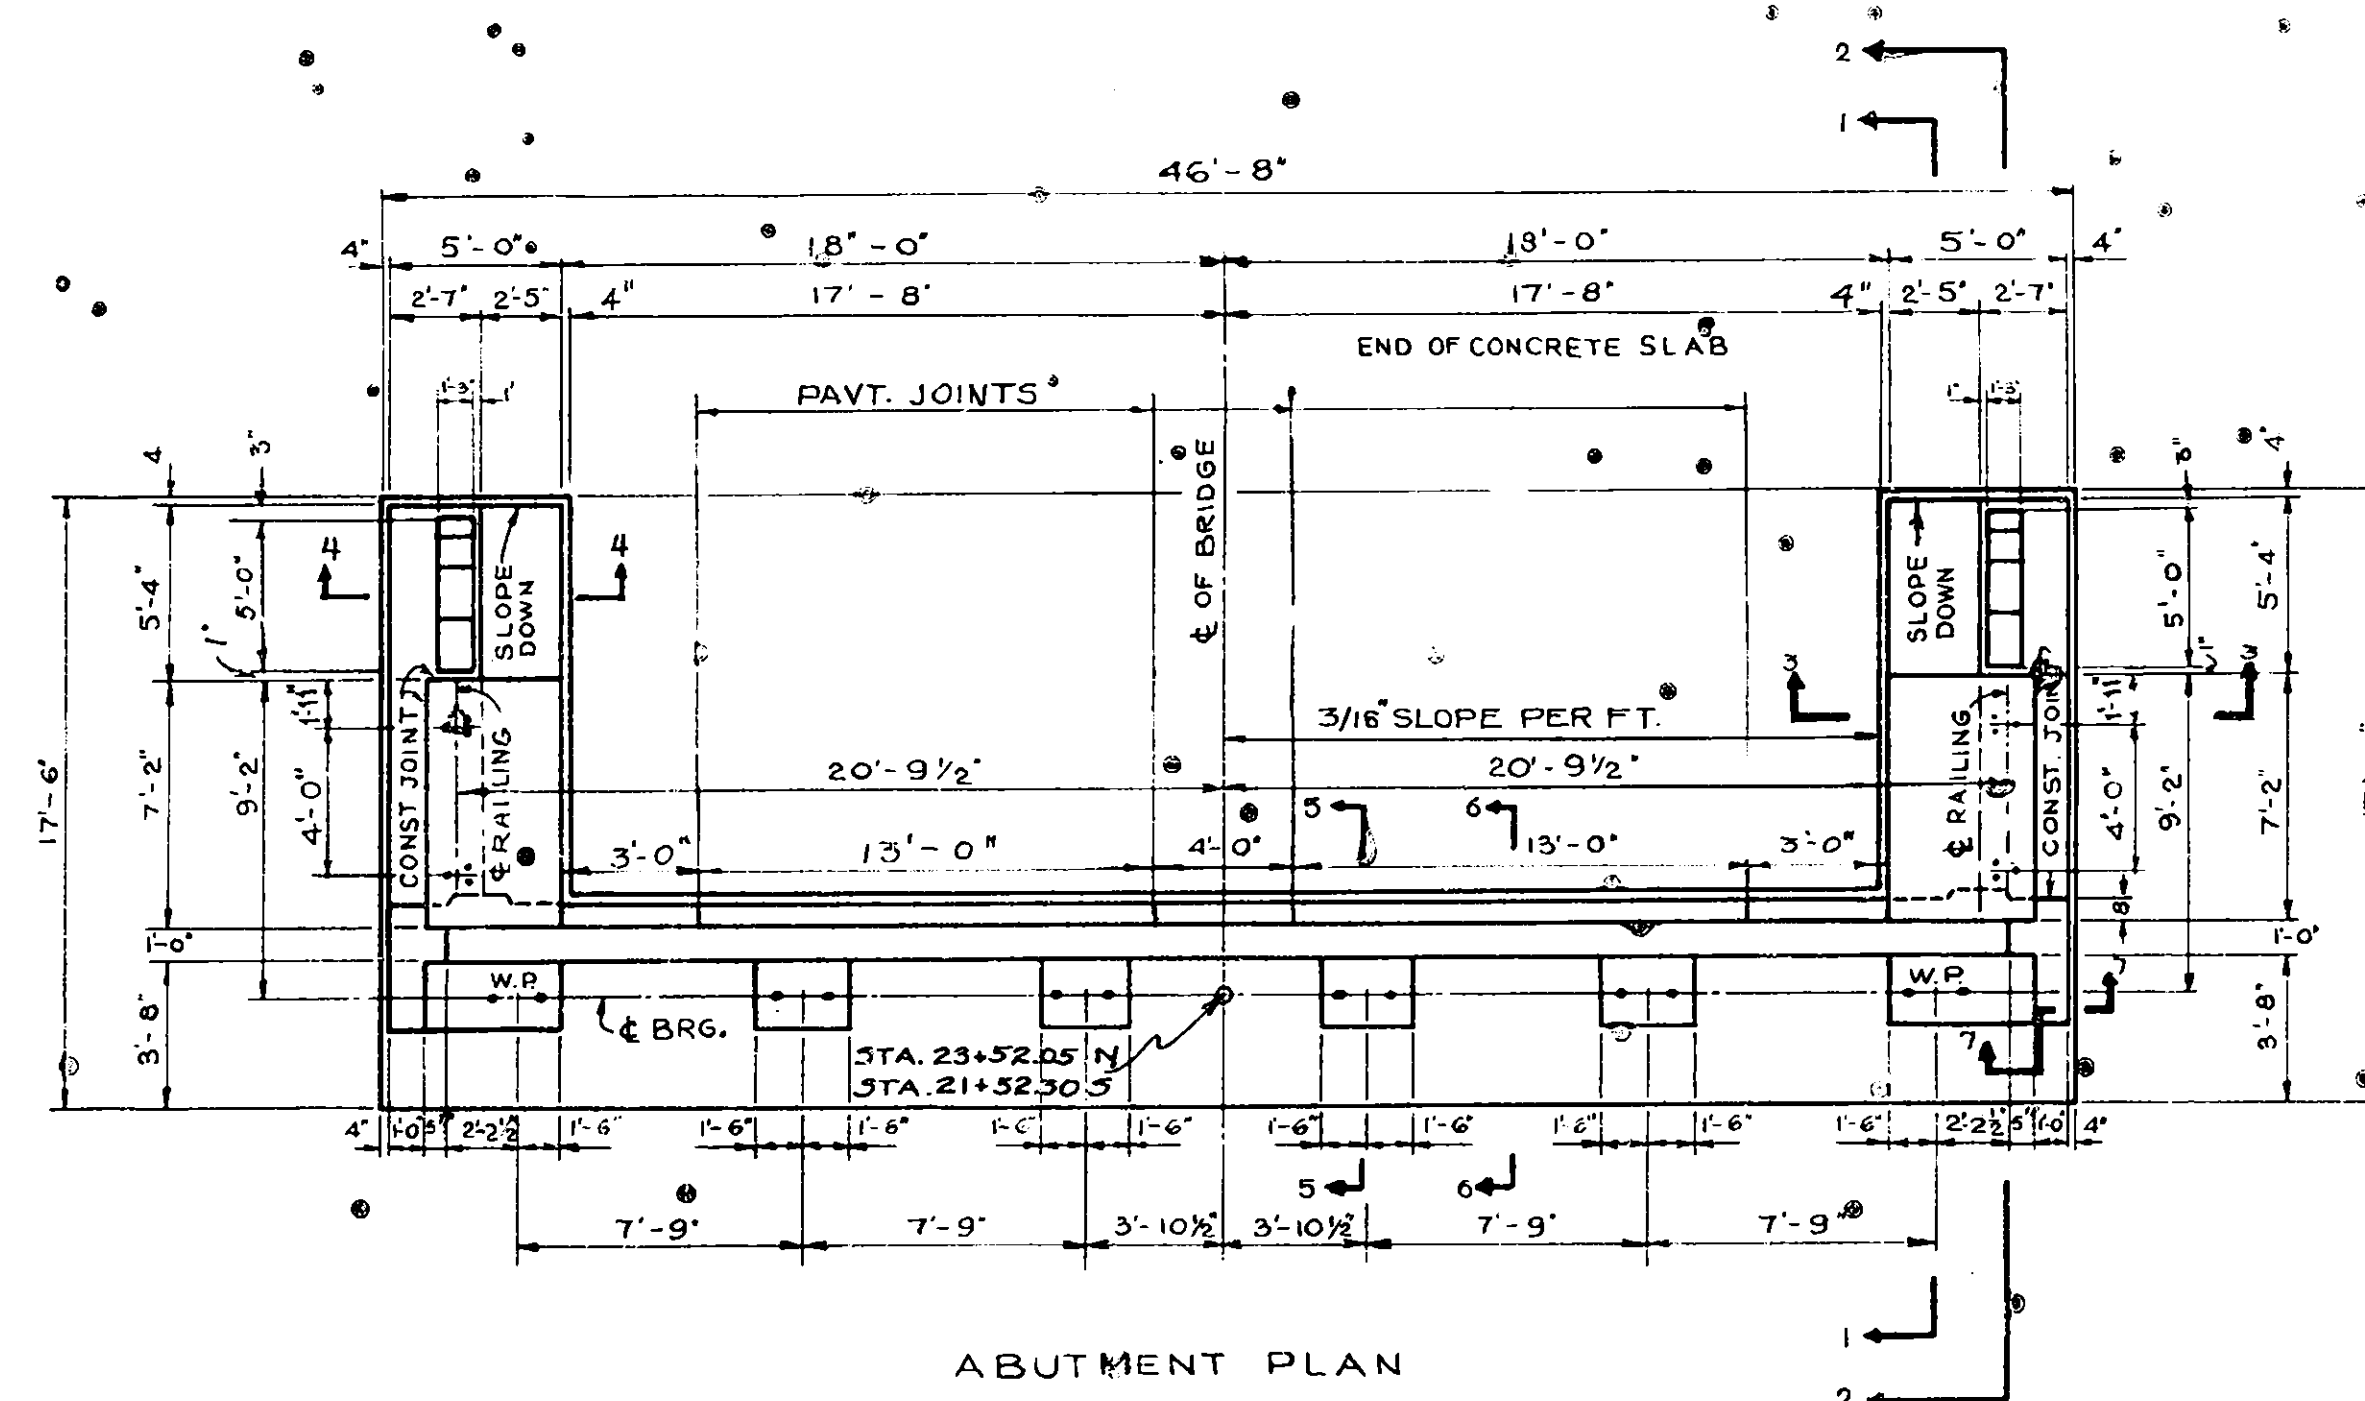
SECTIONAL PLAN
UNDER BRIDGE SEAT

ABUTMENT PLAN

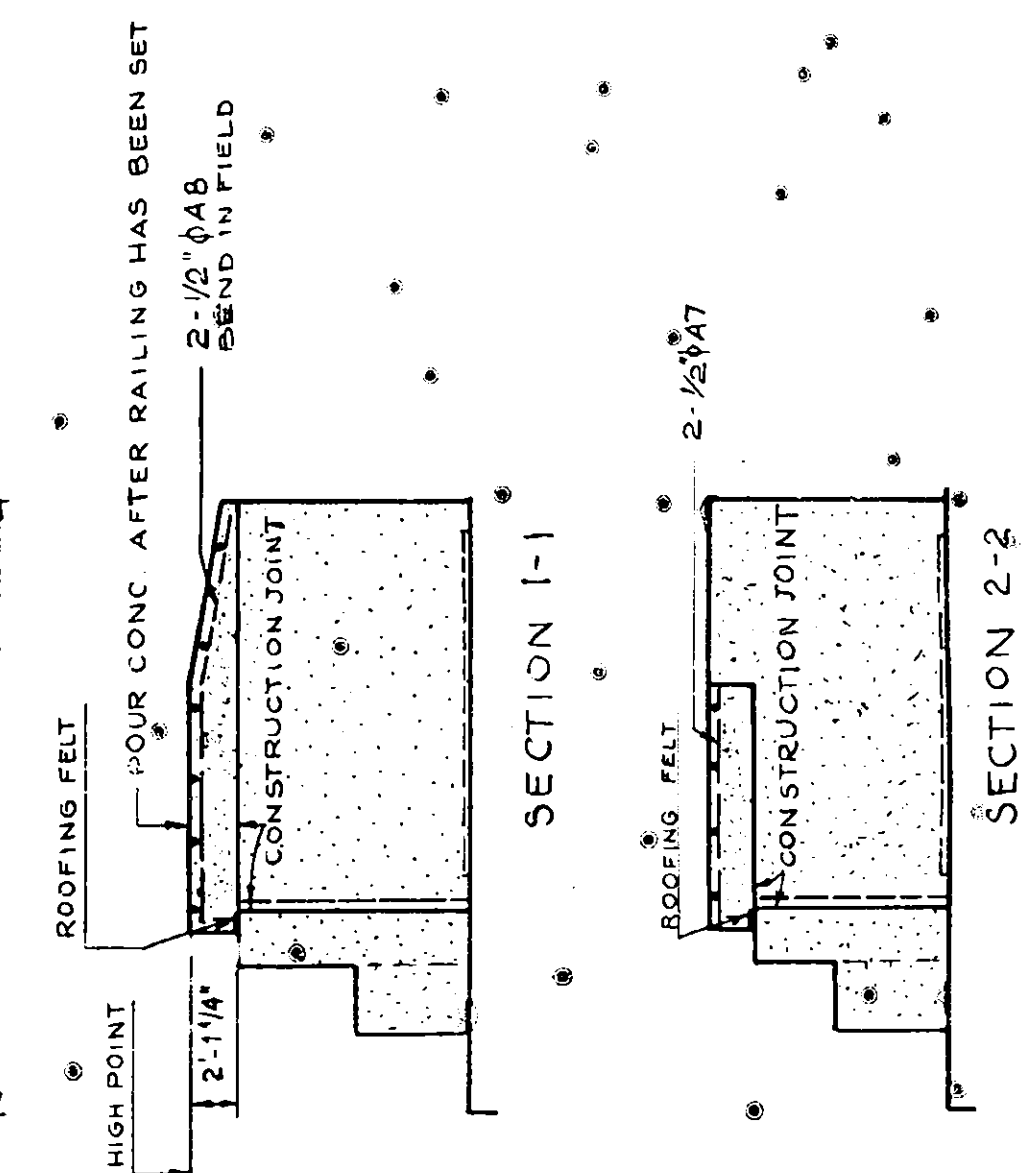


SECTION 1-1

SECTION 2-2

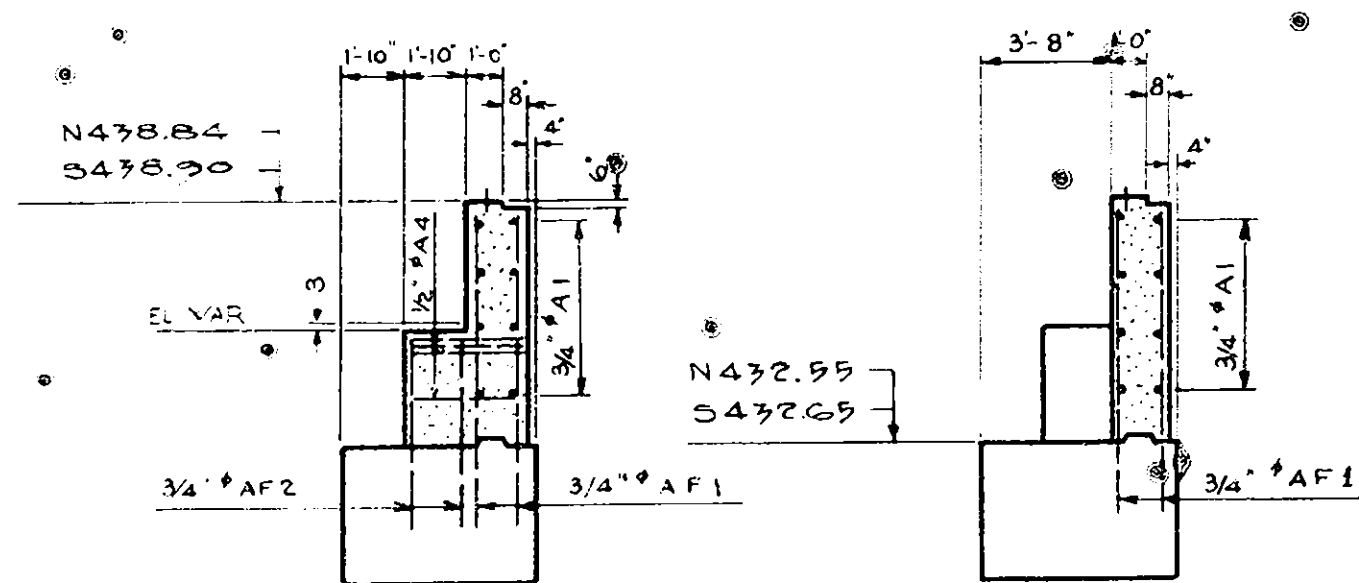


SECTION 5-5

SECTION 6-6

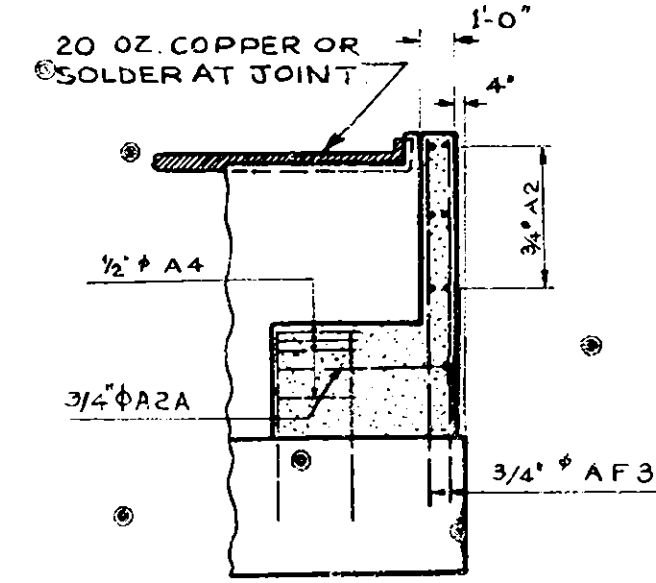

SECTION 7-7

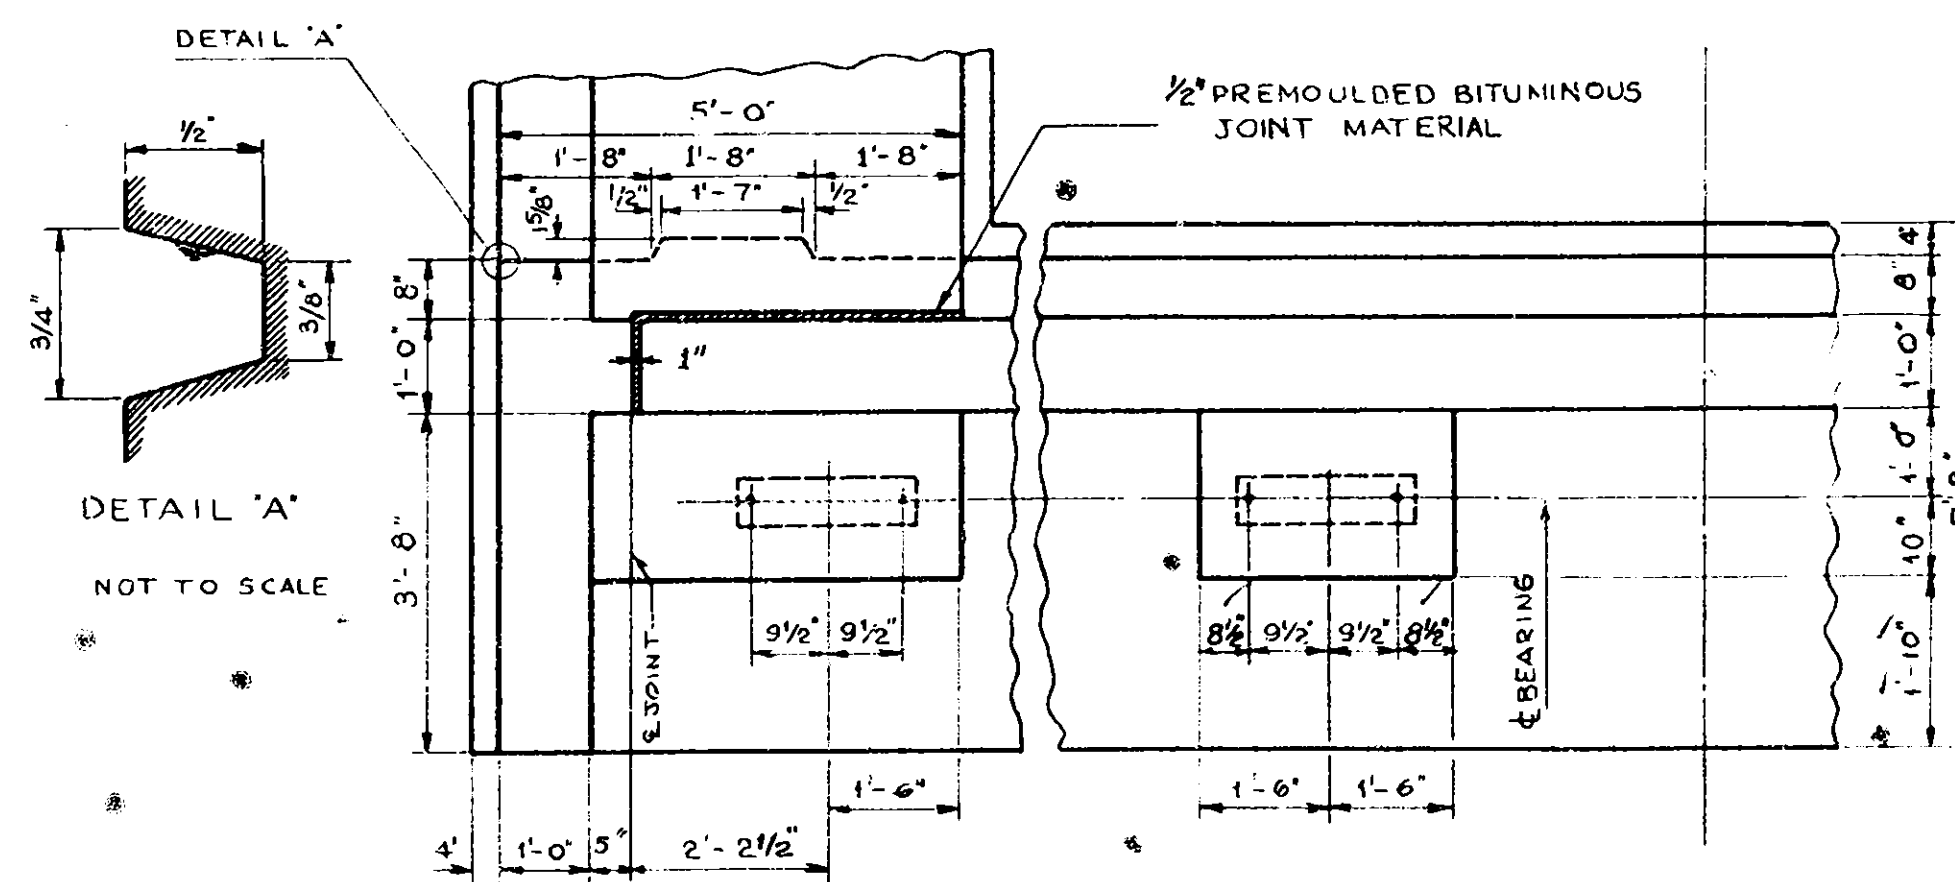BRIDGE SEAT DETAILS
SCALE 1/2\"/>

SCALE 3/16\"/>

* CROSS REFERENCE

FOR LAYOUT OF ABUTMENTS SEE SHEET 46
 FOR DETAILS OF REINFORCING BARS SEE SHEET 54
 FOR DETAILS OF ANCHOR BOLTS SEE SHEET 52
 FOR DETAILS OF ABUTMENT FOUNDATION SEE SHEET 46
 FOR DETAILS OF PYLONS SEE SHEET 53
 FOR DETAILS OF RAILING SEE SHEET 52
 FOR STRINGER LAYOUT SEE SHEET 49

SUBSTRUCTURE DETAILS

THOMPSON ROAD INTERCHANGE

MOHAWK SECTION

NEW YORK STATE THRUWAY

SHEET 47

PREPARED AND RECOMMENDED


 UROUHAUT & DOYLE CONSULTING ENGINEERS
 NEW YORK STATE PROFESSIONAL ENGINEERS

LICENSE NO. 5667

DATE


J. J. Doyle Feb 16-53

SUBSTRUCTURE QUANTITIES				
ITEM NO.	DESCRIPTION	UNIT	NEAT	ROUNDED
5	TRENCH CULVERT & BRIDGE EXCAVATION	C.Y.	260	300
15-2	PORTLAND CEMENT, TYPE 2	BBL.	600	616
15 N	NATURAL CEMENT, TYPE N	BBL.	83	87
18	CLASS 1A CONCRETE FOR STRUCTURES	C.Y.	412	420
28	BAR REINFORCEMENT FOR STRUCTURES	LB.	15000	47000
85-C	CAST IN PLACE CONCRETE PILES	L.F.	560	700
87	FURNISHING EQUIPMENT FOR DRIVING PILES	L. S.	NEC	NEC
92-S	SCREENED GRAVEL - LOOSE MEASURE	C.Y.	145	155
121	TOP SOIL PLACED FROM STOCK PILES	C.Y.	360	380
123	SEEDING	ACRE	.35	.4
124	SODDING	S.Y.	400	420
119	RUN OF BANK GRAVEL FILL	C.Y.	140	150

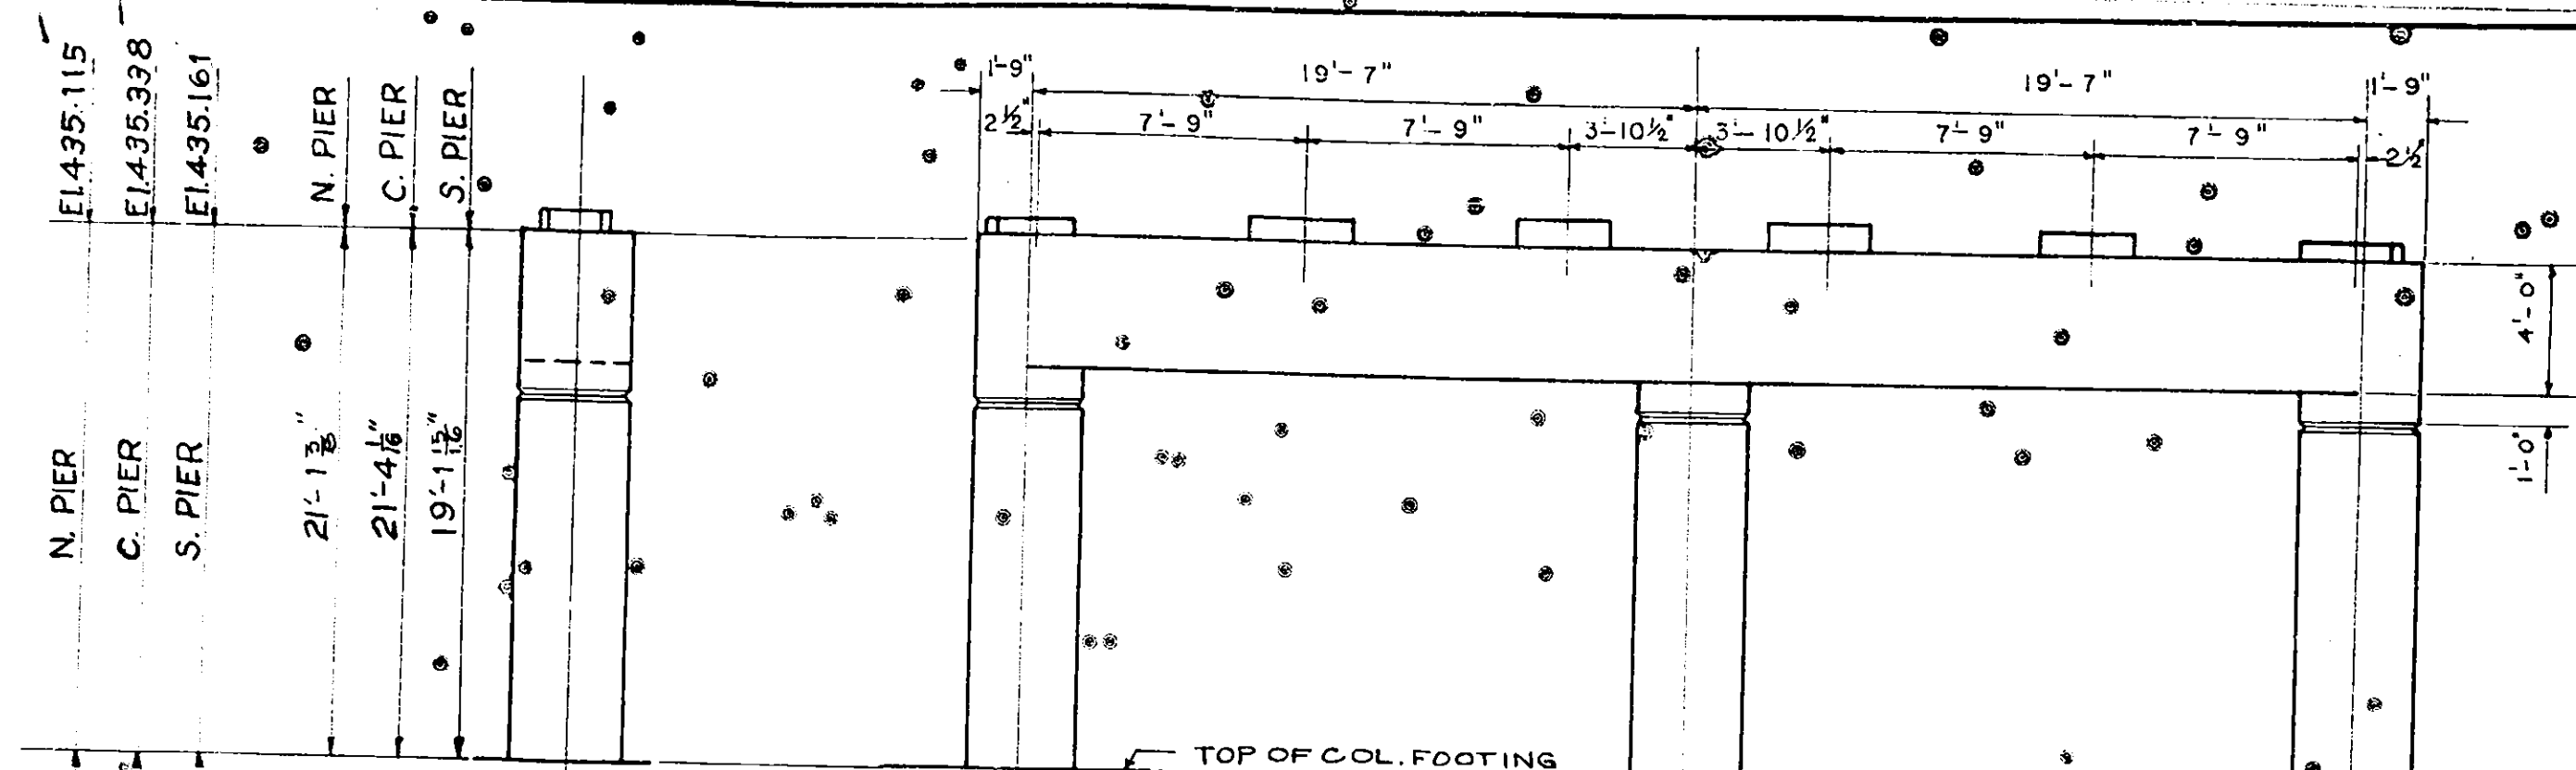


SIDE ELEVATION ALL PIERS



SCALE 3/16" = 1'-0"

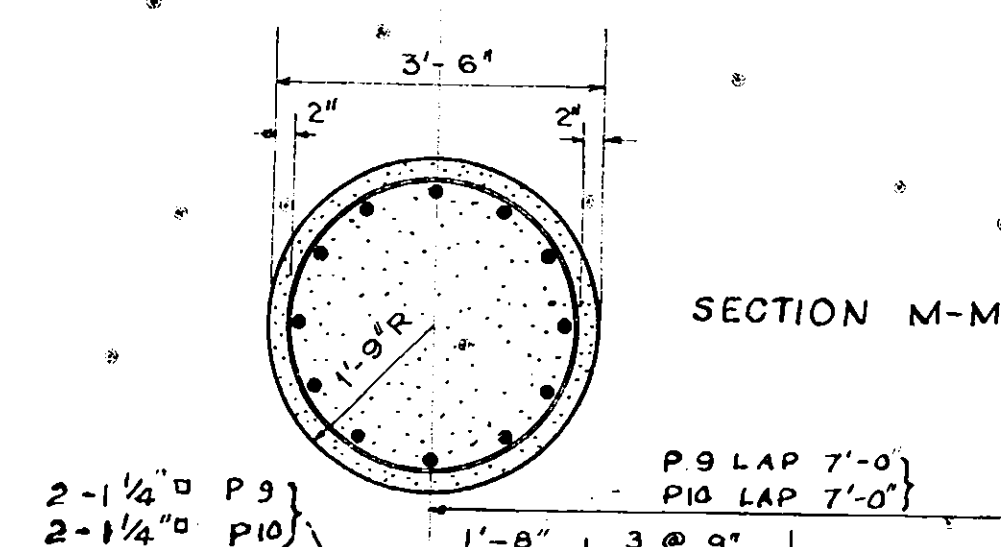

SECTION M-M

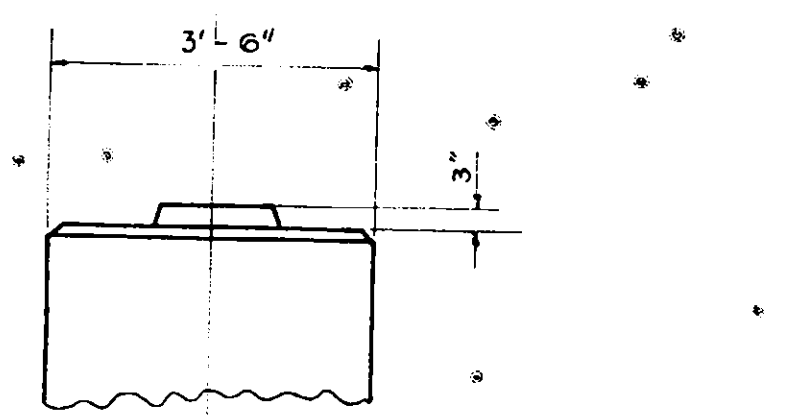

COL. KEY DETAILS

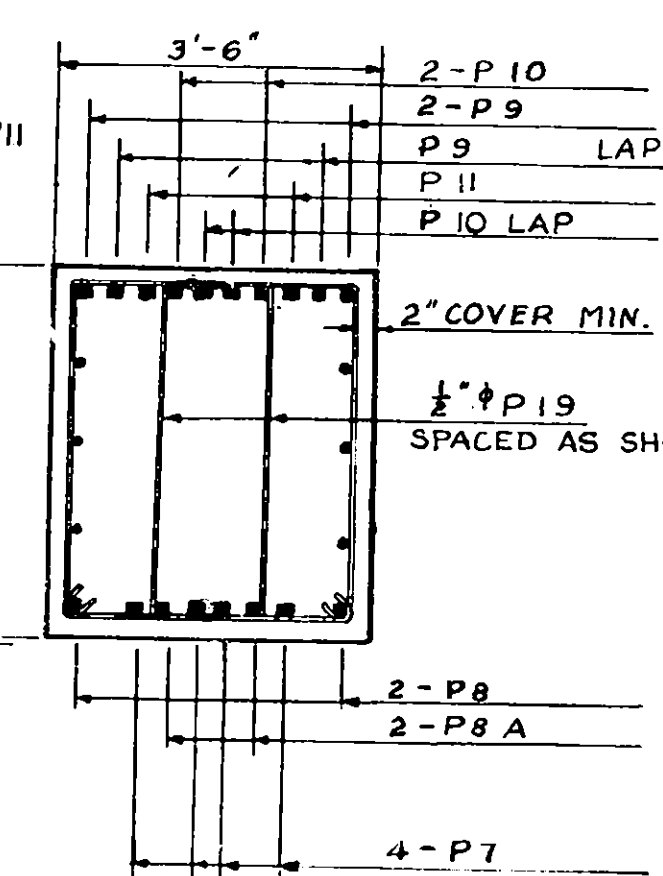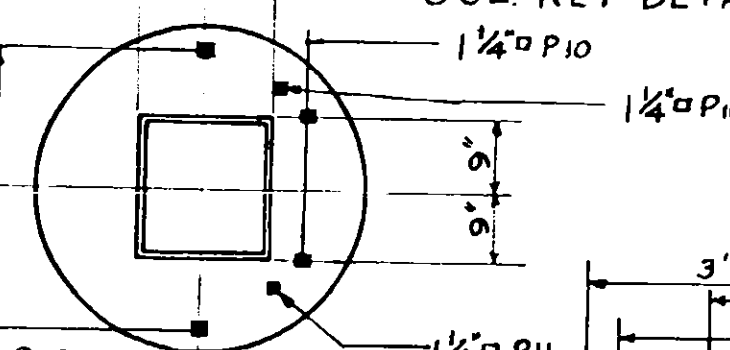

SECTION N-A

SUBSTRUCTURE


GENERAL NOTES

CONSTRUCTION JOINTS SHALL BE PLACED ONLY AS AND WHERE SHOWN ON THE PLANS, EXCEPT WHERE PERMISSION IN WRITING IS GIVEN BY THE DEPUTY CHIEF ENGINEER (BRIDGES), IN WHICH CASE, HIS SUPPLEMENTAL INSTRUCTIONS SHALL BE STRICTLY FOLLOWED.


AFTER THE CONCRETE IS CURED, THE CONTRACTOR SHALL APPLY A WATER-PROOFING OIL TREATMENT, AS DESCRIBED IN THE SPECIFICATIONS FOR M-41W TO ALL EXPOSED SURFACES.

ALL SHOE BEARING SURFACES SHALL BE CAST $\frac{1}{4}$ " ABOVE ELEVATIONS SHOWN ON THE PLANS, AND AFTER THE CONCRETE IS CURED, SHALL BE BUSH-HAMMERED TO THE REQUIRED ELEVATIONS.


THE CONTRACTOR'S ATTENTION IS DIRECTED TO THE SPECIAL NOTES FOR THIS STRUCTURE WHICH APPEAR IN THE PROPOSAL. PARTICULAR ATTENTION SHOULD BE GIVEN TO THE FOUNDATION NOTE WHICH BRIEFLY OUTLINES THE ANTICIPATED SUBSURFACE CONDITIONS AT THE SITE OF THE STRUCTURE, AND WHICH SPECIFIES CERTAIN REQUIREMENTS RELATIVE TO THE CONSTRUCTION.

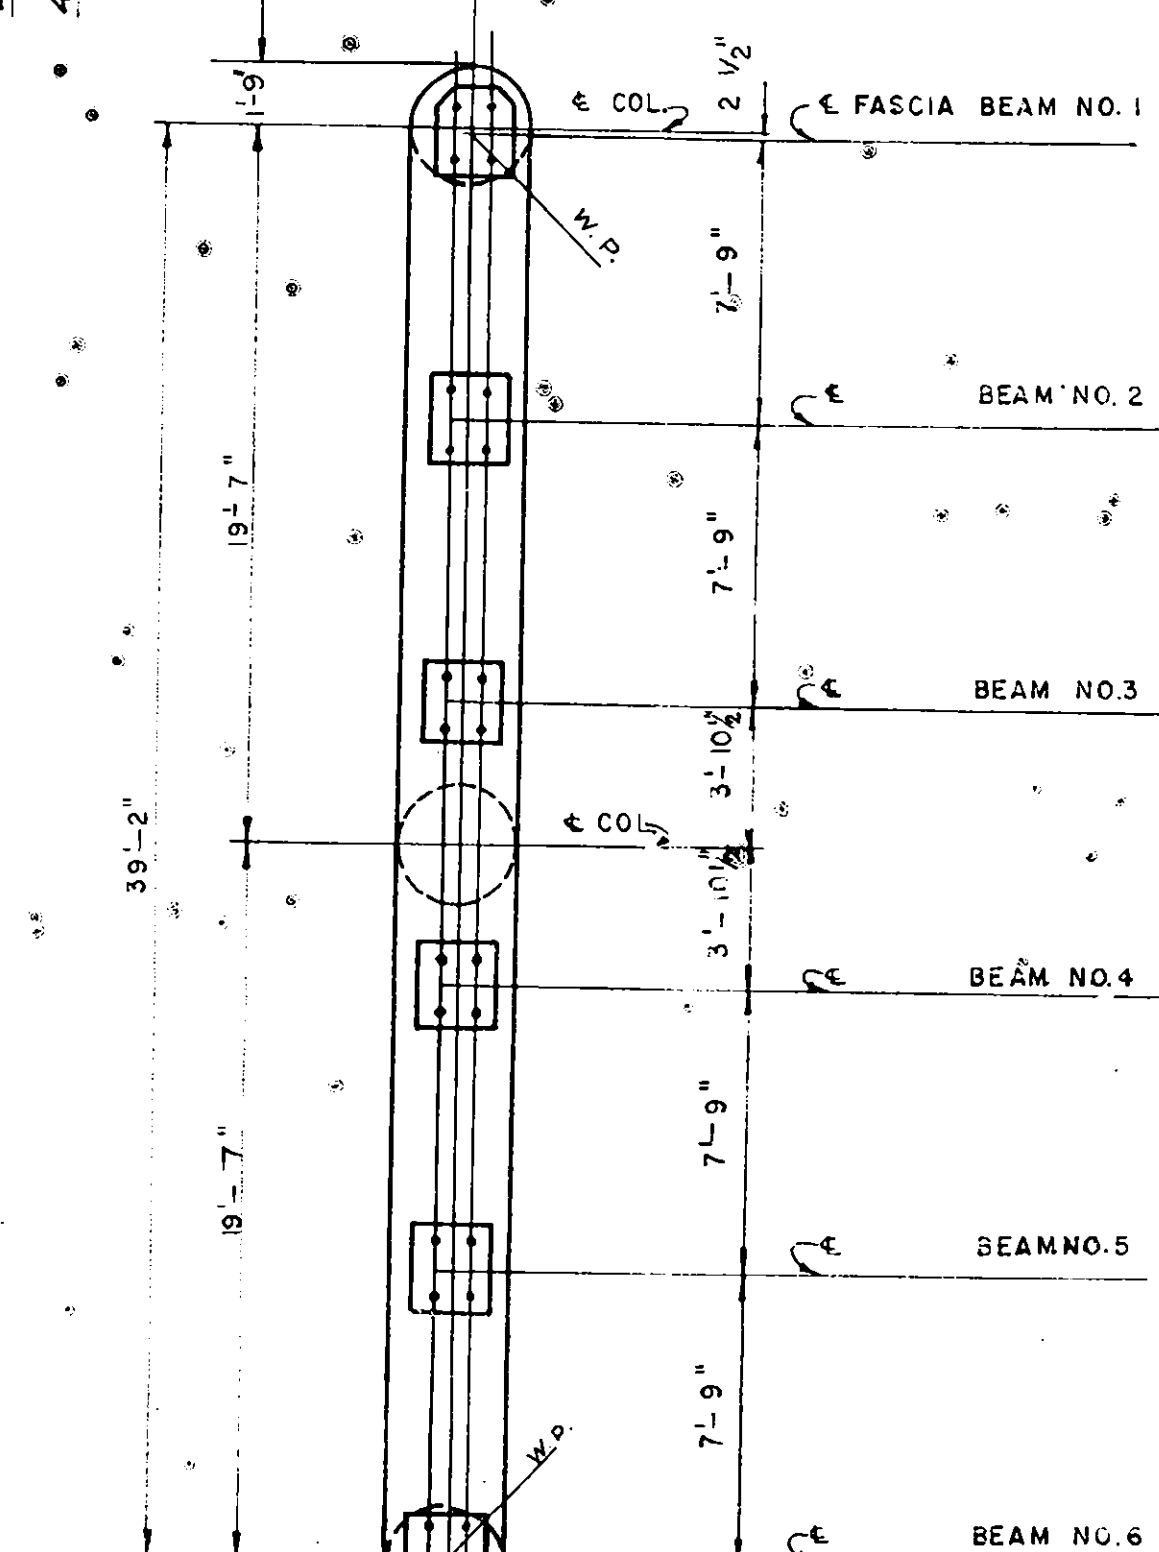

PIER PLAN ALL PIERS
SCALE 3/16"=1'-0"

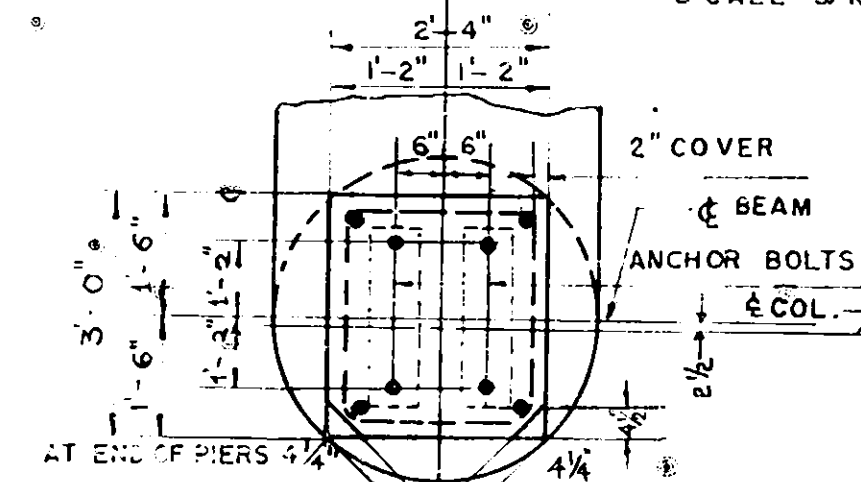

DETAIL OF PIER PAD
SCALE 1/2"=1'-0"

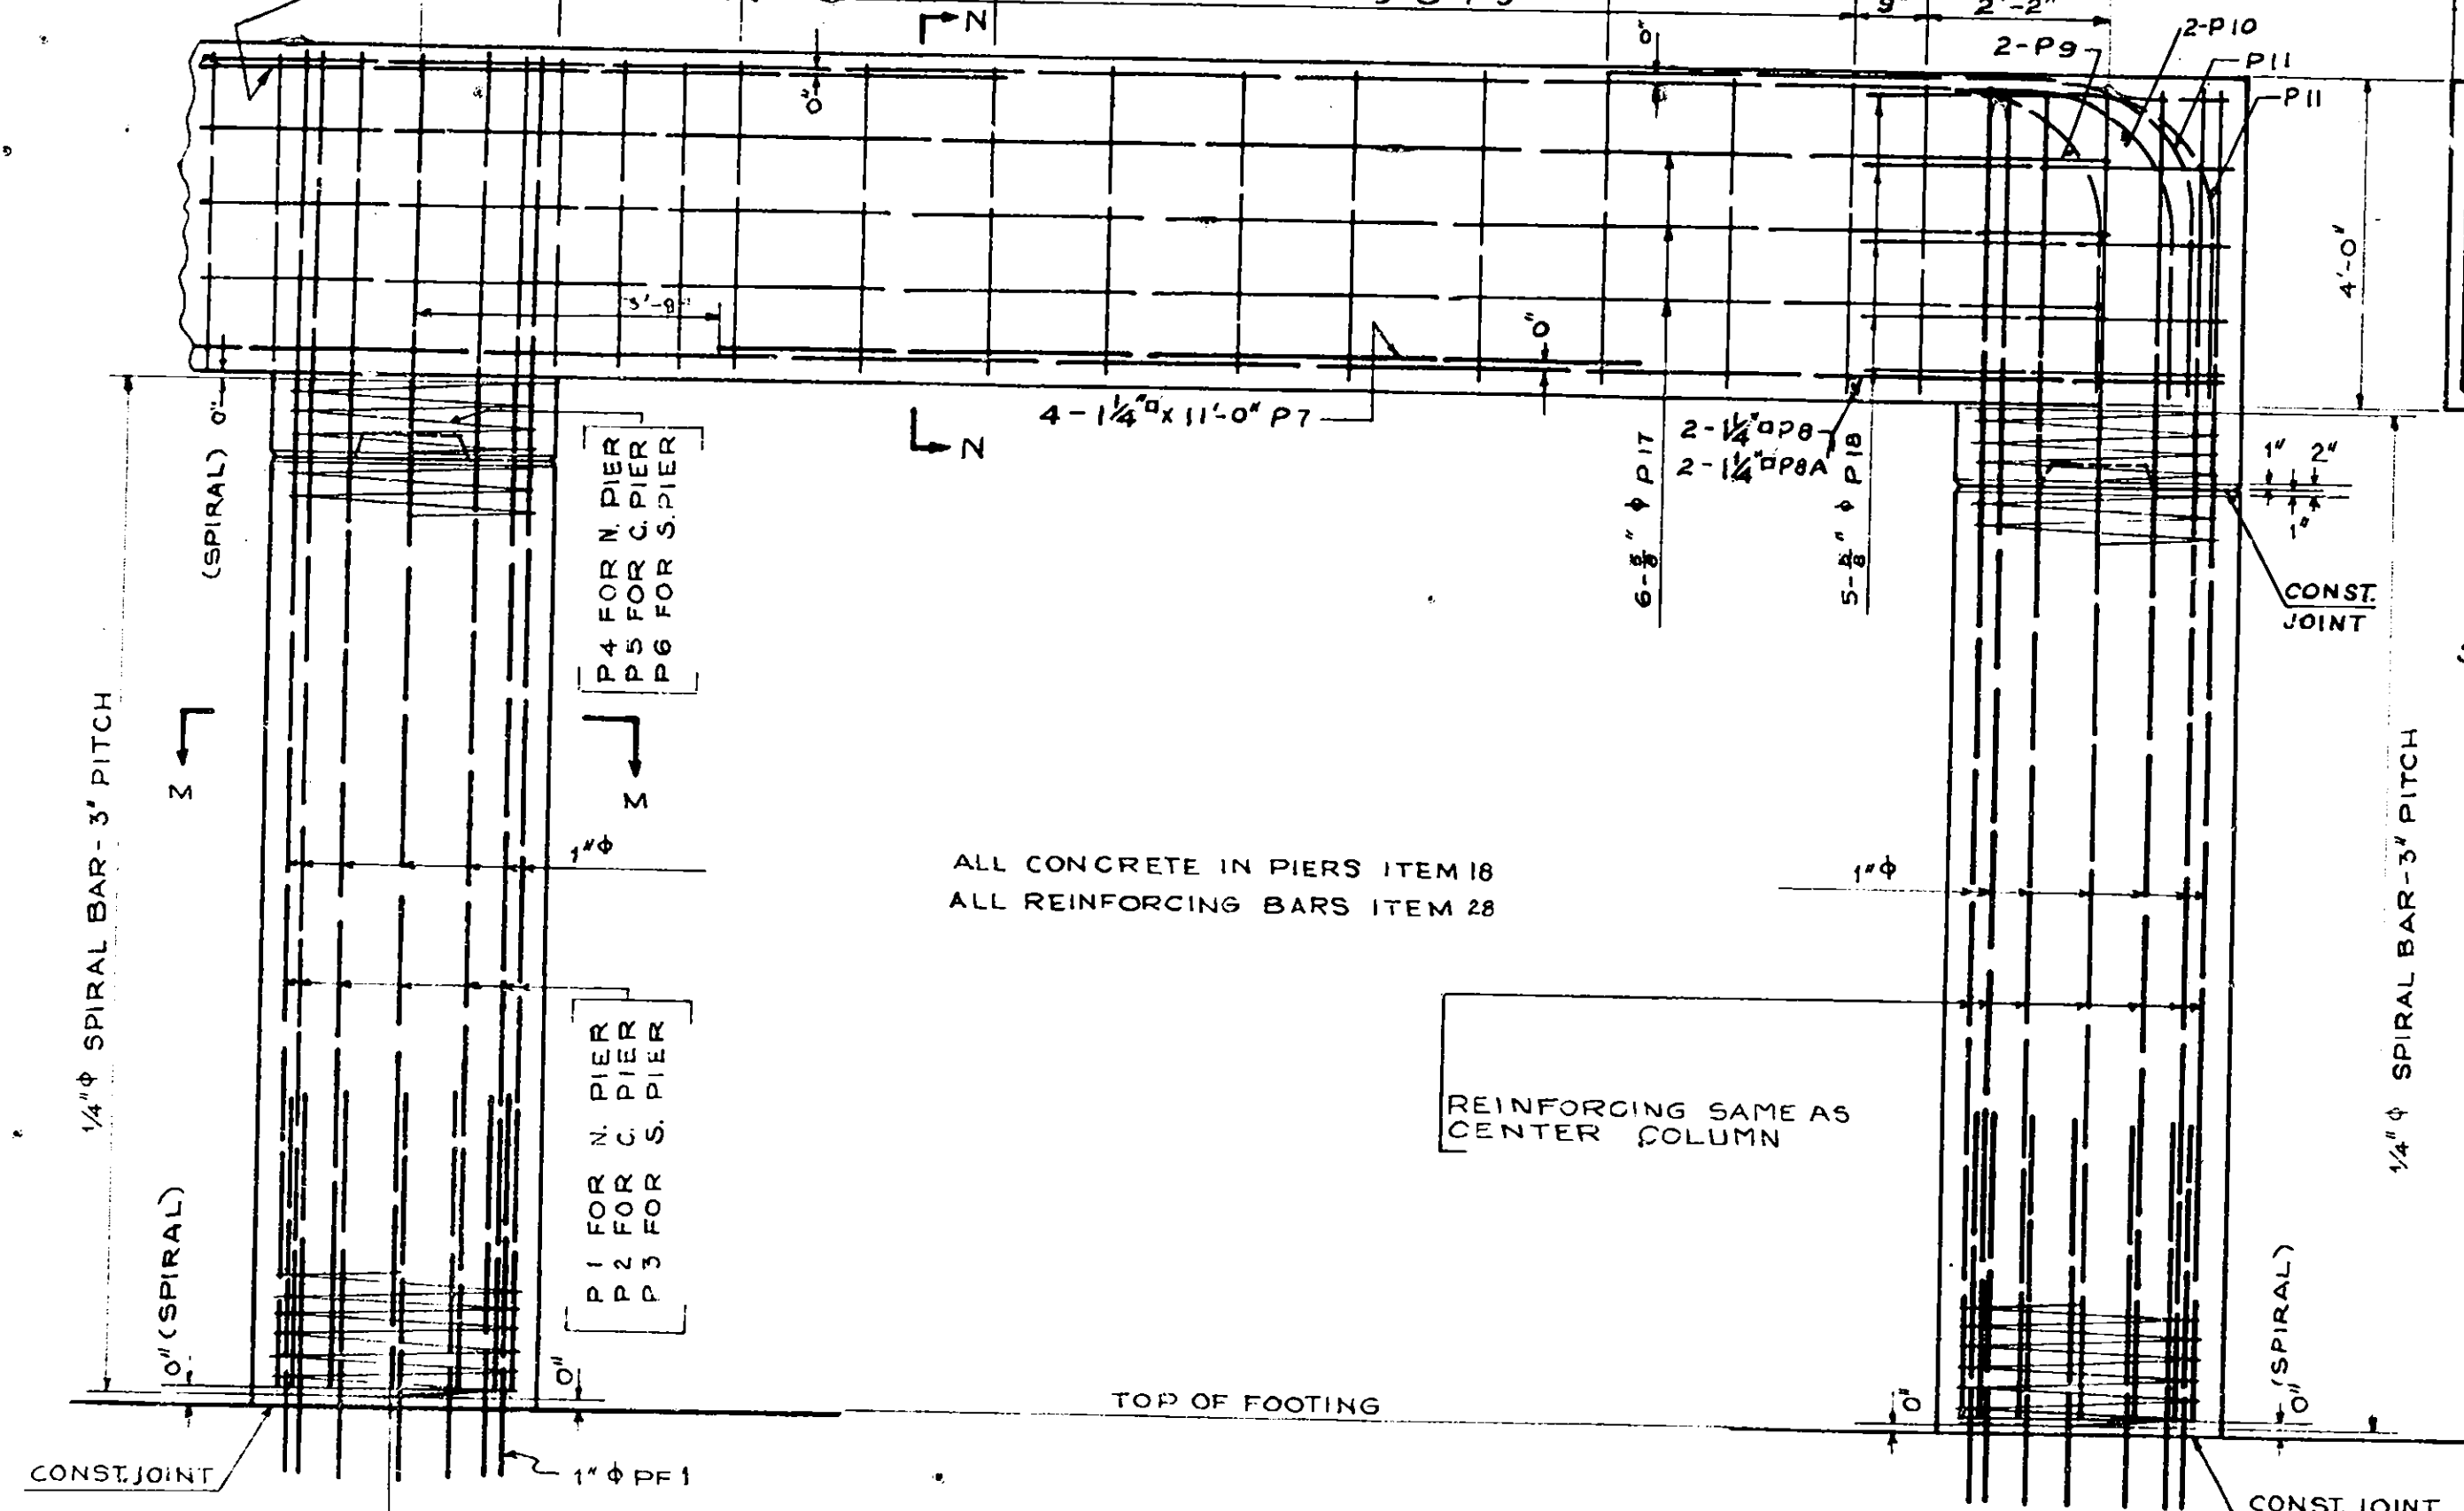

PIER DETAILS - ALL PIERS

SCALE $\frac{1}{2}'' = 1' 0''$

NOTE~ FOR LOCATION OF IDENTIFICATION PLATE,
SEE STANDARD SHEET 53-41.

CROSS REFERENCE

FOR LAYOUT OF PIERS SEE SHEET 46
FOR DETAILS OF REINFORCING BARS SEE SHEET 54
FOR DETAILS OF PIER FOUNDATIONS, SEE SHEET 46
FOR DETAILS OF ANCHOR BOLTS SEE SHEET 52

PREPARED AND RECOMMENDED:

URQUHART & DOYLE, CONSULTING ENGINEERS
NEW YORK STATE PROFESSIONAL ENGINEERS LICENSE NO. 5667

INCEERS *O. W. Ogden* Feb 16-53 DATE

SUBSTRUCTURE DETAILS


THOMPSON ROAD INTERCHANGE

MOHAWK SECTION


NEW YORK STATE THRUWAY.

COUNTY	SHEET NO.	TOTAL SHEETS
ONONDAGA	48	64
STATE THRUWAY, MOHAWK SECTION, SUBDIV. 6B		
INTERCHANGE AT THOMPSON ROAD		


48R

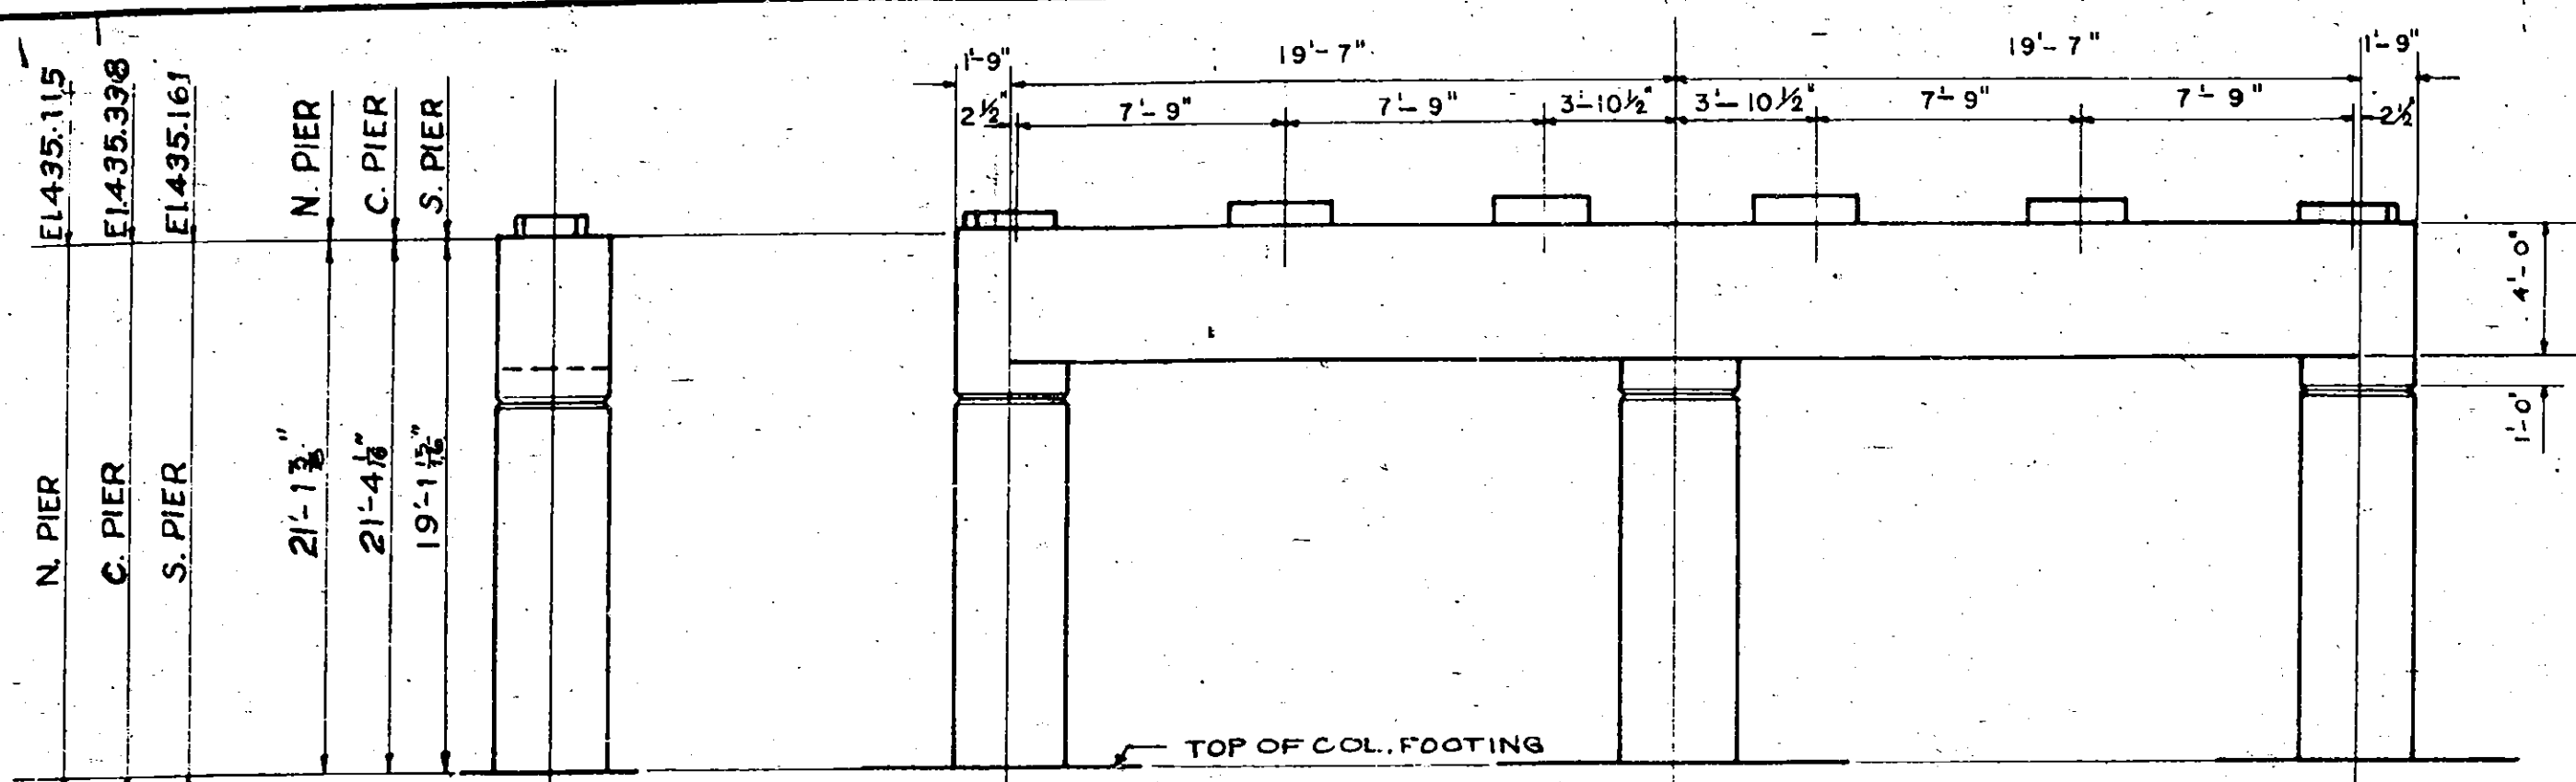


SIDE ELEVATION ALL PIERS
SCALE 3/16"=1'-0"

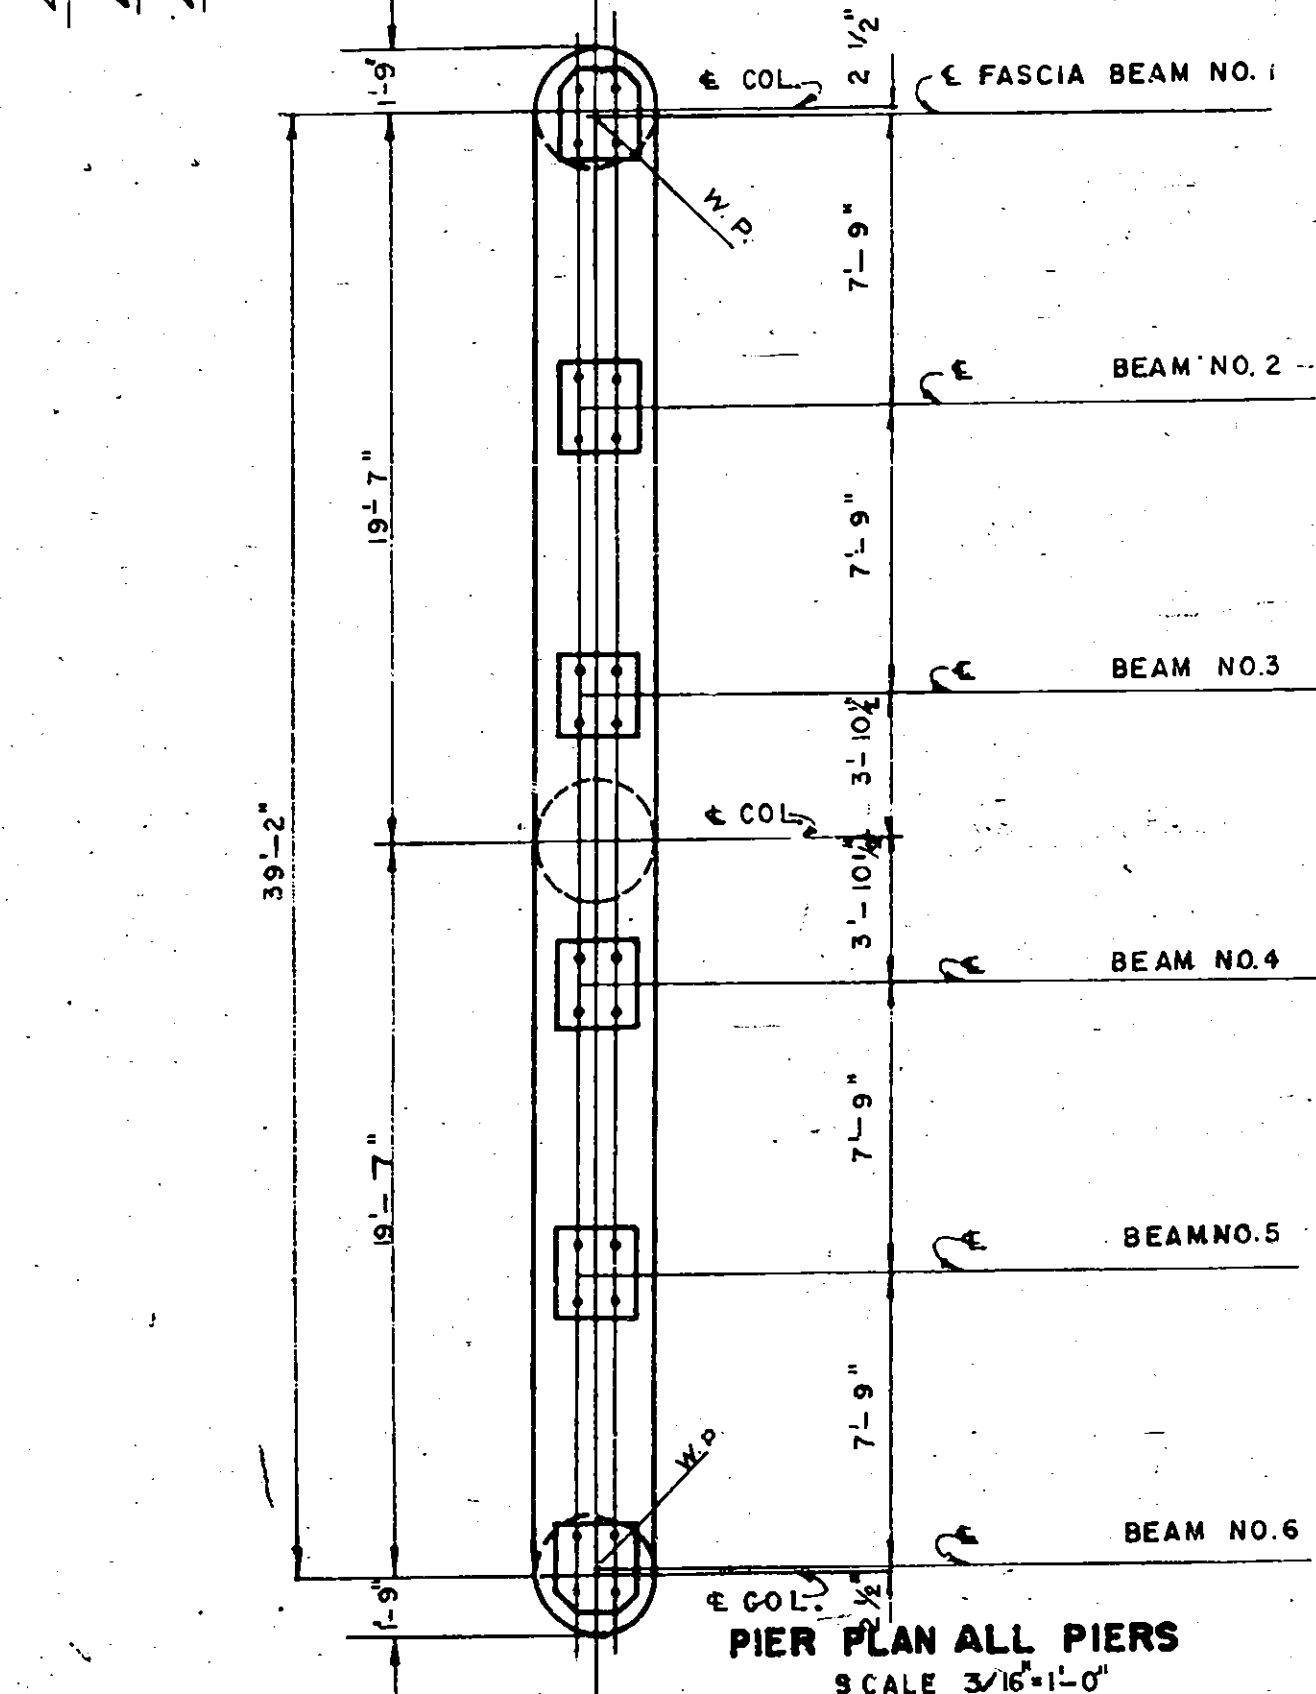


PIER PLAN ALL PIERS
SCALE 3/16"=1'-0"

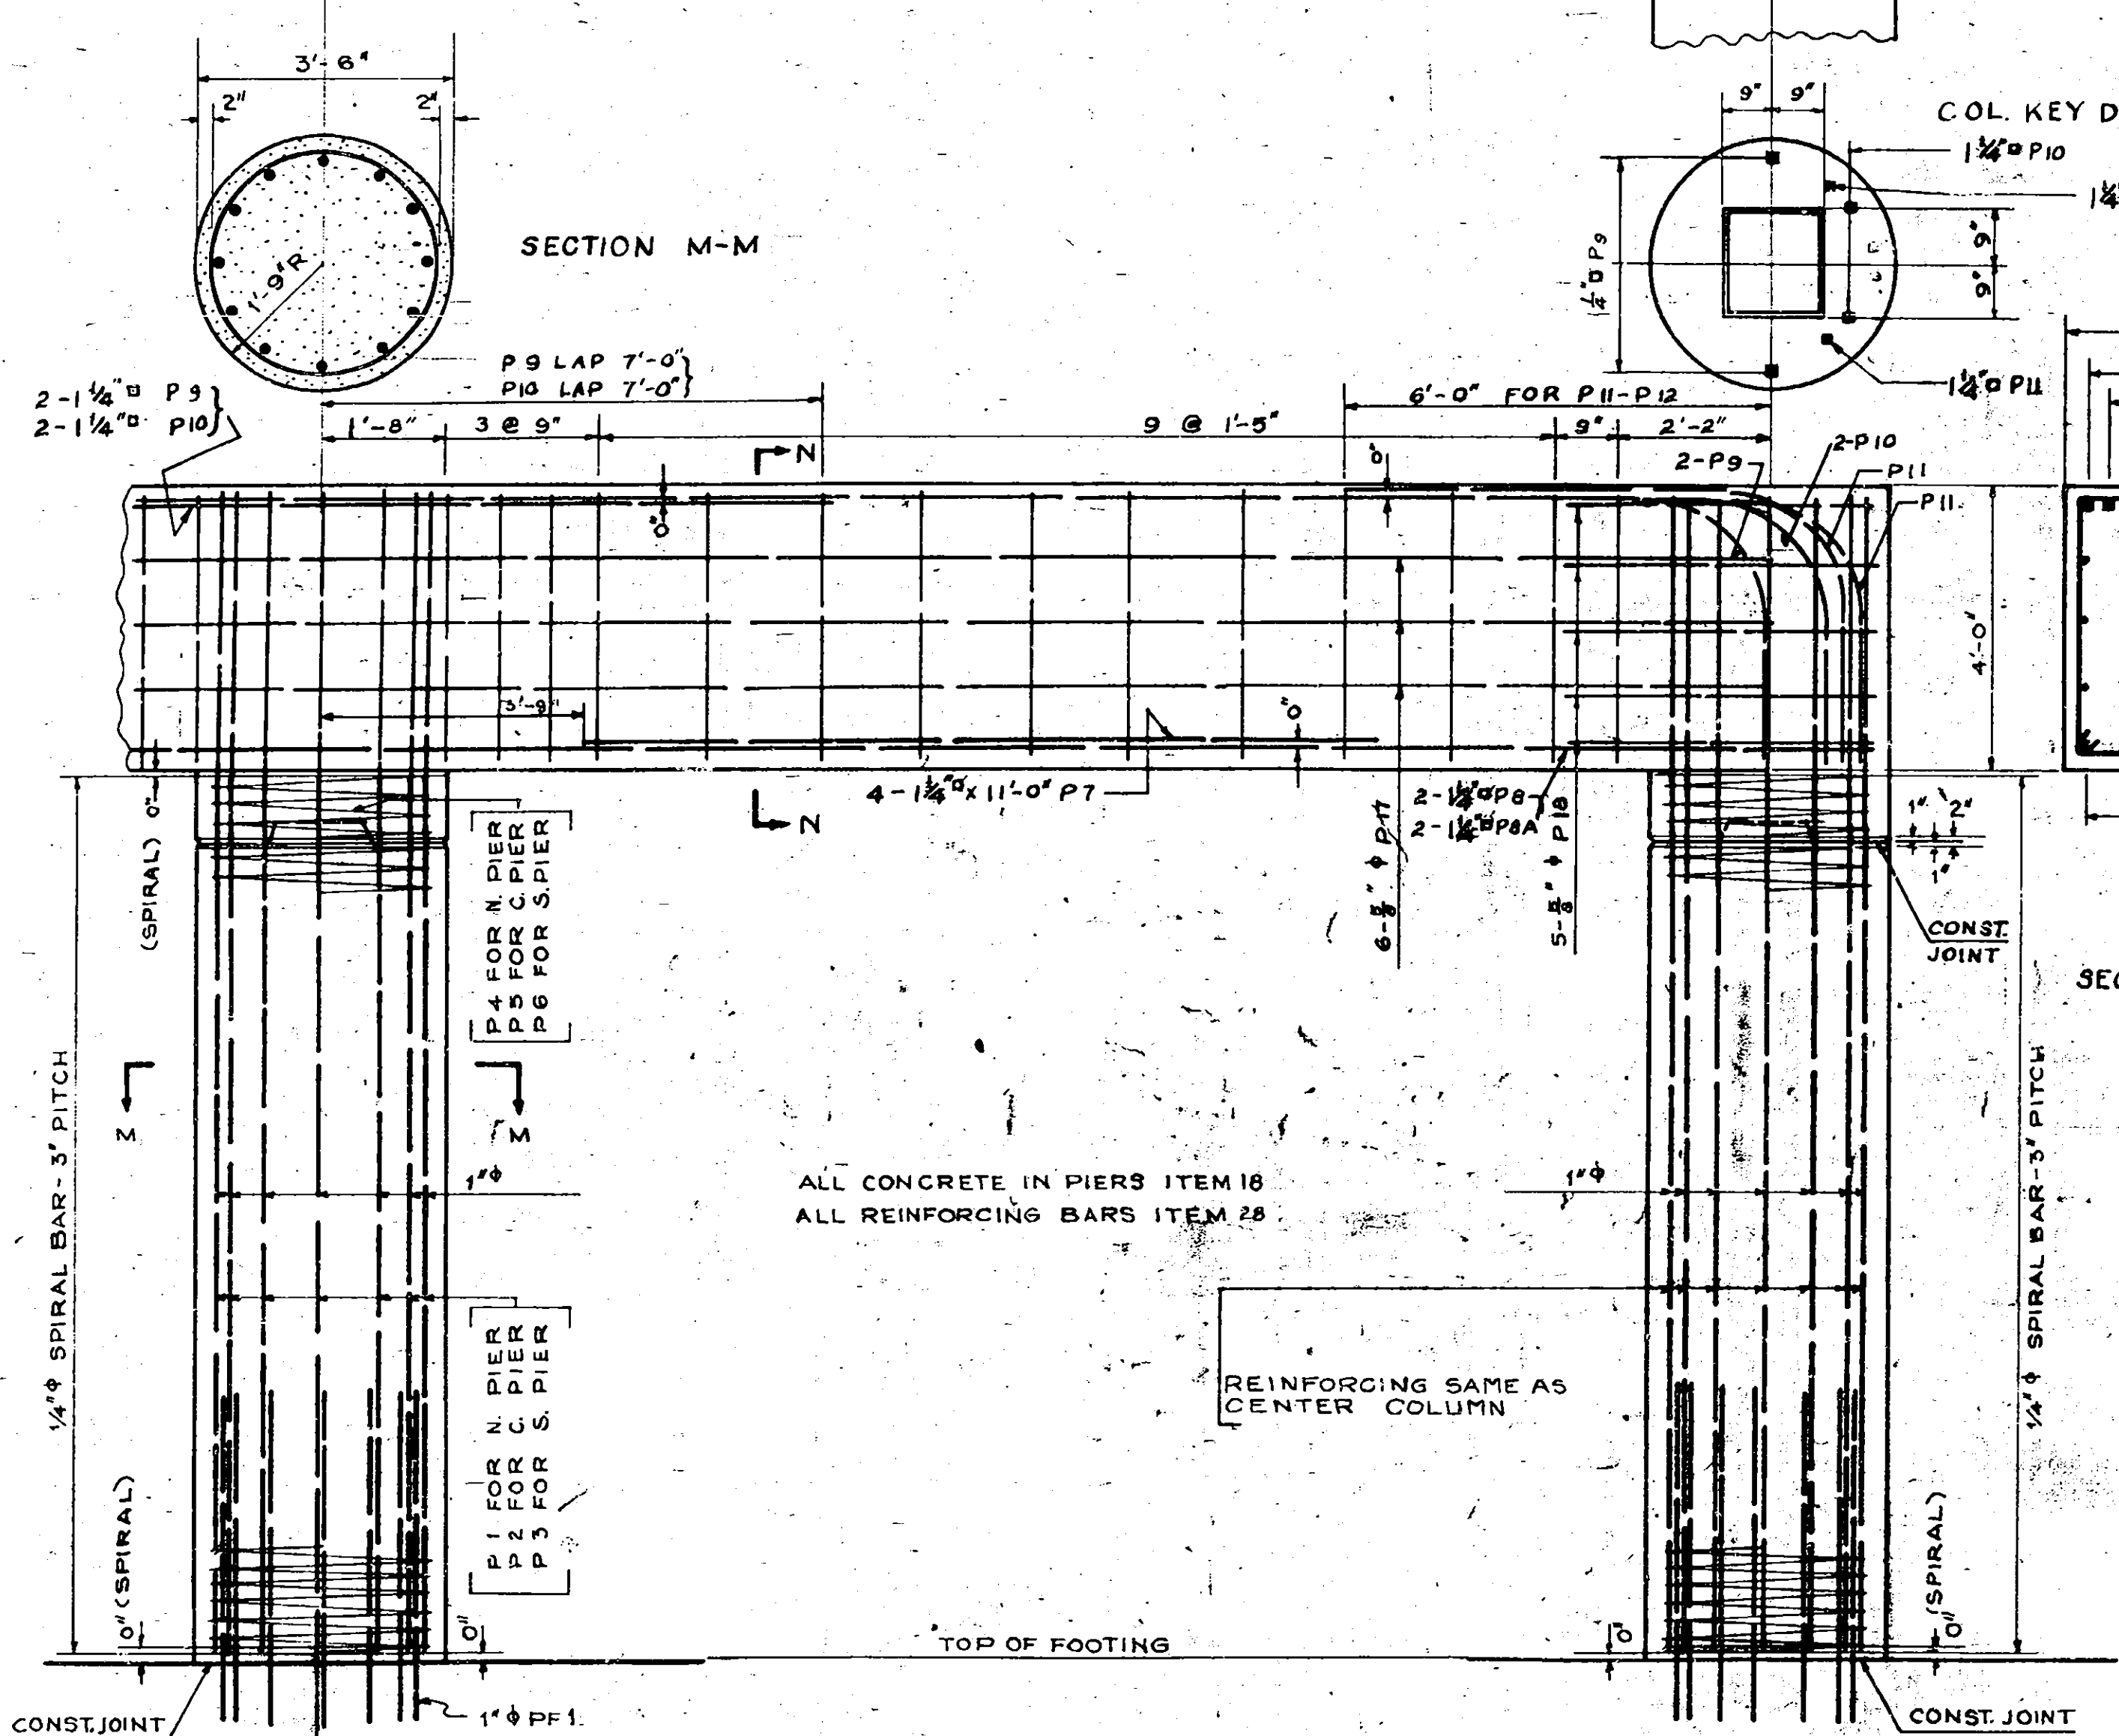

PIER DETAILS - ALL PIERS
SCALE 1/2"=1'-0"

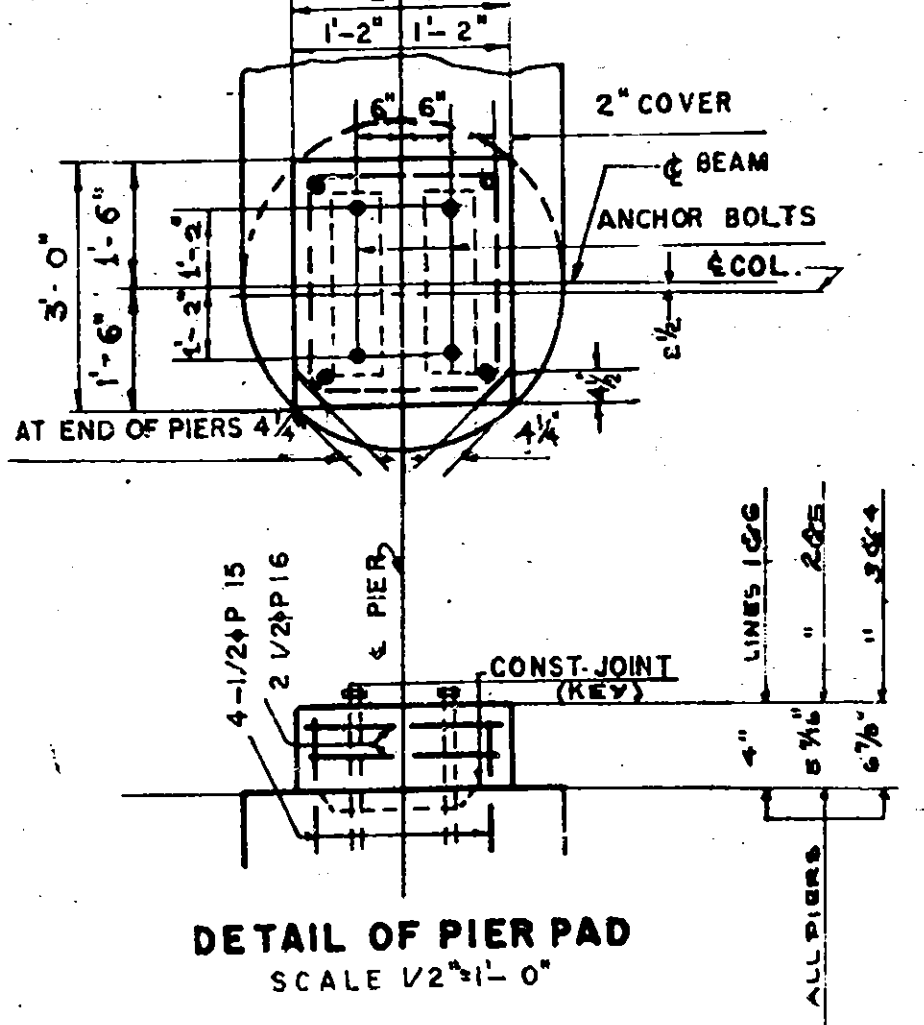

DETAIL OF PIER PAD
SCALE 1/2"=1'-0"

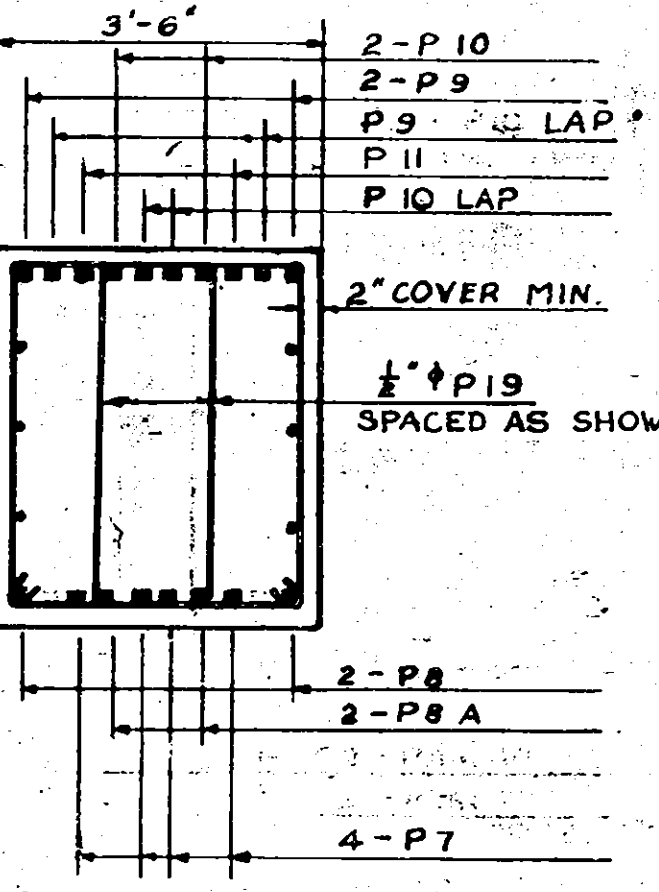

SECTION N-N

ITEM NO.	DESCRIPTION	UNIT	NEAT	ROUNDED
5	TRENCH CULVERT & BRIDGE EXCAVATION	CY.	260	300
15-2	PORTLAND CEMENT, TYPE 2	BBL.	600	616
15-N	NATURAL CEMENT, TYPE N	BBL.	83	87
18	CLASS 1A CONCRETE FOR STRUCTURES	CY.	412	420
28	BAR REINFORCEMENT FOR STRUCTURES	LB.	45000	47000
65-C	CAST IN PLACE CONCRETE PILES	L.F.	560	700
87	FURNISHING EQUIPMENT FOR DRIVING PILES	L.S.	WEC	WEC
92-S	SCREEFED GRAVEL - LOOSE MEASURE	CY.	45	55
121	TOP SOIL PLACED FROM STOCK PILES	CY.	320	320
123	SEEDING	ACRE.	35	4
124	SODDING	S.Y.	400	420
119	RUN OF BANK GRAVEL FILL	CY.	140	150

SUBSTRUCTURE
GENERAL NOTES

CONSTRUCTION JOINTS SHALL BE PLACED ONLY AS AND WHERE SHOWN ON THE PLANS, EXCEPT WHERE PERMISSION IN WRITING IS GIVEN BY THE DEPUTY CHIEF ENGINEER (BRIDGES), IN WHICH CASE, HIS SUPPLEMENTAL INSTRUCTIONS SHALL BE STRICTLY FOLLOWED.

AFTER THE CONCRETE IS CURED, THE CONTRACTOR SHALL APPLY A WATER-PROOFING OIL TREATMENT, AS DESCRIBED IN THE SPECIFICATIONS FOR M-41W TO ALL EXPOSED SURFACES.

ALL SHOE BEARING SURFACES SHALL BE CAST 1/4" ABOVE ELEVATIONS SHOWN ON THE PLANS, AND AFTER THE CONCRETE IS CURED, SHALL BE BUSH-HAMMERED TO THE REQUIRED ELEVATIONS.

THE CONTRACTOR'S ATTENTION IS DIRECTED TO THE SPECIAL NOTES FOR THIS STRUCTURE WHICH APPEAR IN THE PROPOSAL. PARTICULAR ATTENTION SHOULD BE GIVEN TO THE FOUNDATION NOTE WHICH BRIEFLY OUTLINES THE ANTICIPATED SUBSURFACE CONDITIONS AT THE SITE OF THE STRUCTURE, AND WHICH SPECIFIES CERTAIN REQUIREMENTS RELATIVE TO THE CONSTRUCTION.

BUILT ACCORDING TO PLAN

SUBSTRUCTURE DETAILS
THOMPSON ROAD INTERCHANGE
MOHAWK SECTION
NEW YORK STATE THRUWAY


CROSS REFERENCE
FOR LAYOUT OF PIERS SEE SHEET 46
FOR DETAILS OF REINFORCING BARS SEE SHEET 54
FOR DETAILS OF PIER FOUNDATIONS SEE SHEET 46
FOR DETAILS OF ANCHOR BOLTS SEE SHEET 52

SUPERSTRUCTURE
GENERAL NOTES

THE DESIGN OF THE STRUCTURE IS BASED ON A.A.S.H.O. SPECIFICATIONS, 1949. H20-S16-44 LOADING, AND CURRENT MODIFICATIONS AND ADDITIONS.
ALL CONCRETE OF SUPERSTRUCTURE SHALL BE ITEM 18, EXCEPT CONCRETE OF PYLONS WHICH SHALL BE ITEM 19, AND CEMENT CONCRETE PAVEMENT, WHICH SHALL BE ITEM 47-BM.
THE COST OF FURNISHING AND INSTALLING METAL EXPANSION MATERIAL, METAL WATER STOP, PREMOULDED BITUMINOUS JOINT MATERIAL, CAULKING COMPOUND, PARA-PLASTIC, SPONGE RUBBER, ASPHALT ROOFING FELT, ETC. SHALL BE INCLUDED IN THE BID PRICES OF THE RESPECTIVE CONCRETE ITEMS OF THE CONTRACT.
ALL MATERIALS, WORKMANSHIP AND FABRICATION SHALL CONFORM TO NEW YORK STATE DEPARTMENT OF PUBLIC WORKS SPECIFICATIONS, JANUARY 2, 1951, AND CURRENT MODIFICATIONS AND ADDITIONS.
WHERE CAULKING COMPOUND IS TO CONTACT CONCRETE SURFACES, SUCH CONCRETE SHALL BE THOROUGHLY CLEANED AND DRY, AND PRIMED WITH A PRIMING COAT AT LEAST 30 MINUTES BEFORE THE APPLICATION OF CAULKING COMPOUND. THIS WORK SHALL BE DONE BY EXPERIENCED MEN, AND THE COMPLETE OPERATION SHALL BE SPECIALLY DIRECTED BY THE ENGINEER.
CONSTRUCTION JOINTS SHALL BE PLACED ONLY AS AND WHERE SHOWN ON THE PLANS, EXCEPT WHEN PERMISSION IN WRITING IS GIVEN BY THE DEPUTY CHIEF ENGINEER OF BRIDGES, IN WHICH CASE HIS SUPPLEMENTAL INSTRUCTION SHALL BE STRICTLY FOLLOWED.
AFTER THE CONCRETE IS CURED, THE CONTRACTOR SHALL APPLY A WATERPROOFING OIL TREATMENT, AS DESCRIBED IN THE SPECIFICATIONS FOR M-41W TO ALL EXPOSED SURFACES EXCEPT THE UNDERSIDE OF SLABS. TWO APPLICATIONS OF WATERPROOFING OIL TREATMENT SHALL BE APPLIED AT THE TOP OF THE SLAB. THE SECOND APPLICATION SHALL BE APPLIED TWO DAYS PRIOR TO THE PLACING OF THE PAVEMENT OR SIDEWALK.
IMMEDIATELY BEFORE PLACING PAVEMENT CONCRETE, THE CONCRETE SURFACE OR SURFACES UPON WHICH IT IS TO BE PLACED SHALL BE THOROUGHLY WETTED DOWN CONTINUOUSLY FOR ONE HOUR, IF THE AIR TEMPERATURE IS ABOVE 50° F. PAYMENT FOR THIS WORK WILL BE INCLUDED IN THE PRICE BID FOR ITEM 47BM.
THE CONTRACTOR'S ATTENTION IS DIRECTED TO THE SPECIAL NOTES FOR THIS STRUCTURE WHICH APPEAR IN THE PROPOSAL. PARTICULAR ATTENTION SHOULD BE GIVEN TO THE FOUNDATION NOTE WHICH BRIEFLY OUTLINES THE ANTICIPATED SUBSURFACE CONDITIONS OF THE STRUCTURE, AND WHICH SPECIFIES CERTAIN REQUIREMENTS RELATIVE TO CONSTRUCTION.

SUPERSTRUCTURE QUANTITIES				
ITEM NO.	DESCRIPTION	UNIT	NEAT	ROUNDED
15-2	PORTLAND CEMENT, TYPE 2	BBL.	376	397
15-1	NATURAL CEMENT, TYPE N	BBL.	74	78
18	CLASS 1A CONCRETE FOR STRUCTURES	C.Y.	266	280
19	CLASS 1A CONCRETE FOR RAILINGS	C.Y.	2.5	3
28	BAR REINFORCEMENT FOR STRUCTURES	LB.	61,600	64,000
28-B	SPIRAL BAR SHEAR CONNECTORS	LB.	2,060	2,160
29	STRUCTURAL STEEL	LB.	240,800	248,000
37	METAL RAILINGS	L.F.	442	445
47BM	CEMENT CONCRETE PAVEMENT	C.Y.	91	95
* 25F	STEEL FABRIC REINFORCEMENT	S.Y.	820	860
15-BA	PORTLAND CEMENT TYPE 1A	BBL.	136	142

* STEEL FABRIC REINFORCEMENT TO BE FURNISHED IN FLAT SHEETS

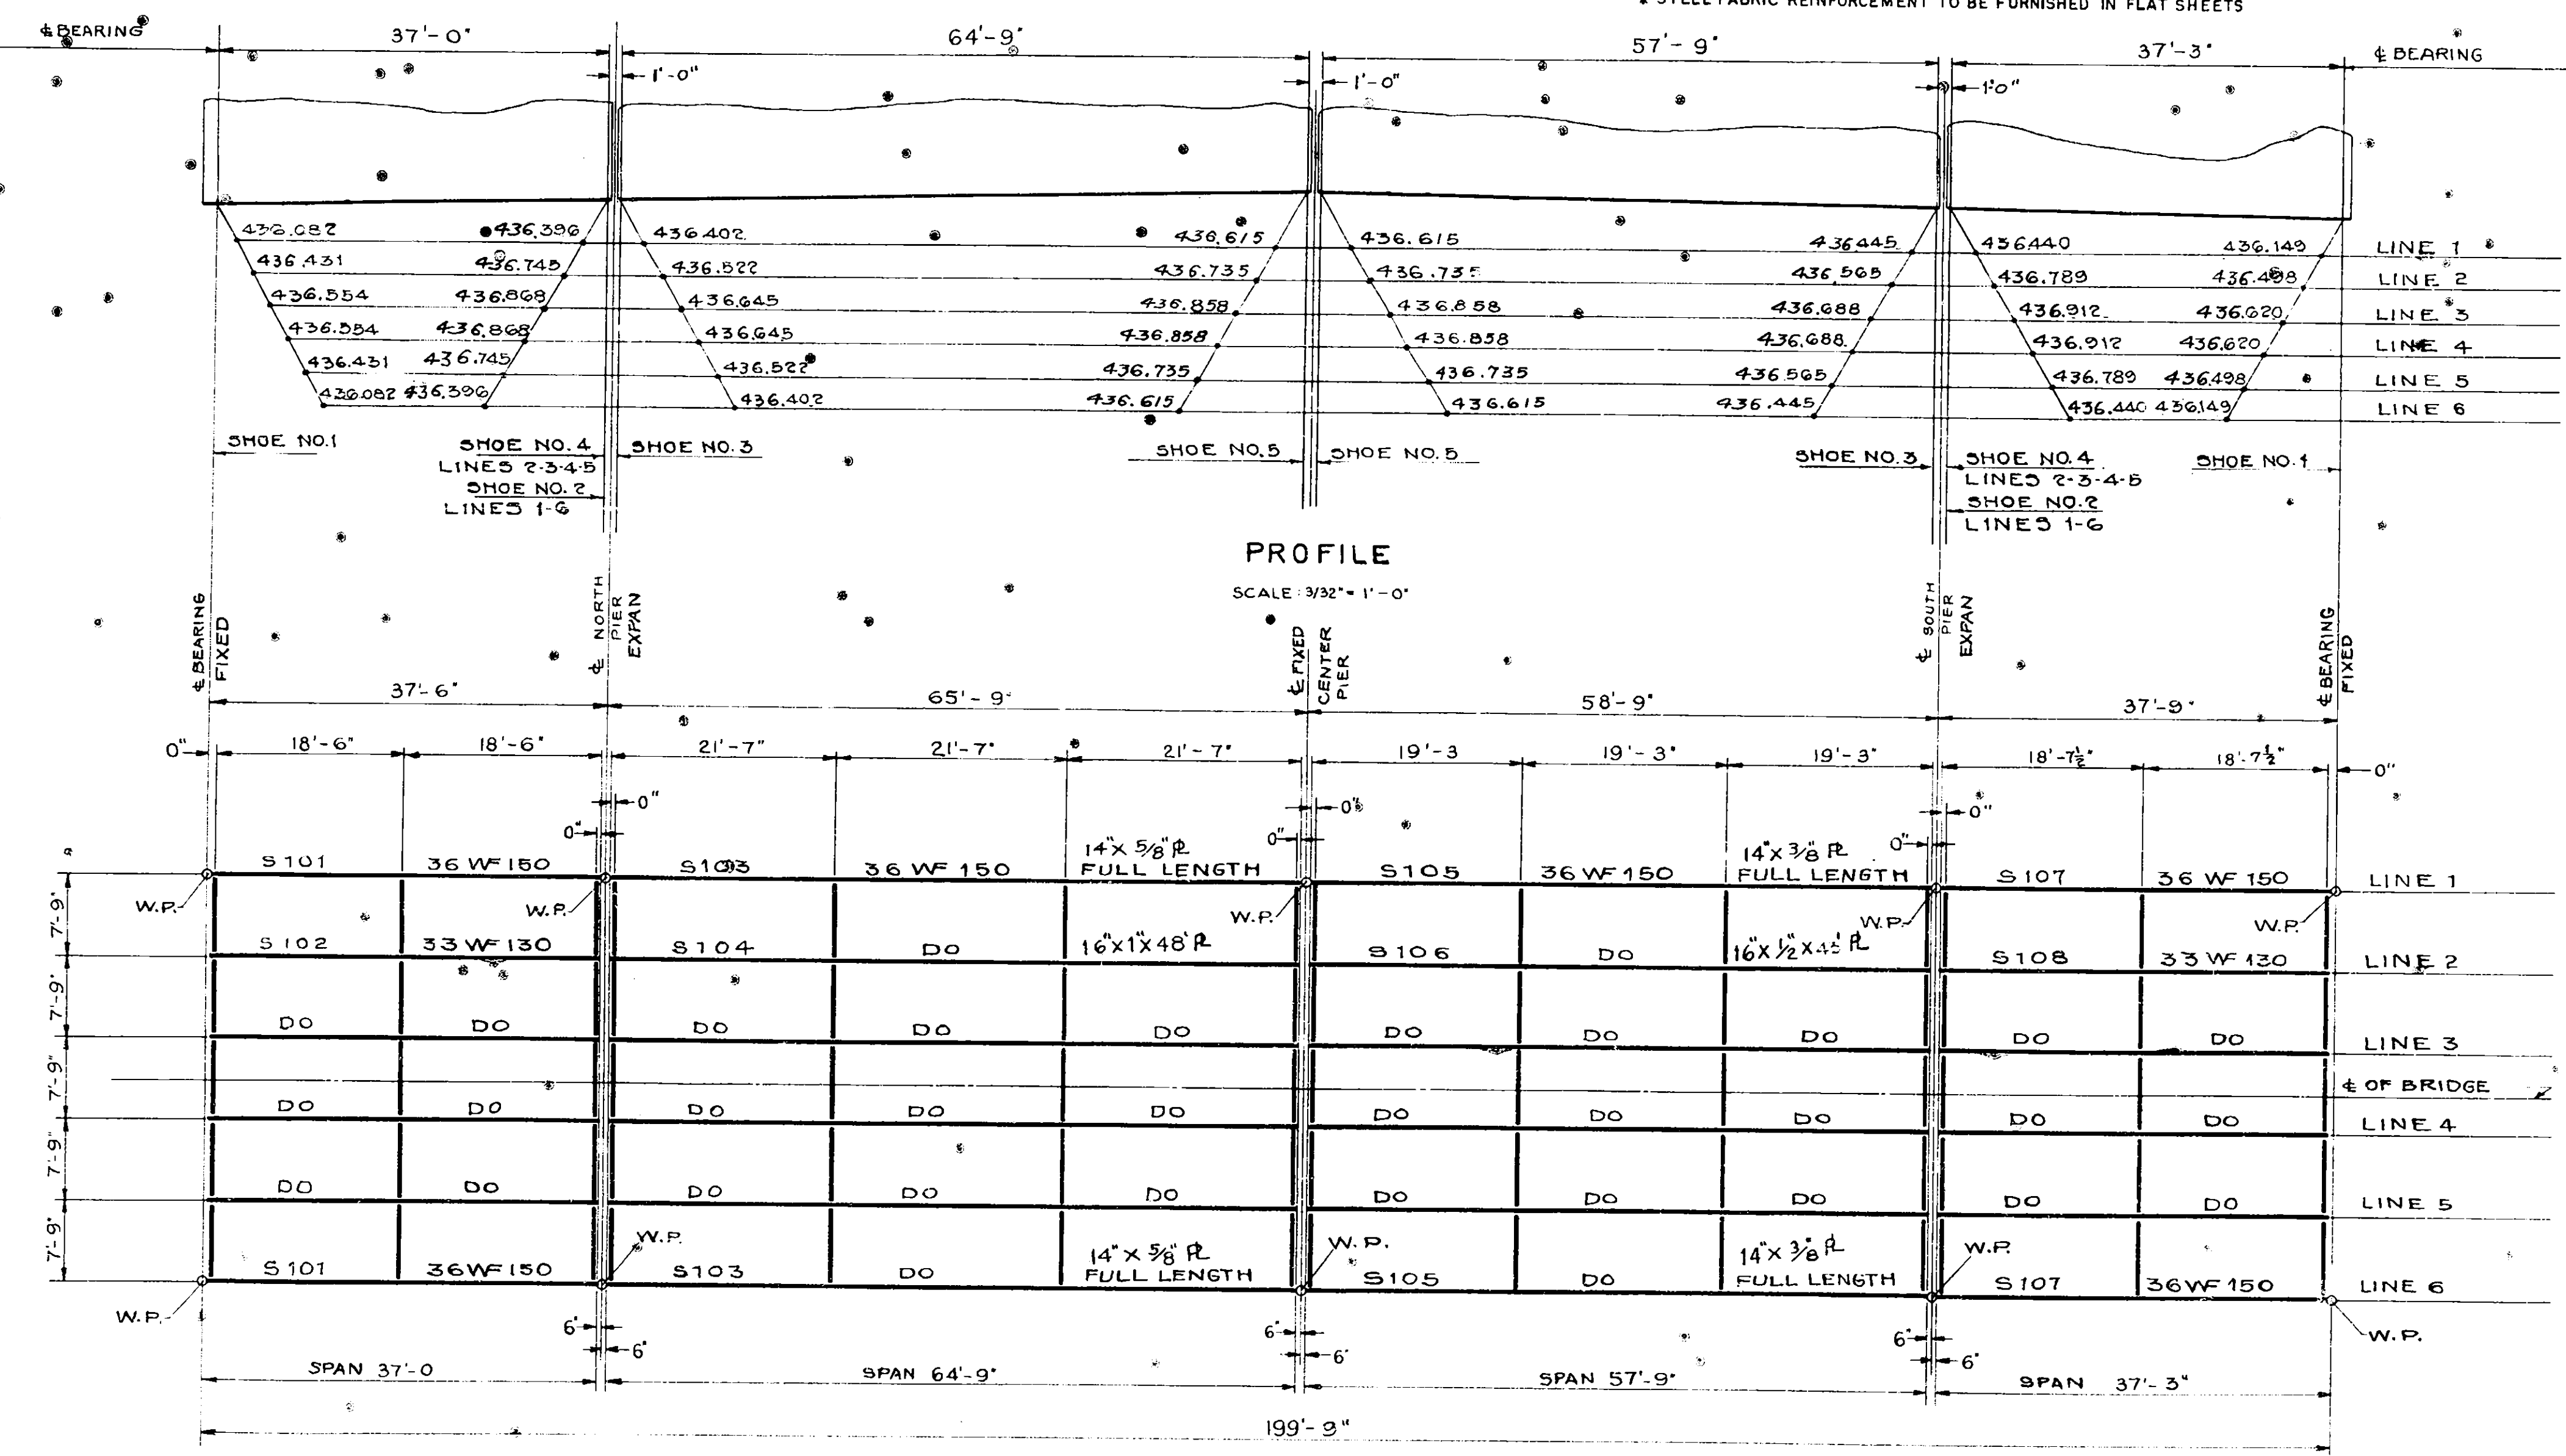

NOTE: ELEVATIONS ARE TO BOTTOM OF BOTTOM FLANGE.

SUPERSTRUCTURE DETAILS
THOMPSON ROAD INTERCHANGE
MOHAWK SECTION
NEW YORK STATE THRUWAY

PREPARED AND RECOMMENDED: *[Signature]* Feb 16, 53
URQUHART & DOYLE, CONSULTING ENGINEERS
NEW YORK STATE PROFESSIONAL ENGINEER LICENSE NO. 5667

SUPERSTRUCTURE

GENERAL NOTES

THE DESIGN OF THE STRUCTURE IS BASED ON A.A.S.H.O. SPECIFICATIONS, 1949, H20-S16-44 LOADING, AND CURRENT MODIFICATIONS AND ADDITIONS. ALL CONCRETE OF SUPERSTRUCTURE SHALL BE ITEM 18, EXCEPT CONCRETE OF PYLONS WHICH SHALL BE ITEM 19, AND CEMENT CONCRETE PAVEMENT, WHICH SHALL BE ITEM 47-BM. THE COST OF FURNISHING AND INSTALLING METAL EXPANSION MATERIAL, METAL WATER STOP, PREMOULDED BITUMINOUS JOINT MATERIAL, CAULKING COMPOUND, PARA-PLASTIC, SPONGE RUBBER, ASPHALT ROOFING FELT, ETC. SHALL BE INCLUDED IN THE BID PRICES OF THE RESPECTIVE CONCRETE ITEMS OF THE CONTRACT.

ALL MATERIALS, WORKMANSHIP, AND FABRICATION SHALL CONFORM TO NEW YORK STATE DEPARTMENT OF PUBLIC WORKS SPECIFICATIONS, JANUARY 2, 1951, AND CURRENT MODIFICATIONS AND ADDITIONS.

WHERE CAULKING COMPOUND IS TO CONTACT CONCRETE SURFACES, SUCH CONCRETE SHALL BE THOROUGHLY CLEANED AND DRY, AND PRIMED WITH A PRIMING COAT AT LEAST 30 MINUTES BEFORE THE APPLICATION OF CAULKING COMPOUND. THIS WORK SHALL BE DONE BY EXPERIENCED MEN, AND THE COMPLETE OPERATION SHALL BE SPECIALLY DIRECTED BY THE ENGINEER.

CONSTRUCTION JOINTS SHALL BE PLACED ONLY AS AND WHERE SHOWN ON THE PLANS, EXCEPT WHEN PERMISSION IN WRITING IS GIVEN BY THE DEPUTY CHIEF ENGINEER OF BRIDGES, IN WHICH CASE HIS SUPPLEMENTAL INSTRUCTION SHALL BE STRICTLY FOLLOWED.

AFTER THE CONCRETE IS CURED, THE CONTRACTOR SHALL APPLY A WATERPROOFING OIL TREATMENT, AS DESCRIBED IN THE SPECIFICATIONS FOR M-41W TO ALL EXPOSED SURFACES EXCEPT THE UNDERSIDE OF SLABS. TWO APPLICATIONS OF WATERPROOFING OIL TREATMENT SHALL BE APPLIED AT THE TOP OF THE SLAB. THE SECOND APPLICATION SHALL BE APPLIED TWO DAYS PRIOR TO THE PLACING OF THE PAVEMENT OR SIDEWALK.


IMMEDIATELY BEFORE PLACING PAVEMENT CONCRETE, THE CONCRETE SURFACE OR SURFACES UPON WHICH IT IS TO BE PLACED SHALL BE THOROUGHLY WETTED DOWN CONTINUOUSLY FOR ONE HOUR, IF THE AIR TEMPERATURE IS ABOVE 50° F. PAYMENT FOR THIS WORK WILL BE INCLUDED IN THE PRICE BID FOR ITEM 47BM.

THE CONTRACTOR'S ATTENTION IS DIRECTED TO THE SPECIAL NOTES FOR THIS STRUCTURE WHICH APPEAR IN THE PROPOSAL. PARTICULAR ATTENTION SHOULD BE GIVEN TO THE FOUNDATION NOTE WHICH BRIEFLY OUTLINES THE ANTICIPATED SUBSURFACE CONDITIONS OF THE STRUCTURE, AND WHICH SPECIFIES CERTAIN REQUIREMENTS RELATIVE TO CONSTRUCTION.

SUPERSTRUCTURE QUANTITIES

ITEM NO.	DESCRIPTION	UNIT	NEAT	ROUNDED
15-2	PORTLAND CEMENT, TYPE 2	BBL.	376	397
15N	NATURAL CEMENT, TYPE N	BBL.	74	77
18	CLASS I A CONCRETE FOR STRUCTURES	C.Y.	266	280
19	CLASS I A CONCRETE FOR RAILINGS	C.Y.	25	3
28	BAR REINFORCEMENT FOR STRUCTURES	LB.	1,600	1,000
28B	SPIRAL BAR SHEAR CONNECTORS	LB.	2,060	2,160
29	STRUCTURAL STEEL	LB.	240,800	248,000
37	METAL RAILINGS	L.F.	442	445
47BM	CEMENT CONCRETE PAVEMENT	C.Y.	91	95
* 25F	STEEL FABRIC REINFORCEMENT	S.Y.	820	860
15-BA	PORTLAND CEMENT TYPE 1A	BBL.	136	142

* STEEL FABRIC REINFORCEMENT TO BE FURNISHED IN FLAT SHEETS

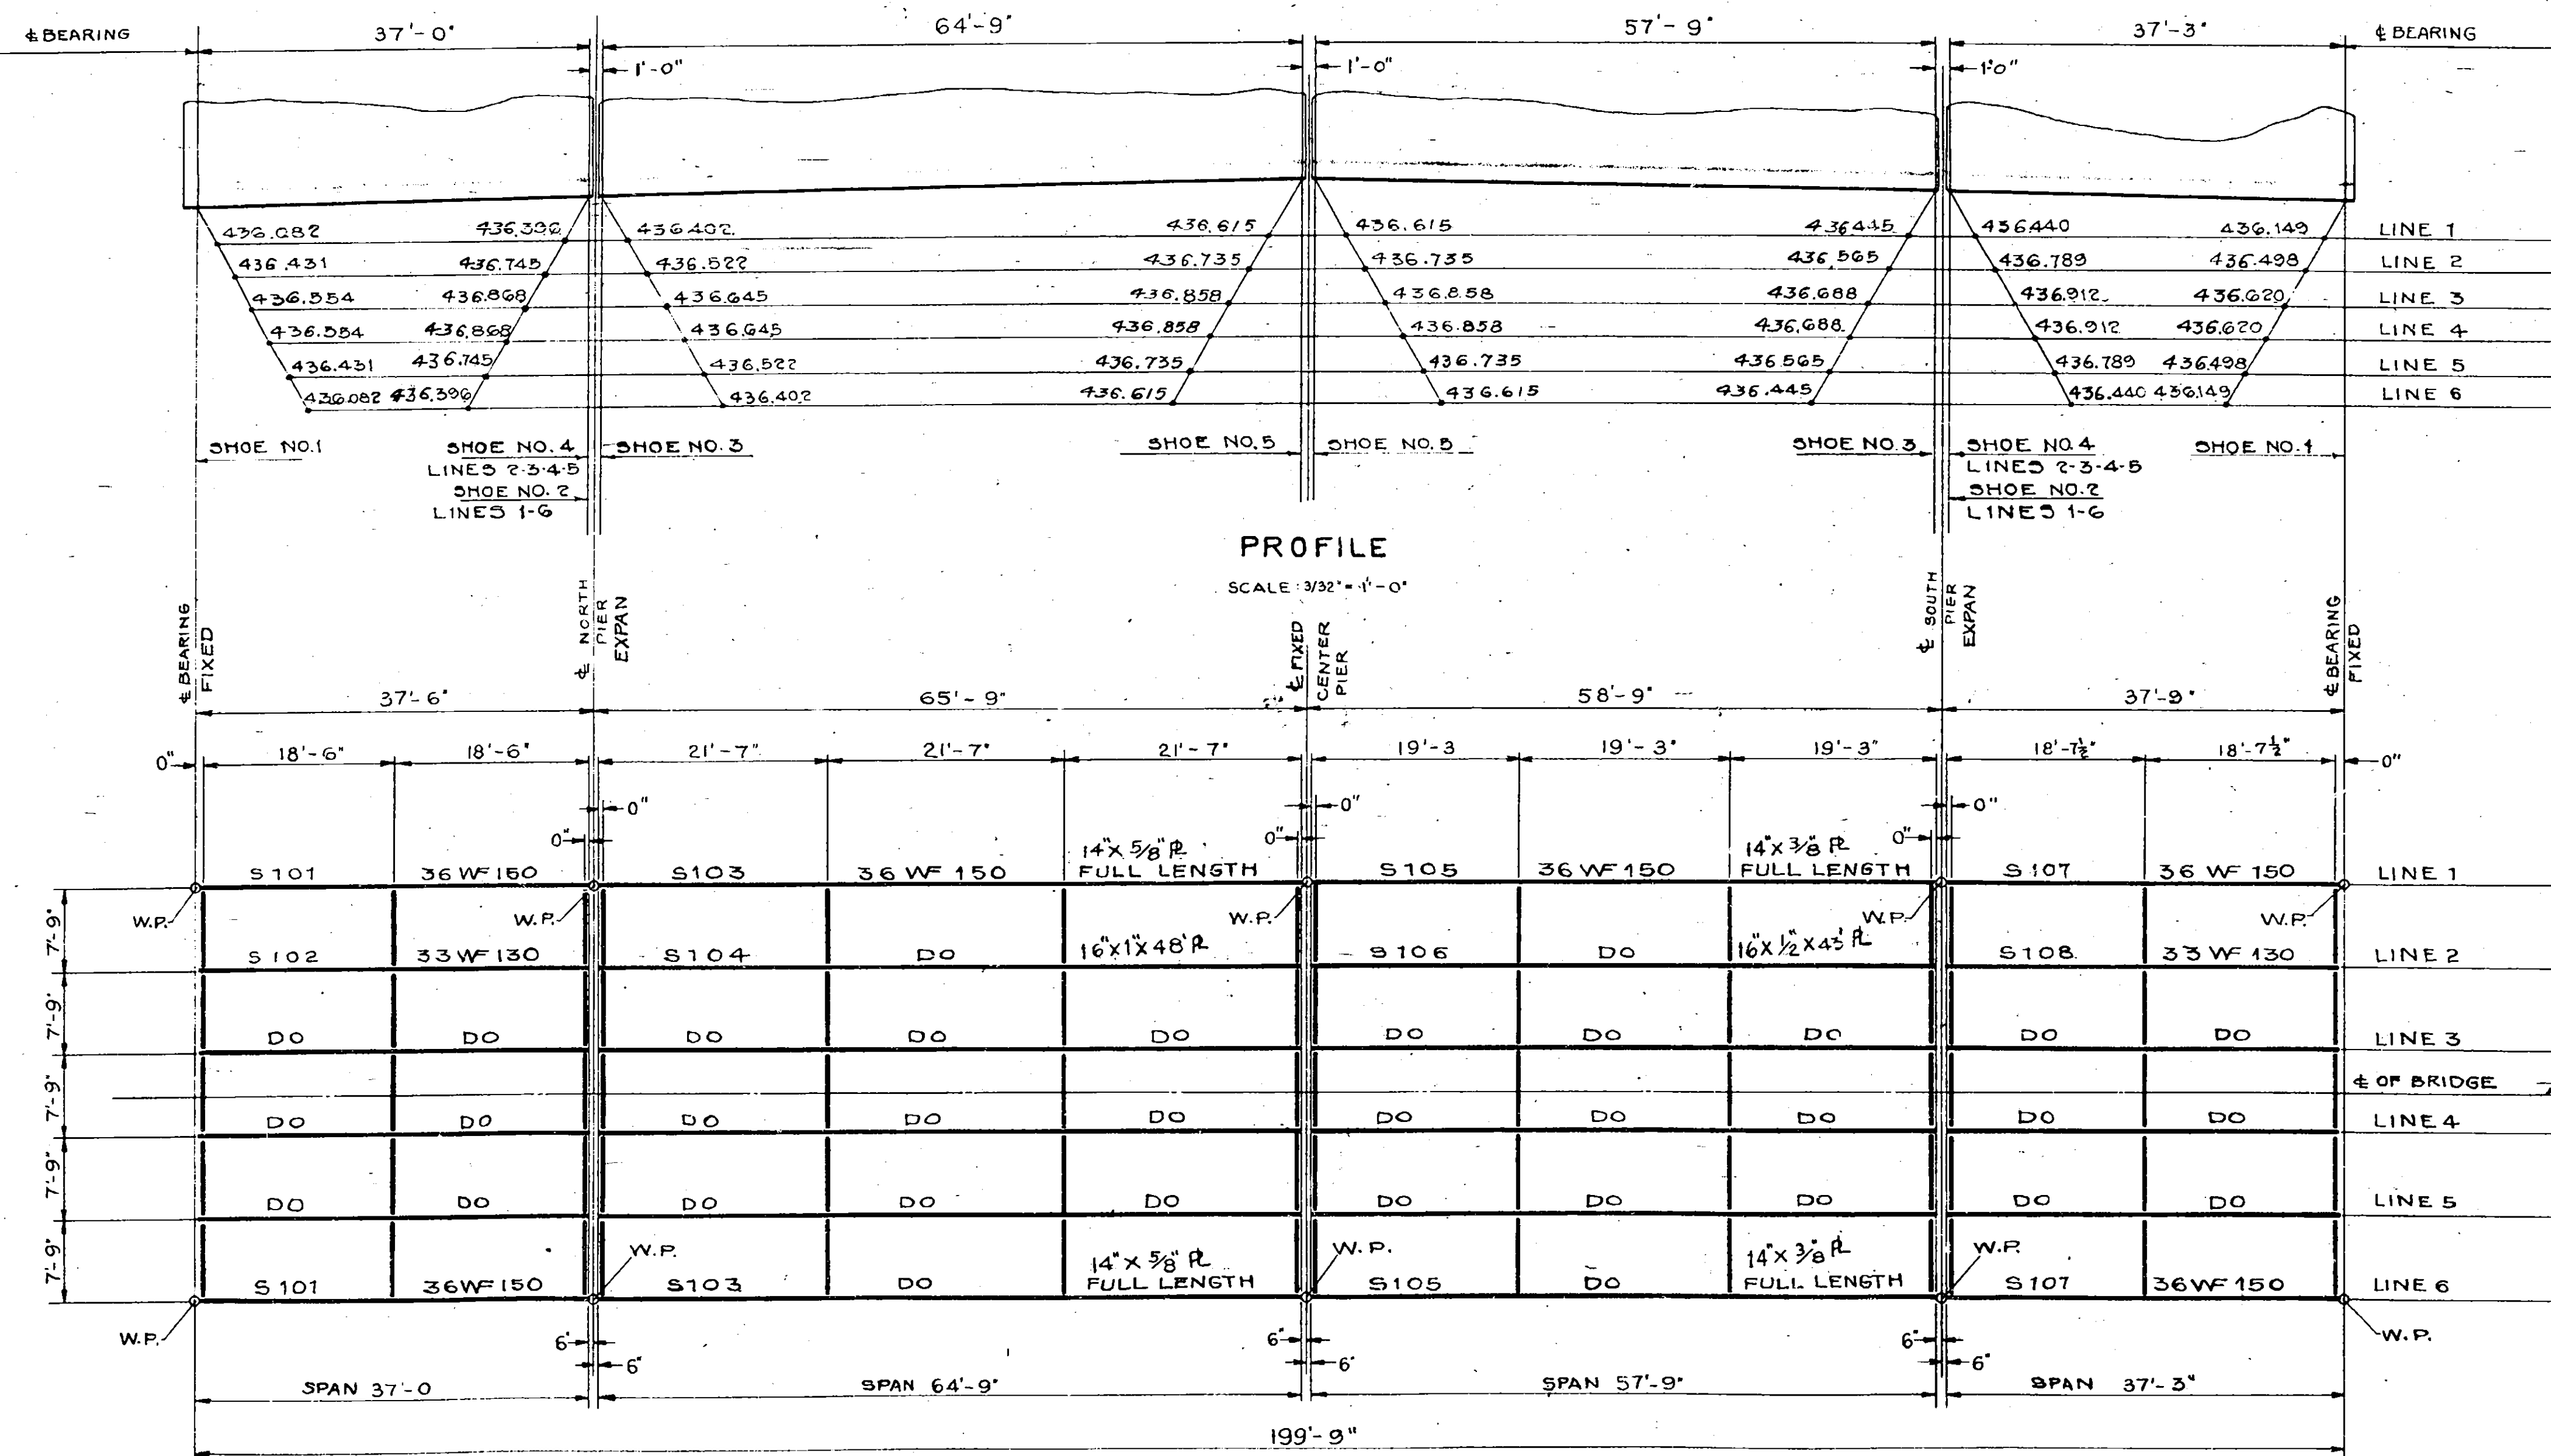

NOTE: ELEVATIONS ARE TO BOTTOM OF BOTTOM FLANGE.

BUILT ACCORDING TO PLAN

SUPERSTRUCTURE DETAILS

THOMPSON ROAD INTERCHANGE

MOHAWK SECTION

NEW YORK STATE THRUWAY


PREPARED AND RECOMMENDED:

URQUHART & DOYLE, CONSULTING ENGINEERS
NEW YORK STATE PROFESSIONAL ENGINEER LICENSE NO. 5667

DATE



SHEET 49

COUNTY	SHEET NO	TOTAL SHEETS
ONONDAGA	50	66
NEW YORK STATE THRUWAY, MOHAWK SECTION SUBDIV. 8B INTERCHANGE AT THOMPSON ROAD		

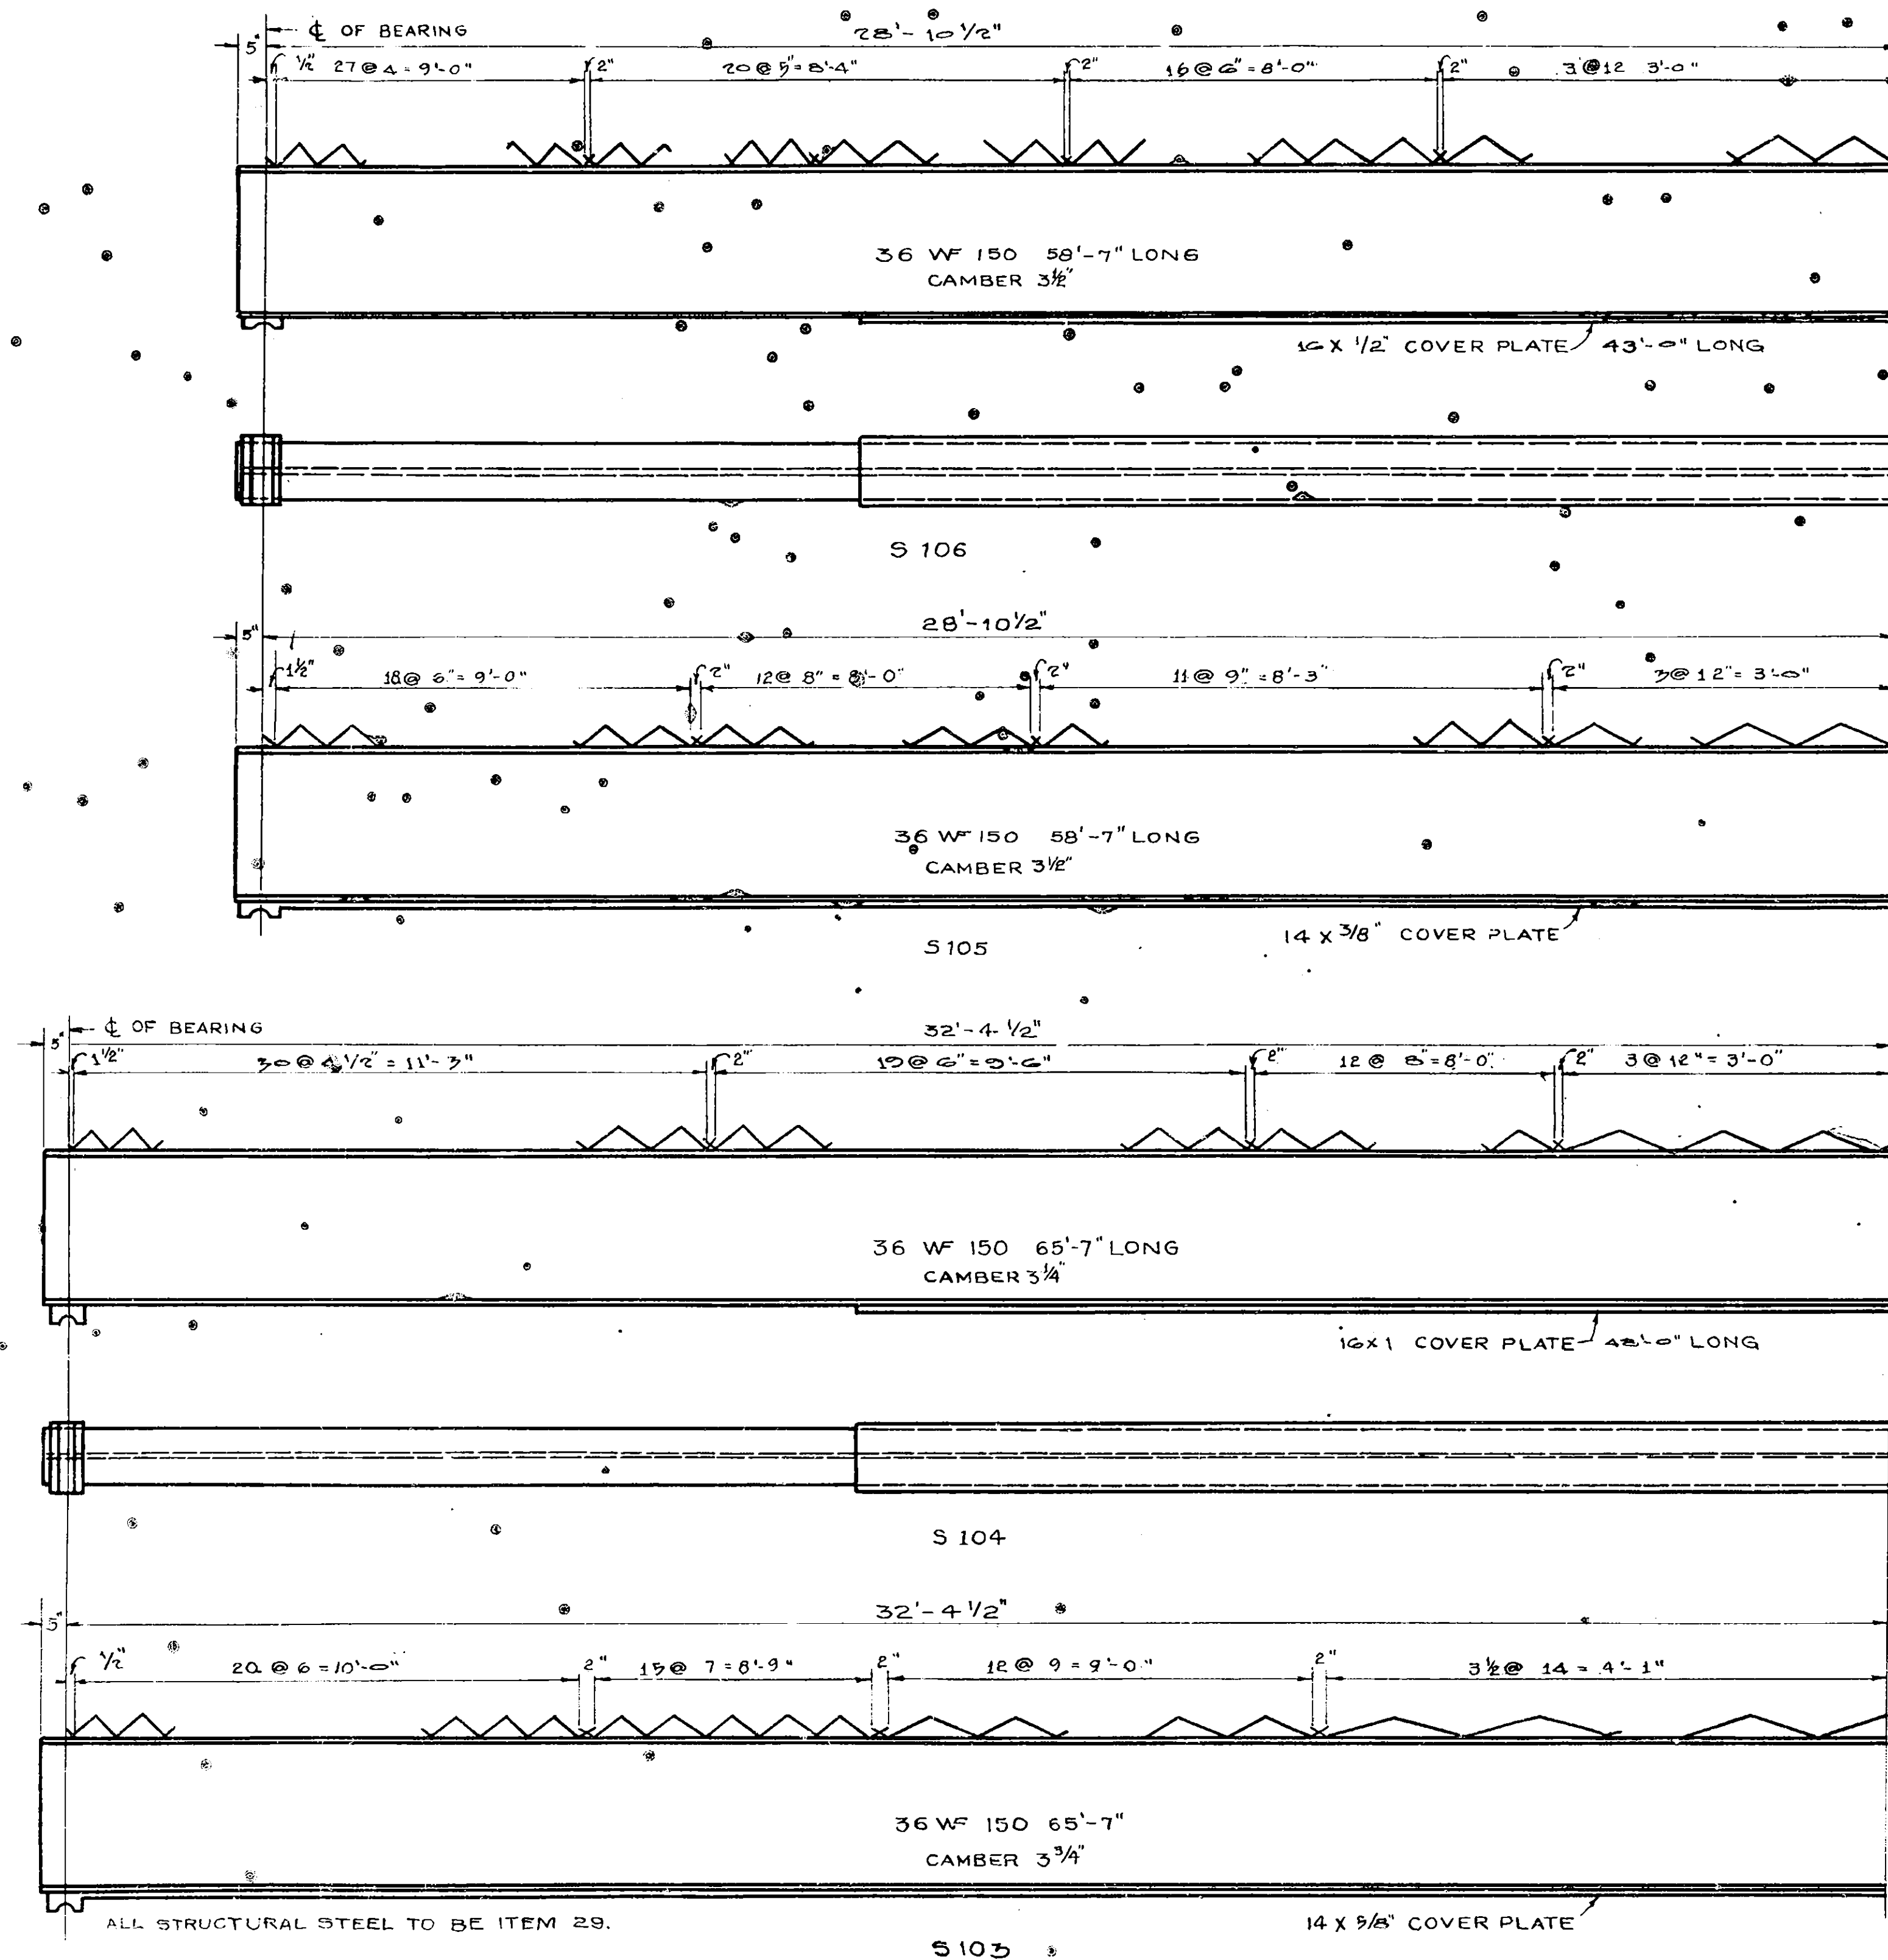


NOTE:
ALL COVER PLATES
TO BE WELDED WITH
5/16" CONTINUOUS
FILLET WELDS.


SCALE: 1/2" = 1'-0"
EXCEPT AS SHOWN
FOR SHOE DETAILS SEE SHEET 52

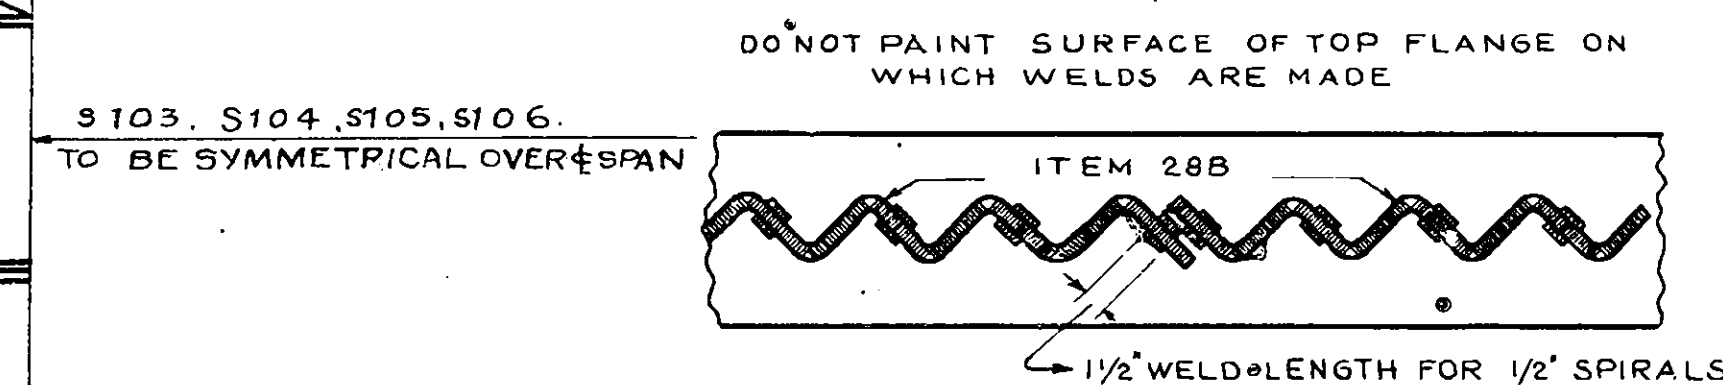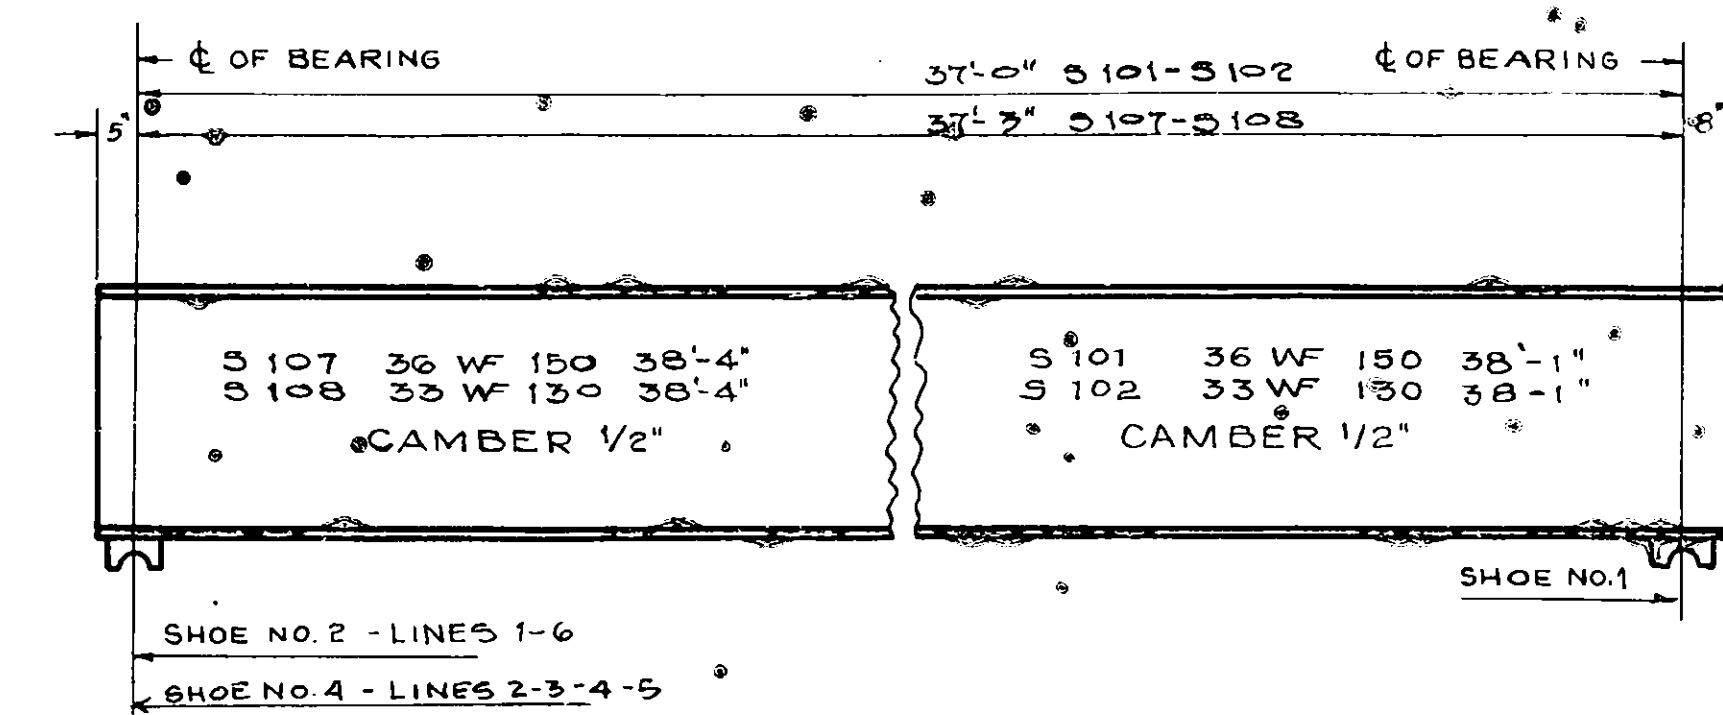

1/2" SPIRAL ROD 5/16"
FILLET WELD 1/2"
LONG ON EACH SIDE
OF ROD.

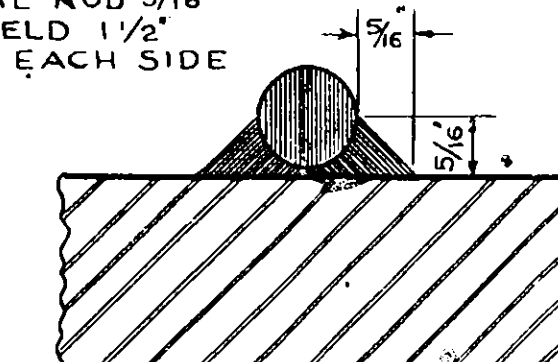

5" MEAN DIAMETER
OF 1/2" SPIRALS

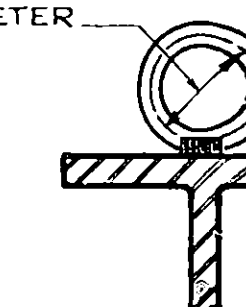

NOTE:
EXTEND BAR
1/4 TURN BEYOND
END WELDS OF
UNIT.

SPIRAL DETAILS

NOT TO SCALE

ALL SPIRAL SHEAR BARS ARE ITEM 28B

SPECIAL NOTES FOR SPIRAL REINFORCEMENTS

THE CONTRACTOR'S AND ENGINEER'S ATTENTION IS CALLED TO THE POSSIBILITY OF INTERFERENCE BETWEEN THE REINFORCING STEEL IN THE SLAB AND THE BEAM SPIRALS. WHILE STEEL SPACING IS GIVEN AS 5/2 INCHES, IT IS TO BE UNDERSTOOD THAT 2 BARS IN EACH OF 11 IN. WILL FULFILL THIS REQUIREMENT IF NO TWO BARS ARE CLOSER THAN 1" LESS THAN REQUIRED SPACING OR FURTHER APART THAN 1" MORE THAN REQUIRED SPACING. IF NECESSARY, SOME BARS MAY BE THREADED THRU ONE OR MORE SPIRALS. ALL SPIRALS MUST HAVE TWO STRUCTURAL WELDS 5/16" x 1 1/2" LONG, AT EACH SIDE OF THE BAR AS SHOWN. 5/32" OR 3/16" DIAMETER ELECTRODES SHALL BE USED IN WELDING THE SPIRAL BAR REINFORCEMENT. SPECIAL PRECAUTIONS MUST BE EXERCISED WHERE WELDING CROSSES EDGE OF FLANGE TO AVOID ANY POSSIBILITY OF 'UNDERCUT' OR NICKS IN THE EDGE OF FLANGE.

SUPERSTRUCTURE DETAILS

THOMPSON ROAD INTERCHANGE

MOHAWK SECTION

NEW YORK STATE THRUWAY


PREPARED AND RECOMMENDED:

URQUHART & DOYLE, CONSULTING ENGINEERS
NEW YORK STATE PROFESSIONAL ENGINEERS LICENSE NO. 5667

DATE


SHEET 50

COUNTY	SHEET NO.	TOTAL SHEETS
ORONDAGA	51	66
N.Y. STATE THRUWAY, MOHAWK SECTION SUBDIV. 8B		
INTERCHANGE AT THOMPSON ROAD		

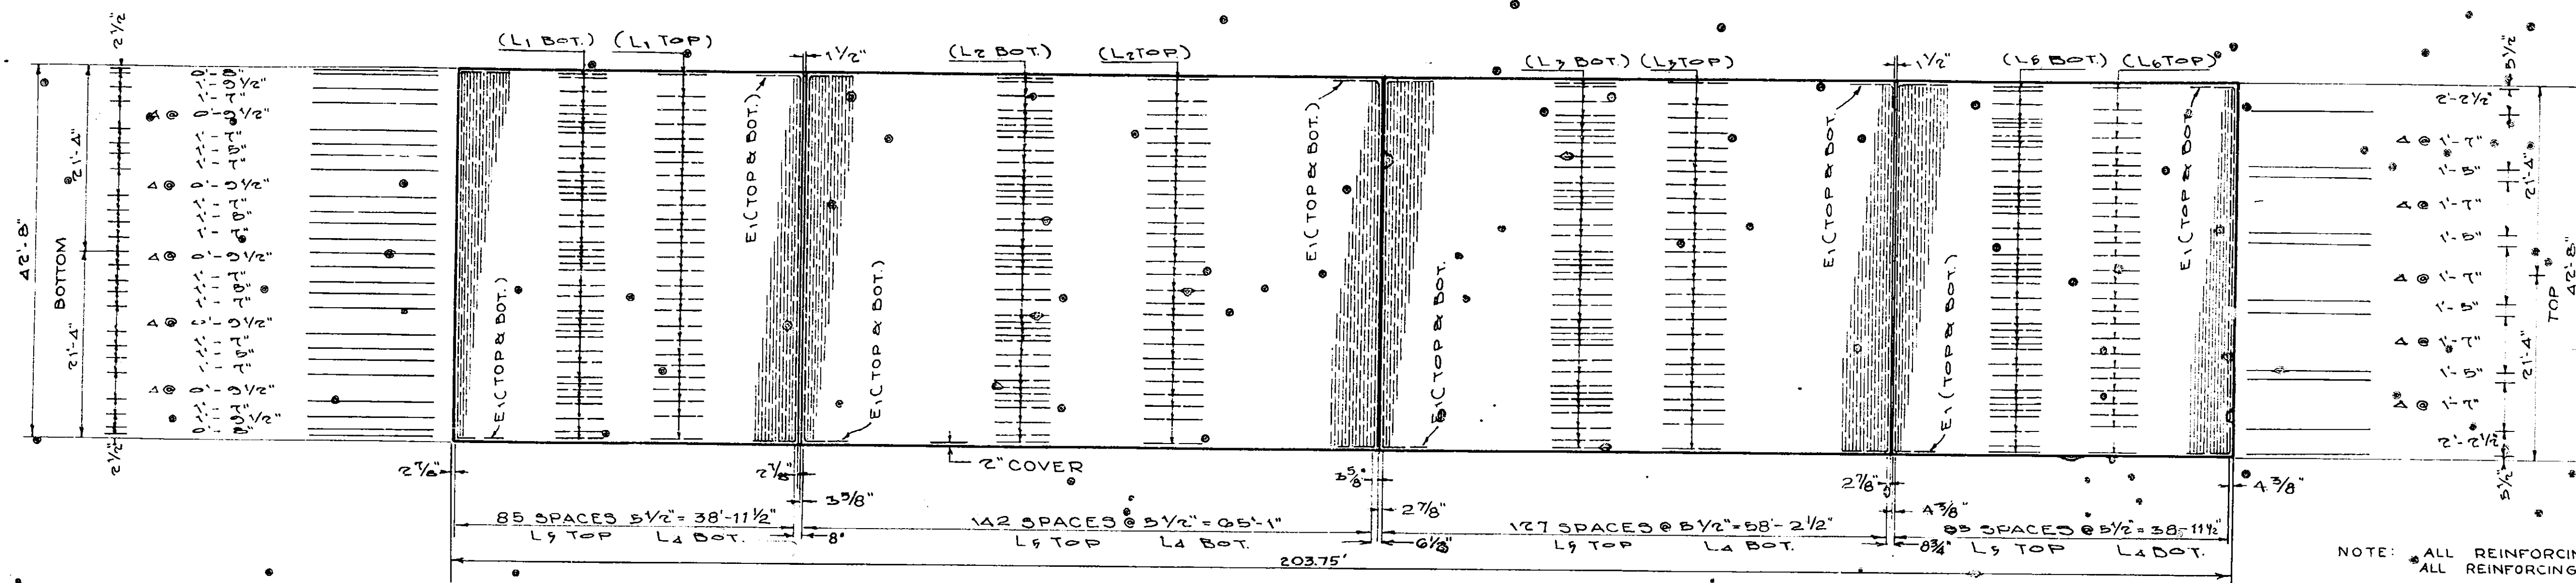


DECK SLAB DETAILS
SCALE 3/32" = 1'-0"

NOTE: ALL REINFORCING BARS ITEM 28
ALL REINFORCING BARS IN DECK SLAB 3/8" ϕ

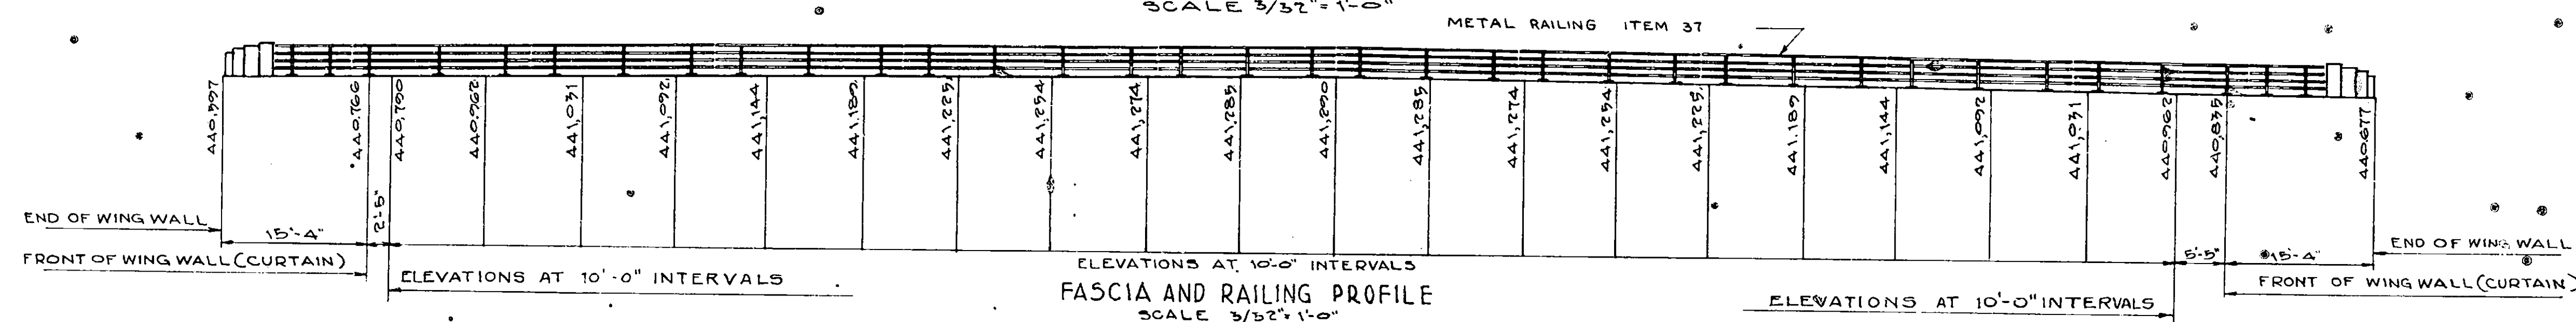

FASCIA AND RAILING PROFILE
SCALE 3/32" = 1'-0"

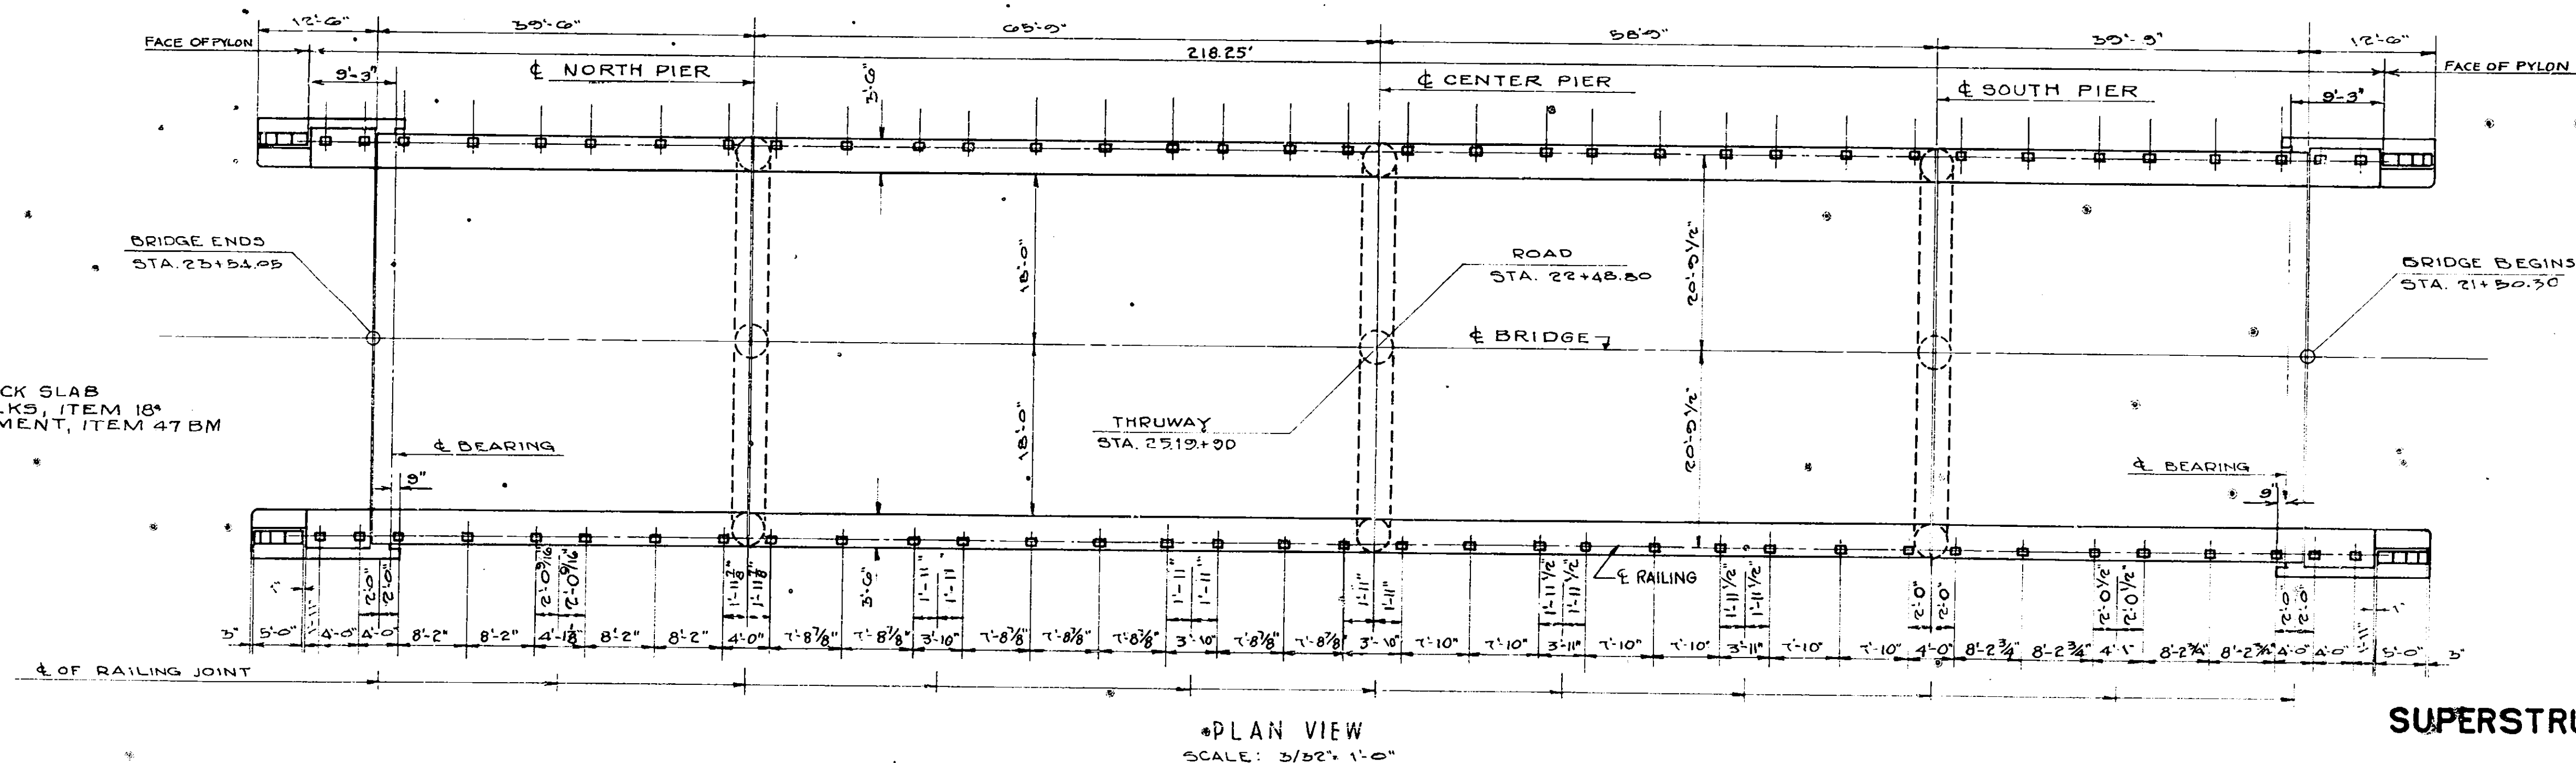

PLAN VIEW
SCALE: 3/32" = 1'-0"

SUPERSTRUCTURE DETAILS

THOMPSON ROAD INTERCHANGE

MOHAWK SECTION



NEW YORK STATE THRUWAY

PREPARED AND RECOMMENDED



URQUHART & DOYLE CONSULTING ENGINEERS
NEW YORK STATE PROFESSIONAL ENGINEERS LICENSE NO 5667

B. J. Doyle Feb 16-53
DATE


COUNTY			SHEET NO.	TOTAL SHEETS
ONONDAGA			52	66
N.Y. STATE THRUWAY MOHAWK SECTION SUBDIV. 8 B				
INTERCHANGE AT THOMPSON ROAD				

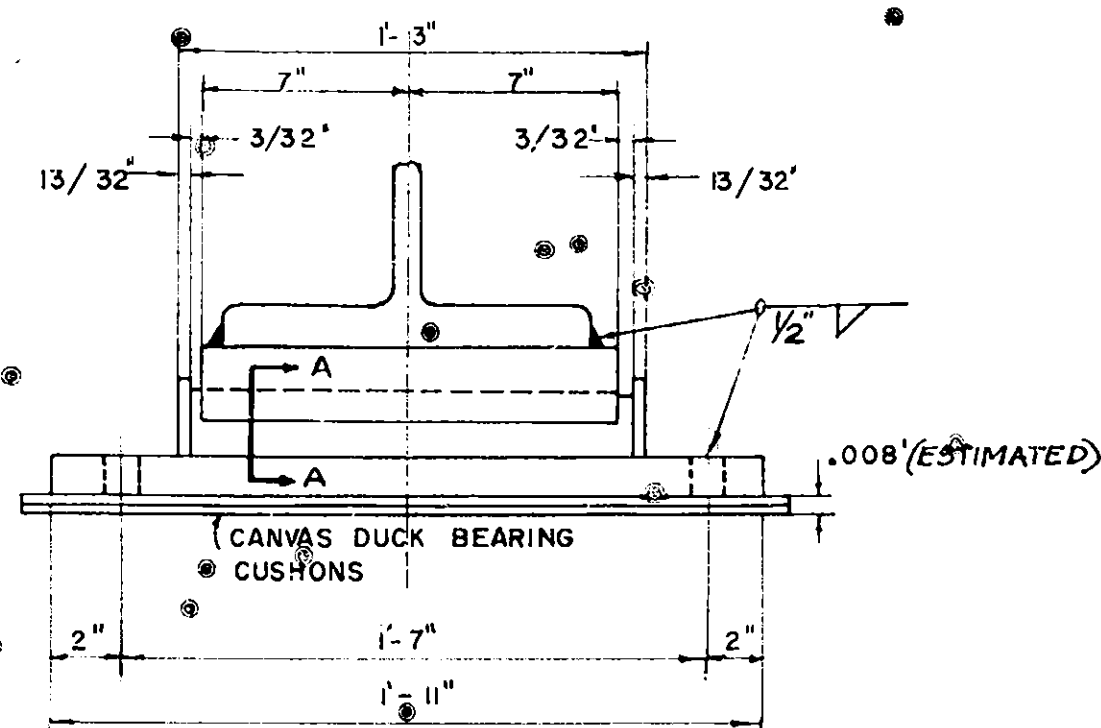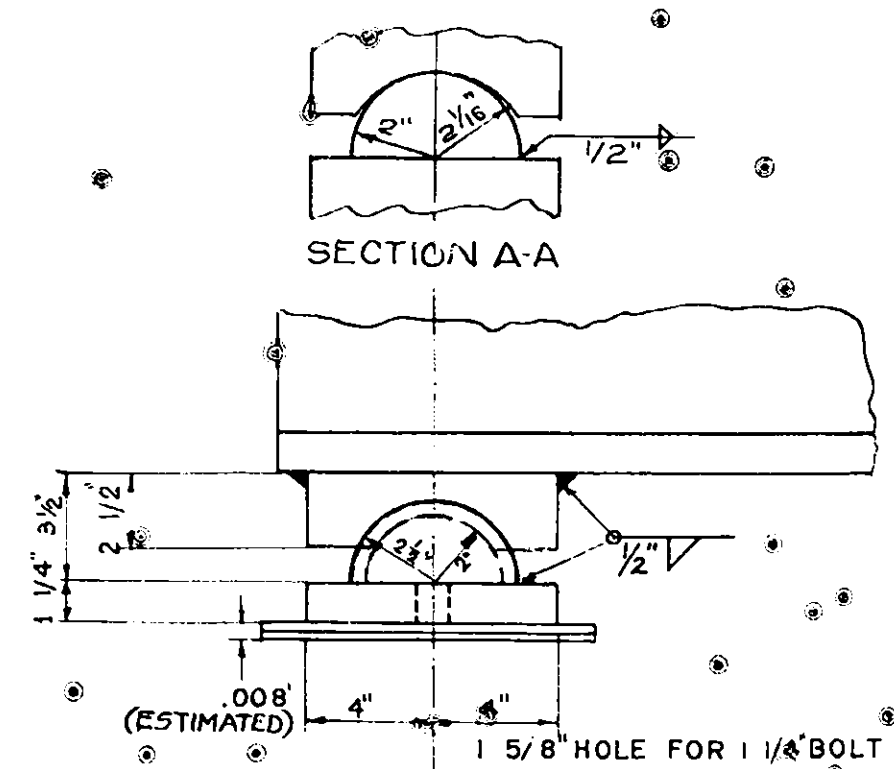



NOTE: ①
② 1/2" WELD ON ALL SHOES

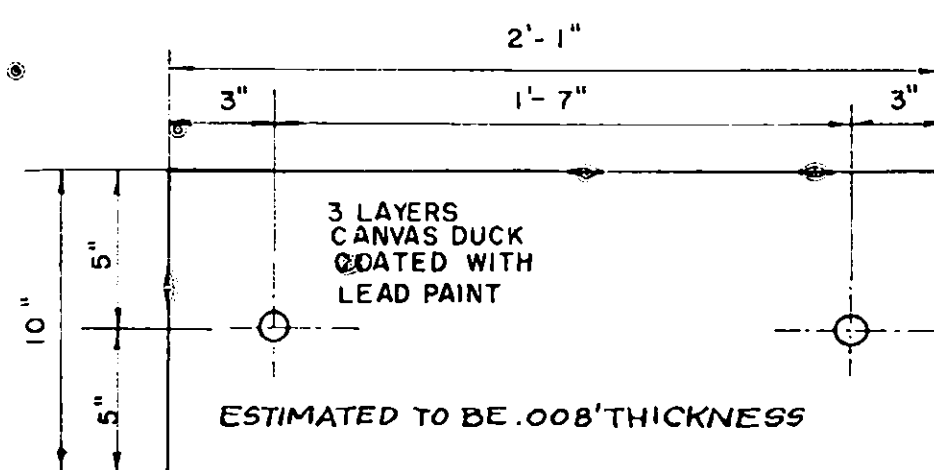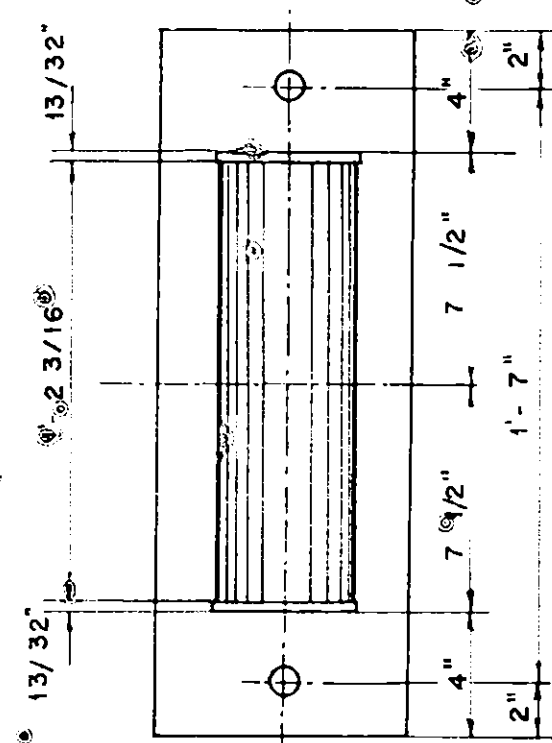


CANVAS DUCK BEARING CUSHION

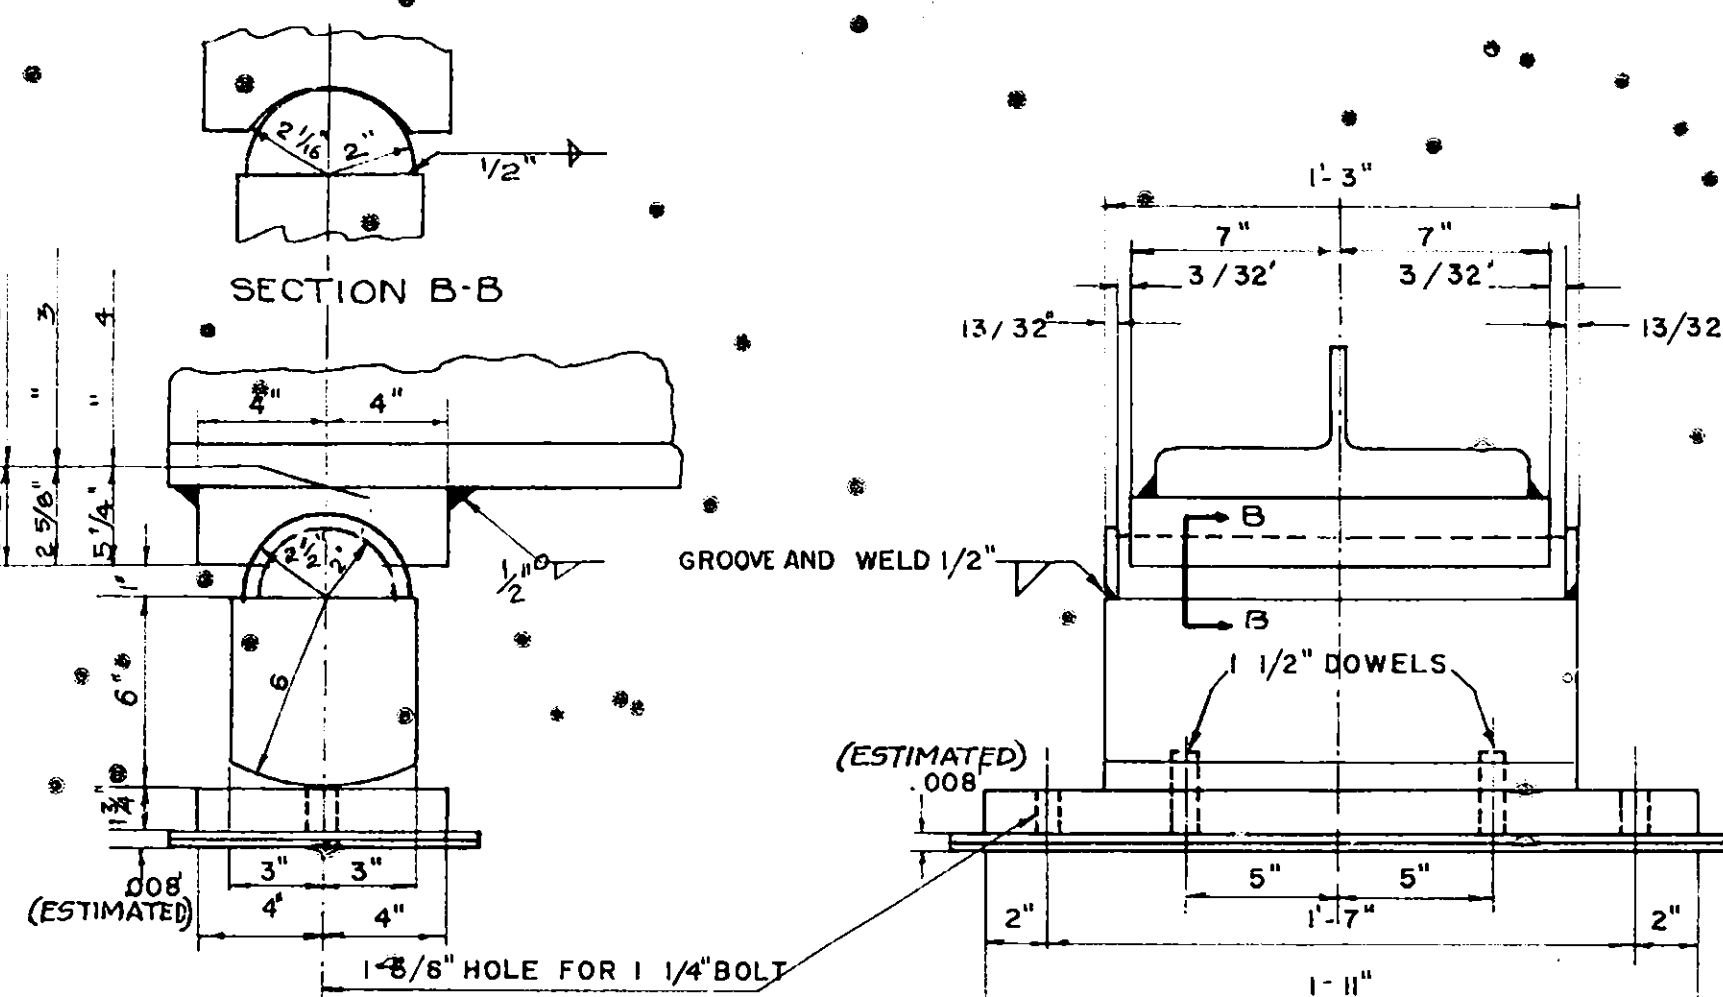


SHOES 2,3.4

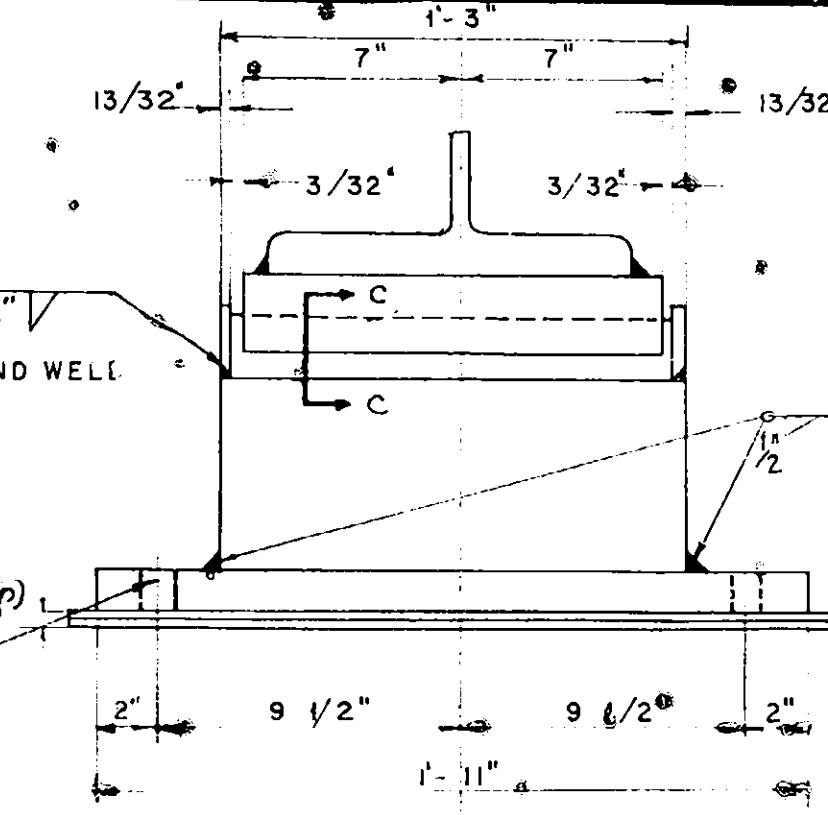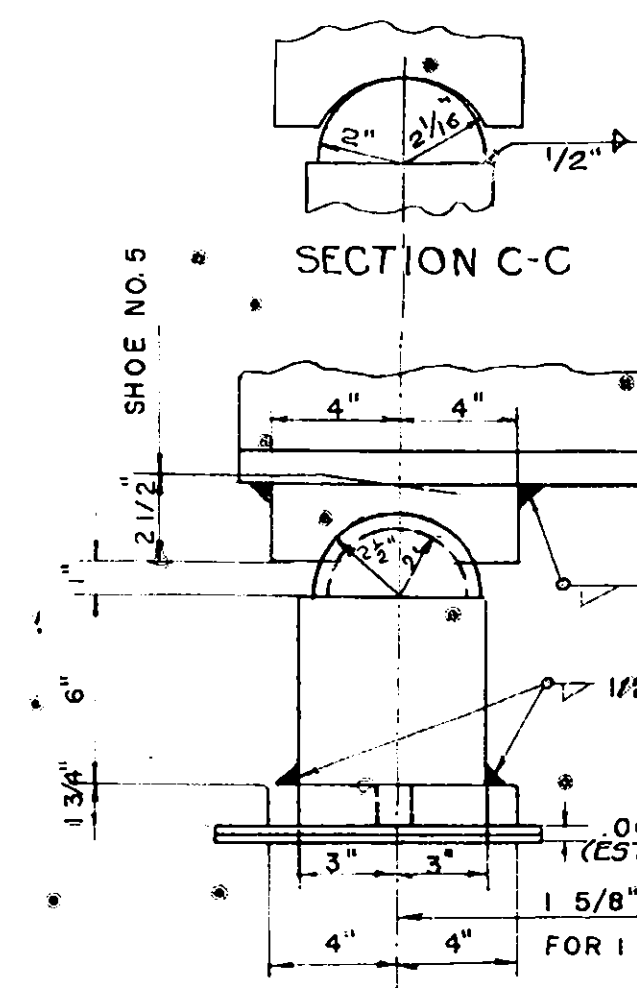



SHOE 9

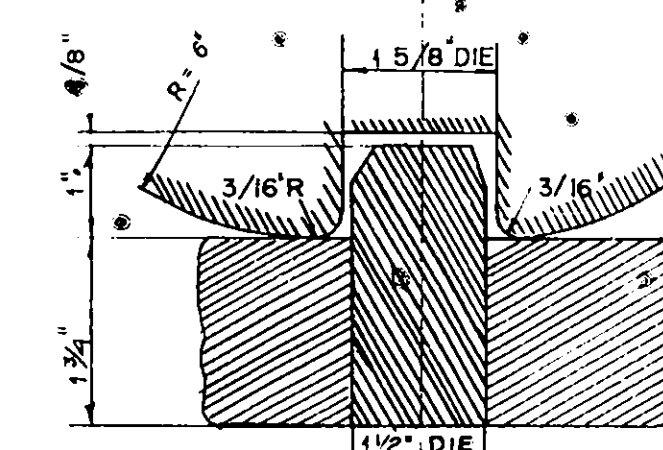


SECTION THRU DOWEL
SCALE HALF SIZE

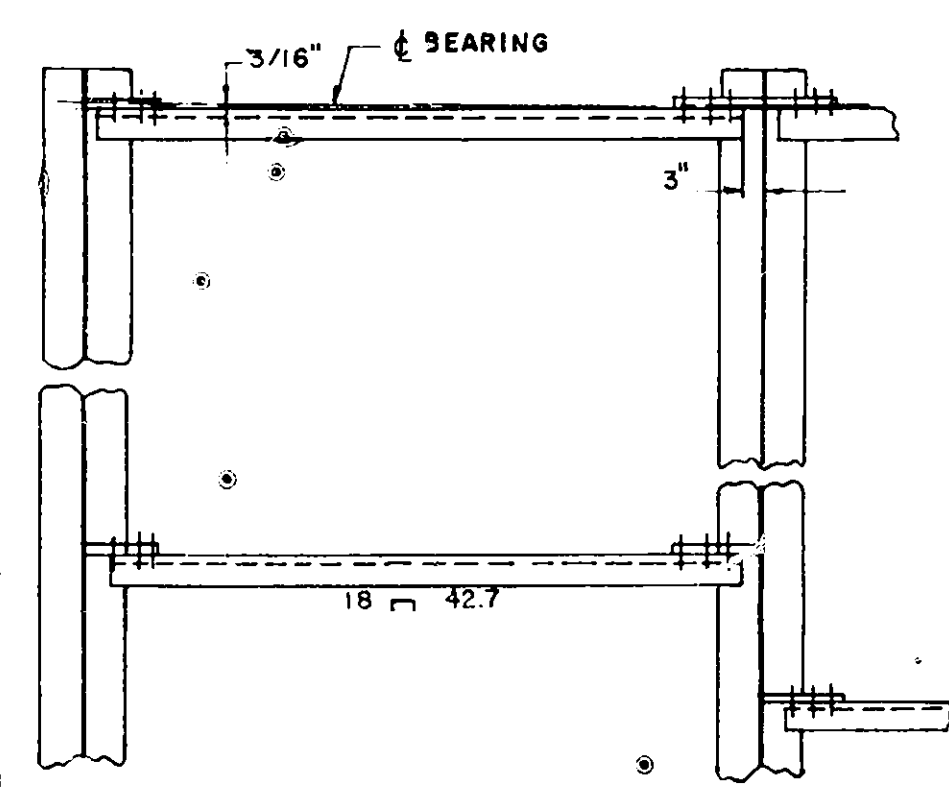


TYPICAL DIAPHRAGM DETAILS

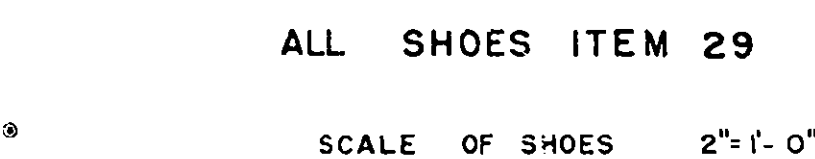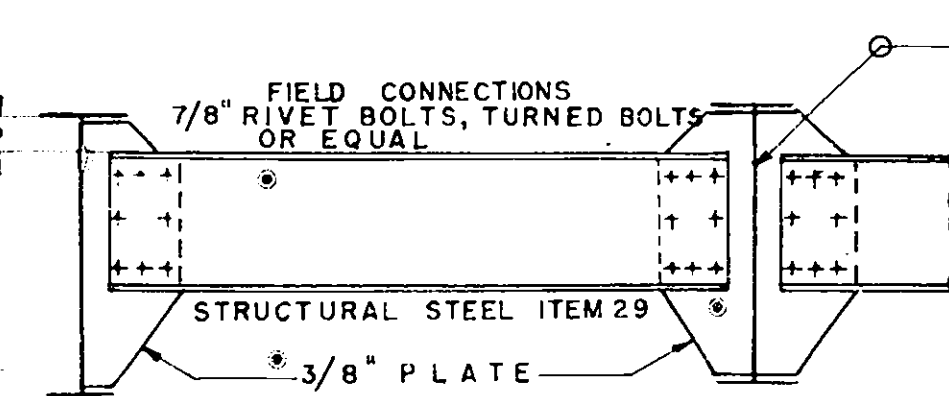

SCALE OF SHOES 2" = 1'- 0"

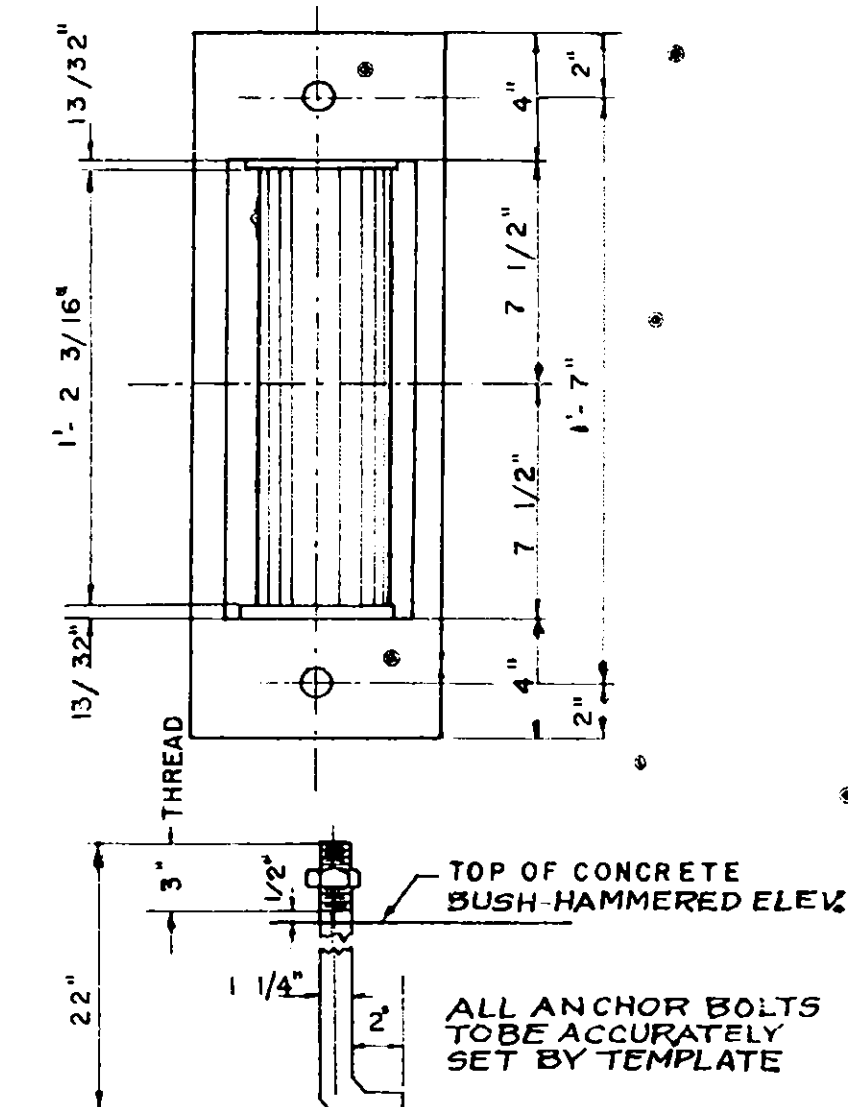


DETAIL OF ANCHOR BOLT


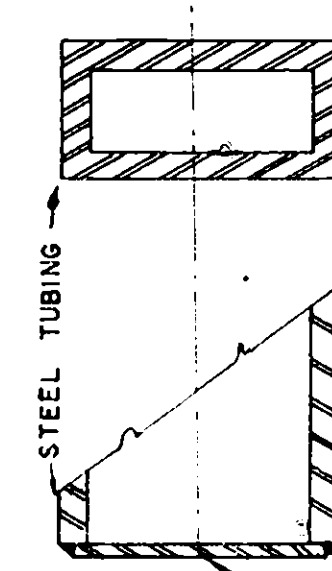


DETAIL AT ENDS


NOT TO SCALE

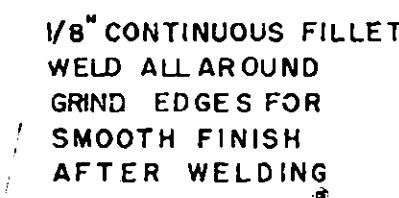


1/8" CONTINUOUS FILLET
WELD ALL AROUND
GRIND EDGES FOR
SMOOTH FINISH
AFTER WELDING

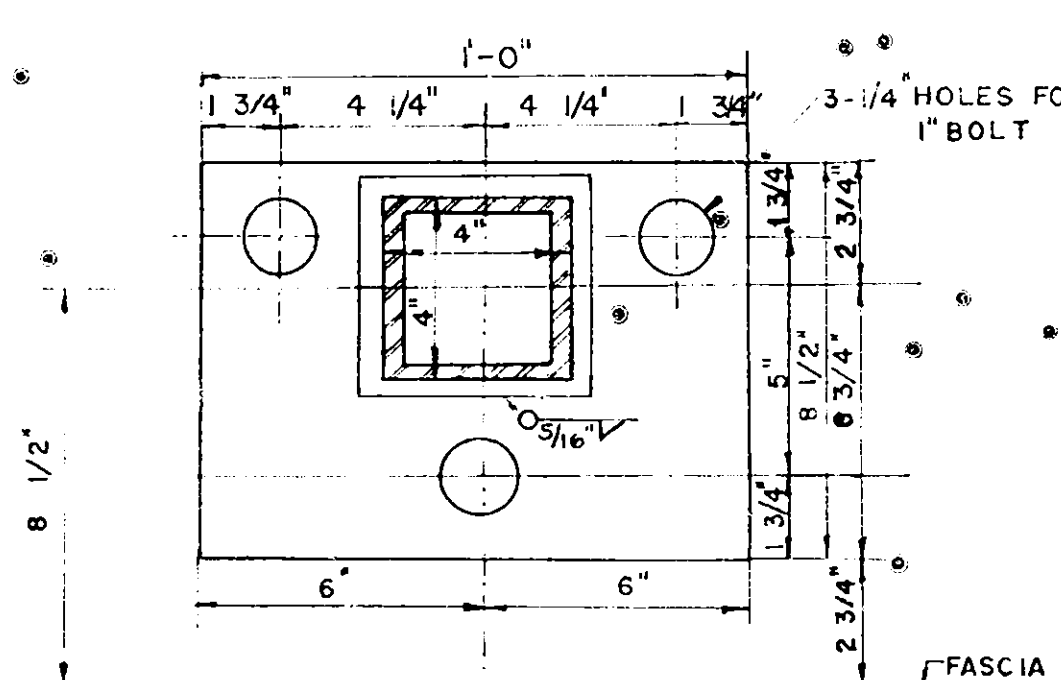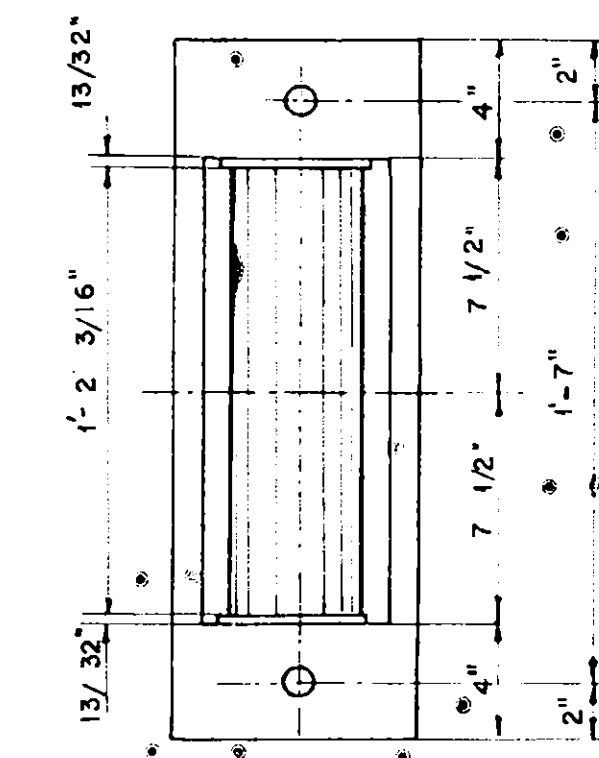


RAIL POST BASE PLATE
SCALE 3" = 1'-0"

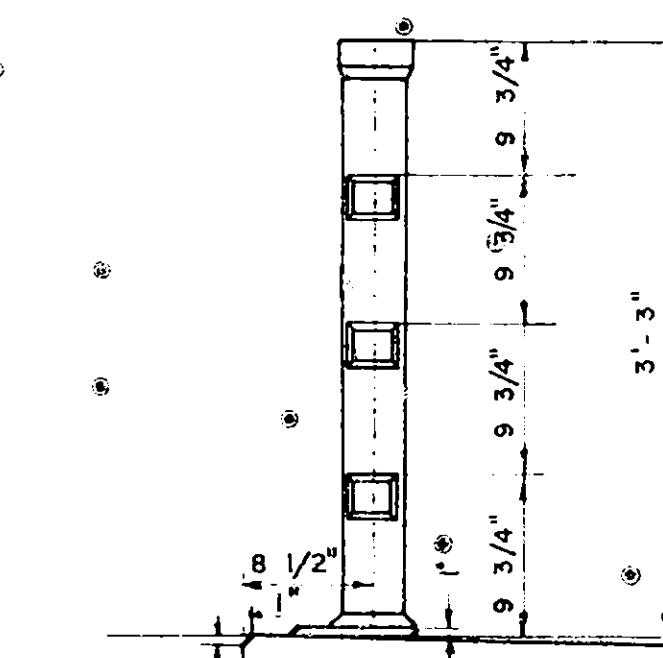

SECTION THRU RAILING

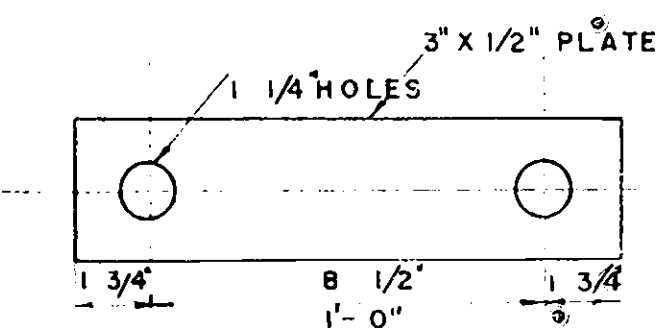

RAILING ANCHOR PLATE
SCALE 3' = 1" = 0"

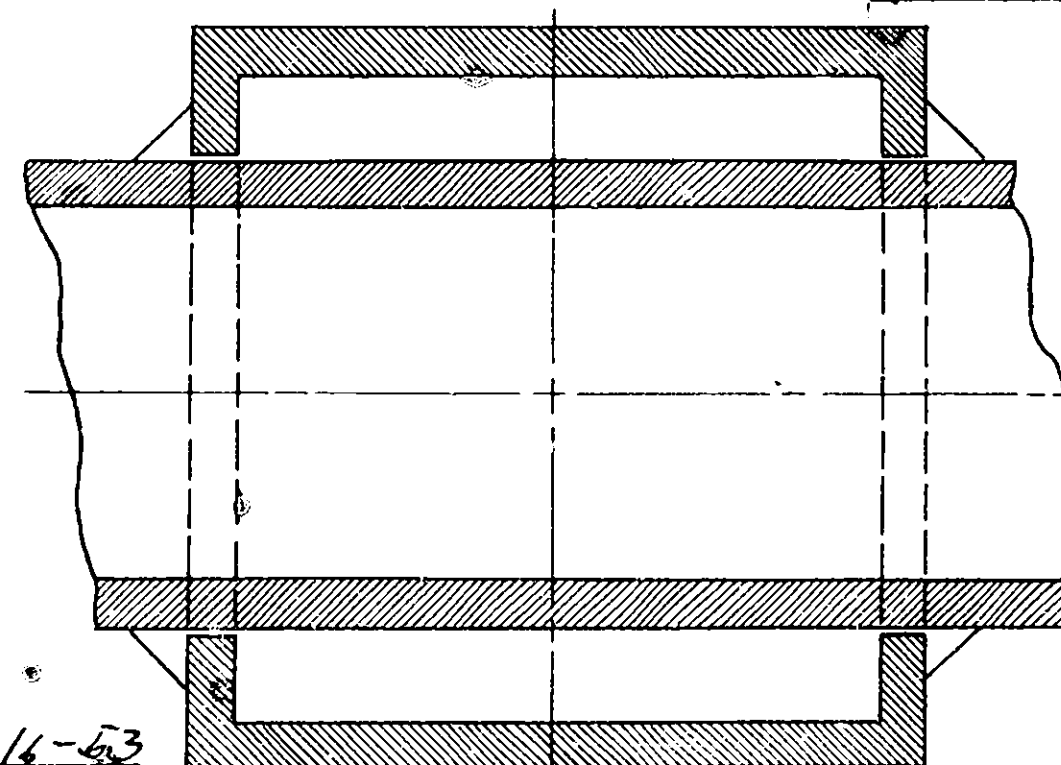

SECT. XX FULL SCALE

NOTE:
WHERE STEEL EXCEEDING ONE INCH IN THICKNESS IS TO BE WELDED, MILL STEEL ARC WELDING ELECTRODES WITH AN OXYGEN-ACETYLENE OR LOW-HYDROGEN TYPE SHALL BE USED. THESE ELECTRODES MUST COMPLY WITH A.S.T.M. (A 233-48) REQUIREMENTS FOR CLASSIFICATION E 6015 OR E 6016. ALL RAILINGS ARE TO BE FABRICATED AND ERECTED SO THE RAILES ARE PARALLEL TO EACH OTHER AND TO THE TOP OF THE FASCIA AND POSTS ARE TRULY VERTICAL. FOR NOTES AND DETAILS NOT SHOWN, SEE STD SHEET 53-106.


PREPARED AND RECOMMENDED

URQUHART & DOYLE, CONSULTING ENGINEERS
NEW YORK STATE PROFESSIONAL ENGINEERS LICENSE NO 5667

62 Doyle Feb 16-53
NEERS DATE


SUPERSTRUCTURE DETAILS
THOMPSON ROAD INTERCHANGE
MOHAWK SECTION
NEW YORK STATE THRUWAY

COUNTY	SHEET NO	TOTAL SHEETS
ONONDAGA	53	66
NEW STATE THRUWAY, MOHAWK SECTION, SUBDIV. 8.5 INTERCHANGE AT THOMPSON ROAD		

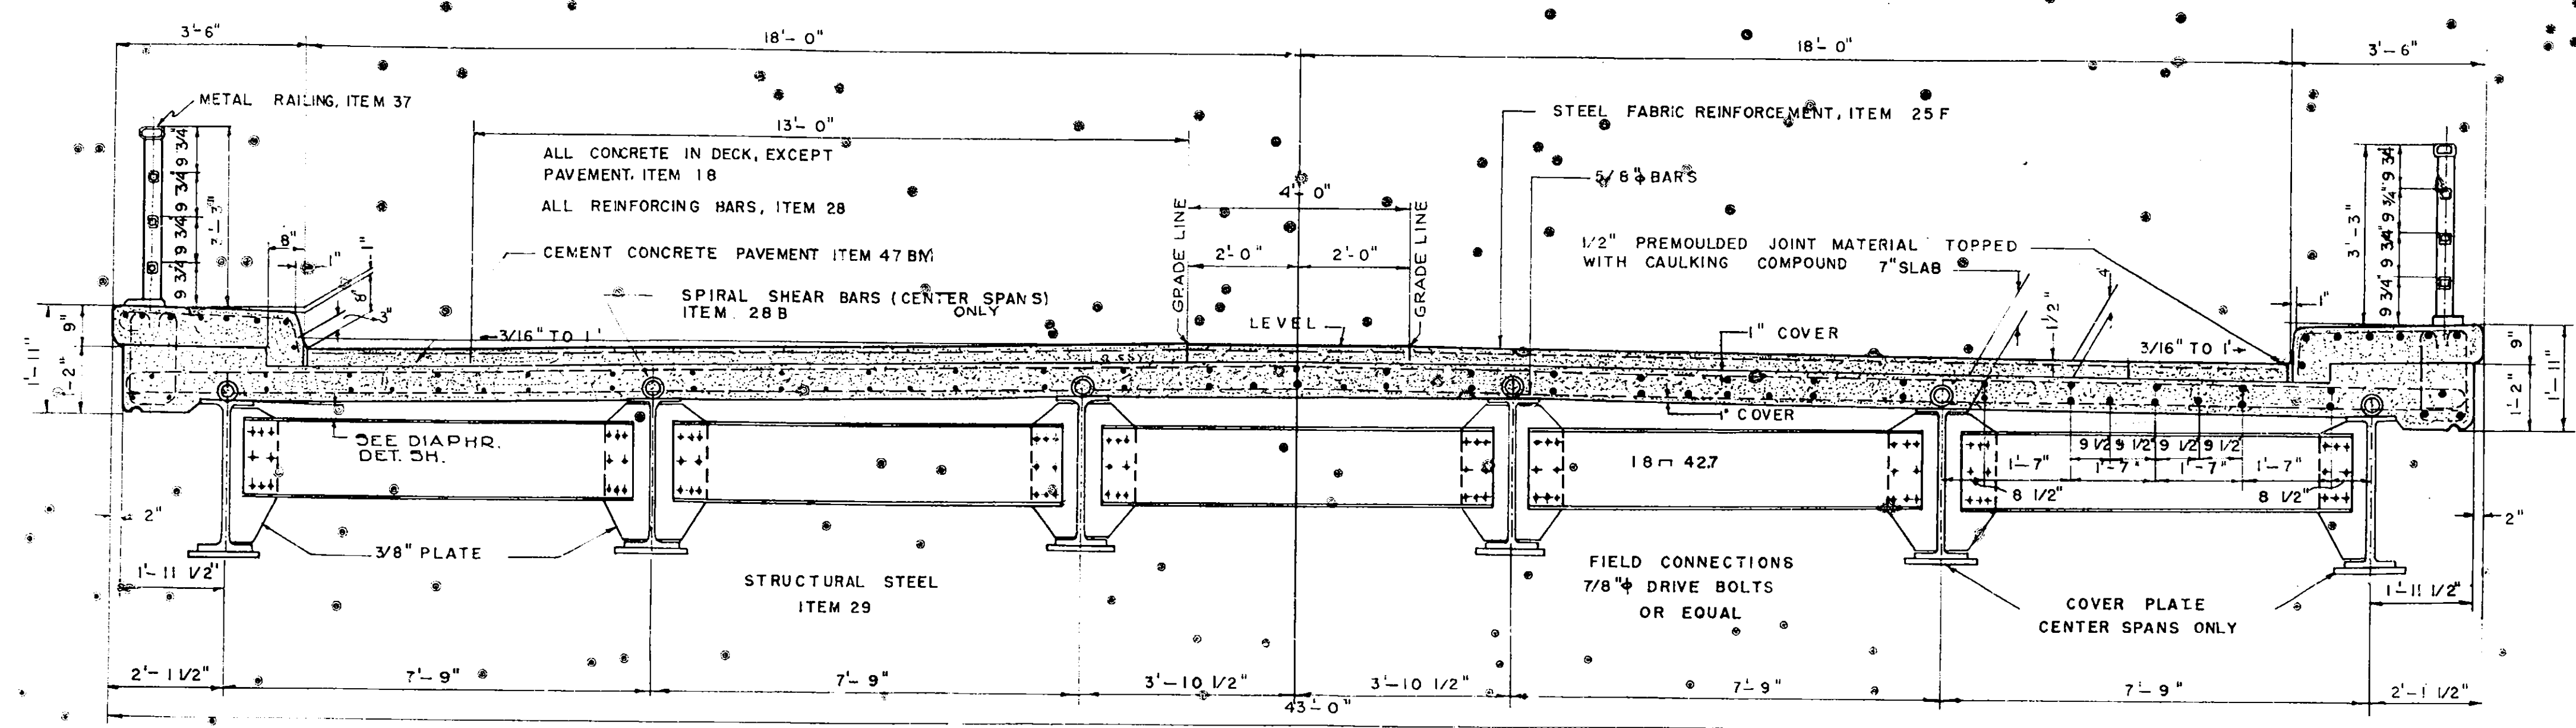


TRANSVERSE SECTION
SCALE 1/2" = 1'-0"

NOTE:
IMMEDIATELY BEFORE PLACING CONCRETE PAVEMENT, THE CONCRETE SURFACE OR SURFACES UPON WHICH IT IS TO BE PLACED SHALL BE THOROUGHLY WETTED DOWN CONTINUOUSLY FOR ONE HOUR IF THE AIR TEMPERATURE IS ABOVE 50°F. COST OF SAME TO BE UNDER ITEM 1WA.
CEMENT IN ITEM 47BM TO BE PORTLAND CEMENT TYPE 1A, ITEM 15-2A.
CEMENT ITEMS 18 & 19 TO BE 7 PARTS PORTLAND CEMENT TYPE 2, ITEM 15-2 AND ONE PART NATURAL CEMENT TYPE N, ITEM 15 N.

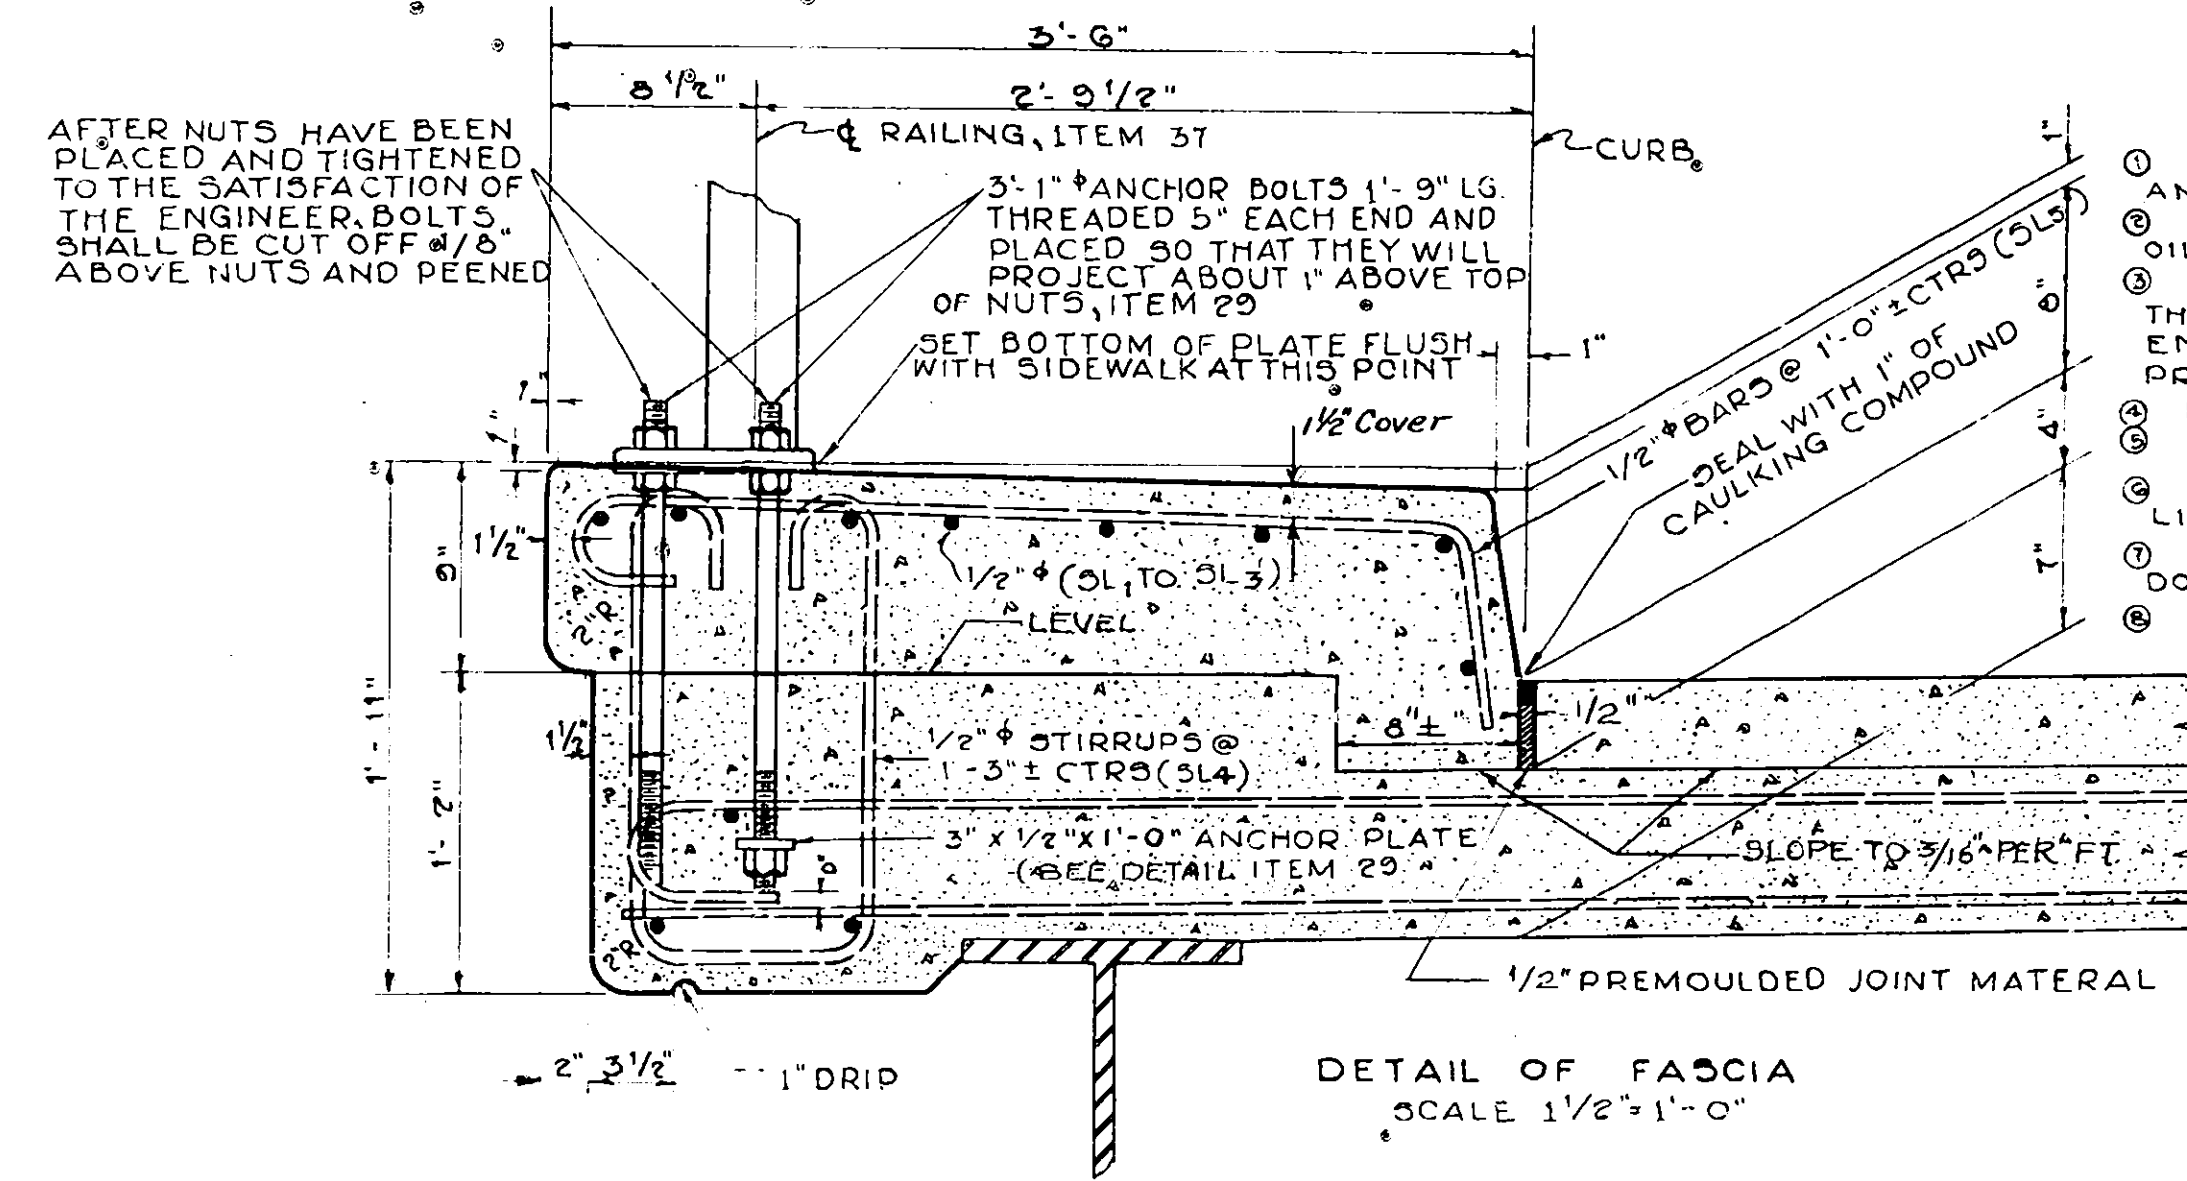


DETAIL OF FASCIA
SCALE 1/2" = 1'-0"

NOTE
FLASHINGS OR WATERSTOPS ARE TO BE PROTECTED FROM DAMAGE DURING THE COURSE OF CONSTRUCTION AS ORDERED BY THE ENGINEER BENDING OR ALTERING THE SHAPE AS SHOWN IN ANY MANNER WILL NOT BE ALLOWED.

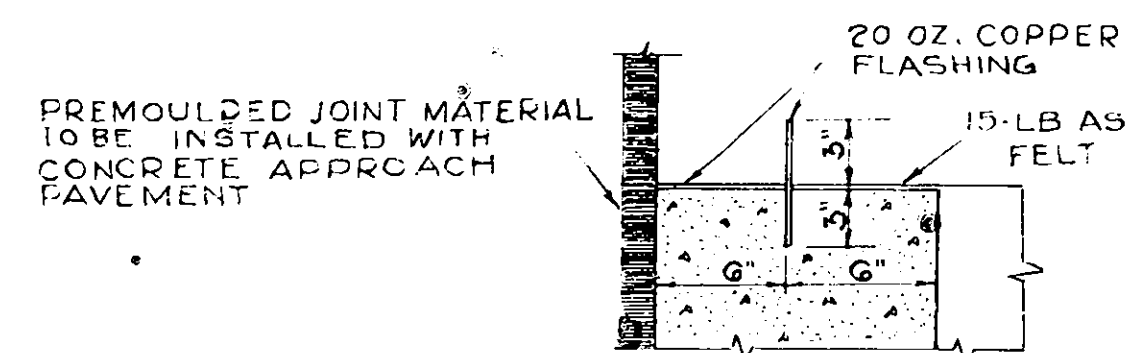


DETAIL B
SCALE 1/2" = 1'-0"

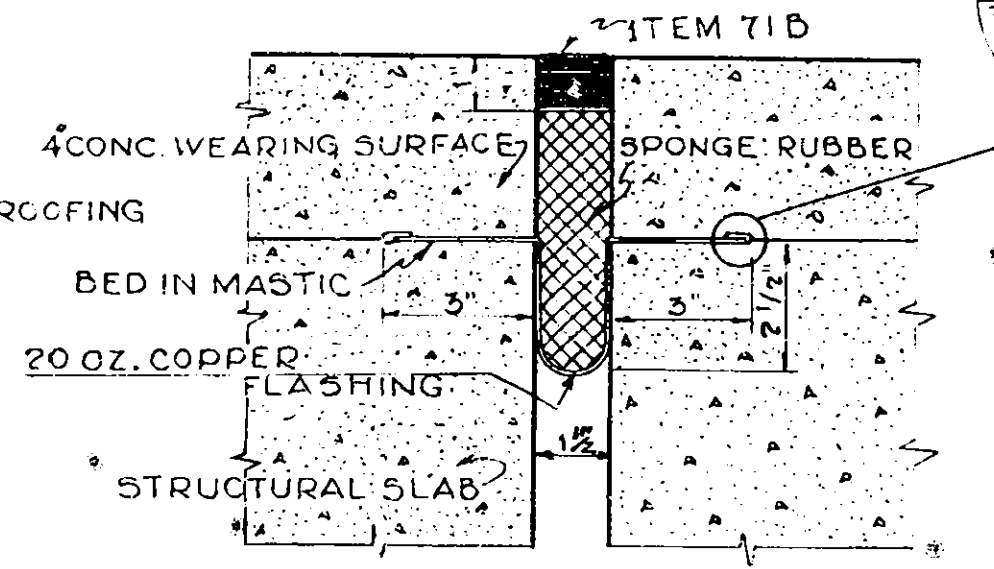


DETAIL OF JOINT OVER N-S PIERS
SCALE 3" = 1'-0"


- CONSTRUCTION PROCEDURE
1. SET ANCHOR BOLTS BY MEANS OF TEMPLATE AND POUR SLAB.
 2. MAKE TWO APPLICATIONS OF WATER-PROOFING OIL TREATMENT M-41-W TO THE TOP OF SLAB.
 3. THE TOP OF THE SLAB SHALL BE CONTINUOUSLY AND THOROUGHLY WETTED DOWN, AS DIRECTED BY THE ENGINEER FOR AT LEAST ONE HOUR, IMMEDIATELY PRIOR TO THE PLACING OF THE ROADWAY PAVEMENT.
 4. POUR ROADWAY PAVEMENT.
 5. PLACE LOWER NUTS ON UPPER END OF ANCHOR BOLTS.
 6. PLACE RAILING ON LOWER NUTS AND ADJUST TO LINE AND GRADE.
 7. PLACE UPPER NUTS ON ANCHOR BOLTS TIGHTEN DOWN ON PLATES.
 8. POUR SIDEWALK TO PROPER LINE AND GRADE.

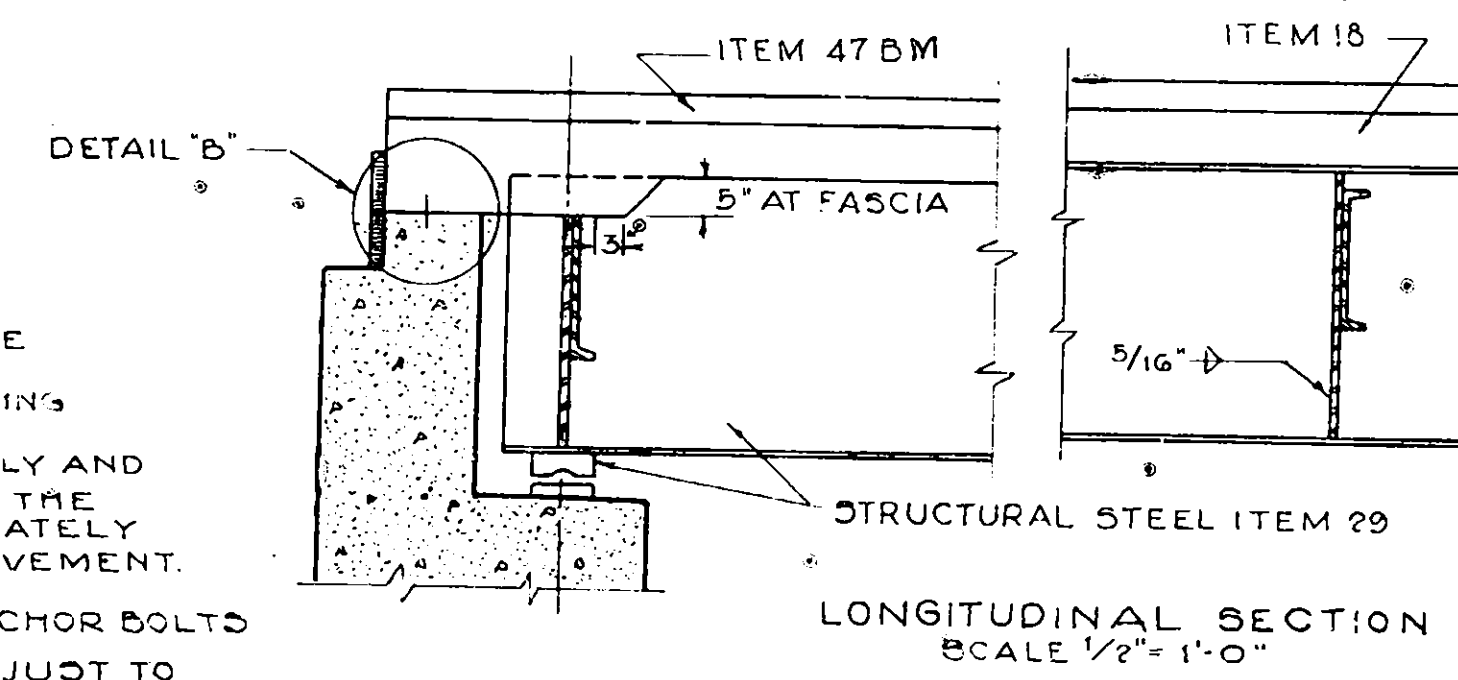



LONGITUDINAL SECTION
SCALE 1/2" = 1'-0"

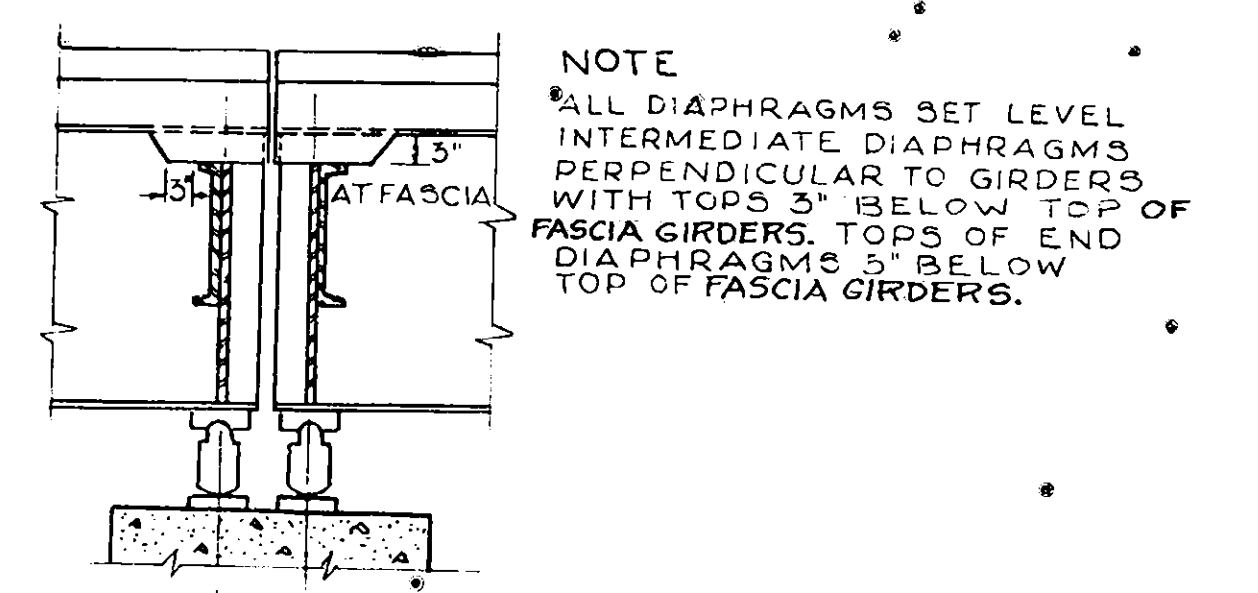

DETAIL OF JOINT OVER CENTER PIER
SCALE: 3" = 1'-0"

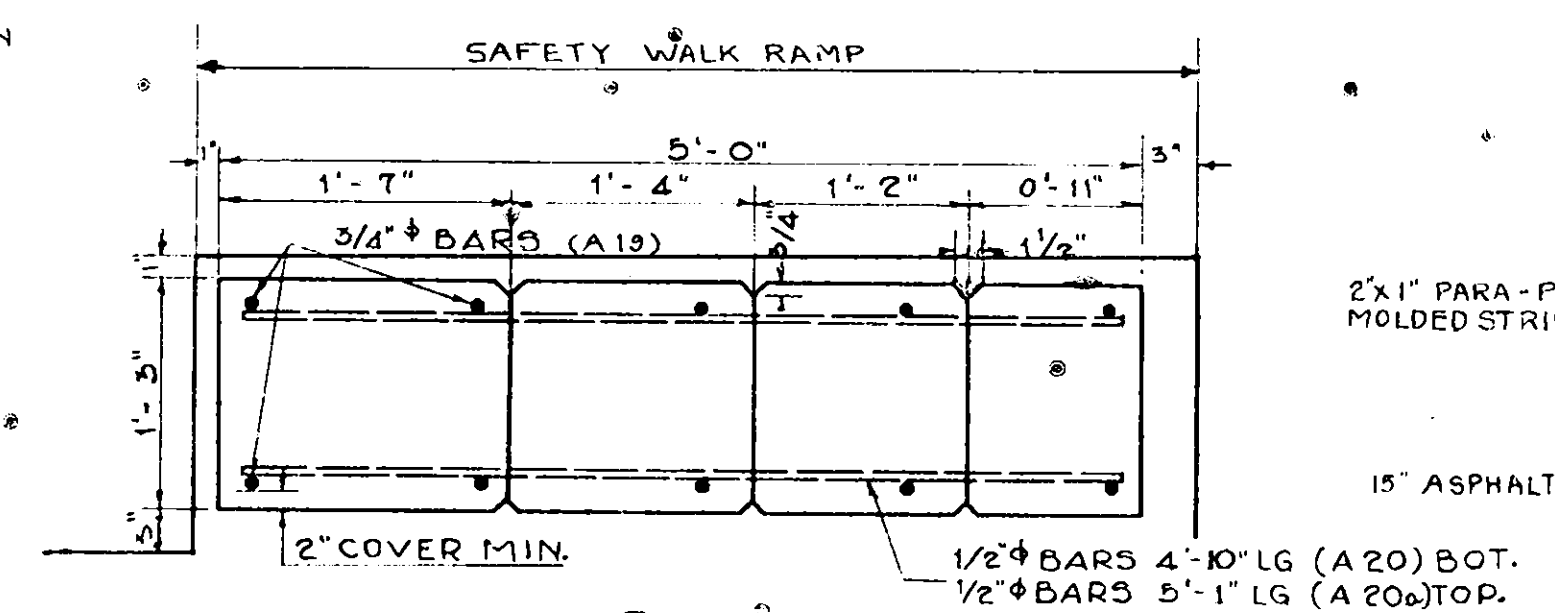


PLAN
SCALE 1" = 1'-0"

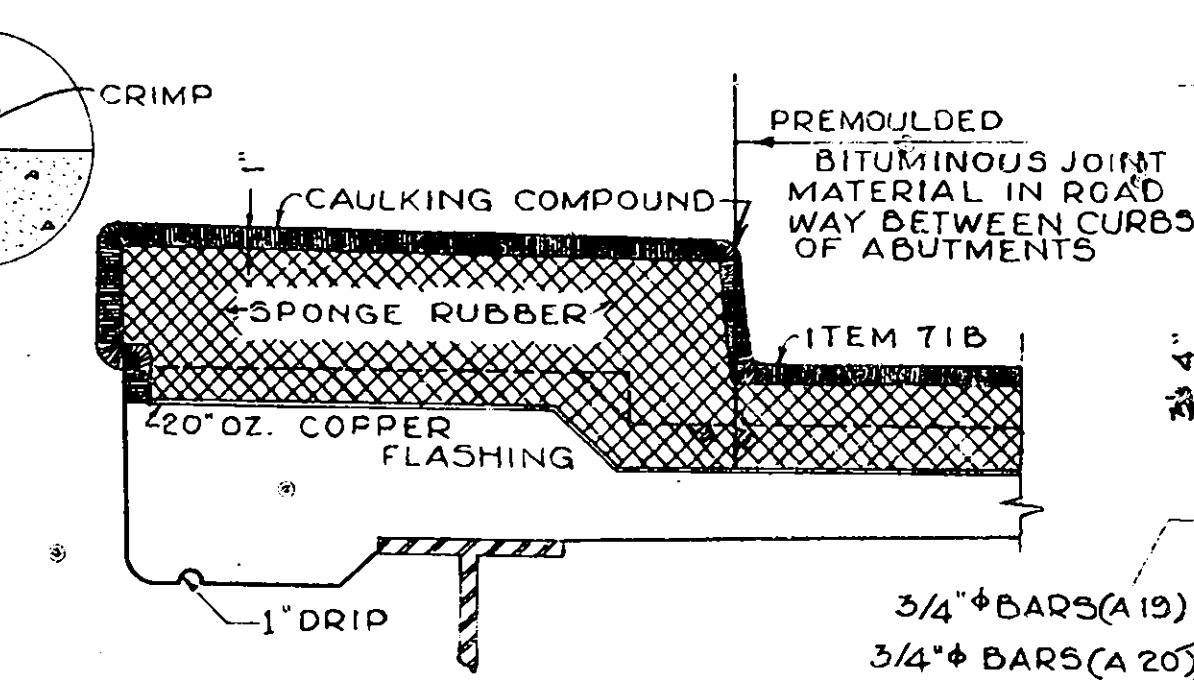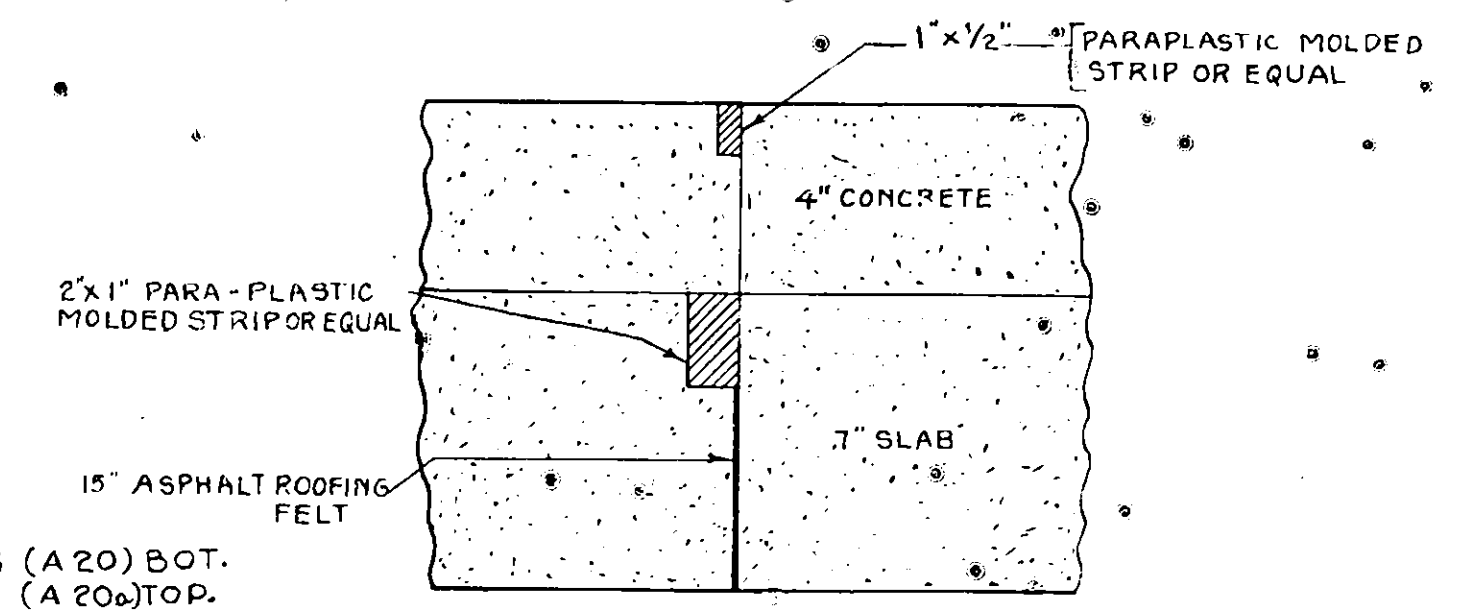

SECTION THRU SAFETY WALK AT JOINT
SCALE 1" = 1'-0"

NOTE
SPONGE RUBBER SHALL COMPLY WITH THE REQUIREMENTS FOR PREFORMED EXPANSION JOINT FILLERS FOR CONCRETE, A. S. T. M. DESIGNATION D 544.
ASPHALT ROOFING FELT SHALL COMPLY WITH THE REQUIREMENTS OF THE STANDARD SPECIFICATIONS OF A. S. T. M., DESIGNATION D 266.

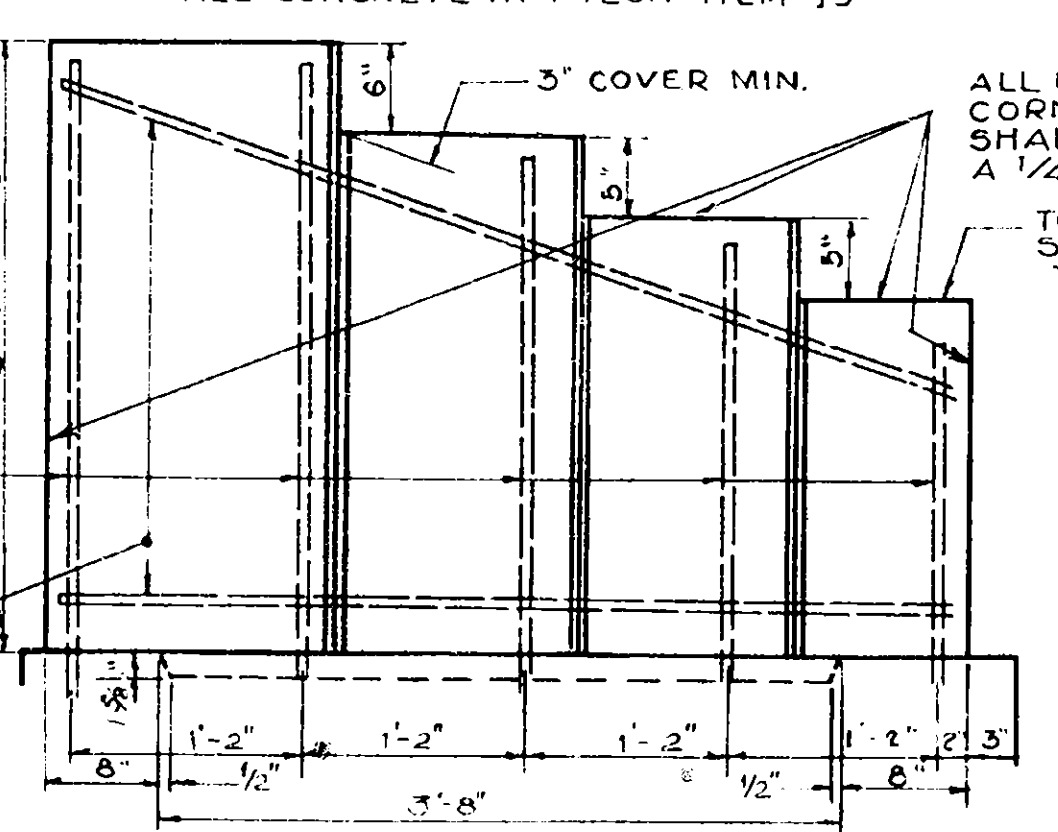

ELEVATION OF PYLON
SCALE 1" = 1'-0"

SUPERSTRUCTURE DETAILS
THOMPSON ROAD INTERCHANGE
MOHAWK SECTION
NEW YORK STATE THRUWAY

PREPARED AND RECOMMENDED:
URQUHART & DOYLE, CONSULTING ENGINEERS
NEW YORK STATE PROFESSIONAL ENGINEERS LICENSE NO. 5667
DATE: Feb 16-53

COUNTY		SHEET NO	TOTAL SHEETS
ONONDAGA		59	66
NY STATE THRUWAY, MOHAWK SECTION, SUBDIV. 8 B			
INTERCHANGE AT THOMPSON ROAD			


53R

NOTE:


NOTE: IMMEDIATELY BEFORE PLACING CONCRETE PAVEMENT. THE CONCRETE SURFACE OR SURFACES UPON WHICH IT IS TO BE PLACED SHALL BE THOROUGHLY WETTED DOWN CONTINUOUSLY FOR ONE HOUR IF THE AIR TEMPERATURE IS ABOVE 50°F. COST OF SAME TO BE UNDER ITEM 1WA.

CEMENT IN ITEM 47 BM TO BE PORTLAND CEMENT
TYPE 1A, ITEM 15-B A.

CEMENT ITEMS 18 & 19 TO BE 7 PARTS PORTLAND CEMENT
TYPE 2, ITEM 15-2 AND ONE PART NATURAL CEMENT
TYPE N, ITEM 15 N.

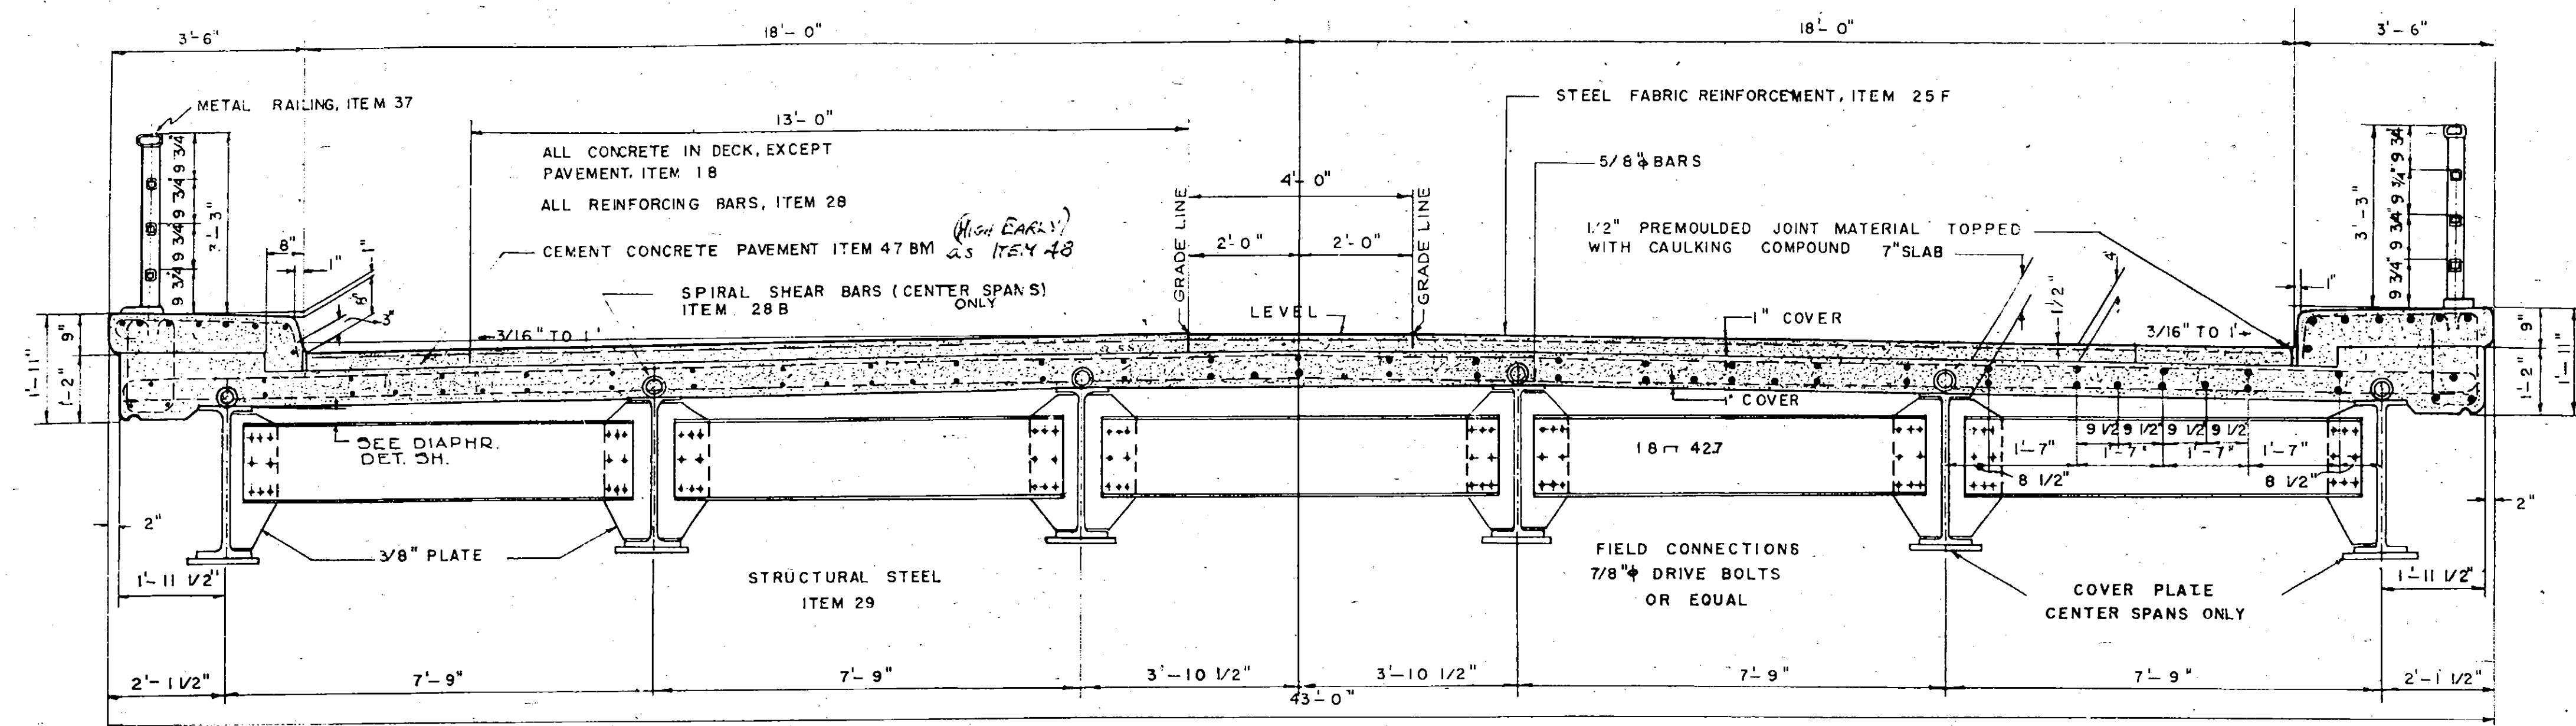


TRANSVERSE SECTION
SCALE: 1/2" = 1'-0"

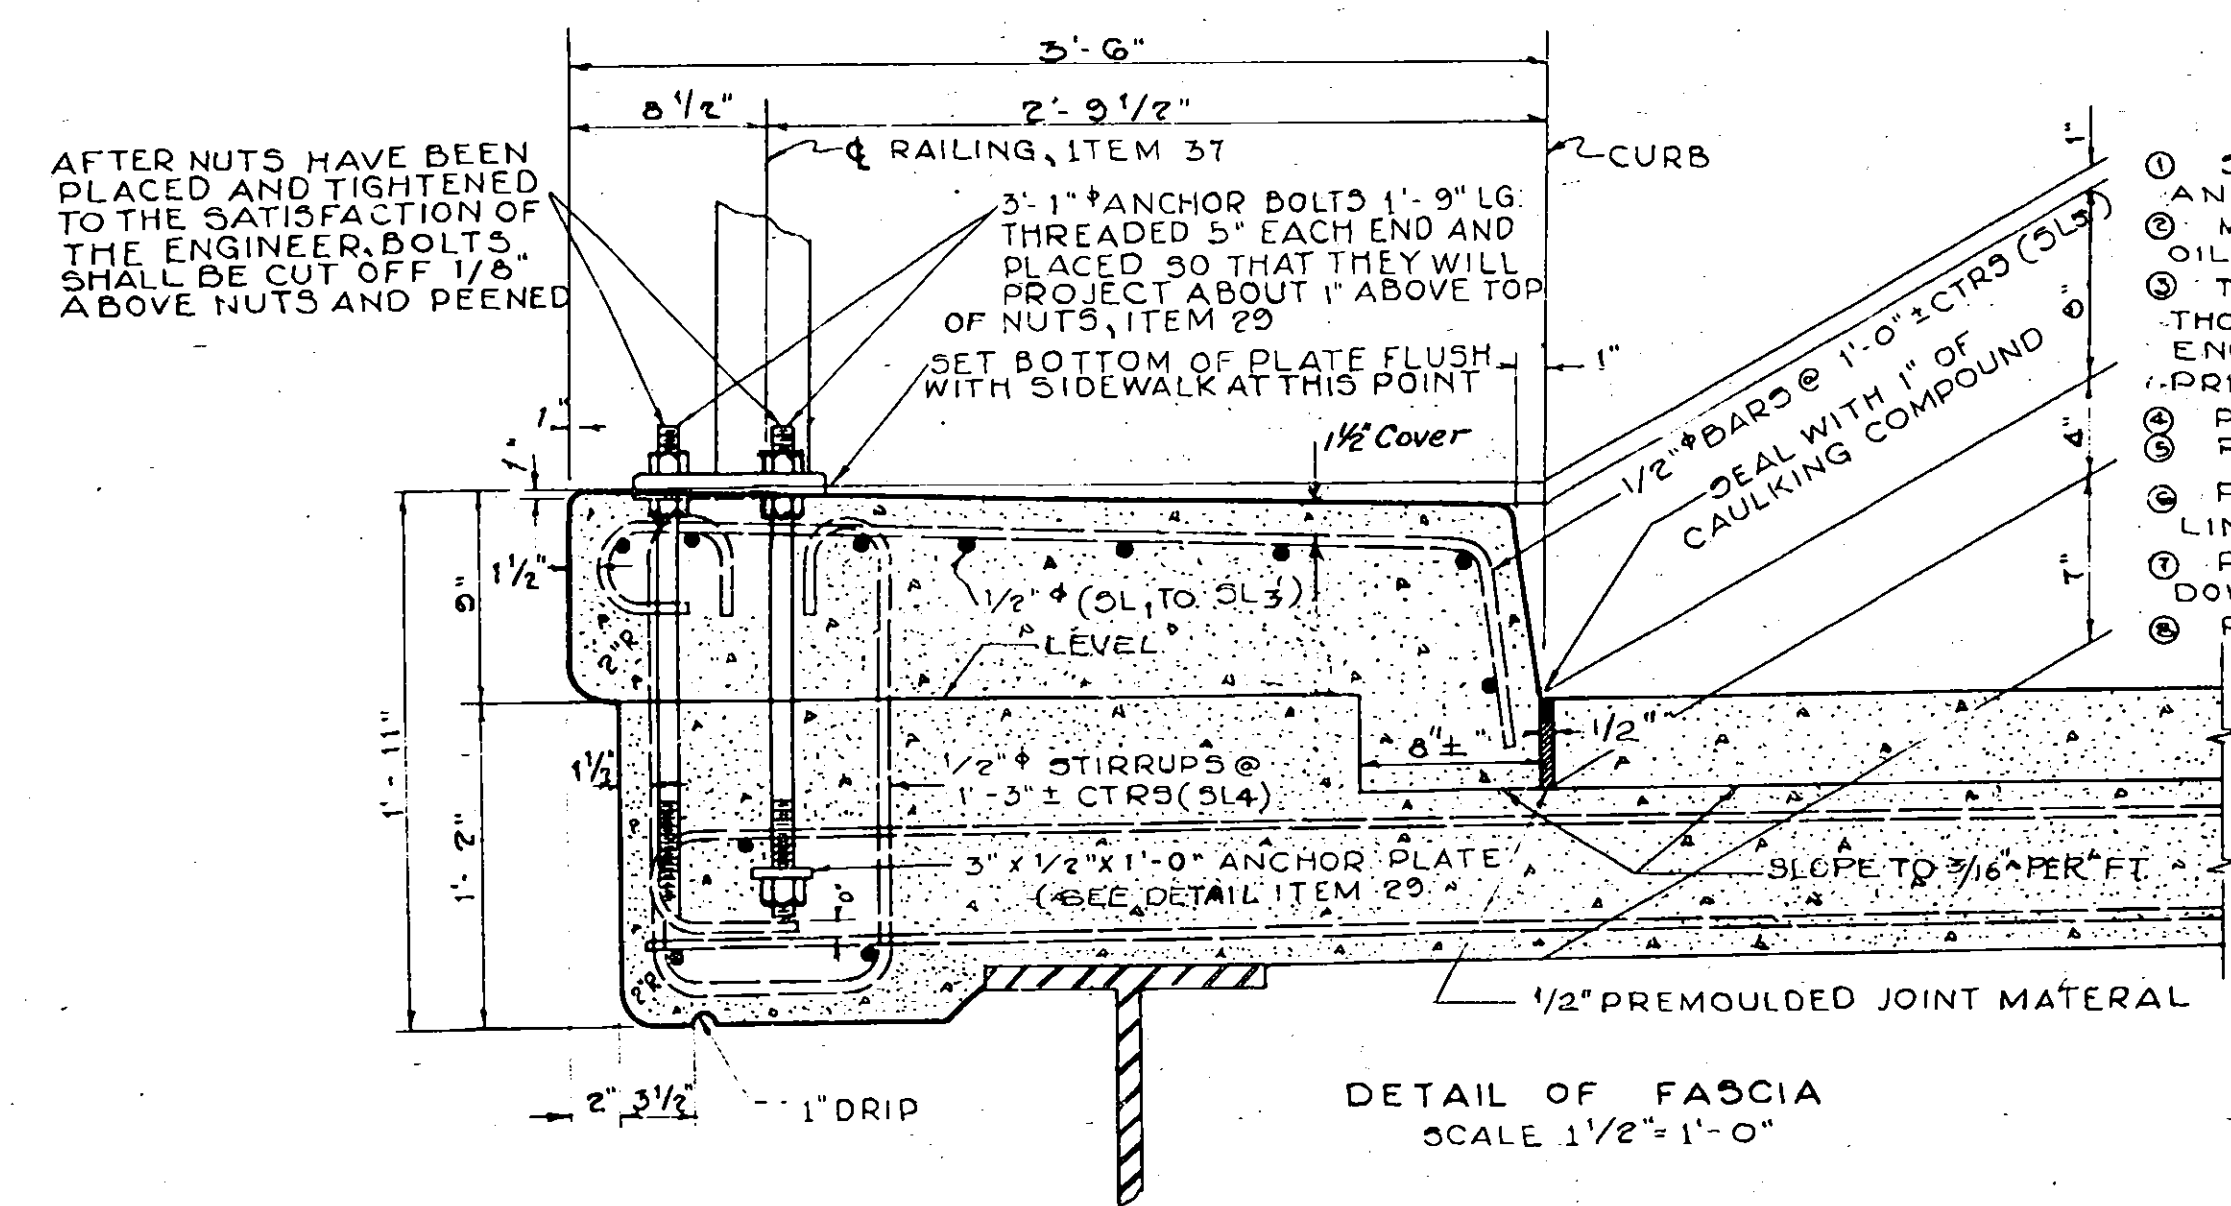


DETAIL OF FASCIA
SCALE 1 1/2" = 1'-0"

NOTE
FLASHINGS OR WATERSTOPS ARE TO BE PROTECTED
FROM DAMAGE DURING THE COURSE OF CONSTRUCTION
AS ORDERED BY THE ENGINEER BENDING OR ALTERING
THE SHAPE AS SHOWN IN ANY MANNER WILL NOT
BE ALLOWED.

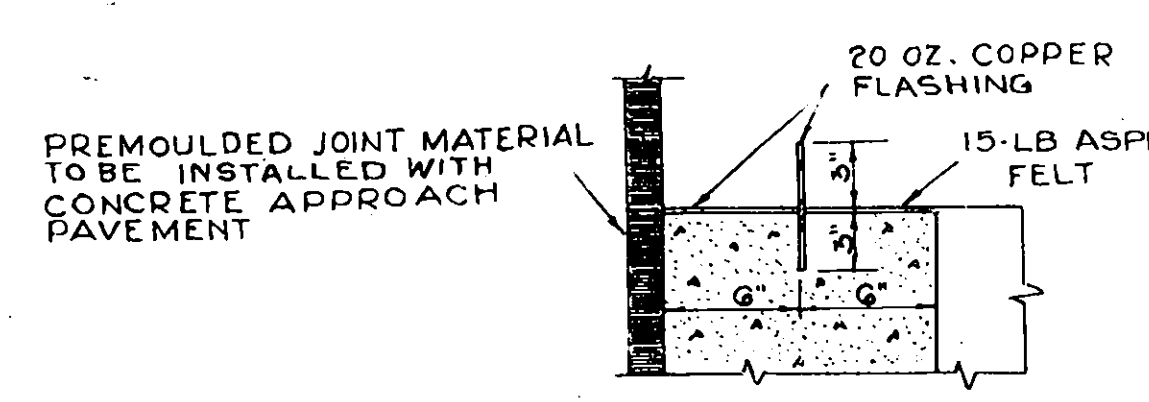


DETAIL B
SCALE 1 1/2" = 1'-0"

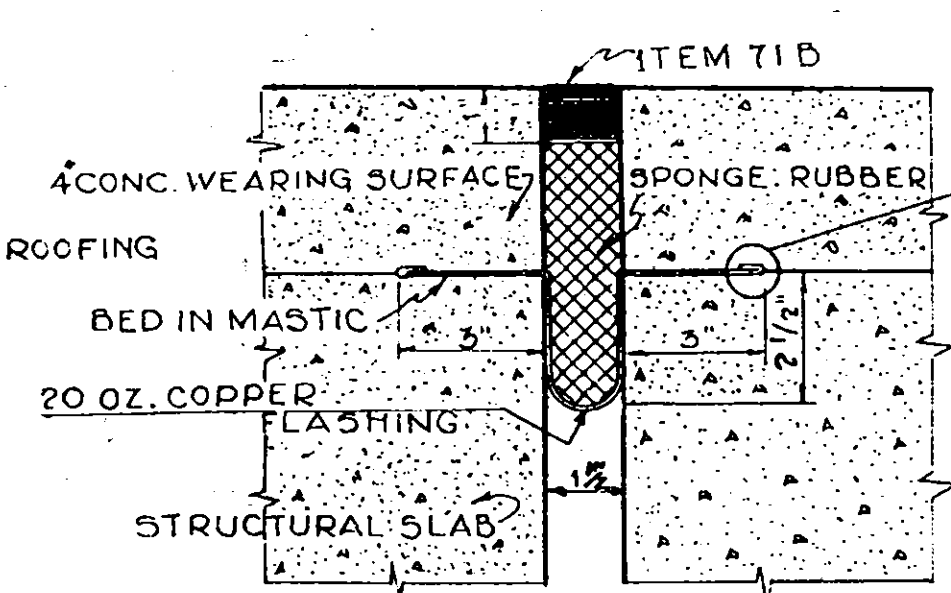


DETAIL OF JOINT OVER N-S PIERS
SCALE 3" = 1'-0"

CONSTRUCTION PROCEDURE


- ① SET ANCHOR BOLTS BY MEANS OF TEMPLATE AND POUR SLAB.
- ② MAKE TWO APPLICATIONS OF WATER-PROOFING OIL TREATMENT M-41- W TO THE TOP OF SLAB.
- ③ THE TOP OF THE SLAB SHALL BE CONTINUOUSLY AND THOROUGHLY WETTED DOWN, AS DIRECTED BY THE ENGINEER FOR AT LEAST ONE HOUR, IMMEDIATELY PRIOR TO THE PLACING OF THE ROADWAY PAVEMENT.
- ④ POUR ROADWAY PAVEMENT.
- ⑤ PLACE LOWER NUTS ON UPPER END OF ANCHOR BOLTS.
- ⑥ PLACE RAILING ON LOWER NUTS AND ADJUST TO LINE AND GRADE.
- ⑦ PLACE UPPER NUTS ON ANCHOR BOLTS TIGHTEN DOWN ON PLATES.
- ⑧ POUR SIDEWALK TO PROPER LINE AND GRADE.

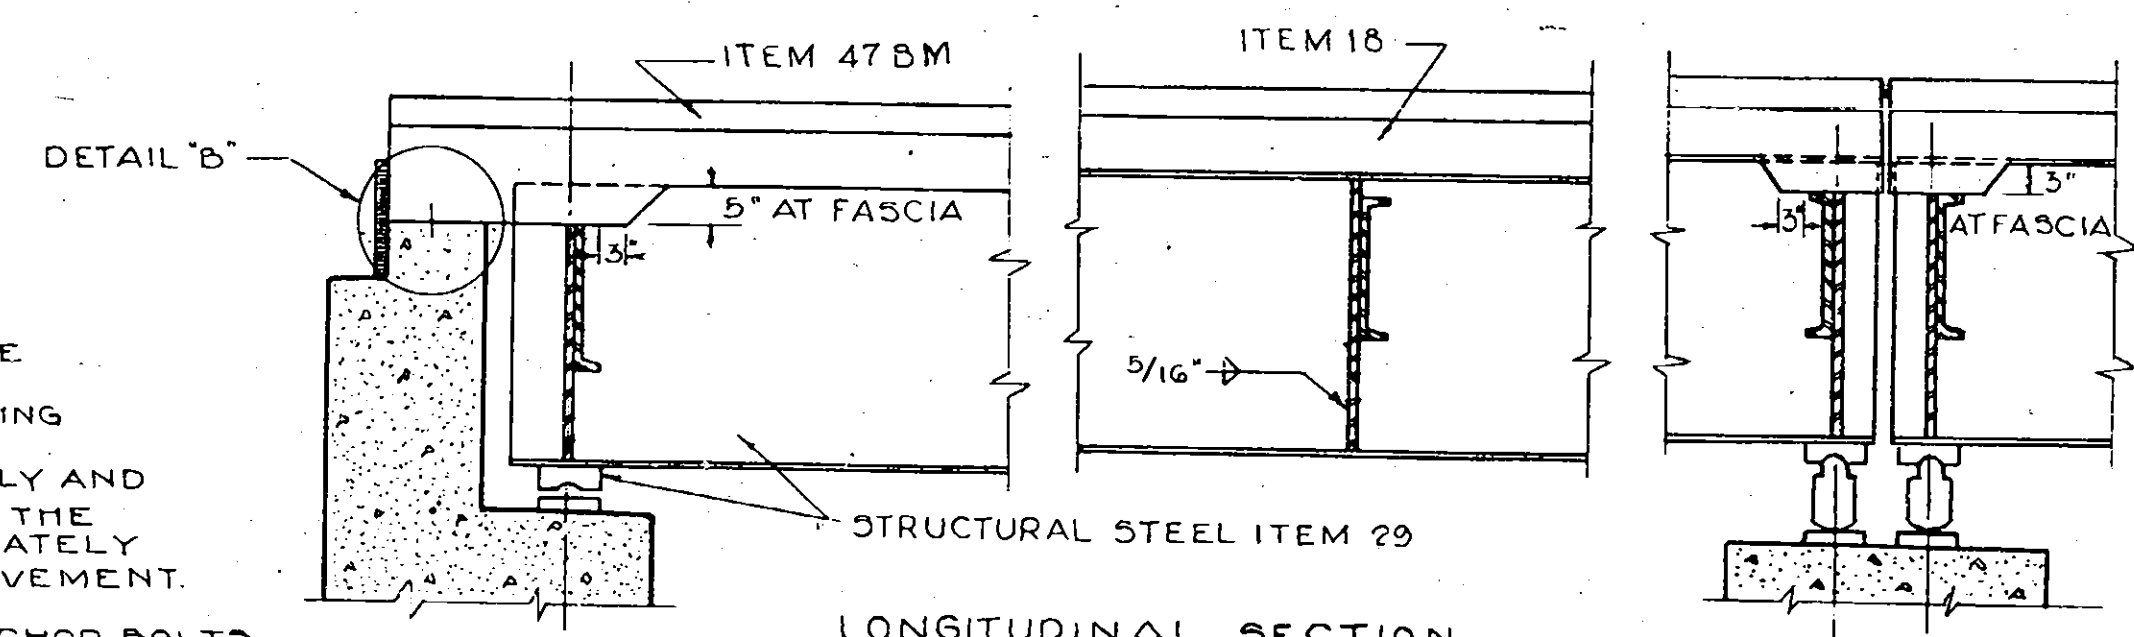


LONGITUDINAL SECTION
SCALE 1/2" = 1'-0"

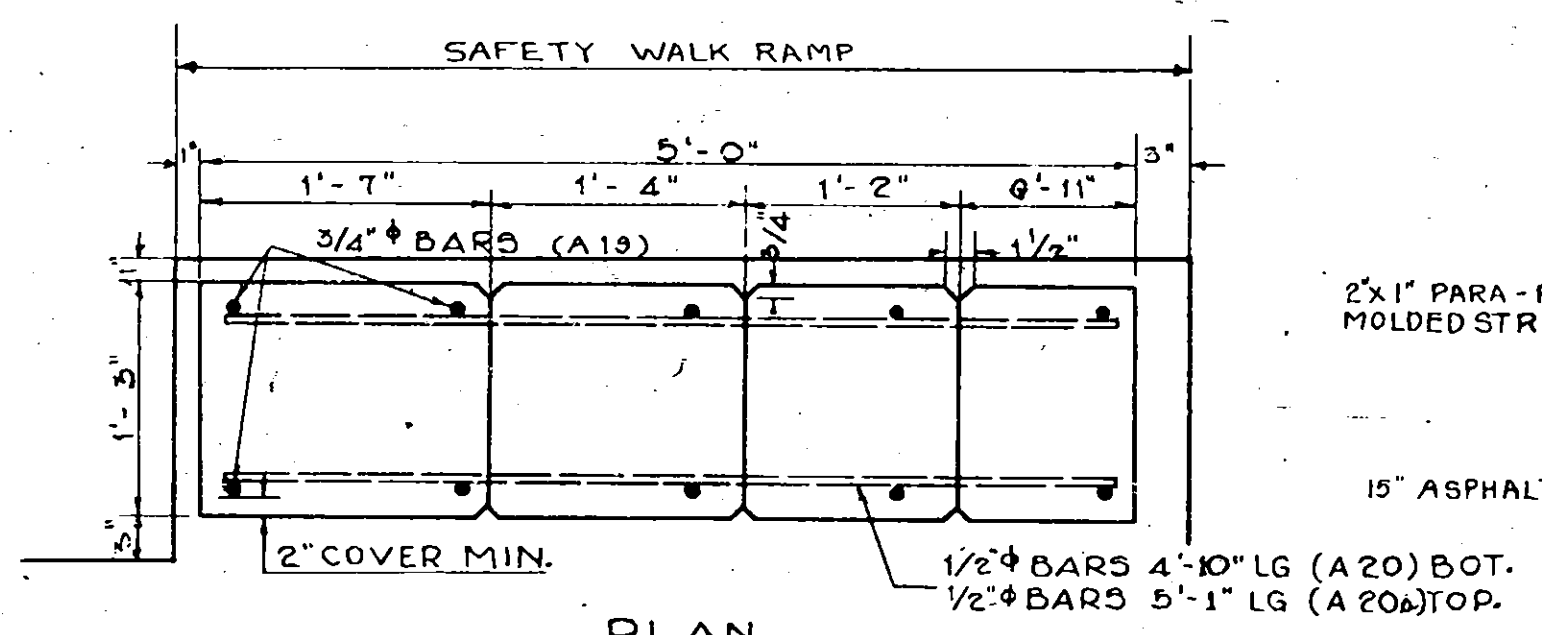

PLAN
SCALE 1" = 1'-0"

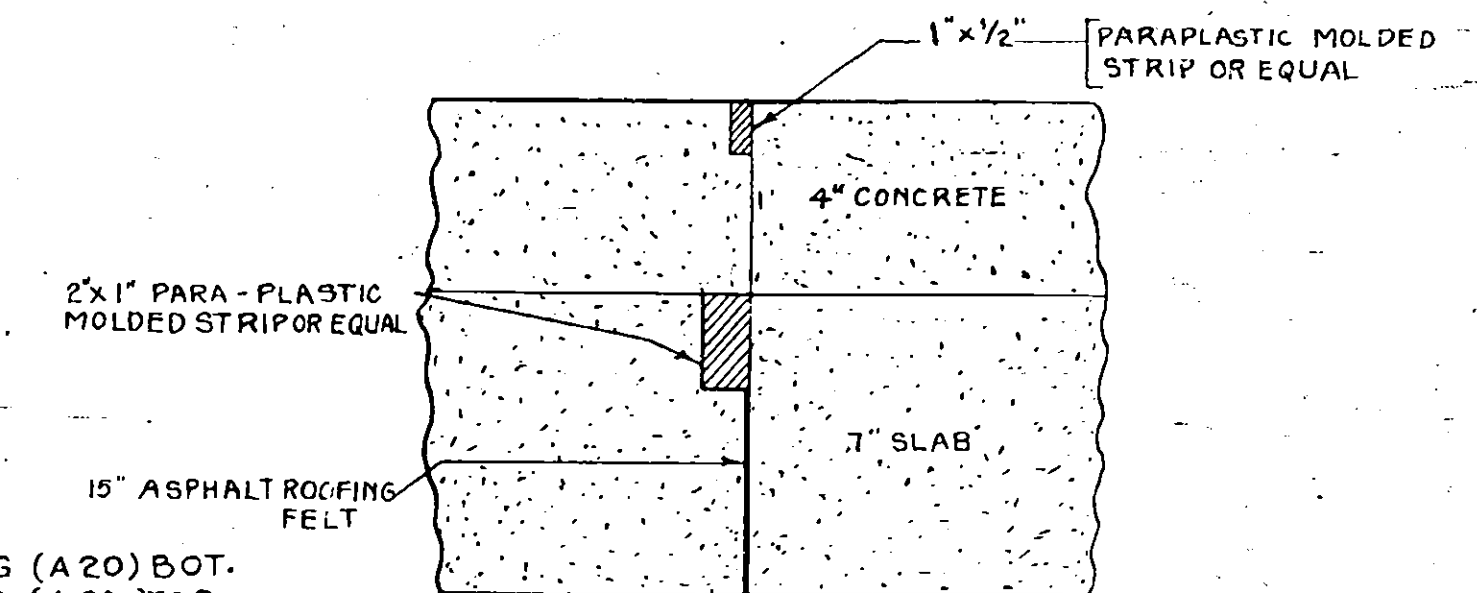

DETAIL OF JOINT OVER CENTER PIER
SCALE: 3" = 1'-0"

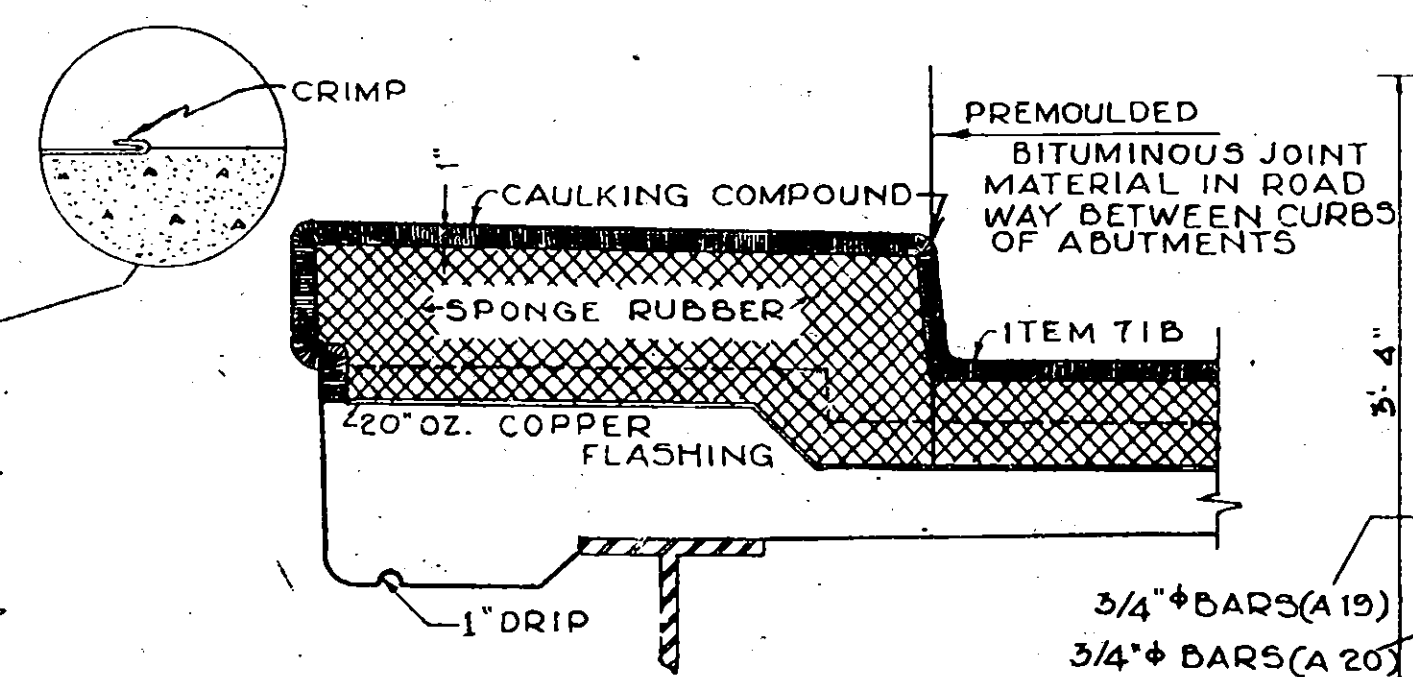


SECTION THRU SAFETY WALK AT JOINT
SCALE 1"=1'-0"

NOTE

SPONGE RUBBER SHALL COMPLY WITH THE
REQUIREMENTS FOR PREFORMED EXPANSION
JOINT FILLERS FOR CONCRETE, A. S. T. M.
DESIGNATION D 544.

ASPHALT ROOFING FELT SHALL COMPLY WITH
THE REQUIREMENTS OF THE STANDARD SPECIFICATIONS
OF A. S. T. M., DESIGNATION D 266.

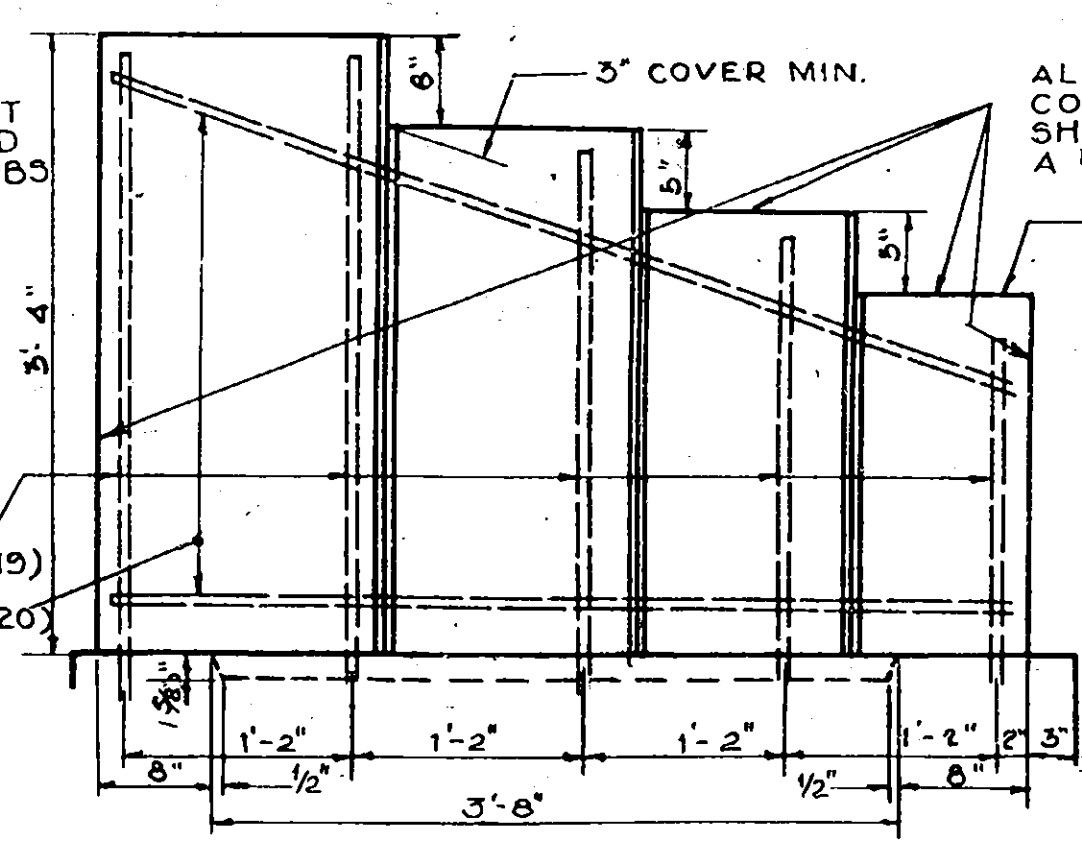

ELEVATION OF PYLON
SCALE 1" = 1'-0"

BUILT ACCORDING TO PLAN

SUPERSTRUCTURE DETAILS

THOMPSON ROAD INTERCHANGE
MOHAWK SECTION
NEW YORK STATE THRUWAY

PREPARED AND RECOMMENDED:

URQUHART & DOYLE, CONSULTING ENGINEERS
NEW YORK STATE PROFESSIONAL ENGINEERS LICENSE NO. 5667

COUNTY	SHEET NO	TOTAL SHEETS
ONONDAGA	54	66
N.Y. STATE THRUWAY, MOHAWK SECTION SUBDIV. B B		
INTERCHANGE AT THOMPSON ROAD		


SUPERSTRUCTURE BAR LIST

MARK	SIZE	NO.	LENGTH	TYPE	A	B	C	LOCATION	MARK	SIZE	NO.	LENGTH	TYPE	A	B	C	LOCATION
L1	3/4"	27	33'-0"	STR				TOP OF DECK SLAB (LONG.)									
L2	3/4"	33	33'-0"					BOTT.									
L2	5/8"	54	34'-9"					TOP									
L2	7/8"	78	34'-9"					BOTT.									
L3	5/8"	54	31'-3"					TOP									
L3	7/8"	78	31'-3"					BOTT.									
L4	435	42'-8"						BOTT. (TRANS) ALL SPANS									
L5	435	43'-8"	I	42-5	0-5	0-10		TOP									
E1	32	26'-0"	III	22-2	0-0	3-10		TOP & BOTT									
SL1	1/2"	32	39'-0"	STR				SIDEWALKS BOTH END SPANS (LONG.)									
SL2	32	34'-9"						N. CENTER SPAN									
SL3	32	31'-3"						S.									
SL4	336	4'-7"	VI	0-10	0-3	1-7		OF ALL SPANS (STRUT)									
SL5	205	4'-6"	II					(TRANS)									
A19	3/4"	40	5'-0"	STR				PYLONS (VERT.)									
A20	8	4'-10"						(HORIZ.)									
A20B	8	5'-1"															


SUBSTRUCTURE BAR LIST

MARK	SIZE	NO.	LENGTH	TYPE	A	B	C	LOCATION
AF1	3/4"	80	9'-1"	STR				ABUTMENT FOOTINGS & BACK WALL
AF2	48	6'-7"						BRS SEATS
AF3	68	11'-3"						WING WALLS
AF4	24	46'-0"						ABUTMENT FOOTINGS
AF5	48	17'-0"						WINGWALL FOOTINGS
AF6	1/2"	112	5'-2"					ABUT. & WINGWALL FOOTINGS
PF1	1"	108	8'-0"	II	7-0	0-8	1-4	PIER FOOTINGS
PF2	1"	22	11'-6"	I	9-6	0-8	1-4	"
PF3	1"	36	10'-8"	I	8-8	0-8	1-4	"
PF4	7/8"	28	8'-3"	I	6-6	0-7	1-2	"
PF5	7/8"	40	6'-3"	I	4-6	0-7	1-2	"
A1	3/4"	16	45'-6"	STR				ABUT. BACK WALLS
A2	12	18'-1"	VII	15-0	2-6	0-7		WING WALLS
A2A	4	19'-8"	III	15-0	0-0	4-8		
A3	16	19'-6"	VII	11-10	3-0	4-7		
A4	1/2"	48	9'-6"	VI	2-4	0-4	3-2	BEARING SEATS
AG	3/4"	40	7'-0"	STR				WING WALLS TO PIERS
AG	1/2"	28	4'-6"	STR				WING WALLS
A7	8	6'-10"						
A8	8	11'-6"						
P1	1"	36	20'-11"	STR				N. PIER COLUMNS
P2	36	21'-2"						C
P3	36	19'-0"						S
P4	1/4"	66	30'-0"	X	17-1			N
P5	66	30'-0"			17-4			C
P6	66	30'-0"			15-1			S
P7	1 1/4"	24	11'-0"	STR				ALL PIER CAPS
P8	6	48'-4"	II	42-2	2-10			
PA	6	39'-0"	STR					
P9	12	29'-9"	IV	25-1	1-6	2-3		
P10	12	30'-9"			26-1	1-6	2-3	
P11	12	10'-8"			6-0	1-6	2-3	
P15	1/2"	72	1'-6"	STR				PIER PADS
P16	1/2"	36	10'-0"	V	2-0	0-3	2-8	
P17	3/8"	36	20'-8"	STR				PIER CAPS
P18	5/8"	30	10'-5"	VII	3-0	3-0	4-5	
P19	1/2"	168	13'-8"	V	2-1	0-3	3-8	
PL1	3/4"	240	8'-9"	II	8-0	0-6	1-0	ALL PILES (BASED ON EST. LENGTH)
PL2	1/4"	240	3'-0"	IX	0-8	0-0	0-0	(ASSUMED FOR 12" STR. PILES)


BAR DETAILS

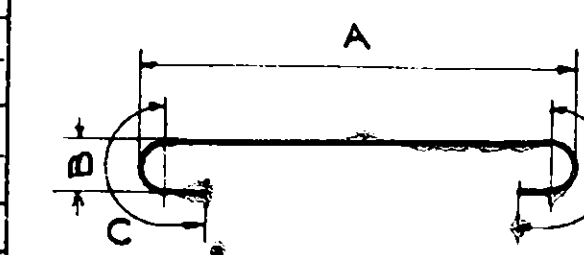


TYPE I

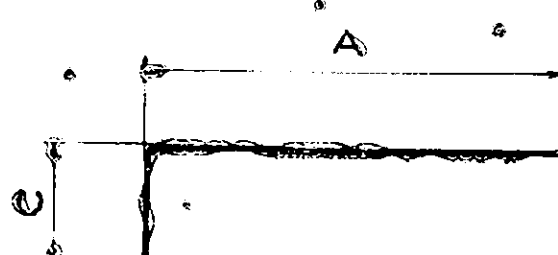


TYPE VII

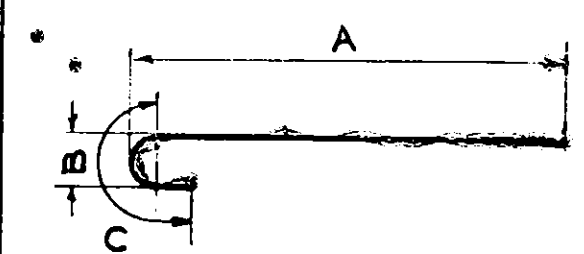


TYPE II

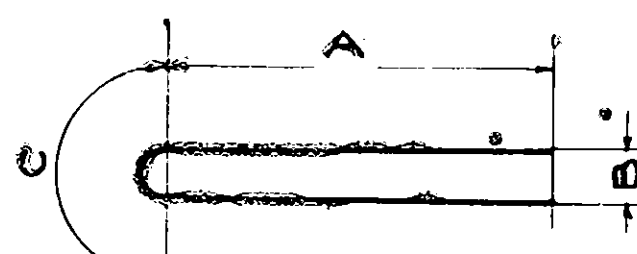


TYPE VIII

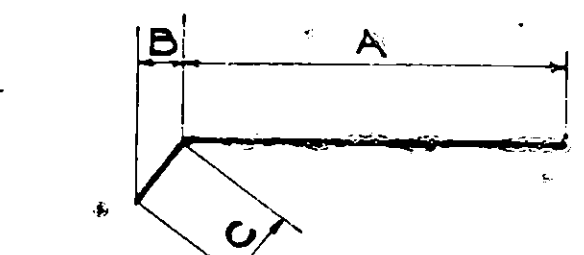


TYPE III

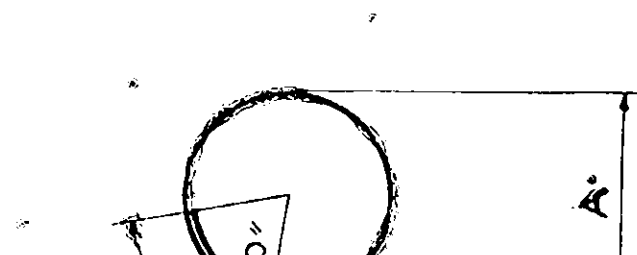


TYPE IX

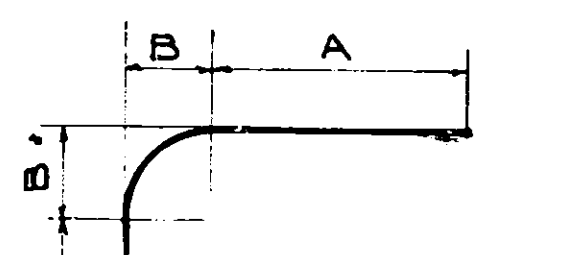


TYPE IV

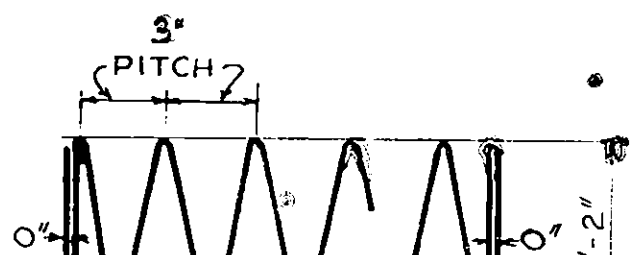


TYPE X

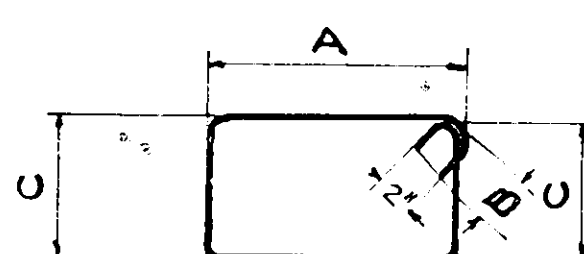

TYPE V

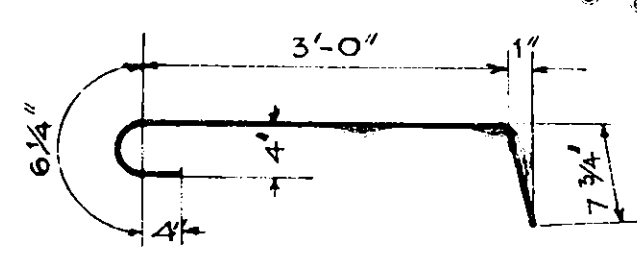

TYPE XI

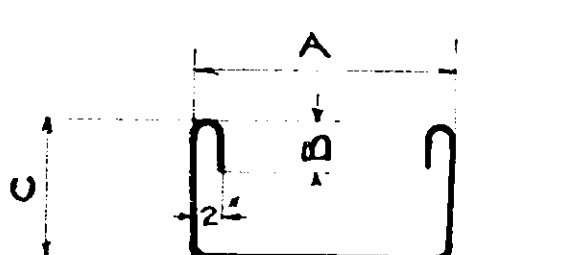

TYPE VI

ALL REINFORCING BARS, ITEM 28

BAR LIST




THOMPSON ROAD INTERCHANGE
MOHAWK SECTION
NEW YORK STATE THRUWAY

PREPARED AND RECOMMENDED:

URQUHART & DOYLE, CONSULTING ENGINEERS
NEW YORK STATE PROFESSIONAL ENGINEERS LICENSE NO. 5667

DATE

COUNTY	SHEET NO	TOTAL SHEETS
ONONDAGA	55	66
N.Y. STATE THRUWAY, MOHAWK SECTION SUBDIV. 88		
INTERCHANGE AT THOMPSON ROAD		

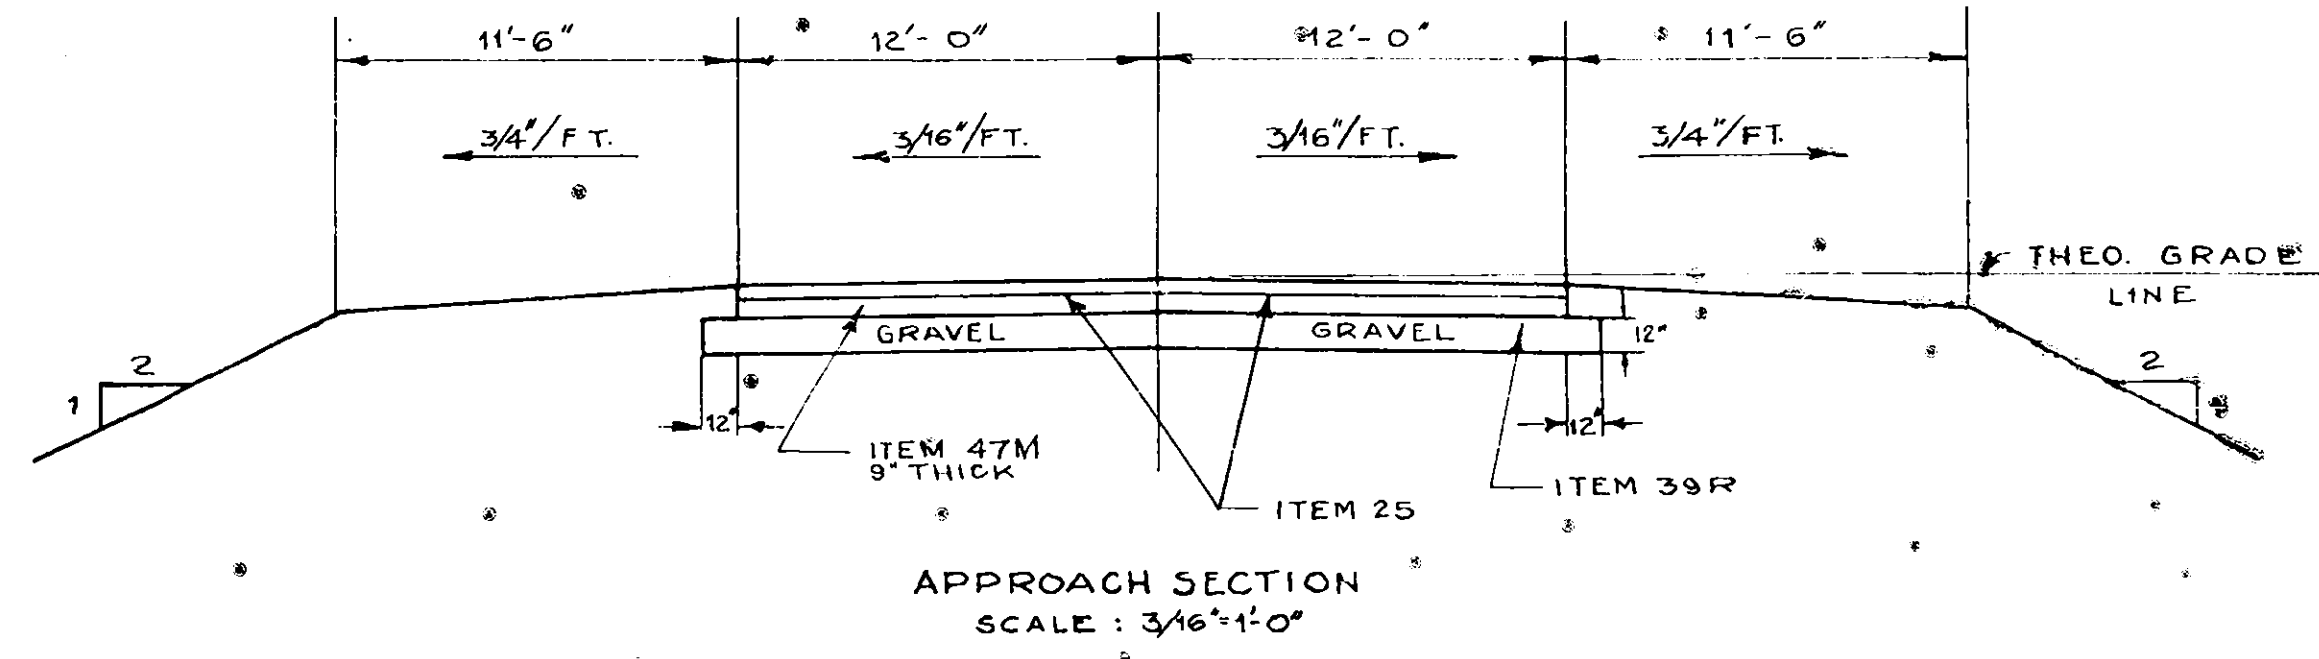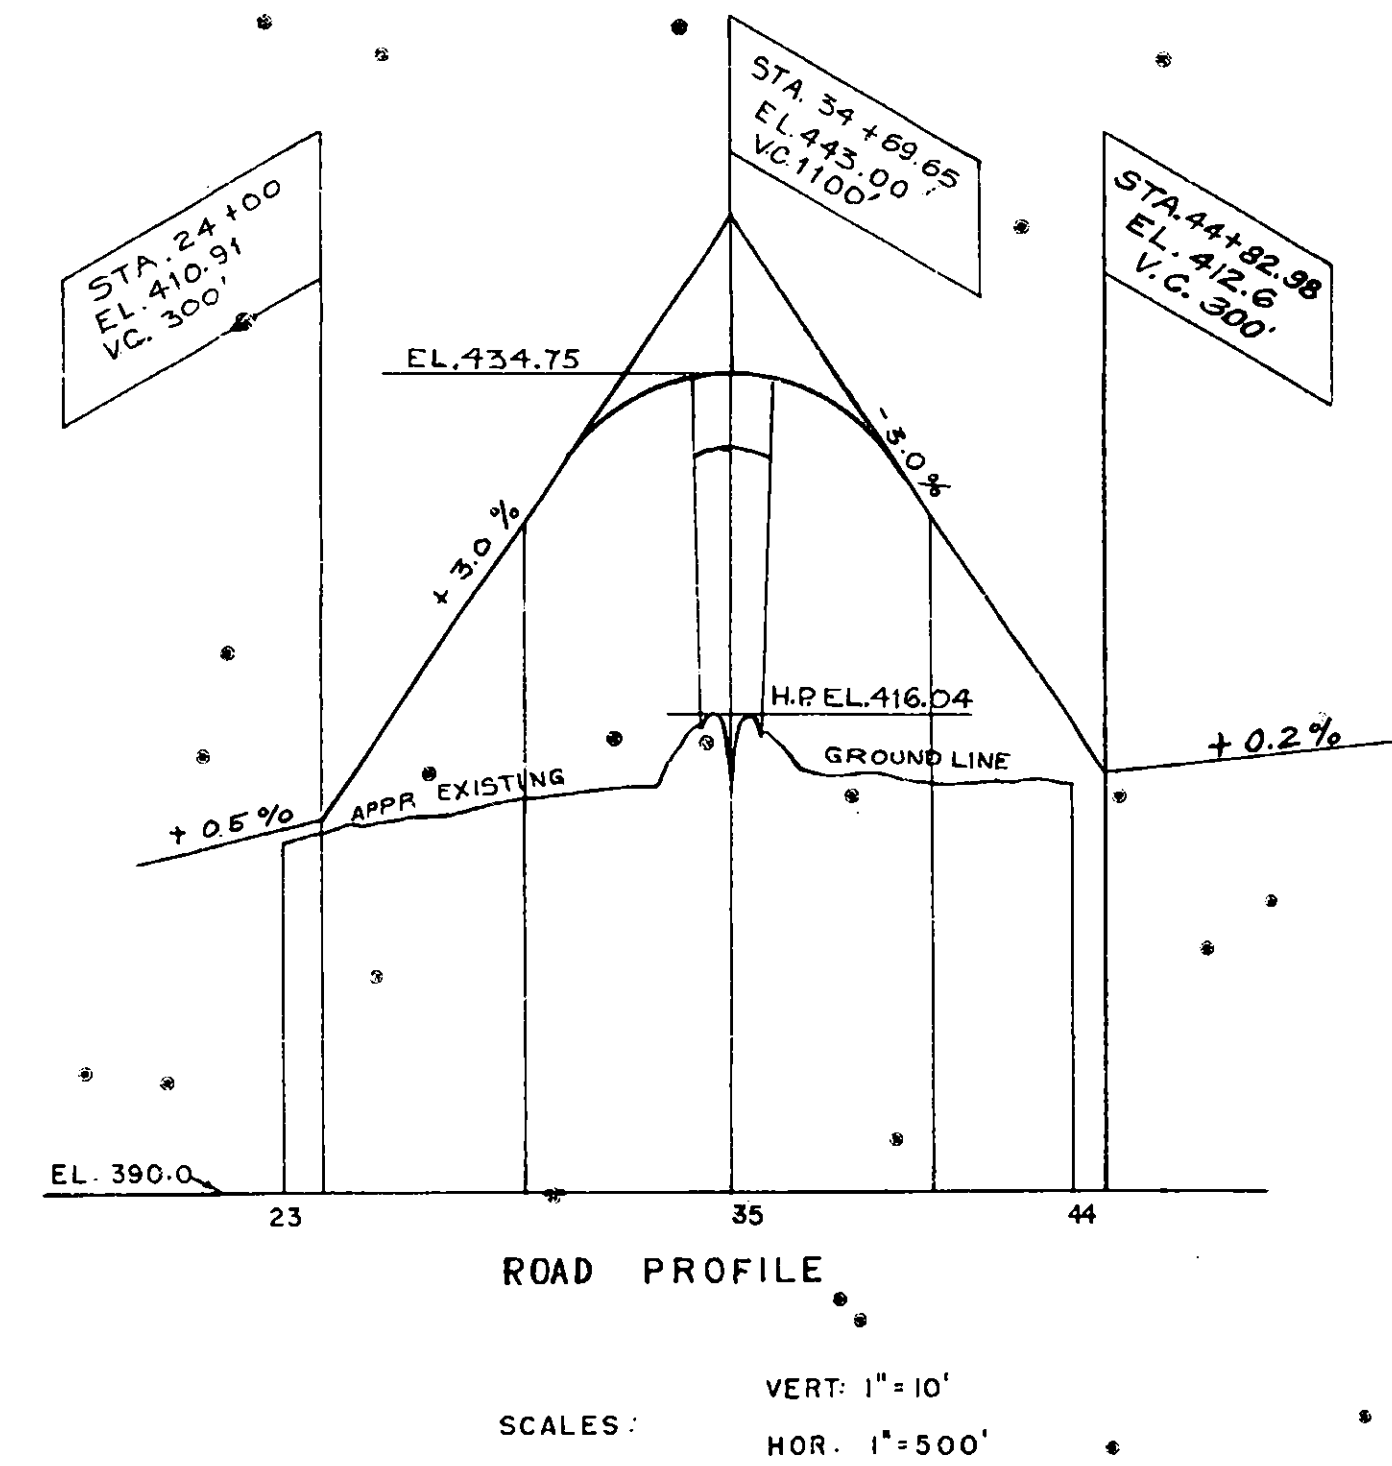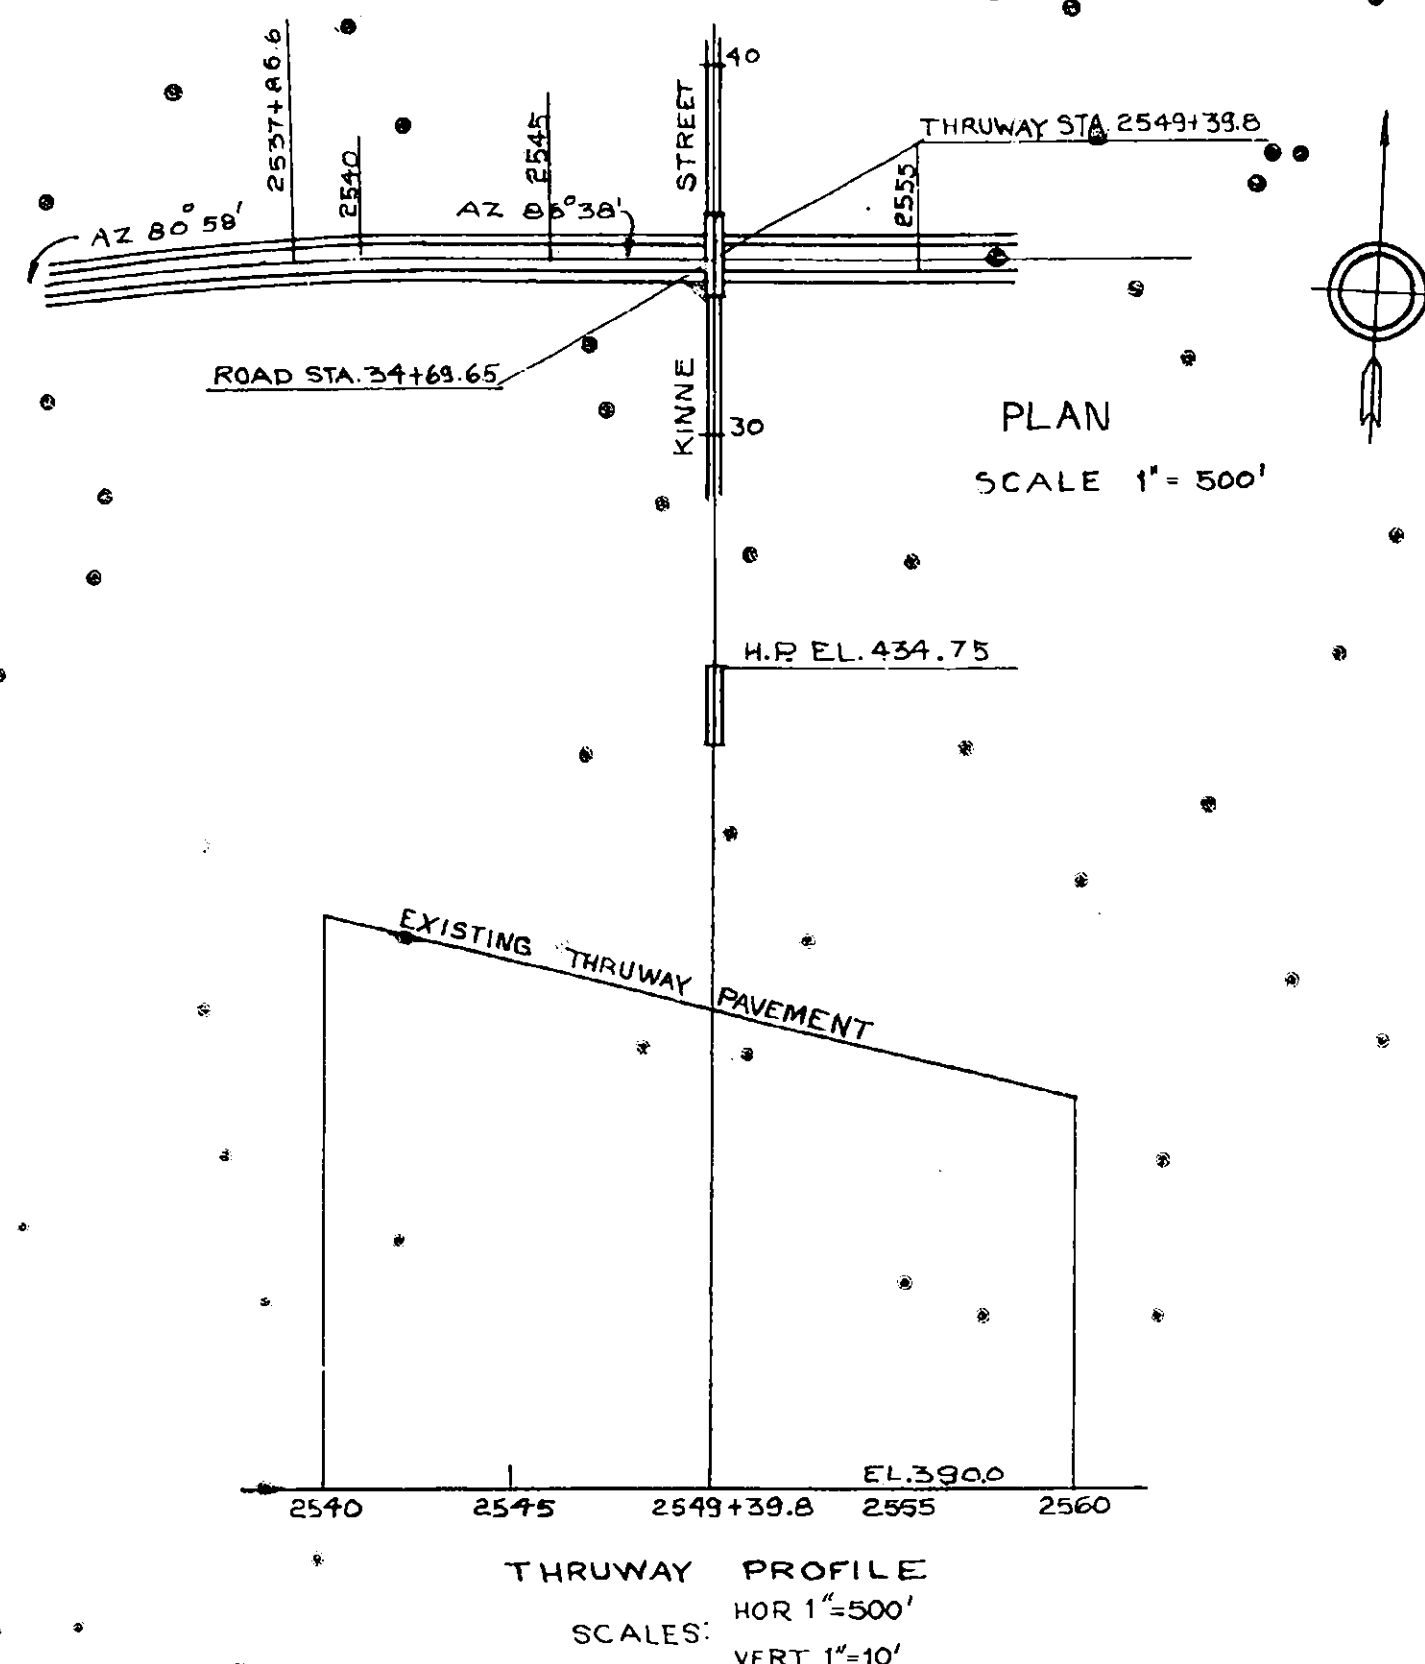

DEPARTMENT OF PUBLIC WORKS

RECOMMENDED: W. Robinson 7/6/53
WM. ROBINSON
DISTRICT ENGINEER DATE

APPROVED: E.T. GAWKINS 7/6/53
E.T. GAWKINS
DEPUTY CHIEF ENGINEER DATE

E.W. WENDELL
DEPUTY CHIEF ENGINEER DATE


J.B. McMorran 7/6/53
J.B. MCMORRAN
CHIEF ENGINEER DATE

APPROVED: February 16 1953
NEW YORK STATE THRUWAY AUTHORITY

B. D. TALLAMY, CHAIRMAN



BY: C.H. LANG
DEPUTY CHIEF ENGINEER

PRELIMINARY LAYOUT
KINNE STREET
MOHAWK SECTION
NEW YORK STATE THRUWAY

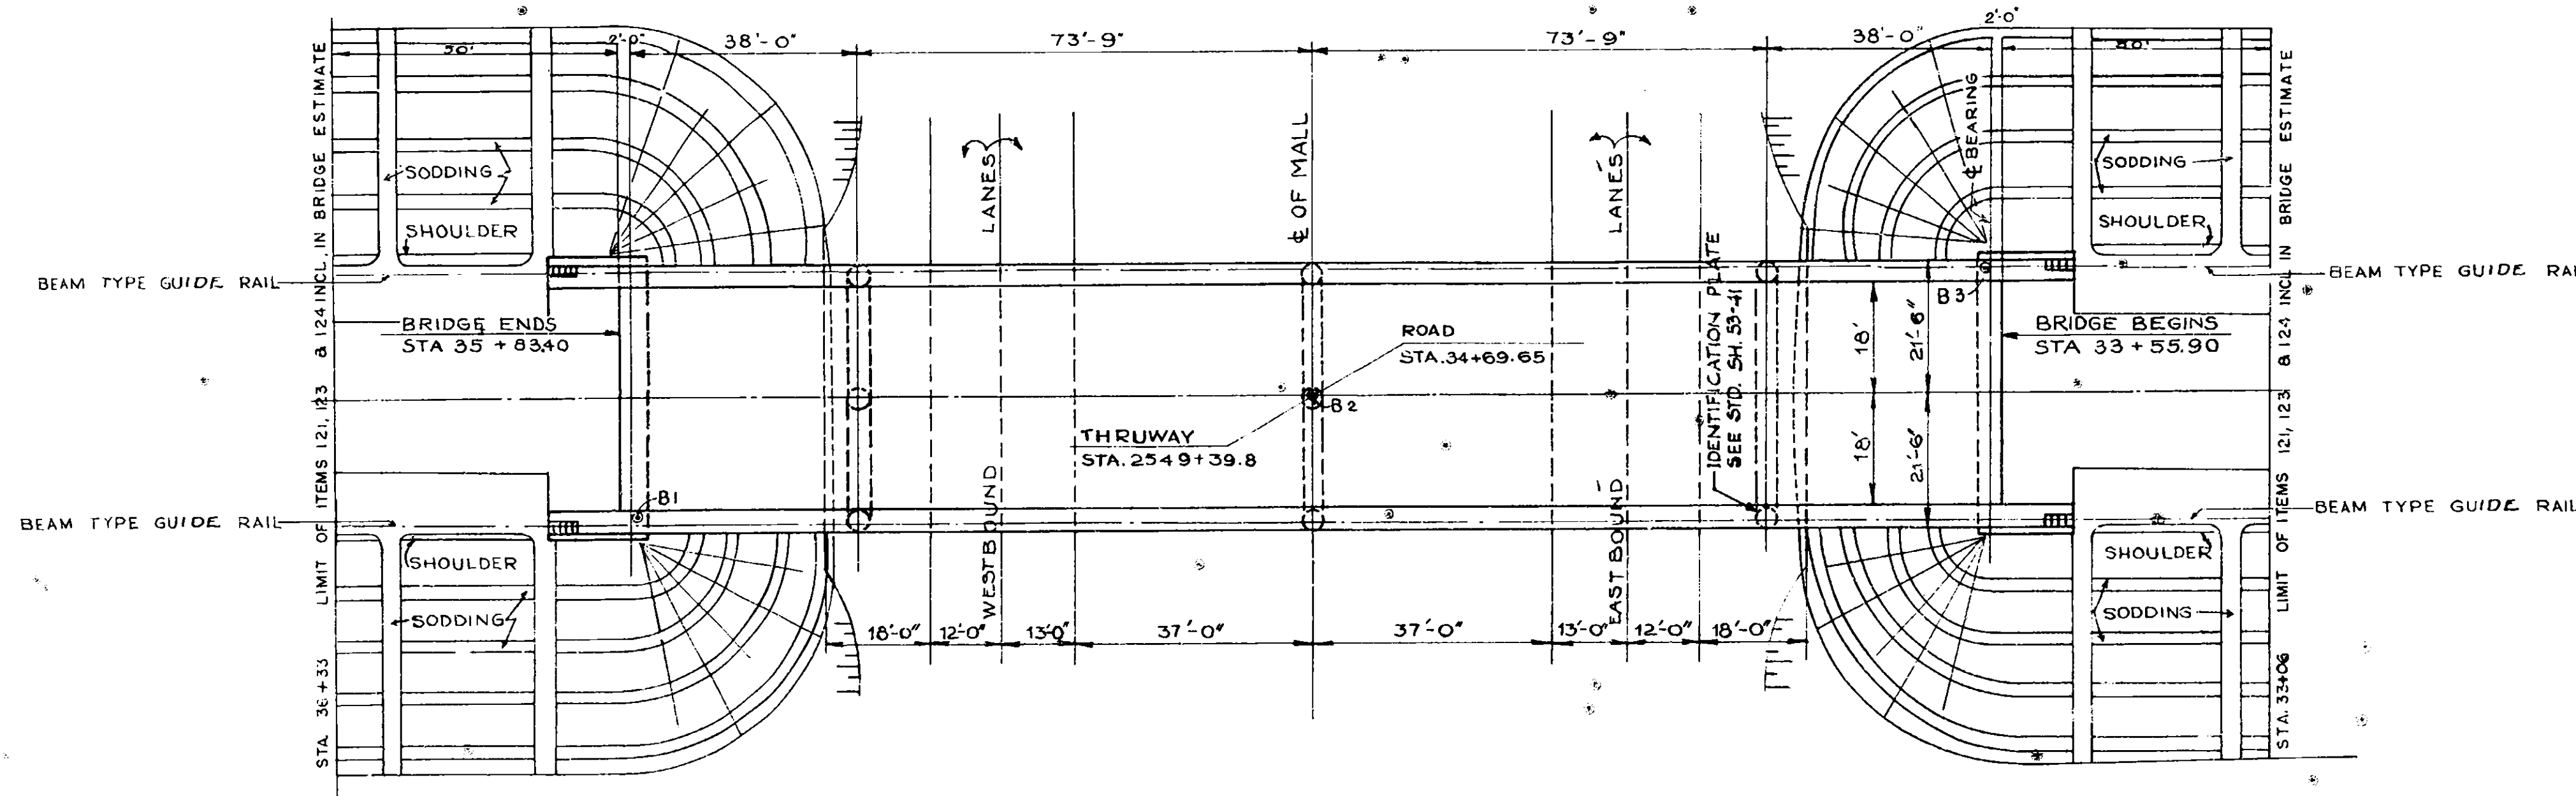

PREPARED AND RECOMMENDED
URQUHART & DOYLE CONSULTING ENGINEERS
NEW YORK STATE PROFESSIONAL ENGINEERS LICENSE NO. 5667
DATE 7/29/52

COUNTY	SHEET NO.	TOTAL SHEETS
ONONDAGA	56	66
N.Y. STATE THRUWAY, MOHAWK SECTION SUBDIV. B B		
INTERCHANGE AT THOMPSON ROAD		

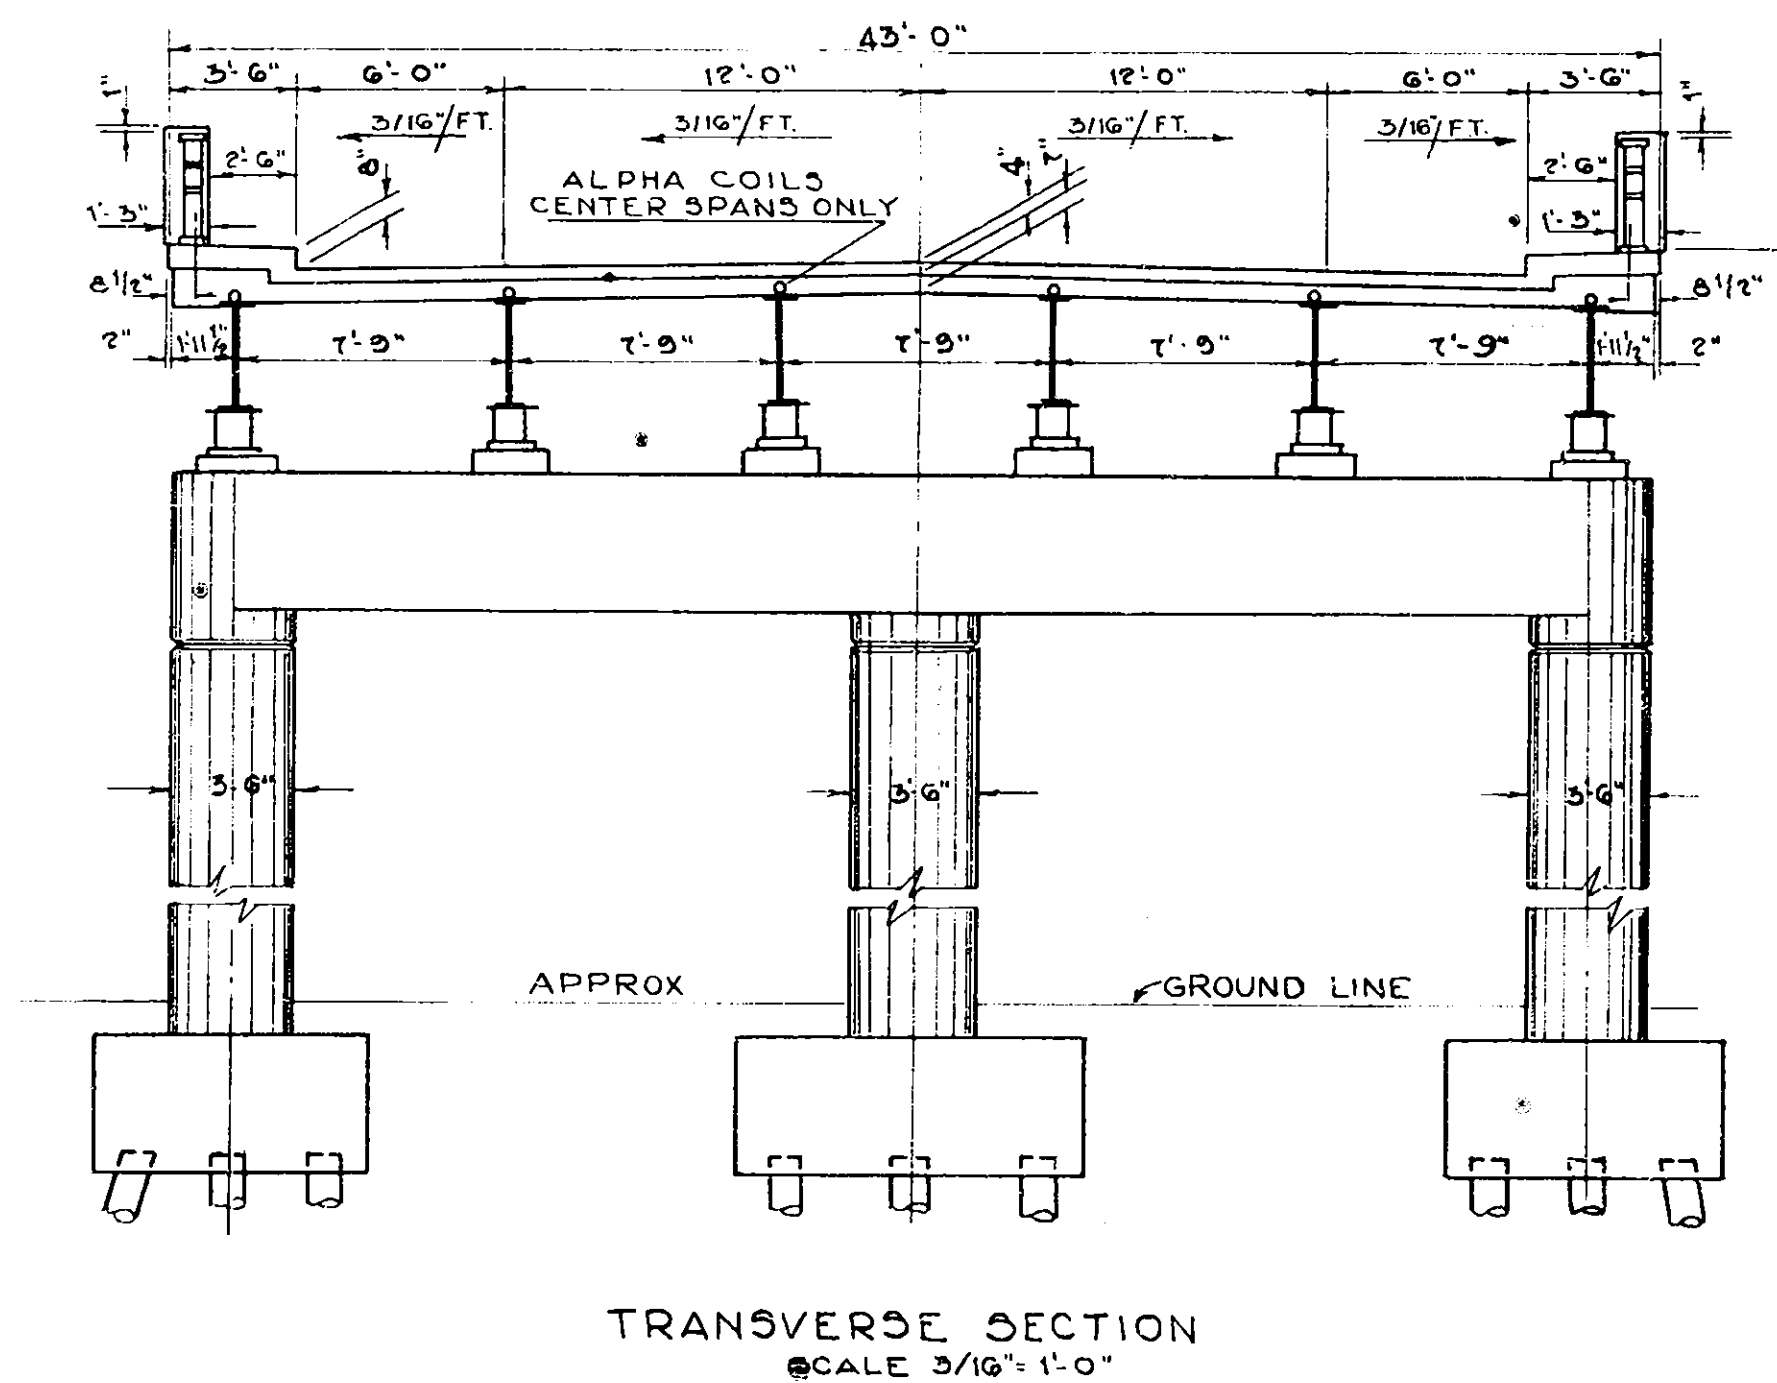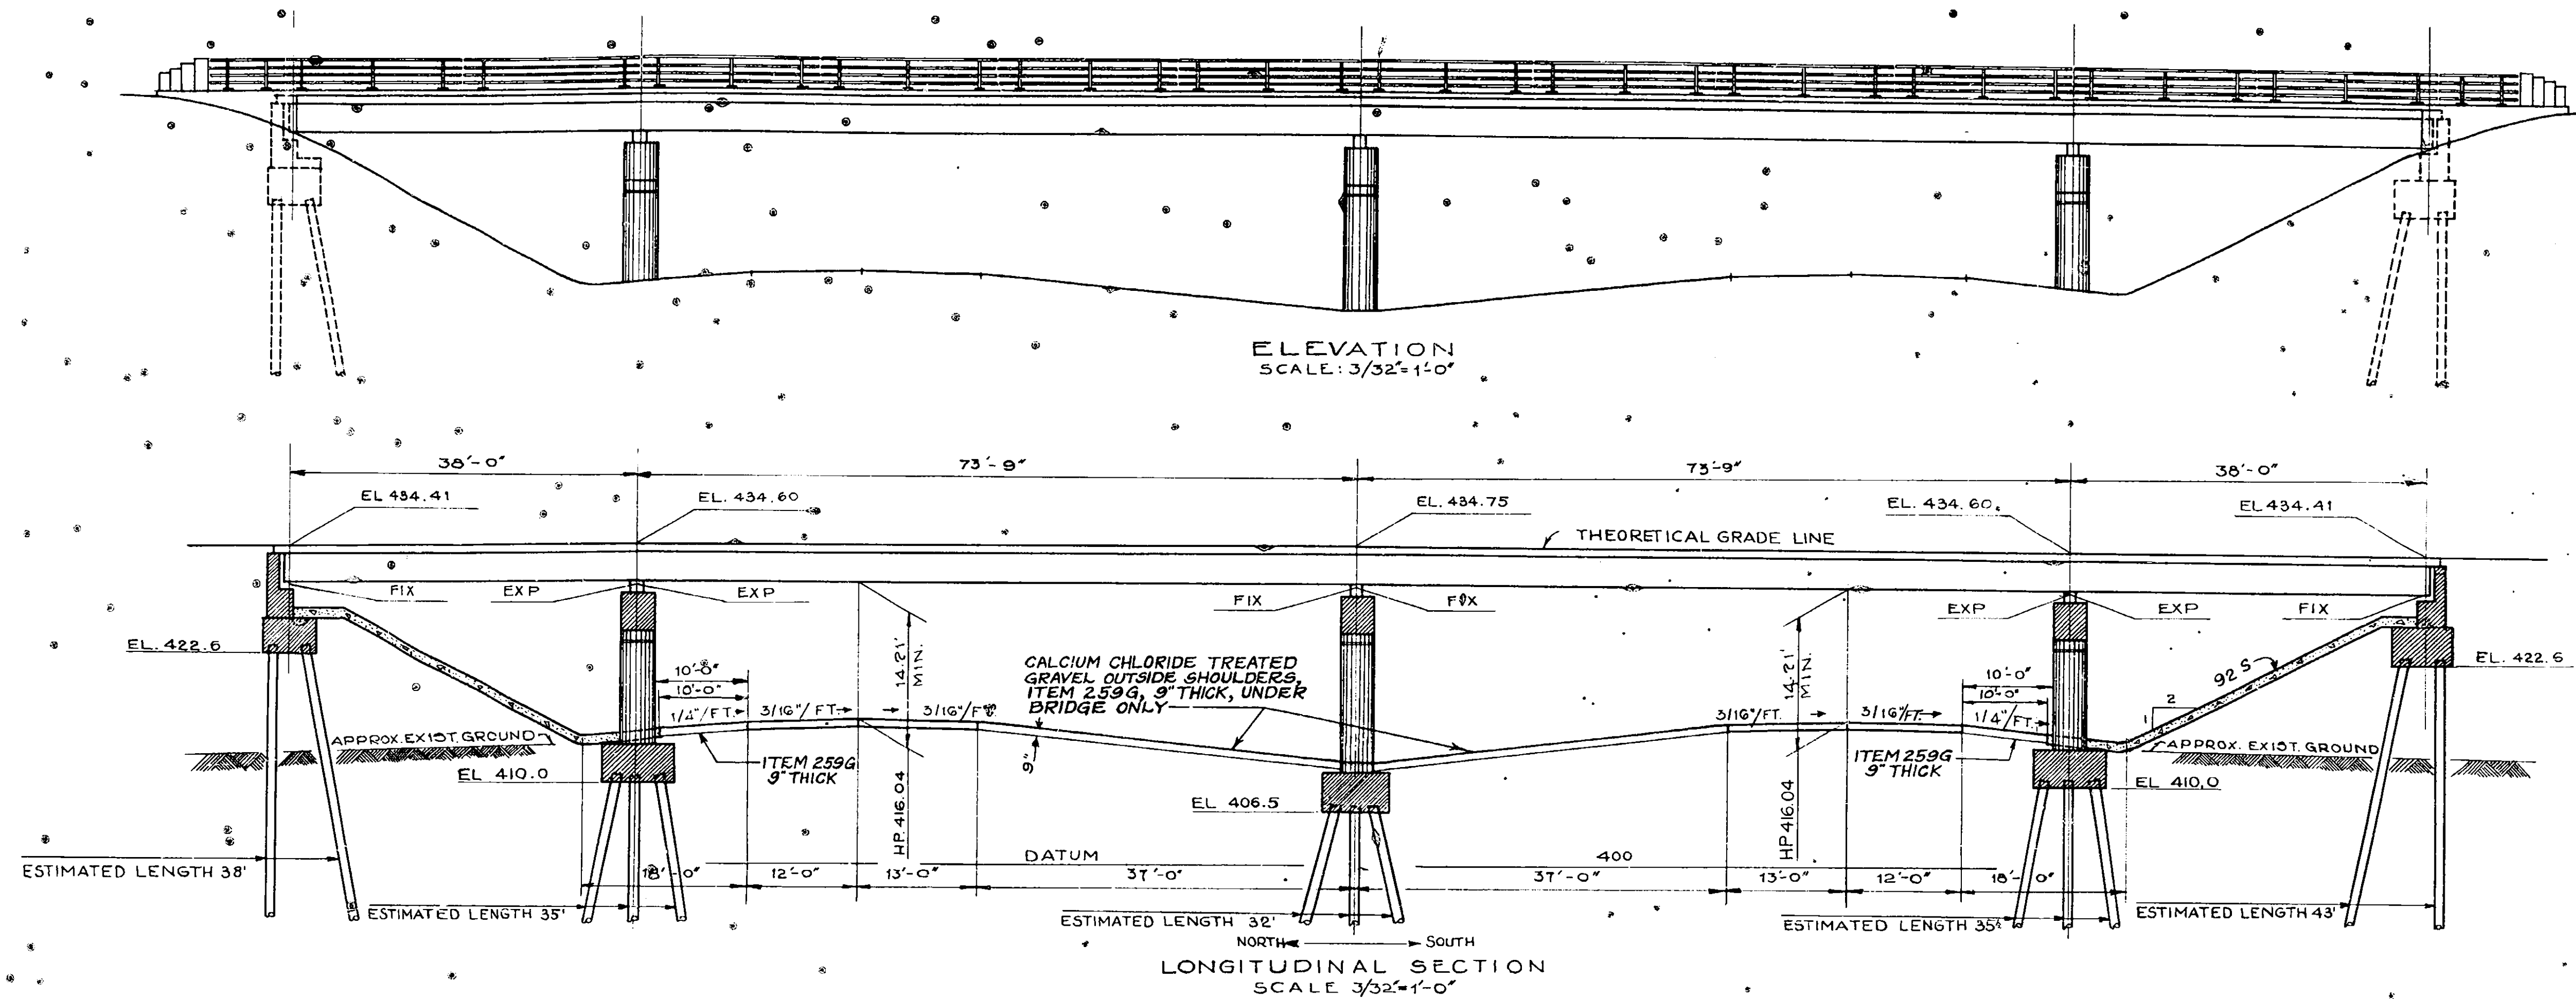

NOTE:


DESIGN SPECIFICATIONS A.A.S.H.O. 1949-H20-S16 LOADING MODIFIED MATERIAL AND FABRICATION SPECIFICATIONS N.Y.S. D.P.W. JAN. 2, 1951. SUPERSTRUCTURE W/ BEAMS, COMPOSITE CONSTRUCTION CENTER SPANS ONLY. FOUNDATION TREATMENT OF ABUTMENTS ON PILES: FOR DESIGN PURPOSES, THE ASSUMED LOAD PER PILE DOES NOT EXCEED 30 TONS. PIERS ON PILE FOUNDATIONS: FOR DESIGN PURPOSES, THE ASSUMED LOAD PER PILE DOES NOT EXCEED 30 TONS. TOP SOILING, SODDING AND SEEDING TO BE SHOWN ON BRIDGE CONTRACT PLANS, AND INCLUDED IN BRIDGE ESTIMATE FOR BOTH APPROACHES TO EXTENT NOTED IN PLAN.

PRELIMINARY LAYOUT
KINNE STREET
MOHAWK SECTION
NEW YORK STATE THRUWAY

PREPARED AND RECOMMENDED


URQUHART & DOYLE CONSULTING ENGINEERS
NEW YORK STATE PROFESSIONAL ENGINEERS LICENSE NO. 5667

DATE

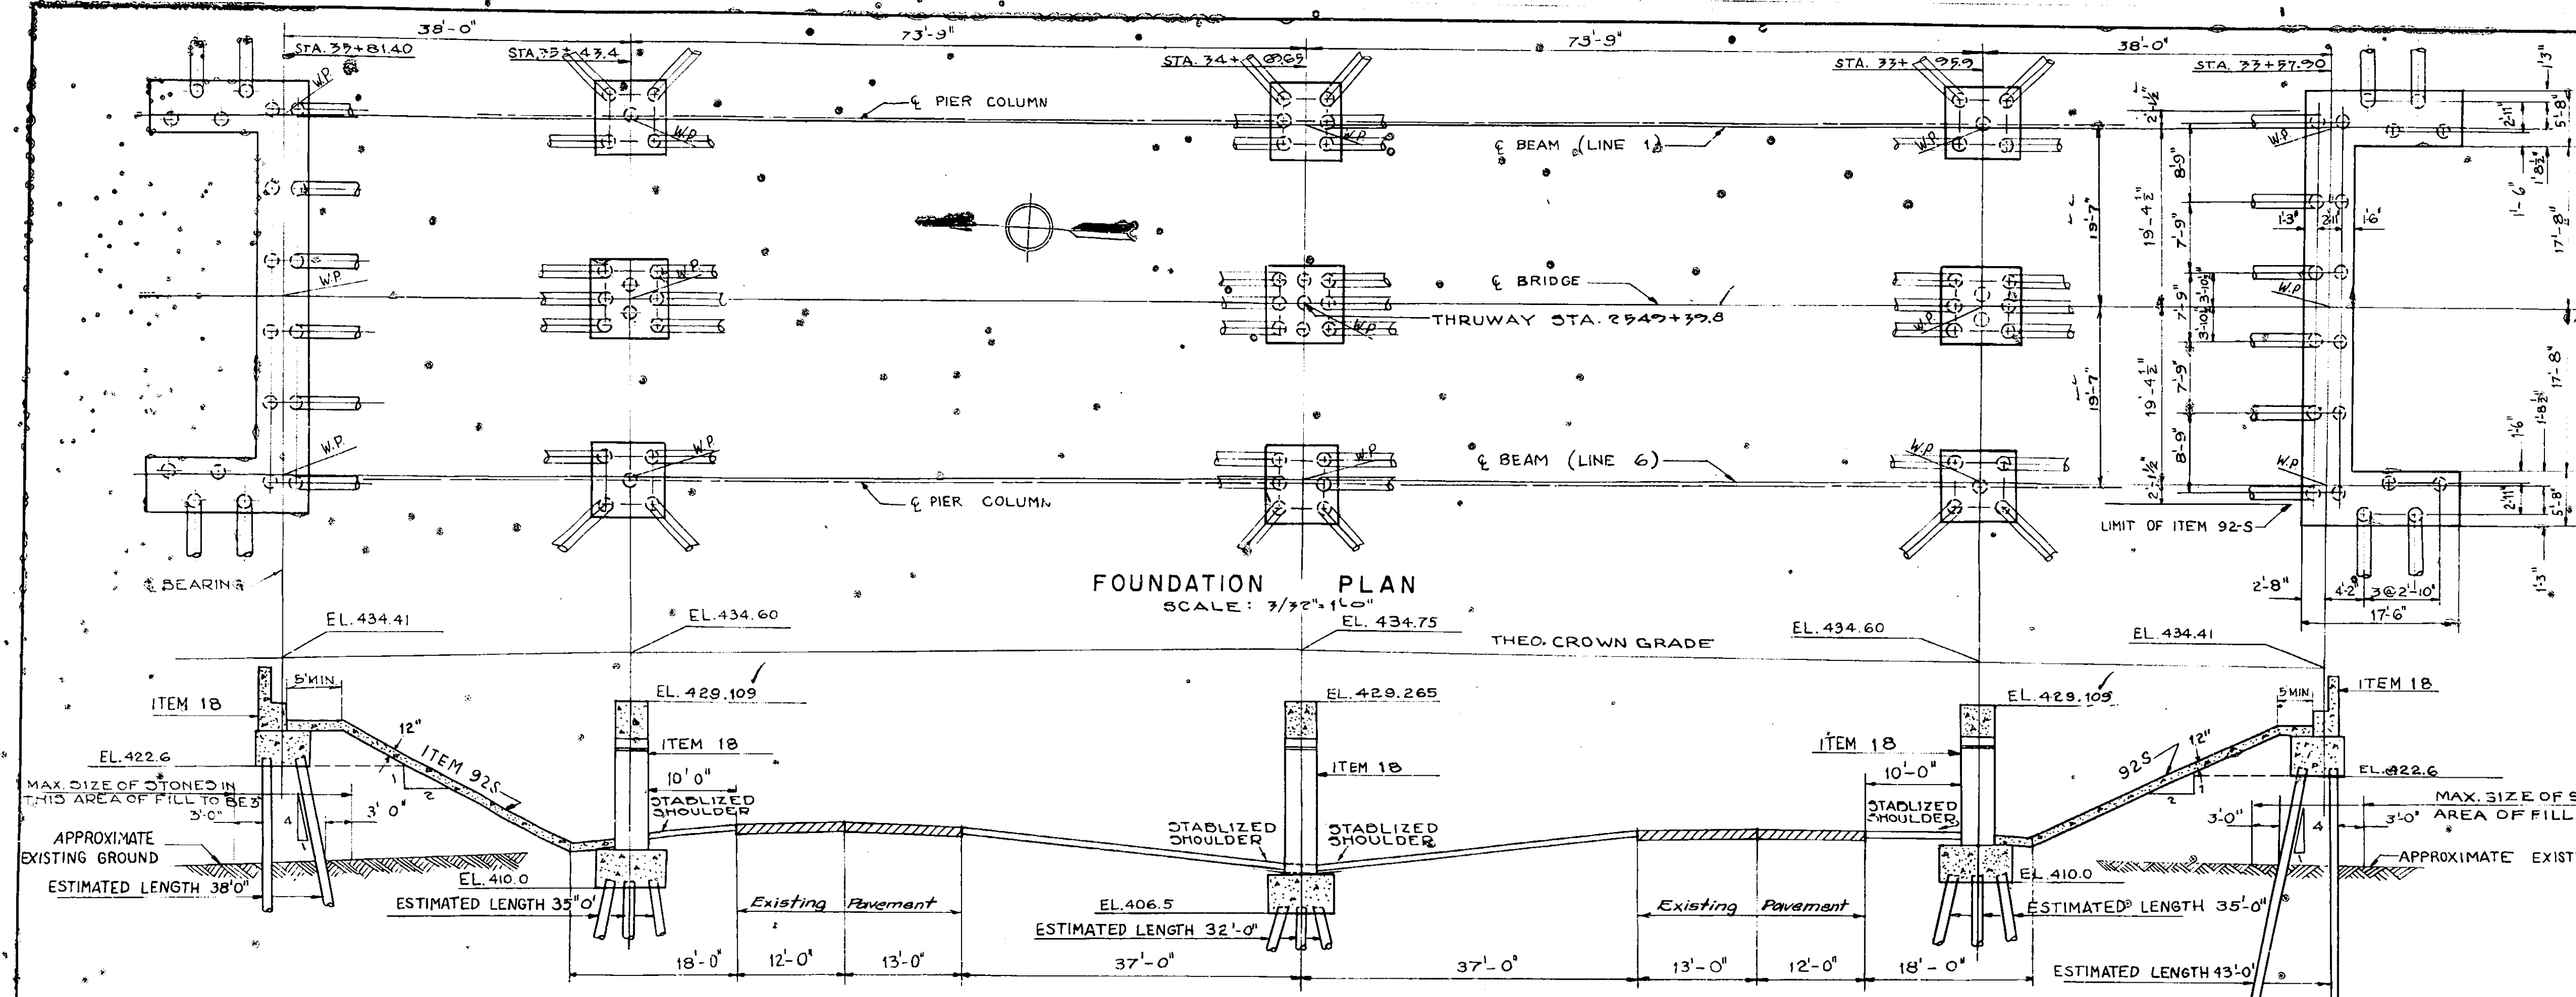

FOUNDATION PLAN

SCALE: 3/32" = 1'-0"

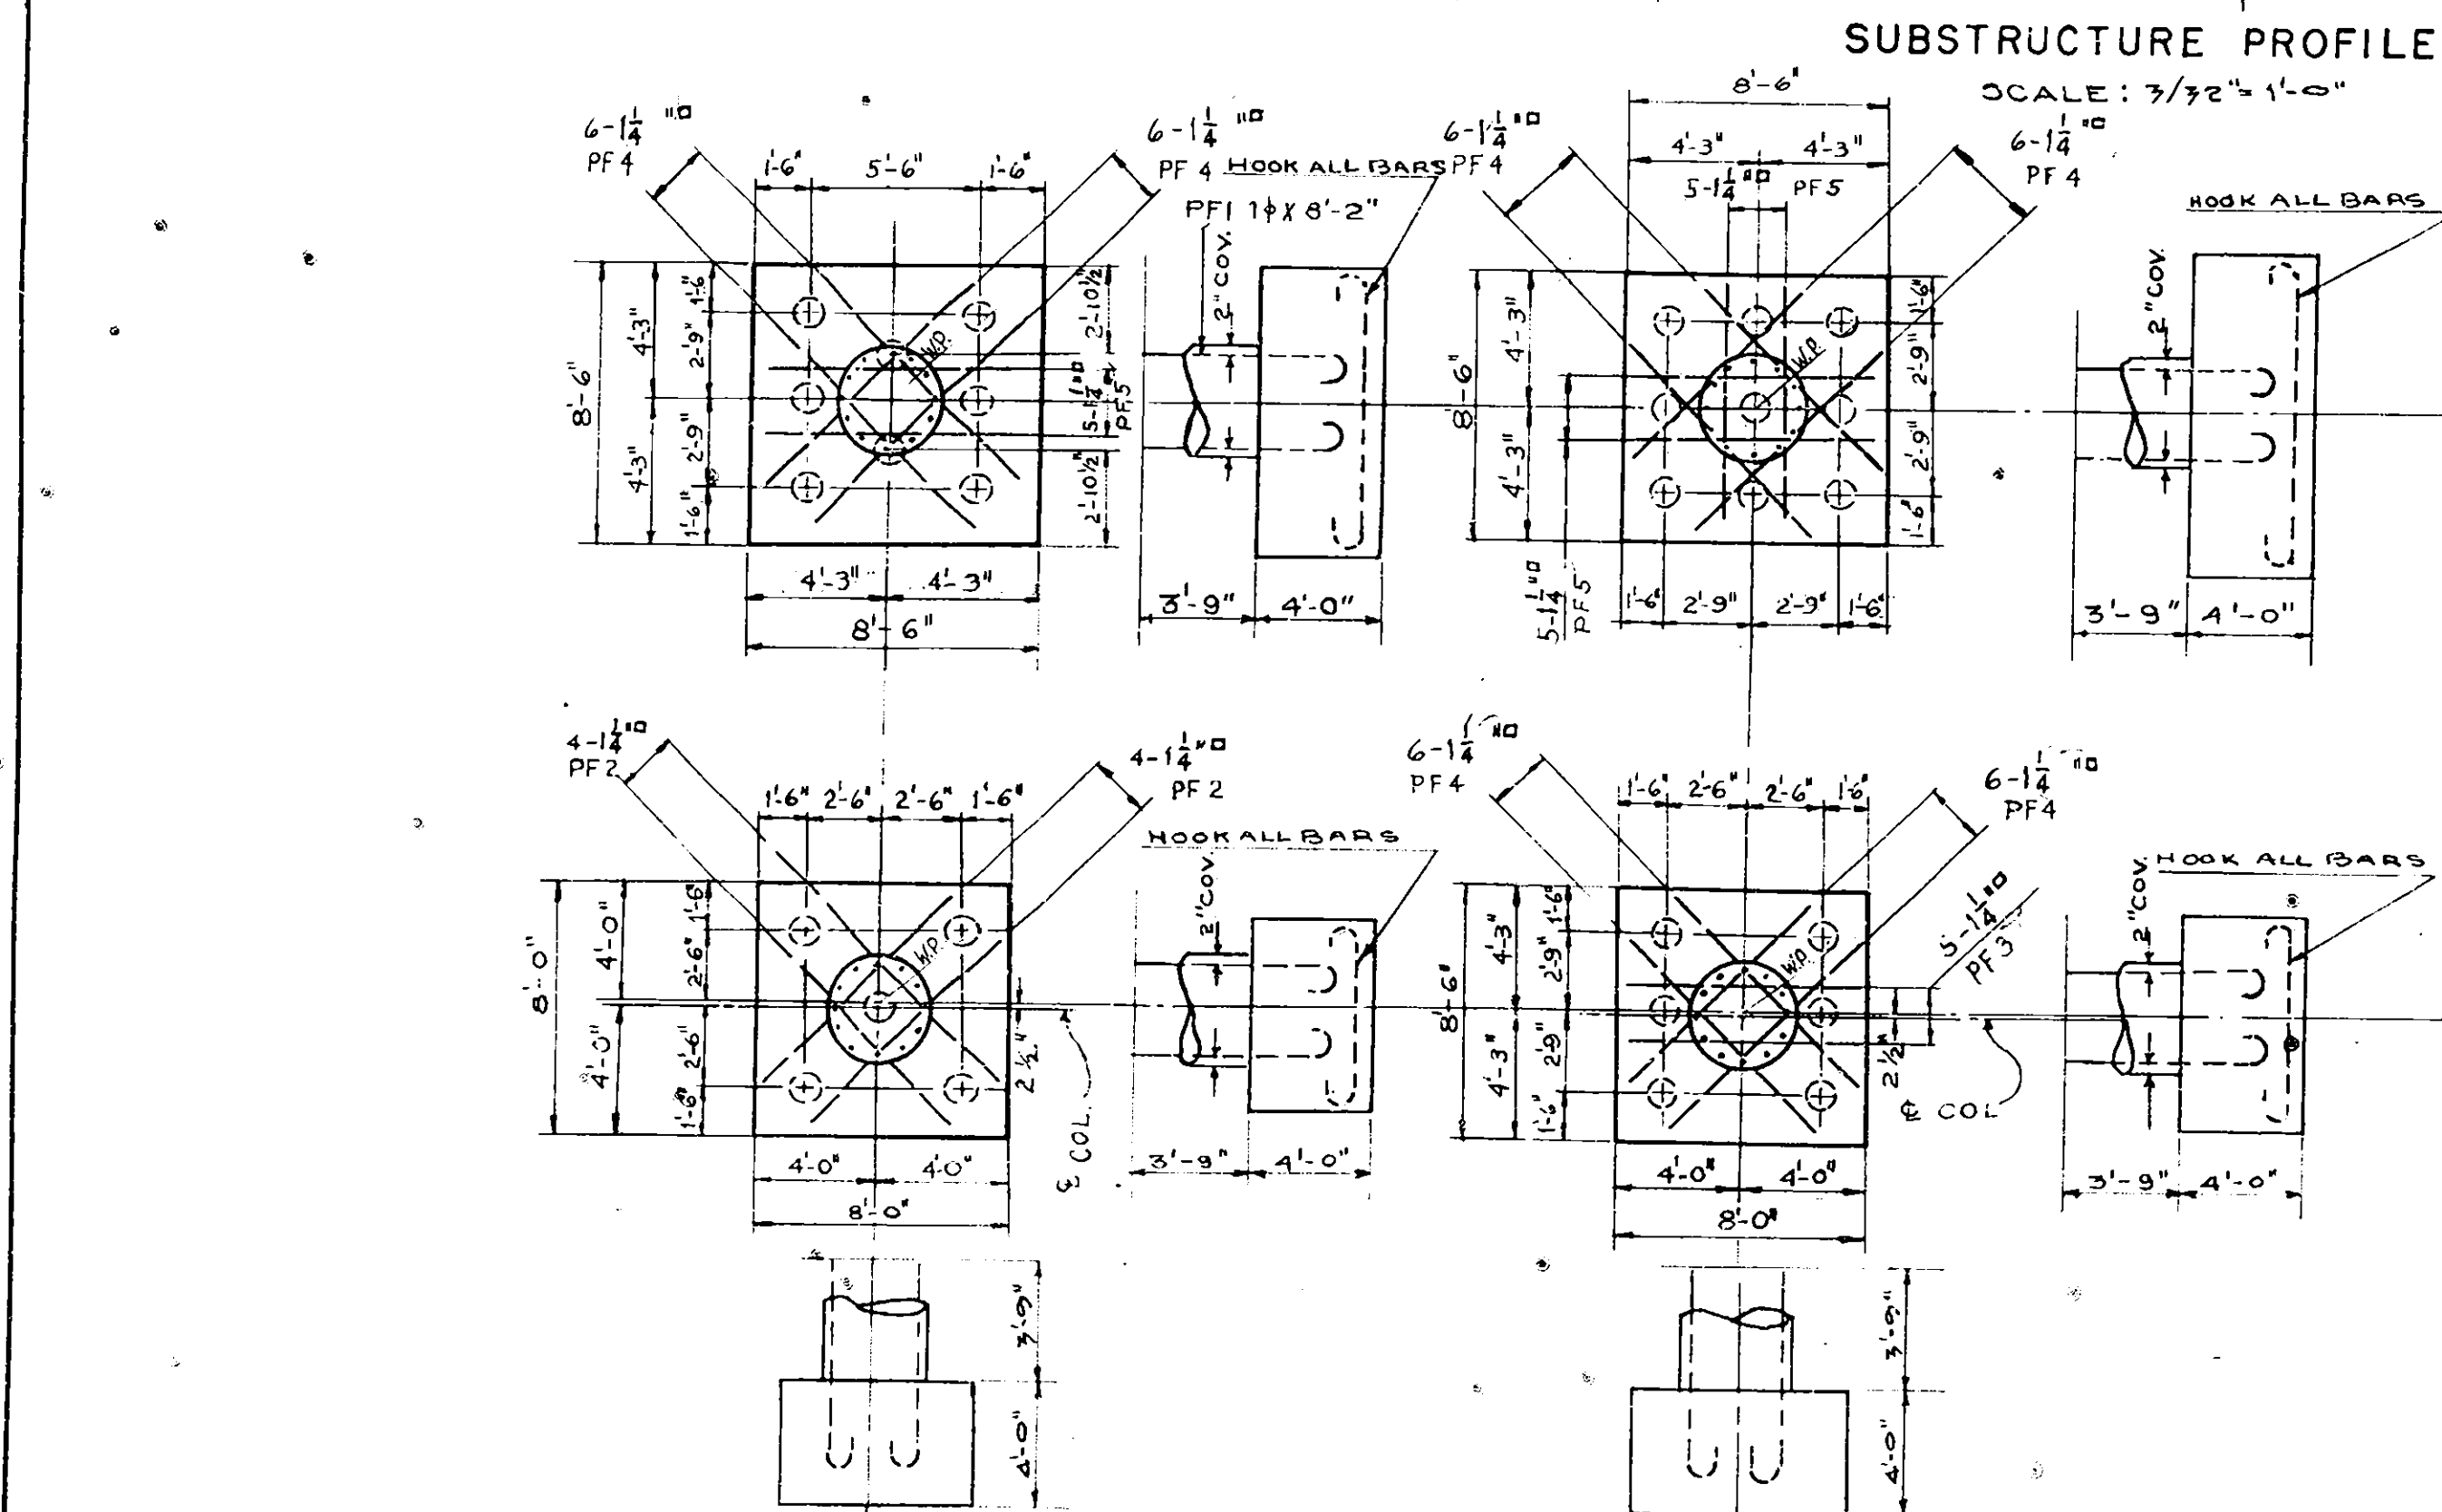

SUBSTRUCTURE PROFILE


SCALE: 3/32" = 1'-0"

NOTE:
SHEET NUMBERS IN THE LOWER RIGHT-HAND
CORNER OF THE SHEETS ARE TO BE USED FOR
CROSS REFERENCE OF THE STRUCTURAL DETAILS

NOTE:
FOR DESIGN PURPOSES, MAX PILE
LOADING DOES NOT EXCEED
30 TONS PER PILE.

ALL CONCRETE IN FOOTINGS ITEM 18
ALL REINFORCING BARS, ITEM 28

APPROVED METAL SPACERS SHALL BE
ATTACHED TO THE TOP AND BOTTOM HOOPS
TO INSURE THAT THE MINIMUM REQUIRED
CLEAR DISTANCE TO THE SHELL WILL
BE OBTAINED

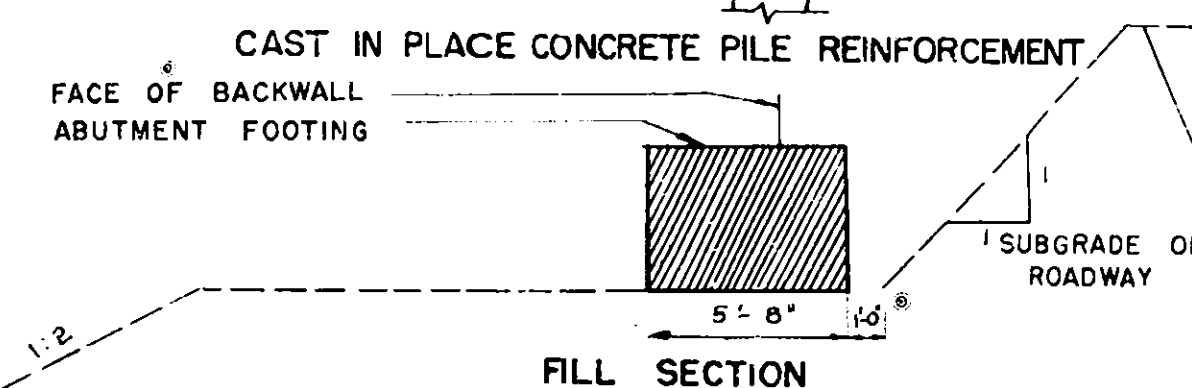

FILL SECTION

NOTE:
PLACING OF PILES AND CONSTRUCTION
OF THE ABUTMENTS WILL NOT BE PERMITTED
UNTIL THE HIGHWAY EMBANKMENT ADJACENT
TO THE STRUCTURE HAS BEEN PLACED AND
CONSOLIDATED IN A MANNER AND FOR A
PERIOD OF TIME SATISFACTORY TO THE
DEPUTY CHIEF ENGINEER (BRIDGES).

CROSS REFERENCE

FOR DETAILS OF ABUTMENTS SEE SHEET 58
FOR DETAILS OF PIERS SEE SHEET 59
FOR DETAILS OF BARS SEE SHEET 65
FOR DETAILS OF ANCHOR BOLTS SEE SHEET 63

NOTE: CROSS REFERENCE SHEET NUMBERS ARE THOSE SHOWN IN
THE LOWER RIGHT HAND CORNER OF THE SHEETS.

SUBSTRUCTURE DETAILS

KINNE STREET
MOHAWK SECTION
NEW YORK STATE THRUWAY

ABUTMENT FOUNDATION
SCALE 3/16" = 1'-0"










SECTION A

PREPARED AND RECOMMENDED

URQUHART & DOYLE CONSULTING ENGINEERS
NEW YORK STATE PROFESSIONAL ENGINEERS LICENSE NO 5667

DATE

COUNTY	SHEET NO.	TOTAL SHEETS
ONONDAGA	58	66
N.Y. STATE THRUWAY, MOHAWK SECTION SUBDIV. B.B.		
INTERCHANGE AT THOMPSON ROAD		

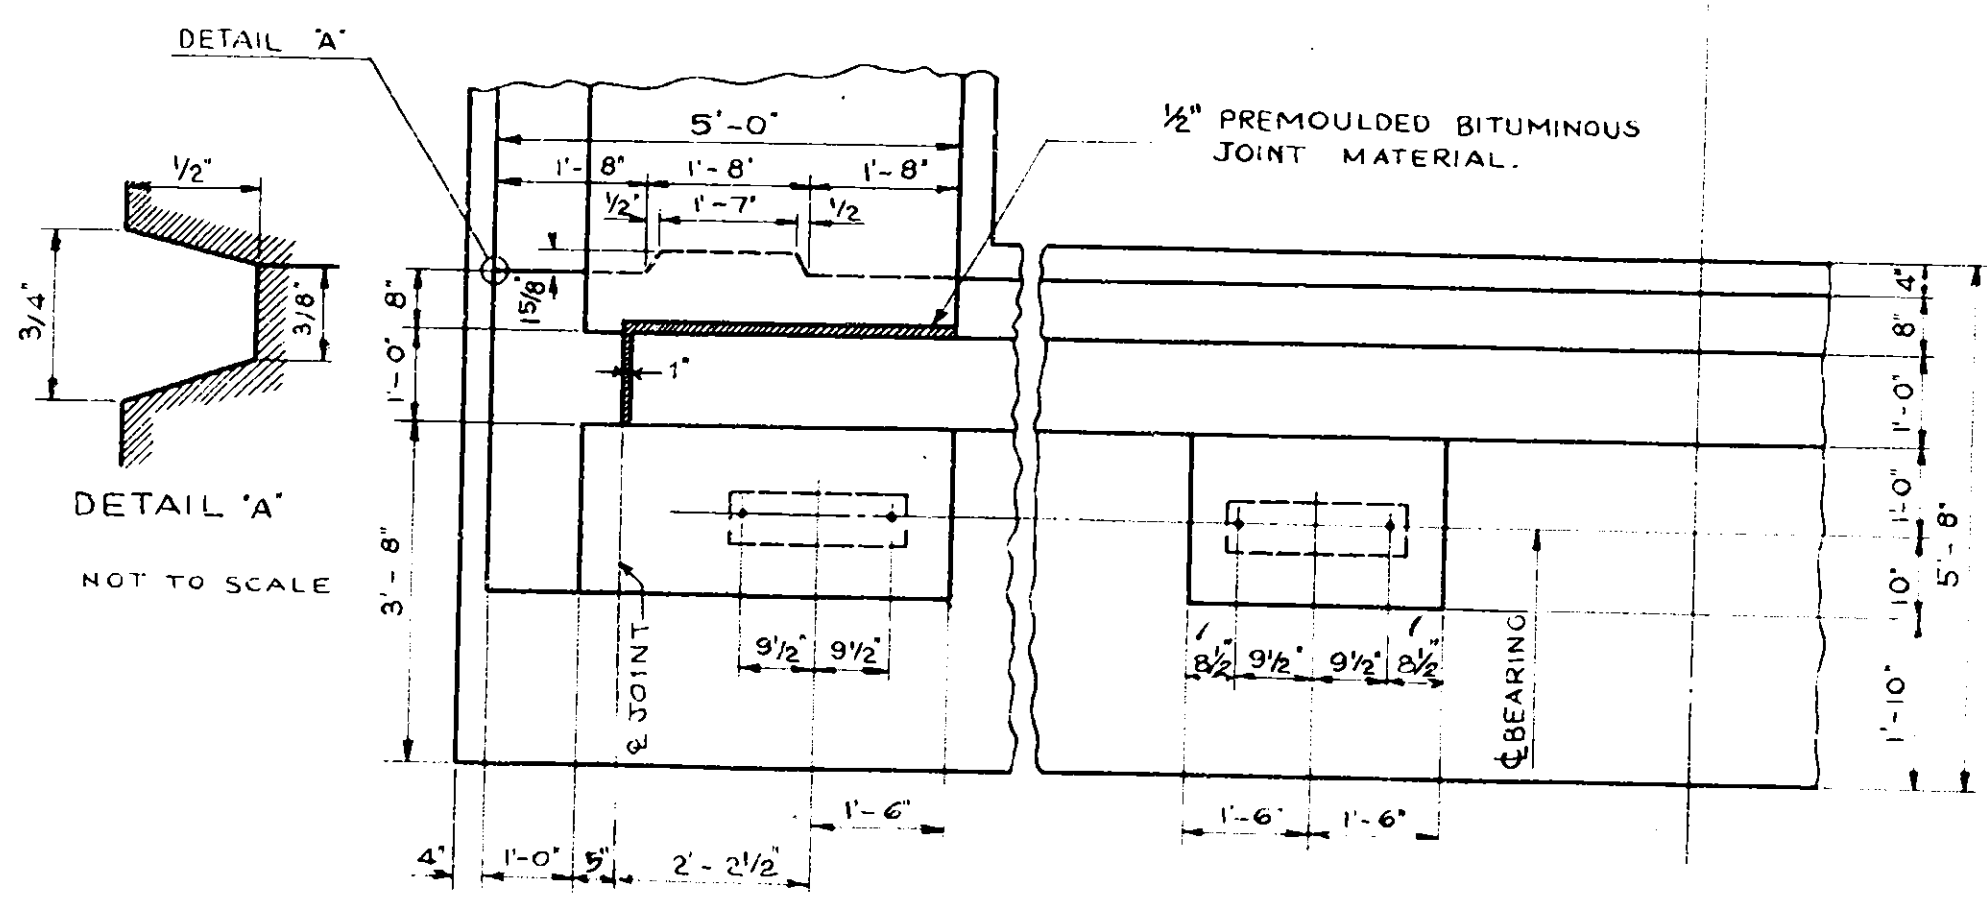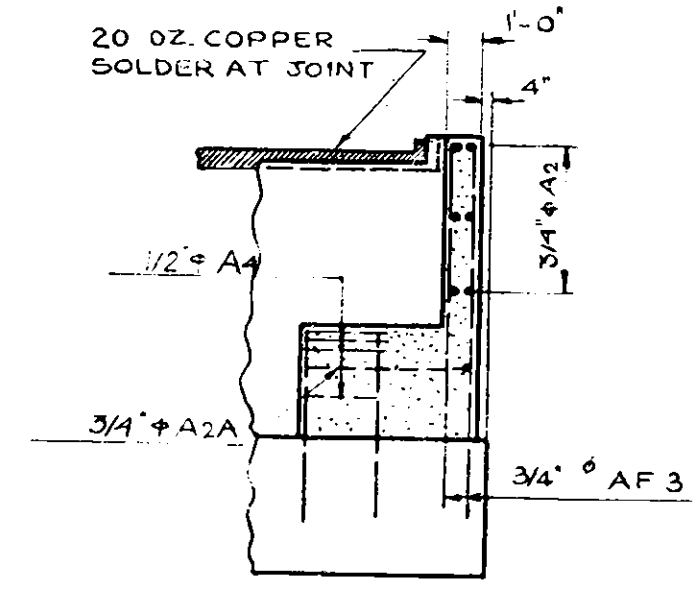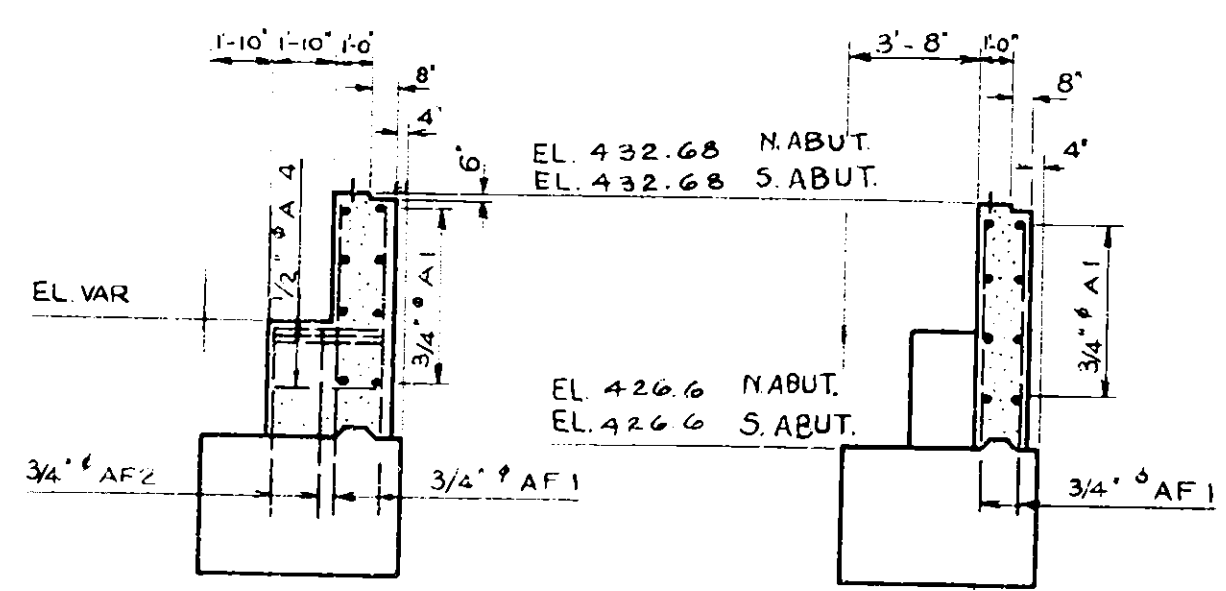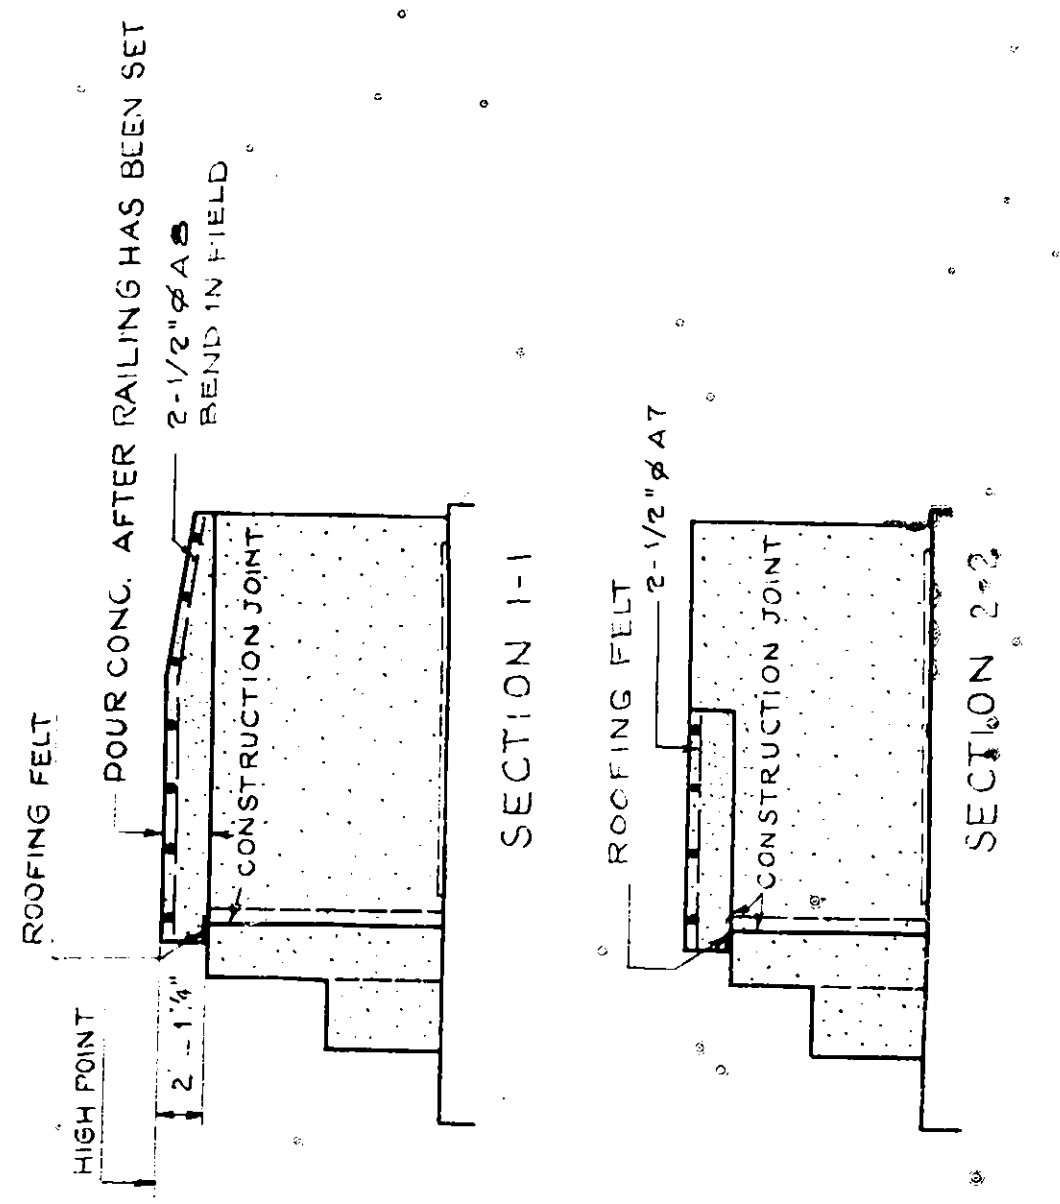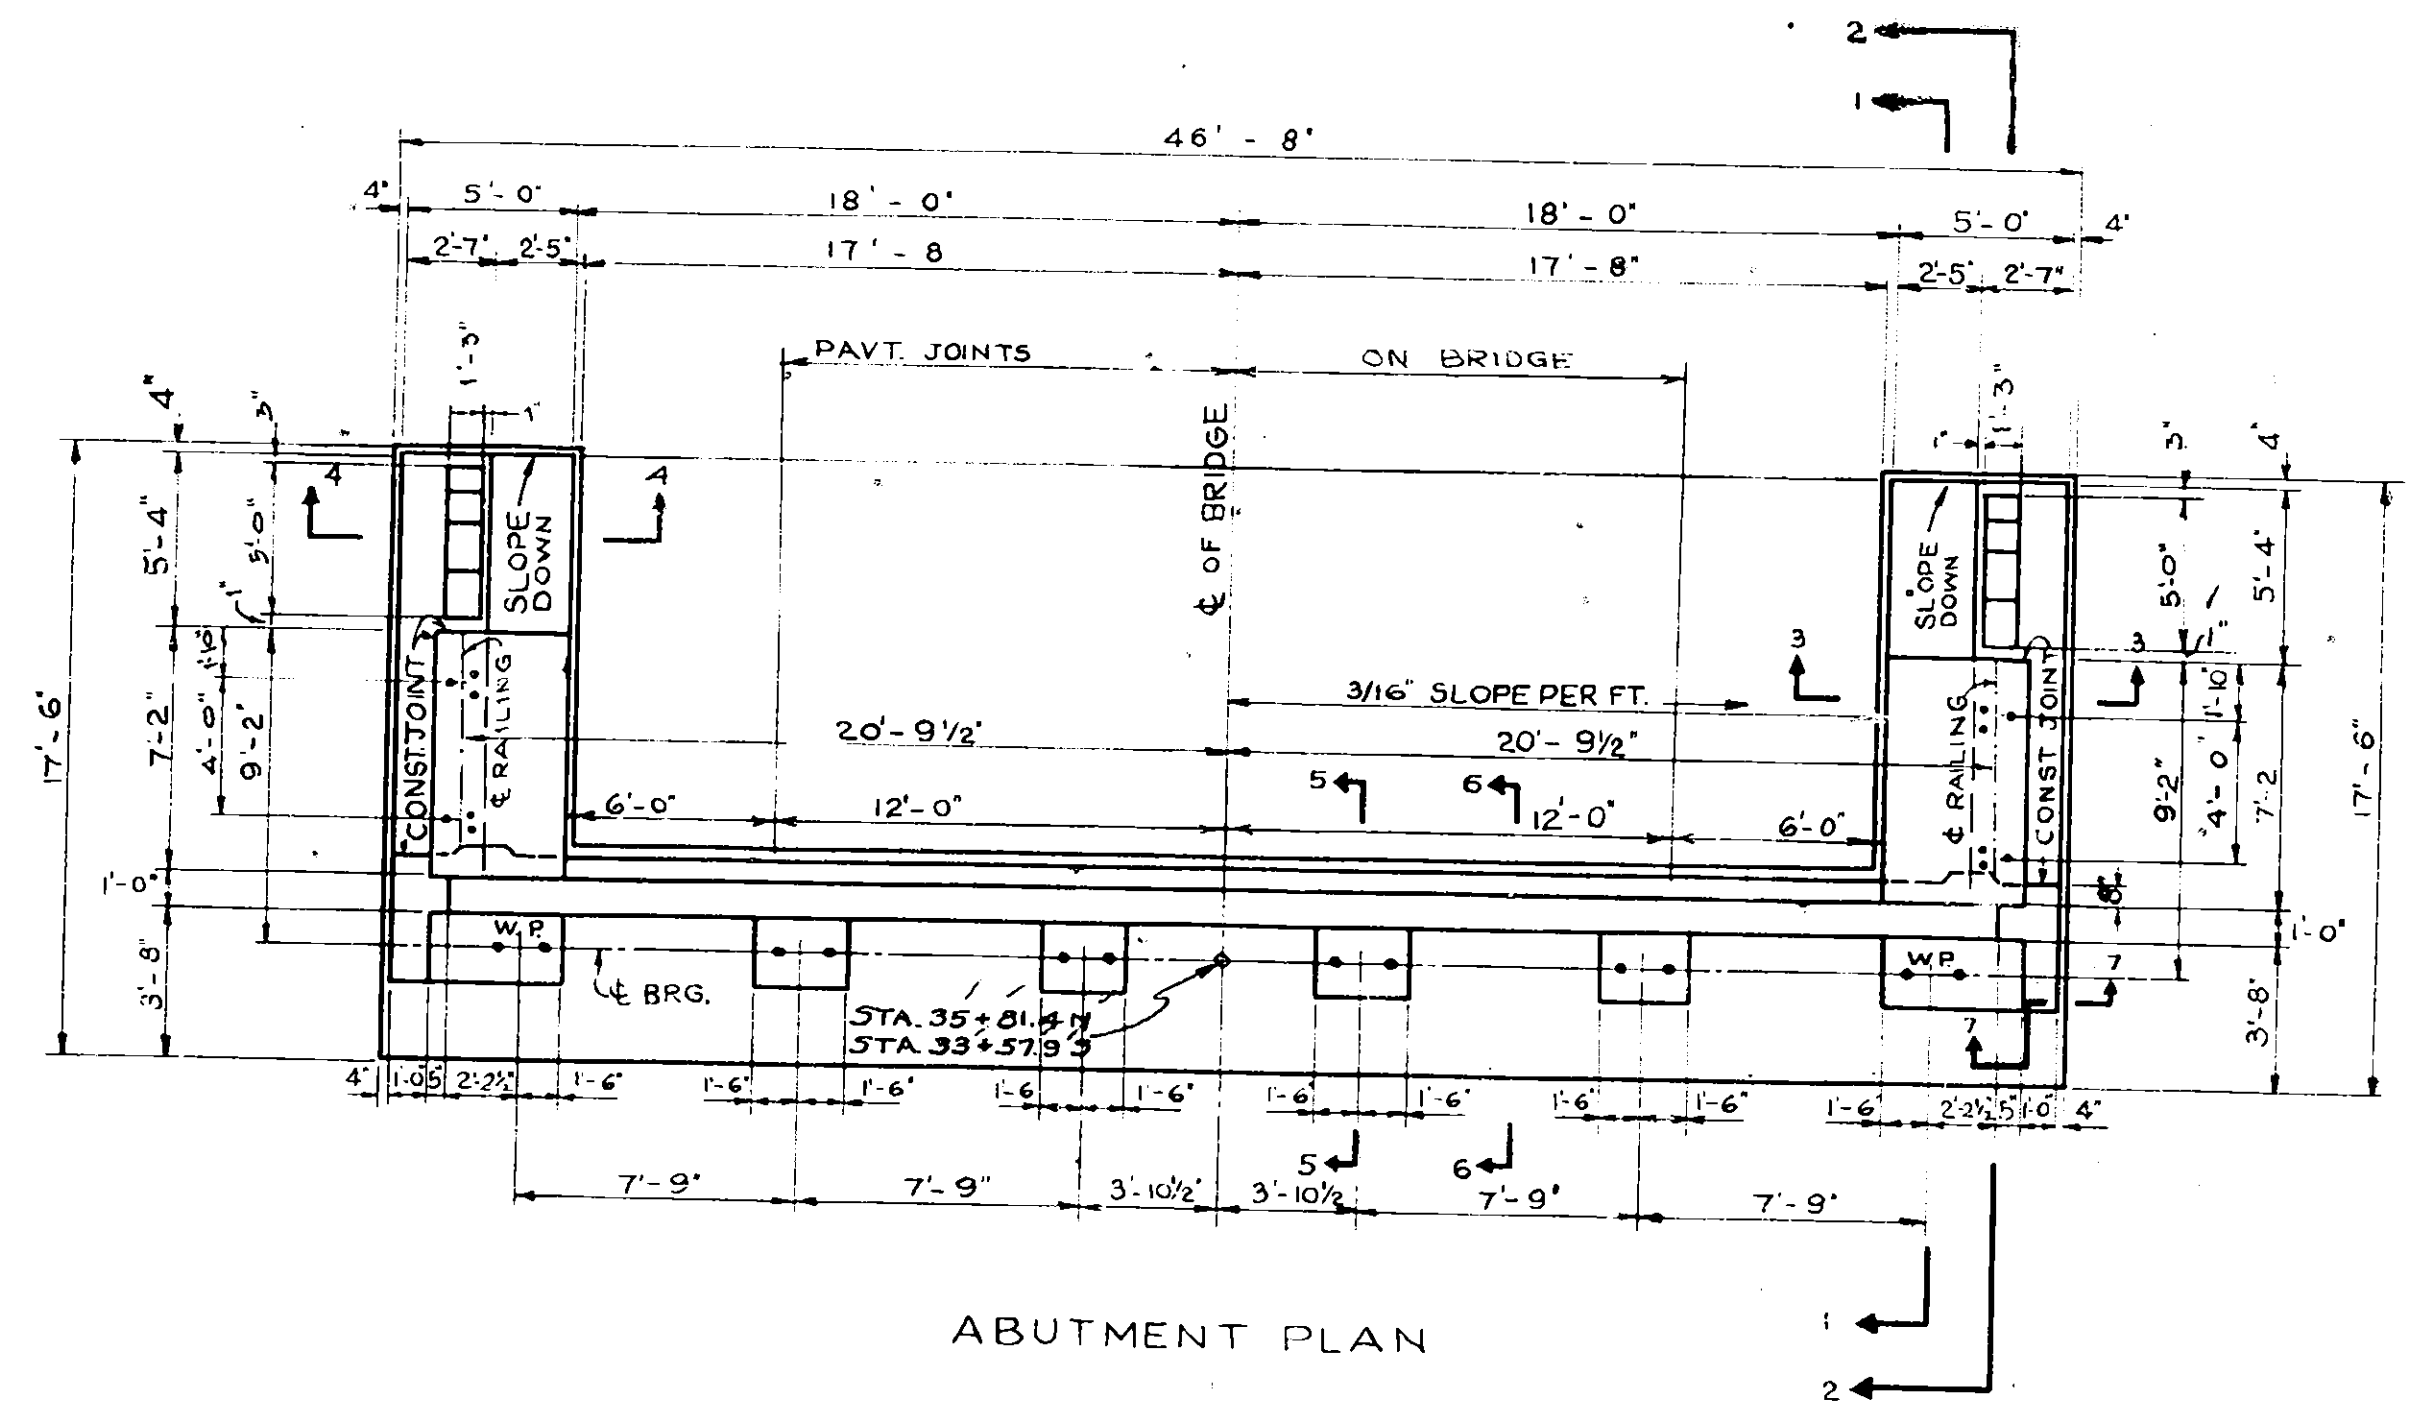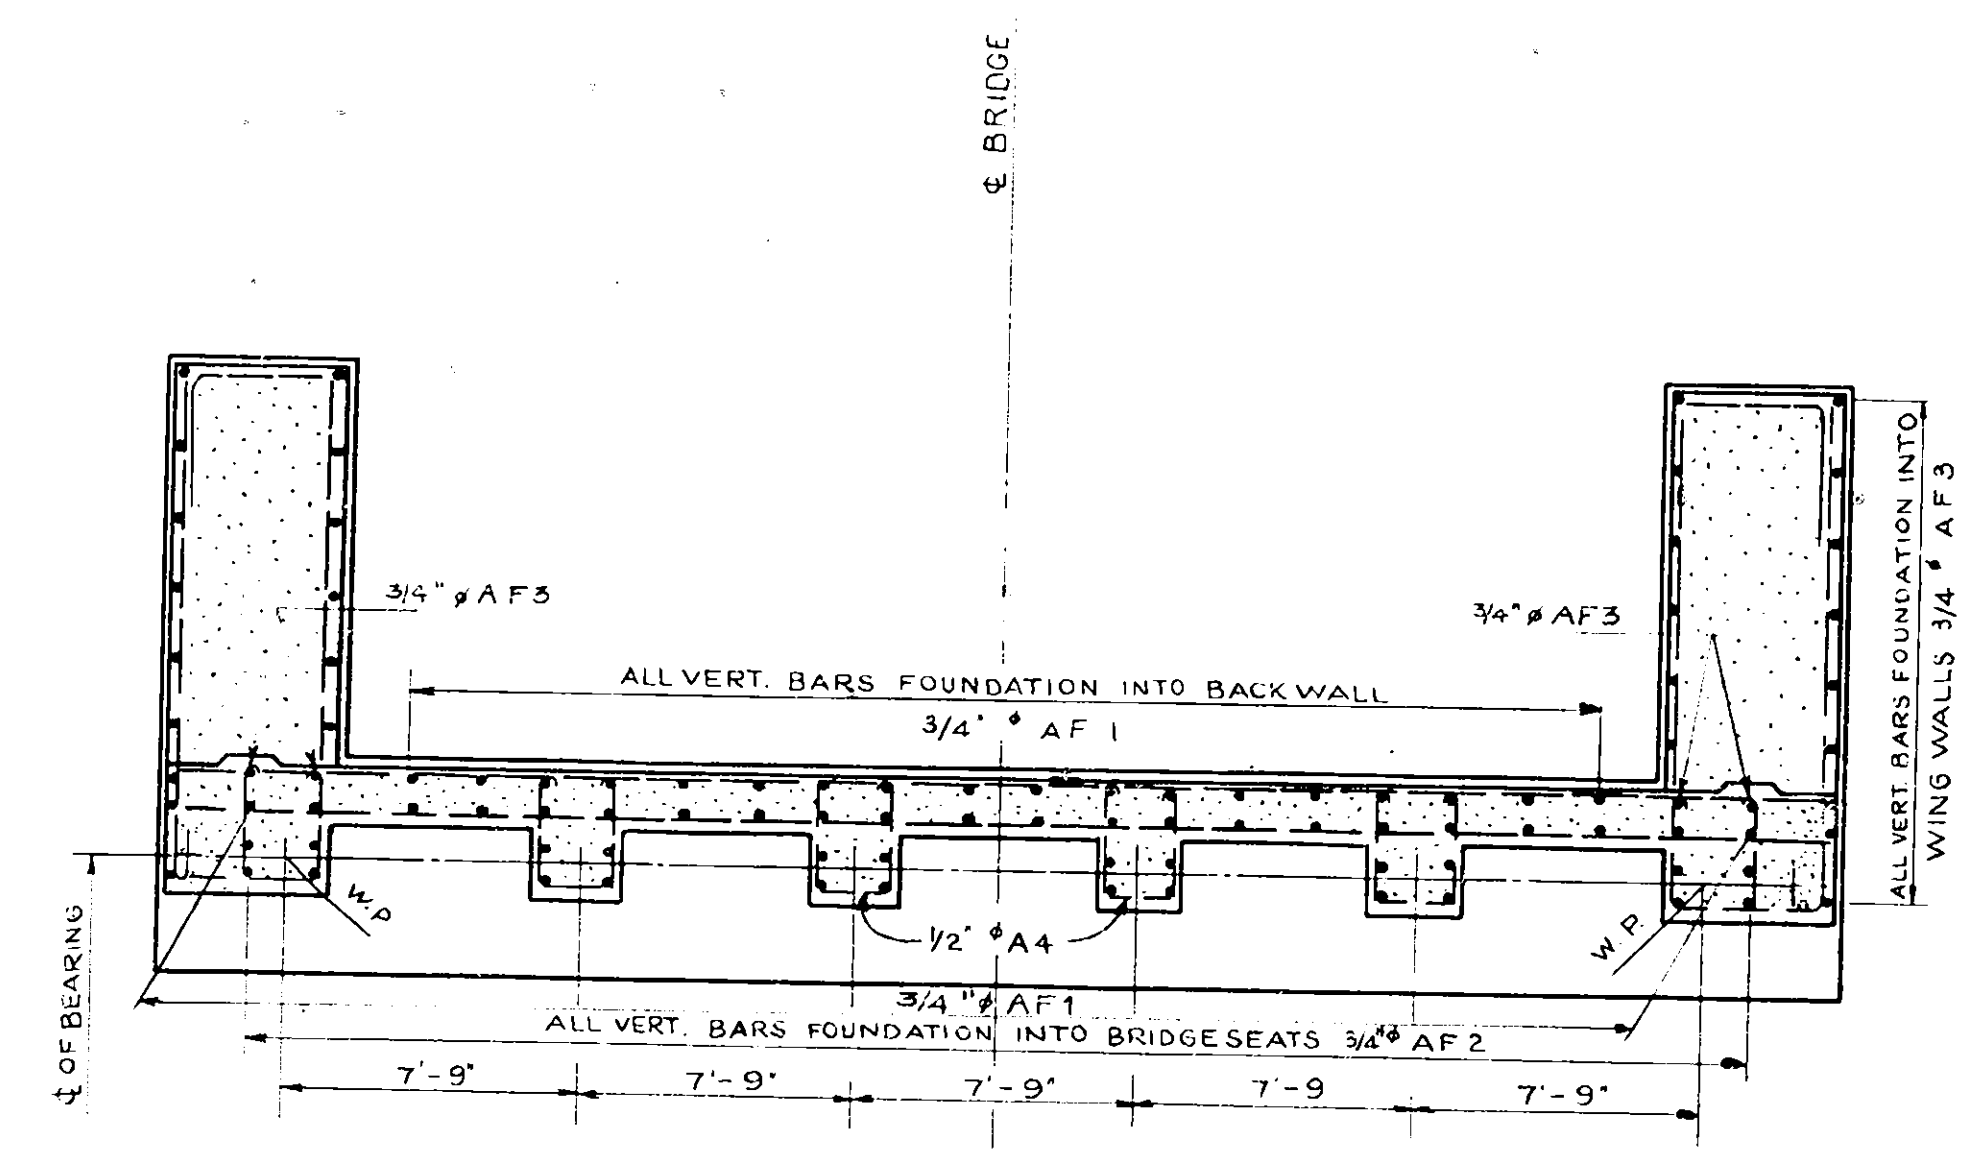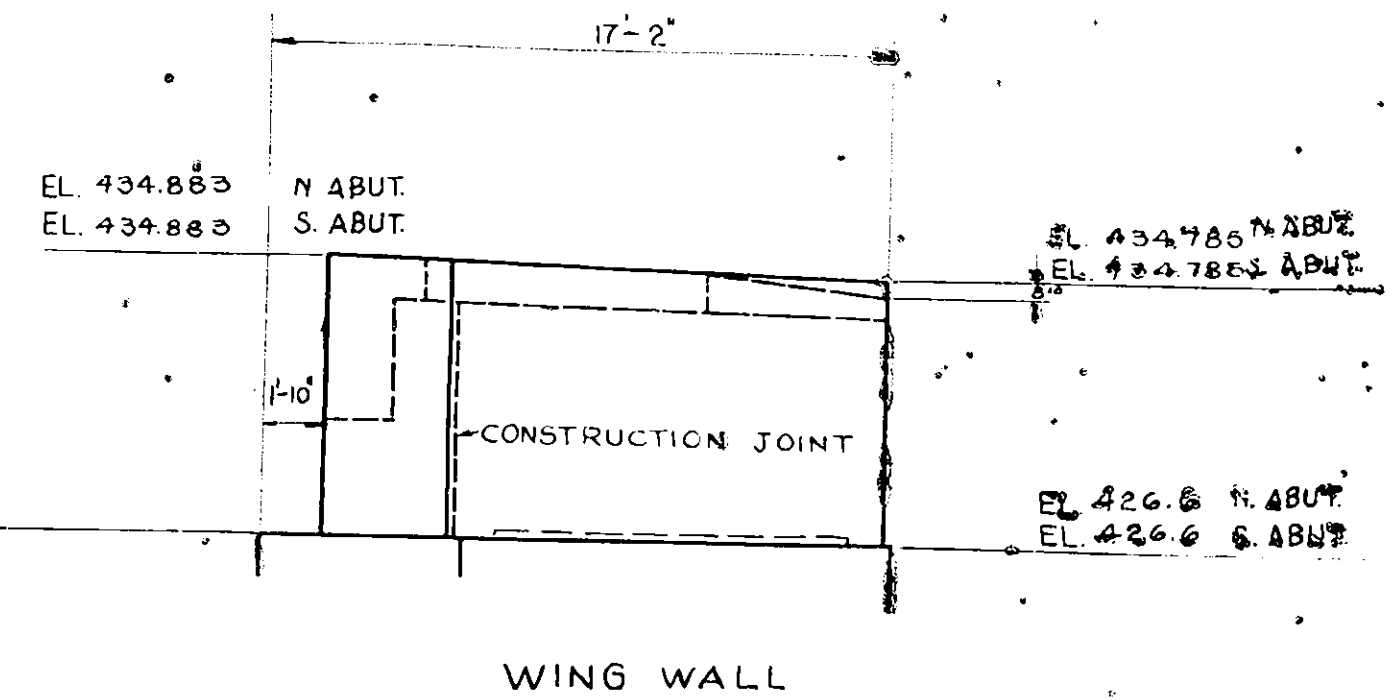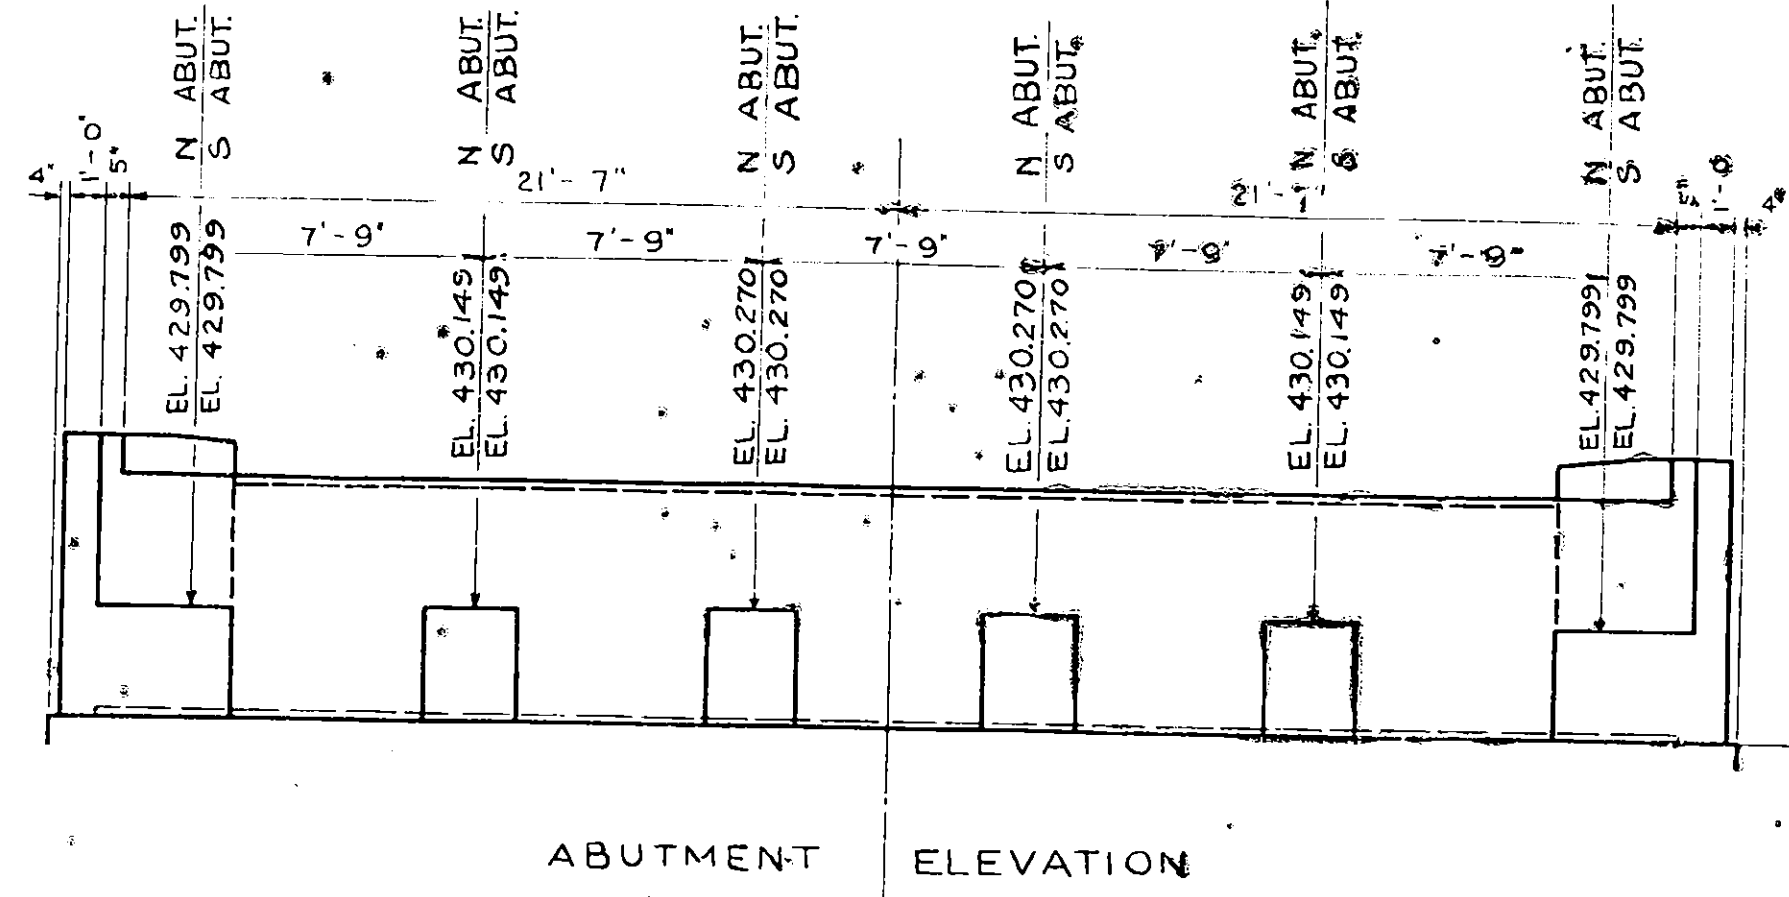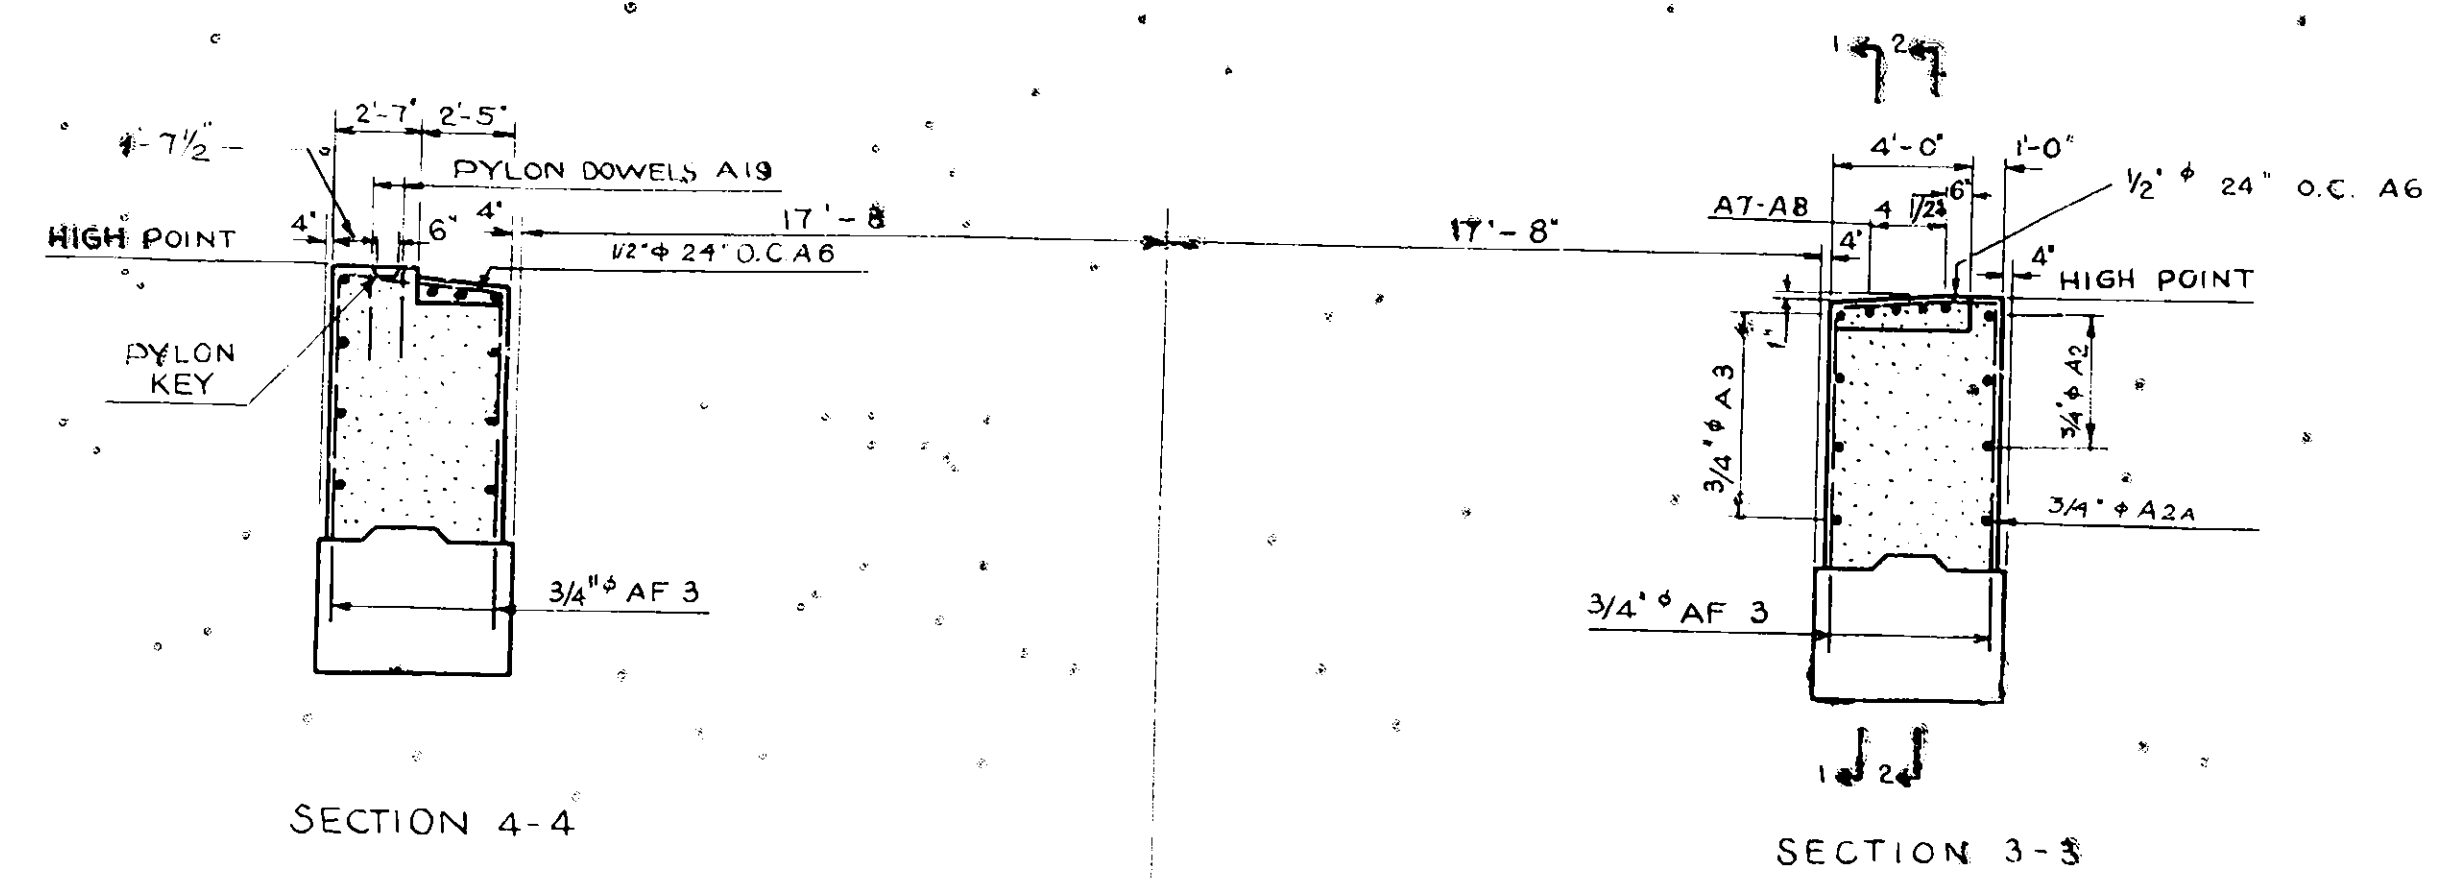

SCALE 3/16" = 1'-0", EXCEPT AS SHOWN






CROSS REFERENCE
 FOR LAYOUT OF ABUTMENTS SEE SHEET 57
 FOR DETAILS OF REINFORCING BARS SEE SHEET 65
 FOR DETAILS OF ANCHOR BOLTS SEE SHEET 63
 FOR DETAILS OF ABUTMENT FOUNDATION SEE SHEET 57
 FOR DETAILS OF PYLONS SEE SHEET 64
 FOR DETAILS OF RAILING SEE SHEET 63
 FOR STRINGER LAYOUT SEE SHEET 60

SUBSTRUCTURE DETAILS
 KINNE STREET
 MOHAWK SECTION
 NEW YORK STATE THRUWAY

PREPARED AND RECOMMENDED *Doyle* Feb 16-53
 URBAN & DOYLE CONSULTING ENGINEERS
 NEW YORK STATE PROFESSIONAL ENGINEERS LICENSE NO. 5667

NY STATE THRUWAY, MOHAWK SECTION SUBDIV. 8 B
INTERCHANGE AT THOMPSON ROAD

ITEM NO.	DESCRIPTION	UNIT	NEAT	ROUNDED
5	TRENCH, CULVERT & BRIDGE EXCAVATION	C.Y.	260	300
15-2	PORTLAND CEMENT TYPE 2	BBL.	745	764
15-N	NATURAL CEMENT TYPE N	BBL.	86	88
18	CLASS 1A CONCRETE FOR STRUCTURES	C.Y.	430	447
20	BAR REINFORCEMENT FOR STRUCTURES	LB.	44,500	46,000
85-C	CAST IN PLACE CONCRETE PILES	L.F.	3,552	3,700
87	FURNISHING EQUIPMENT FOR DRIVING PILES	L.S.	NEC	NEC
92S	SCREENED GRAVEL - LOOSE MEASURE	C.Y.	145	155
121	TOP SOIL PLACED FROM STOCK PILES	C.Y.	360	380
123	SEEDING	ACRE	.4	.5
124	SOODING	S.Y.	635	670

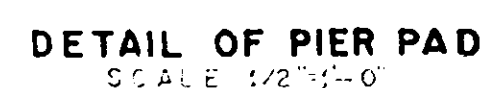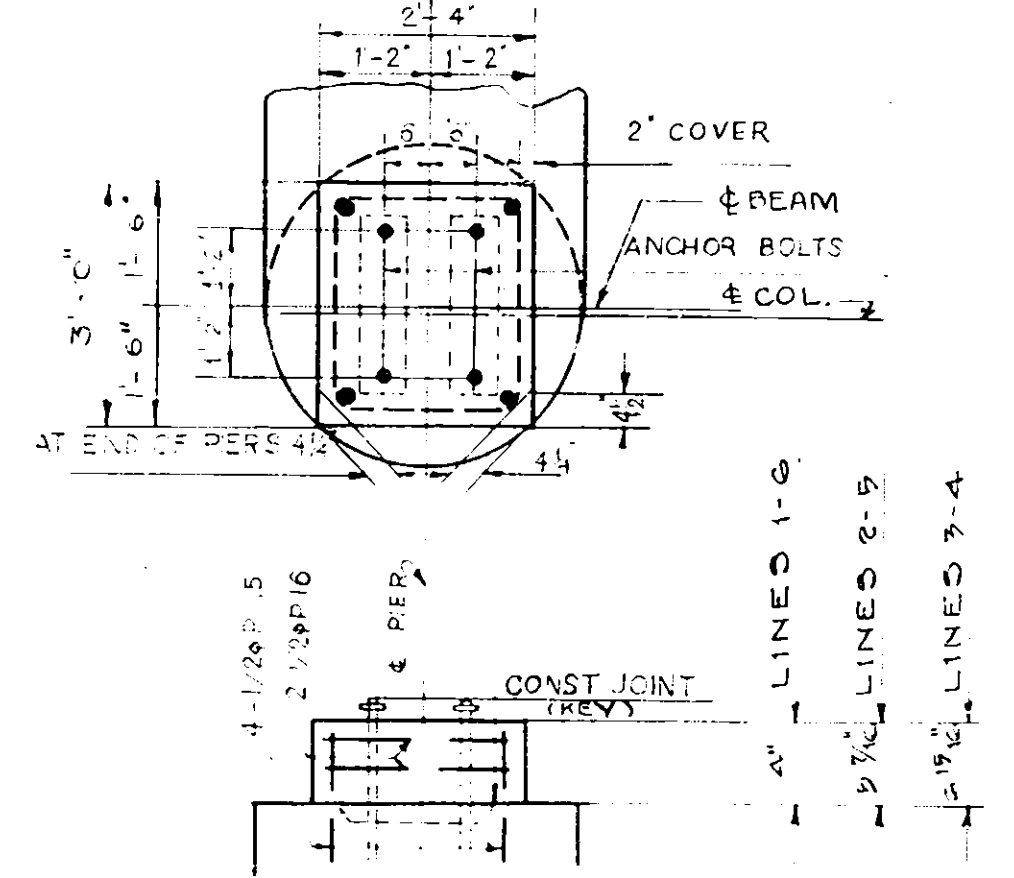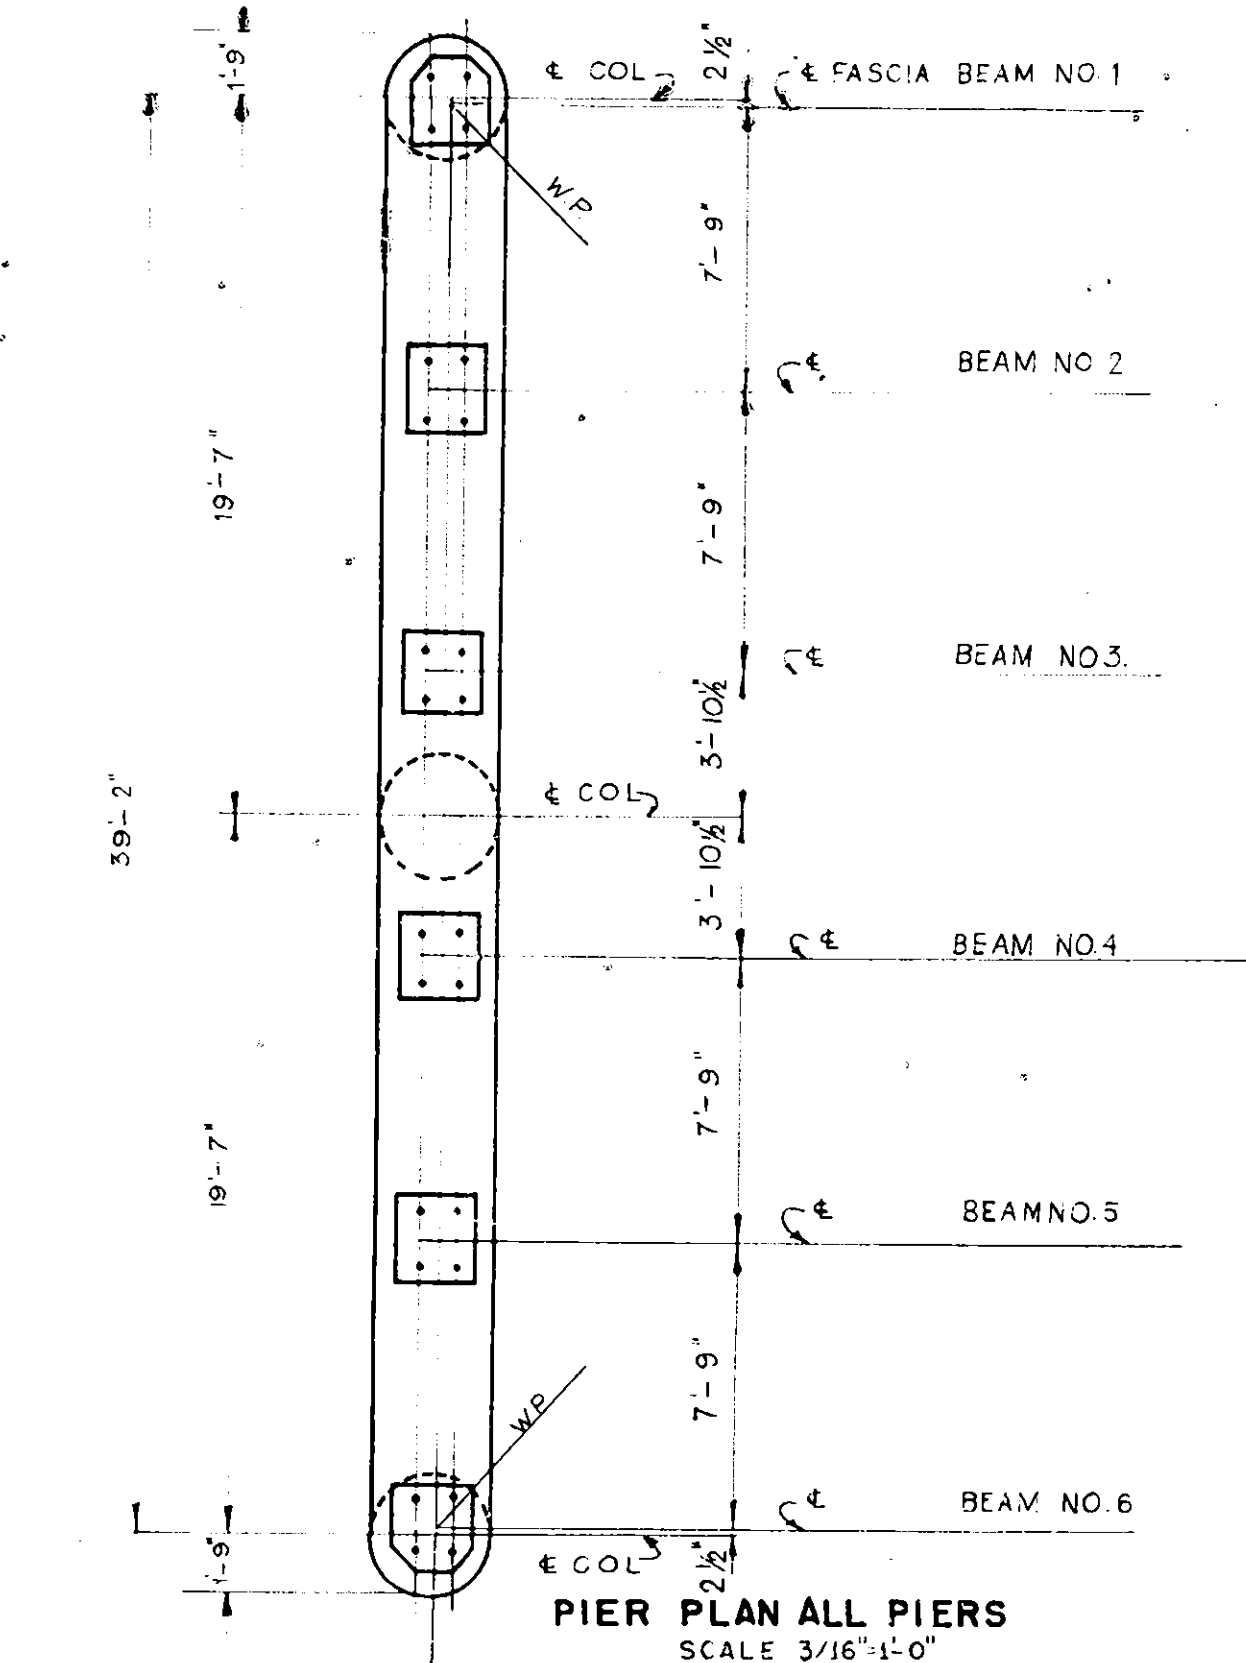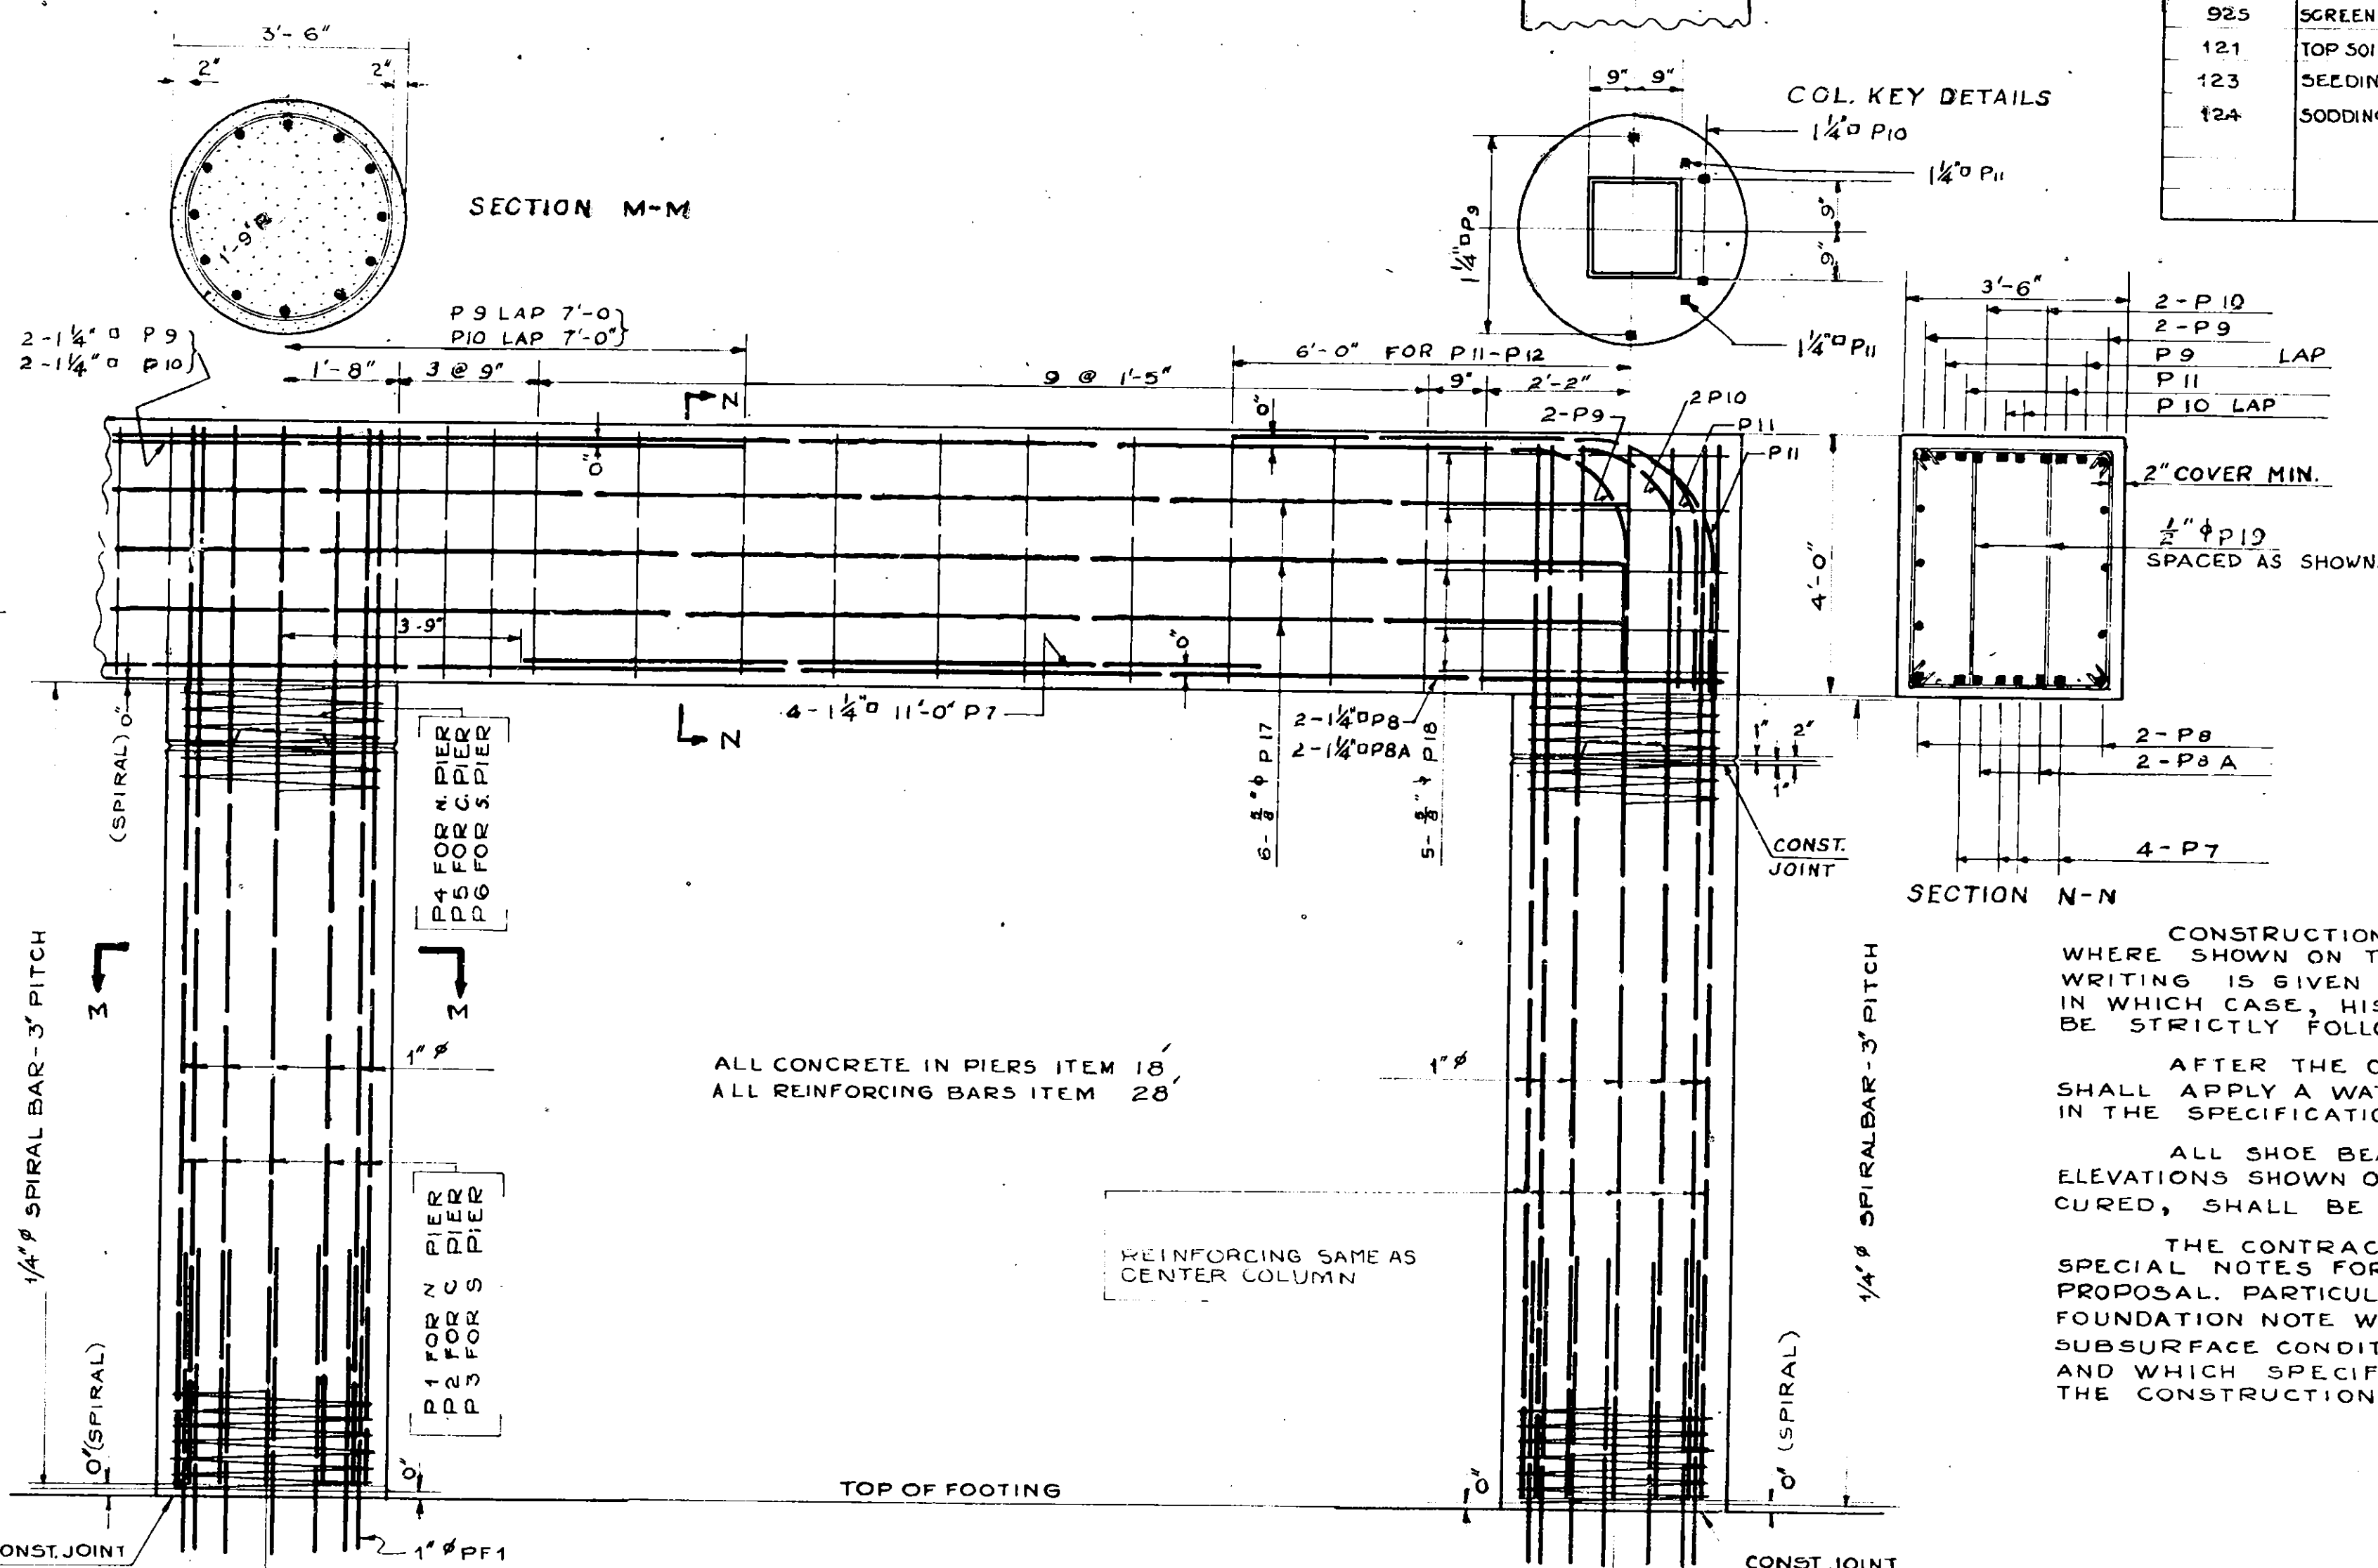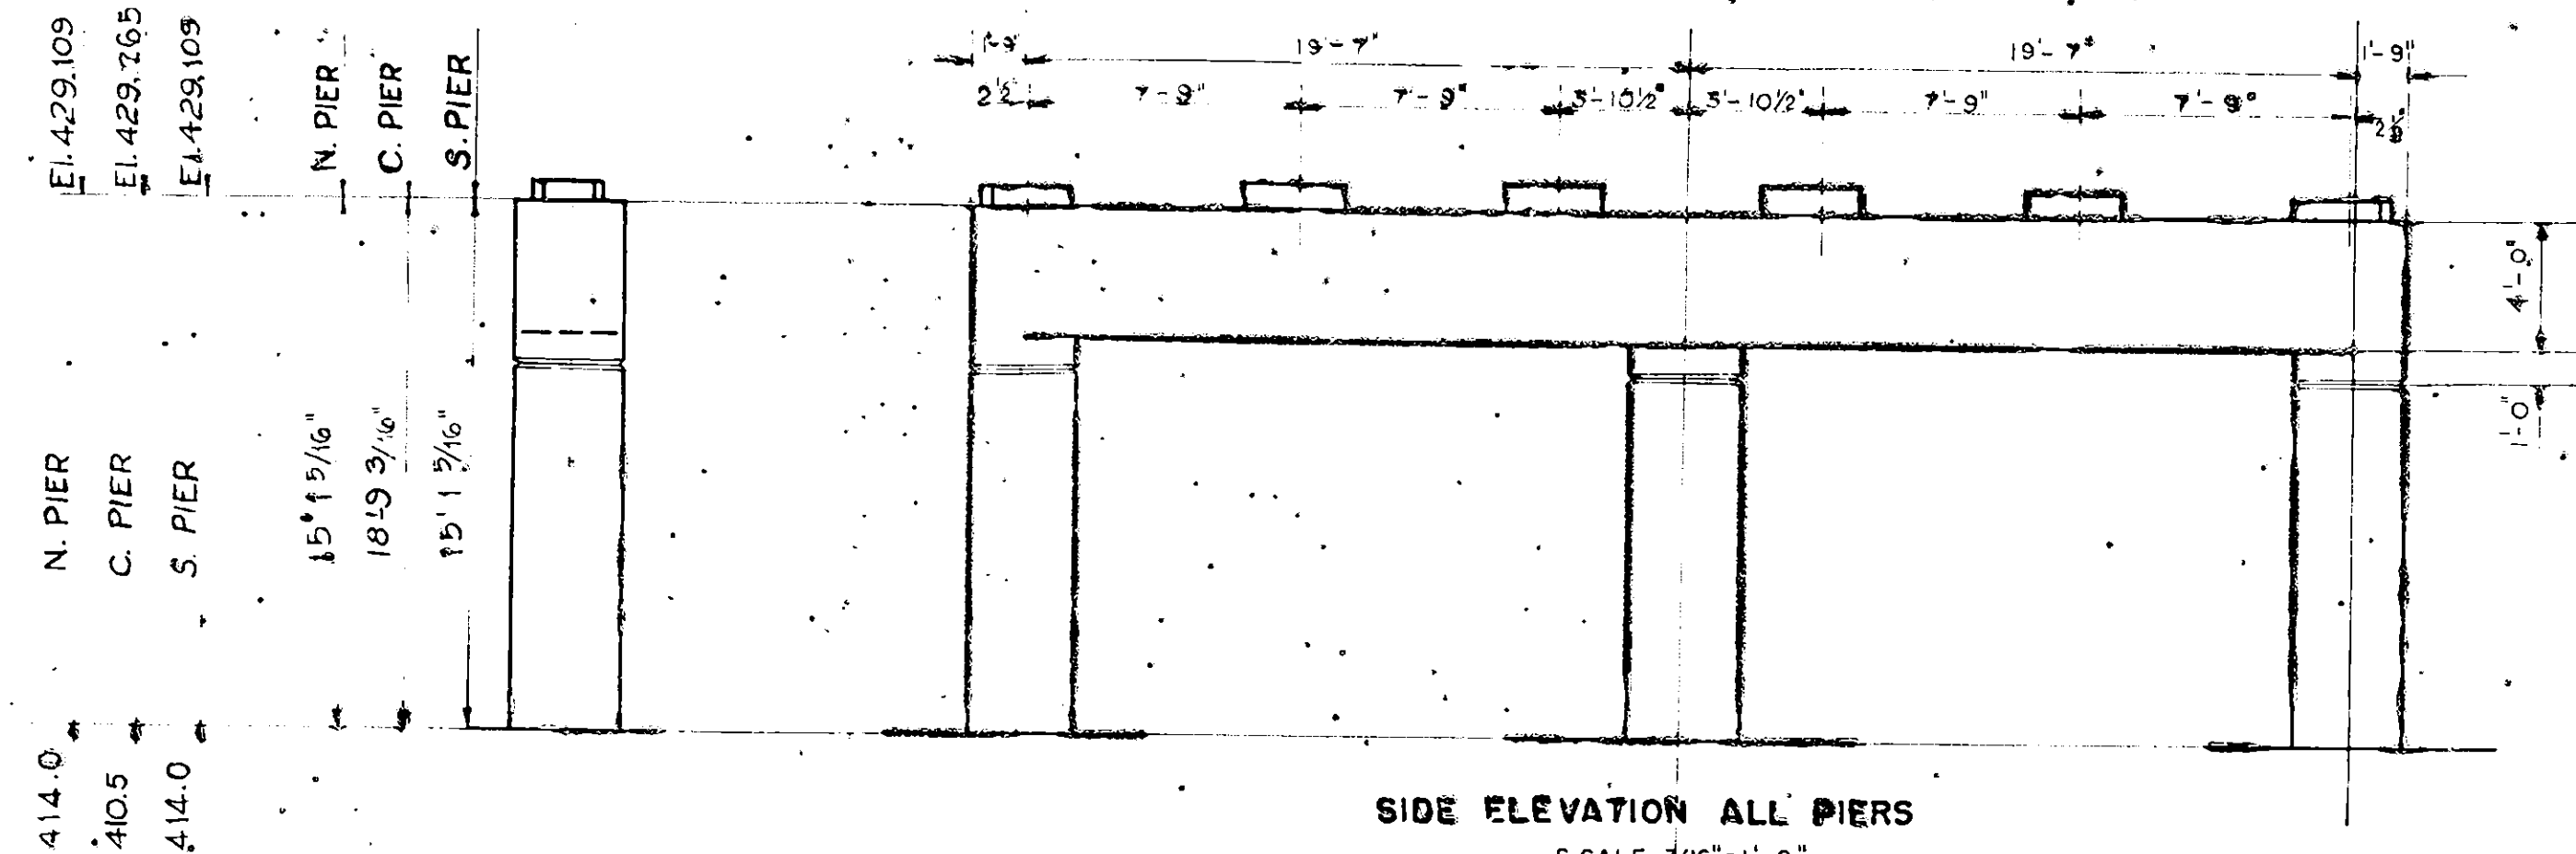

PIER DETAILS - ALL PIERS

NOTE: For location of Identification Plate see
Standard Sheet No. 53-41.

CROSS REFERENCE

FOR LAYOUT OF PIERS SEE SHEET 57
FOR DETAILS OF REINFORCING BARS SEE SHEET 65
FOR DETAILS OF PIER FOUNDATION SEE SHEET 57
FOR DETAILS OF ANCHOR BOLTS SEE SHEET 63

SUBSTRUCTURE

GENERAL NOTES

CONSTRUCTION JOINTS SHALL BE PLACED ONLY AS AND WHERE SHOWN ON THE PLANS, EXCEPT WHERE PERMISSION IN WRITING IS GIVEN BY THE DEPUTY CHIEF ENGINEER (BRIDGES), IN WHICH CASE, HIS SUPPLEMENTAL INSTRUCTIONS SHALL BE STRICTLY FOLLOWED.

AFTER THE CONCRETE IS CURED, THE CONTRACTOR SHALL APPLY A WATER-PROOFING OIL TREATMENT, AS DESCRIBED IN THE SPECIFICATIONS FOR M-41 W TO ALL EXPOSED SURFACES.

ALL SHOE BEARING SURFACES SHALL BE CAST $\frac{1}{4}$ " ABOVE ELEVATIONS SHOWN ON THE PLANS, AND AFTER THE CONCRETE IS CURED, SHALL BE BUSH-HAMMERED TO THE REQUIRED ELEVATIONS.

THE CONTRACTOR'S ATTENTION IS DIRECTED TO THE SPECIAL NOTES FOR THIS STRUCTURE WHICH APPEAR IN THE PROPOSAL. PARTICULAR ATTENTION SHOULD BE GIVEN TO THE FOUNDATION NOTE WHICH BRIEFLY OUTLINES THE ANTICIPATED SUBSURFACE CONDITIONS AT THE SITE OF THE STRUCTURE, AND WHICH SPECIFIES CERTAIN REQUIREMENTS RELATIVE TO THE CONSTRUCTION.

SUBSTRUCTURE DETAILS

KINNE STREET
MOHAWK SECTION

NEW YORK STATE THRUWAY

SHEET 59


COUNTY	SHEET NO	TOTAL SHEETS
ONONDAGA	59	66

NEW YORK STATE THRUWAY, MOHAWK SECTION SUBDIV. B B
INTERCHANGE AT THOMSON ROAD


59R

SUBSTRUCTURE QUANTITIES




ITEM NO.	DESCRIPTION	UNIT	NEAT	ROUNDED
5	TRENCH, CULVERT & BRIDGE EXCAVATION	C.Y.	260	300
15-2	PORTLAND CEMENT TYPE 2	BBL.	743	764
15-N	NATURAL CEMENT TYPE N	BBL.	80	80
18	CLASS 1A CONCRETE FOR STRUCTURES	C.Y.	430	440
20	BAR REINFORCEMENT FOR STRUCTURES	LB	48,500	48,000
85-C	CAST IN PLACE CONCRETE PILES	L.F.	3,552	3,000
87	FURNISHING EQUIPMENT FOR DRIVING PILES	L.S.	NEC	NEC
92S	SCREENED GRAVEL - LOOSE MEASURE	C.Y.	45	55
121	TOP SOIL PLACED FROM STOCK PILES	C.Y.	360	380
123	SEEDING	ACRE	4	5
124	SODDING	S.Y.	635	670

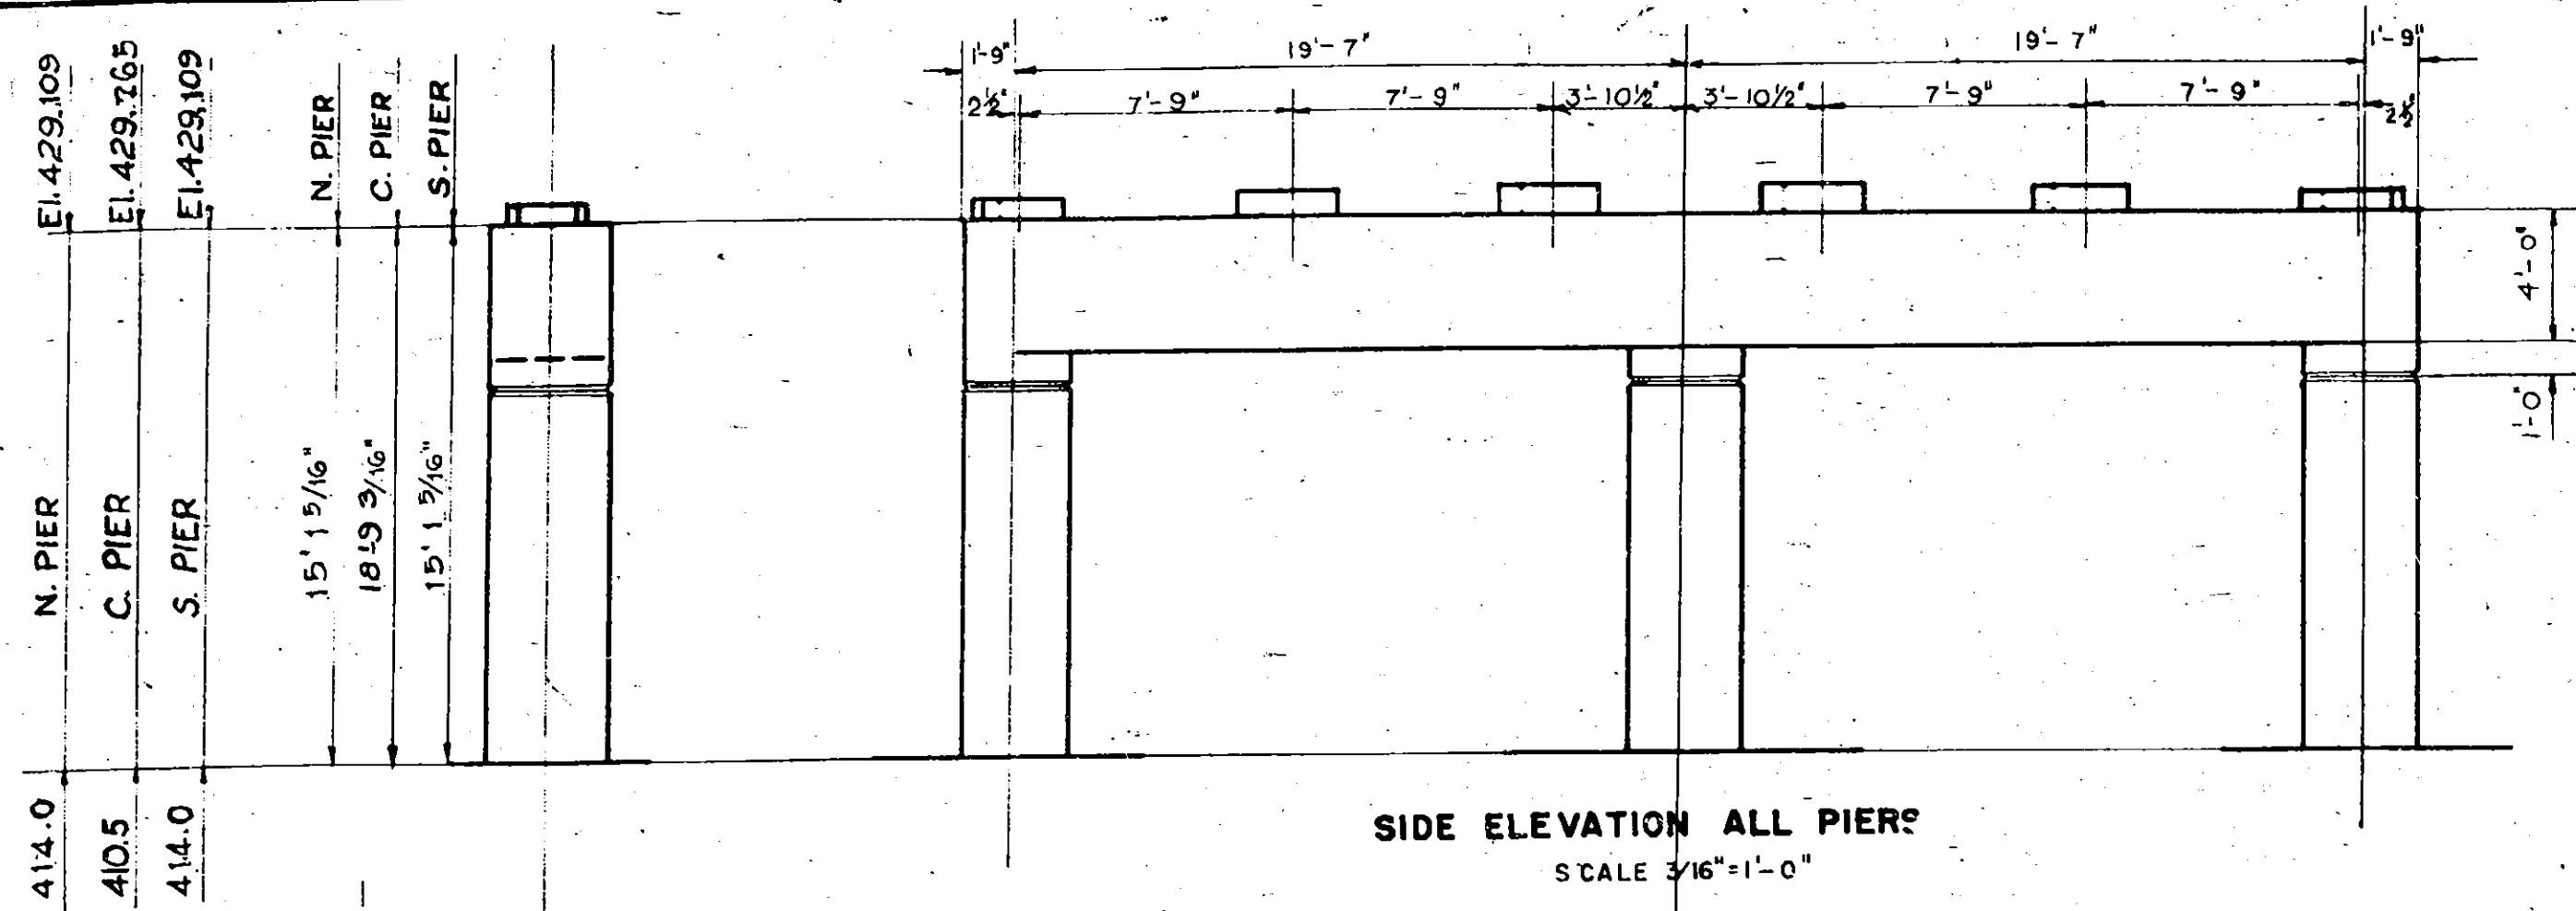SIDE ELEVATION ALL PIERS
SCALE 3/16"=1'-0"

SECTION M-M

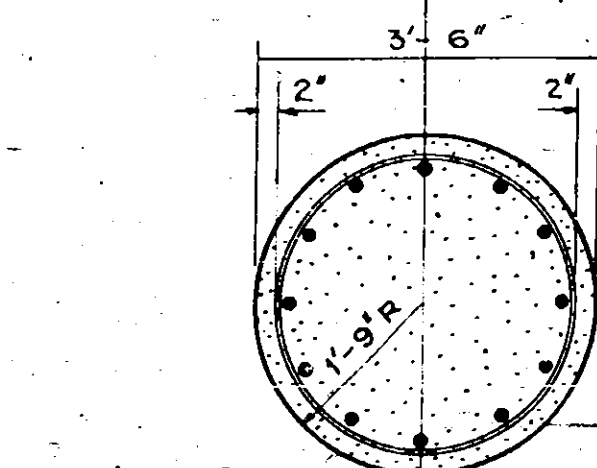

COL. KEY DETAILS

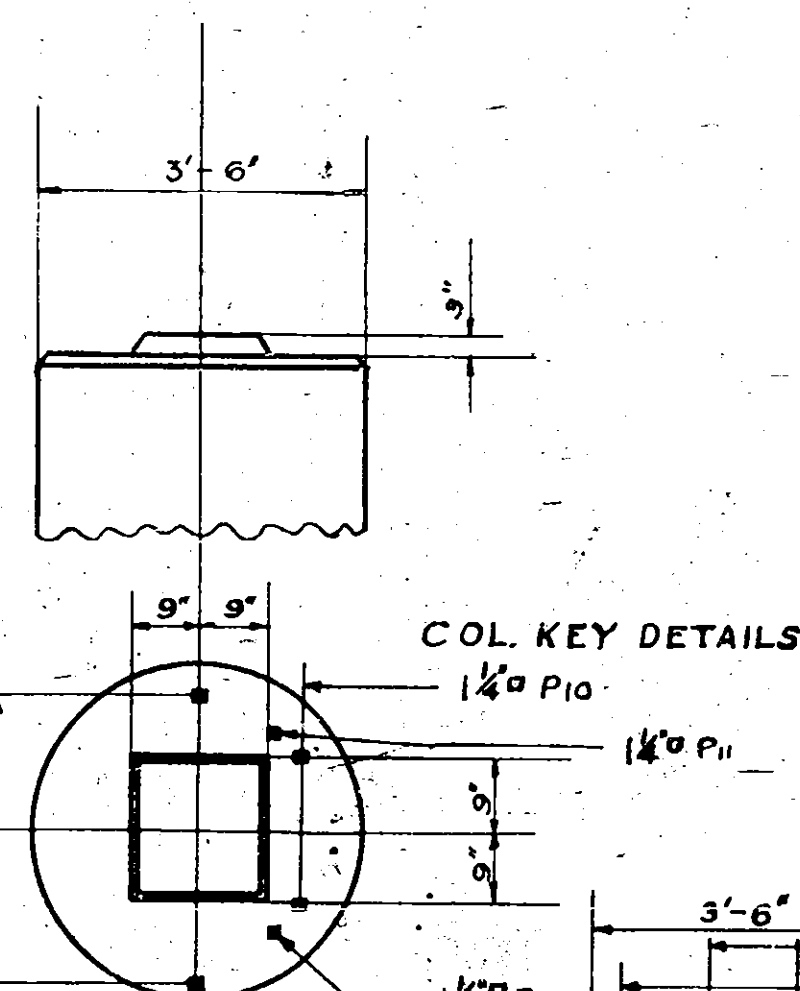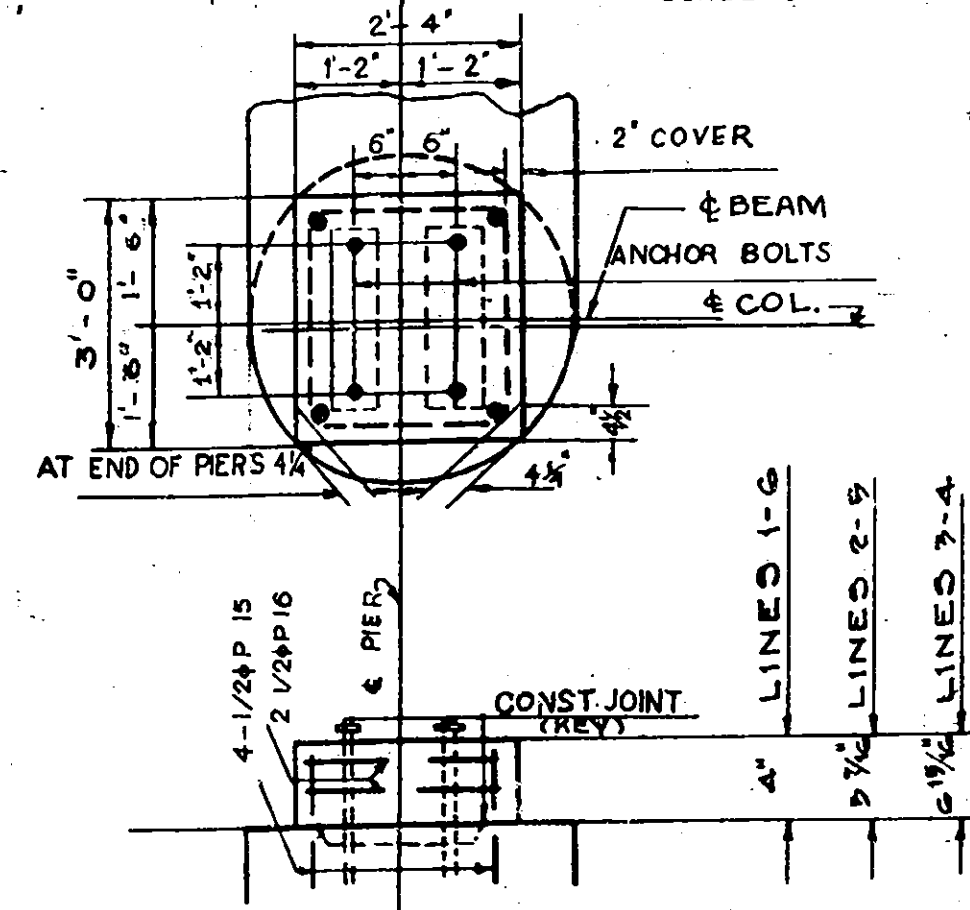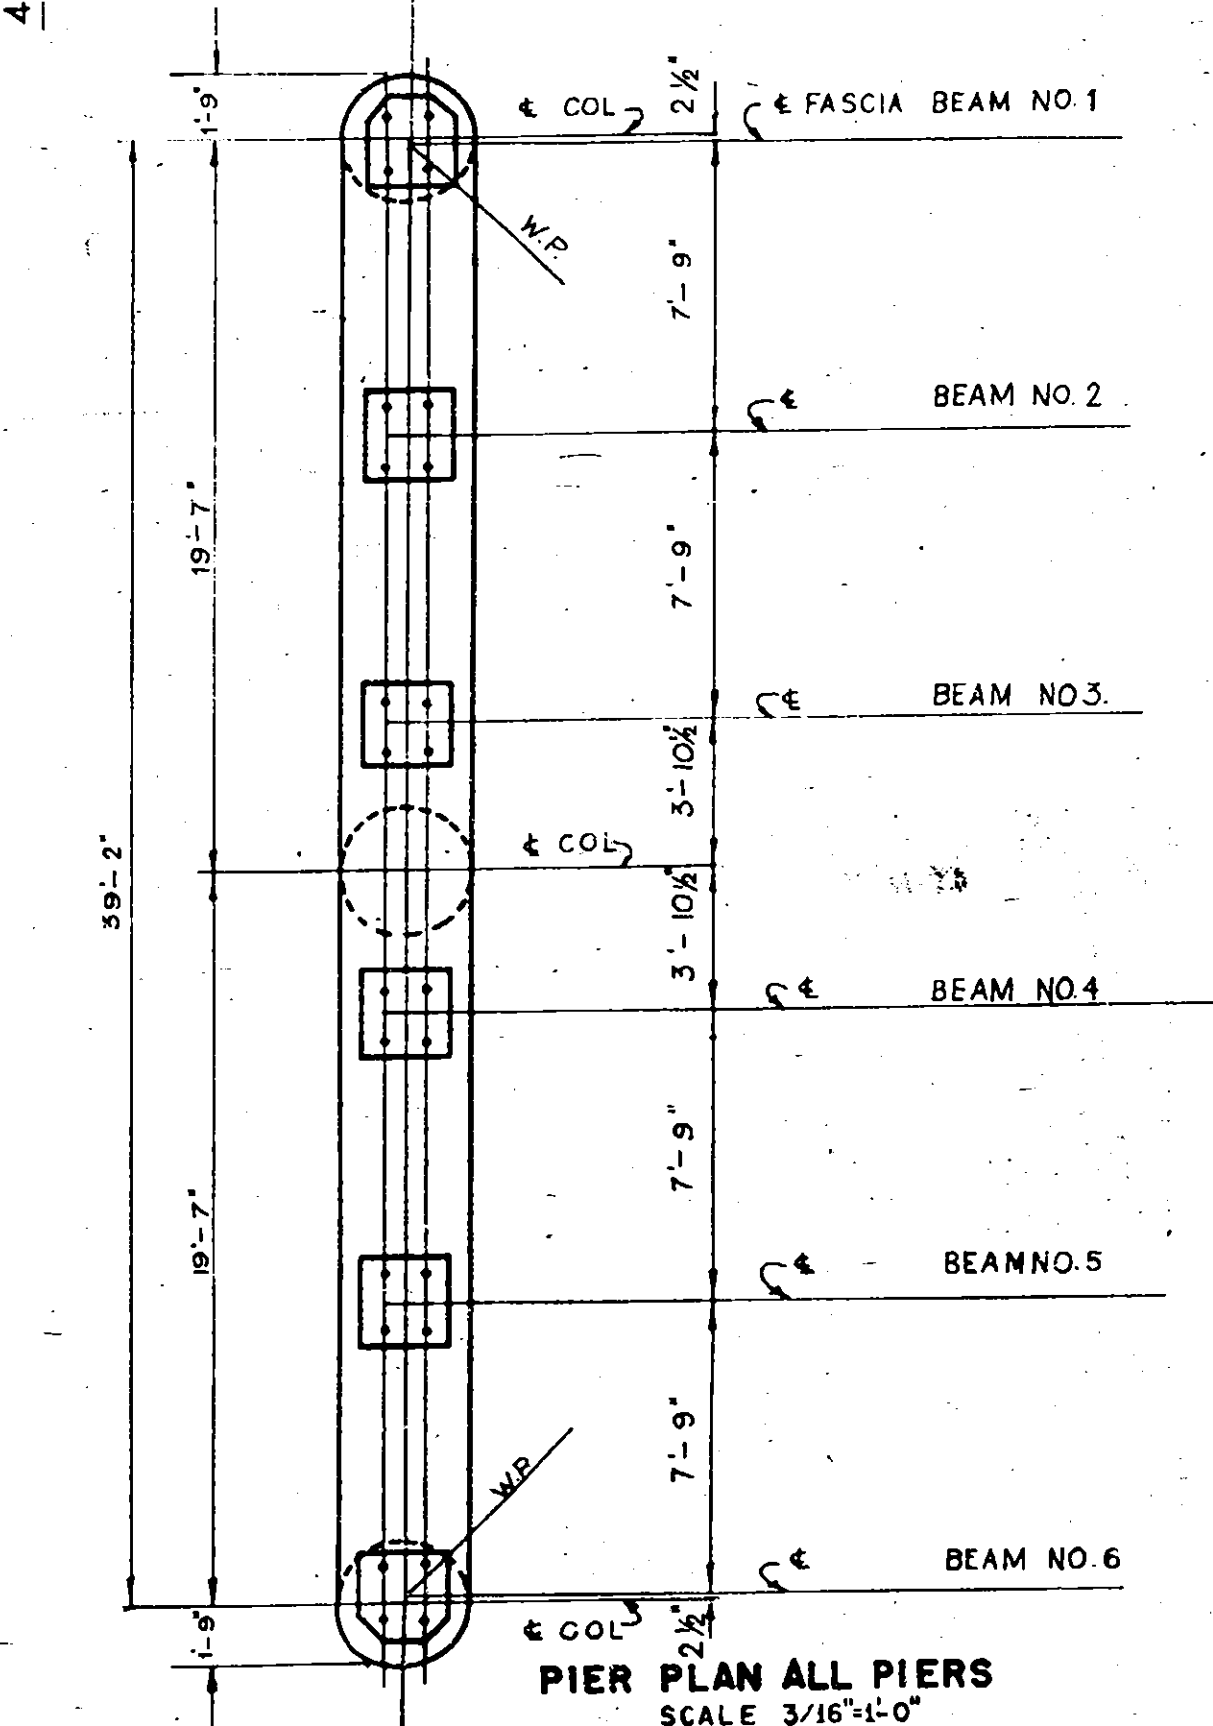PIER PLAN ALL PIERS
SCALE 3/16"=1'-0"DETAIL OF PIER PAD
SCALE 1/2"=1'-0"

ALL CONCRETE IN PIERS ITEM 18
ALL REINFORCING BARS ITEM 20

REINFORCING SAME AS
CENTER COLUMN

PIER DETAILS - ALL PIERS

Note: For location of Identification Plate see
Standard Sheet No. 53-41.

CROSS REFERENCE

FOR LAYOUT OF PIERS SEE SHEET 57
FOR DETAILS OF REINFORCING BARS SEE SHEET 65
FOR DETAILS OF PIER FOUNDATION SEE SHEET 57
FOR DETAILS OF ANCHOR BOLTS SEE SHEET 63

SUBSTRUCTURE
GENERAL NOTES

CONSTRUCTION JOINTS SHALL BE PLACED ONLY AS AND WHERE SHOWN ON THE PLANS, EXCEPT WHERE PERMISSION IN WRITING IS GIVEN BY THE DEPUTY CHIEF ENGINEER (BRIDGES); IN WHICH CASE, HIS SUPPLEMENTAL INSTRUCTIONS SHALL BE STRICTLY FOLLOWED.

AFTER THE CONCRETE IS CURED, THE CONTRACTOR SHALL APPLY A WATER-PROOFING OIL TREATMENT, AS DESCRIBED IN THE SPECIFICATIONS FOR M-41W TO ALL EXPOSED SURFACES.

ALL SHOE BEARING SURFACES SHALL BE CAST 1/4" ABOVE ELEVATIONS SHOWN ON THE PLANS, AND AFTER THE CONCRETE IS CURED, SHALL BE BUSH-HAMMERED TO THE REQUIRED ELEVATIONS.

THE CONTRACTOR'S ATTENTION IS DIRECTED TO THE SPECIAL NOTES FOR THIS STRUCTURE WHICH APPEAR IN THE PROPOSAL. PARTICULAR ATTENTION SHOULD BE GIVEN TO THE FOUNDATION NOTE WHICH BRIEFLY OUTLINES THE ANTICIPATED SUBSURFACE CONDITIONS AT THE SITE OF THE STRUCTURE, AND WHICH SPECIFIES CERTAIN REQUIREMENTS RELATIVE TO THE CONSTRUCTION.

BUILT ACCORDING TO PLAN

SUBSTRUCTURE DETAILS

KINNE STREET
MOHAWK SECTION

NEW YORK STATE THRUWAY

SHEET 59

PREPARED AND RECOMMENDED:

URQUHART & DOYLE, CONSULTING ENGINEERS
NEW YORK STATE PROFESSIONAL ENGINEERS LICENSE NO. 6667

Ed Doyle Feb 16-53
DATE

SUPERSTRUCTURE

GENERAL NOTES

THE DESIGN OF THE STRUCTURE IS BASED ON A.A.S.H.O. SPECIFICATIONS, 1949, H-20-S16-44 LOADING AND CURRENT MODIFICATIONS AND ADDITIONS. ALL CONCRETE OF SUPERSTRUCTURE SHALL BE ITEM 18, EXCEPT CONCRETE OF PYLONS WHICH SHALL BE ITEM 19, AND CEMENT CONCRETE PAVEMENT, WHICH SHALL BE ITEM 47-BM. THE COST OF FURNISHING AND INSTALLING METAL EXPANSION MATERIAL, METAL WATER STOP, PREMOULDED BITUMINOUS JOINT MATERIAL, CAULKING COMPOUND, PARA-PLASTIC, SPONGE RUBBER, ASPHALT ROOFING FELT, ETC., SHALL BE INCLUDED IN THE BID PRICES OF THE RESPECTIVE CONCRETE ITEMS OF THE CONTRACT.

ALL MATERIALS, WORKMANSHIP, AND FABRICATION SHALL CONFORM TO NEW YORK STATE DEPARTMENT OF PUBLIC WORKS SPECIFICATIONS, JANUARY 2, 1951, AND CURRENT MODIFICATIONS AND ADDITIONS.

WHERE CAULKING COMPOUND IS TO CONTACT CONCRETE SURFACES, SUCH CONCRETE SHALL BE THOROUGHLY CLEANED AND DRY, AND PRIMED WITH A PRILING COAT AT LEAST 30 MINUTES BEFORE THE APPLICATION OF CAULKING COMPOUND. THIS WORK SHALL BE DONE BY EXPERIENCED MEN, AND THE COMPLETE OPERATION SHALL BE SPECIALLY DIRECTED BY THE ENGINEER.

CONSTRUCTION JOINTS SHALL BE PLACED ONLY AS AND WHERE SHOWN ON THE PLANS, EXCEPT WHEN PERMISSION IN WRITING IS GIVEN BY THE DEPUTY CHIEF ENGINEER OF BRIDGES. IN WHICH CASE HIS SUPPLEMENTAL INSTRUCTION SHALL BE STRICTLY FOLLOWED.

AFTER THE CONCRETE IS CURED, THE CONTRACTOR SHALL APPLY WATERPROOFING OIL TREATMENT, AS DESCRIBED IN THE SPECIFICATIONS, FOR 11-41W TO ALL EXPOSED SURFACES EXCEPT THE UNDERSIDE OF SLABS. TWO APPLICATIONS OF WATERPROOFING OIL TREATMENT SHALL BE APPLIED AT THE TOP OF THE SLAB, THE SECOND APPLICATION SHALL BE APPLIED TWO DAYS PRIOR TO THE PLACING OF THE PAVEMENT OR SIDEWALK.


IMMEDIATELY BEFORE PLACING PAVEMENT CONCRETE, THE CONCRETE SURFACE OR SURFACES UPON WHICH IT IS TO BE PLACED SHALL BE THOROUGHLY WETTED DOWN CONTINUOUSLY FOR ONE HOUR, IF THE AIR TEMPERATURE IS ABOVE 50°F. PAYMENT FOR THIS WORK WILL BE INCLUDED IN THE PRICE BID FOR ITEM 47-BM.

THE CONTRACTOR'S ATTENTION IS DIRECTED TO THE SPECIAL NOTES FOR THIS STRUCTURE WHICH APPEAR IN THE PROPOSAL. PARTICULAR ATTENTION SHOULD BE GIVEN TO THE FOUNDATION NOTE, WHICH BRIEFLY OUTLINES THE ANTICIPATED SUBSURFACE CONDITIONS OF THE SITE OF THE STRUCTURE, AND WHICH SPECIFIES CERTAIN REQUIREMENTS RELATIVE TO CONSTRUCTION.

SUPERSTRUCTURE QUANTITIES

ITEM NO.	DESCRIPTION	UNIT	NEAT	ROUNDED
15-2	PORTLAND CEMENT TYPE 2	BBL.	418	425
15-N	NATURAL CEMENT TYPE N	BBL.	81	84
18	CLASS 1A CONCRETE FOR STRUCTURES	C.Y.	291	300
19	CLASS 1A CONCRETE FOR RAILINGS	C.Y.	25	3
28	BAR REINFORCEMENT FOR STRUCTURES	LB.	69,300	72,000
28B	SPIRAL BAR SHEAR CONNECTORS	LB.	2,260	2,380
29	STRUCTURAL STEEL	LB.	283,800	292,300
37	METAL RAILING	L.F.	482	485
47BM	CEMENT CONCRETE PAVEMENT	C.Y.	102	105
*25F	STEEL FABRIC REINFORCEMENT	S.Y.	900	940
15-0A	PORTLAND CEMENT TYPE 1A	BBL.	152	157

* STEEL FABRIC REINFORCEMENT TO BE FURNISHED IN FLAT SHEETS

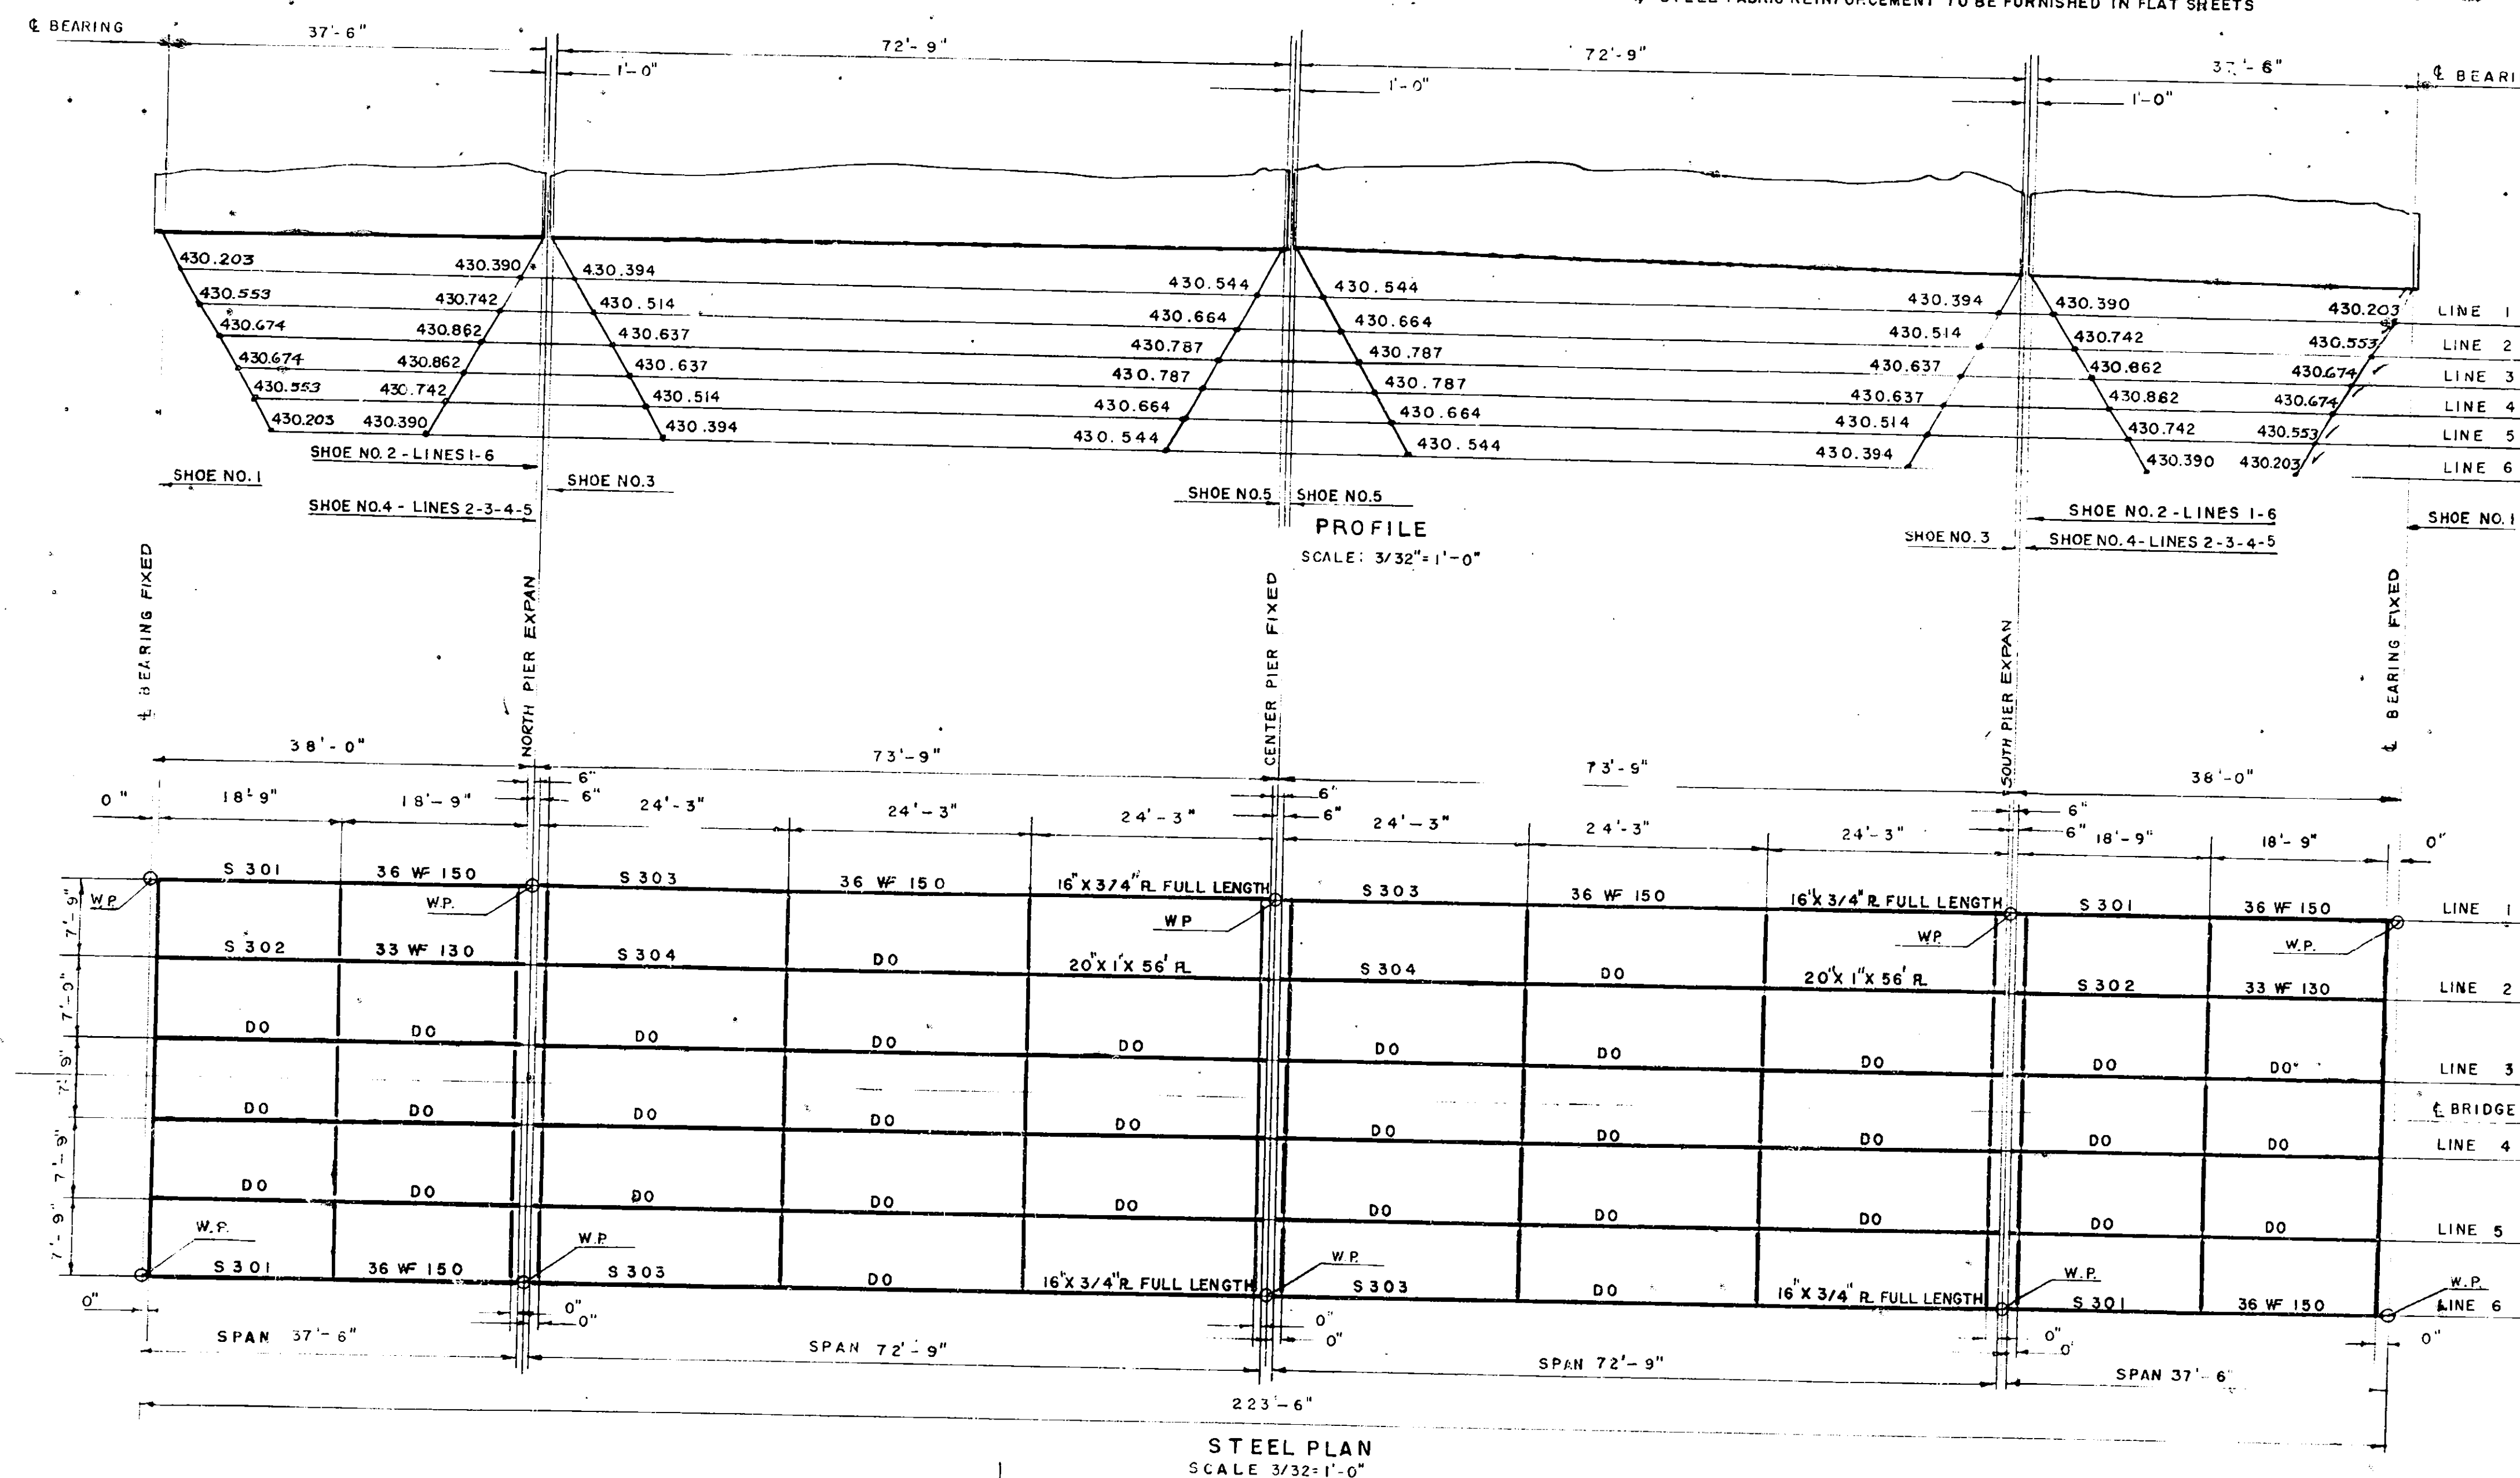

NOTE
ELEVATIONS ARE TO
BOTTOM OF BOTTOM
FLANGE.

STEEL PLAN
SCALE 3/32" = 1'-0"

SUPERSTRUCTURE DETAILS

KINNE STREET

MOHAWK SECTION

NEW YORK STATE THRUWAY

PREPARED AND RECOMMENDED

URDUHAST & DOYLE CONSULTING ENGINEERS
NEW YORK STATE PROFESSIONAL ENGINEERS LICENSE NO. 5667

COUNTY	SHEET NO.	TOTAL SHEETS
ONONDAGA	60	66
NEW YORK STATE THRUWAY, MOHAWK SECTION, SUBDIV. 6B		
INTERCHANGE AT THOMPSON ROAD		

SUPERSTRUCTURE

GENERAL NOTES

THE DESIGN OF THE STRUCTURE IS BASED ON A.A.S.H.O. SPECIFICATIONS, 1949, H-20-S16-44 LOADING AND CURRENT MODIFICATIONS AND ADDITIONS. ALL CONCRETE OF SUPERSTRUCTURE SHALL BE ITEM 18, EXCEPT CONCRETE OF PYLONS WHICH SHALL BE ITEM 18 AND CEMENT CONCRETE PAVEMENT, WHICH SHALL BE ITEM 47-BM. THE COST OF FURNISHING AND INSTALLING METAL EXPANSION MATERIAL, METAL WATER STOP, PREMOULDED BITUMINOUS JOINT MATERIAL, CAULKING COMPOUND, PAPA-PLASTIC, SPONGE RUBBER, ASPHALT ROOFING FELT, ETC., SHALL BE INCLUDED IN THE BID PRICES OF THE RESPECTIVE CONCRETE ITEMS OF THE CONTRACT.

ALL MATERIALS, WORKMANSHIP, AND FABRICATION SHALL CONFORM TO NEW YORK STATE DEPARTMENT OF PUBLIC WORKS SPECIFICATIONS, JANUARY 2, 1951, AND CURRENT MODIFICATIONS AND ADDITIONS.

WHERE CAULKING COMPOUND IS TO CONTACT CONCRETE SURFACES, SUCH CONCRETE SHALL BE THOROUGHLY CLEANED AND DRY, AND PRIMED WITH A PRIMING COAT AT LEAST 30 MINUTES BEFORE THE APPLICATION OF CAULKING COMPOUND. THIS WORK SHALL BE DONE BY EXPERIENCED MEN, AND THE COMPLETE OPERATION SHALL BE SPECIALLY DIRECTED BY THE ENGINEER.

CONSTRUCTION JOINTS SHALL BE PLACED ONLY AS AND WHERE SHOWN ON THE PLANS, EXCEPT WHEN PERMISSION IN WRITING IS GIVEN BY THE DEPUTY CHIEF ENGINEER OF BRIDGES, IN WHICH CASE HIS SUPPLEMENTAL INSTRUCTION SHALL BE STRICTLY FOLLOWED.

AFTER THE CONCRETE IS CURED, THE CONTRACTOR SHALL APPLY WATERPROOFING OIL TREATMENT, AS DESCRIBED IN THE SPECIFICATIONS FOR M-41W TO ALL EXPOSED SURFACES EXCEPT THE UNDERSIDE OF SLABS. TWO APPLICATIONS OF WATERPROOFING OIL TREATMENT SHALL BE APPLIED AT THE TOP OF THE SLAB, THE SECOND APPLICATION SHALL BE APPLIED TWO DAYS PRIOR TO THE PLACING OF THE PAVEMENT OR SIDEWALK.


IMMEDIATELY BEFORE PLACING PAVEMENT CONCRETE, THE CONCRETE SURFACE OR SURFACES UPON WHICH IT IS TO BE PLACED SHALL BE THOROUGHLY WETTED DOWN CONTINUOUSLY FOR ONE HOUR, IF THE AIR TEMPERATURE IS ABOVE 50°. PAYMENT FOR THIS WORK WILL BE INCLUDED IN THE PRICE BID FOR ITEM 47-BM.

THE CONTRACTOR'S ATTENTION IS DIRECTED TO THE SPECIAL NOTES FOR THIS STRUCTURE WHICH APPEAR IN THE PROPOSAL. PARTICULAR ATTENTION SHOULD BE GIVEN TO THE FOUNDATION NOTE, WHICH BRIEFLY OUTLINES THE ANTICIPATED SUBSURFACE CONDITIONS OF THE SITE OF THE STRUCTURE, AND WHICH SPECIFIES CERTAIN REQUIREMENTS RELATIVE TO CONSTRUCTION.

SUPERSTRUCTURE QUANTITIES				
ITEM NO.	DESCRIPTION	UNIT	NEAT	ROUNDED
15-2	PORTLAND CEMENT TYPE 2	BBL.	411	425
15-N	NATURAL CEMENT TYPE N	BBL.	81	84
18	CLASS I-A CONCRETE FOR STRUCTURES	C.Y.	29	300
19	CLASS I-A CONCRETE FOR RAILINGS	C.Y.	25	3
28	BAR REINFORCEMENT FOR STRUCTURES	LB.	69,300	72,000
28B	SPIRAL BAR SHEAR CONNECTORS	LB.	2,260	2,280
29	STRUCTURAL STEEL	LB.	2,83,800	294,300
37	METAL RAILING	L.F.	482	485
47-BM	CEMENT CONCRETE PAVEMENT	C.Y.	1.02	1.05
* 25 F	STEEL FABRIC REINFORCEMENT	S.Y.	900	940
18-BA	PORTLAND CEMENT TYPE I-A	BBL.	102	137

* STEEL FABRIC REINFORCEMENT TO BE FURNISHED IN FLAT SHEETS

60R

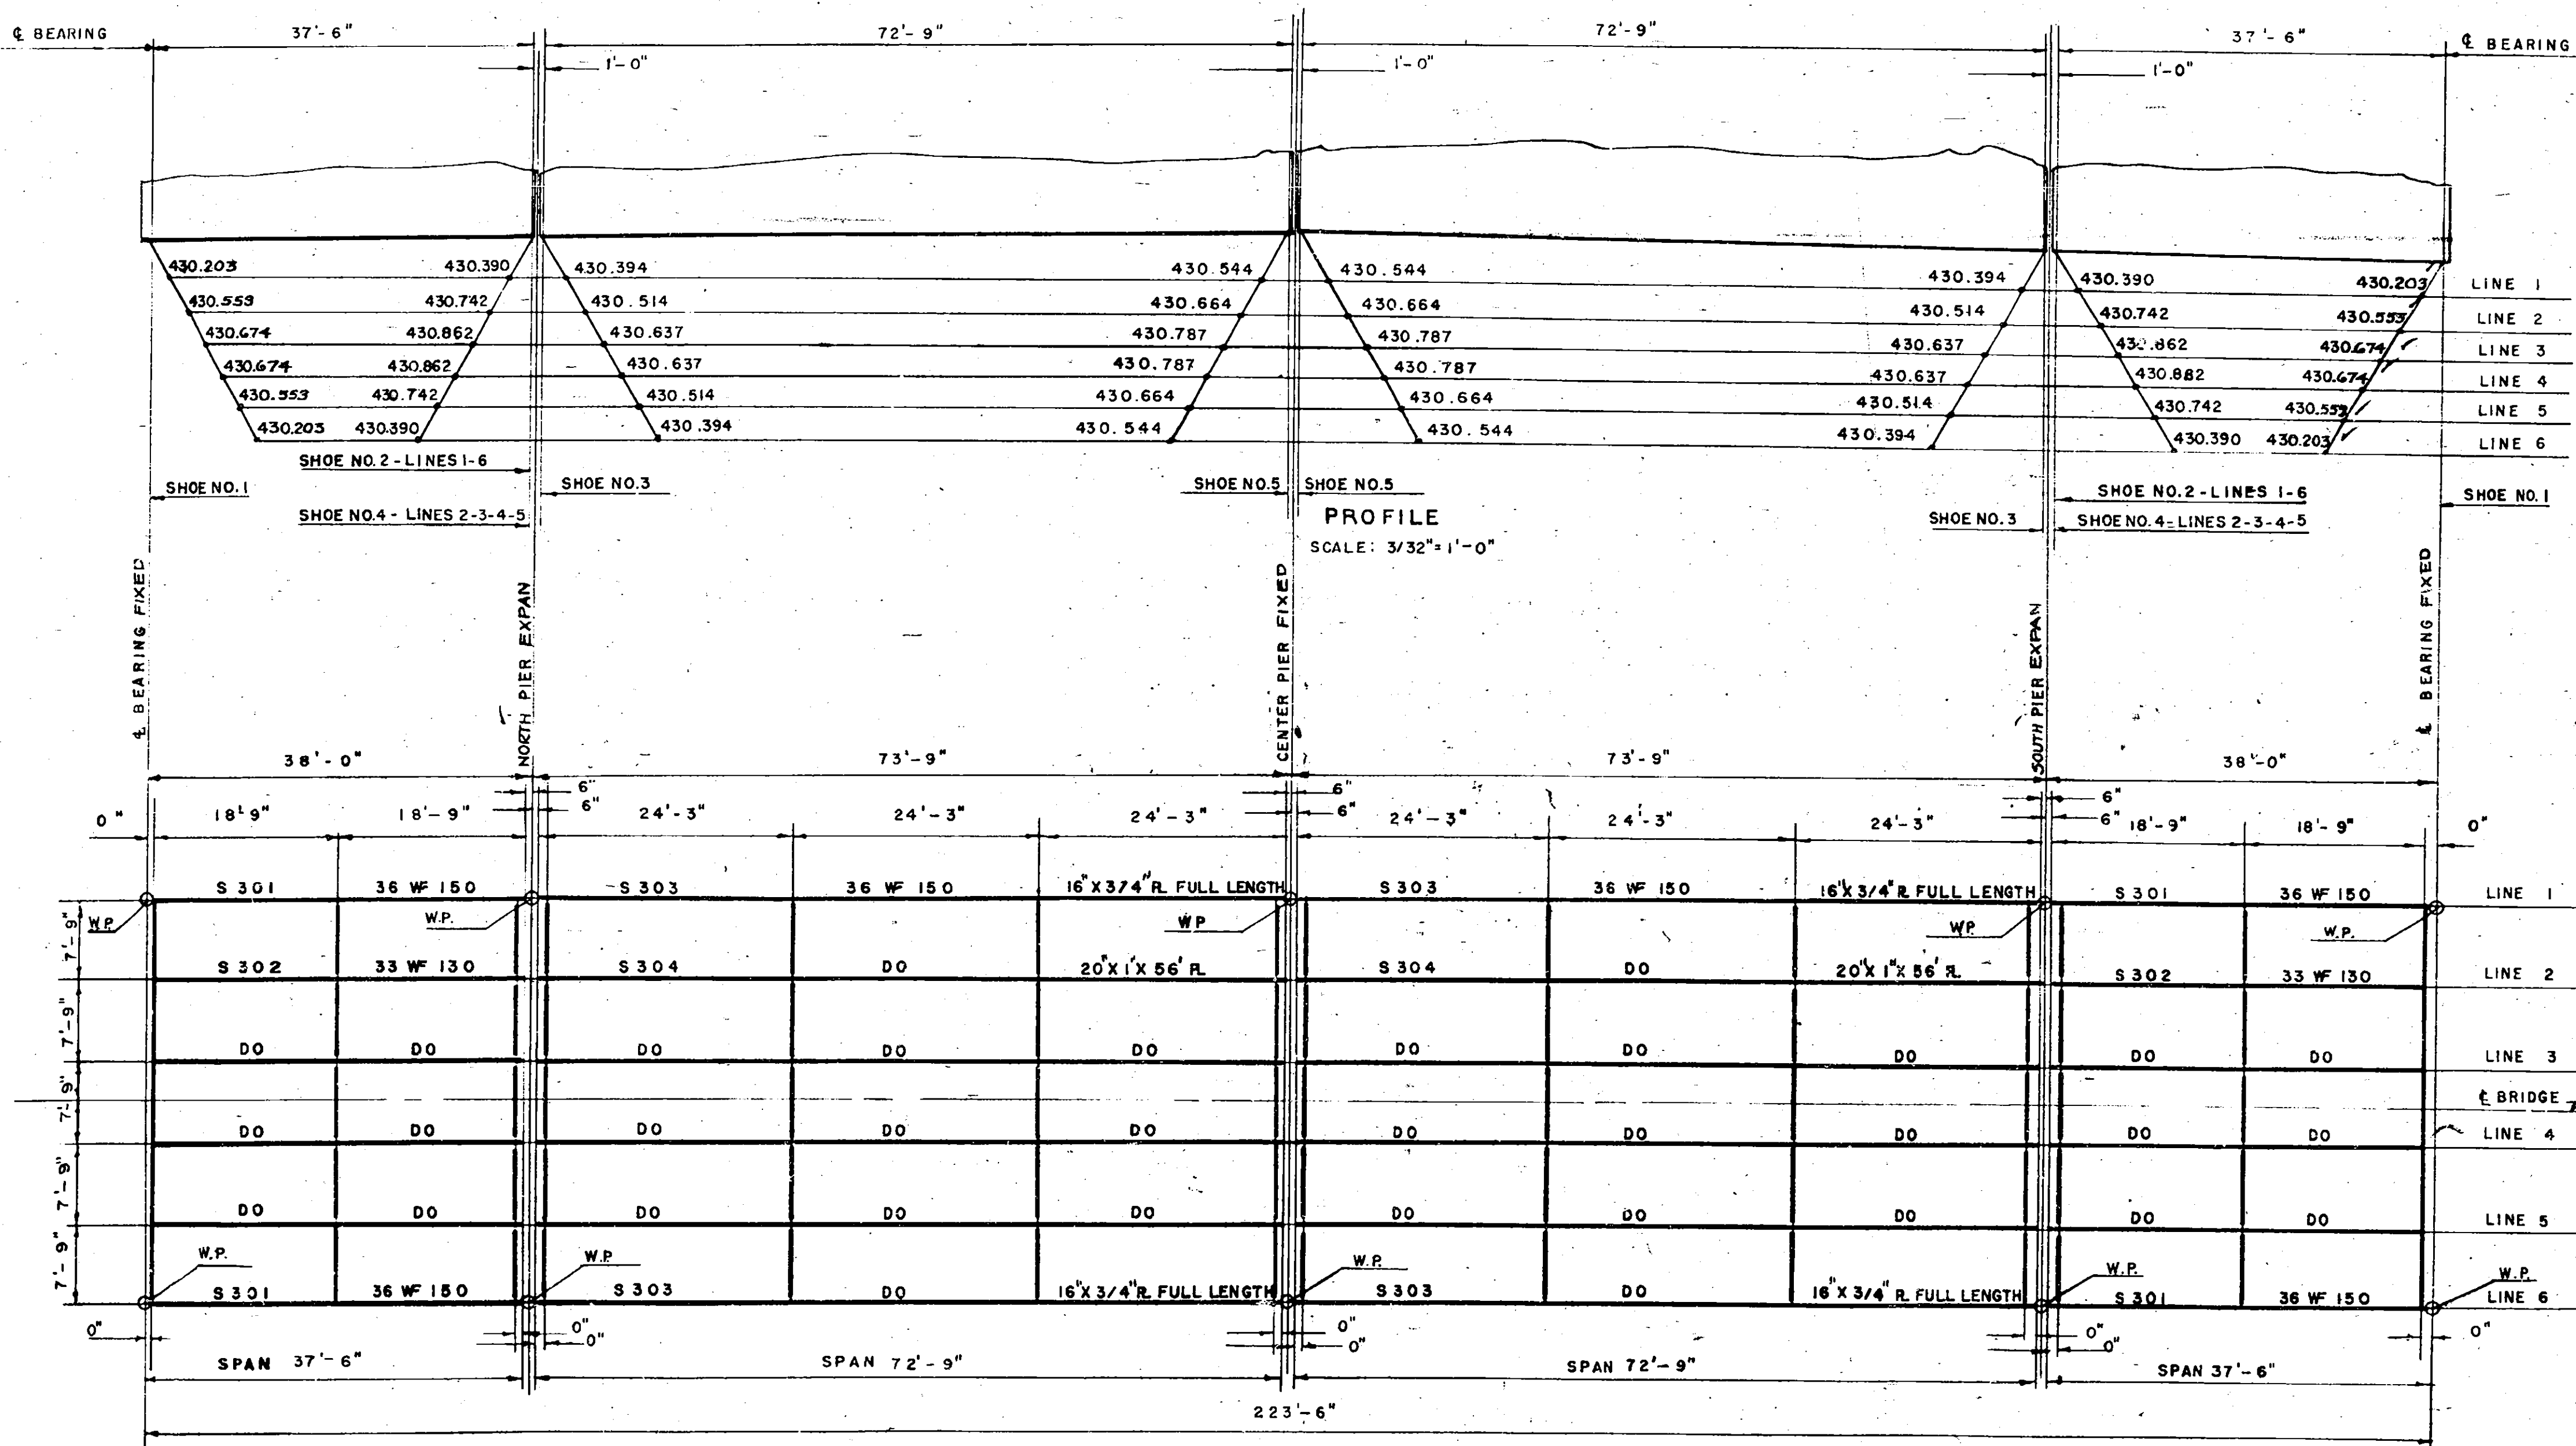


NOTE
ELEVATIONS ARE TO
BOTTOM OF BOTTL
FLANGE.

BUILT ACCORDING TO PLAN

SUPERSTRUCTURE DETAILS
KINNE STREET
MOHAWK SECTION
NEW YORK STATE THRUWAY

COUNTY	SHEET NO.	TOTAL SHEETS
ONONDAGA	61	66
N.Y. STATE THRUWAY, MOHAWK SECTION, SUBDIV. 8B		
INTERCHANGE AT THOMPSON ROAD		

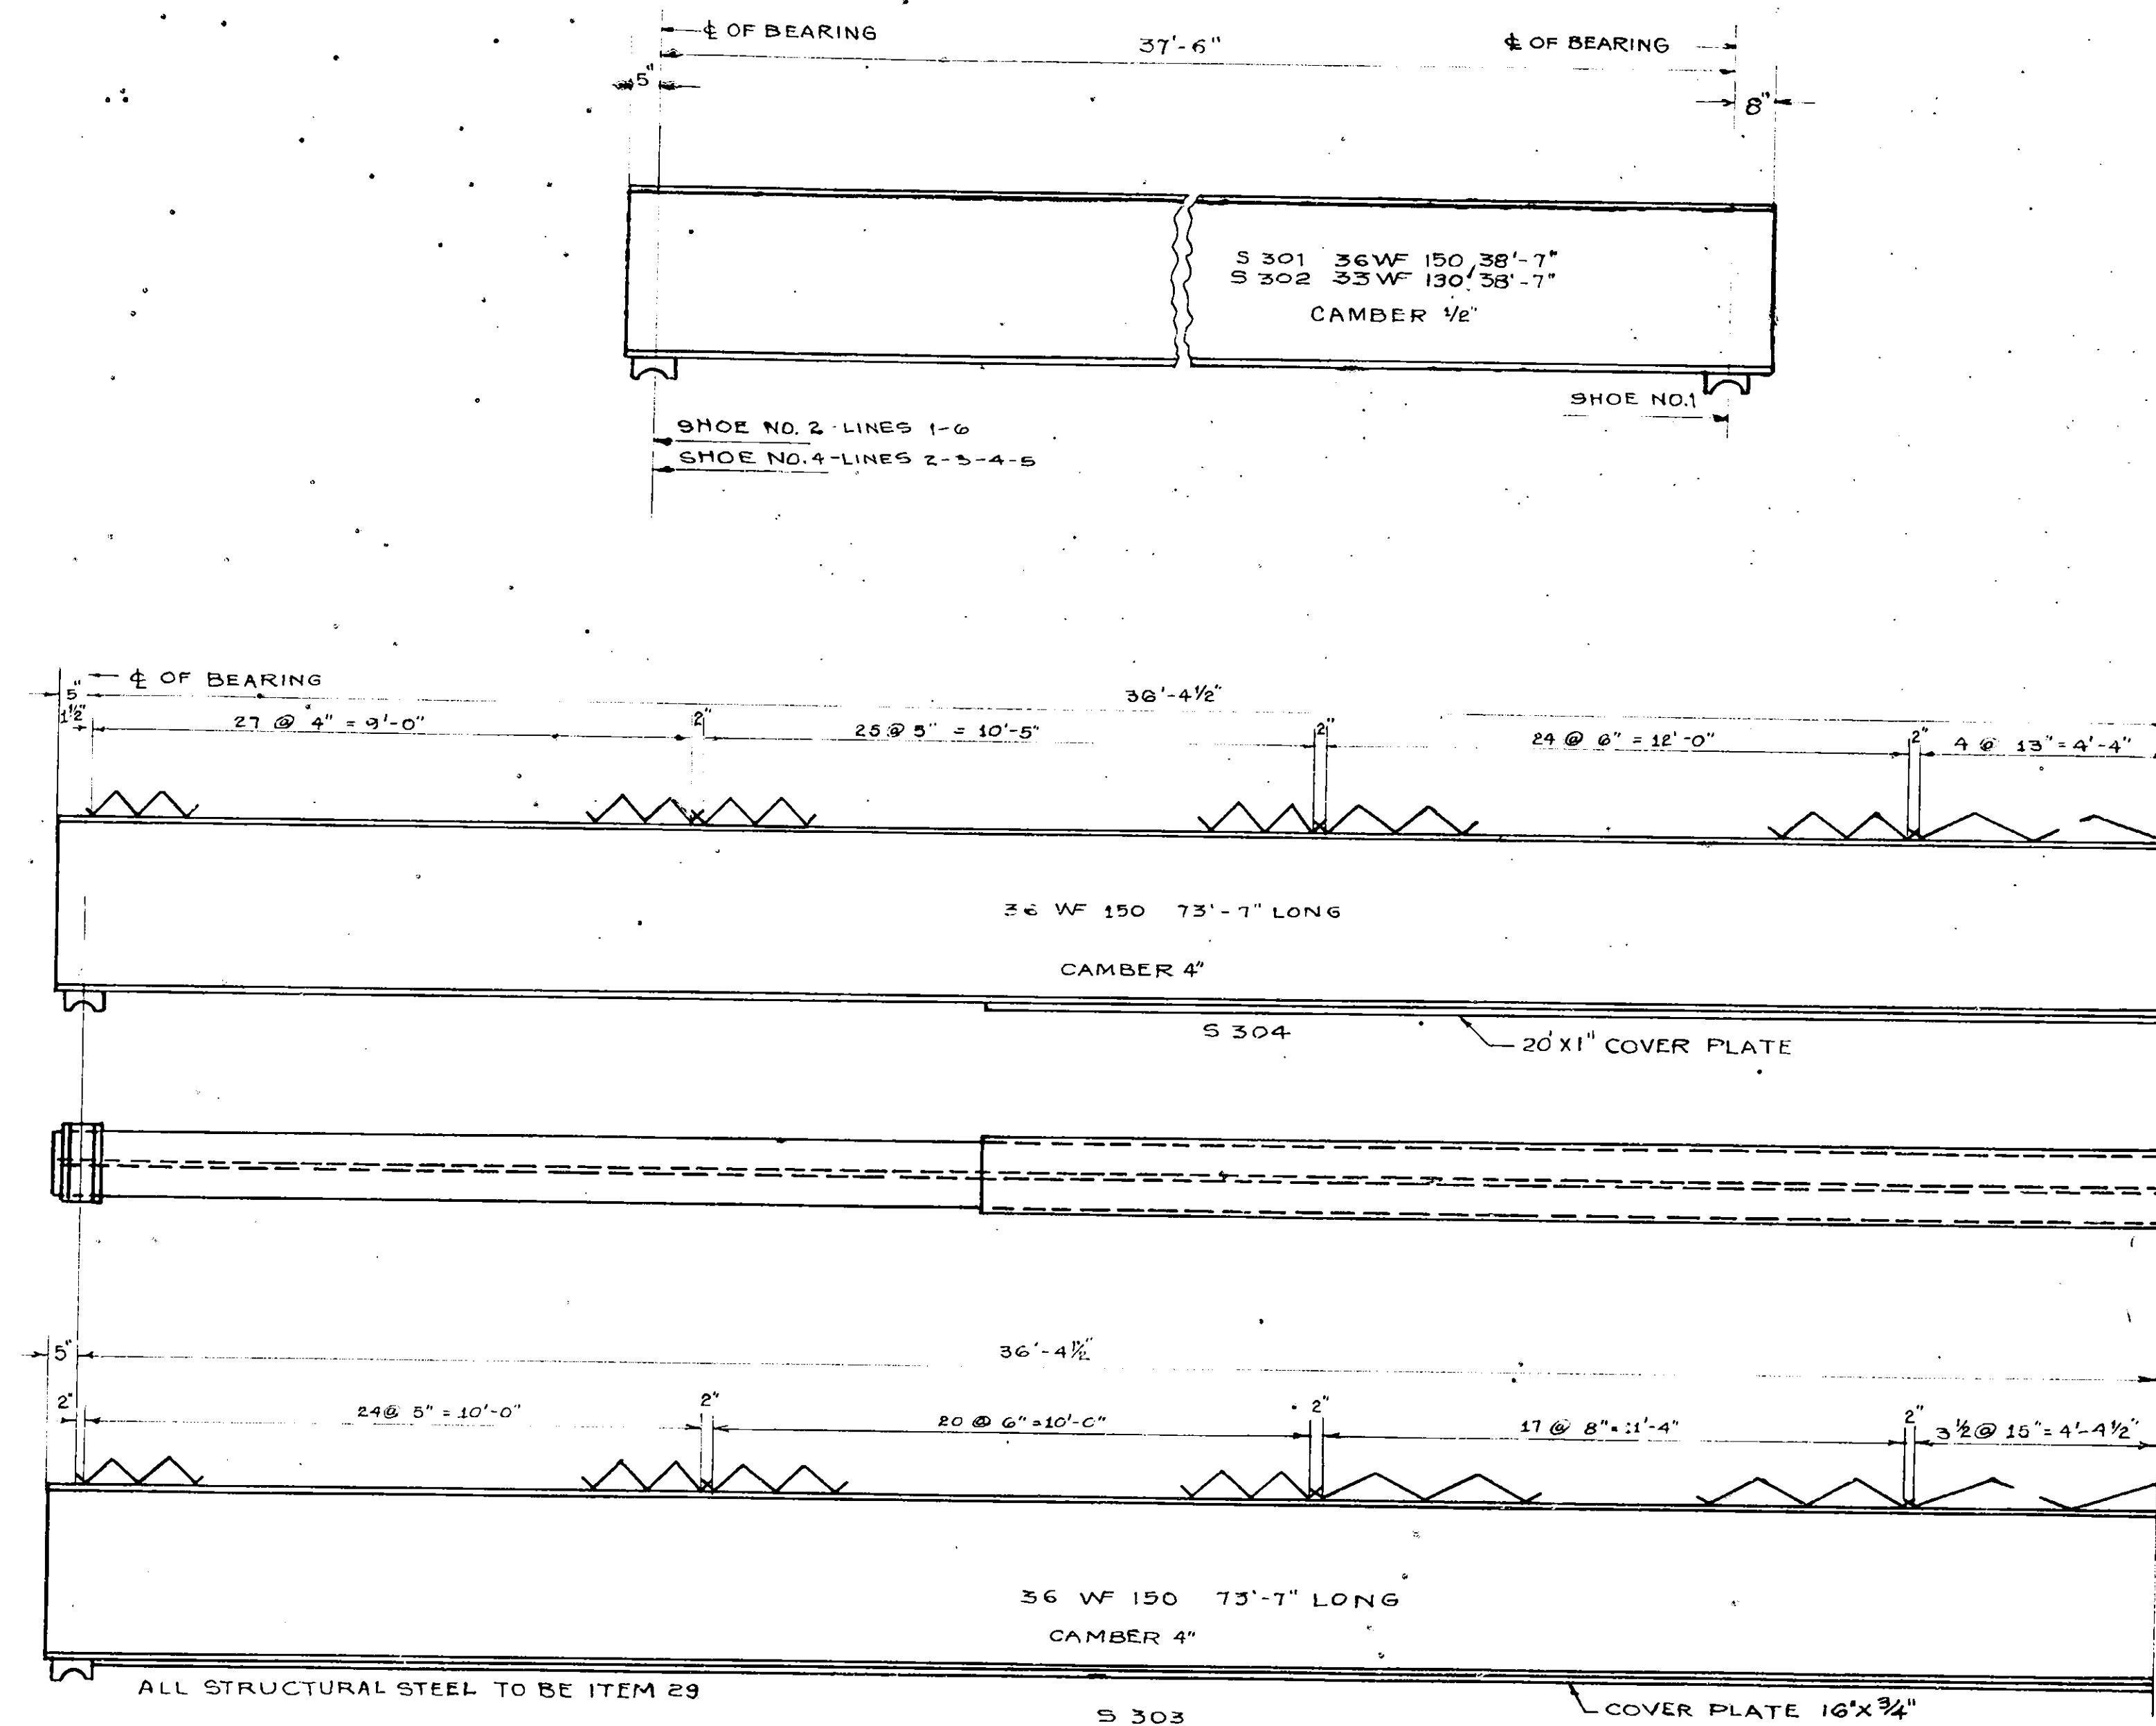


NOTE:


ALL COVER PLATES
TO BE WELDED WITH
5/16" CONTINUOUS
FILLET WELDS.

SCALE: 1/2" = 1'-0"
EXCEPT AS SHOWN
FOR SHOE DETAILS SEE SHEET 63


DO NOT PAINT SURFACE OF TOP FLANGE ON
WHICH WELDS ARE MADE

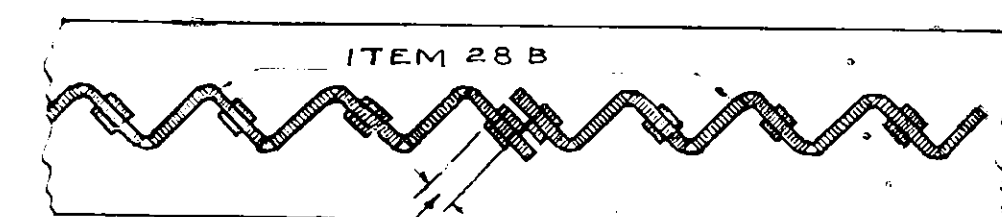

1/2" SPIRAL ROD 5/16"
FILLET WELD 1 1/2"
LONG ON EACH SIDE
OF ROD.

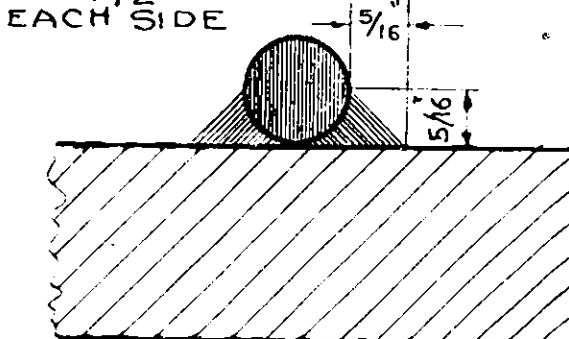

5" MEAN DIAMETER
OF 1/2" SPIRALS

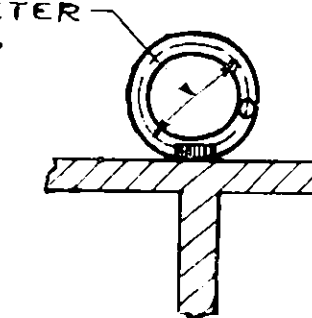

NOTE:
EXTEND BAR
1/4 TURN BEYOND
END WELDS OF
UNIT

SPIRAL DETAILS

NOT TO SCALE
ALL SPIRAL SHEAR BARS ARE ITEM 28 B

SPECIAL NOTES FOR SPIRALS

THE CONTRACTOR'S AND ENGINEER'S ATTENTION IS CALLED TO THE POSSIBILITY OF INTERFERENCE BETWEEN THE REINFORCING STEEL IN THE SLAB AND THE BEAM SPIRALS WHILE STEEL SPACING IS GIVEN AS 5 1/2 INCHES, IT IS TO BE UNDERSTOOD THAT 2 BARS IN EACH OF 11 IN. WILL FULFILL THIS REQUIREMENT. IF NO TWO BARS ARE CLOSER THAN 1" LESS THAN REQUIRED SPACING OR FURTHER APART THAN 1" MORE THAN REQUIRED SPACING. IF NECESSARY, SOME BARS MAY BE THREADED THRU ONE OR MORE SPIRALS. ALL SPIRALS MUST HAVE TWO STRUCTURAL WELDS 5/16" x 1 1/2" LONG, AT EACH SIDE OF THE BAR AS SHOWN, 5/32" OR 3/16" DIAMETER ELECTRODES SHALL BE USED IN WELDING THE SPIRAL BAR REINFORCEMENT. SPECIAL PRECAUTIONS MUST BE EXERCISED WHERE WELDING CROSS-ES. EDGE OF FLANGE TO AVOID ANY POSSIBILITY OF UNDERCUT OR NICKS IN THE EDGE OF FLANGE.

SUPERSTRUCTURE DETAILS

KINNE STREET

MOHAWK SECTION

NEW YORK STATE THRUWAY







PREPARED AND RECOMMENDED:

UROUHART & COYLE CONSULTING ENGINEERS
NEW YORK STATE PROFESSIONAL ENGINEERS LICENSE NO. 5667



DATE

Feb 16-53


COUNTY			SHEET NO.	TOTAL SHEETS
ONONDAGA			63	66
N.Y. STATE THRUWAY, MOHAWK SECTION SUBDIV. 8B.				
INTERCHANGE AT THOMPSON ROAD				

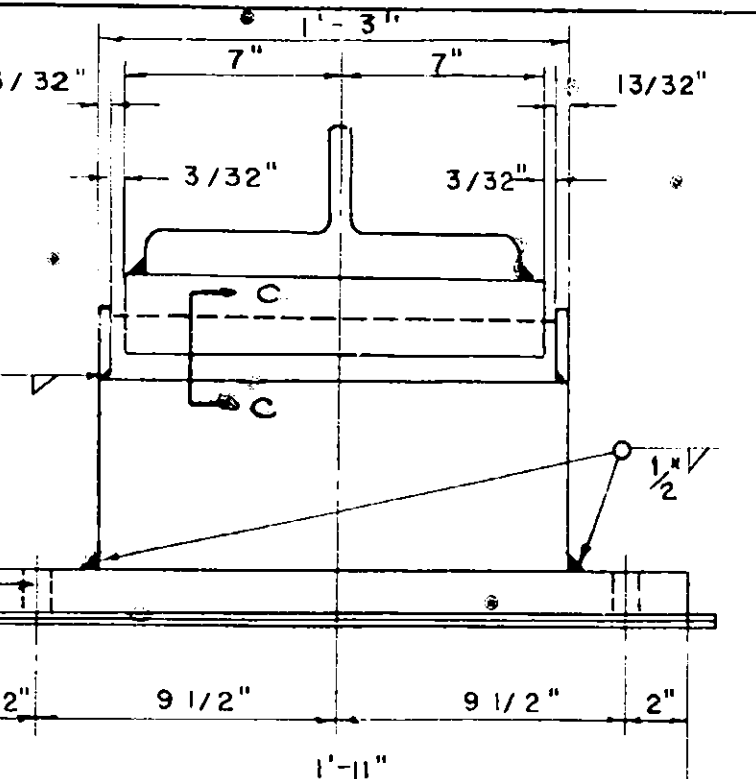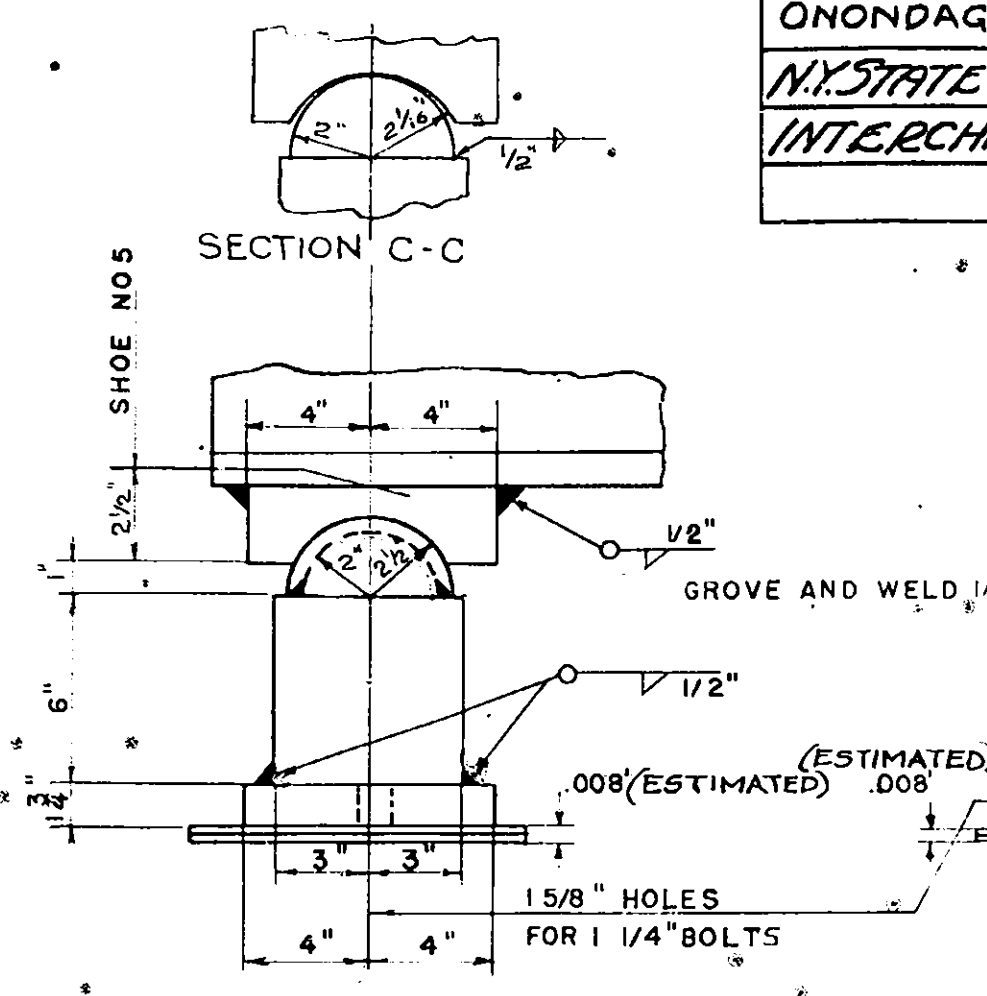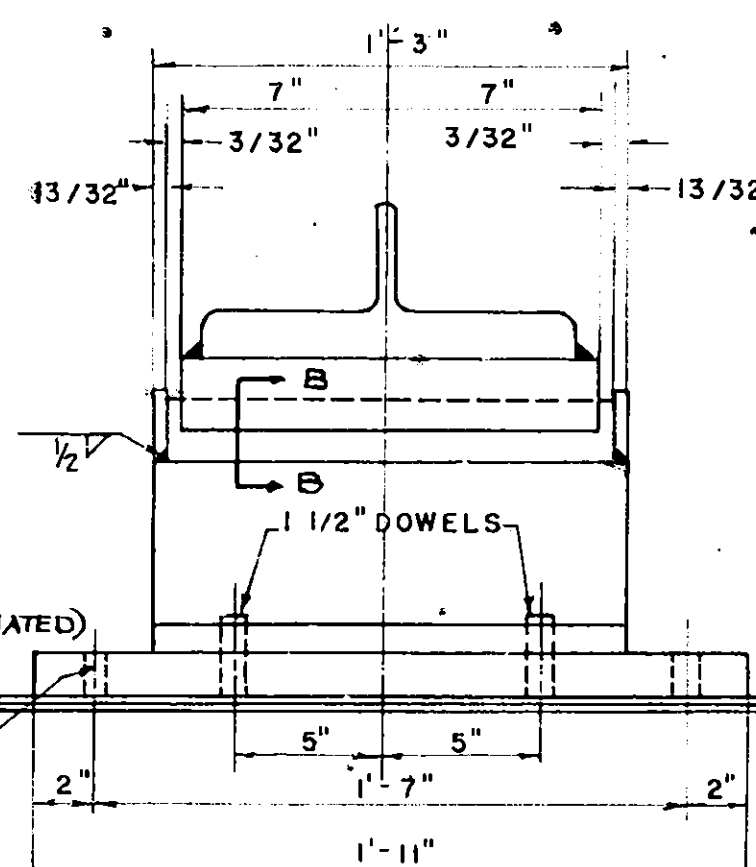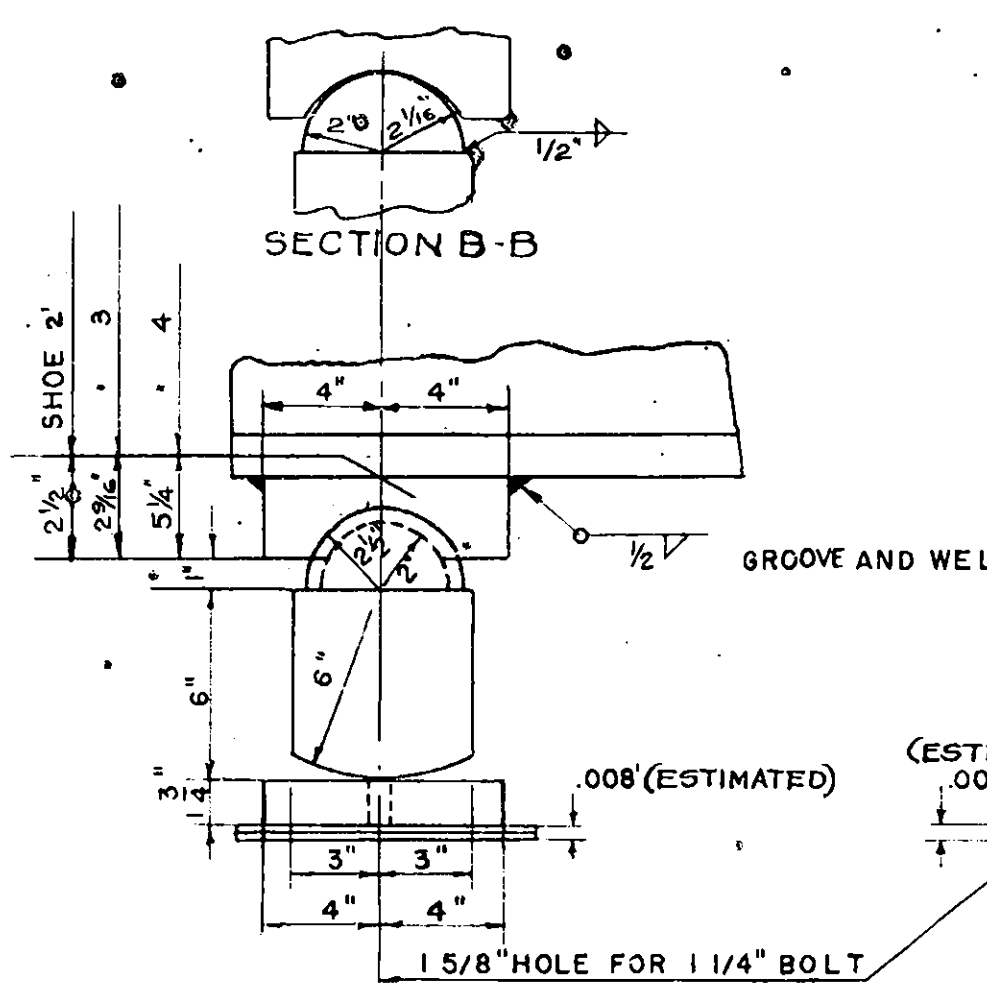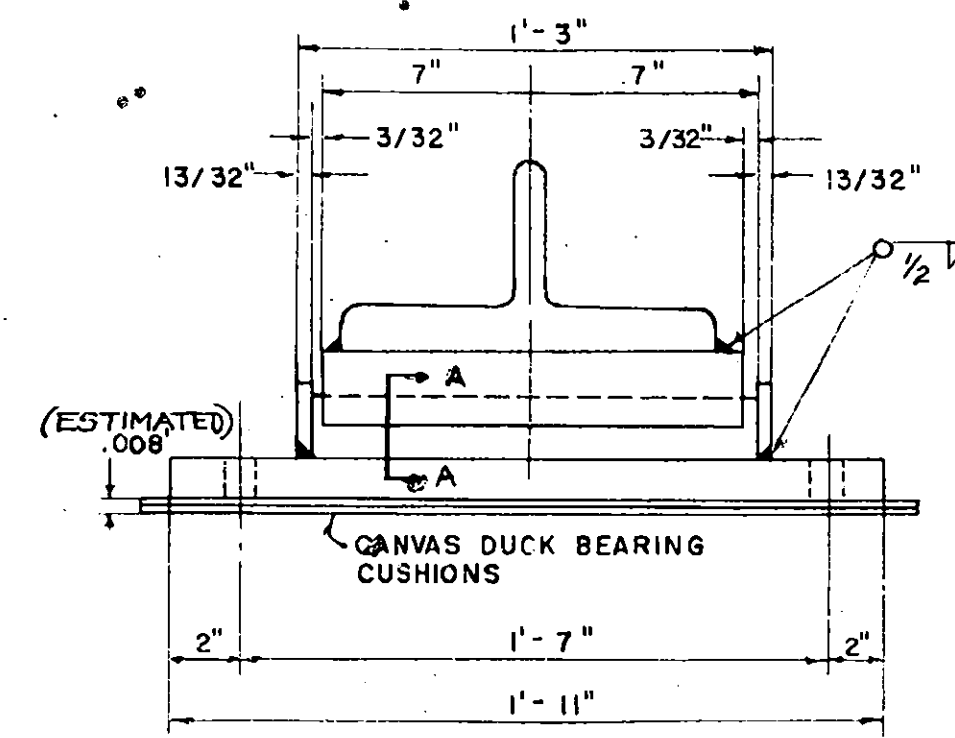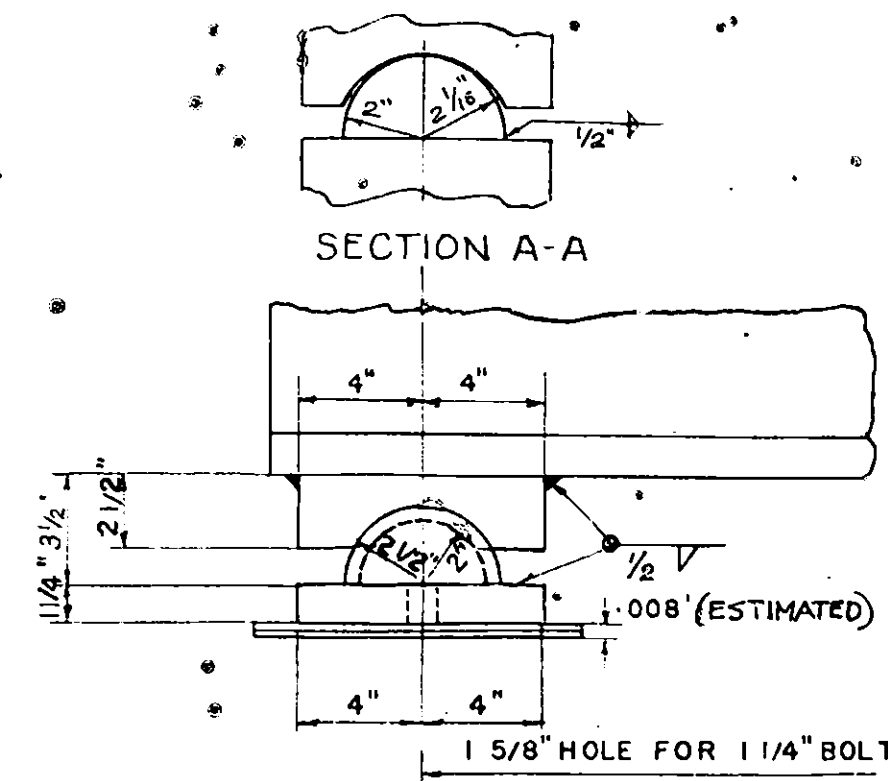


NOTE:
1/2" WELD ON ALL SHOES

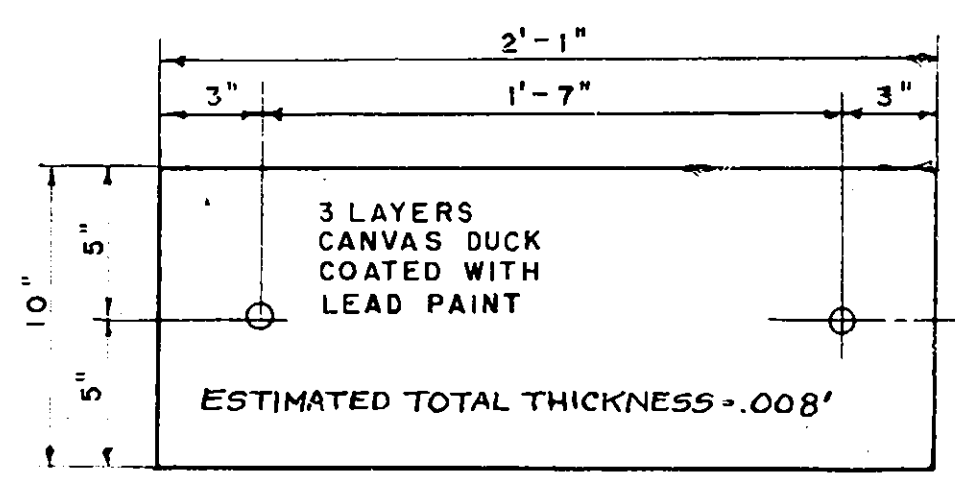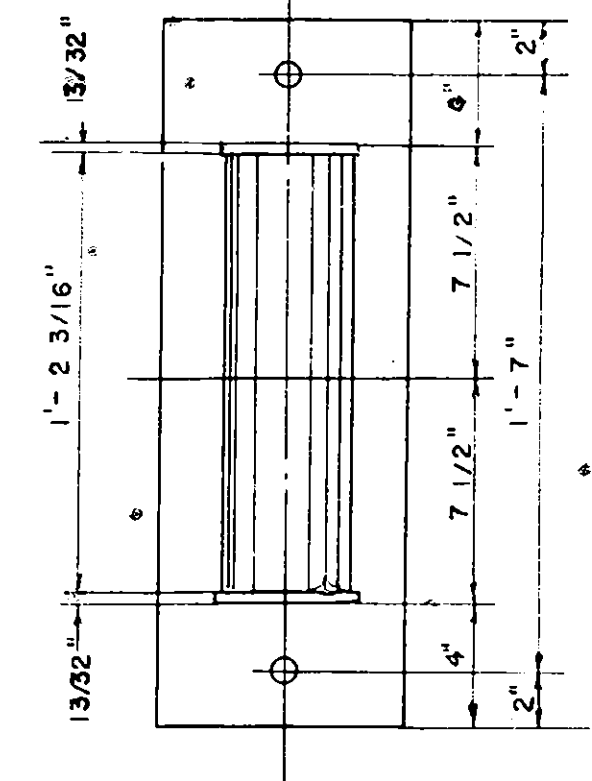



CANVAS DUCK BEARING CUSHION

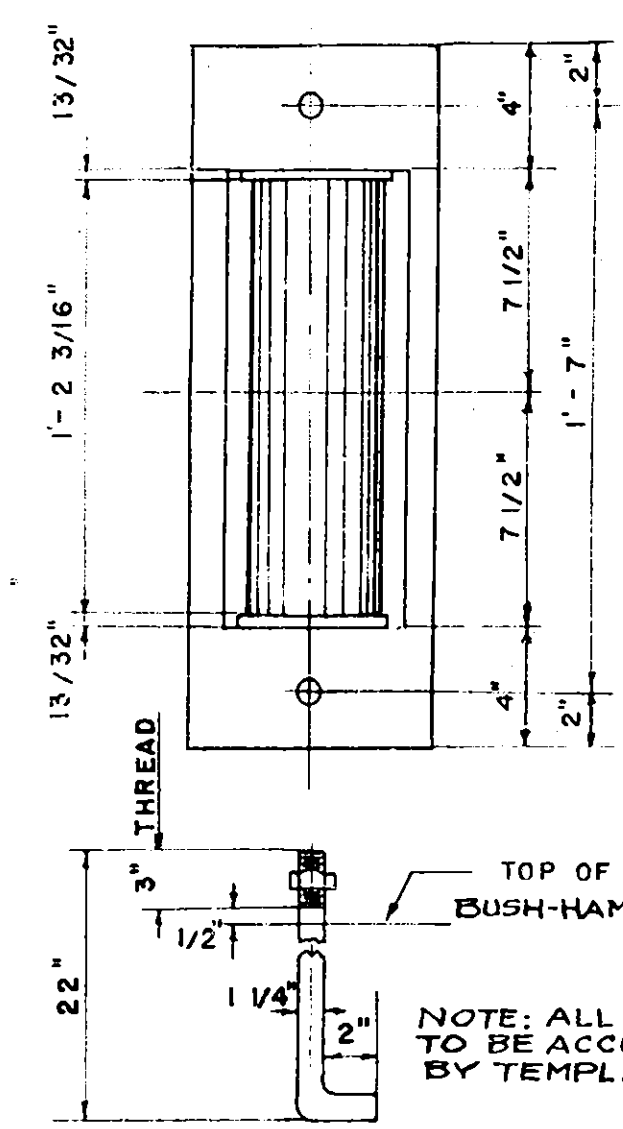

SHOES 2, 3, 4.

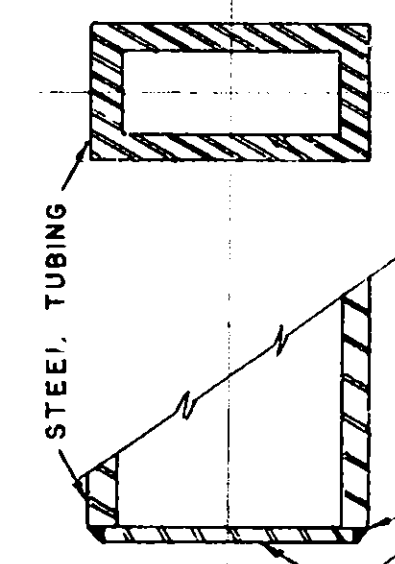


1/8" CONTINUOUS FILLET
WELD ALL AROUND
GRIND EDGES FOR
SMOOTH FINISH
AFTER WELDING

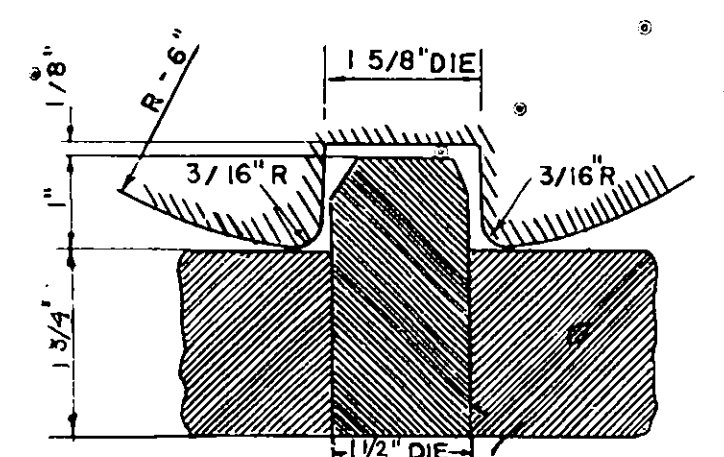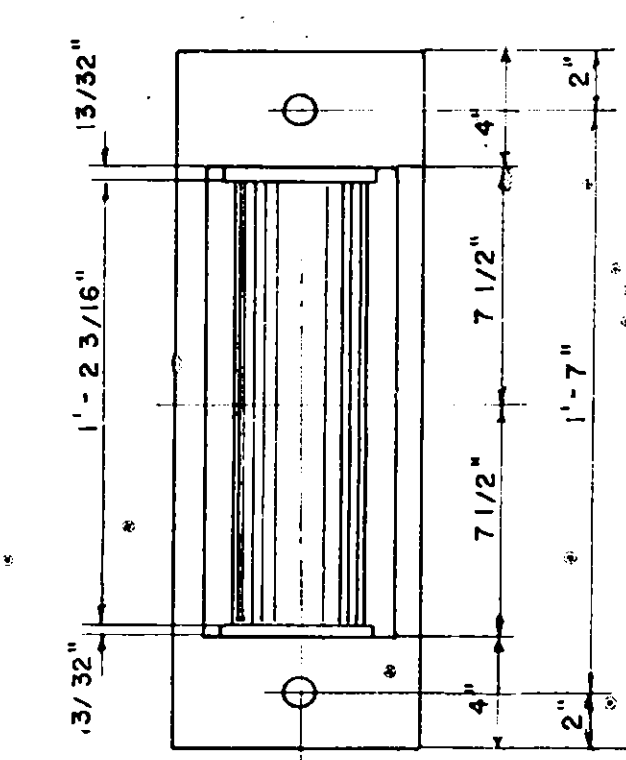

SECTION THRU DOWEL
SCALE HALF SIZE


ALL SHOES ITEM 29

SCALE OF SHOES 2"=1'-0"

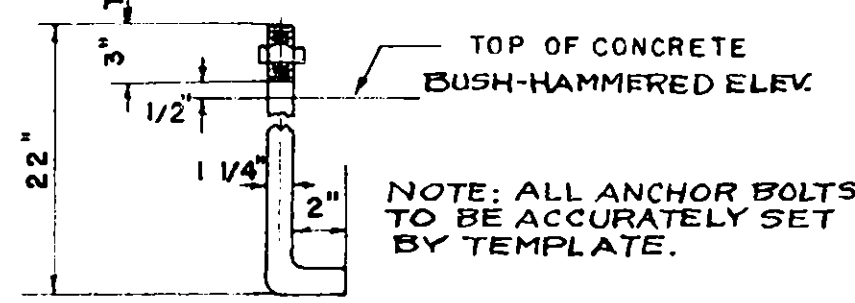


DETAIL AT ENDS
OF RAILS
NOT TO SCALE

DETAIL OF ANCHOR BOLT

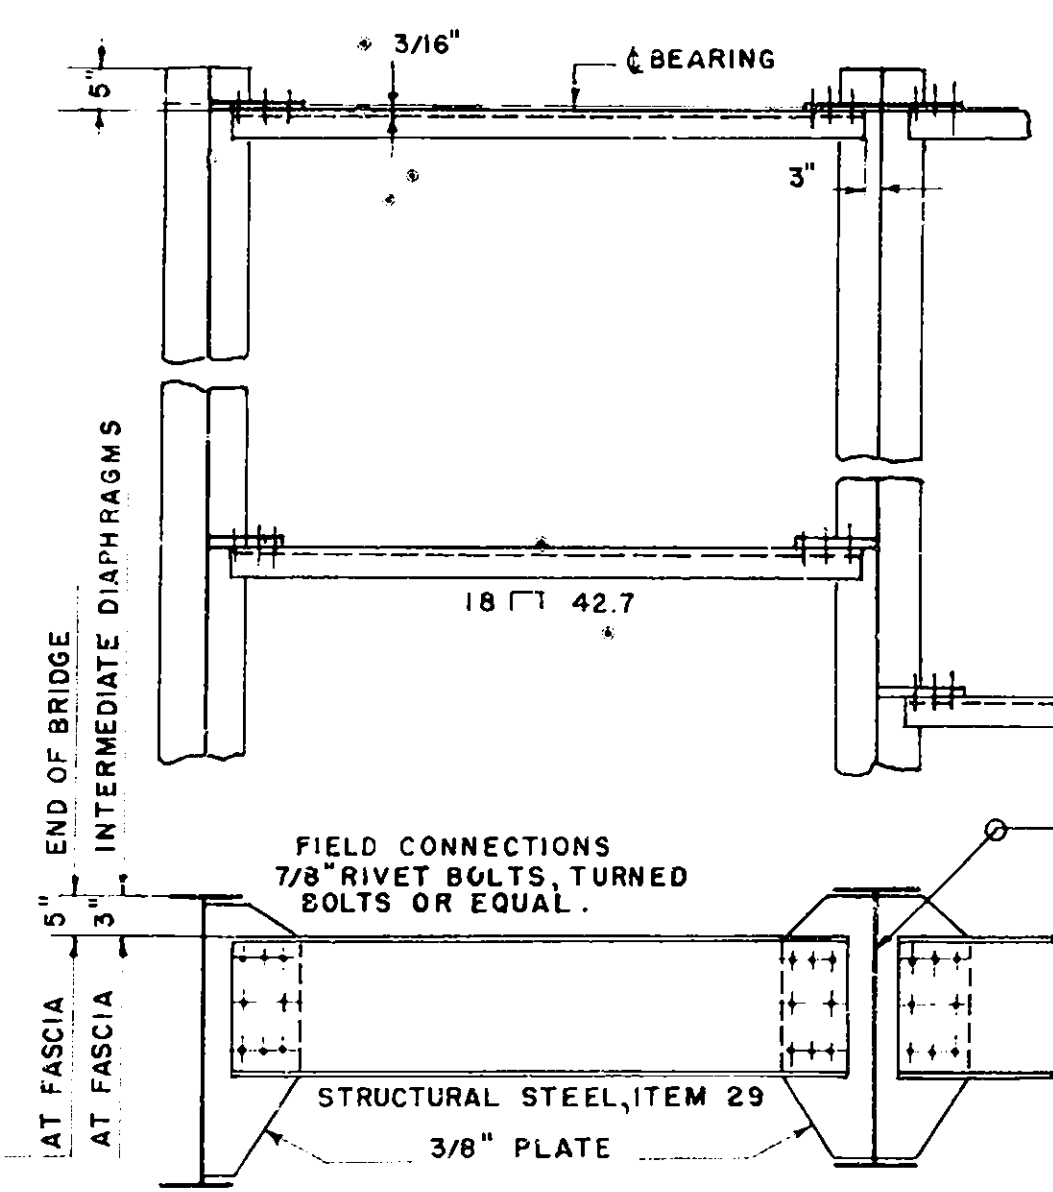

TYPICAL DIAPHRAGM DETAILS

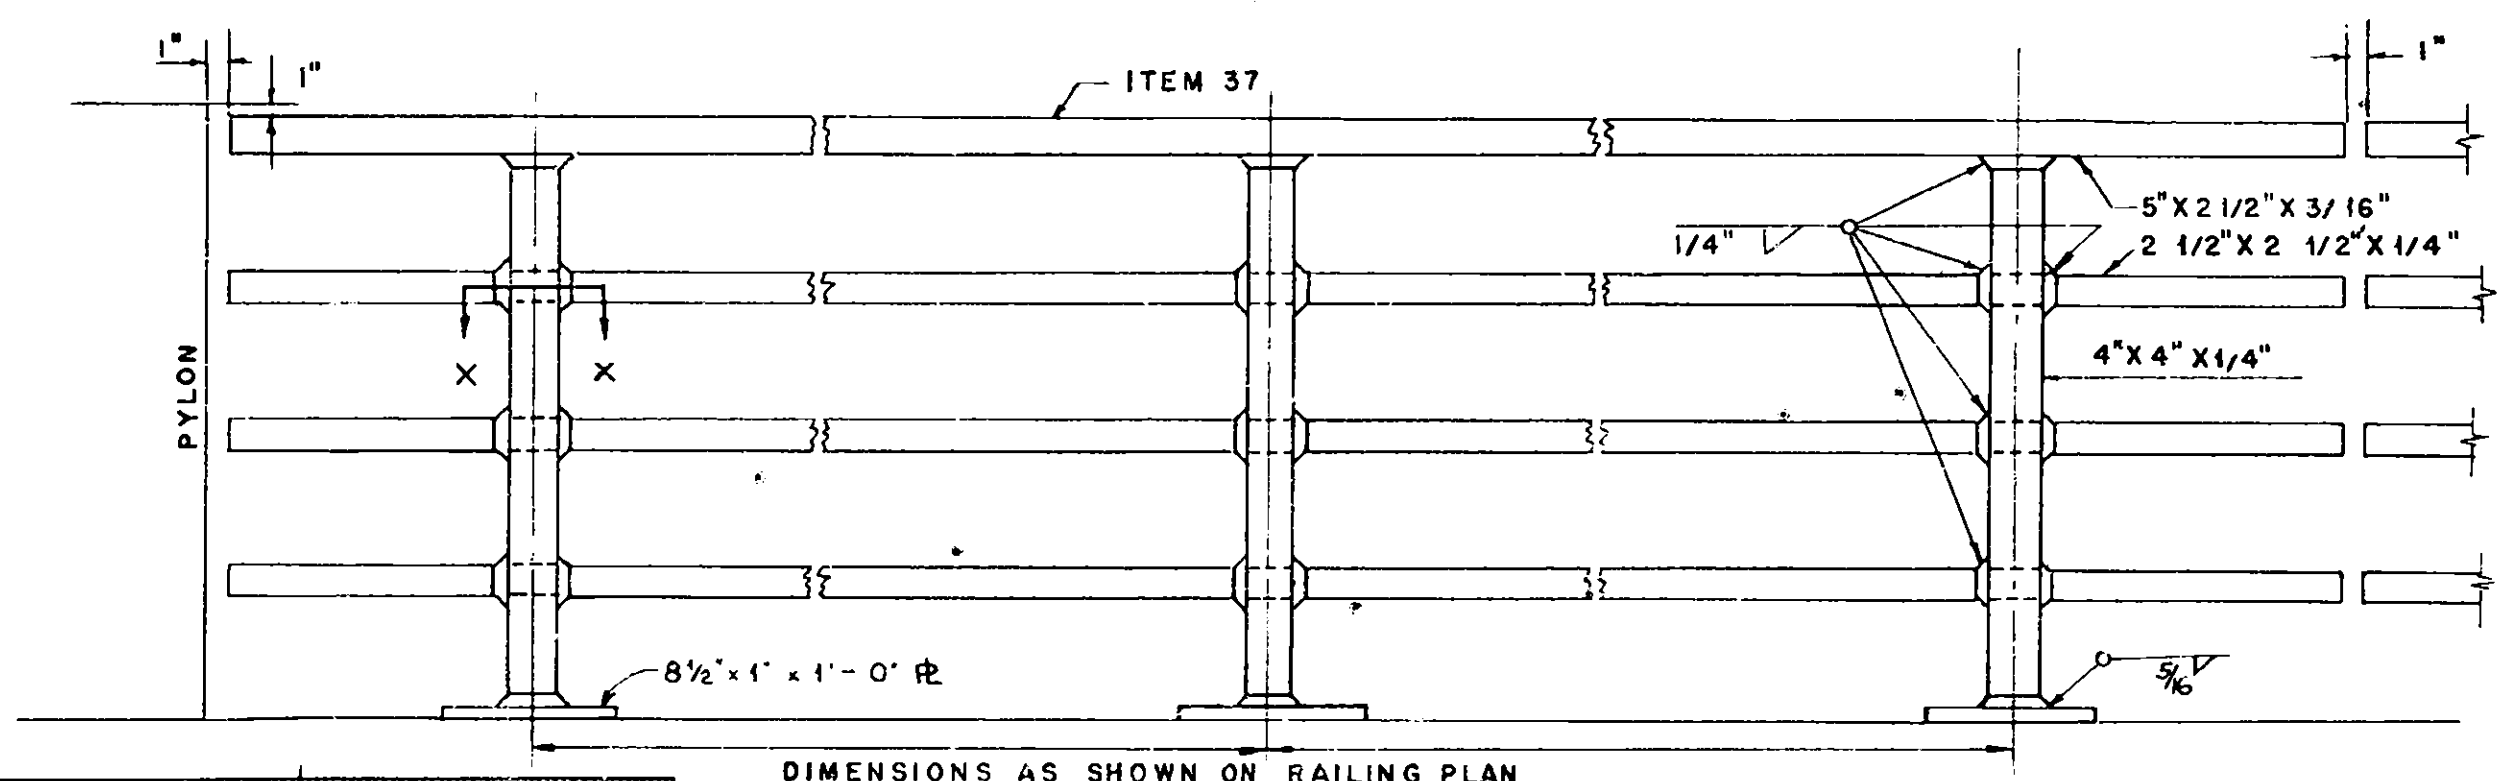


DIMENSIONS AS SHOWN ON RAILING PLAN

TYPICAL RAILING DETAIL
SCALE 1"=1'-0"


NOTE:

WHERE STEEL EXCEEDING ONE INCH IN THICKNESS IS TO BE WELDED, MILD STEEL LOW-ARC WELDING ELECTRODES WITH COVERING OF LOW-HYDROGEN TYPE SHALL BE USED. THE ELECTRODES MUST COMPLY WITH A. S. T. M. A 233-48T REQUIREMENT FOR CLASSIFICATION 6015 E 60. ALL RAILINGS ARE TO BE FABRICATED AND ERECTED SO THAT RAILS ARE PARALLEL TO EACH OTHER AND TO THE TOP OF FASCIA AND POSTS ARE TRULY VERTICAL.


FOR NOTES AND DETAILS NOT SHOWN SEE SHEET 53-106.

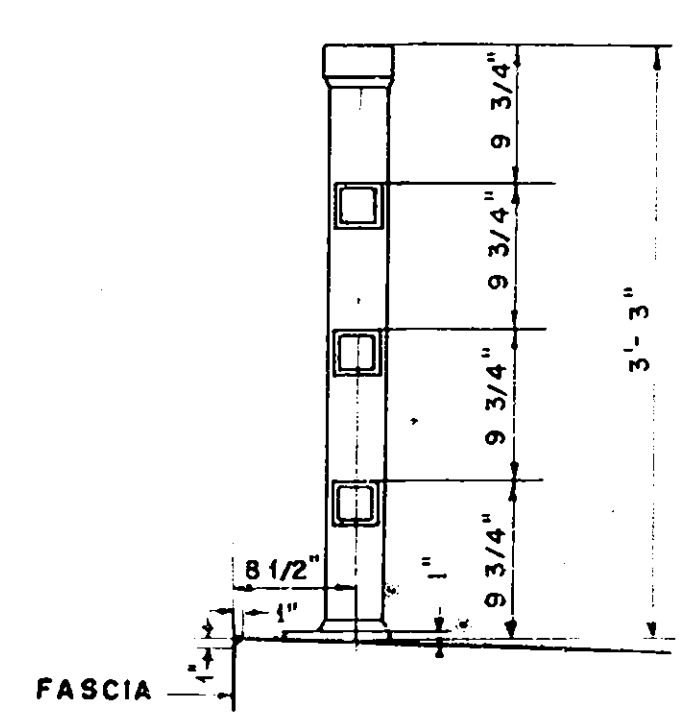

SECTION THRU RAILING

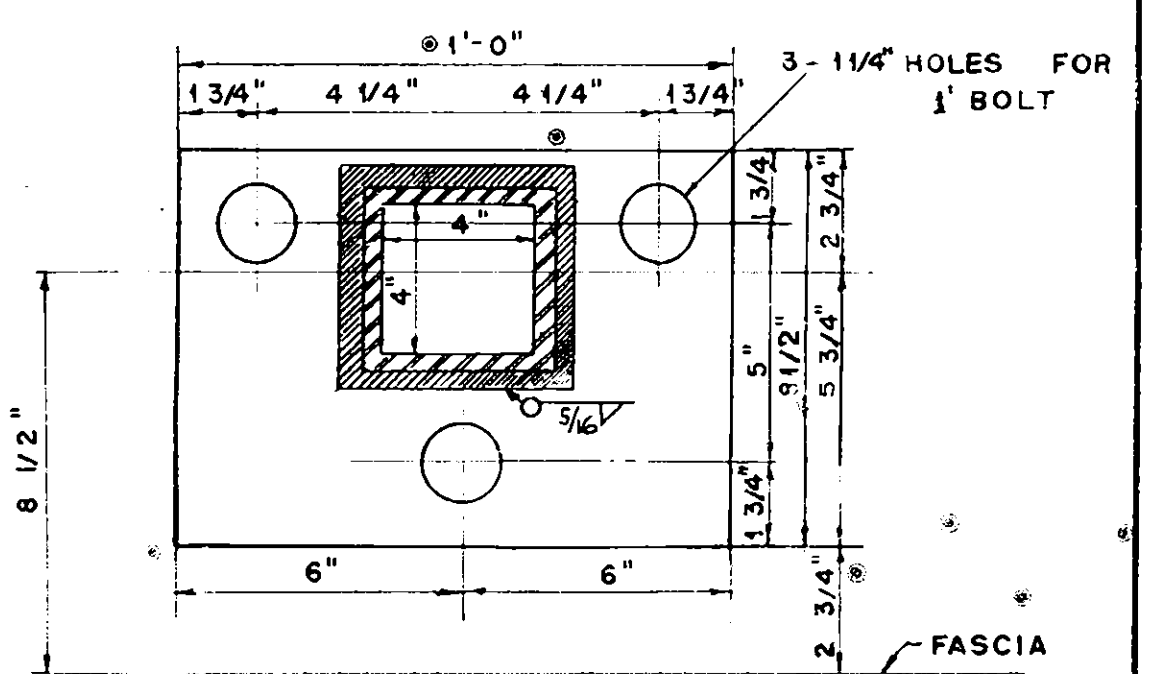

RAIL POST BASE PLATE
SCALE 3"-1'-0"

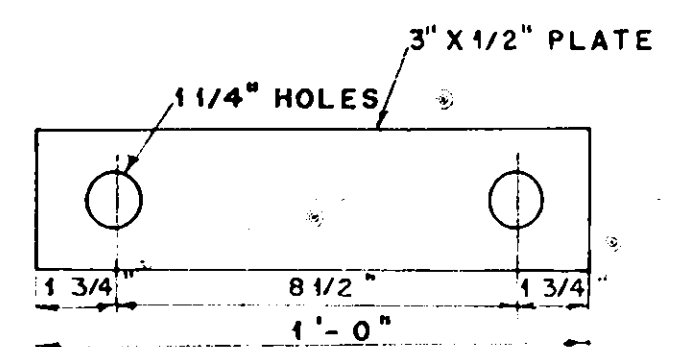

RAILING ANCHOR PLATE
SCALE 3"=1'-0"

SUPERSTRUCTURE DETAILS
KINNE STREET
MOHAWK SECTION
NEW YORK STATE THRUWAY


PREPARED AND RECOMMENDED

URQUHART & DOYLE, CONSULTING ENGINEERS
NEW YORK STATE PROFESSIONAL ENGINEERS LICENSE NO 5667

DATE

SECTION XX FULL SCALE


COUNTY	SHEET NO	TOTAL SHEETS
ONONDAGA	64	66
N.Y. STATE THRUWAY, MOHAWK SECTION SUBDIV. 8B.		
INTERCHANGE AT THOMPSON ROAD		

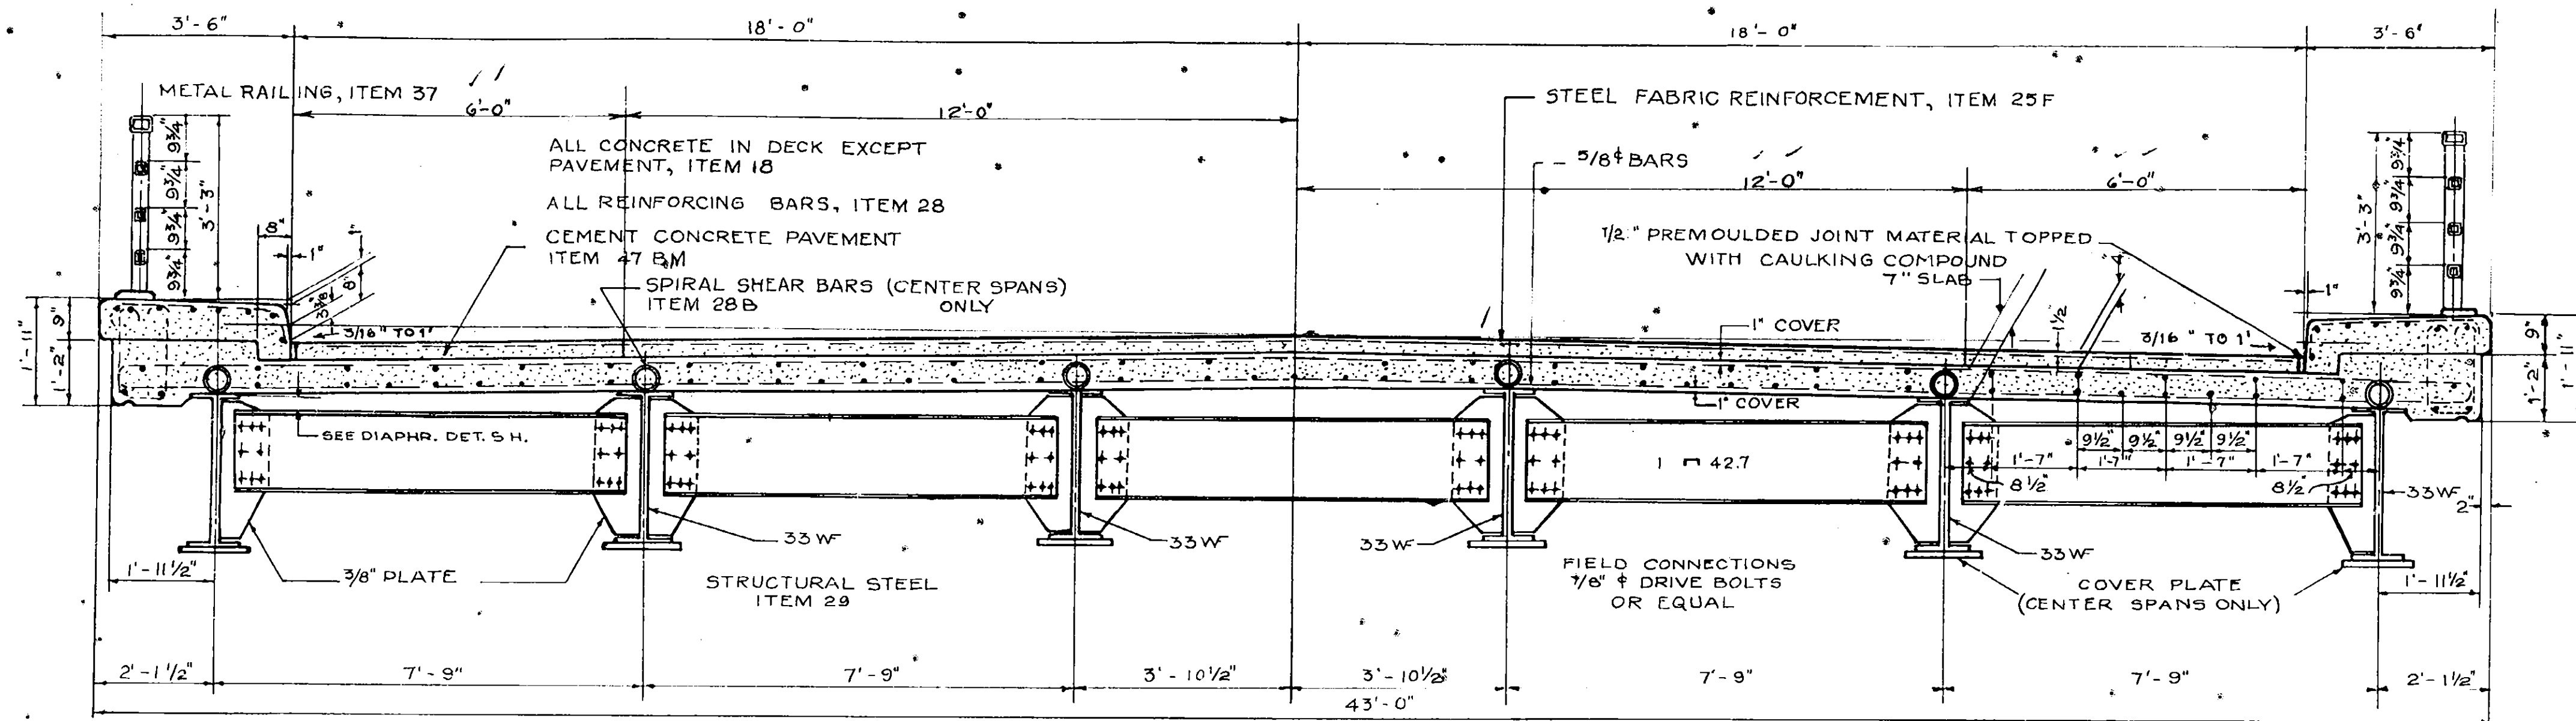

TRANSVERSE SECTION
SCALE 1/2" = 1'-0"


NOTE:
IMMEDIATELY BEFORE PLACING CONCRETE PAVEMENT, THE CONCRETE SURFACE OR SURFACES UPON WHICH IT IS TO BE PLACED SHALL BE THOROUGHLY WETTED DOWN CONTINUOUSLY FOR ONE HOUR IF THE AIR TEMPERATURE IS ABOVE 50°F. COST OF SAME TO BE UNDER ITEM 1WA.

CEMENT IN ITEM 47BM TO BE PORTLAND CEMENT TYPE 1A, ITEM 15-8A.
CEMENT IN ITEMS 18 & 19 TO BE 2 PARTS PORTLAND CEMENT TYPE 2, ITEM 15-2 AND ONE PART NATURAL CEMENT TYPE N- ITEM 15N.

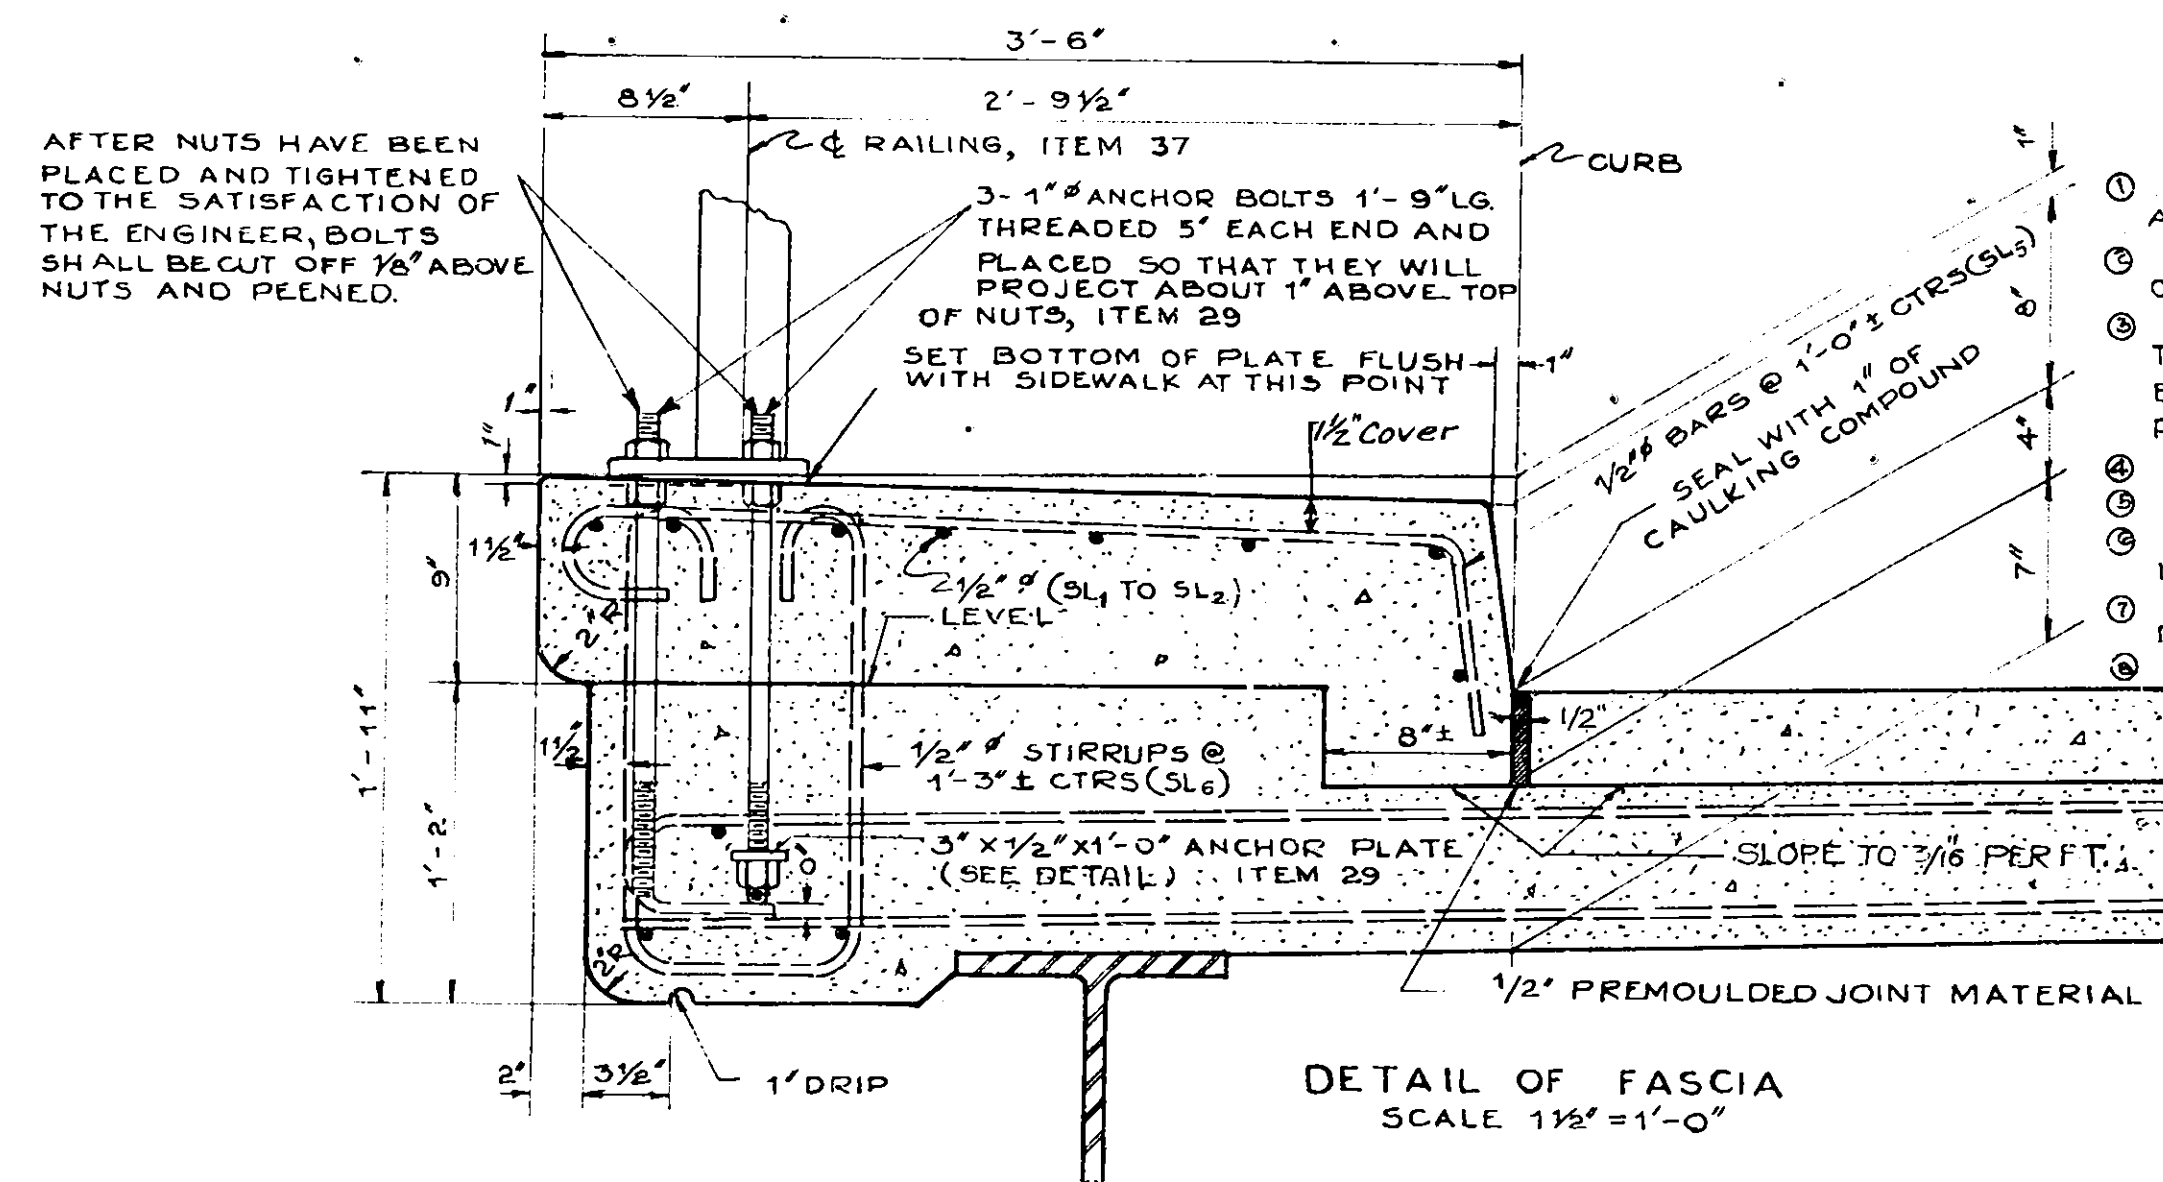


DETAIL OF FASCIA
SCALE 1 1/2" = 1'-0"

- CONSTRUCTION PROCEDURE
1. SET ANCHOR BOLTS BY MEANS OF TEMPLATE AND POUR SLAB.
 2. MAKE TWO APPLICATIONS OF WATER-PROOFING OIL TREATMENT M41-W TO TOP OF SLAB.
 3. THE TOP OF THE SLAB SHALL BE CONTINUOUSLY AND THOROUGHLY WETTED DOWN, AS DIRECTED BY THE ENGINEER FOR AT LEAST ONE HOUR, IMMEDIATELY PRIOR TO THE PLACING OF THE ROADWAY PAVEMENT.
 4. POUR ROADWAY PAVEMENT.
 5. PLACE LOWER NUTS ON UPPER END OF ANCHOR BOLTS
 6. PLACE RAILING ON LOWER NUTS AND ADJUST TO LINE AND GRADE.
 7. PLACE UPPER NUTS ON ANCHOR BOLTS TIGHTEN DOWN ON PLATES.
 8. POUR SIDEWALK TO PROPER LINE AND GRADE.

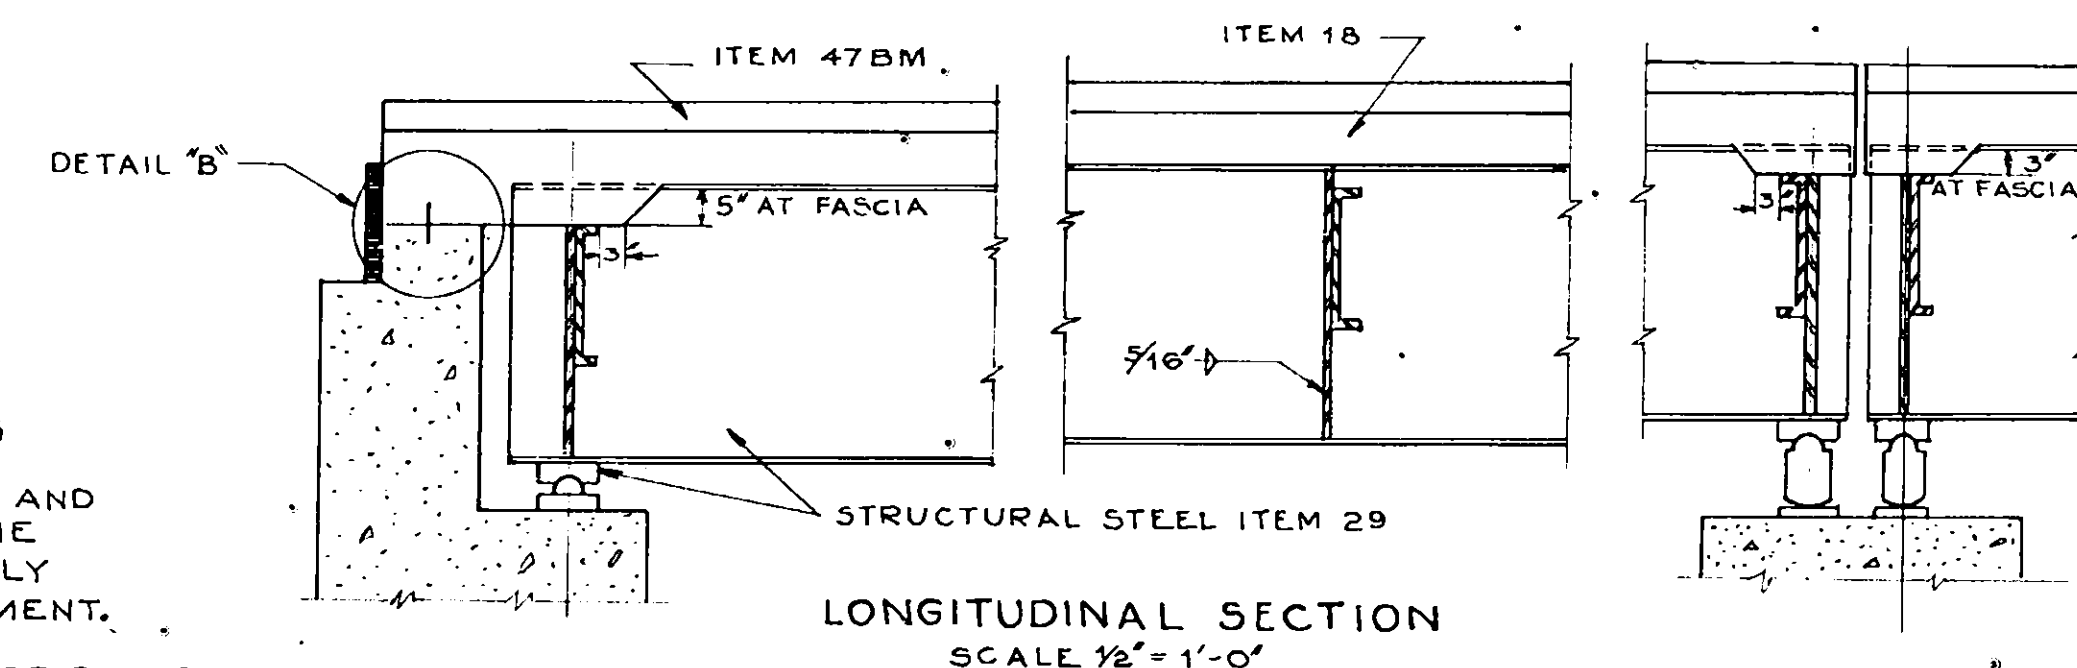


LONGITUDINAL SECTION
SCALE 1/2" = 1'-0"

NOTE:
ALL DIAPHRAGMS SET LEVEL. INTERMEDIATE DIAPHRAGMS PERPENDICULAR TO GIRDERS WITH TOPS 3" BELOW TOP OF FASCIA GIRDERS. TOPS OF END DIAPHRAGMS 5" BELOW TOP OF FASCIA GIRDERS.

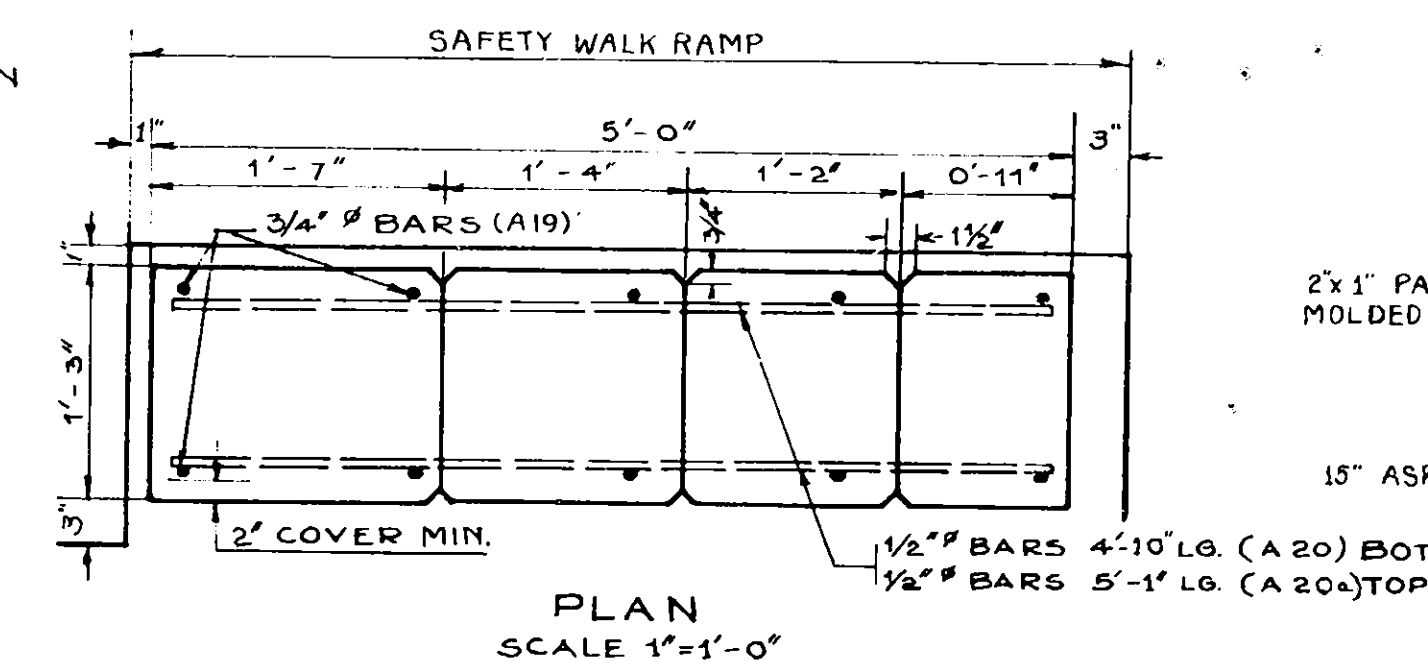


PLAN
SCALE 1" = 1'-0"

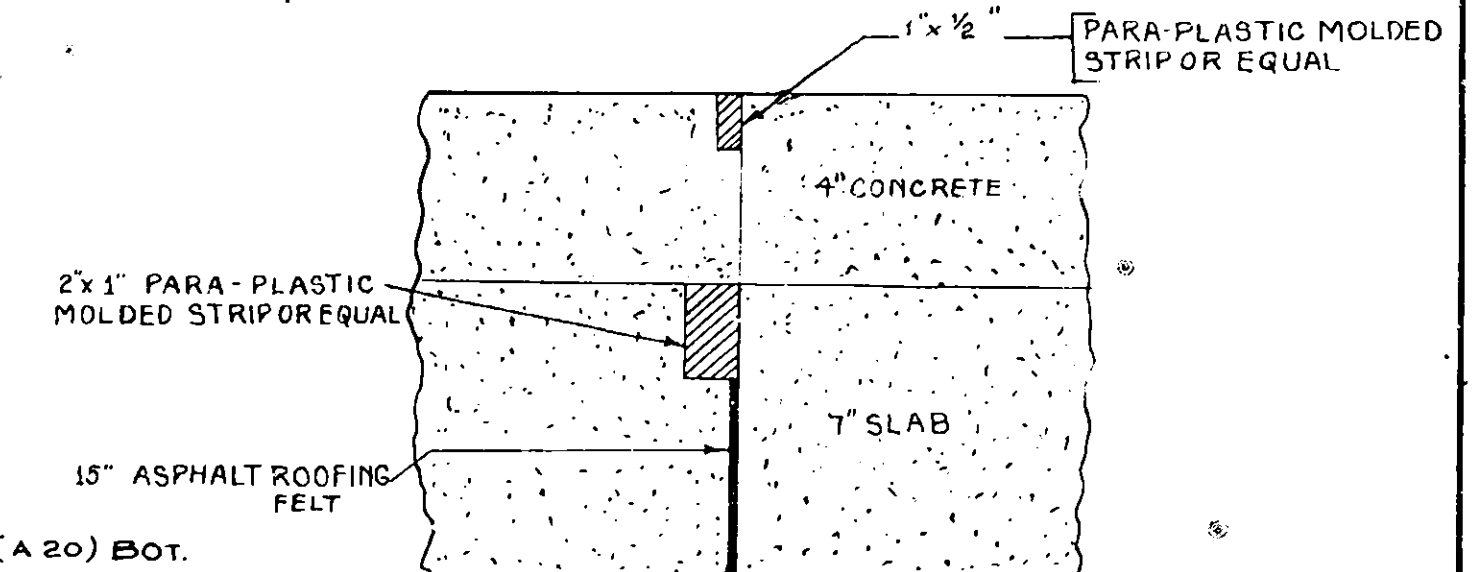


DETAIL OF JOINT OVER CENTER PIER
SCALE 3" = 1'-0"


NOTE:
FLASHINGS OR WATERSTOPS ARE TO BE PROTECTED FROM DAMAGE DURING THE COURSE OF CONSTRUCTION AS ORDERED BY THE ENGINEER. BENDING OR ALTERING THE SHAPE AS SHOWN IN ANY MANNER WILL NOT BE ALLOWED.

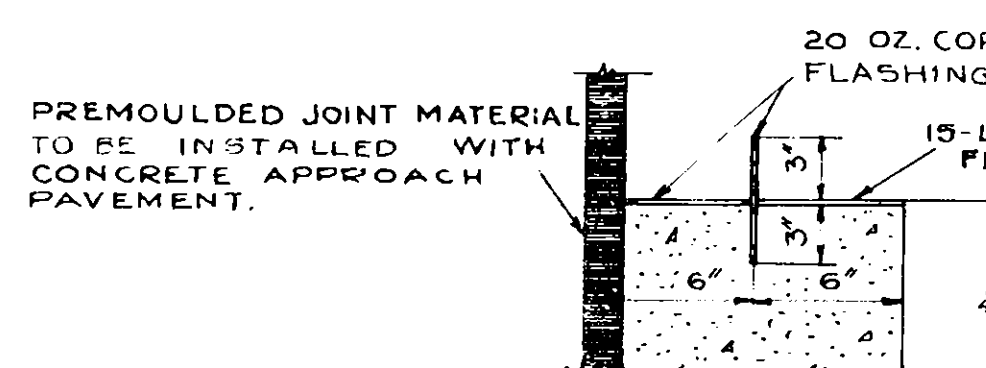

DETAIL B
SCALE 1 1/2" = 1'-0"

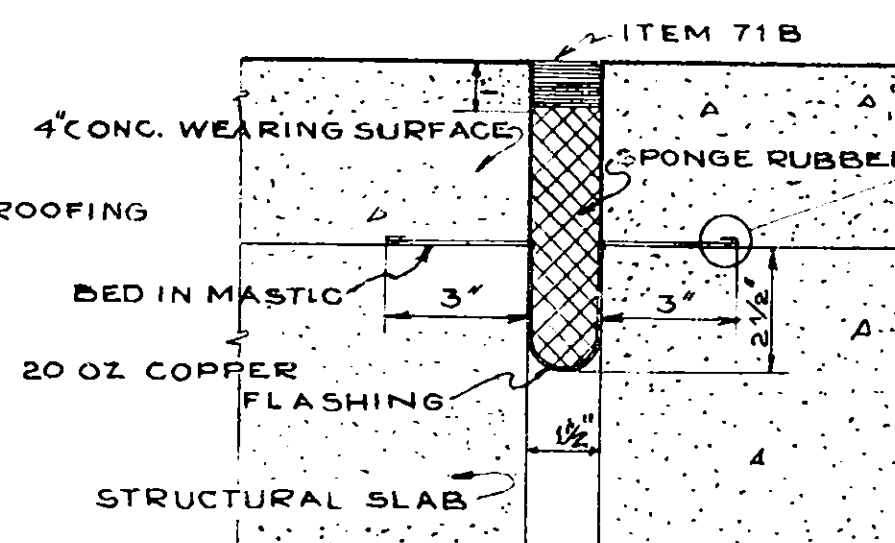


DETAIL OF JOINT OVER N-S PIERS
SCALE 3" = 1'-0"

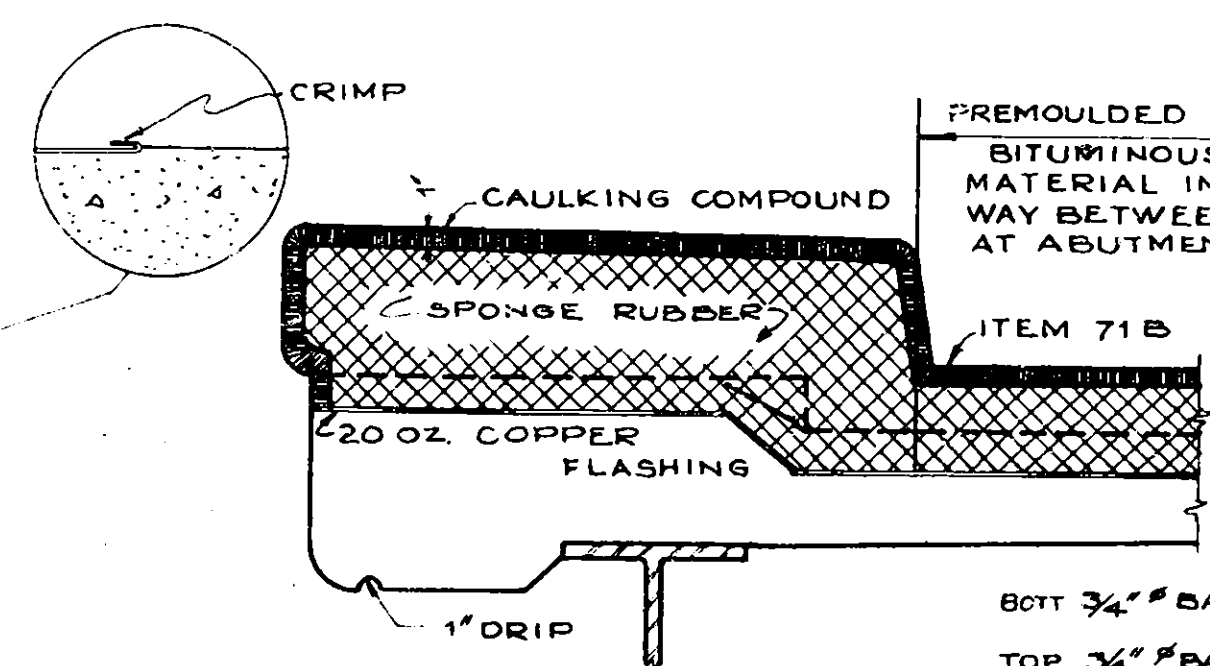

SECTION THRU SAFETY WALK AT JOINT
SCALE 1" = 1'-0"

NOTE:
SPONGE RUBBER SHALL COMPLY WITH THE REQUIREMENTS FOR PREFORMED EXPANSION JOINT FILLERS FOR CONCRETE, A.S.T.M. DESIGNATION D544.
ASPHALT ROOFING FELT SHALL COMPLY WITH THE REQUIREMENTS OF THE STANDARD SPECIFICATIONS OF A.S.T.M., DESIGNATION D266.

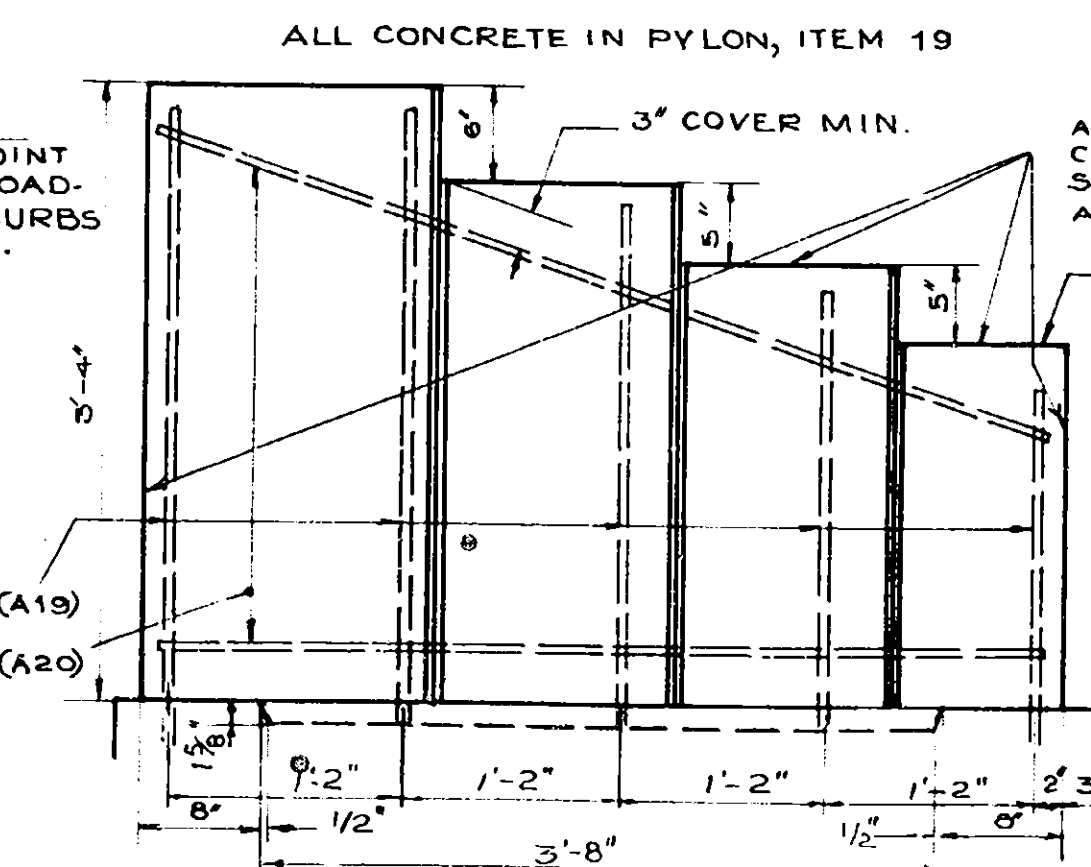

ELEVATION OF PYLON
SCALE 1" = 1'-0"

SUPERSTRUCTURE DETAILS

KINNE STREET
MOHAWK SECTION
NEW YORK STATE THRUWAY

PREPARED AND RECOMMENDED:


UROUHART & DOYLE, CONSULTING ENGINEERS
NEW YORK STATE PROFESSIONAL ENGINEERS LICENSE NO. 5667

DATE

SHEET 64

COUNTY	SHEET NO	TOTAL SHEETS
ONONDAGA	64	66
N.Y. STATE THRUWAY, MOHAWK SECTION, SUBDIV. B.B.		
INTERCHANGE AT THOMPSON ROAD		


64R

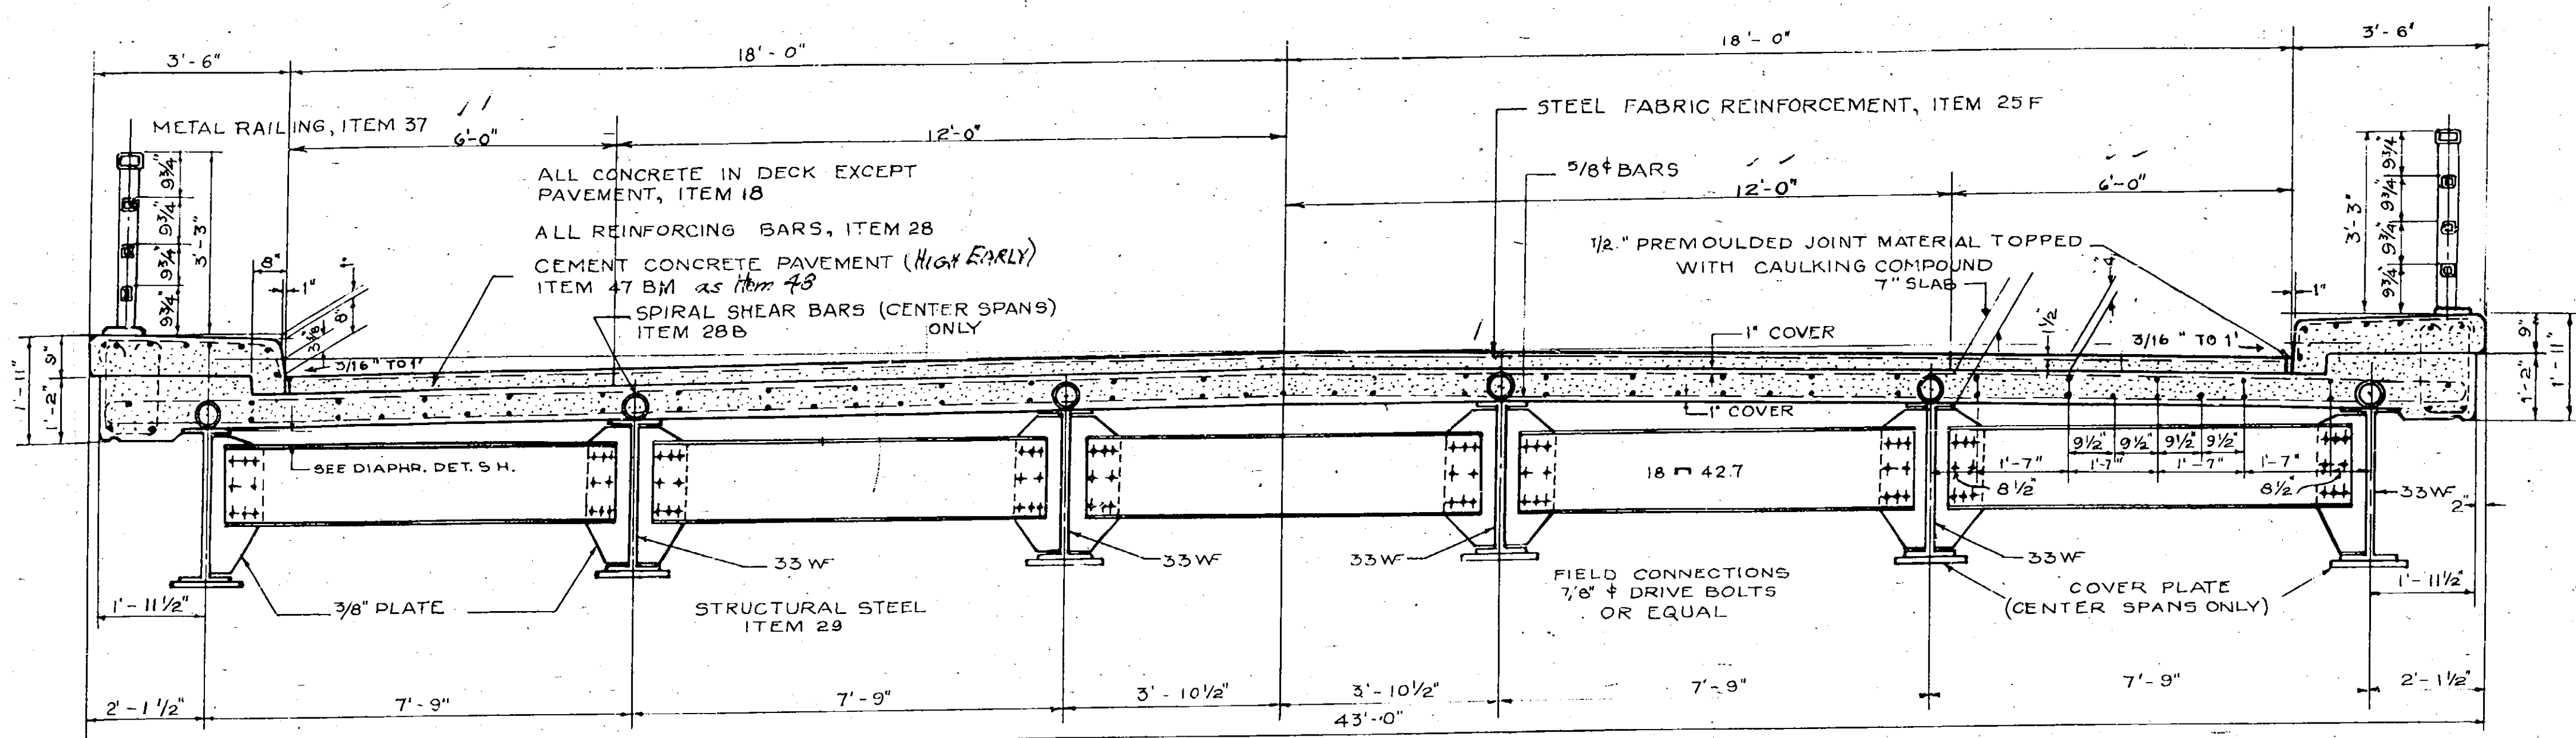

TRANSVERSE SECTION
SCALE 1/2" = 1'-0"


NOTE:
IMMEDIATELY BEFORE PLACING CONCRETE PAVEMENT, THE CONCRETE SURFACE OR SURFACES UPON WHICH IT IS TO BE PLACED SHALL BE THOROUGHLY WETTED DOWN CONTINUOUSLY FOR ONE HOUR IF THE AIR TEMPERATURE IS ABOVE 50°F. COST OF SAME TO BE UNDER ITEM 1WA.

CEMENT IN ITEM 47BM TO BE PORTLAND CEMENT TYPE 1A, ITEM 15-BA.
CEMENT IN ITEMS 18 & 19 TO BE 7 PARTS PORTLAND CEMENT TYPE 2, ITEM 15-2 AND ONE PART NATURAL CEMENT TYPE N - ITEM 15N.

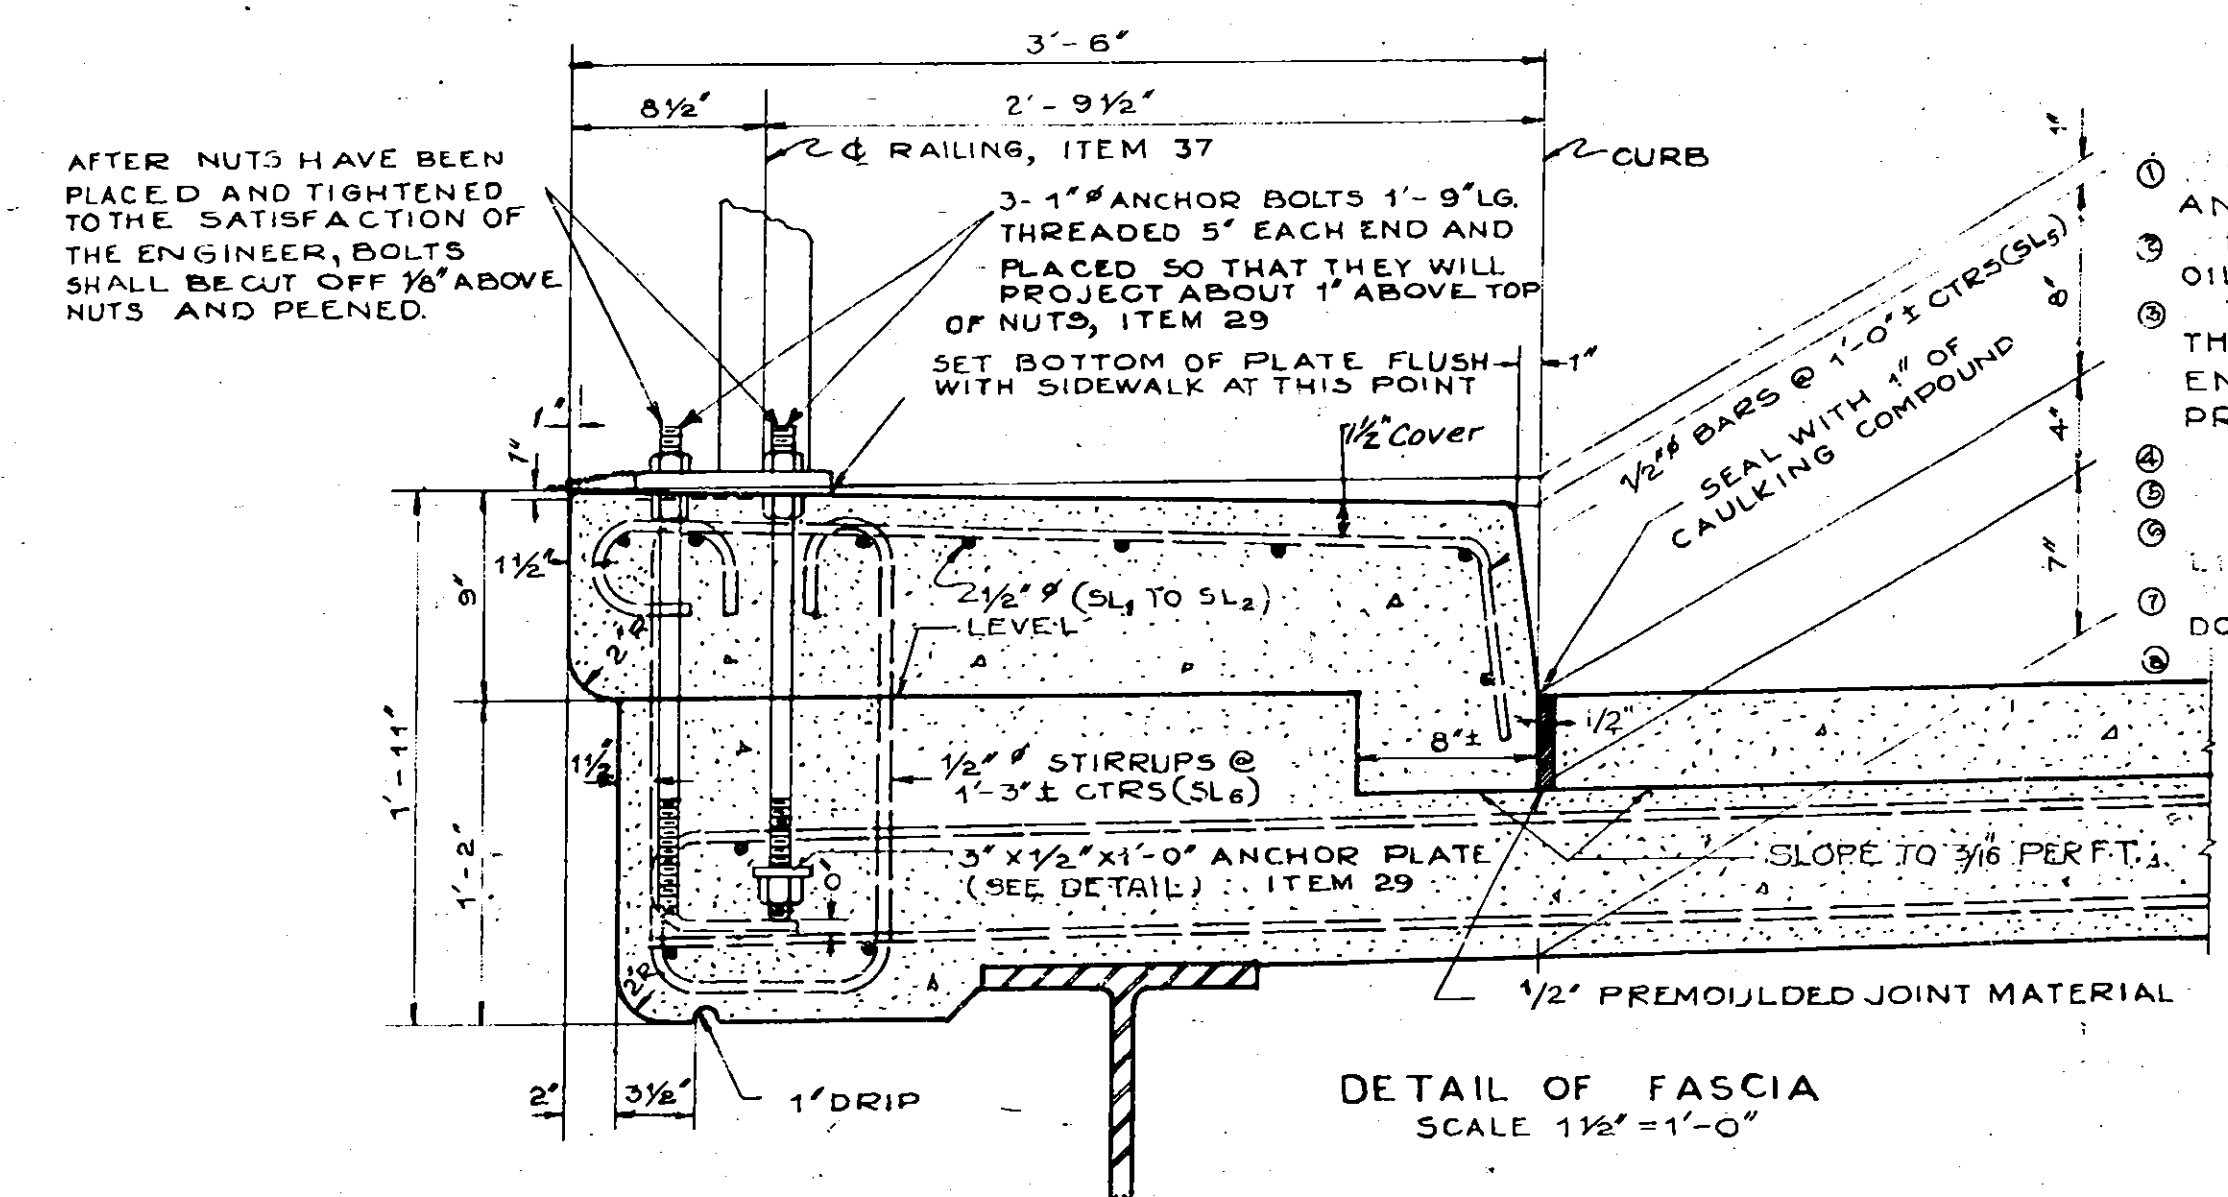


DETAIL OF FASCIA
SCALE 1 1/2" = 1'-0"

- CONSTRUCTION PROCEDURE
1. SET ANCHOR BOLTS BY MEANS OF TEMPLATE AND POUR SLAB.
 2. MAKE TWO APPLICATIONS OF WATER-PROOFING OIL TREATMENT M41-W TO TOP OF SLAB.
 3. THE TOP OF THE SLAB SHALL BE CONTINUOUSLY AND THOROUGHLY WETTED DOWN, AS DIRECTED BY THE ENGINEER FOR AT LEAST ONE HOUR, IMMEDIATELY PRIOR TO THE PLACING OF THE ROADWAY PAVEMENT.
 4. POUR ROADWAY PAVEMENT.
 5. PLACE LOWER NUTS ON UPPER END OF ANCHOR BOLTS.
 6. PLACE RAILING ON LOWER NUTS AND ADJUST TO LINE AND GRADE.
 7. PLACE UPPER NUTS ON ANCHOR BOLTS TIGHTEN DOWN ON PLATES.
 8. POUR SIDEWALK TO PROPER LINE AND GRADE.

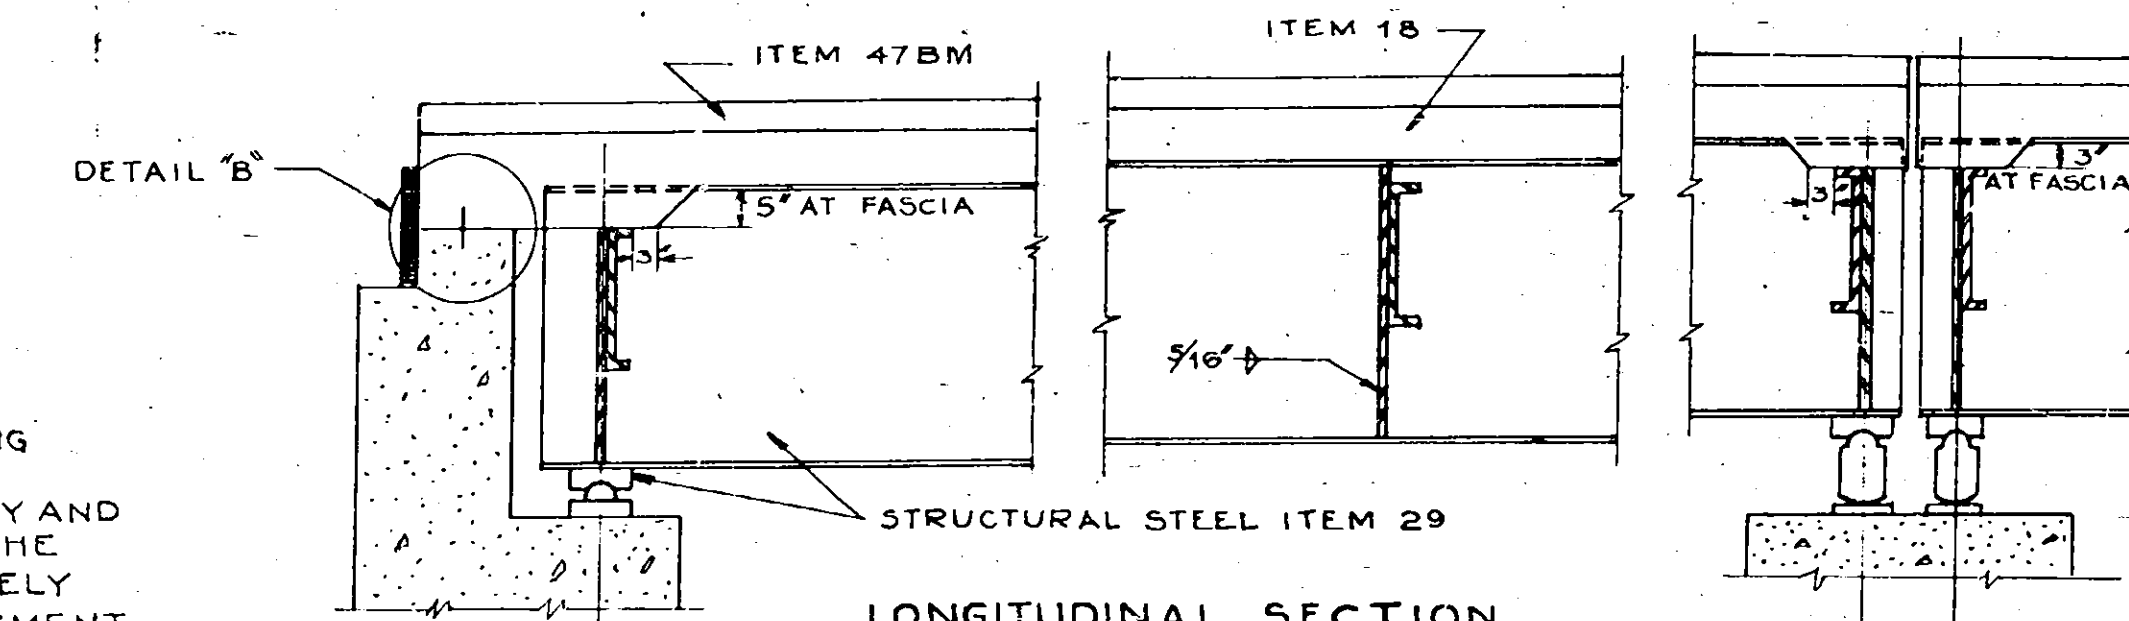


LONGITUDINAL SECTION
SCALE 1/2" = 1'-0"

NOTE:
ALL DIAPHRAGMS 5FT LEVEL. INTERMEDIATE DIAPHRAGMS PERPENDICULAR TO GIRDERS WITH TOPS 3" BELOW TOP OF FASCIA GIRDERS. TOPS OF END DIAPHRAGMS 5" BELOW TOP OF FASCIA GIRDERS.

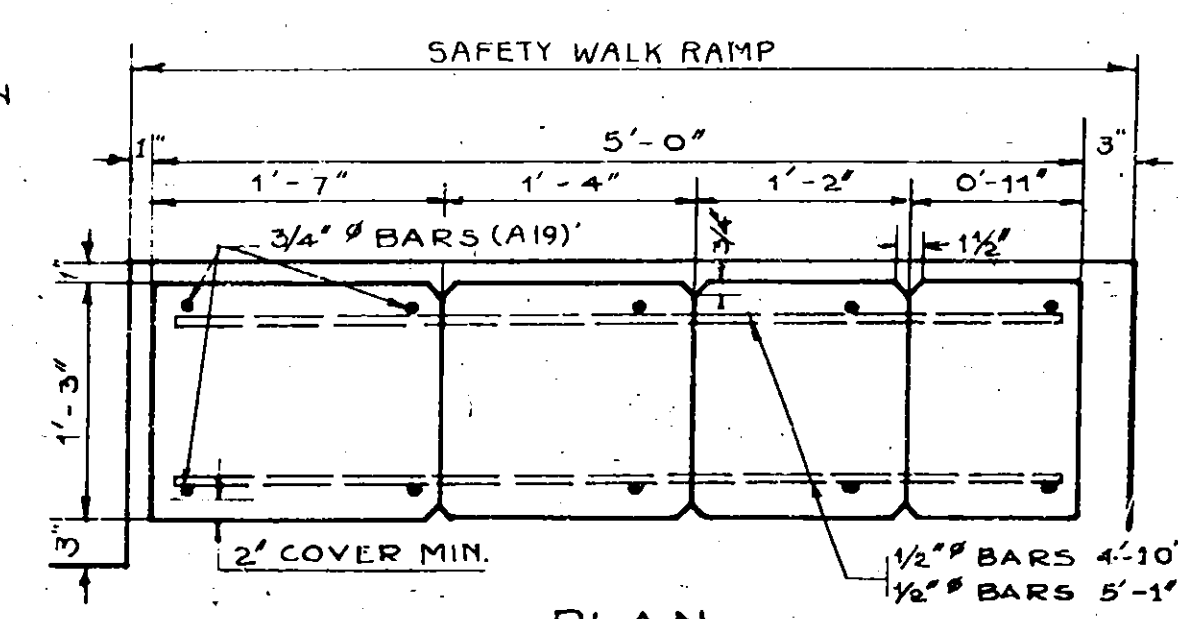


PLAN
SCALE 1" = 1'-0"

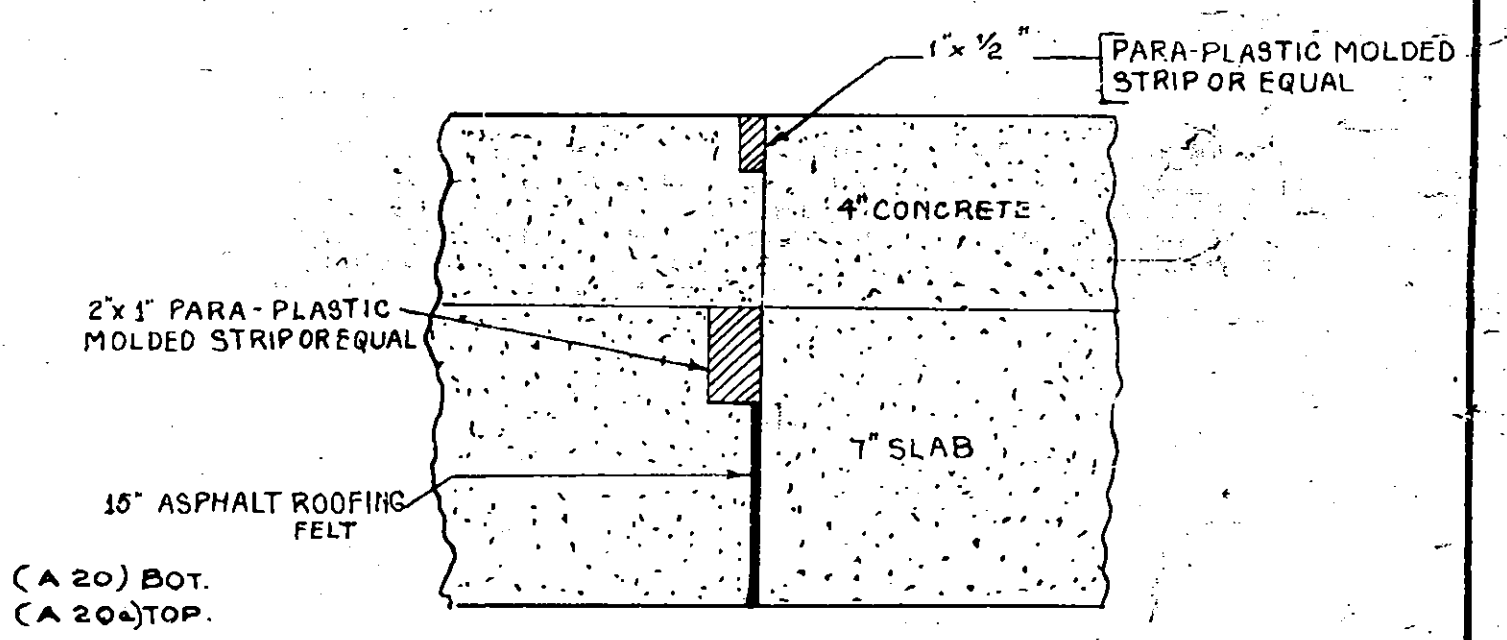


DETAIL OF JOINT OVER CENTER PIER
SCALE 3" = 1'-0"

NOTE:
FLASHINGS OR WATERSTOPS ARE TO BE PROTECTED FROM DAMAGE DURING THE COURSE OF CONSTRUCTION AS ORDERED BY THE ENGINEER. BENDING OR ALTERING THE SHAPE AS SHOWN IN ANY MANNER WILL NOT BE ALLOWED.

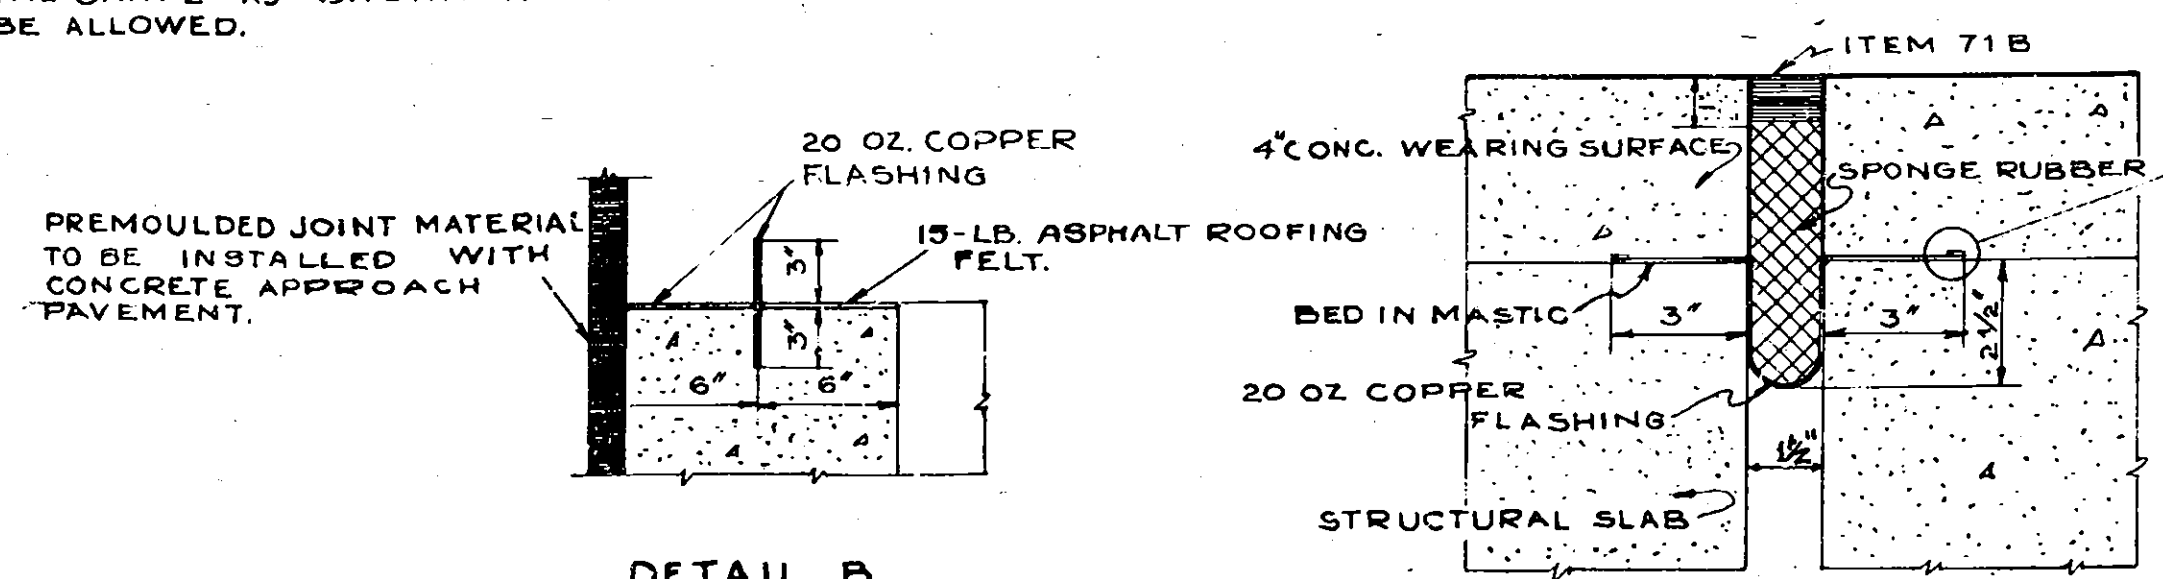


DETAIL B
SCALE 1 1/2" = 1'-0"

DETAIL OF JOINT OVER N-S PIERS
SCALE 3" = 1'-0"

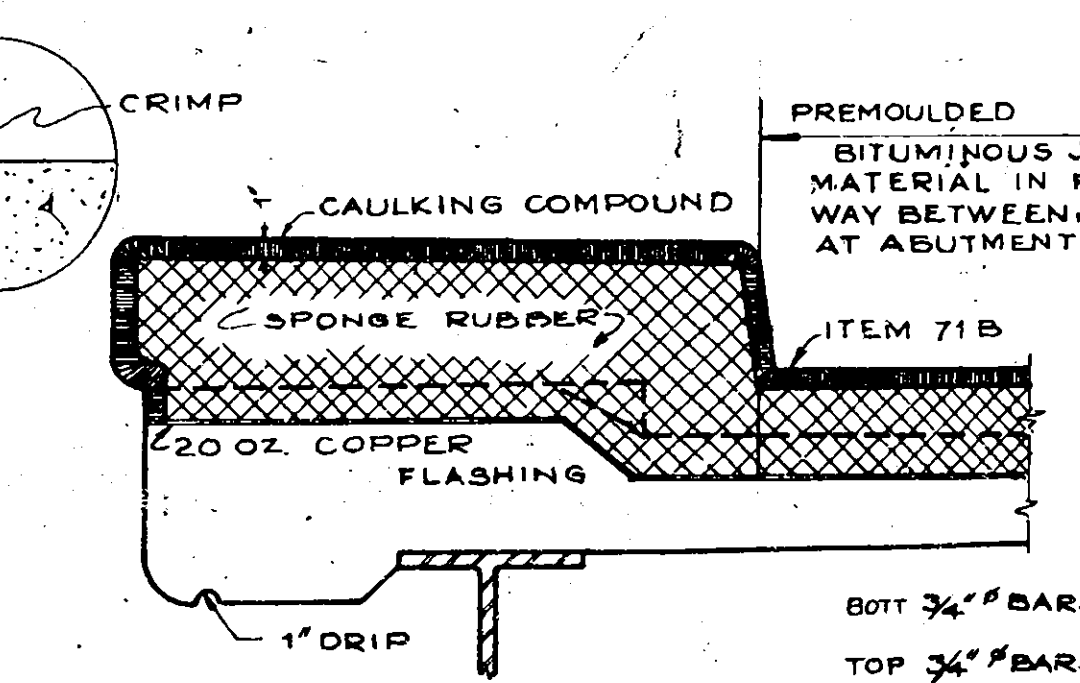

SECTION THRU SAFETY WALK AT JOINT
SCALE 1" = 1'-0"

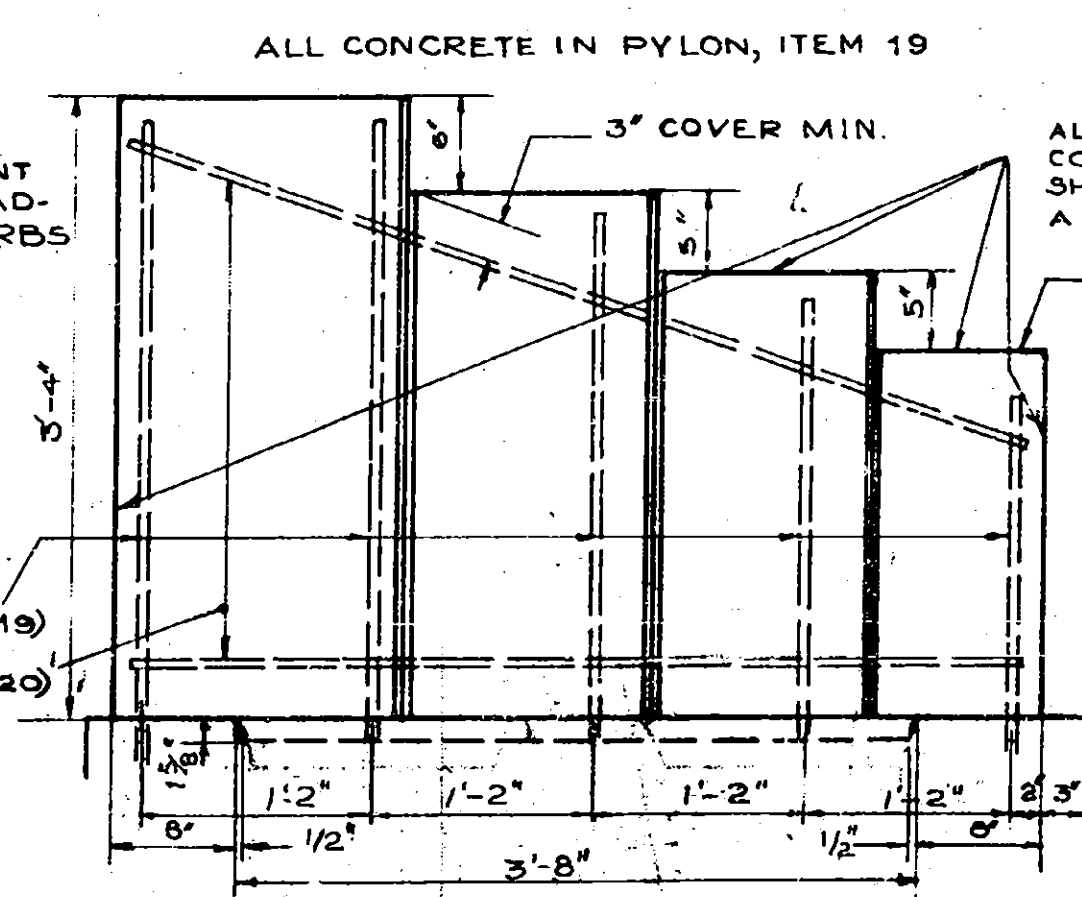

ELEVATION OF PYLON
SCALE 1" = 1'-0"

ALL UNCHAMFERED CORNERS OF PYLONS SHALL BE RUBBED TO A 1/4" RADIUS.
TOP SURFACE OF PYLONS SHALL BE PLACED PARALLEL TO GRADE.

NOTE:
SPONGE RUBBER SHALL COMPLY WITH THE REQUIREMENTS FOR PREFORMED EXPANSION JOINT FILLERS FOR CONCRETE, A.S.T.M. DESIGNATION D544.
ASPHALT ROOFING FELT SHALL COMPLY WITH THE REQUIREMENTS OF THE STANDARD SPECIFICATIONS OF A.S.T.M., DESIGNATION D266.

BUILT ACCORDING TO PLAN

SUPERSTRUCTURE DETAILS

KINNE STREET
MOHAWK SECTION
NEW YORK STATE THRUWAY

COUNTY			SHEET NO.	TOTAL SHEETS
ONONDAGA			65	66
N.Y. STATE THRUWAY, MOHAWK SECTION SUBDIV. 8 B				
INTERCHANGE AT THOMPSON ROAD				







SUPERSTRUCTURE · BAR LIST

[illegible]

SUBSTRUCTURE BAR LIST

SUBSTRUCTURE BAR LIST									
MARK	SIZE	NO.	LENGTH	TYPE	A	B	C	LOCATION	
AF ₁	3/4"	80	9-1	STR.				ABUT. FOOTINGS & BACKWALL	
AF ₂		48	6-7					ABUT. FOOTINGS & BRIDGE SEAT	
AF ₃		72	11-3					WINGWALLS	
AF ₄		24	46-0					ABUT. FOOTINGS	
AF ₅		48	17-0					WINGWALL FOOTINGS	
AF ₆	1/2"	112	5-2					ABUT. & WINGWALL FOOTINGS	
PF ₁	1"	108	8-0	II	7-0	0-8	1-4	PIER FOOTINGS	
PF ₂	1 1/4"	32	11-2	I	8-8	0-10	1-8	" "	
PF ₃		10	9-10	I	7-4	0-10	1-8	" "	
PF ₄		48	10-6	I	8-0	0-10	1-8	" "	
PF ₅		30	10-4	I	7-10	0-10	1-8	" "	
A ₁	3/4"	16	45-6	STR.				ABUT. BACKWALLS	
A ₂		12	18-1	VII	15-0	2-6	0-7	" WINGWALLS	
A _{2A}		4	19-8	III	15-0	0-0	4-8	" "	
A ₃		16	19-6	VII	11-10	3-0	4-7	" "	
A ₄	1/2"	48	9-6	VI	2-4	0-4	3-2	" SEARING SEATS	
A ₁₉	3/4"	40	7-0	STR.				PYLON DOWELS	
A ₆	1/2"	28	4-6	STR.				ABUTMENT WINGWALLS	
A ₇		8	6-10					ABUTMENT WINGWALLS	
A ₈		8	11-6					ABUTMENT WINGWALLS	
P ₁	1"	36	14-11	STR.				NORTH PIER COLUMNS	
P ₂	1"	36	18-7	STR.				CENTER " "	
P ₃	1"	36	14-11	STR.				SOUTH " "	
P ₄	1/4"	43	30-0	X	11-1	PITCH 3"		NORTH " " (SPIRALS)	
P ₅	1/4"	45			14-9	"	"	CENTER " " "	
P ₆	1/4"	45			11-1	"	"	SOUTH " " "	
P ₇	1 1/4"	24	11-0	STR.				ALL PIER CAPS	
P ₈		6	48-4	II	42-2	2-10		" " " "	
P _{8A}		6	39-0	STR.				" " " "	
P ₉		12	29-9	IV	25-1	1-6	2-3	" " " "	
P ₁₀		12	30-9		26-1	1-6	2-3	" " " "	
P ₁₁		12	10-8		6-0	1-6	2-3	" " " "	
								" " " "	
P ₁₅	1/2"	72	1-6	STR.				PIER PADS	
P ₁₆	1/2"	36	10-0	V	2-0	0-3	2-8	PIER PADS	
P ₁₇	5/8"	36	20-8	STR.				PIER CAPS	
P ₁₈	5/8"	30	10-5	VIII	3-0	3-0	4-5	PIER CAPS	
P ₁₉	1/2"	168	13-8	V	2-1	0-3	3-8		
BASED ON EST. LENGTHS:									
PL ₁	3/4"	120	15-7	II	14-10	0-6	1-0	NORTH, SOUTH ABUT. (VERTICAL PILES)	
PL ₁	3/4"	120	22-7	II	21-10	0-6	1-0	NORTH, SOUTH ABUT. (BATTER PILES)	
PL ₁	3/4"	48	12-7	II	11-10	0-6	1-0	N-S PIERS (VERTICAL PILES)	
PL ₁	3/4"	168	18-7	II	17-10	0-6	1-0	N-S PIERS (BATTER PILES)	
PL ₁	3/4"	18	11-7	II	10-10	0-6	1-0	CENTER PIER (VERTICAL PILES)	
PL ₁	3/4"	108	16-7	II	15-10	0-6	1-0	CENTER PIER (BATTER PILES)	
PL ₂	1/4"	1600	3-0	IX	0-8			ALL PILES (ASS. FOR 12" STR. PILES)	

BAR DETAILS

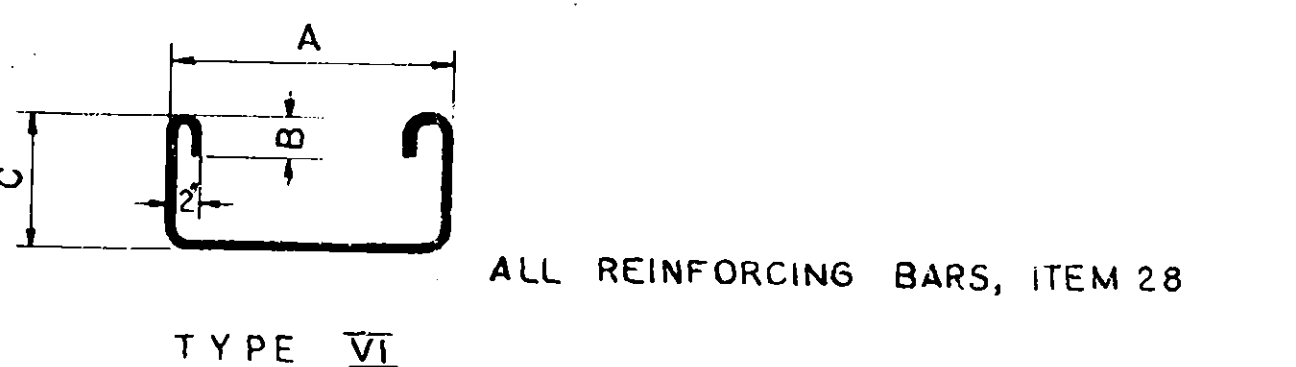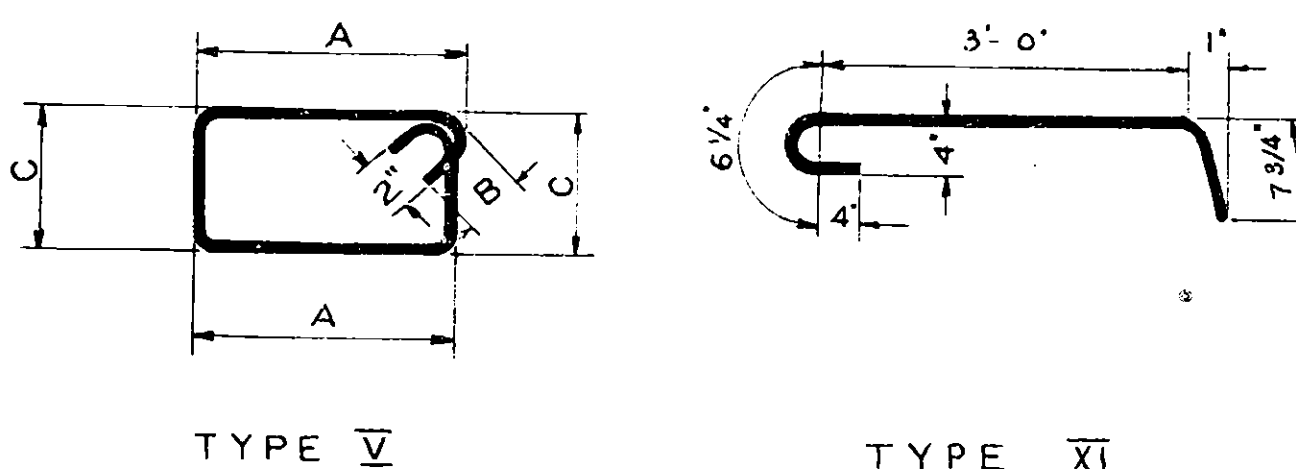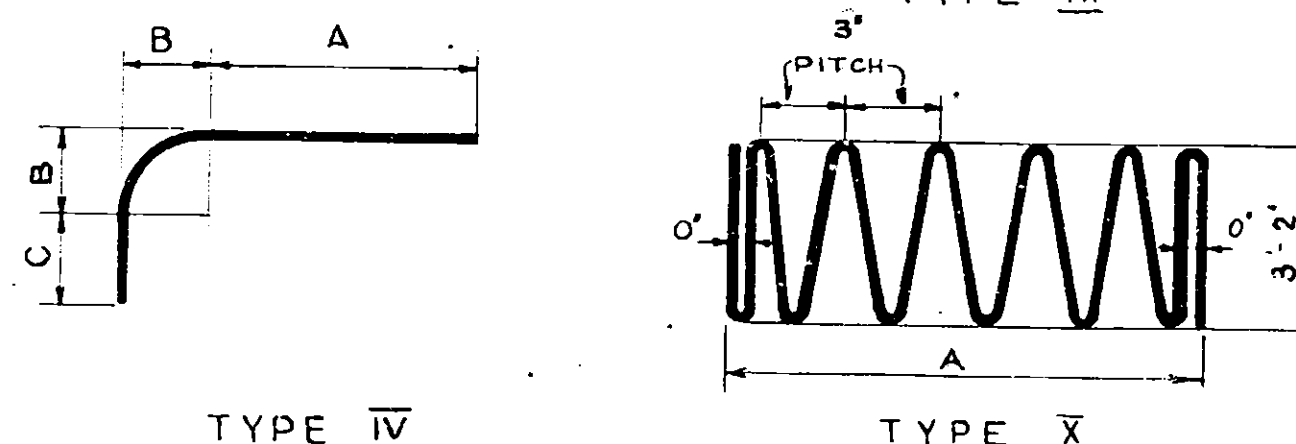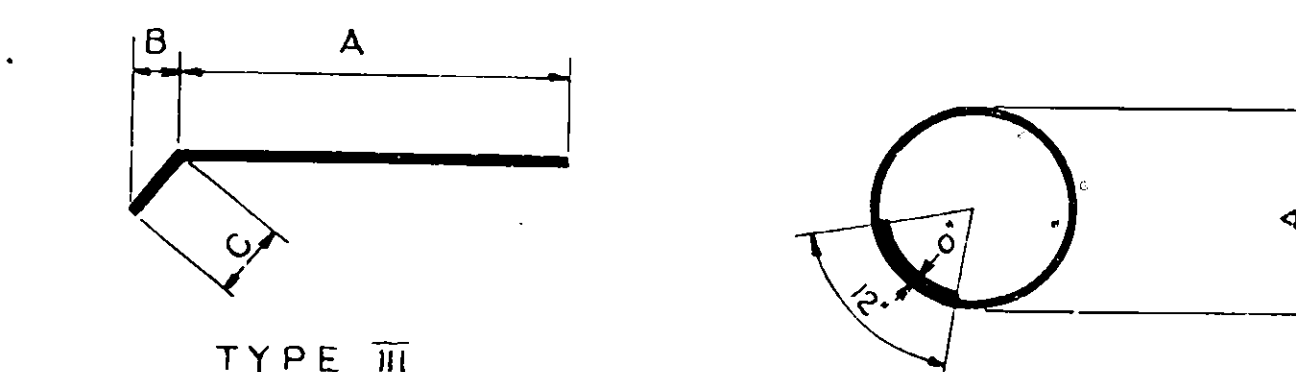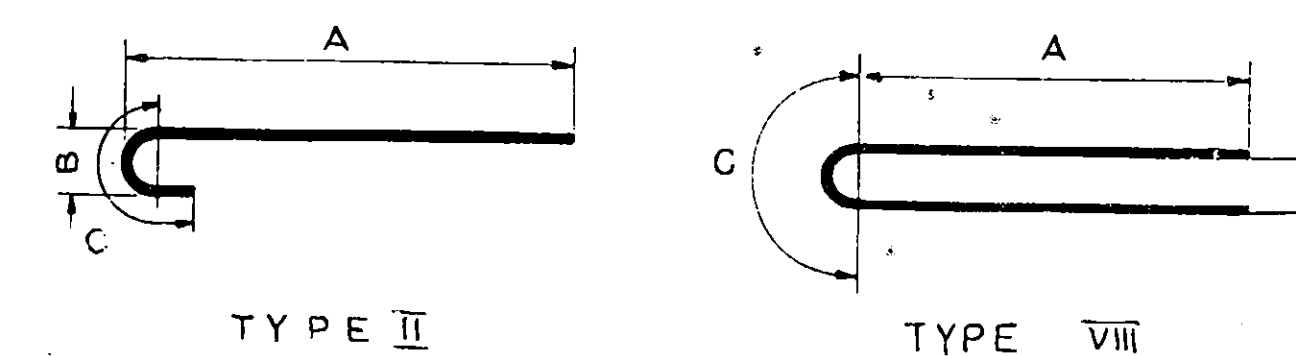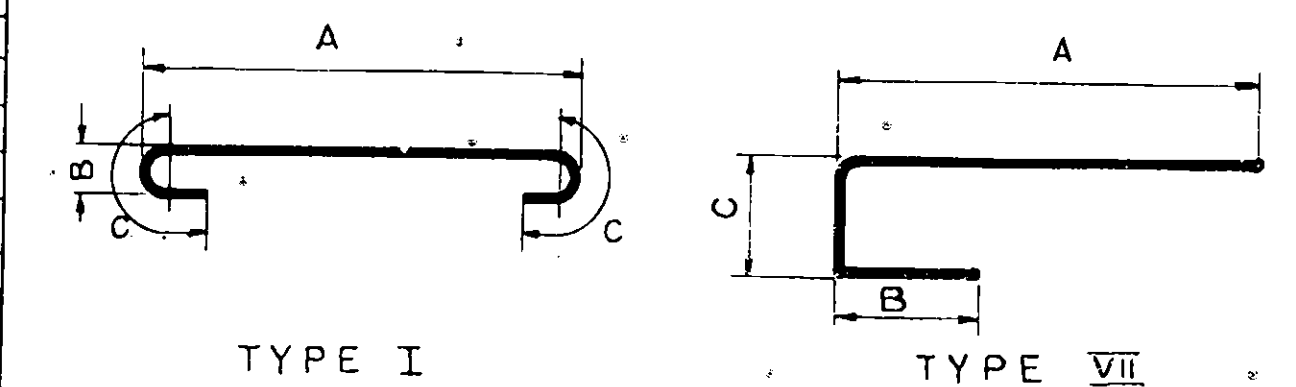

ALL REINFORCING BARS, ITEM 28

BAR LIST

KINNE STREET
MOHAWK SECTION

NEW YORK STATE THRUWAY

SHEET 65

PREPARED AND RECOMMENDED

URQUHART & DOYLE, CONSULTING ENGINEERS
NEW YORK STATE PROFESSIONAL ENGINEERS LICENSE NO. 5667

SCHEDULE A

ITEM NO. QUANTITY OF PAYMENT TYPE

ELECTRONICS PARKWAY INTERCHANGE

80+00-81+00, 82+11-83+02 L.R. 121 2129 Cu. Yds. } B RAMP
80+00-81+00, 82+11-83+02 L.R. 123 5.28 Acres }
80+00-81+00, 82+11-83+02 L.R. 124 475 Sq. Yds. See Note A, Item 124, Schedule B

818+06 ~ 821+11 L.R. 121 400 Cu. Yds. } BRIDGE PORTION
818+06 ~ 821+11 L.R. 123 0.4 Acres }
818+06 ~ 821+11 L.R. 124 410 Sq. Yds. See Note A, Item 124, Schedule B

C0+00 ~ C26+55 L.R. 121 768 Cu. Yds. } C Ramp
C0+00 ~ C26+55 L.R. 123 1.90 Acres }

D0+00 ~ D27+27 L.R. 121 576 Cu. Yds. } D Ramp
D0+00 ~ D27+27 L.R. 123 1.43 Acres }

E0+00 ~ E23+13 L.R. 121 410 Cu. Yds. } E Ramp
E0+00 ~ E23+13 L.R. 123 1.02 Acres }

7TH NORTH STREET EXTENSION

3+00 ~ 20+75 L.R. 121 1015 Cu. Yds.
3+00 ~ 20+75 L.R. 123 2.52 Acres
8+50 ~ 14+50 L.R. 124 209 Sq. Yds. See Note E, Item 124, Schedule B

THOMPSON ROAD RELOCATION

Circle ~ B23+28 L.R. 121 813 Cu. Yds. B Line (South)
Circle ~ B23+28 L.R. 123 1.95 Acres
Circle ~ B23+28 L.R. 124 320 Sq. Yds. See Note B, Item 124, Schedule B

B23+28 ~ B26+40 L.R. 121 360 Cu. Yds. } BRIDGE PORTION
B23+28 ~ B26+40 L.R. 123 0.35 Acres }
B23+28 ~ B26+40 L.R. 124 400 Sq. Yds. See Note B, Item 124, Schedule B

B26+40 ~ B42+35 L.R. 121 757 Cu. Yds. B LINE (North)
B26+40 ~ B42+35 L.R. 123 1.81 Acres
B26+40 ~ B42+35 L.R. 124 317 Sq. Yds. See Note B, Item 124, Schedule B

THOMPSON ROAD INTERCHANGE

Circle ~ A21+00 L.R. 121 463 Cu. Yds. A Ramp (South of Thruway)
Circle ~ A21+00 L.R. 123 1.11 Acres
Circle ~ A21+00 L.R. 124 172 Sq. Yds. See Note C, Item 124, Schedule B

A21+00 ~ A24+04 L.R. 121 360 Cu. Yds. } BRIDGE PORTION
A21+00 ~ A24+04 L.R. 123 0.35 Acres }
A21+00 ~ A24+04 L.R. 124 400 Sq. Yds. See Note C, Item 124, Schedule B

A24+04 ~ A45+00 L.R. 121 713 Cu. Yds. A Ramp (North of Thruway)
A24+04 ~ A45+00 L.R. 123 1.72 Acres
A24+04 ~ A45+00 L.R. 124 230 Sq. Yds. See Note C, Item 124, Schedule B

D0+25 ~ D18+47 L.R. 121 332 Cu. Yds. D Ramp
D0+25 ~ D18+47 L.R. 123 0.82 Acres

E0+25 ~ E10+68 L.R. 121 498 Cu. Yds. E Ramp
E0+25 ~ E10+68 L.R. 123 1.23 Acres

F0+00 ~ F19+46 L.R. 121 412 Cu. Yds. F Ramp
F0+00 ~ F19+46 L.R. 123 1.02 Acres

KINNE STREET

E25+32 ~ K33+06 L.R. 121 852 Cu. Yds.
E25+32 ~ K33+06 L.R. 123 2.02 Acres
E25+32 ~ K33+06 L.R. 124 430 Sq. Yds. See Note D, Item 124, Schedule B

K33+06 ~ K36+33 L.R. 121 360 Cu. Yds. } BRIDGE PORTION
K33+06 ~ K36+33 L.R. 123 0.4 Acres }
K33+06 ~ K36+33 L.R. 124 635 Sq. Yds. See Note D, Item 124, Schedule B

K36+33 ~ K46+33 L.R. 121 726 Cu. Yds.
K36+33 ~ K46+33 L.R. 123 1.72 Acres
K36+33 ~ K46+33 L.R. 124 396 Sq. Yds. See Note D, Item 124, Schedule B

COLLEGE PLACE

12+39 ~ C26+55 L.R. 123 0.64 Acres

SCHEDULE B

DETAIL SPECIFICATIONS TO ACCOMPANY PUBLIC WORKS SPECIFICATIONS

ITEM NO. DESCRIPTION

IWA APPLYING WATER

a. AREAS ~ Sodded areas as shown under Item 124, Schedule A
RATES ~ When and as directed by the Engineer to supply sufficient water to prevent drying out of sod.

121 TOPSOIL PLACED FROM STOCKPILES

a. AREAS ~ See Schedule A. To be placed from pavement edge or edge of calcium treated shoulder as case may be, extending to toe of slope or top of cut or as directed by the Engineer.

STOCKPILES ~ Contractor shall secure the necessary amount from his shippings within the limits of the contract.

c. DEPTH OF TOPSOIL ~ 3 inches in place.

123 SEEDING

a. AREAS ~ See Schedule A and/or as directed by the Engineer

Previously established Thruway Turf Areas that are disturbed by the Contractor outside his contract limits will be reestablished to the satisfaction of the Engineer at no additional cost to the State.

b MATERIALS

Seed ~ See Schedule D
Fertilizer ~ M55 Type No. 2 or equivalent to furnish a minimum of 80 lbs. of nitrogen by weight per acre.
Lime ~ M52 or M53
Mulch ~ M59 (Hay) or M60 (Straw)

c CONSTRUCTION

Seeding Rate ~ 50 lbs. PLS. per acre
Fertilizer Rate ~ 800 lbs. per acre minimum
Lime Rate ~ 2000 lbs. per acre
Mulch Rate ~ 2 to 4 tons per acre
The mulch rate will depend on the method used for spreading. 2 tons will generally be sufficient when spread by hand or blown by machine uncut. 4 tons or more may be required when the mulch is cut fine. The intent is to provide an adequate protective cover until turf is established.

No seeding will be permitted between July 15 and August 15 without special permission.

124 SODDING

a. AREAS ~ See Schedule A and/or as directed by the Engineer.

b MATERIALS ~ Sod, M64, Type No. 1, 1 1/2" thick

c CONSTRUCTION ~ Sod will be laid as shown on Std. Sheet 630-34. The applicable bridge sheets and/or as directed by the Engineer. Sod strips will be 2 feet wide, laid on the contour on 10 foot centers; sod gutters will be 3 feet wide, vertical gutters to be at right angle to sod strips and laid on 25 foot centers, or as directed by the Engineer to meet field conditions.

NOTE A ~ ELECTRONICS INTERCHANGE BRIDGE ~ Vertical Sod Gutters are estimated at the following stations (both sides) ~ B17+13, B17+63, B17+85, B18+13, B18+30, B20+79, B21+04, B21+29, B21+54, B22+05, B22+54, B23+04. Horizontal Sod gutters start at B17+13 and end at B23+04. Sod strips (3 each side) start at B17+63 and end at B21+54.

NOTE B ~ THOMPSON ROAD BRIDGE ~ Vertical Sod Gutters are estimated at the following stations on side indicated: 21+32(R), 21+43(L), 21+82(R), 21+93(L), 22+32(R), 22+43(L), 22+82(R), 22+93(L), 23+07(R), 23+18(L), 23+32(R), 23+43(L), 23+57(R), 23+68(L), 24+00(R), 24+12(L), 24+25(R), 24+37(L), 24+62(R), 24+75(L), 24+87(L), 27+25(R), 27+37(L), 27+75(R), 27+87(L), 28+25(R), 28+37(L). Horizontal Sod Gutters start at 21+32 and end at 28+25(R) and 21+43 ~ 28+37(L) Sod strips (4 each side) start at

SCHEDULE C

DETAIL SPECIFICATIONS FOR PLANTS

ITEM QUAN. GENUS & SPECIES ABBR. COMMON NAME SIZE

SUMMARY ~ NEAT & ROUNDED QUANTITIES

ITEM UNIT	121 CUBIC YARDS NEAT ROUND	123 ACRES NEAT ROUND	124 SQUARE YARDS NEAT ROUND	IWA MGAL.
ELECTRONICS PARKWAY INTERCHANGE				
ELECTRONICS INTERCHANGE				
RAMPS	3883	3900	9.63	9.8
BRIDGE PORTION	400	450	0.4	0.6
SEVENTH NORTH ST. EXT.	1015	1050	2.52	2.6
ELECTRONICS PKWY TOTAL	5298	5400	12.55	13.0
THOMPSON ROAD INTERCHANGE AND CONNECTIONS				
THOMPSON RD "B" LINE				
APPROACHES	1570	1600	3.76	4.0
BRIDGE PORTION	360	380	0.35	0.4
INTERCHANGE				
RAMPS	2418	2460	5.90	6.0
BRIDGE PORTION	360	380	0.35	0.4
KINNE STREET				
APPROACHES	1578	1600	3.74	4.0
BRIDGE PORTION	360	380	0.40	0.5
COLLEGE PLACE "C" LINE			0.64	0.7
THOMPSON ROAD TOTALS	6646	6800	15.14	16.00
GRAND TOTALS	11944	12200	27.69	29.0

NOTE B (Continued) 22+82 end at 26+75(R) and 22+93 to 26+87(L)

NOTE C ~ THOMPSON ROAD INTERCHANGE BRIDGE ~ Vertical Sod Gutters are estimated at the following stations, 20+09, 20+59, 20+84, 21+09, 21+34, 23+68, 23+93, 24+18, 24+43, 24+93, and 25+43. Horizontal Sod Gutters start at 20+09 to 25+43 Sod strips (3 each side) start at 20+59 to 24+43.

NOTE D ~ KINNE STREET BRIDGE ~ Vertical Sod gutters are estimated at the following stations, 30+62, 31+12, 31+62, 32+12, 32+62, 32+87, 33+12, 33+37, 35+91, 36+22, 36+47, 36+72, 37+22, 37+72, 38+22, 38+72. Horizontal sod gutters start at 30+62, and end at 38+72. Sod strips (4 each side) start at 32+62 to 36+72.

NOTE E ~ 7TH NORTH STREET EXTENSION ~ A Sodded Berm Gutter will be constructed as shown on the plans at top of cut on left from station 8+50 to station 14+53. Two vertical Sod gutters will connect the berm gutter with concrete ditch gutter at stations 12+00 and 14+50. All gutters to be 3 feet wide.

66 66

ROADSIDE DEVELOPMENT
N.Y. STATE THRUWAY ~ ONTARIO SECTION ~ SUB DIV. 8A
INTERCHANGE AT ELECTRONICS PARKWAY (HOPKINS ROAD)
N.Y. STATE THRUWAY ~ MOHAWK SECTION SUB DIV. 8B
INTERCHANGE AT THOMPSON ROAD

SCHEDULE D

DETAIL SPECIFICATIONS FOR PLANTS

RED FESCUE
(Festuca rubra) Commercial 95 75 25

CANADA BLUEGRASS
(Poa compressa) Commercial 80 80 10

COMMON RYEGRASS
(Lolium perenne) Commercial 95 75 10

ALSIKE CLOVER Commercial-Max.
(Trifolium hybridum 30% hard seed 95 85 3

LADINO CLOVER Commercial-Max.
(Trifolium repens var) 30% hard seed 95 90 2

TOTAL PLS 50

Plus one of the following according to season.

If seeding is done between April 1 & July 15 use -

COMMON ORTS Mohawk, Clinton 95 90 -
(Avena sativa) 20 lbs. per acre gross

If seeding is done between August 15 & April 1 use

WINTER RYE Commercial 95 90 -
(Secale cereale) 20 lbs. per acre gross

IWA 29 M Gal. APPLYING WATER

121 12,200 Cu. Yds. TOPSOIL PLACED FROM STOCKPILES

123 29 Acres SEEDING

124 4700 Sq. Yd. SODDING