

S.T. 52-8

241

S.T. 52-8

STATE OF NEW YORK
DEPARTMENT OF PUBLIC WORKS
DIVISION OF CONSTRUCTION

PLANS FOR CONSTRUCTING A PORTION OF THE
NEW YORK STATE THRUWAY
THE MOHAWK SECTION - (Subdivision 1 and 2)

GRADE SEPARATIONS WITH THE
PINE PLAINS-KIRKVILLE ROAD; FYLER SETTLEMENT ROAD; CHITTENANGO-
LAKEPORT ROAD; GEES ROAD; NORTH MAIN STREET, CANASTOTA
A length of 1.79 miles in the Town of Sullivan, 0.36 mile in the Village of Canastota, Town of Lenox,
a total length of 2.15 miles

AND THE RELOCATION OF THE
TAG STREET - SEEBER ROAD (Town Road)
A length of 1.34 miles in the Town of Sullivan
A TOTAL COMBINED LENGTH OF 3.49 MILES

MADISON COUNTY

CONTRACT S.T. 52-8

SHEETS



FED. RD. DIV. NO.	STATE	FED. AID PROJ. NO.	COUNTY	SHEET NO.	TOTAL SHEETS
	N.Y.		Madison	1	67

TYPE OF CONSTRUCTION
Asphalt Concrete Pavement, Type 1A, Opt. 2.15 Miles
Foundation Course Gravel 1.34 Miles

Including
Pine Plains-Kirkville Rd. Bridge-Sta. 64+36
5 Span I-Beam, 1 @ 51'-8 1/4", 2 @ 39'-3 3/4", and 2 @ 61'-2 1/4"
Fyler Settlement Rd. Bridge-Sta. 200+06
2 I-Beam Spans @ 43'-6", and 2 I-Beam (alpha) Spans @ 89'-4"
Chittenango-Lakeport Rd. Bridge-Sta. 278+18.43
2 I-Beam Spans @ 36'-6", and 2 I-Beam (alpha) Spans @ 83'-5"
Gees Road Bridge-Sta. 378+60
2 I-Beam Spans @ 36'-0", and 3 I-Beam (alpha) Spans @ 54'-0"
North Main Street, Canastota, Sta. 388+82
2 I-Beam Spans @ 36'-1 1/2", and 2 I-Beam (alpha) Spans @ 58'-10"

STANDARD STRUCTURE SHEETS
39-9, 47-2, 47-2C, 47-12, 49-6S, 49-7, 49-43, 50-1R,
50-10, 50-34, 51-33R, 52-41

All work contemplated under this contract to be covered by and in conformity with the specifications adopted January 2, 1951, except as modified on these plans and in the itemized Proposal.

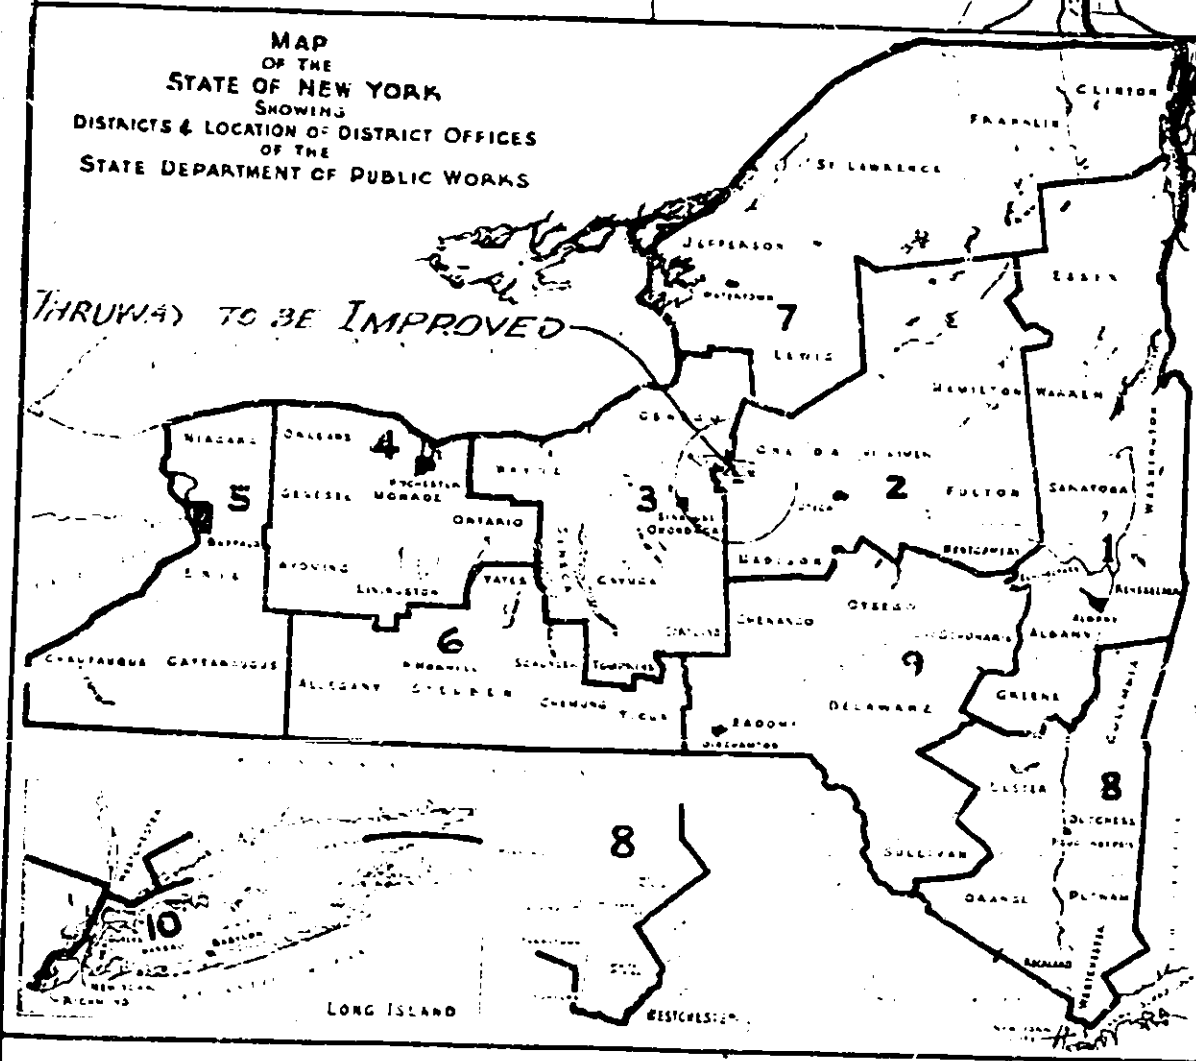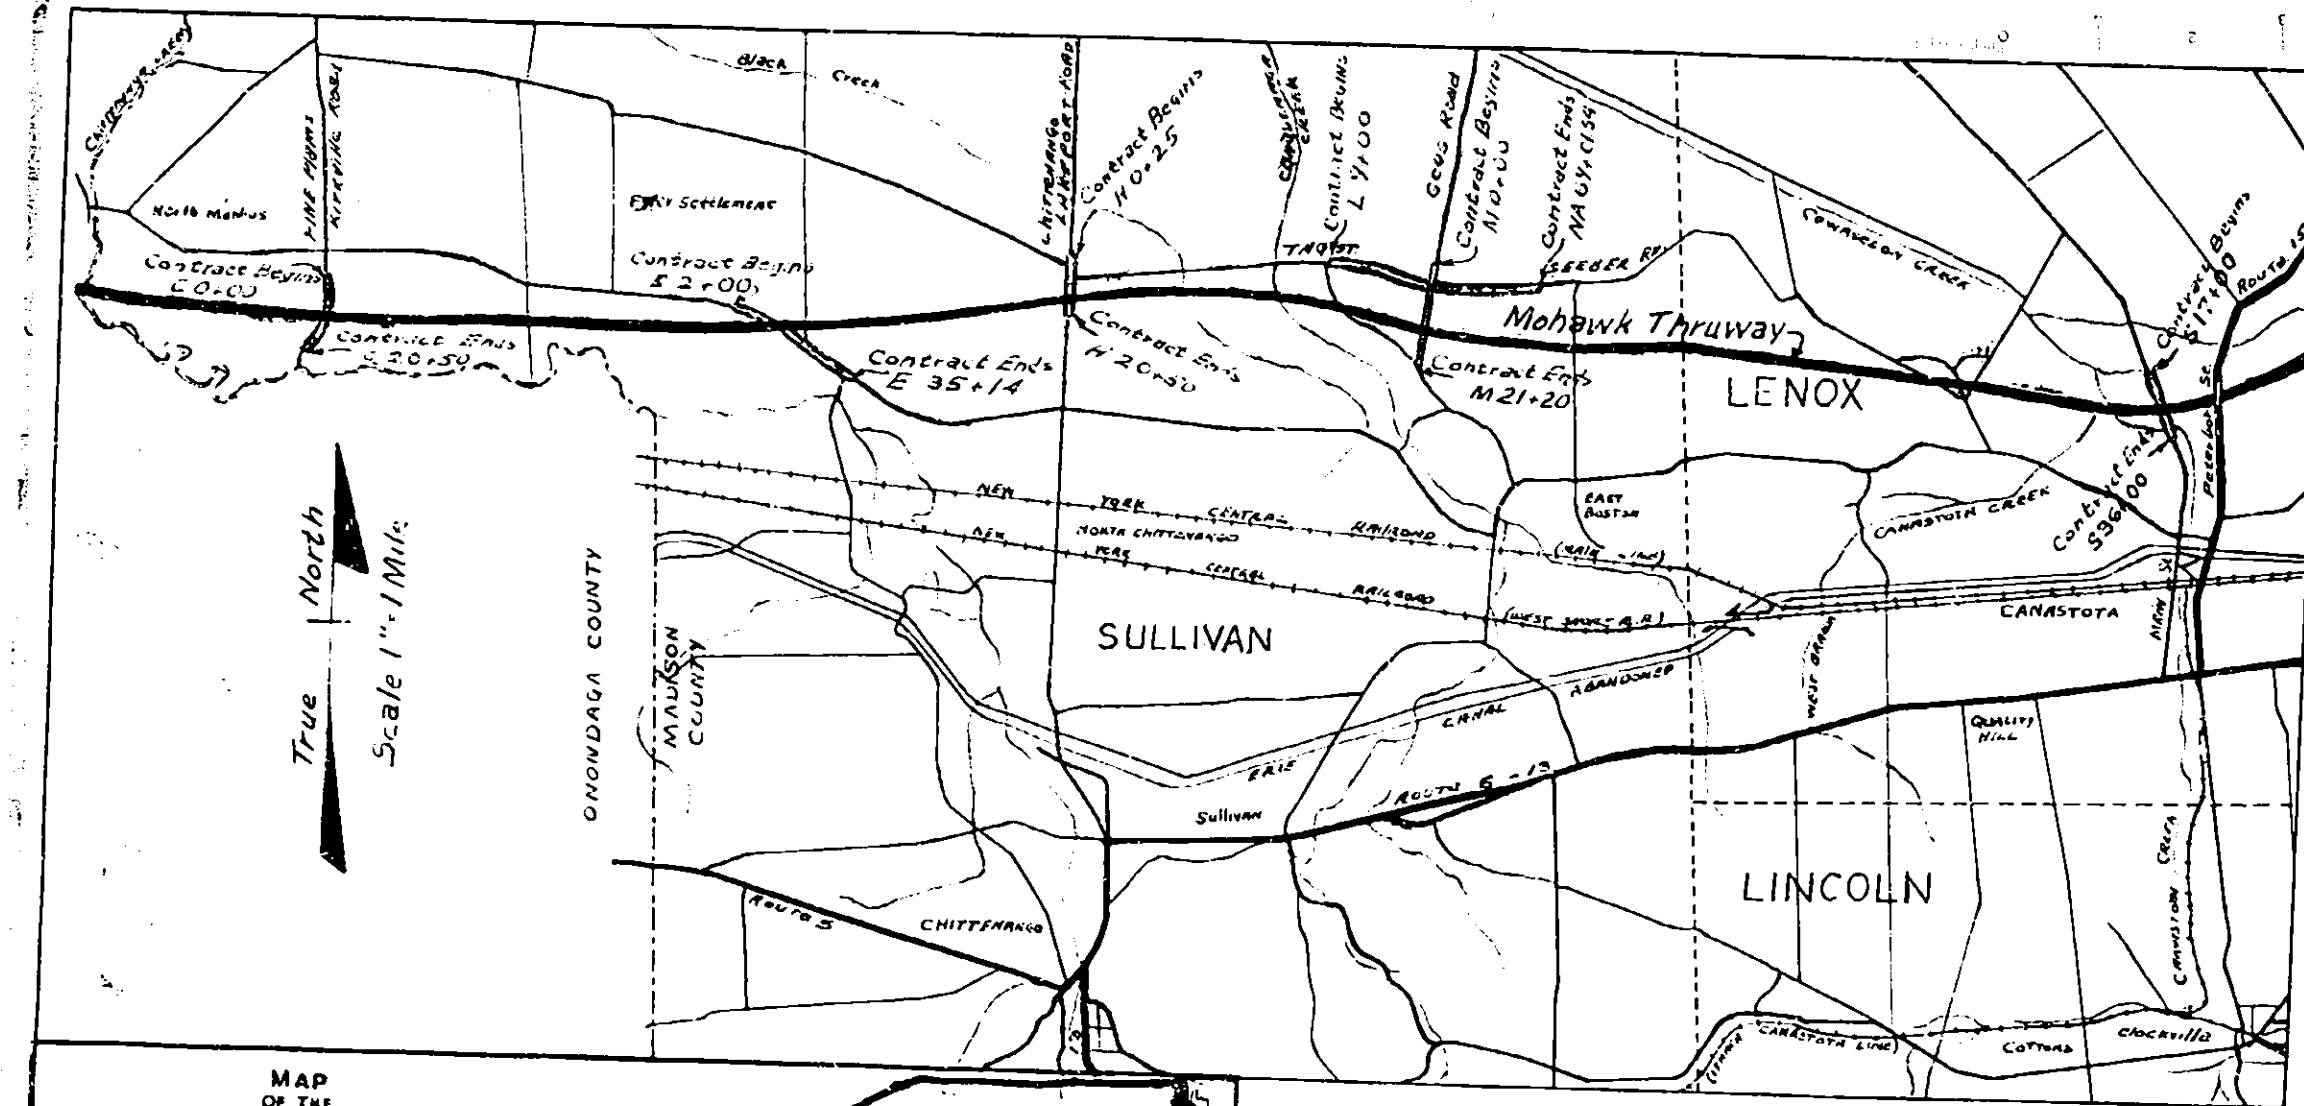

MADE BY THACED BY CHECKED BY
PLAN D. Lewis Estangio

S.T. 52-8

NEW YORK STATE DEPARTMENT OF PUBLIC WORKS DIVISION OF CONSTRUCTION	
Approved J. B. McMorran	19...
Chief Engineer	
Approved E. T. GAWKINS	10 52
Deputy Chief Engineer	

APPROVED Feb. 29 1952
NEW YORK STATE THRUWAY AUTHORITY
B. D. TALLAMY, Chairman
By: C. H. LANG
DEPUTY CHIEF ENGINEER

RECOMMENDED FOR APPROVAL DATE _____

DISTRICT ENGINEER
BUREAU OF PUBLIC ROADS
DEPARTMENT OF COMMERCE

APPROVED _____ DATE _____

DIVISION ENGINEER
BUREAU OF PUBLIC ROADS
DEPARTMENT OF COMMERCE



Approved
E. W. WENDELL
19...
Deputy Chief Engineer

PREPARED PURSUANT TO THE
HIGHWAY LAW & RECOMMENDED BY
E. T. GAWKINS
ENGR. DISTRICT No. 2
DATE _____

S.T. 52-8

S.T. 52-8

S.T. 52-8

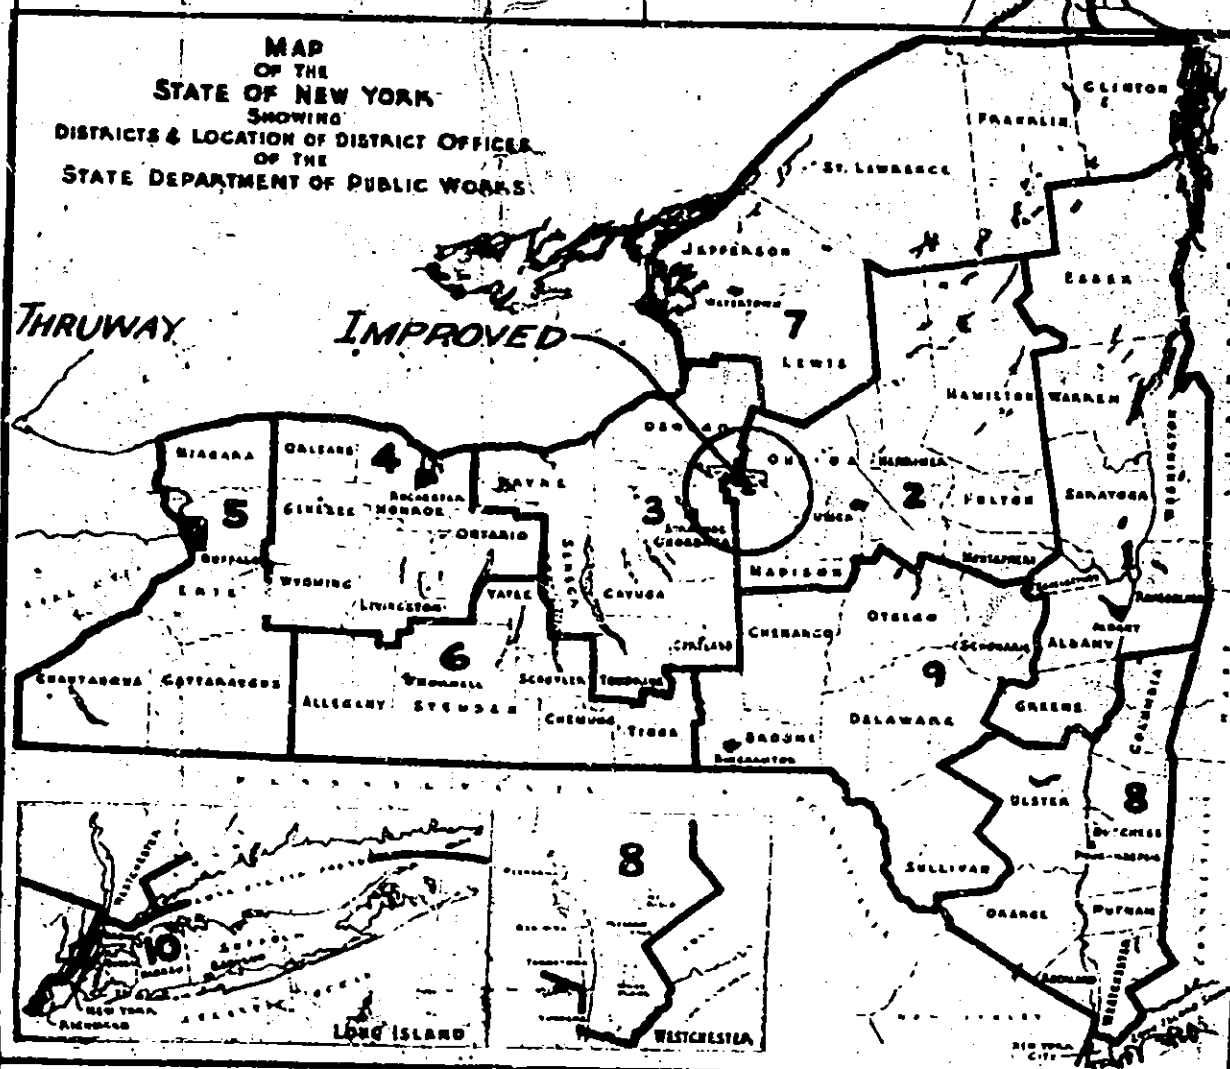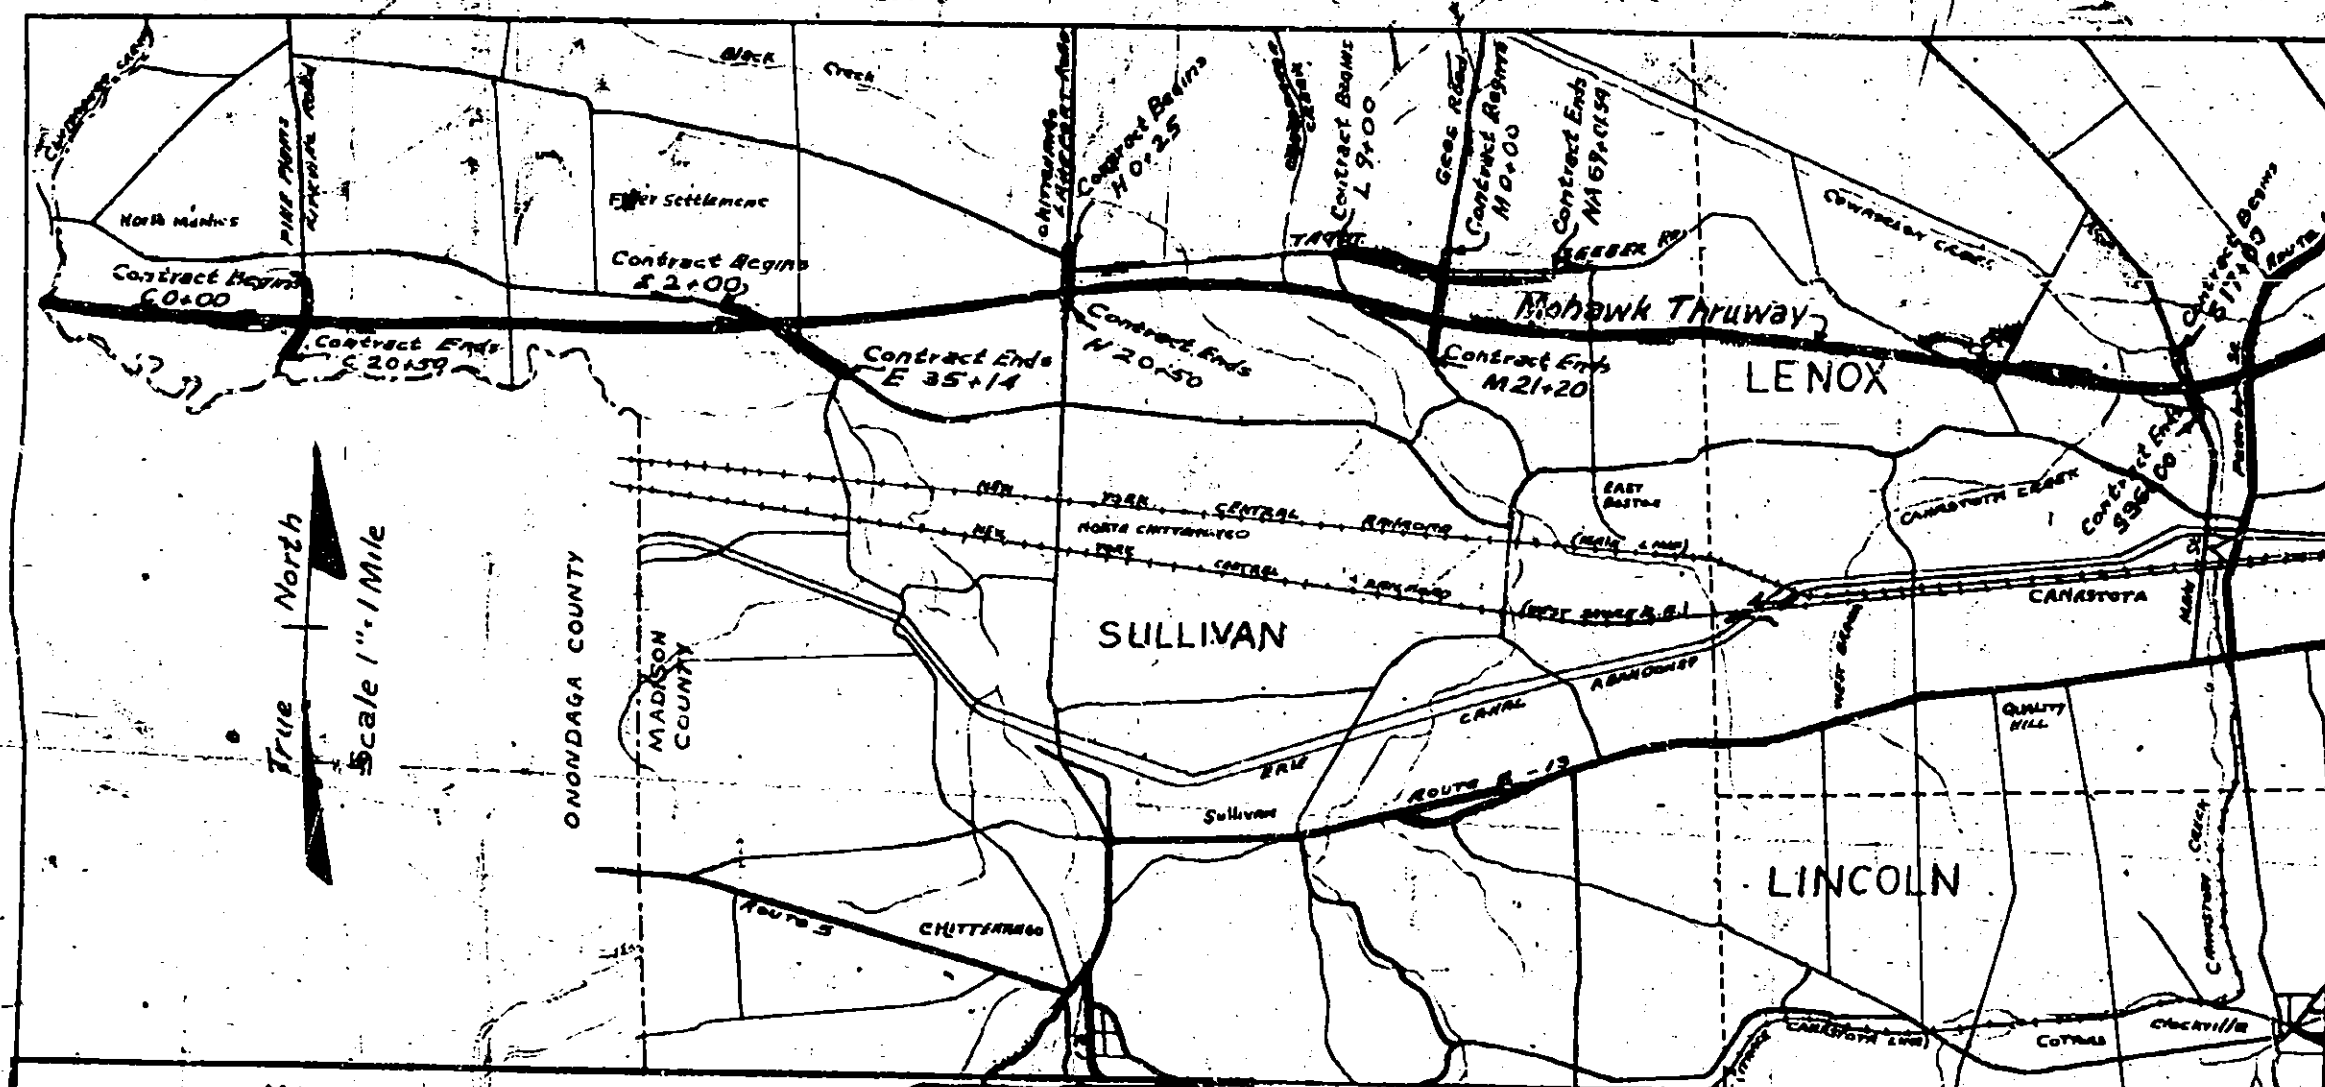

SOURCE OF MATERIALS

CONCRETE - ONEIDA CONC. PROD., CANASTOTA, N.Y.
 ASPH. FILLER
 EXPAN. JOINT MAT. THOMPSON MATERIALS
 CUPPER FLASHING
 WATERPROOFING OIL
 ASPH. CONC. - EASTERN ROCK PROD. - ORISKANY FALLS, N.Y.
 BIT. MAT. - BARRETT - SYRACUSE, N.Y.
 SAND - EASTERN ROCK PROD., BOONVILLE, N.Y.
 STONE - SOLVAY PROCESS, SYRACUSE, N.Y.
 PORTLAND CEMENT - LONE STAR
 NATURAL CEMENT - CENTURY CEMENT CO.
 STRUCTURAL STEEL - PINE BROOK IRON WORKS, SCRANTON, PA.
 METAL RAILING
 SPIRAL BAR SHEAR CONNECTORS -
 PAINT - SUNDURE PAINT CO.
 BAR REINF. - TRUSCON
 STEEL FABRIC REINF. - TRUSCON
 CAST-IN-PLACE CONC. PILES - ARMCO
 STEEL BEARING PILES - BETHLEHEM STEEL CO.
 CABLE GUIDE RAILING
 CONC. PIPE - UNIVERSAL CONC. PIPE CO.
 CORR. MET. PIPE - U.S. FABRICATORS
 GUIDERAIL PAINT - GLIDDEN CO.
 SEED - G.L.F.
 CHLG. CHLOR. - SOLVAY PROCESS, SYRACUSE, N.Y.
 MANHOLE FR. COVER - LITON ST. EN. & BOILER WORKS
 GUARD RAIL END SETS - HOME STEEL CO.

STATE OF NEW YORK
 DEPARTMENT OF PUBLIC WORKS
 DIVISION OF CONSTRUCTION

PLANS FOR CONSTRUCTING A PORTION OF THE
NEW YORK STATE THRUWAY
 THE MOHAWK SECTION - (Subdivision 1 and 2)

GRADE SEPARATIONS WITH THE
**PINE PLAINS-KIRKVILLE ROAD; FYLER SETTLEMENT ROAD; CHITTENANGO-
 LAKEPORT ROAD; GEES ROAD; NORTH MAIN STREET, CANASTOTA**
 A length of 1.79 miles in the Town of Sullivan, 0.36 mile in the Village of Canastota, Town of Lenox,
 a total length of 2.15 miles

AND THE RELOCATION OF THE
TAG STREET - SEEBER ROAD (Town Road)
 A length of 1.34 miles in the Town of Sullivan
 A TOTAL COMBINED LENGTH OF 3.49 MILES

SHEETS

MADISON COUNTY

CONTRACT S.T. 52-8

CONTRACTOR: BRUNELLI CONSTRUCTION CO., INC.

SOUTHINGTON, CONN.

ENGINEER-IN-CHARGE: L.A. COMIS

DATE OF LETTING
 DATE OF CONTRACT
 CONTRACT DATE OF COMPLETION
 CONTRACT EXTENDED
 CONSTRUCTION STARTED
 CONTRACT COMPLETED
 CONTRACT ACCEPTED

MARCH 19, 1952
 APRIL 3, 1952
 AUGUST 1, 1953
 DECEMBER 1, 1953
 JUNE 5, 1952
 NOVEMBER 19, 1953
 NOVEMBER 20, 1953

FED. RD. Div. No.	STATE	FED. AID PROJ. No.	COUNTY	SHEET No.	TOTAL SHEETS
	N.Y.		Madison	1	67

TYPE OF CONSTRUCTION

Asphalt Concrete Pavement, Type 1A, Opt. 2.15 Miles
 Foundation Course Gravel 1.34 Miles

Including

Pine Plains-Kirkville Rd. Bridge-Sta. 64+36
 5 Span I-Beam, 1 @ 51'-8 1/2", 2 @ 39'-3 1/2", and 2 @ 61'-2 1/2"
 Fyler Settlement Rd. Bridge-Sta. 200+06
 2 I-Beam Spans @ 43'-6", and 2 I-Beam (alpha) Spans @ 89'-4"
 Chittenango-Lakeport Rd. Bridge-Sta. 278+18.43
 2 I-Beam Spans @ 36'-6", and 2 I-Beam (alpha) Spans @ 85'-5"
 Gees Road Bridge-Sta. 378+60
 2 I-Beam Spans @ 36'-0", and 3 I-Beam (alpha) Spans @ 54'-0"
 North Main Street, Canastota, Sta. 588+92
 2 I-Beam Spans @ 36'-1 1/2", and 2 I-Beam (alpha) Spans @ 58'-10"

STANDARD STRUCTURE SHEETS

39-9, 47-2, 47-2C, 47-12, 49-4S, 49-7, 49-43, 50-1R,
 50-10, 50-34, 51-33R, 52-41

All work contemplated under this contract to be covered by and in conformity with the specifications adopted January 2, 1951, except as modified on these plans and in the itemized Proposal.

NEW YORK STATE DEPARTMENT OF PUBLIC WORKS
DIVISION OF CONSTRUCTION

Approved: J. B. McMorran
 Chief Engineer

Approved: Feb 29 1952
 E. T. GAWKINS
 Deputy Chief Engineer

APPROVED Feb. 29, 1952
 NEW YORK STATE THRUWAY AUTHORITY
 B. D. TALLAMY, Chairman
 By: C. H. LANG
 DEPUTY CHIEF ENGINEER

RECOMMENDED FOR APPROVAL DATE

DISTRICT ENGINEER
 BUREAU OF PUBLIC ROADS
 DEPARTMENT OF COMMERCE

APPROVED DATE





DIVISION ENGINEER
 BUREAU OF PUBLIC ROADS
 DEPARTMENT OF COMMERCE

Approved: E. W. WENDELL
 Deputy Chief Engineer

PREPARED PURSUANT TO THE
 HIGHWAY LAW & RECOMMENDED BY:
 E. T. GAWKINS
 ENGINEER DISTRICT No. 2
 DATE

MADE BY: Traced By: Checked By:
 PLAN D. Lewis Colangelo
 PROFILE

FED. AID DIST. NO.	STATE	FED. AID PROJ. NO.	FISCAL YEAR	SHEET NO.	TOTAL SHEETS
	N.Y.			2	67
MOHAWK THRUWAY					
FROM MADISON COUNTY TO MADISON COUNTY					

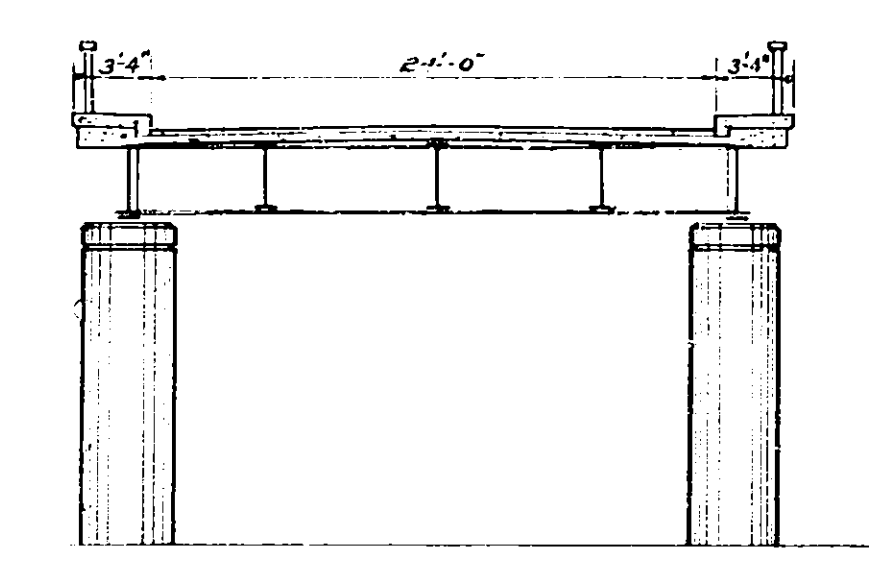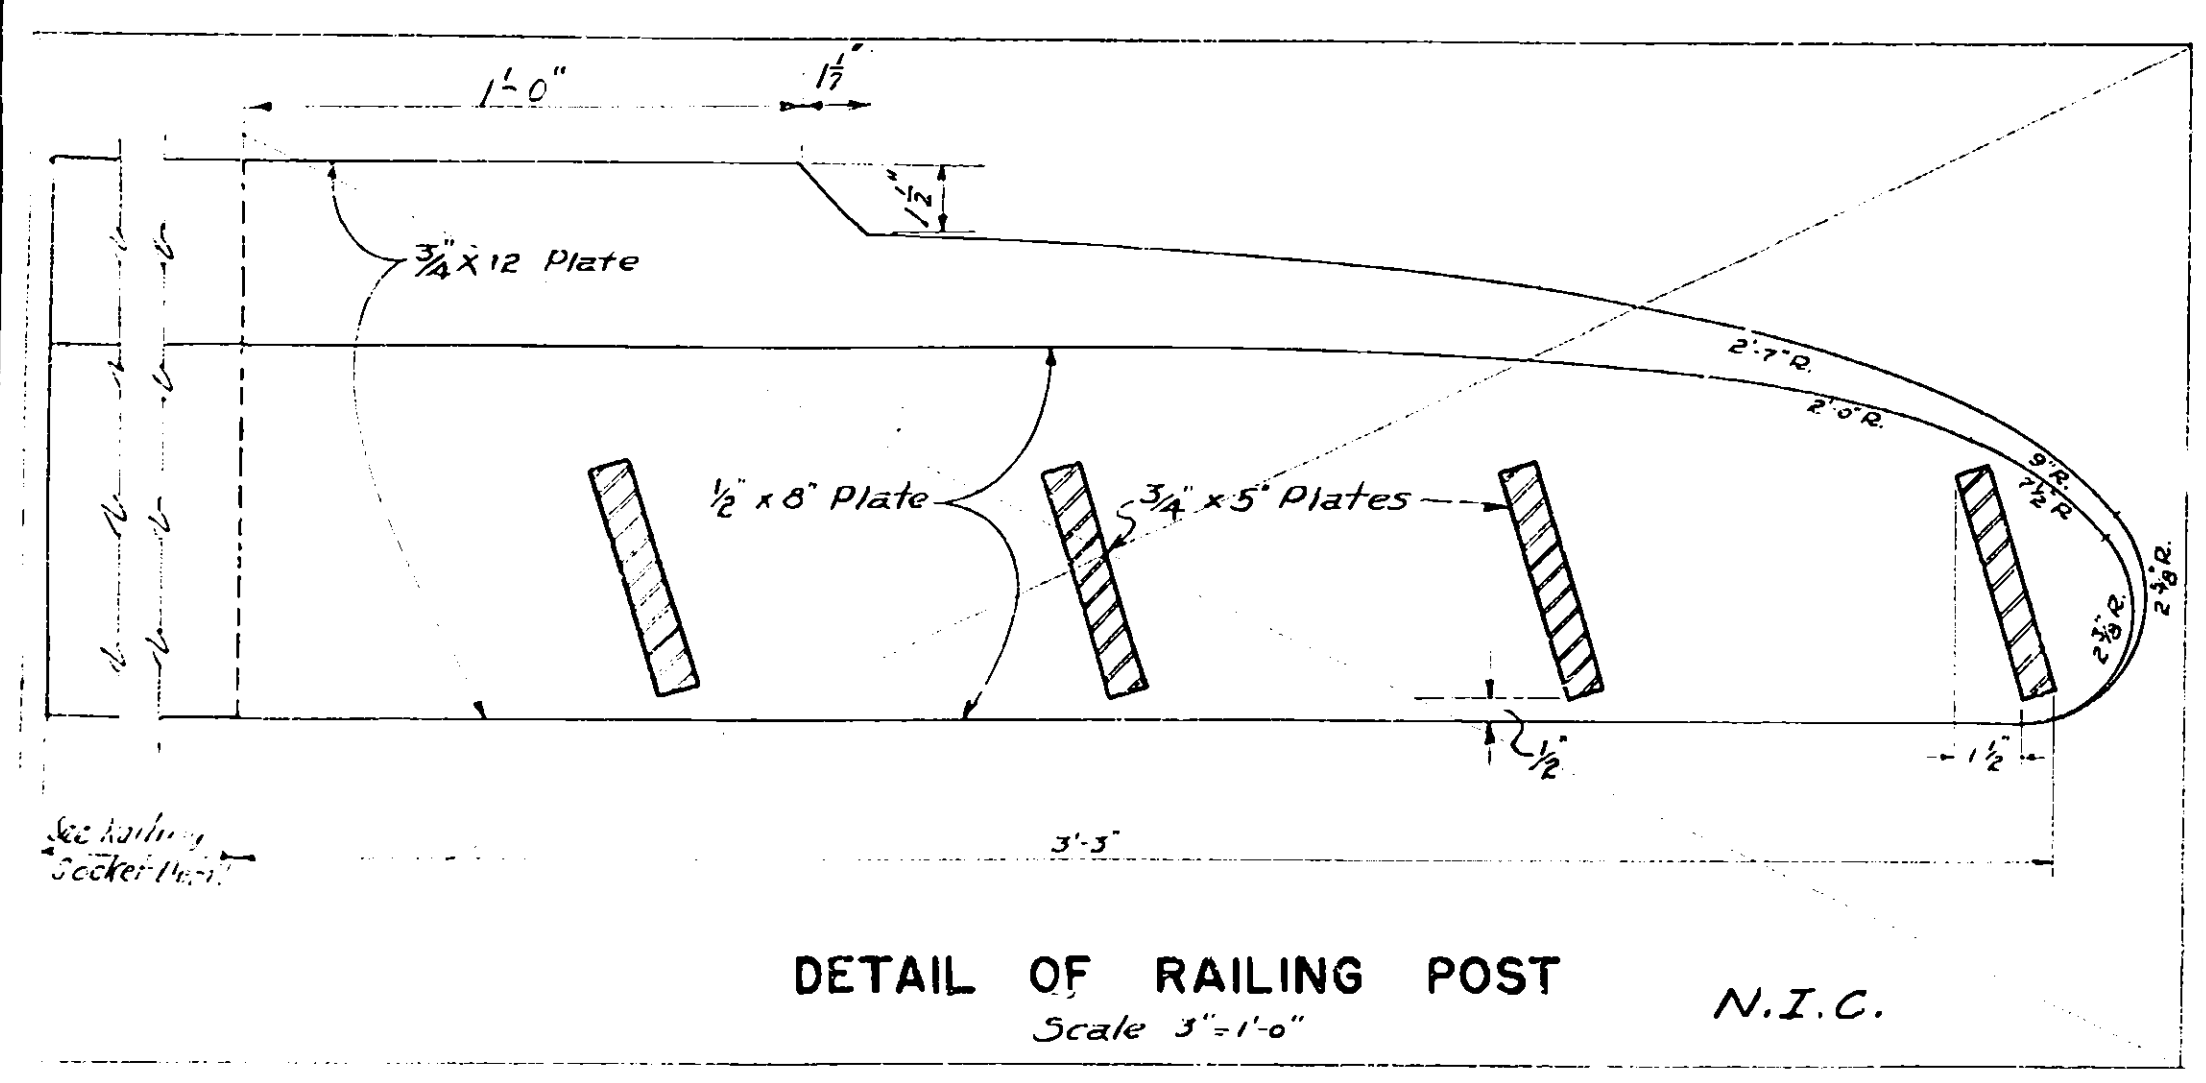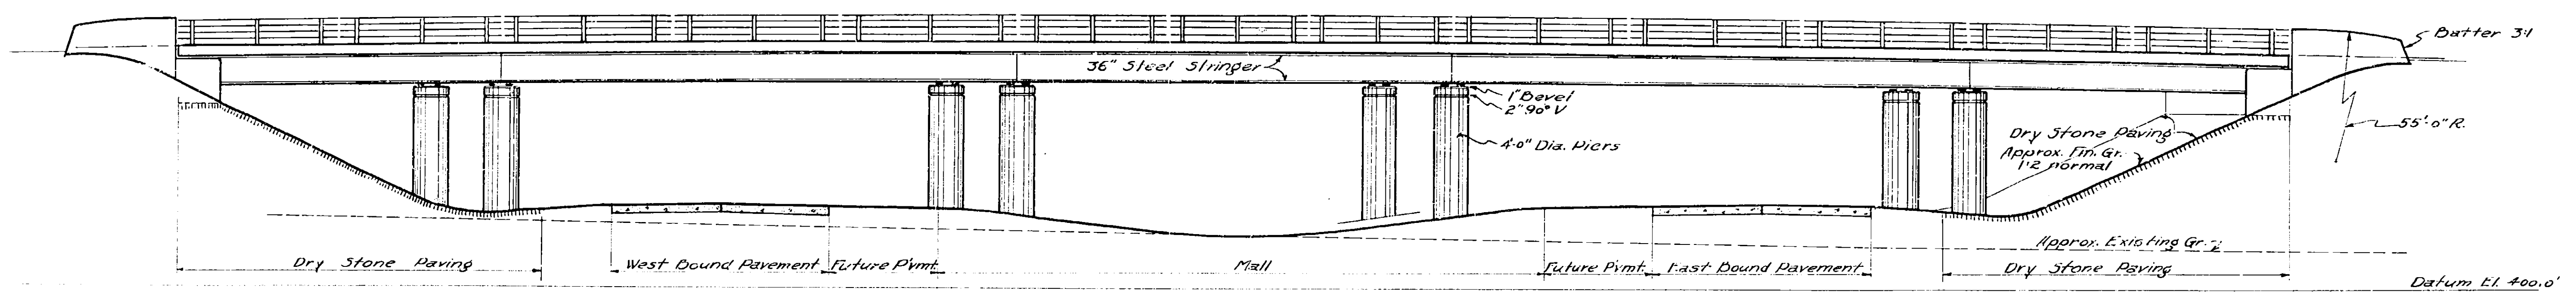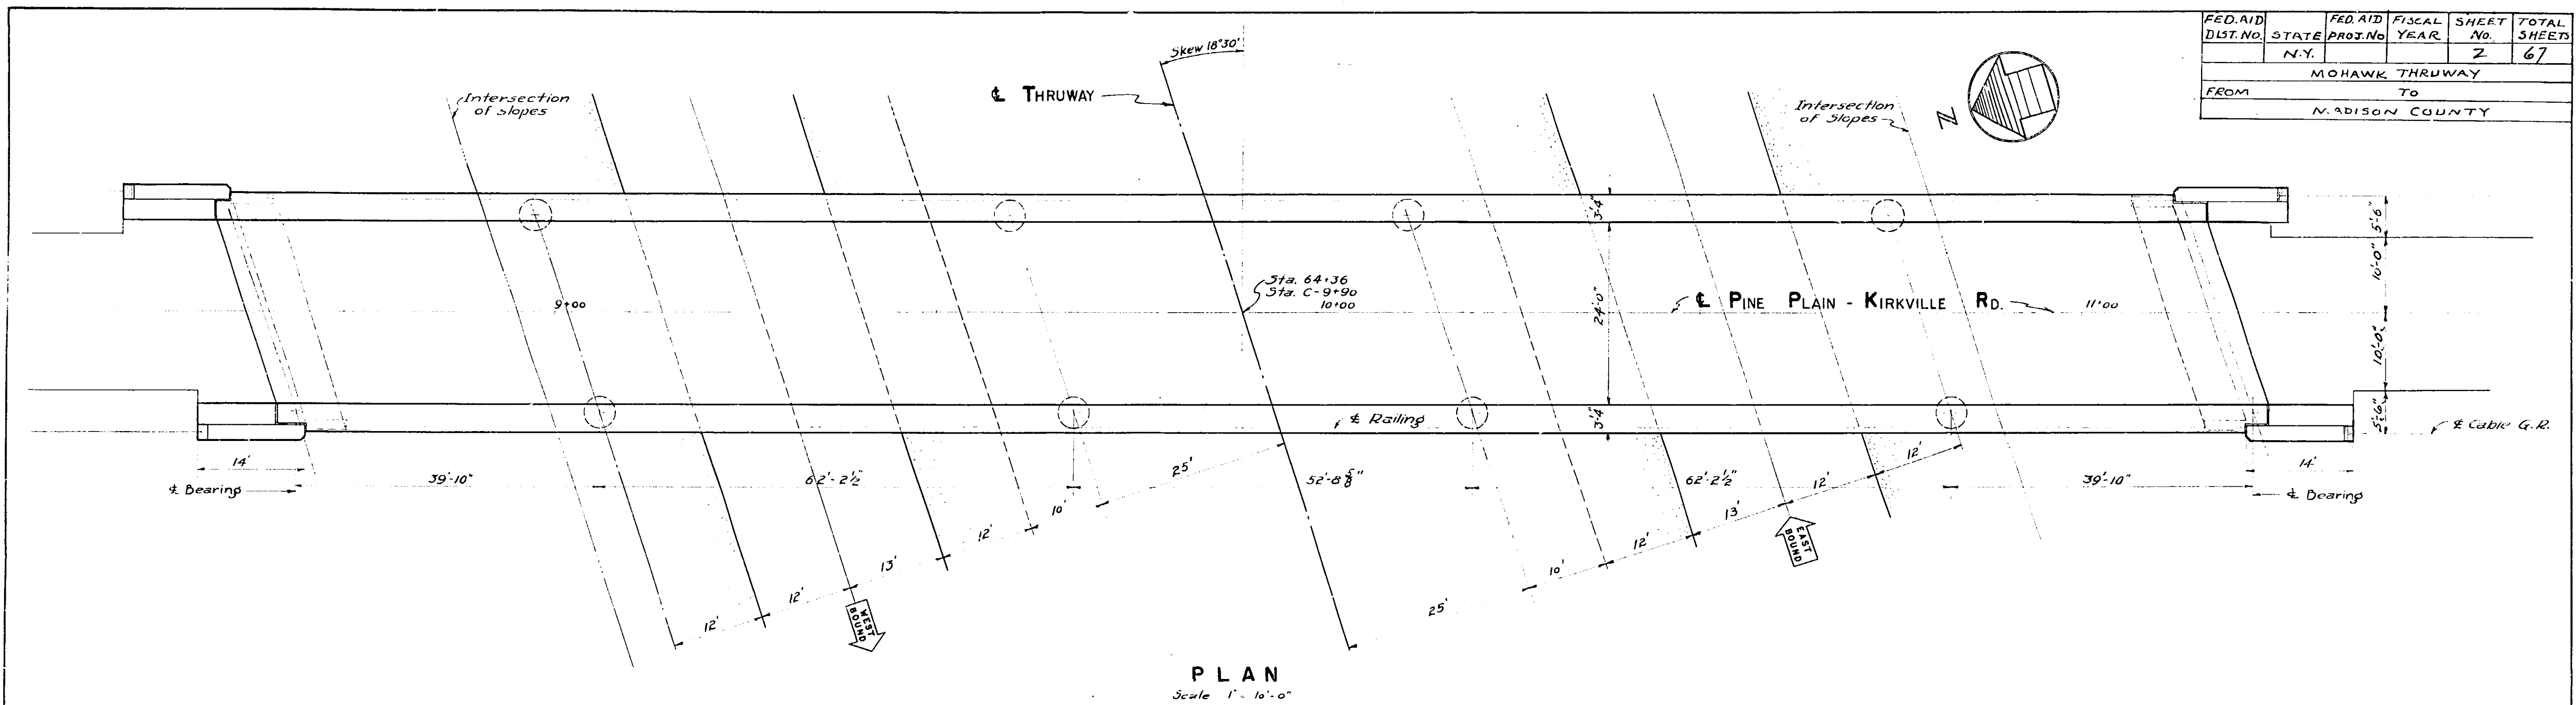

Note:
The Contractor's attention is directed to the special notes for this structure which appears in the proposal. Particular attention should be given to the foundation note which briefly outlines the anticipated subsurface conditions of the site of the structure and which specifies certain requirements relative to construction.

MOHAWK THRUWAY
UNDER
PINE PLAIN - KIRKVILLE RD.
MADISON CO. STA. 64 + 36

ARCHITECTURAL PLAN
ELEVATION AND DETAILS
SCALE - AS INDICATED

MADE BY
TRACED BY W.BERARD
CHECKED BY

FED. AID DIST. NO.	STATE	FED. AID PROJ. NO.	FISCAL YEAR	SHEET NO.	TOTAL SHEETS
	N.Y.			3	67
FROM MADISON COUNTY TO MADISON COUNTY					





TOTAL ESTIMATE OF QUANTITIES
SUBSTRUCTURE & SUPERSTRUCTURE

NO.	ITEM	UNIT	MEAS.	ROUNDED
9	Trench, Culvert and Bridge Excavation	Cu Yds.	334	380
15-2	Portland Cement - Type 3	Bbls.	1080	1152
15-N	Natural Cement - Type N	Bbls.	158	166
18	Class 1A Concrete for Structures (1:2:3 1/2 Approx.)	Cu Yds.	385	406
20	Class 1 Concrete (1:2:4 Approx.)	Cu Yds.	224	236
25-F	Steel Fabric Reinforcement	Sq Yds.	835	850
25	Bar Reinforcement for Structures	Lbs.	20910	21000
29	Structural Steel	Lbs.	26870	27000
37	Metal Baling	Lin Ft.	511	515
17B	Cement Concrete Pavement	Cu Yds.	65	70
19	Class 1A Concrete for Railings (1:2:3 1/2 Approx.)	Cu Yds.	12	13
19	Dry Stone Paving	Sq Yds.	321	340
85C	Cast-in-Place Concrete Piles	Lin Ft.	3320	3600
87	Furnishing Equipment for Driving Piles	L.S.	Neg.	Neg.
121	Top Soil Placed from Stockpiles	Cu Yds.	267	290
123B	Seeding on Prepared Areas	Acre	0.38	0.50
124	Sodding	Sq Yd.	596	650

BAR LIST


MARK	SIZE	No.	LENGTH	DESCRIPTION
SA	3/4"	18	8'-3"	Vertical Bars in front of backwall
SA1	3/4"	18	8'-9"	Vertical Bars in rear of backwall (Bent in field)
SB	1/2"	6	30'-0"	Longit. Bars in backwall (Set by 12' 3 1/2' back)
SC	3/4"	10	30'-0"	Longit. Bars in Bridge Seat (Set by 12' 3 1/2' back)
SD	1/2"	18	4'-0"	Transverse bars in bridge seat
SE	3/4"	40	8'-3"	Vertical bars in walls in front of Pylon
SF	1/2"	24	12'-5"	Ties in walls
SG	3/4"	40	5'-10"	Vertical bars in Pylons (Bent to 22° over in field)
SH	1/2"	24	13'-6"	Longit. bars in Pylons
SJ	3/4"	68	10'-0"	Vertical bars in wingwalls
SK	1/2"	8	17'-8"	Longit. Bars in wingwalls
SL	1/2"	8	19'-4"	Longit. Bars in wingwalls
SM	1/2"	8	20'-0"	Longit. bars in wingwalls
SN	1/2"	8	15'-9"	Longit. bars in wingwalls
SP	7/8"	16	7'-6"	Bars in Pylons
SS	3/4"	28	32'-0"	Bars in Abutment Footings
ST	1/2"	28	6'-6"	Bars in Abutment Footings
SU	3/4"	24	20'-0"	Bars in Wingwall Footings
SV	3/4"	8	18'-0"	Bars in Wingwall Footings
SW	3/4"	8	16'-0"	Bars in Wingwall Footings
SX	1/2"	32	4'-6"	Spacers in Wingwall Footings
SY	3/4"	168	19'-0"	Bars in Abutment Piles
SZ	1/4"	448	2'-8"	Ties in Abutment Piles - The exact length of these ties will be determined in the field after type of pile has been determined.
PIERS				
PA1	1"	64	16'-7"	Vertical bars in Cols. - 1 & 4
PA2	1"	64	17'-3"	" " " " " 2 & 3
PB	1"	128	6'-8"	" " " " " footings
PC1	3/4"	56	8'-8"	Trans. bars in footings - Piers 1, 2, 4
PC2	3/4"	72	6'-8"	Longit. " " " " " Piers 1, 2, 4
PD	3/8"	132	12'-3"	1/4" x 2" Ties in Column
PF	3/4"	288	16'-0"	Bars in C.I.P. Piles
PG	1/2"	624	2'-8"	Ties in C.I.P. Piles - The exact length of ties will be determined in the field after type of pile has been determined.

Concrete in abutments shall be Item #20
Concrete in piers including footings shall be Item #18
Concrete in pylons shall be Item #19
Payment for furnishing and placing anchor bolts and nuts will be made under Item #29
Bridge seat areas directly under ends of beams shall be bush hammered for perfect bearing if directed by the Engineer in the field
Estimated length of cast-in-place concrete piles shall be as follows -
Piers - 40'
Abutment - 50'

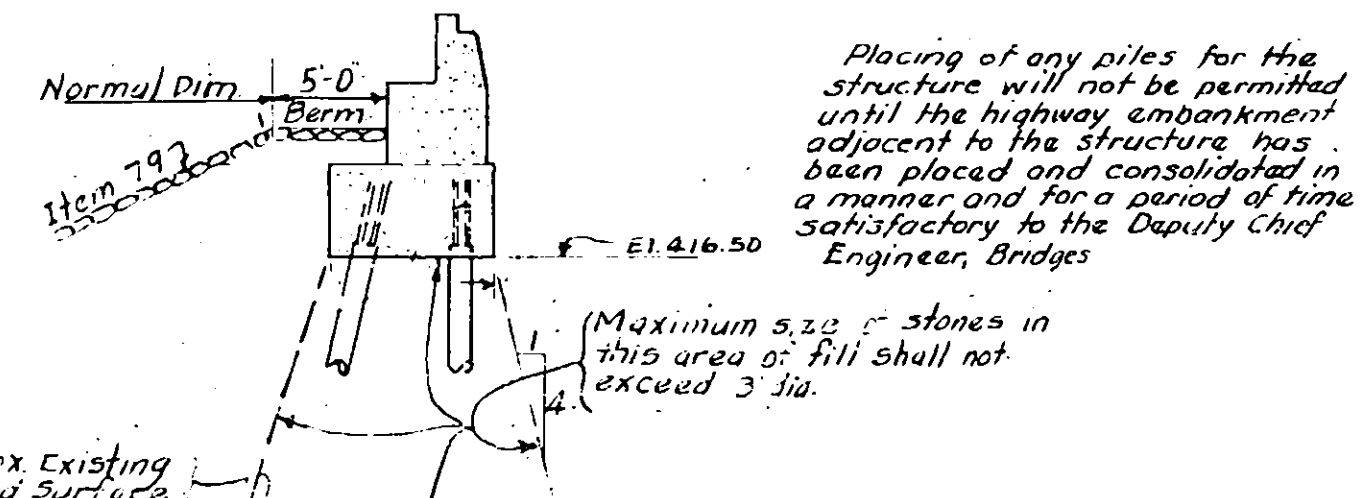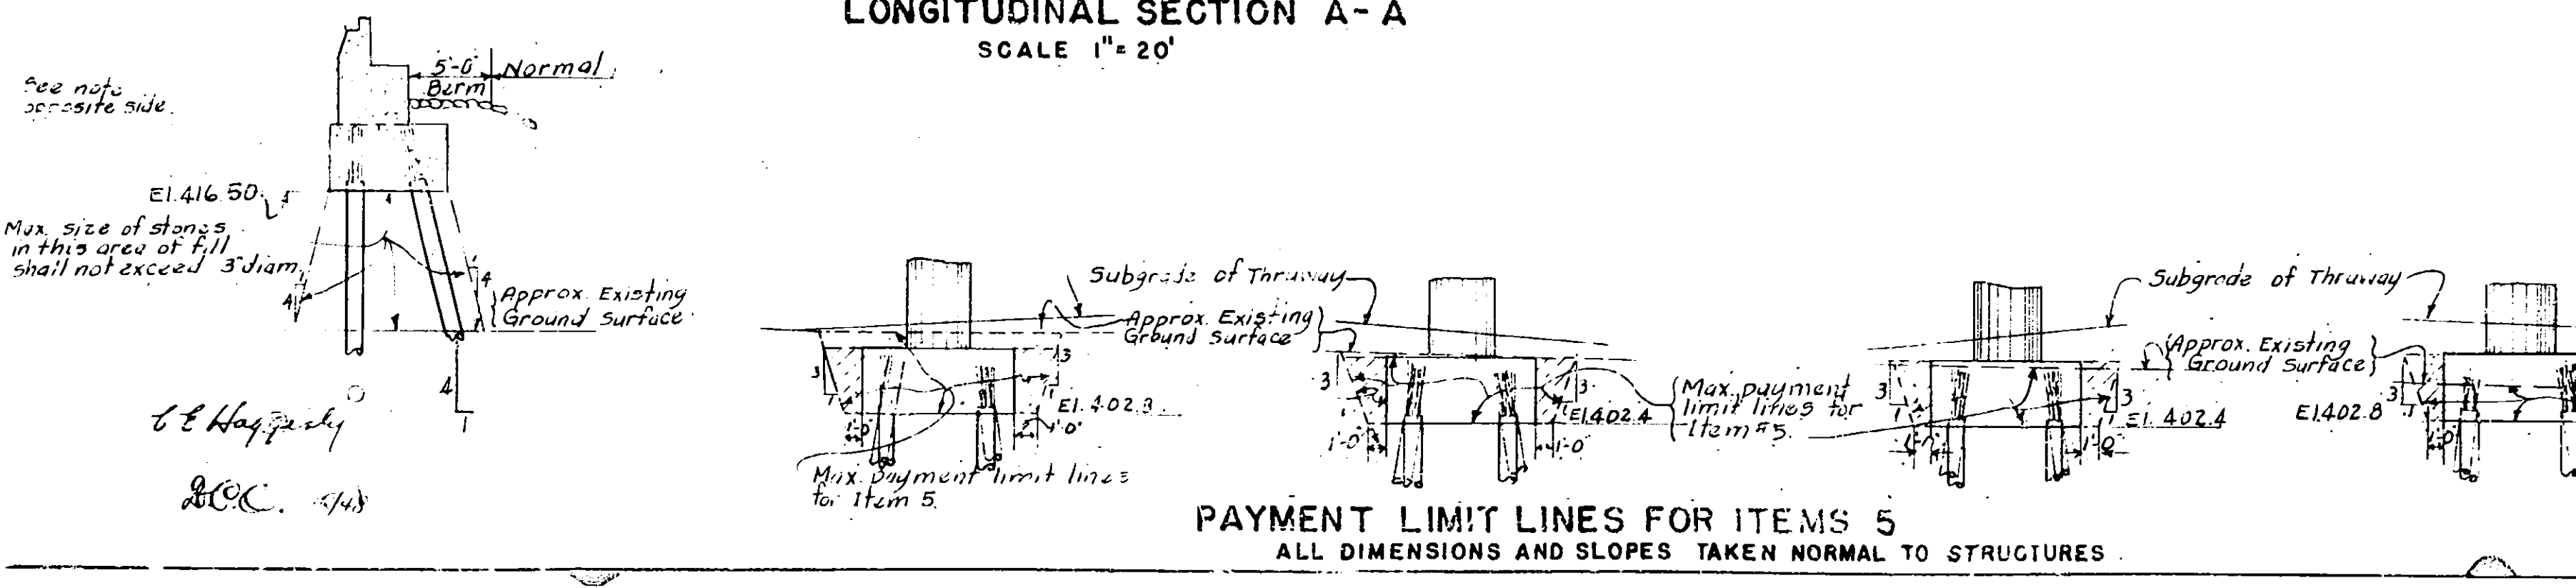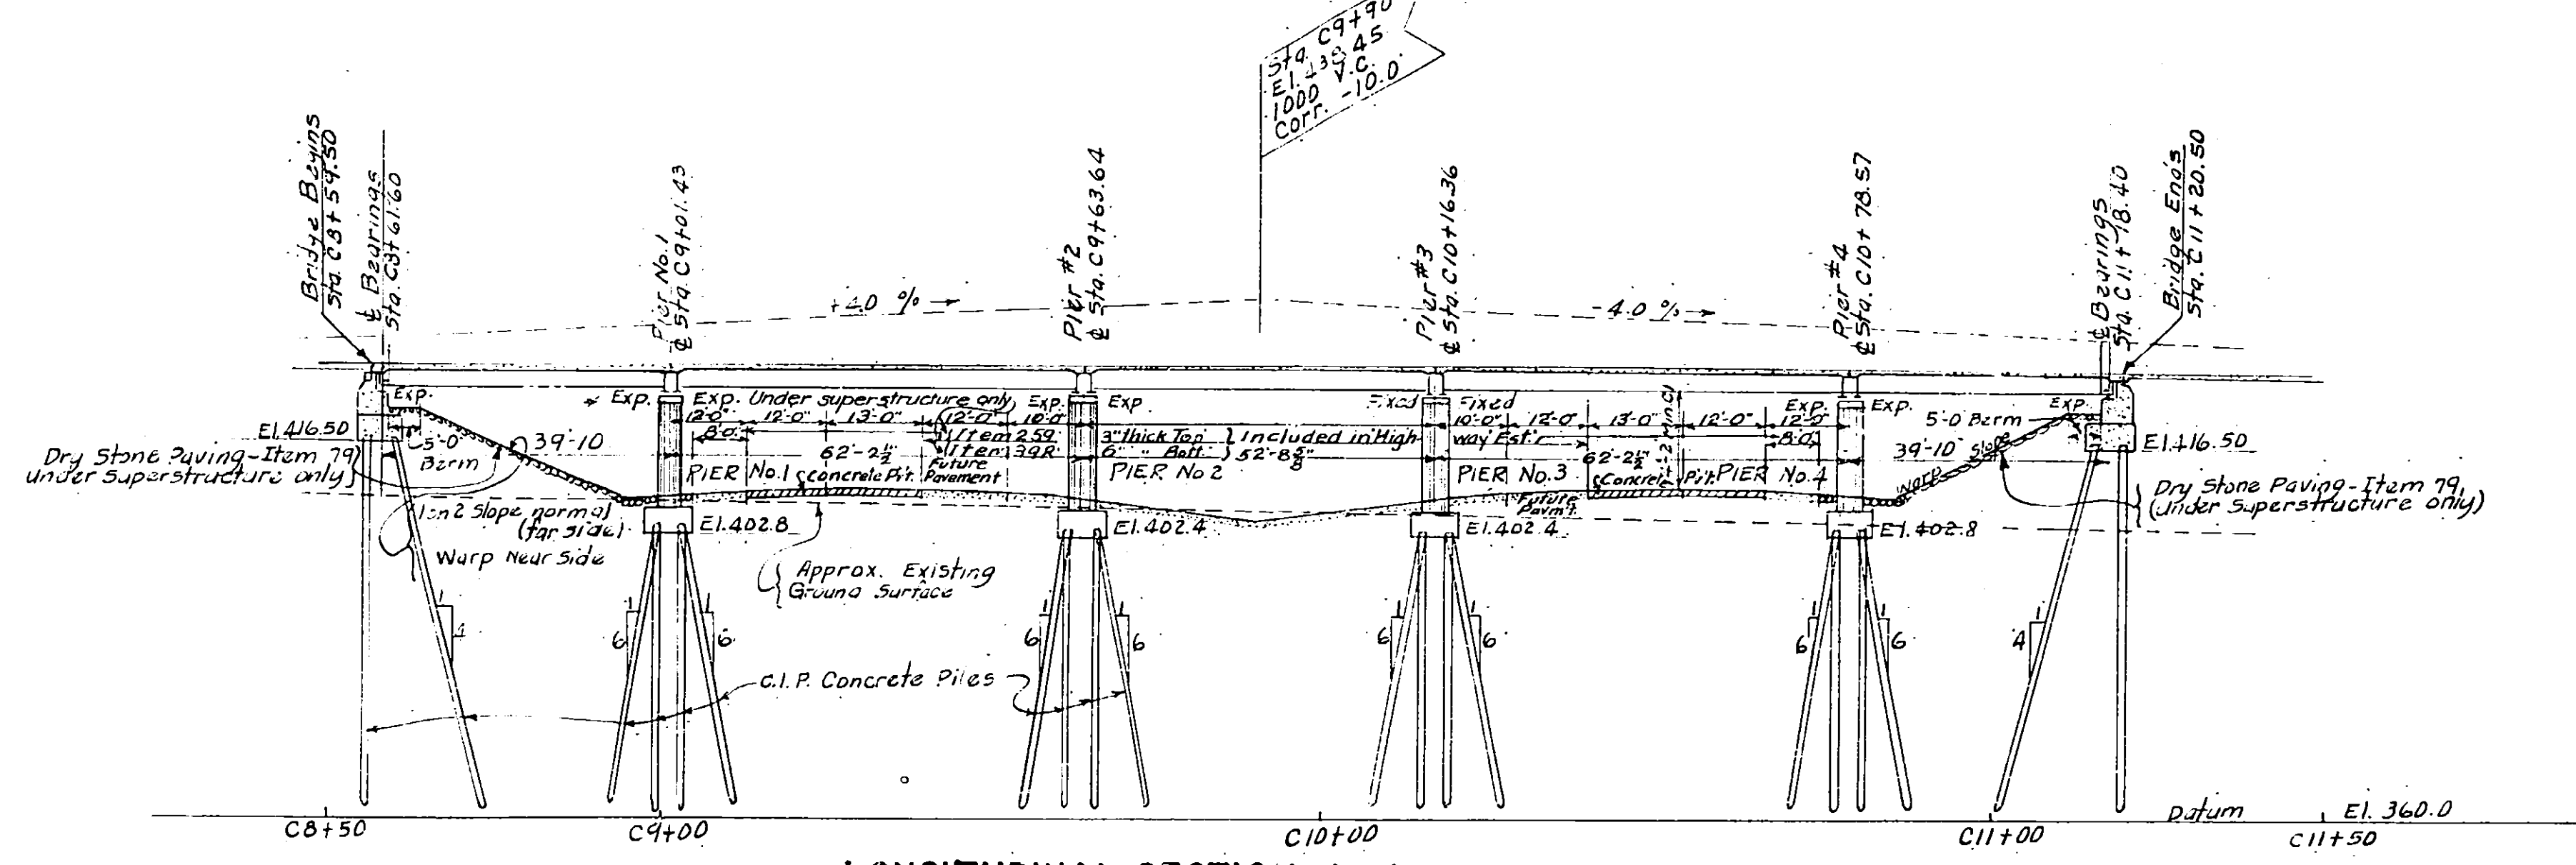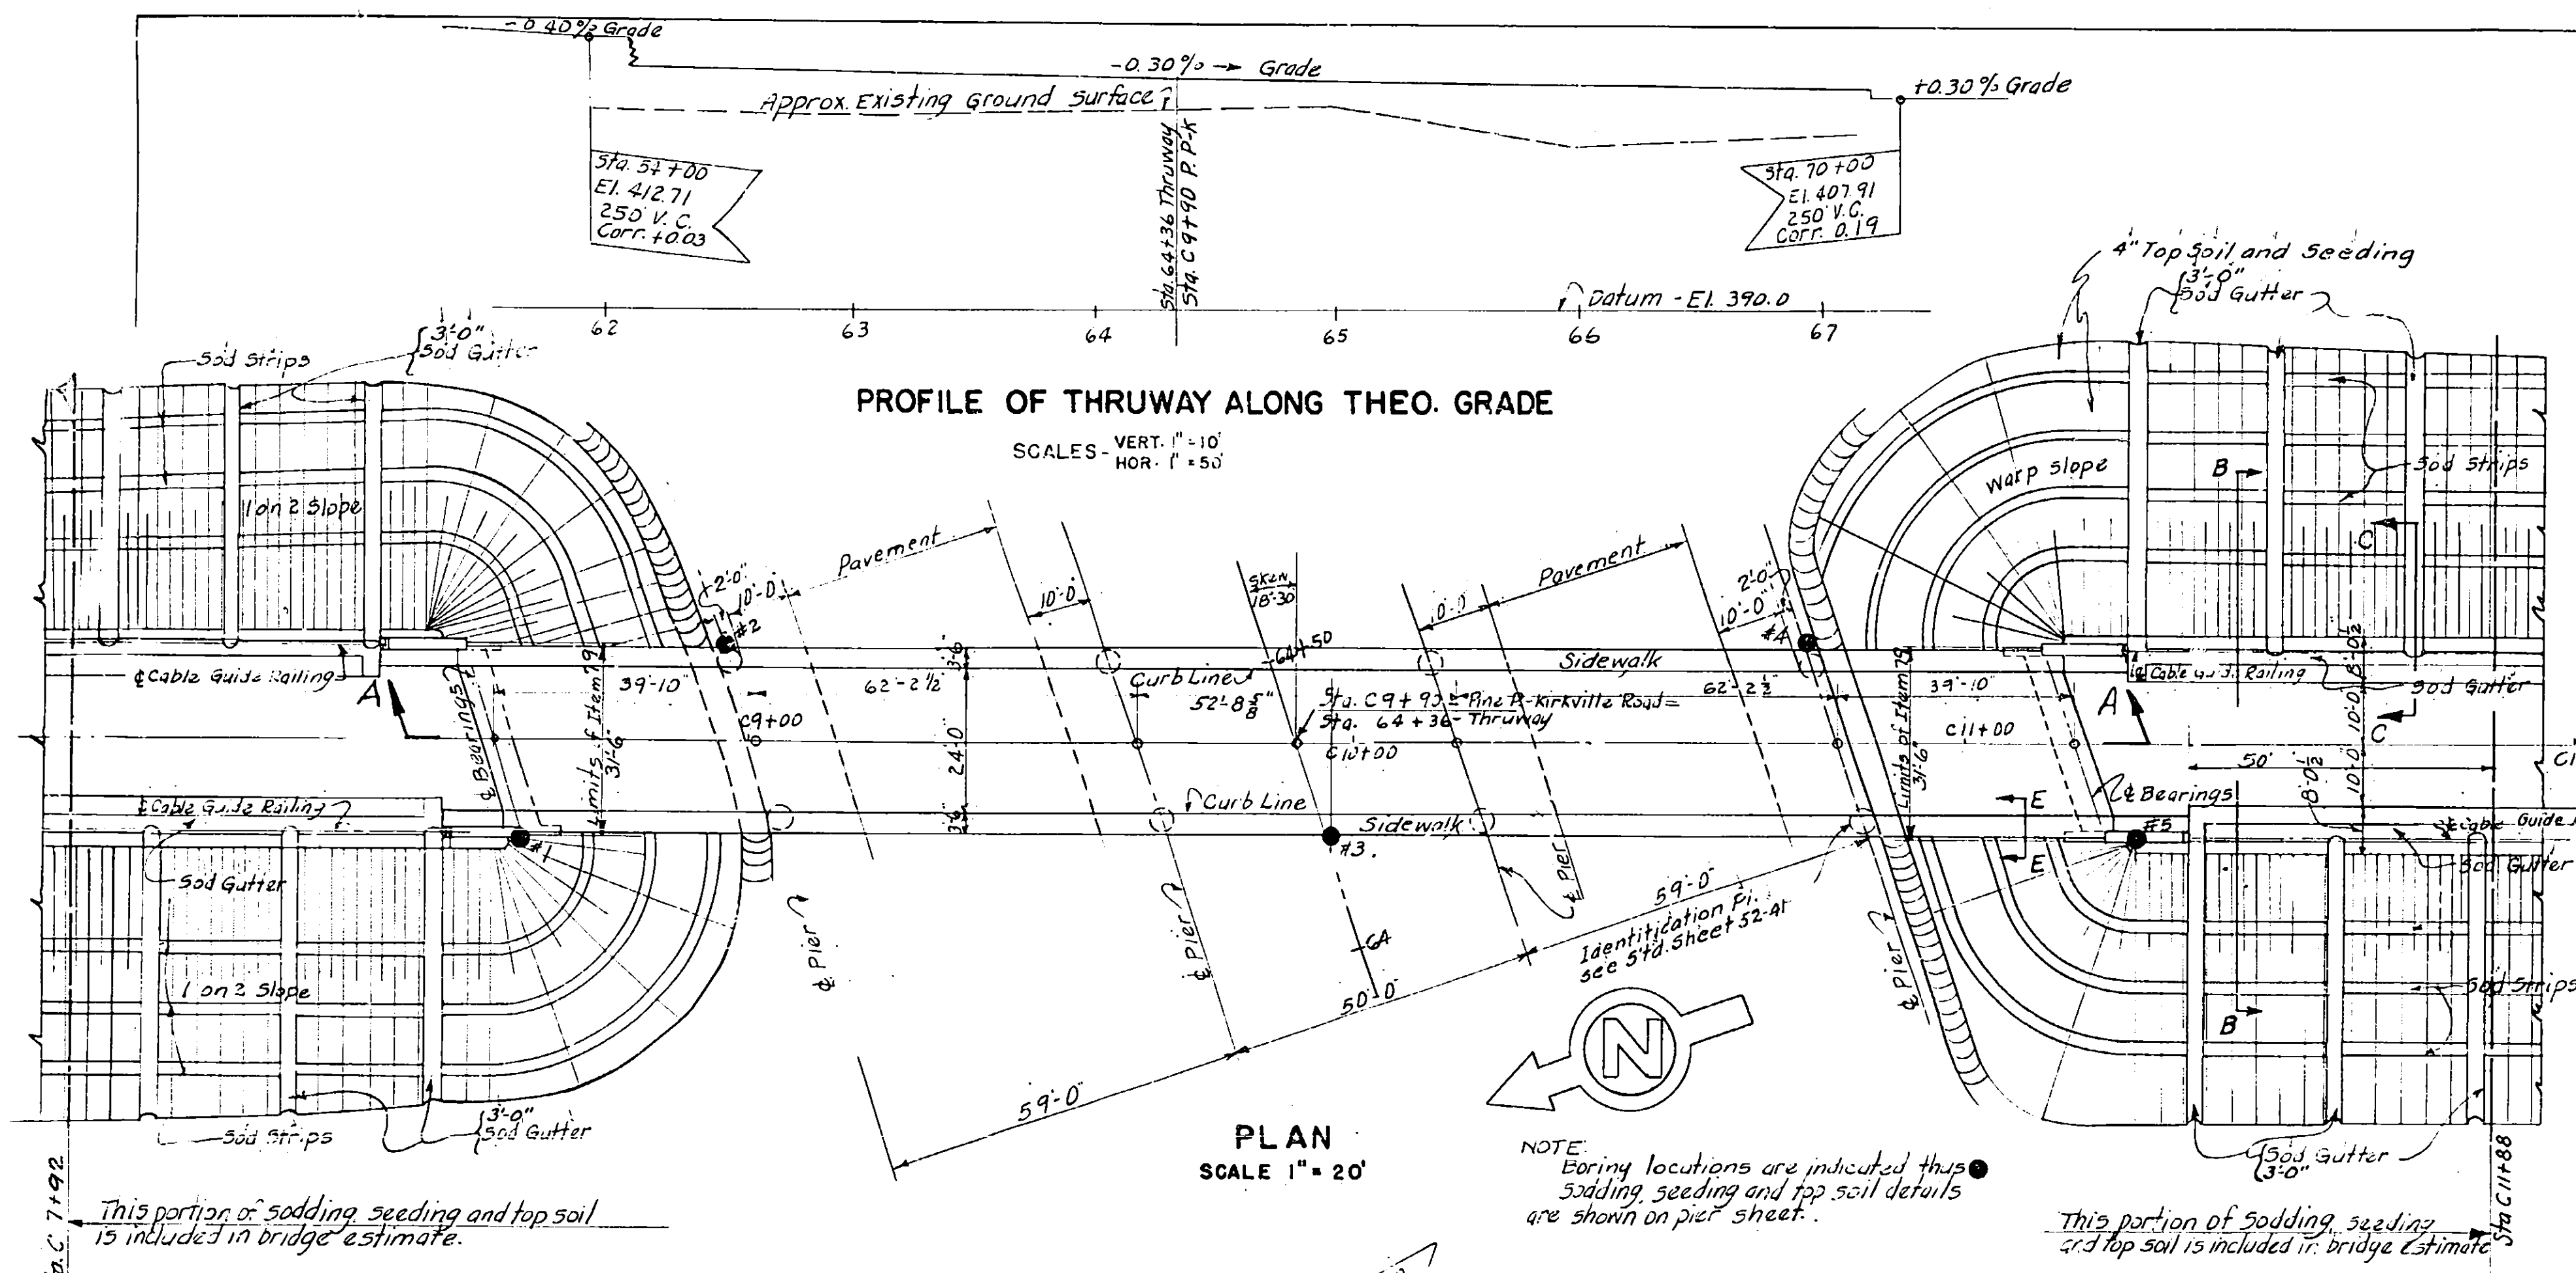


PINE PLAIN-KIRKVILLE ROAD
STA. 64 + 36
PLAN & PROFILE


FED. AID DIST. NO.	STATE	FED. AID PROJ. NO.	FISCAL YEAR	SHEET NO.	TOTAL SHEET
	N.Y.			4	67
MOHAWK THRUWAY					
FROM			TO		
MADISON COUNTY					

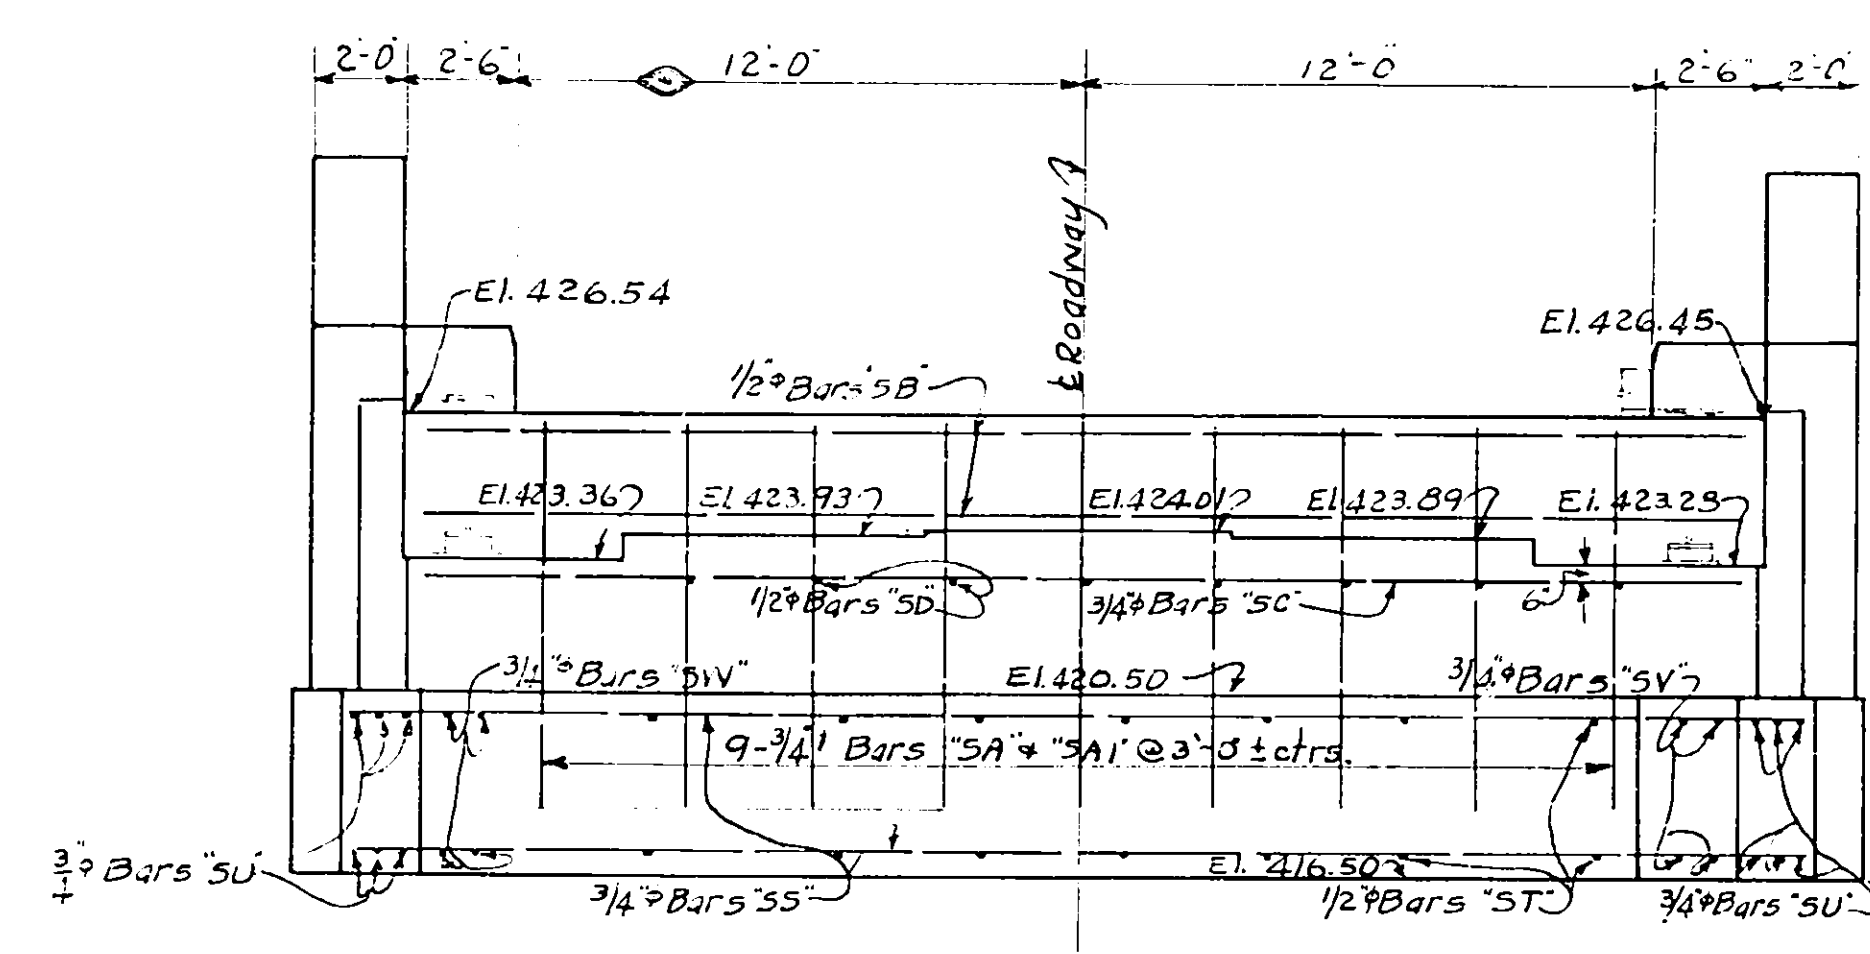


FRONT ELEVATION
BOTH ABUTMENTS
SCALE 1/4"=1'-0"

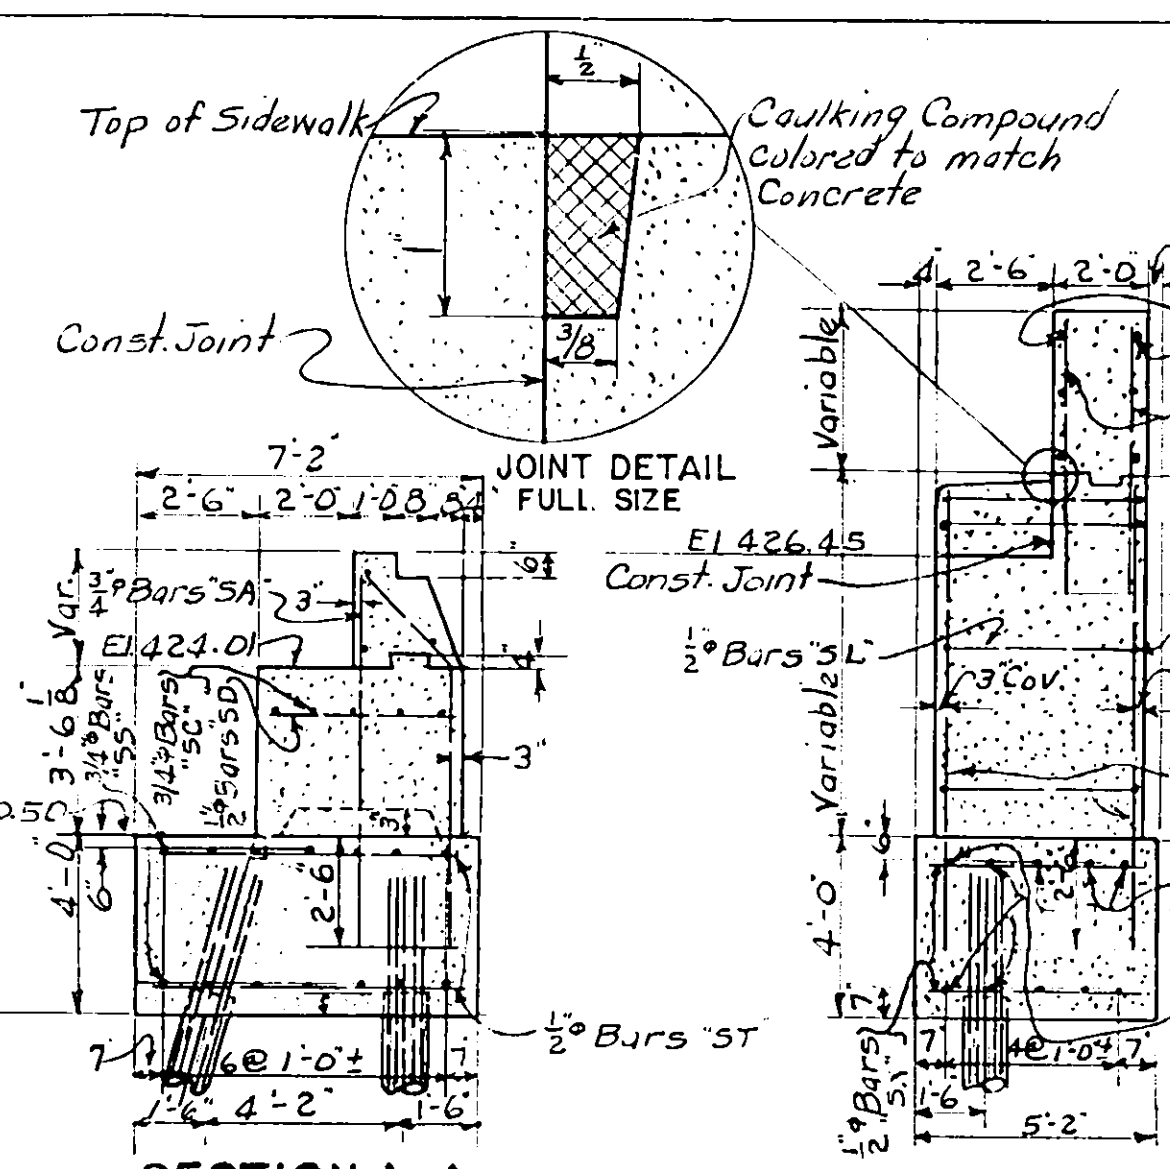


SECTION A-A
SCALE 1/4" = 1'-0"

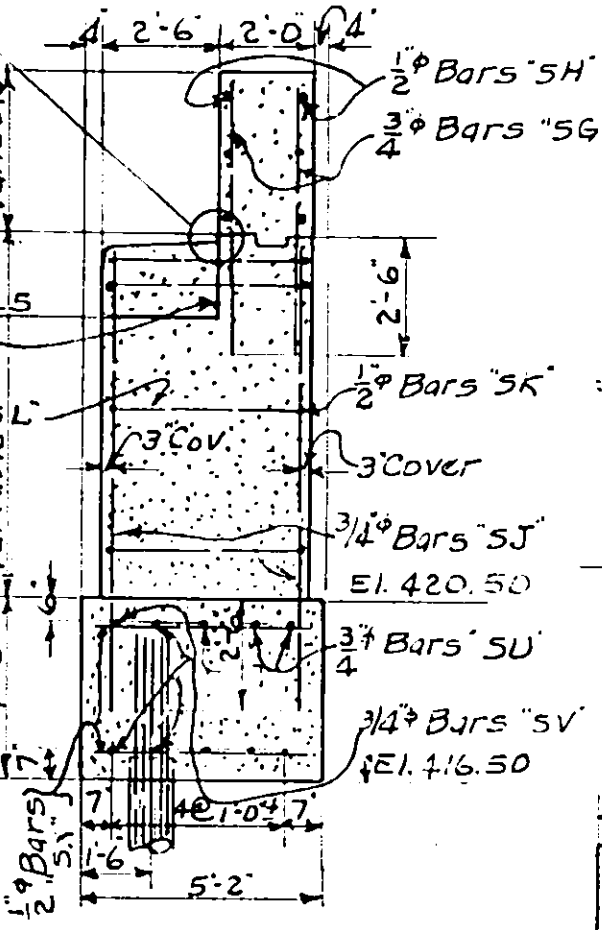

SECTION B-B
SCALE 1/4"=1'-0"

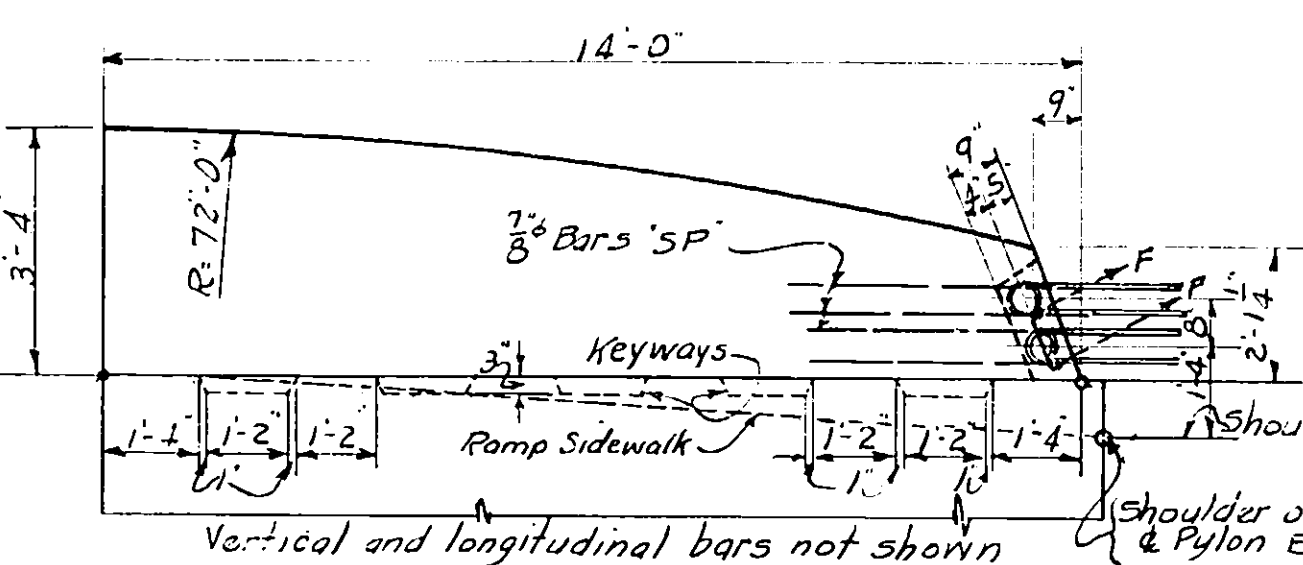


DETAIL OF PYLON
SCALE 3/8"=1'-0"

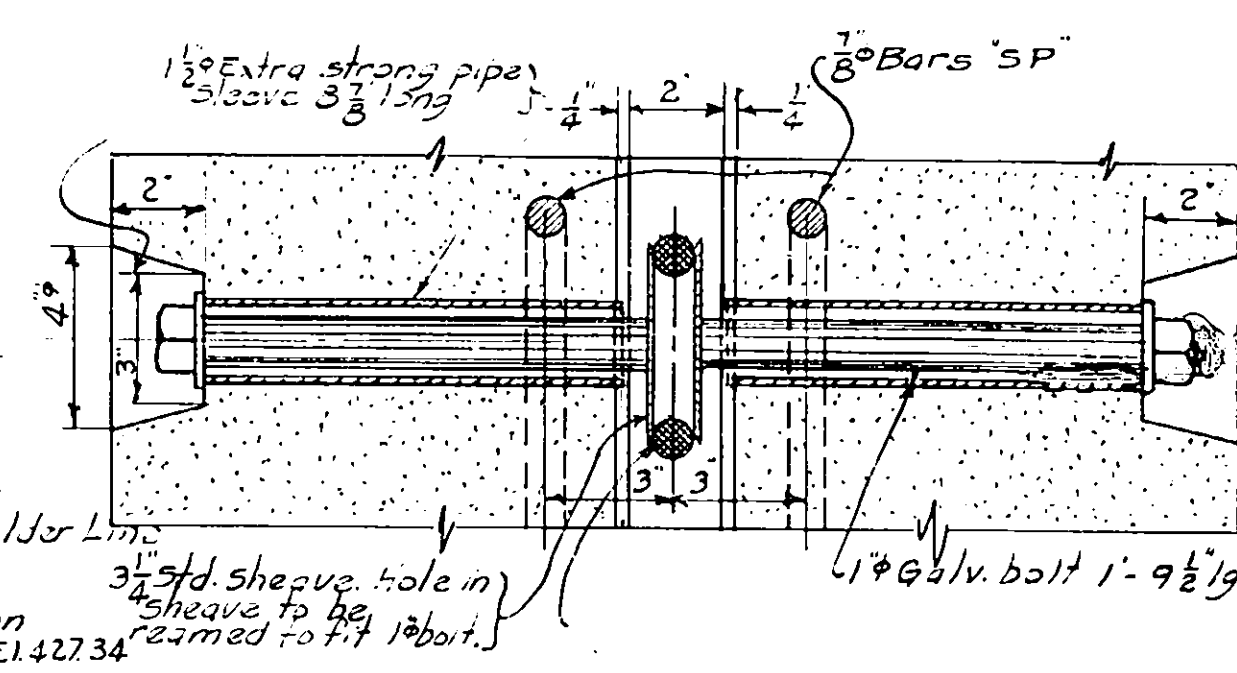


DETAIL F-F
SCALE 3"=1'-0"


Sheaves sleeves and bolts for cable guide rail connections will be paid for under Item #29.

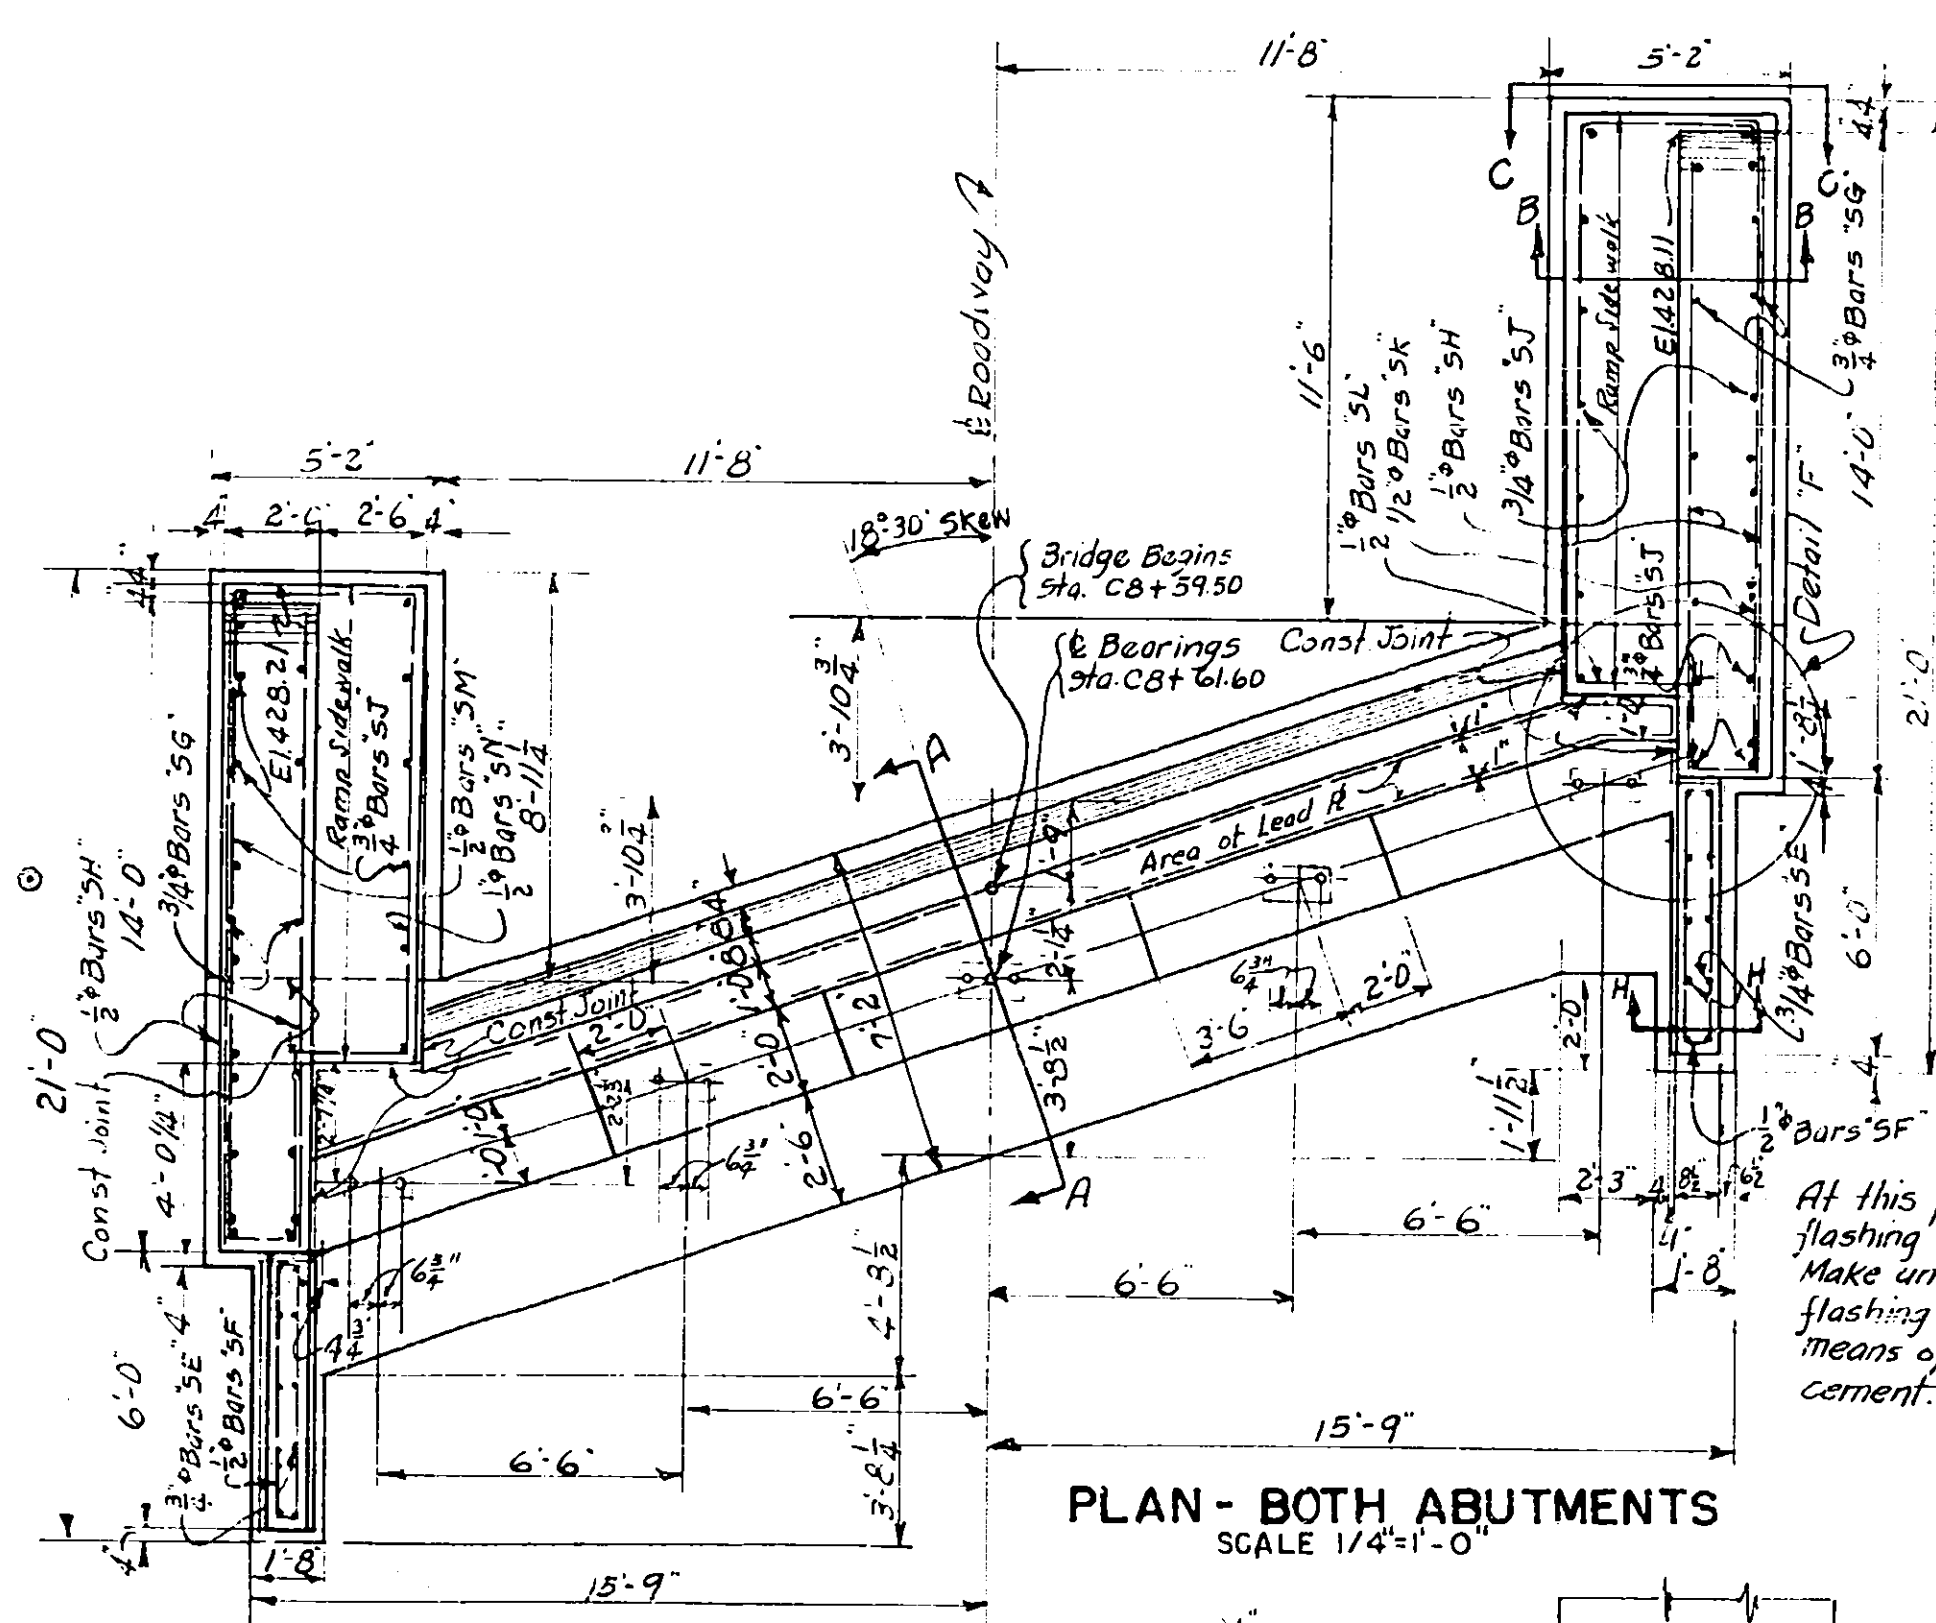


PLAN - BOTH ABUTMENTS
SCALE 1/4"=1'-0"

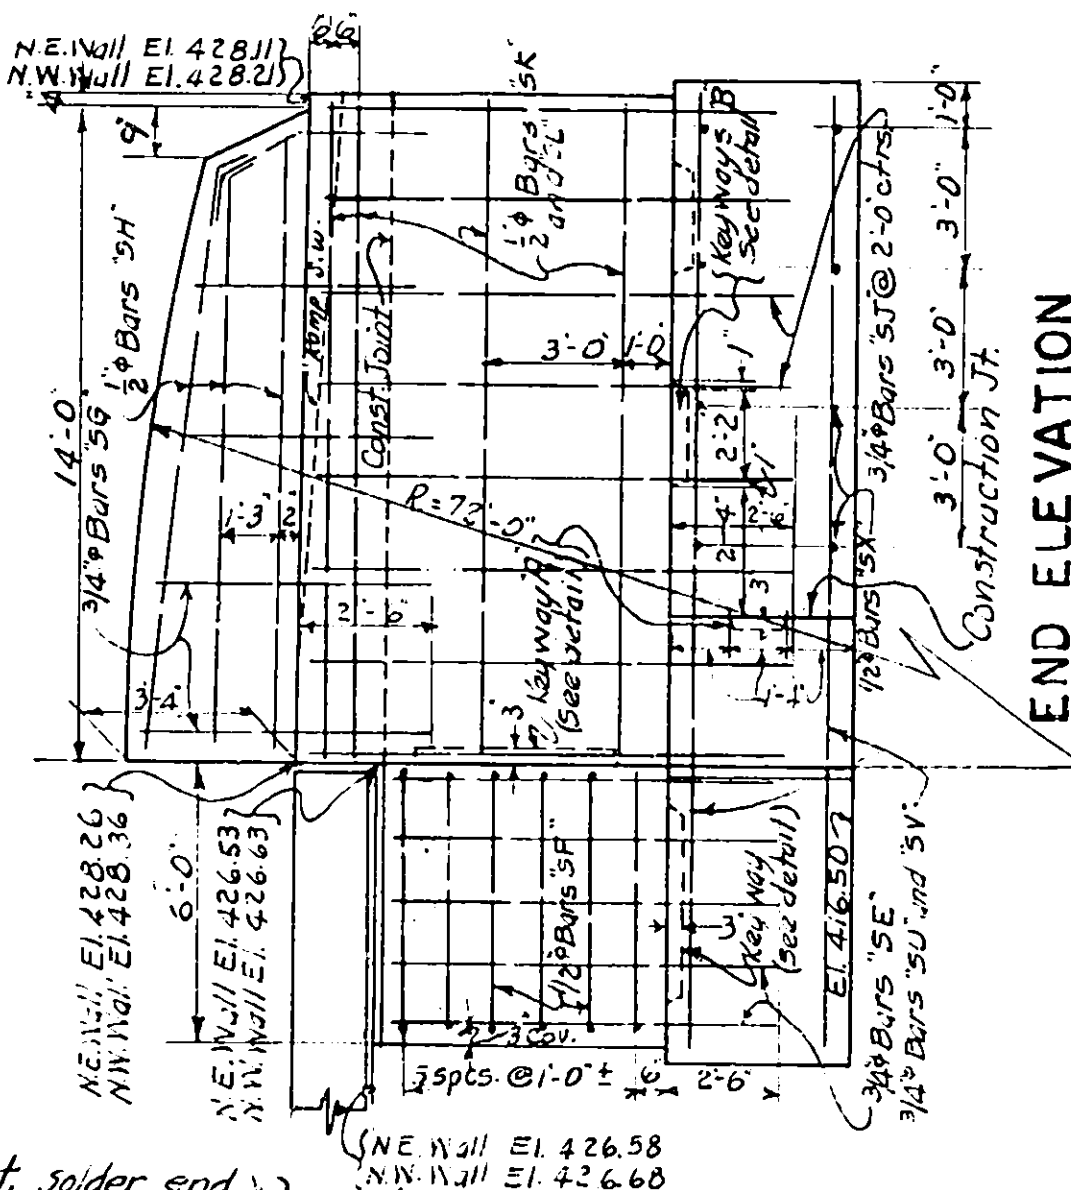


Construction Jt.
END ELEVATION
SCALE 1/4"=1'-0"

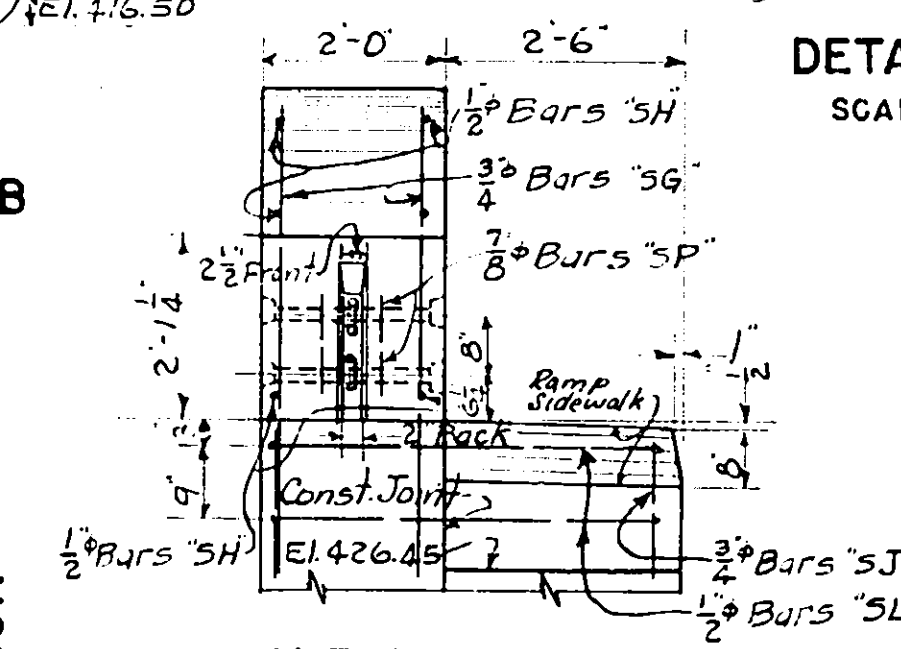


VIEW C-C
SCALE 1/2"=1'-0"

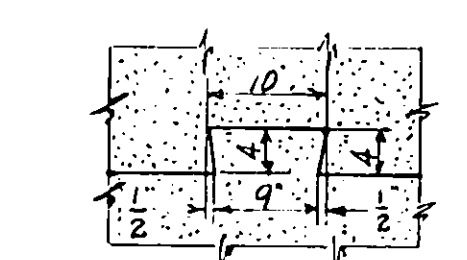

BACKWALL KEYWAY
SCALE 3/4"=1'-0"

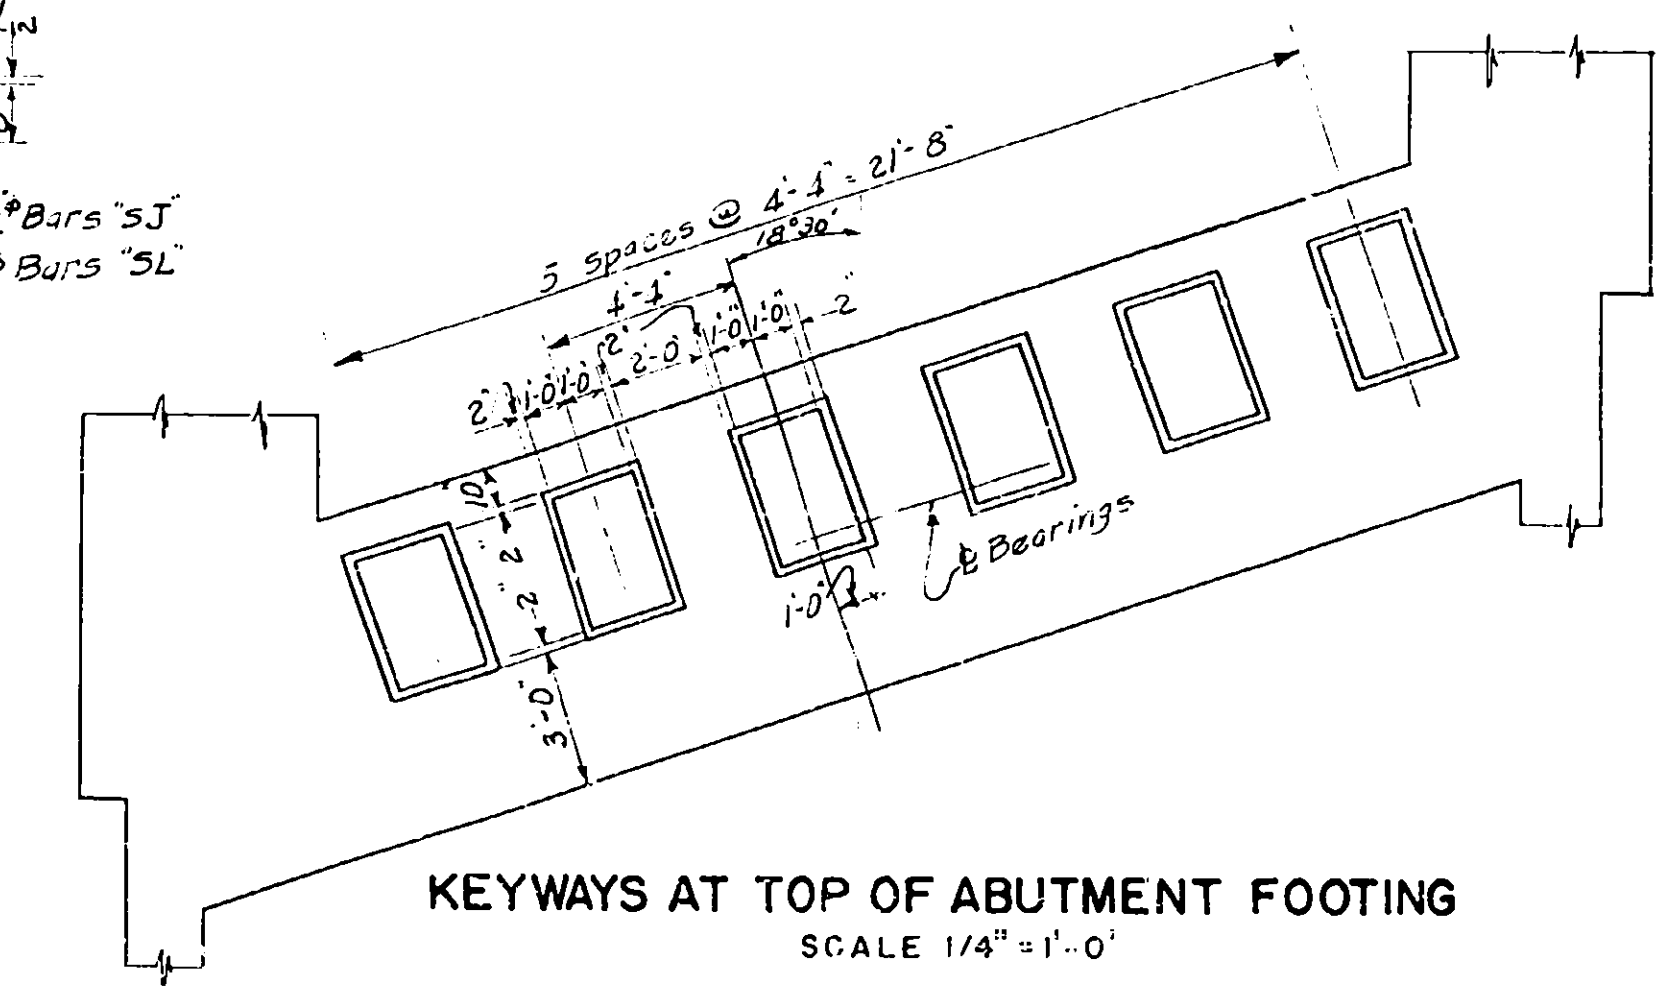


KEYWAYS AT TOP OF ABUTMENT FOOTING
SCALE 1/4" = 1'-0"

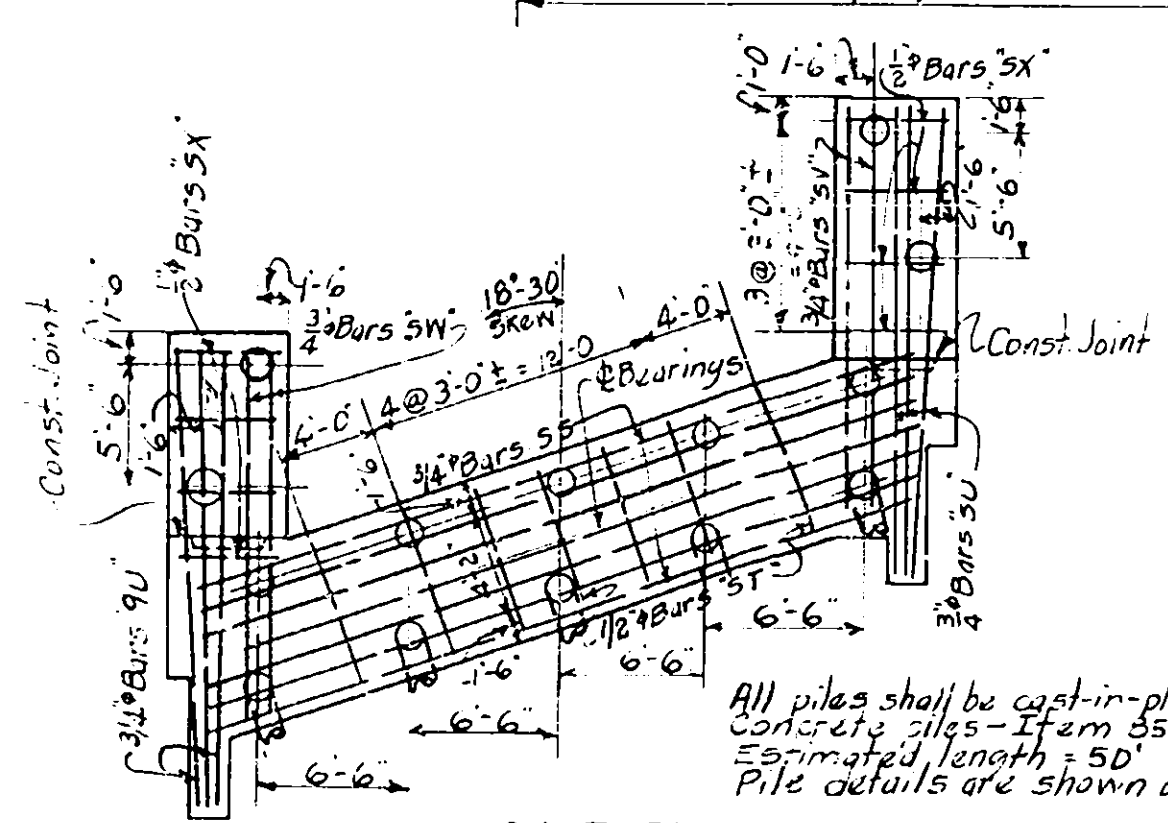


PILE PLAN


BOTH ABUTMENTS
SCALE 1/8" = 1'-0"

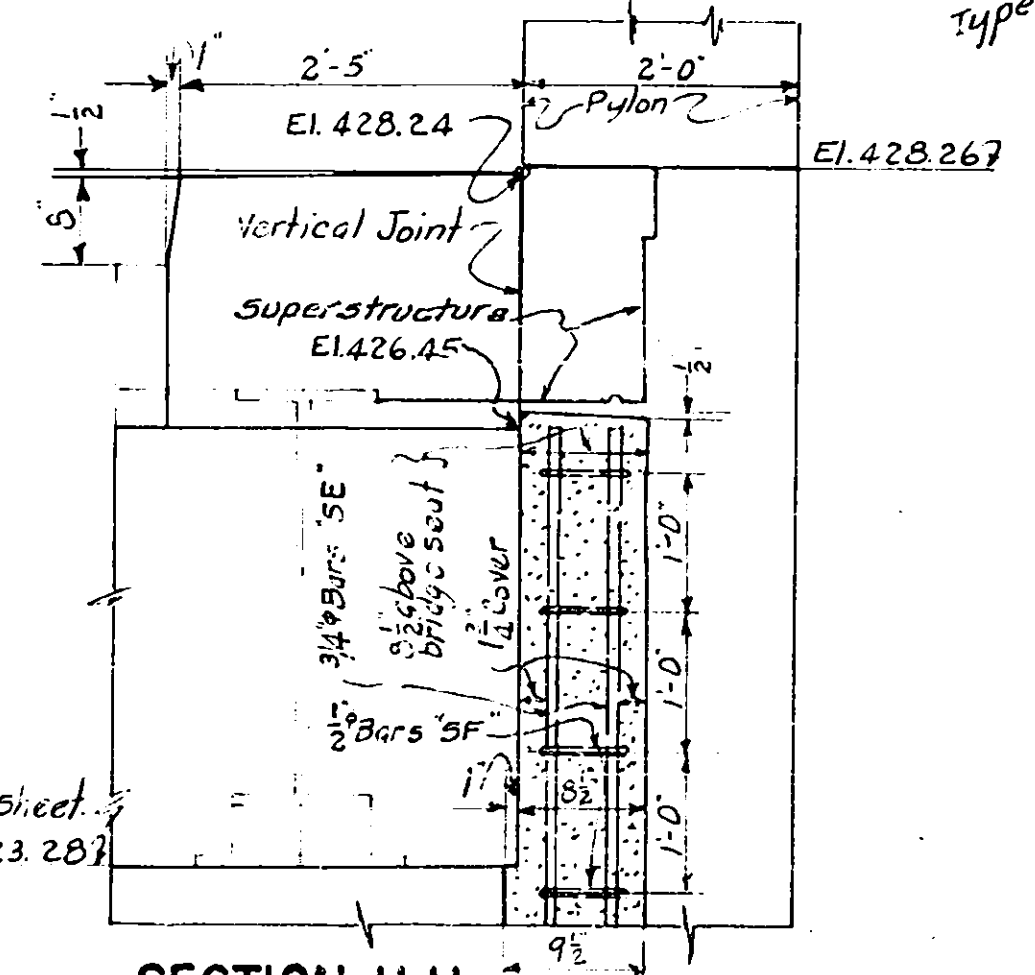


SECTION H-H
SCALE 3/4" = 1'-0"

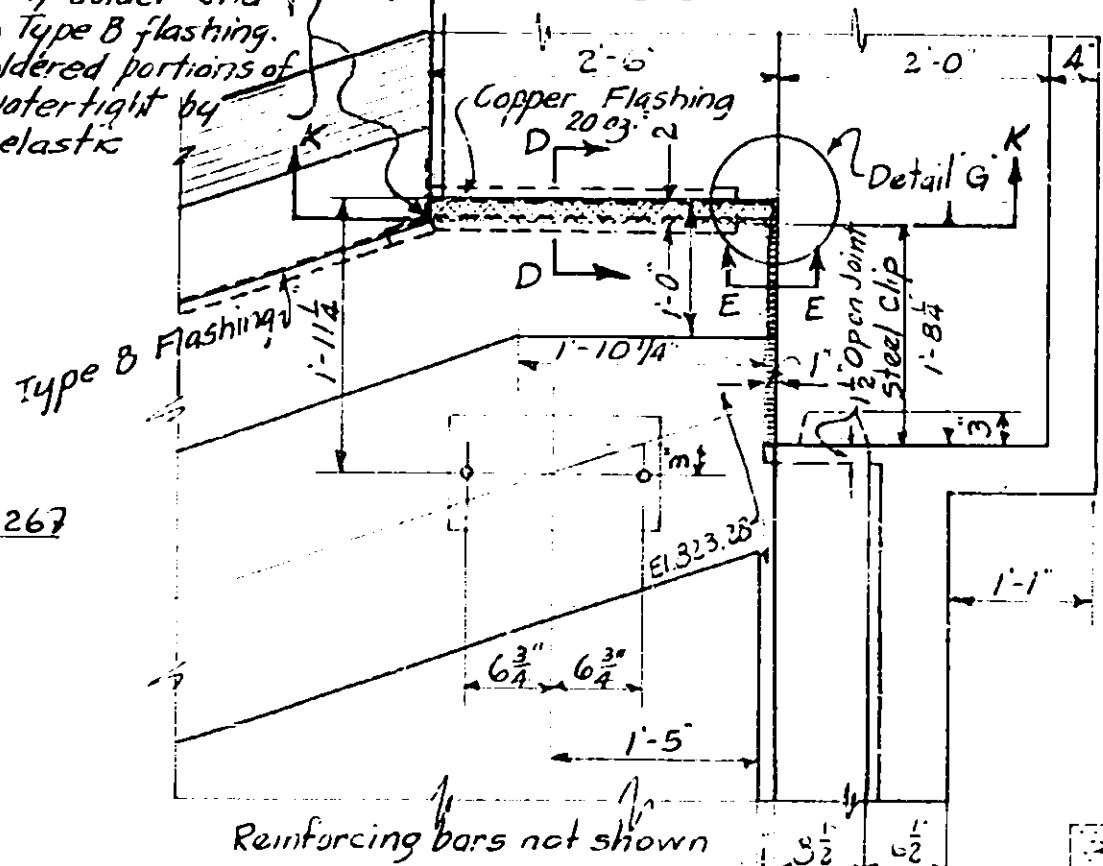


DETAIL "F"
SCALE 3/4" = 1'-0"

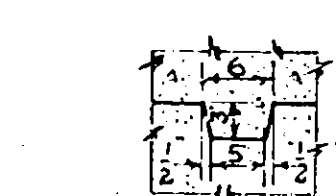


WINGWALL KEYWAY

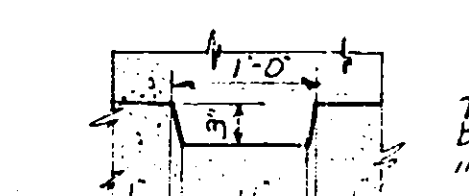


WINGWALL KEYWAY

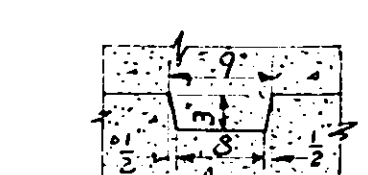

PYLON KEYWAY
SCALE 3/4" = 1' - 0"

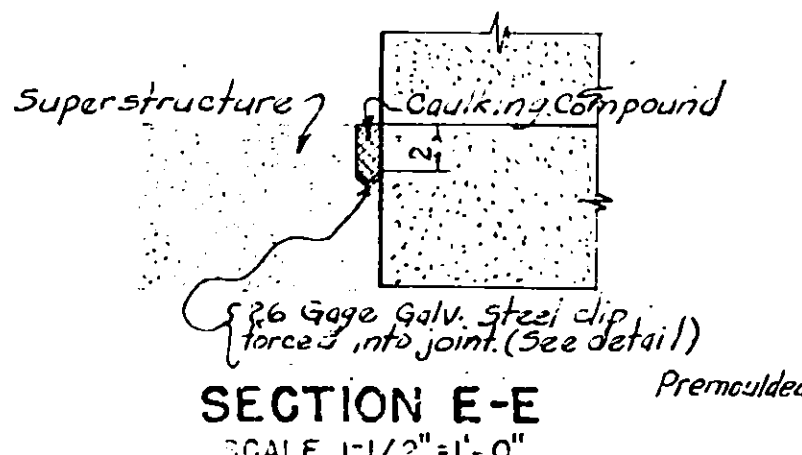


SECTION E-E
SCALE 1 1/2" = 1'-0"

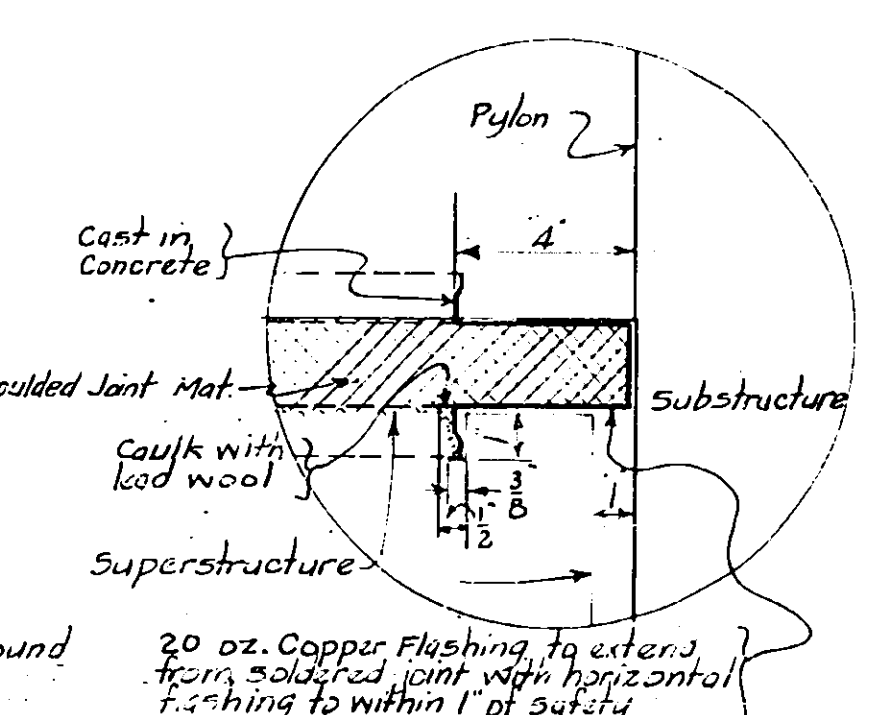


face. see Section
DETAIL "G"

SCALE 3" = 1' - 0"

Solder near side of flashing to Type B flashing. Bend bottom of flashing down and solder to Type B flashing by means of extra strip of copper. Bend far side of flashing against concrete and make entire joint water tight with elastic cement

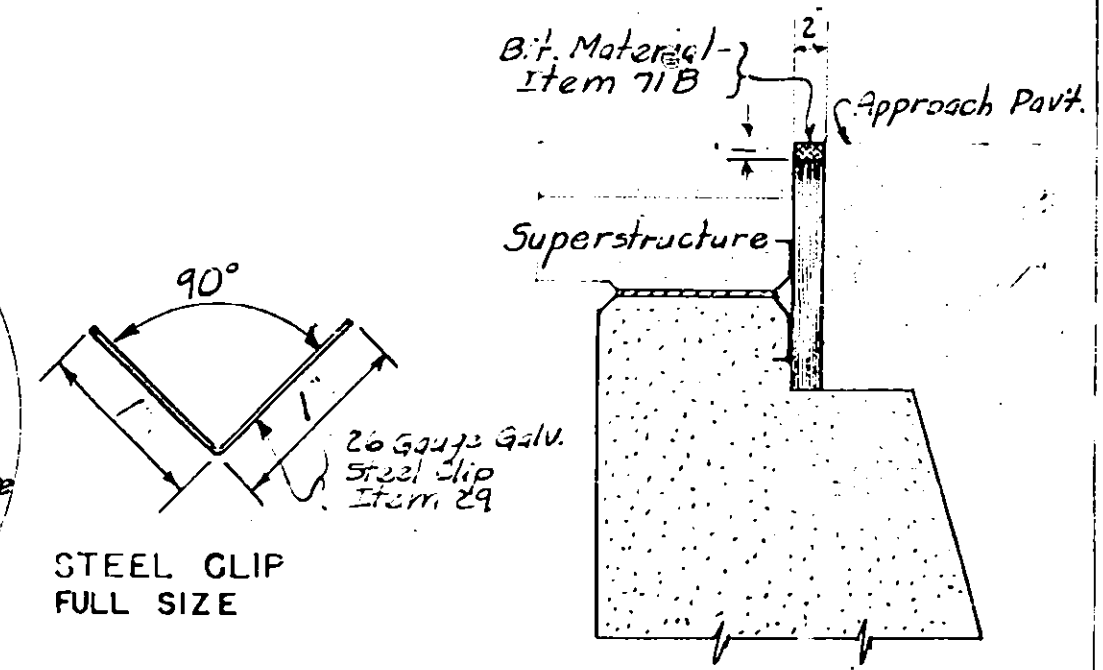

STEEL CLIP
FULL SIZE


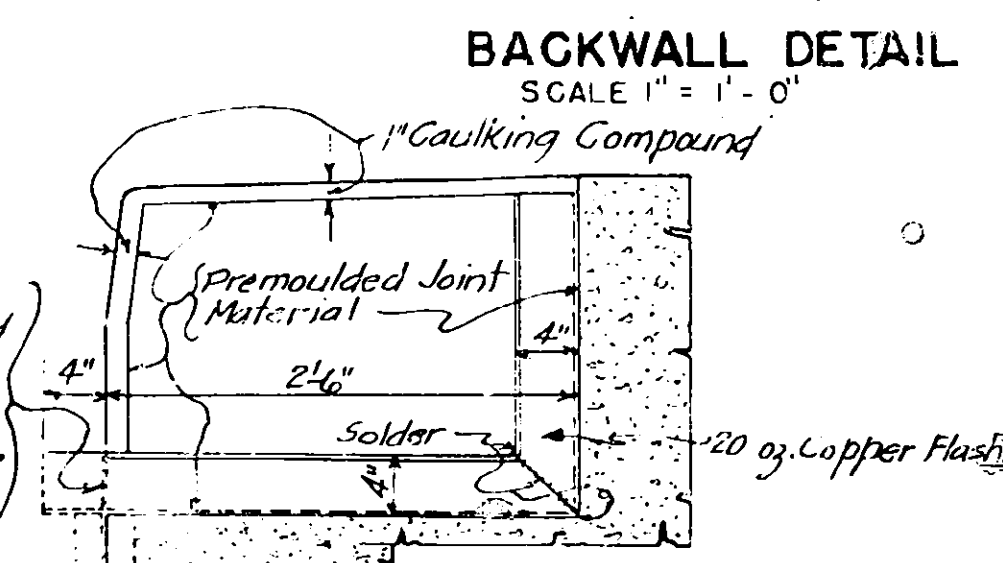


BACKWALL DETAIL

SECTION K-K
SCALE: 1" = 1'-0"


PINE PLAIN - KIRKVILLE ROAD
STA. 64+36
NORTH & SOUTH ABUTS:

FED. AID DIST. NO.	STATE	FED. AID PROJ. NO.	FISCAL YEAR	SHEET NO.	TOTAL SHEETS
	N.Y.			5	67
FROM MOHAWK THRUWAY TO MADISON COUNTY					

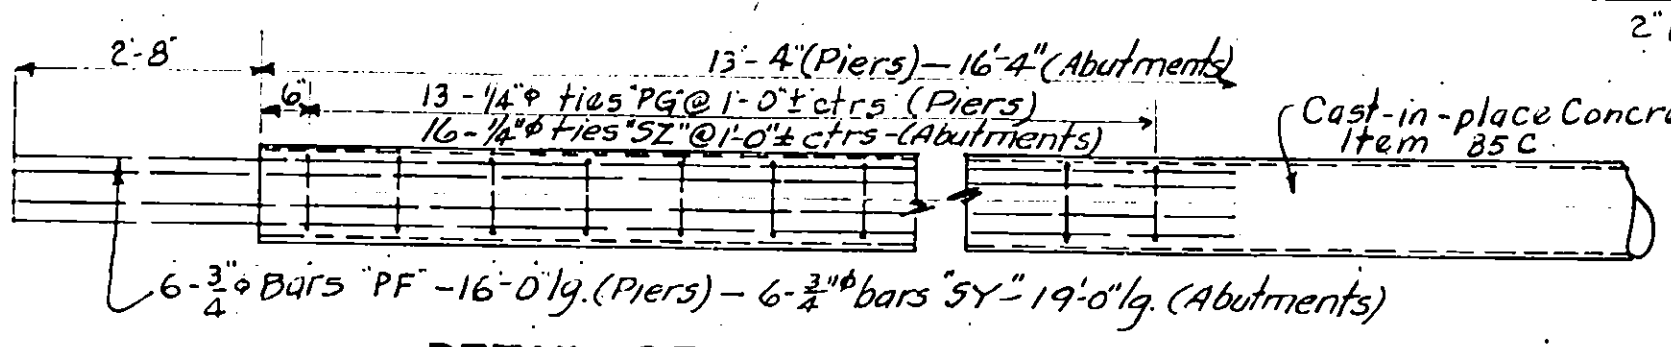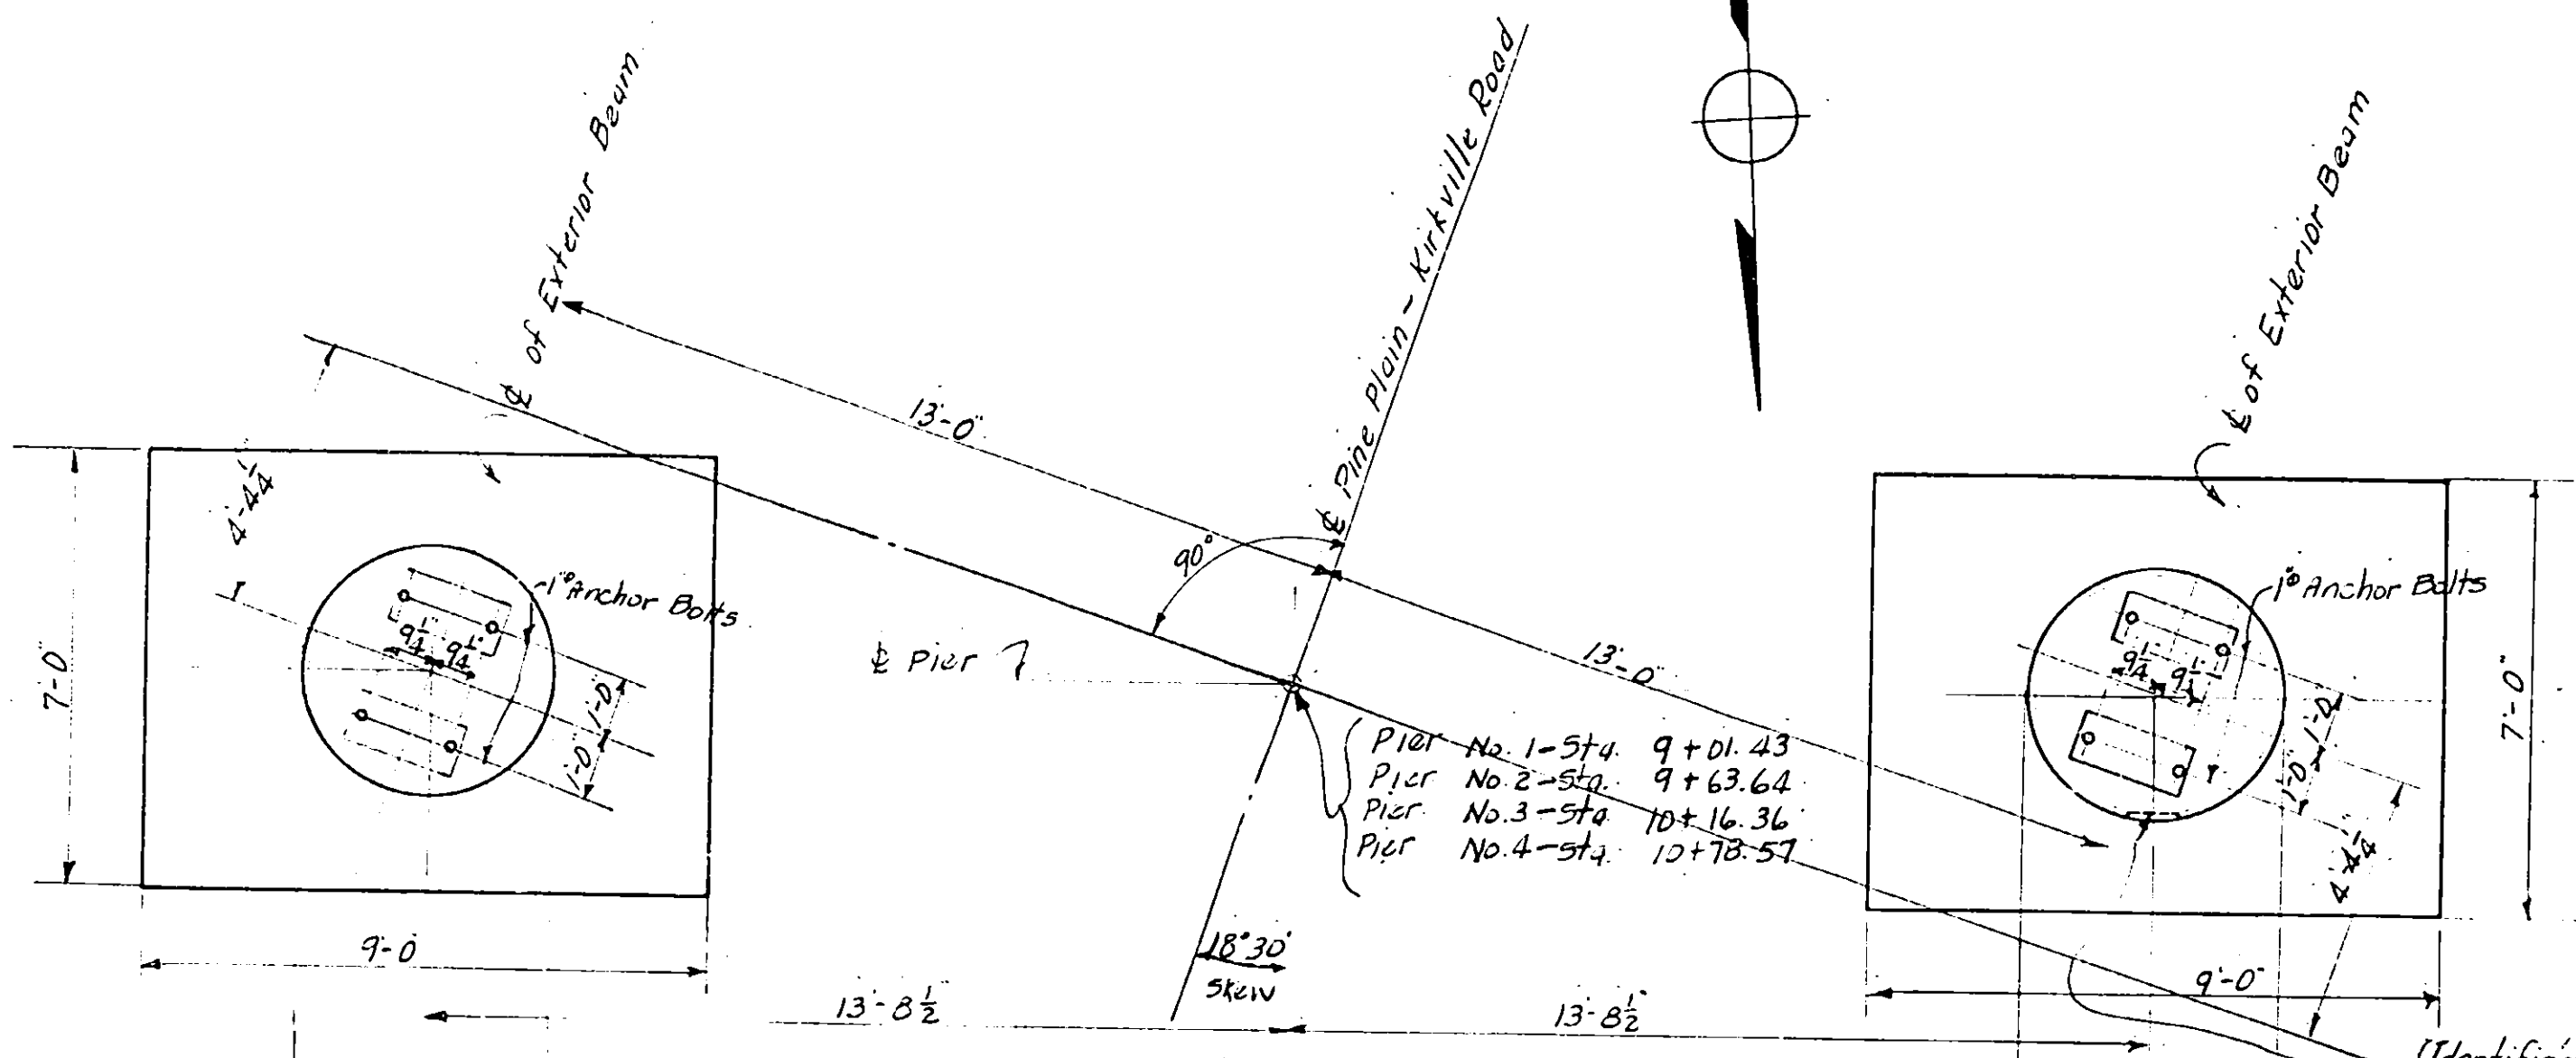


DETAIL OF PILE REINFORCING
SCALE 1/2" = 1'-0"


NOTE: Reinforcing cages shall be fabricated before being placed and shall be held in position while concrete is being cast. Reinforcing has been shown for a parallel sided pile. If a tapered pile is provided, the main reinforcement shall remain as shown but adjustment shall be made in the length of the ties. The cost required to furnish and place concrete (1:2:3 1/2 Mix.) in piles shall be included in the price per lin. ft. bid for Item 85C. The estimated lengths of piles to be driven is as follows: - Piers - 40 ft. - Abutments 50 ft. For design purposes the assumed load does not exceed 30 Tons per pile (Live Load and Dead Load only).

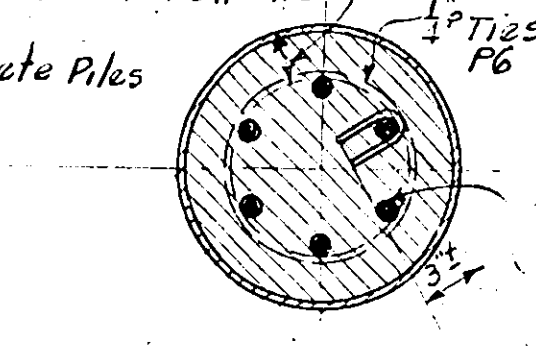

TYPICAL PILE SECTION
SCALE 1'-1/2" = 1'-0"

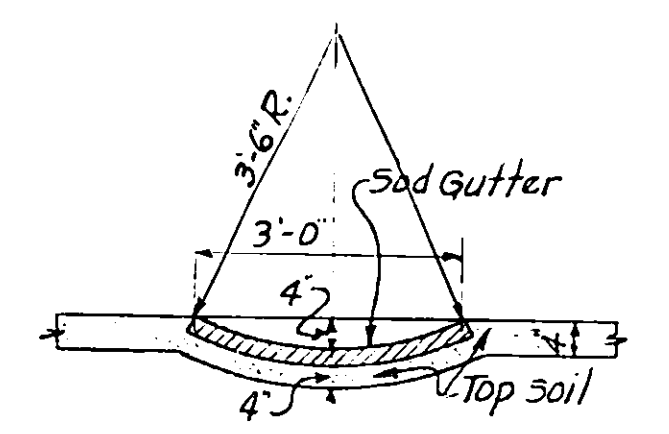


SECTION D-D
SCALE 1/2" = 1'-0"

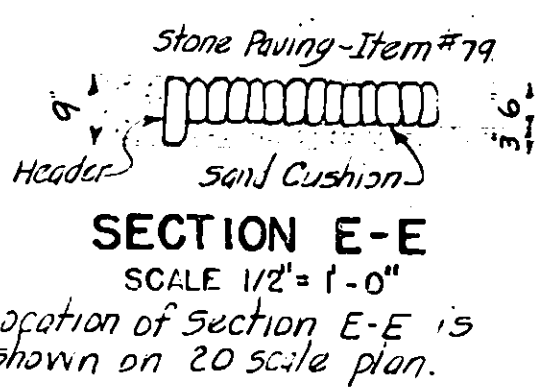


SECTION E-E
SCALE 1/2" = 1'-0"


PLAN
SCALE 3/8" = 1'-0"

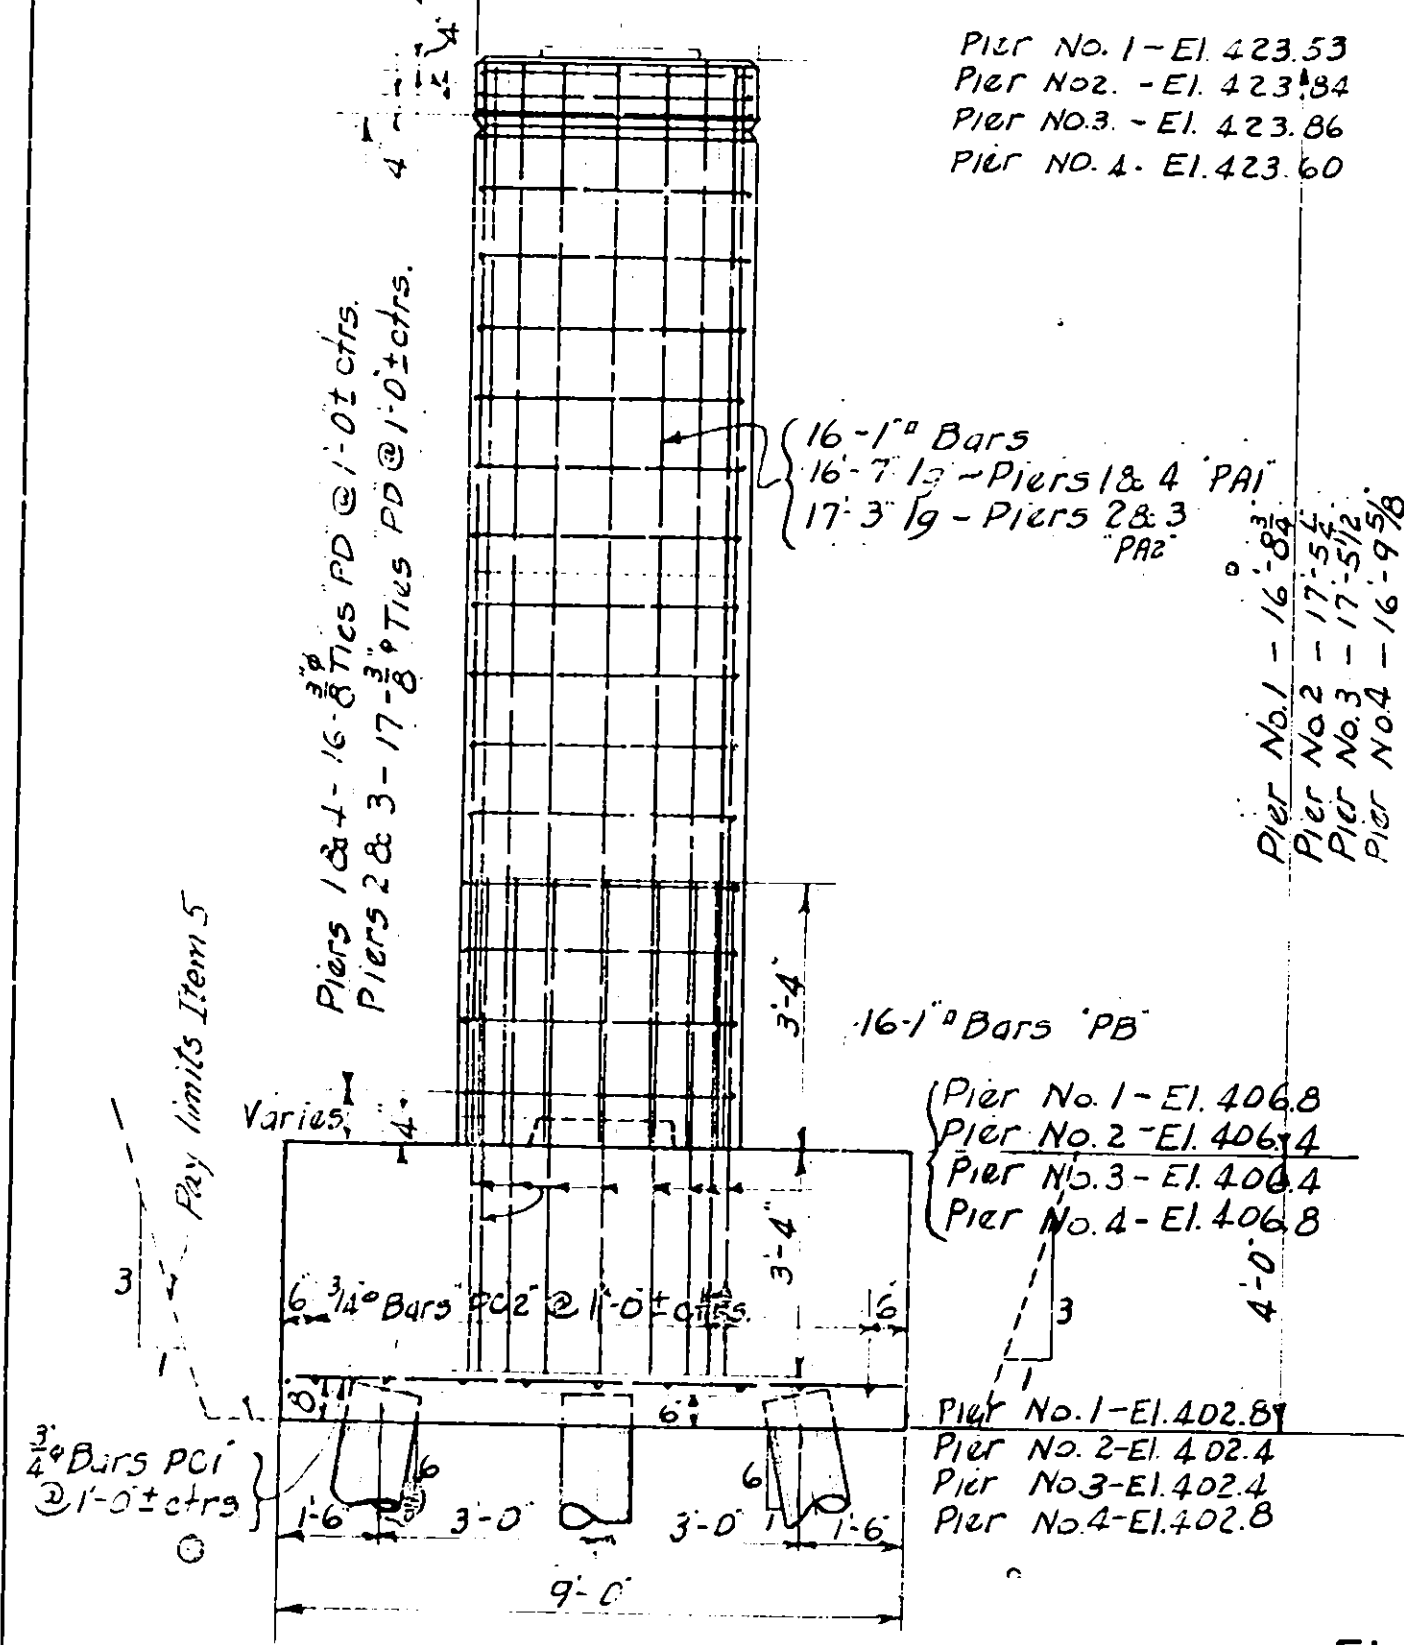


ELEVATION
PIER 1, 2, 3 & 4
SCALE 3/8" = 1'-0"

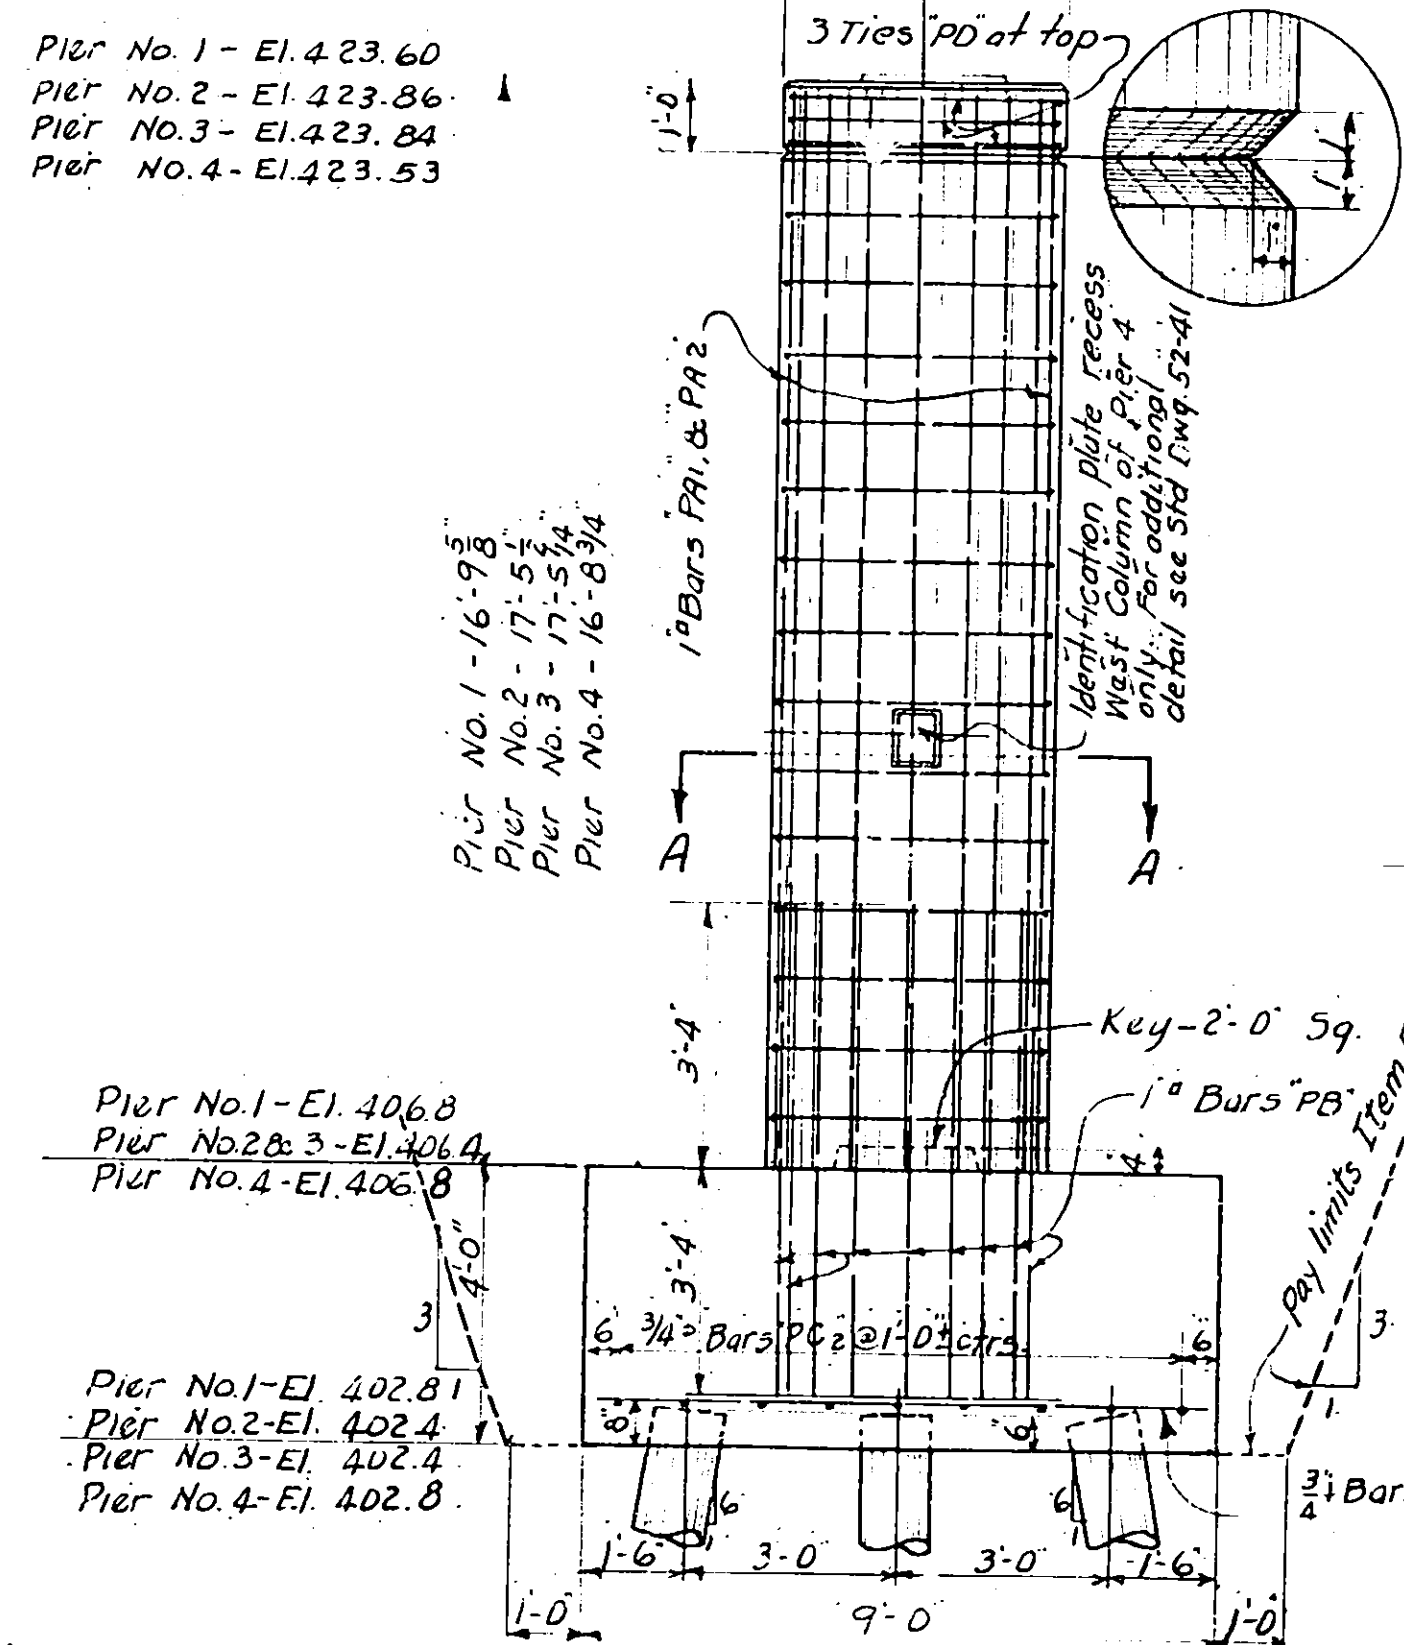


PAYMENT LIMIT LINES
ITEM 5

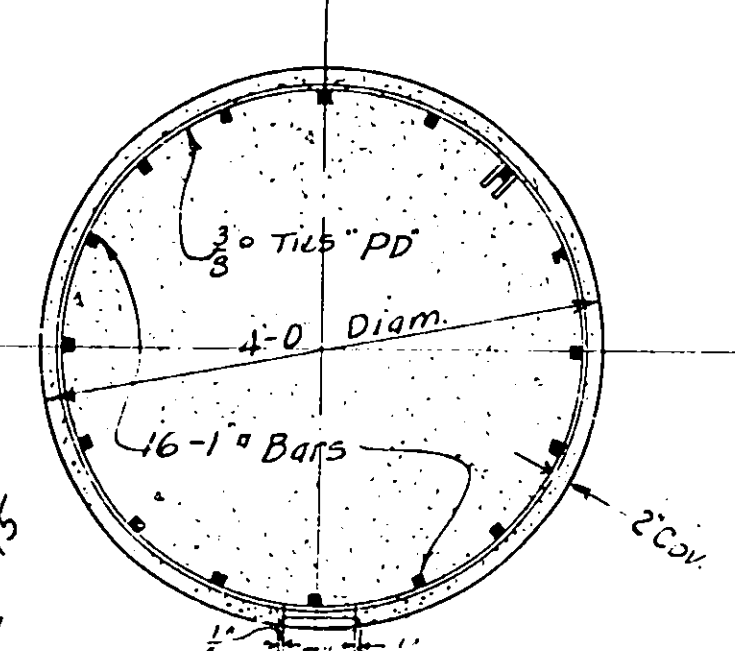


SECTION A-A
SCALE 3/4" = 1'-0"

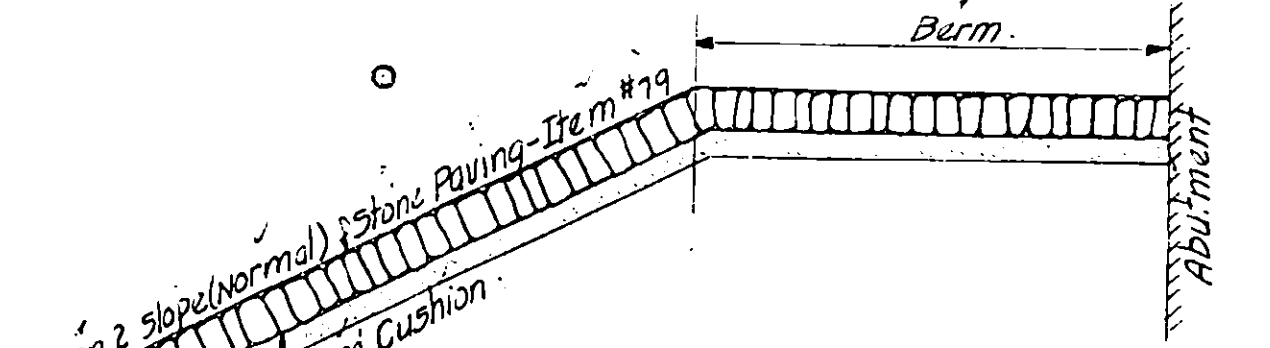

DETAIL DRY STONE PAVING
ITEM 79
SCALE 1/2" = 1'-0"

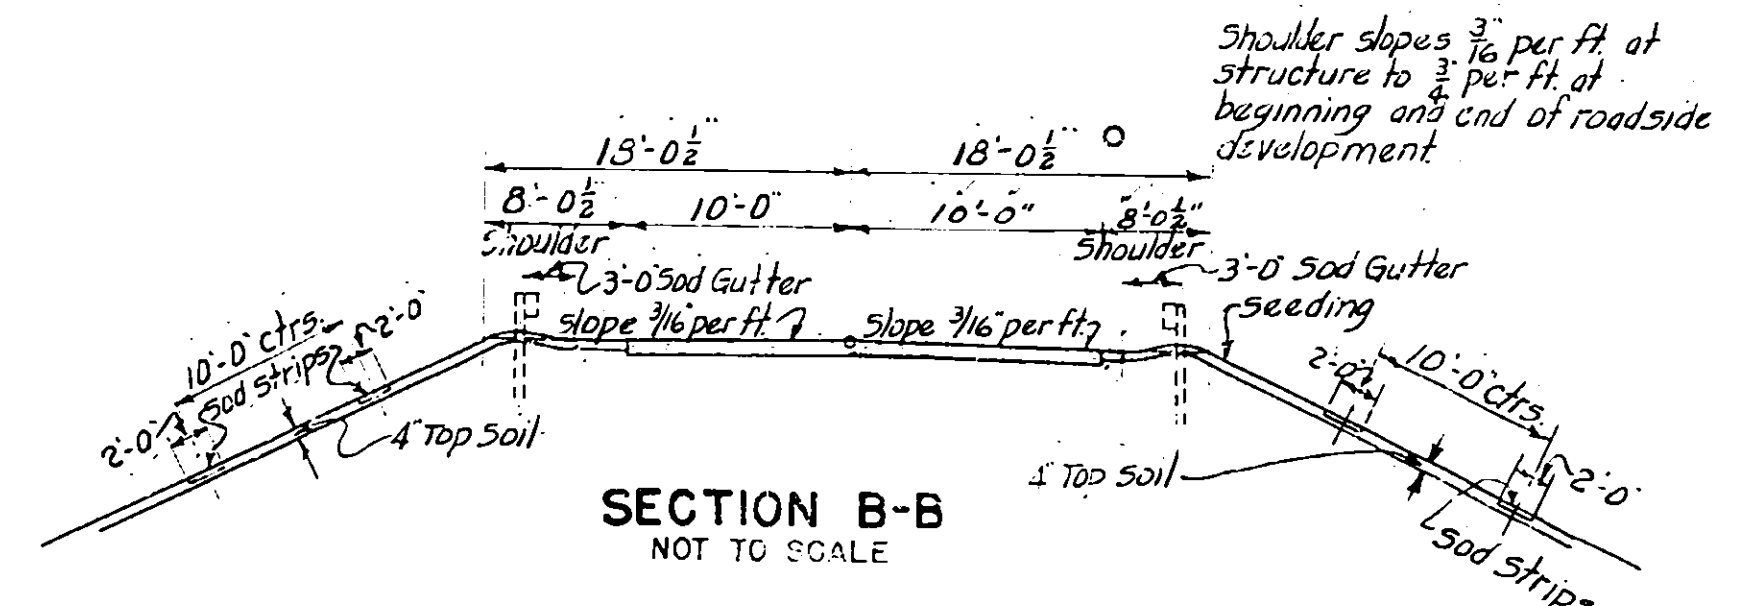

SECTION B-B
NOT TO SCALE

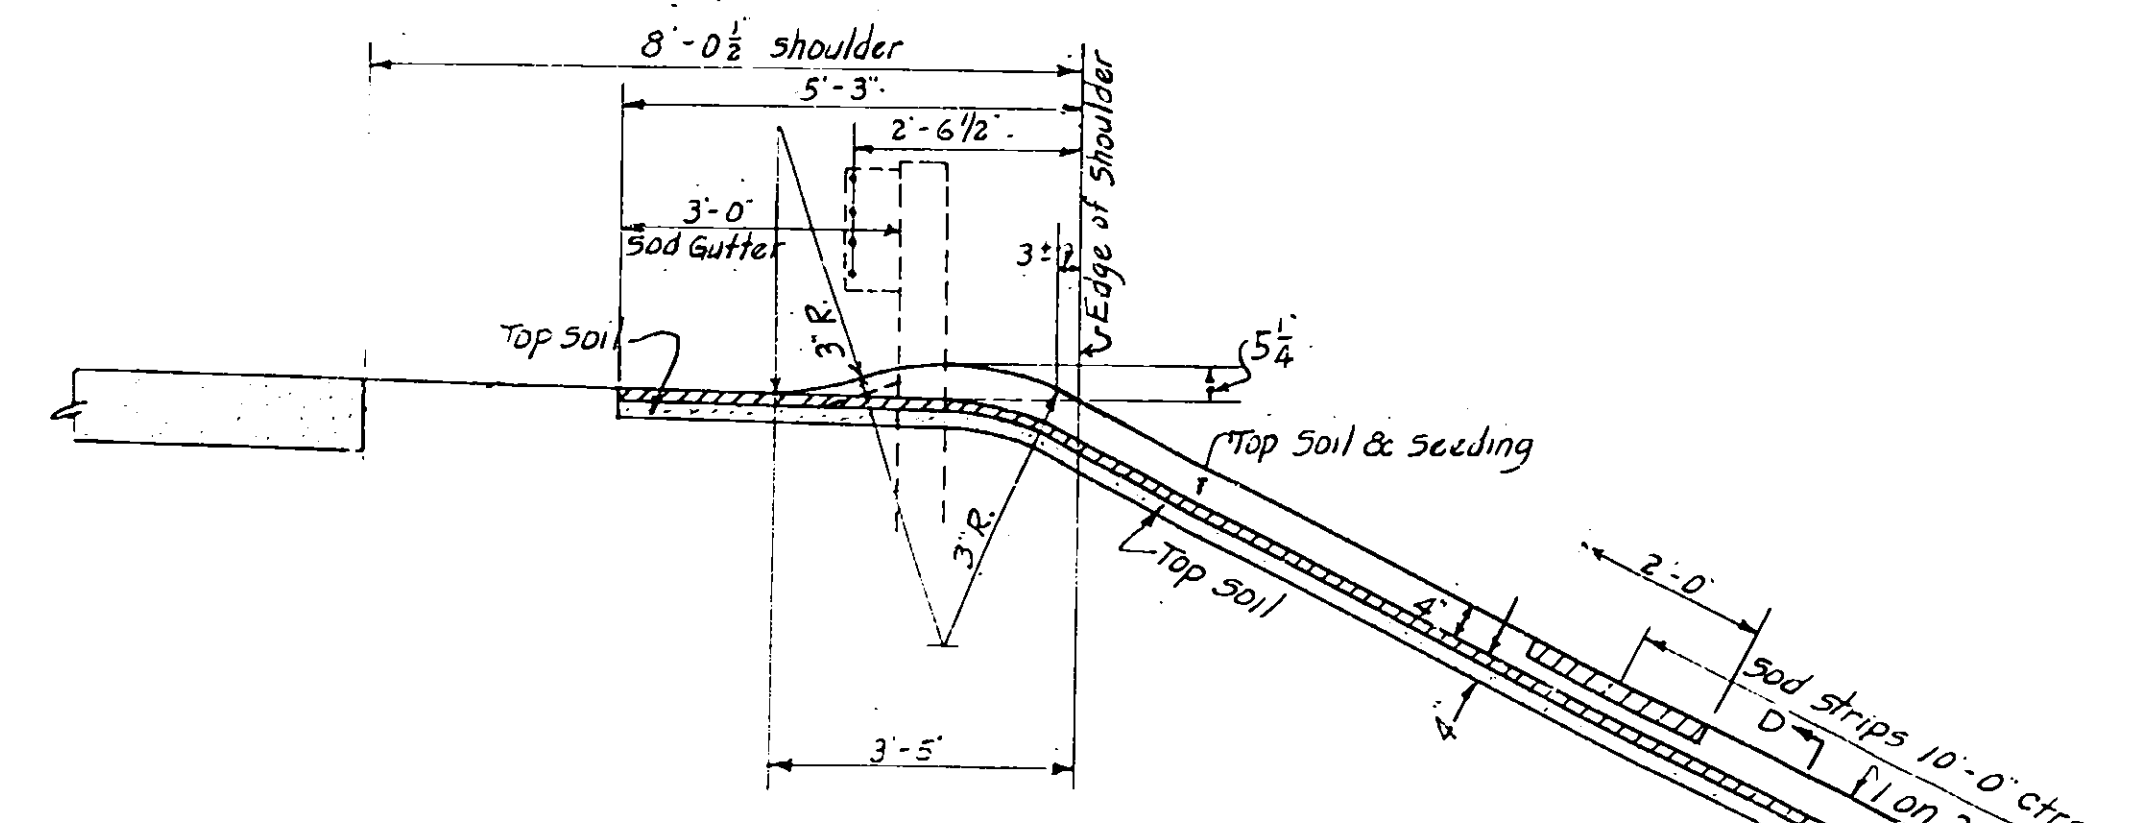

SECTION C-C
SCALE 1/2" = 1'-0"

NOTE: Location of Sections B-B and C-C are shown on 20 scale plan.


PLAN OF FOOTINGS - PIERS 1, 2, 3 & 4
SCALE 3/8" = 1'-0"

DIAGRAM
SHOWING PILE BATTERS
AND LOCATION OF PIERS
SCALE 1" = 20'

PLAN-IDENT. PL. RECES
SCALE 1" = 1'-0"

SECTION B-B
SCALE 1" = 1'-0"


PINE PLAIN - KIRKVILLE RD
STA. 64+36
PIERS 1, 2, 3 & 4

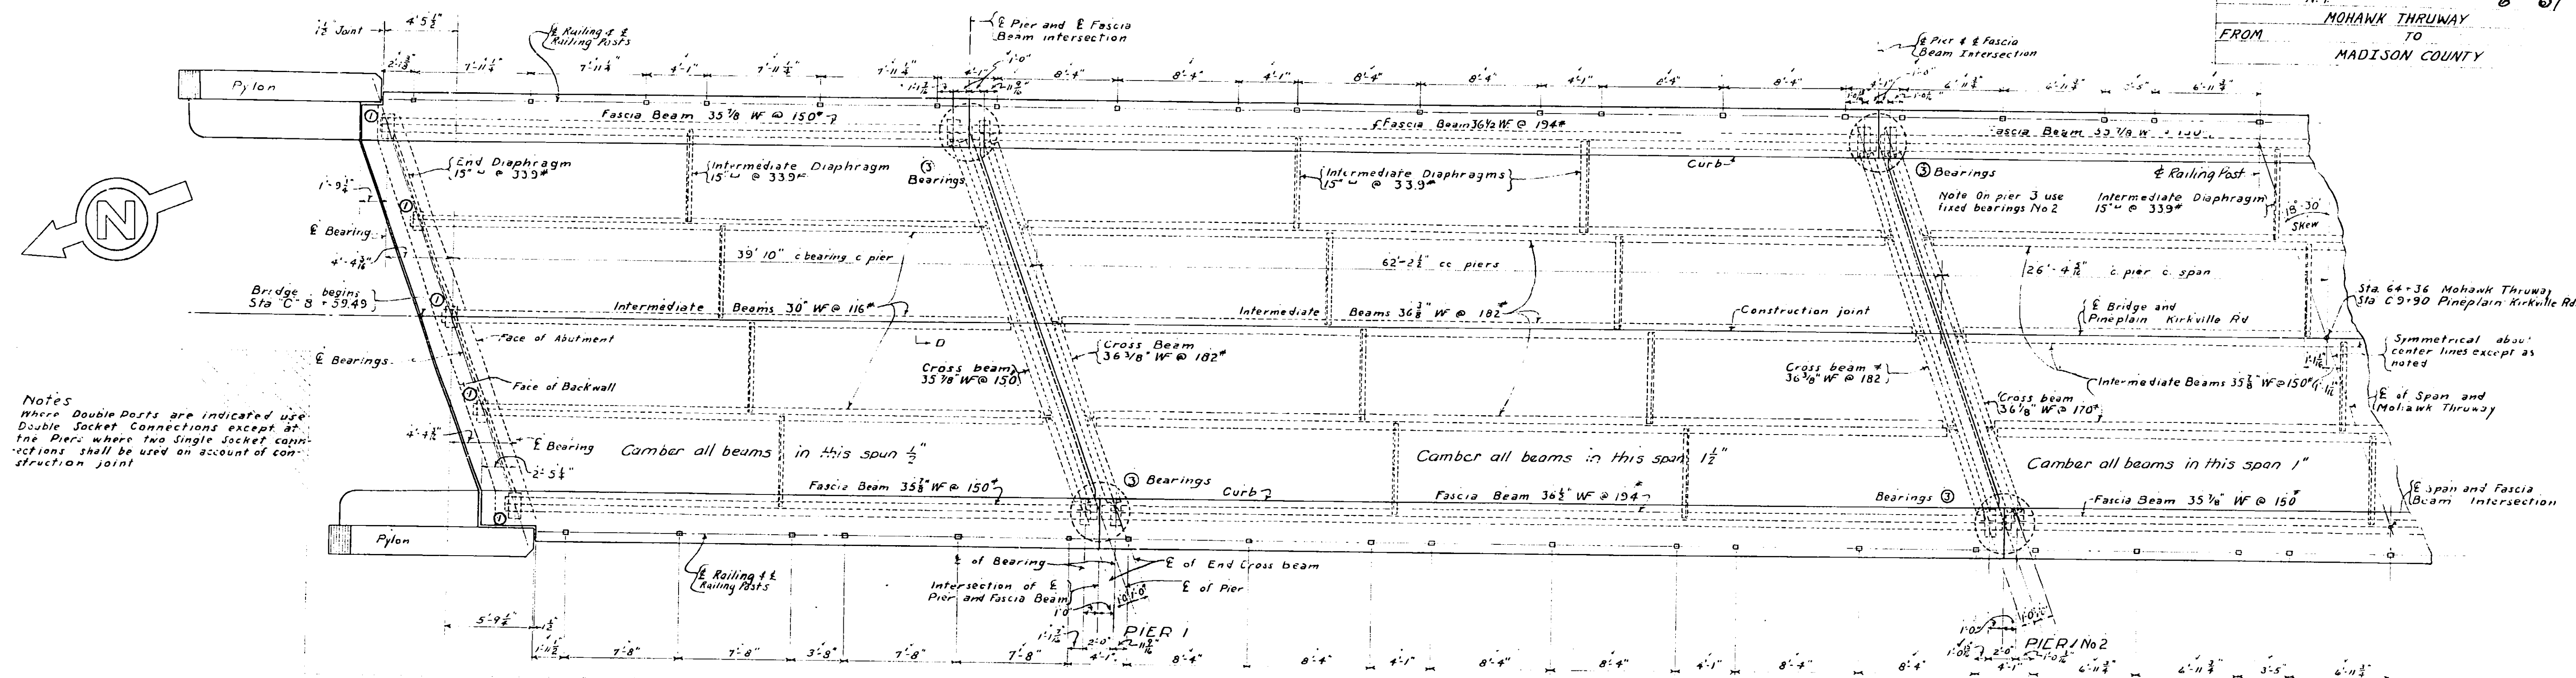

Notes
Where Double Ports are indicated use
Double Socket Connections except at
the Piers where two Single Socket con-
nections shall be used on account of con-
struction joint

NOTE: Details in Enclosed Area (Not in Contract,
For Railing Details and Railing Notes- See
North Main St Bridge Plans.
For Location of Railing Posts- See Super-
Structure Plan on this sheet.

HALF PLAN
SCALE $\frac{3}{8}'' = 1'-0''$

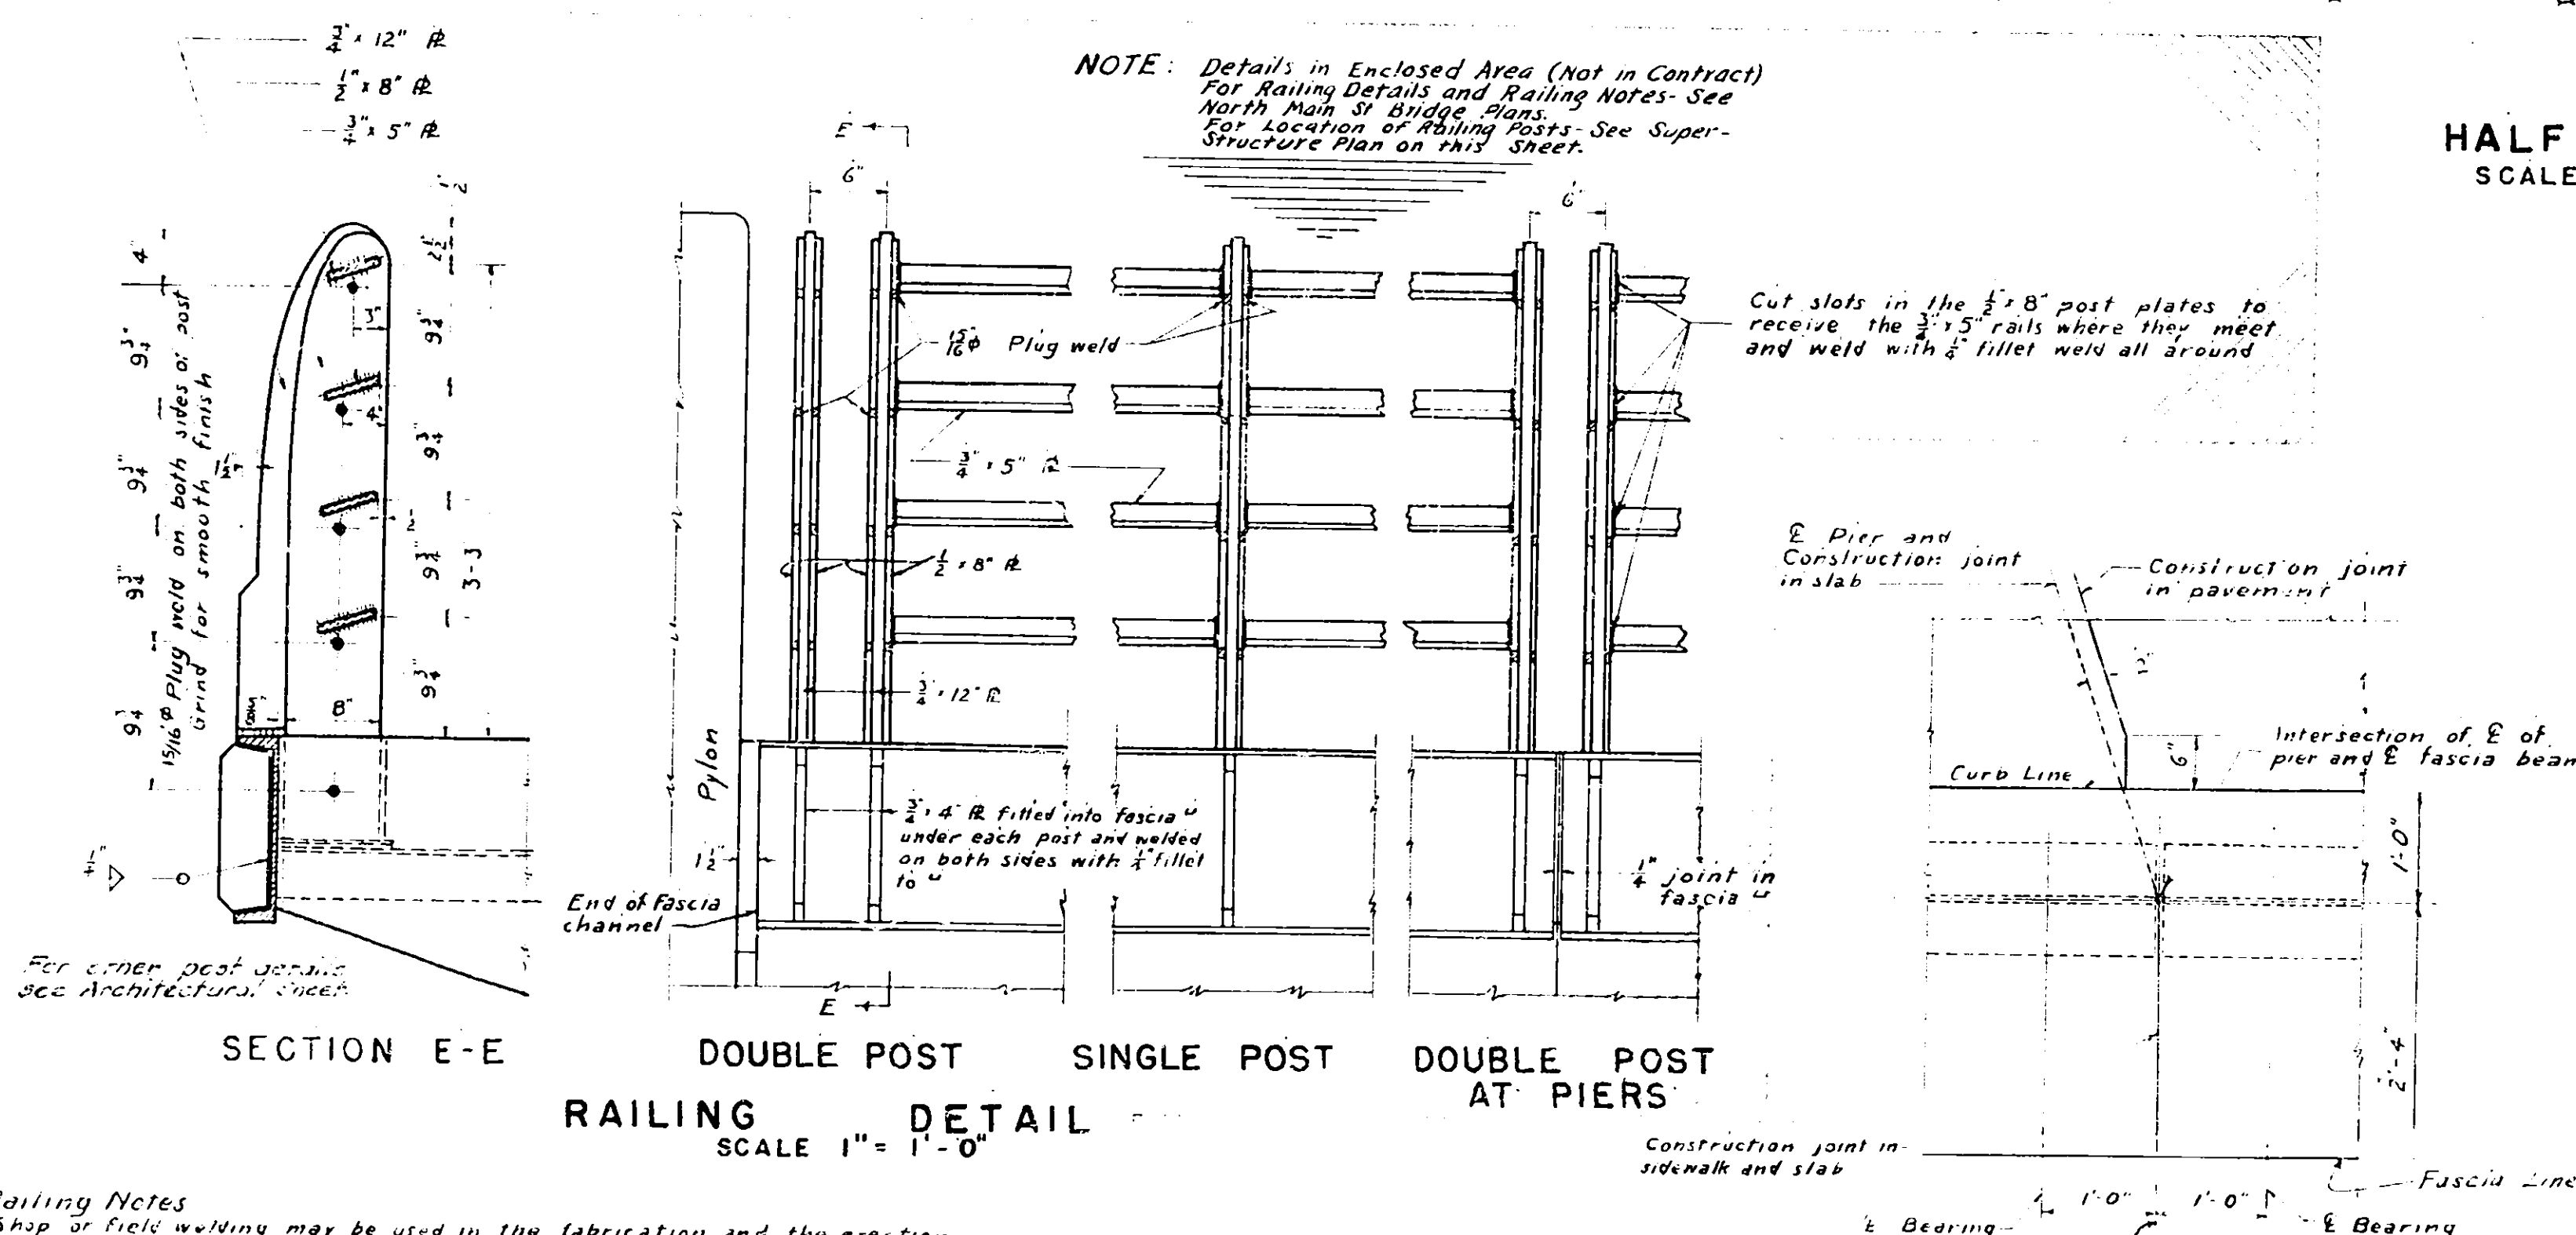


Railing Notes
Shop or field welding may be used in the fabrication and the erection of the railing. Since the posts must be truly vertical and the finished railing must meet all requirements of fit, alignment and grade to the full satisfaction of the Engineer it is suggested that measurements be made before any shop fabrication work is done.

All railings are to be fabricated and erected so that the rails are parallel to the toe of fascina.

Nets for weirs and rails shall be structural steel meeting the requirements of Public Works Specs. M-6.

T. J. R. R.
 Bossid,
 Becker, Dec. 10, 48

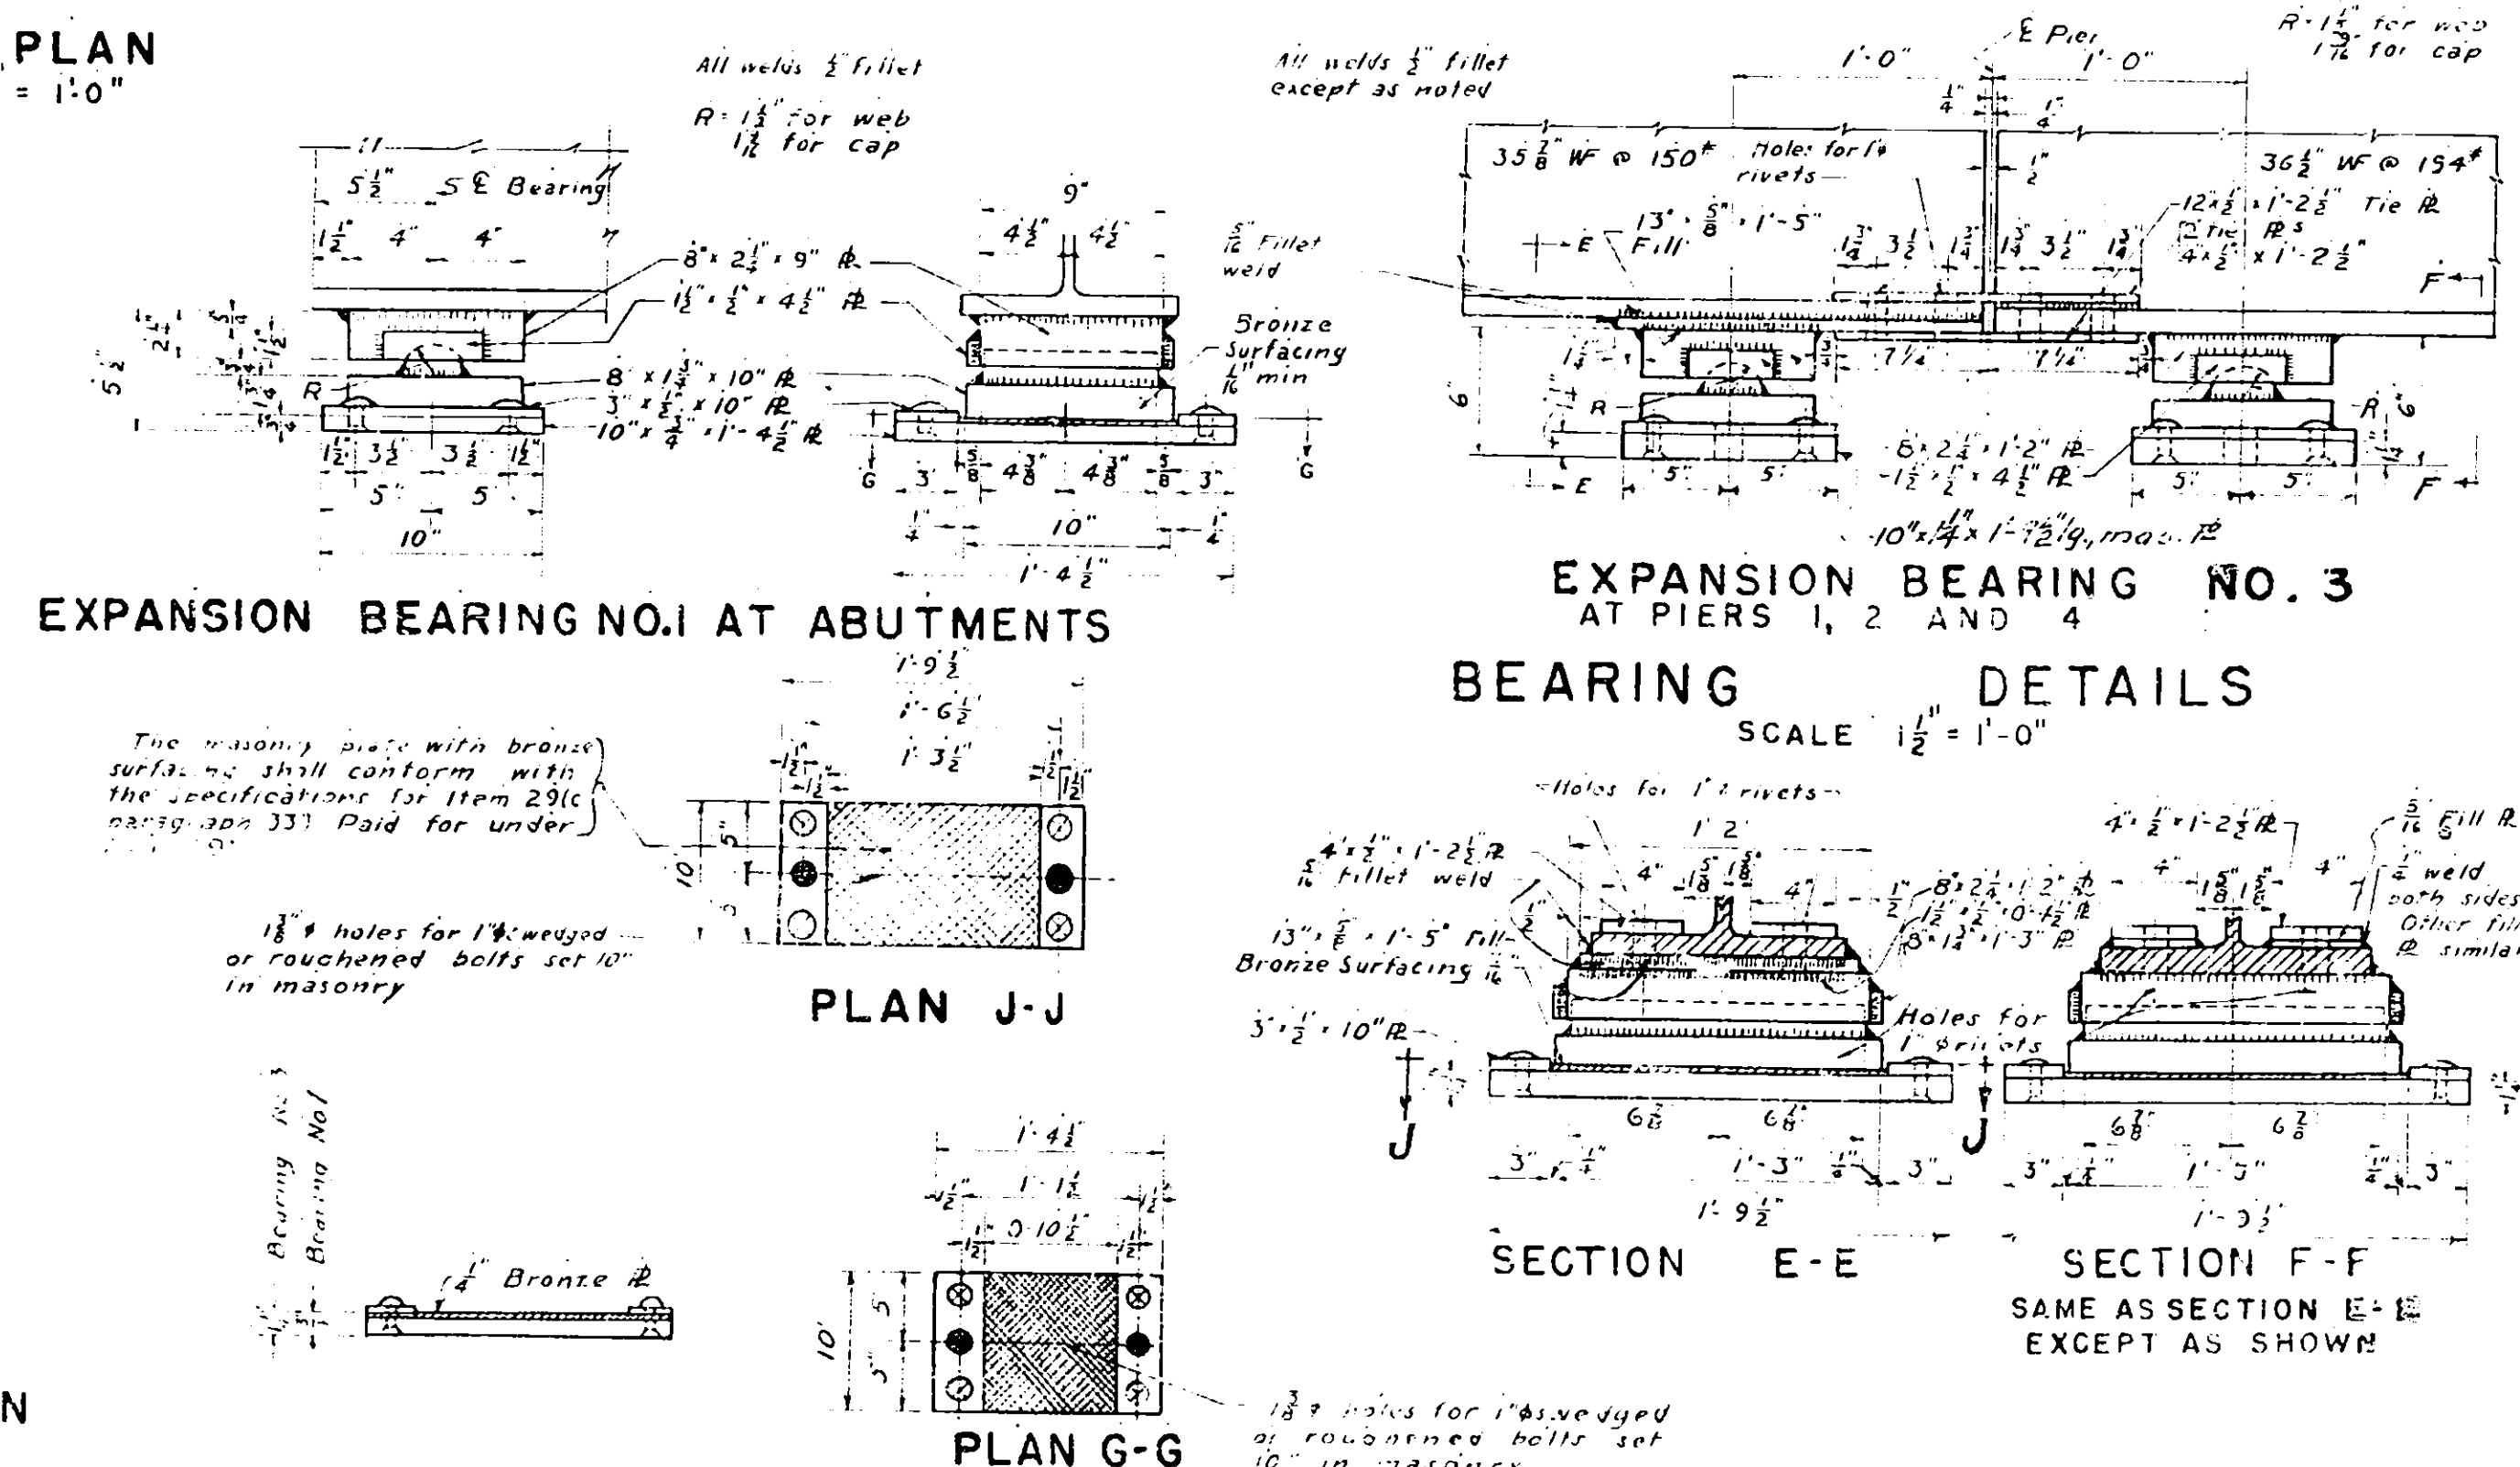

EXPANSION BEARING NO.1 AT ABUTMENTS

EXPANSION BEARING NO. 3
AT PIERS 1, 2 AND 4

BEARING DETAILS





SCALE $1\frac{1}{2}'' = 1'-0''$

PLAN OF PIERS SHOWING CONSTRUCTION
JOINT

BEAM CONNECTIONS AT SECTION D-D
SCALE $\frac{1}{2}" = 1'-0"$



PINEPLAIN-KIRKVILLE ROAD
STA. 64+36
SUPERSTRUCTURE

Note:-
Use Railing Details and Railing Notes on
North Main Street Plans:-
For location of railing posts see super-
structure plan for this bridge:-

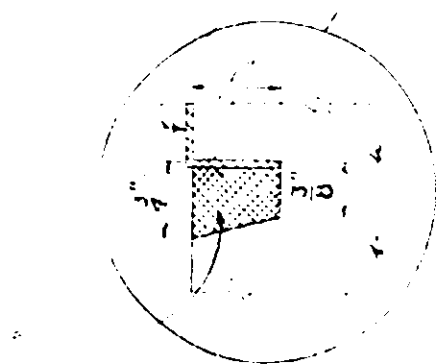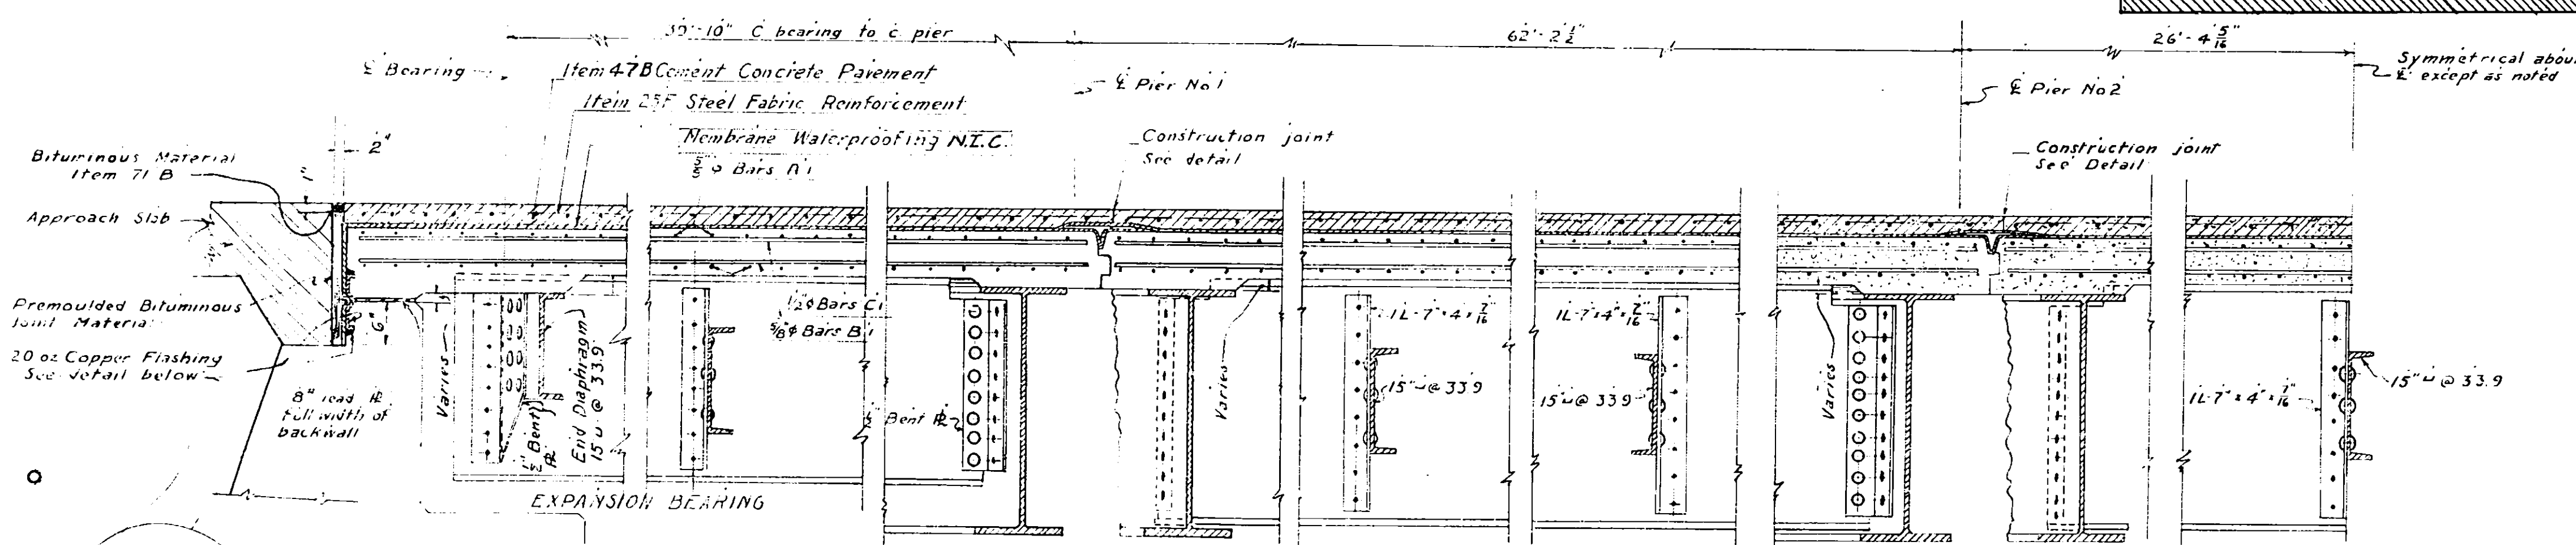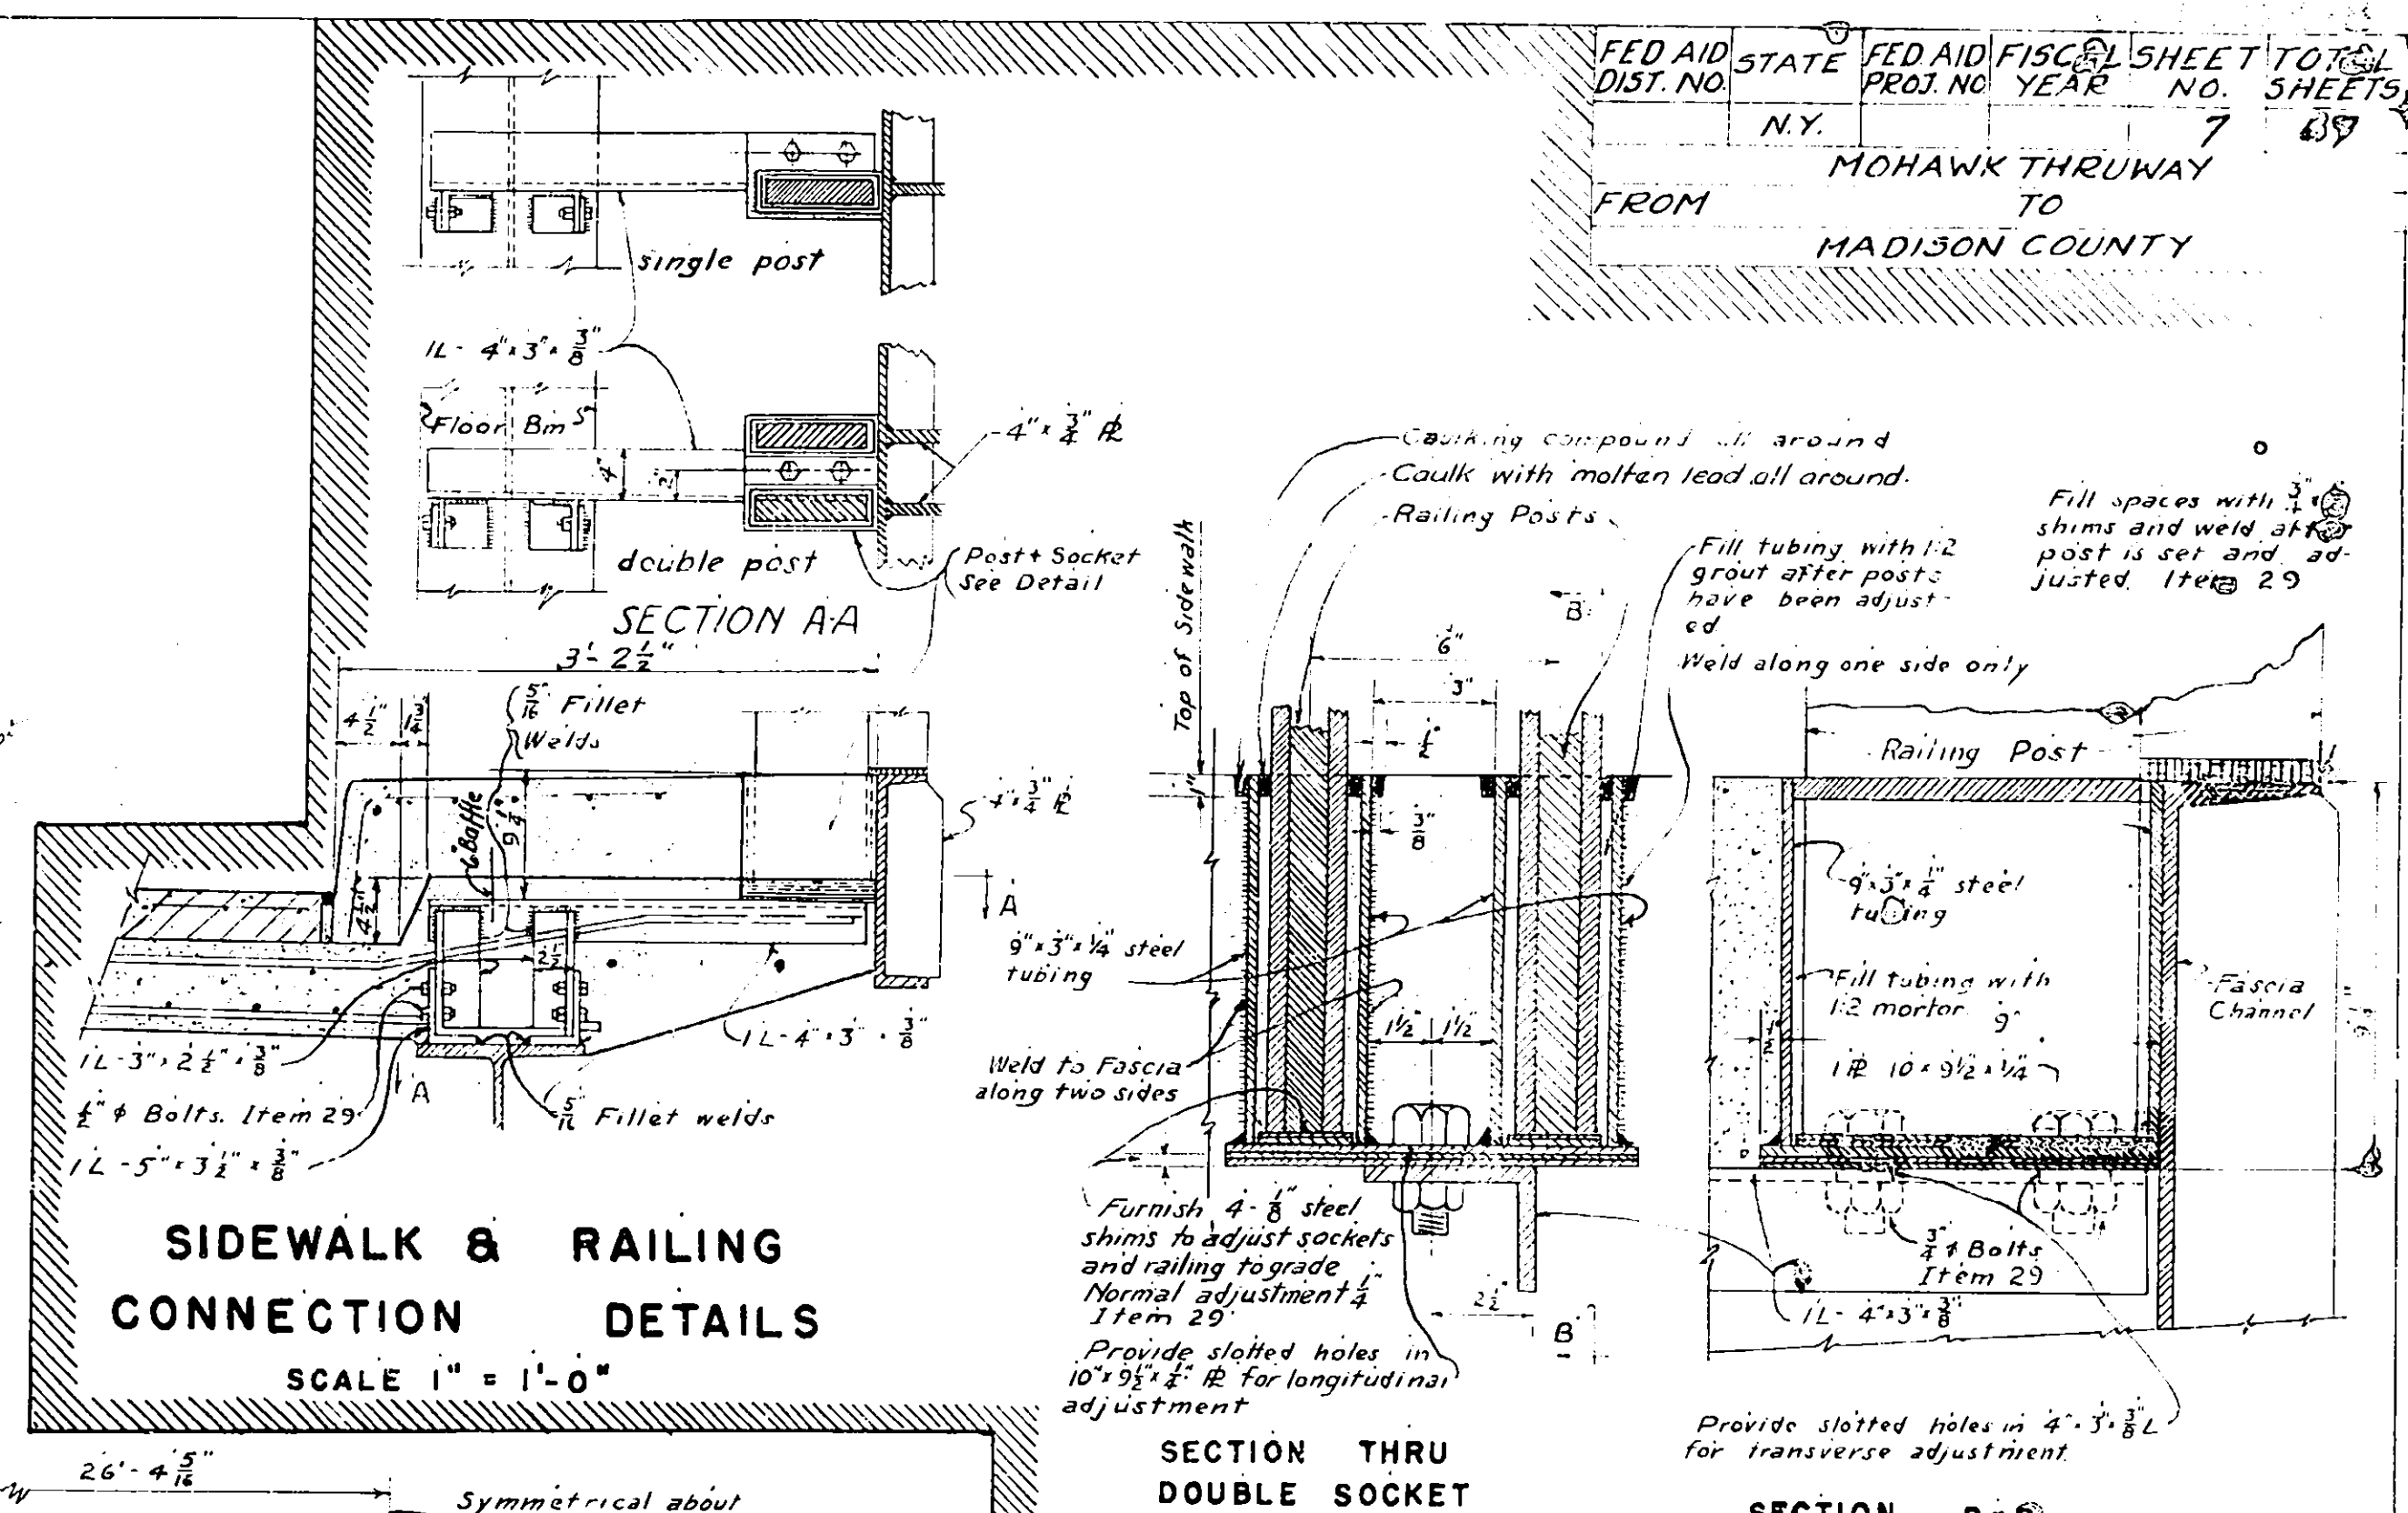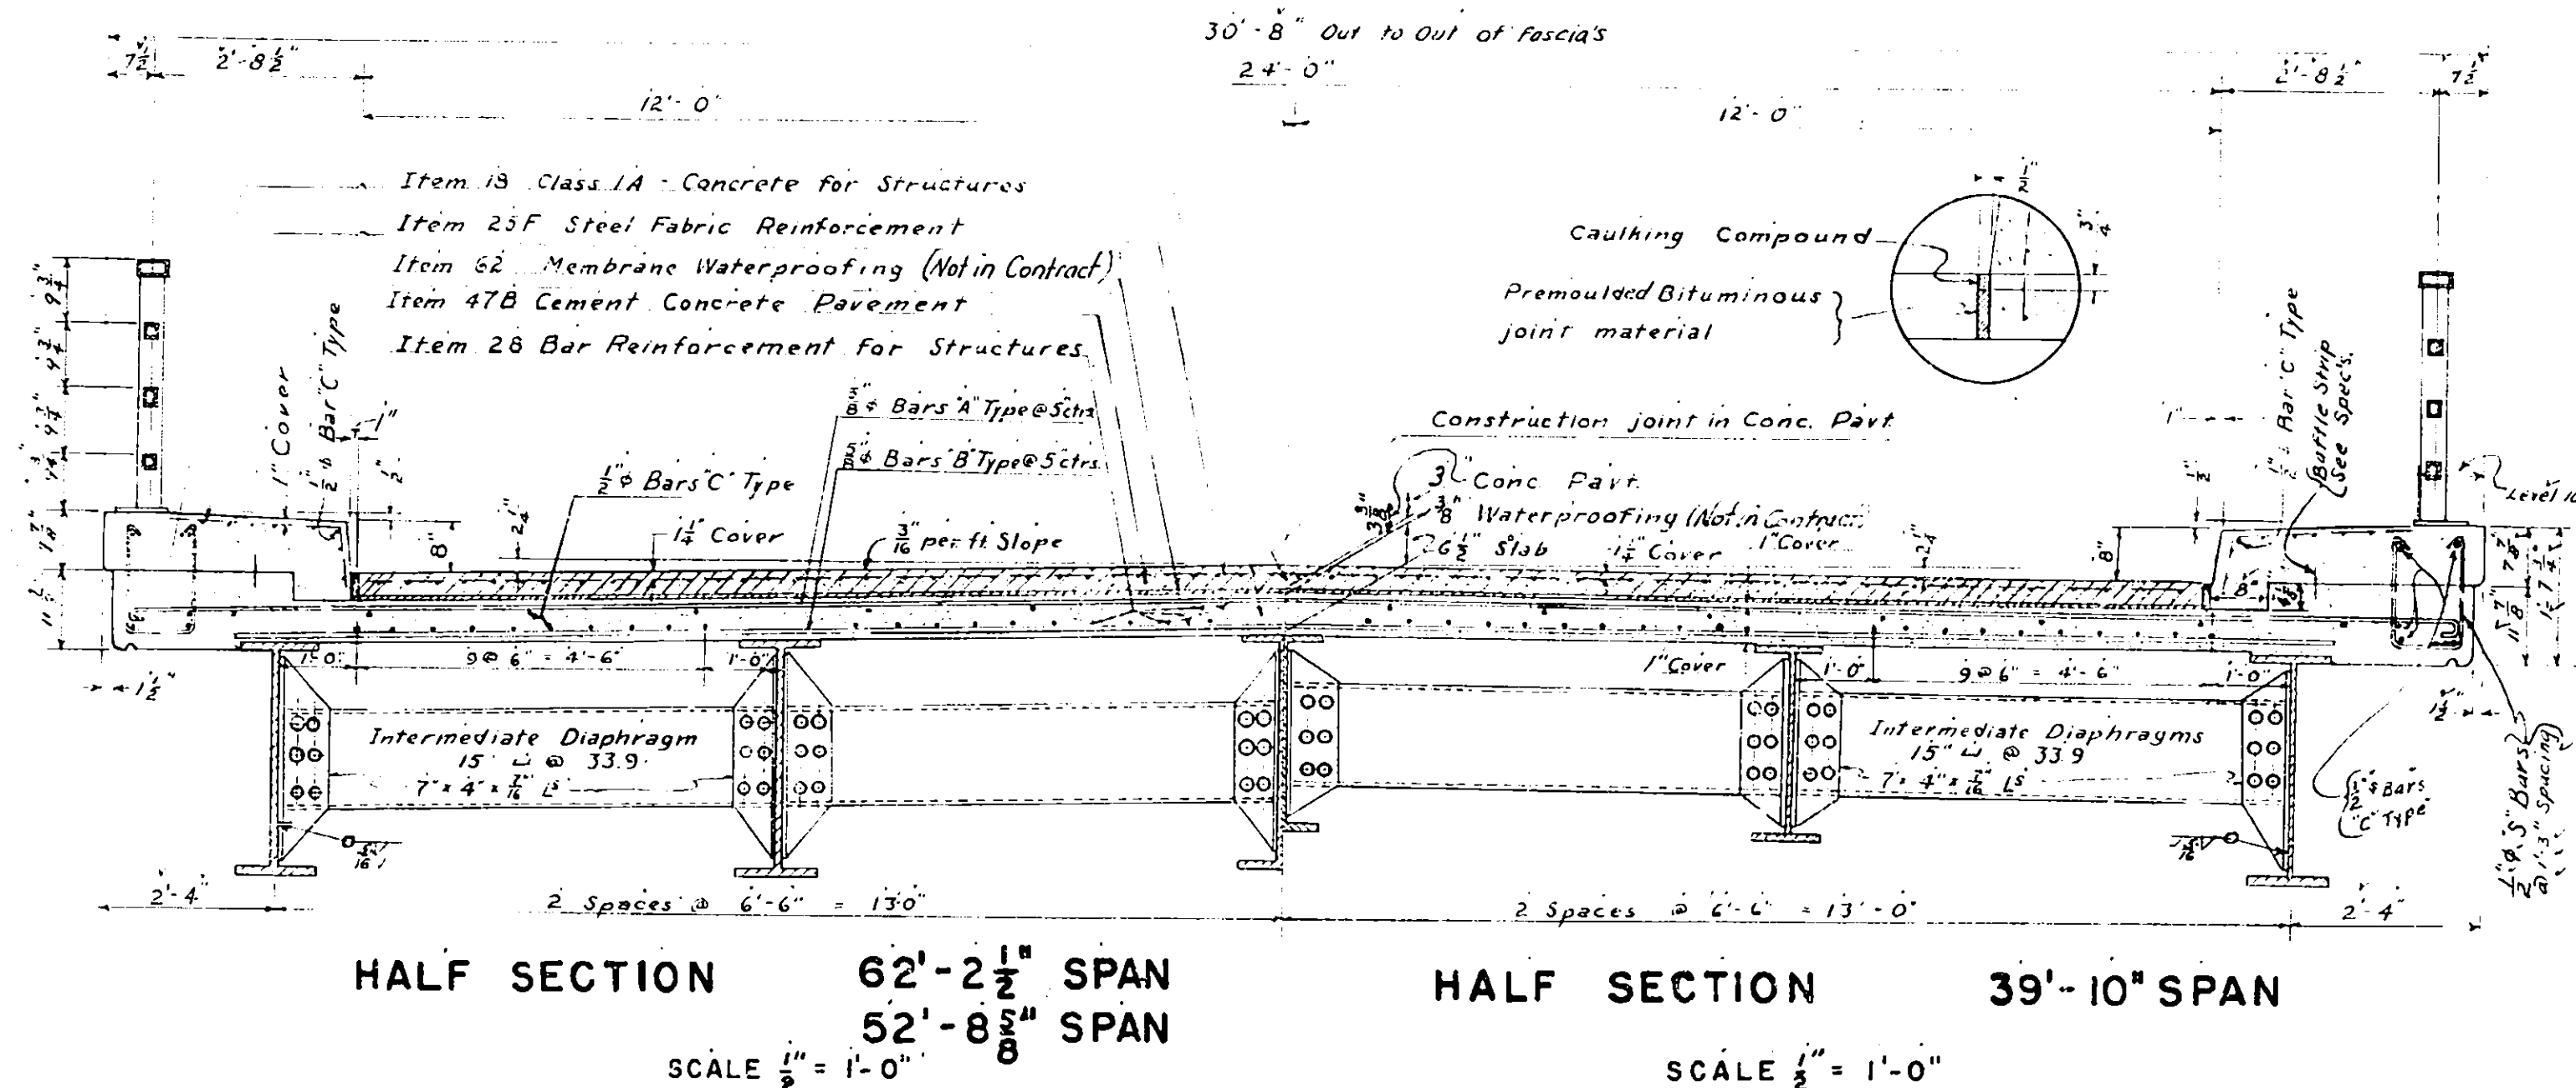


Coated with
lead wool

COPPER FLASHING
SCALE @ $1\frac{1}{2}'' = 1' - 0''$

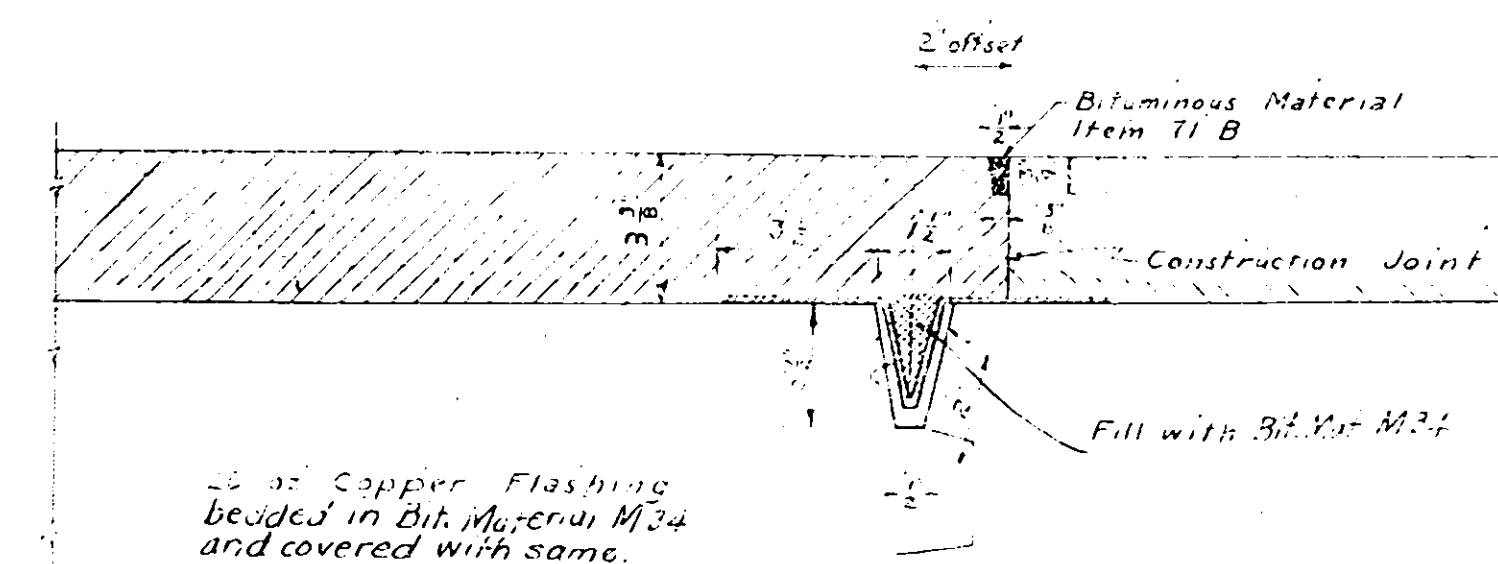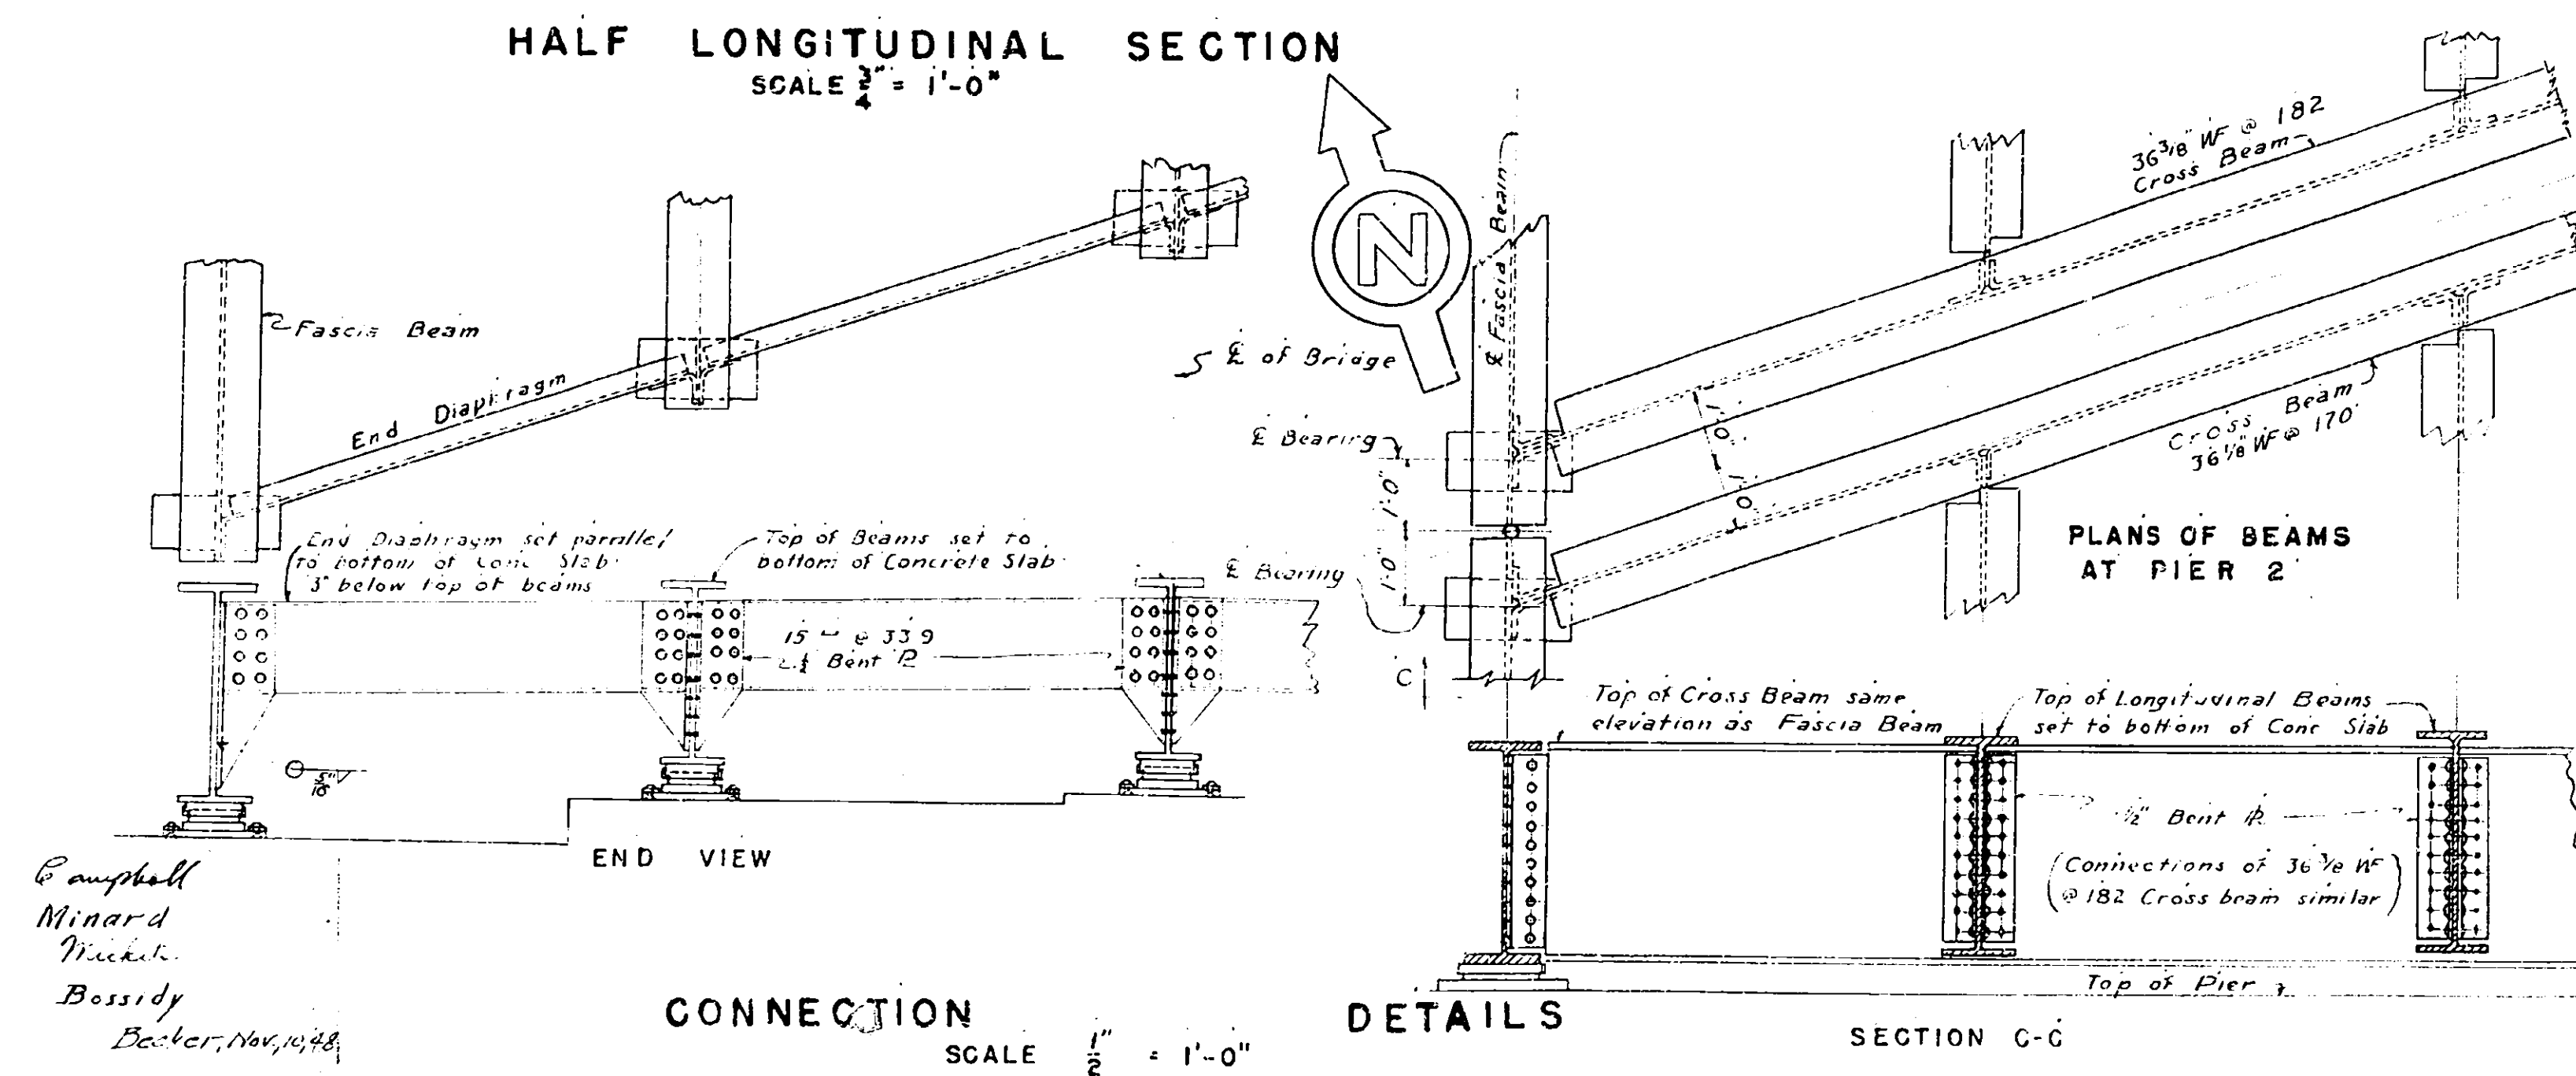


CONSTRUCTION JOINT OVER PIERS
SCALE 3" = 1'-0"
PINEPLAIN KIRKVILLE ROAD
STA. 64 + 36
SUPERSTRUCTURE

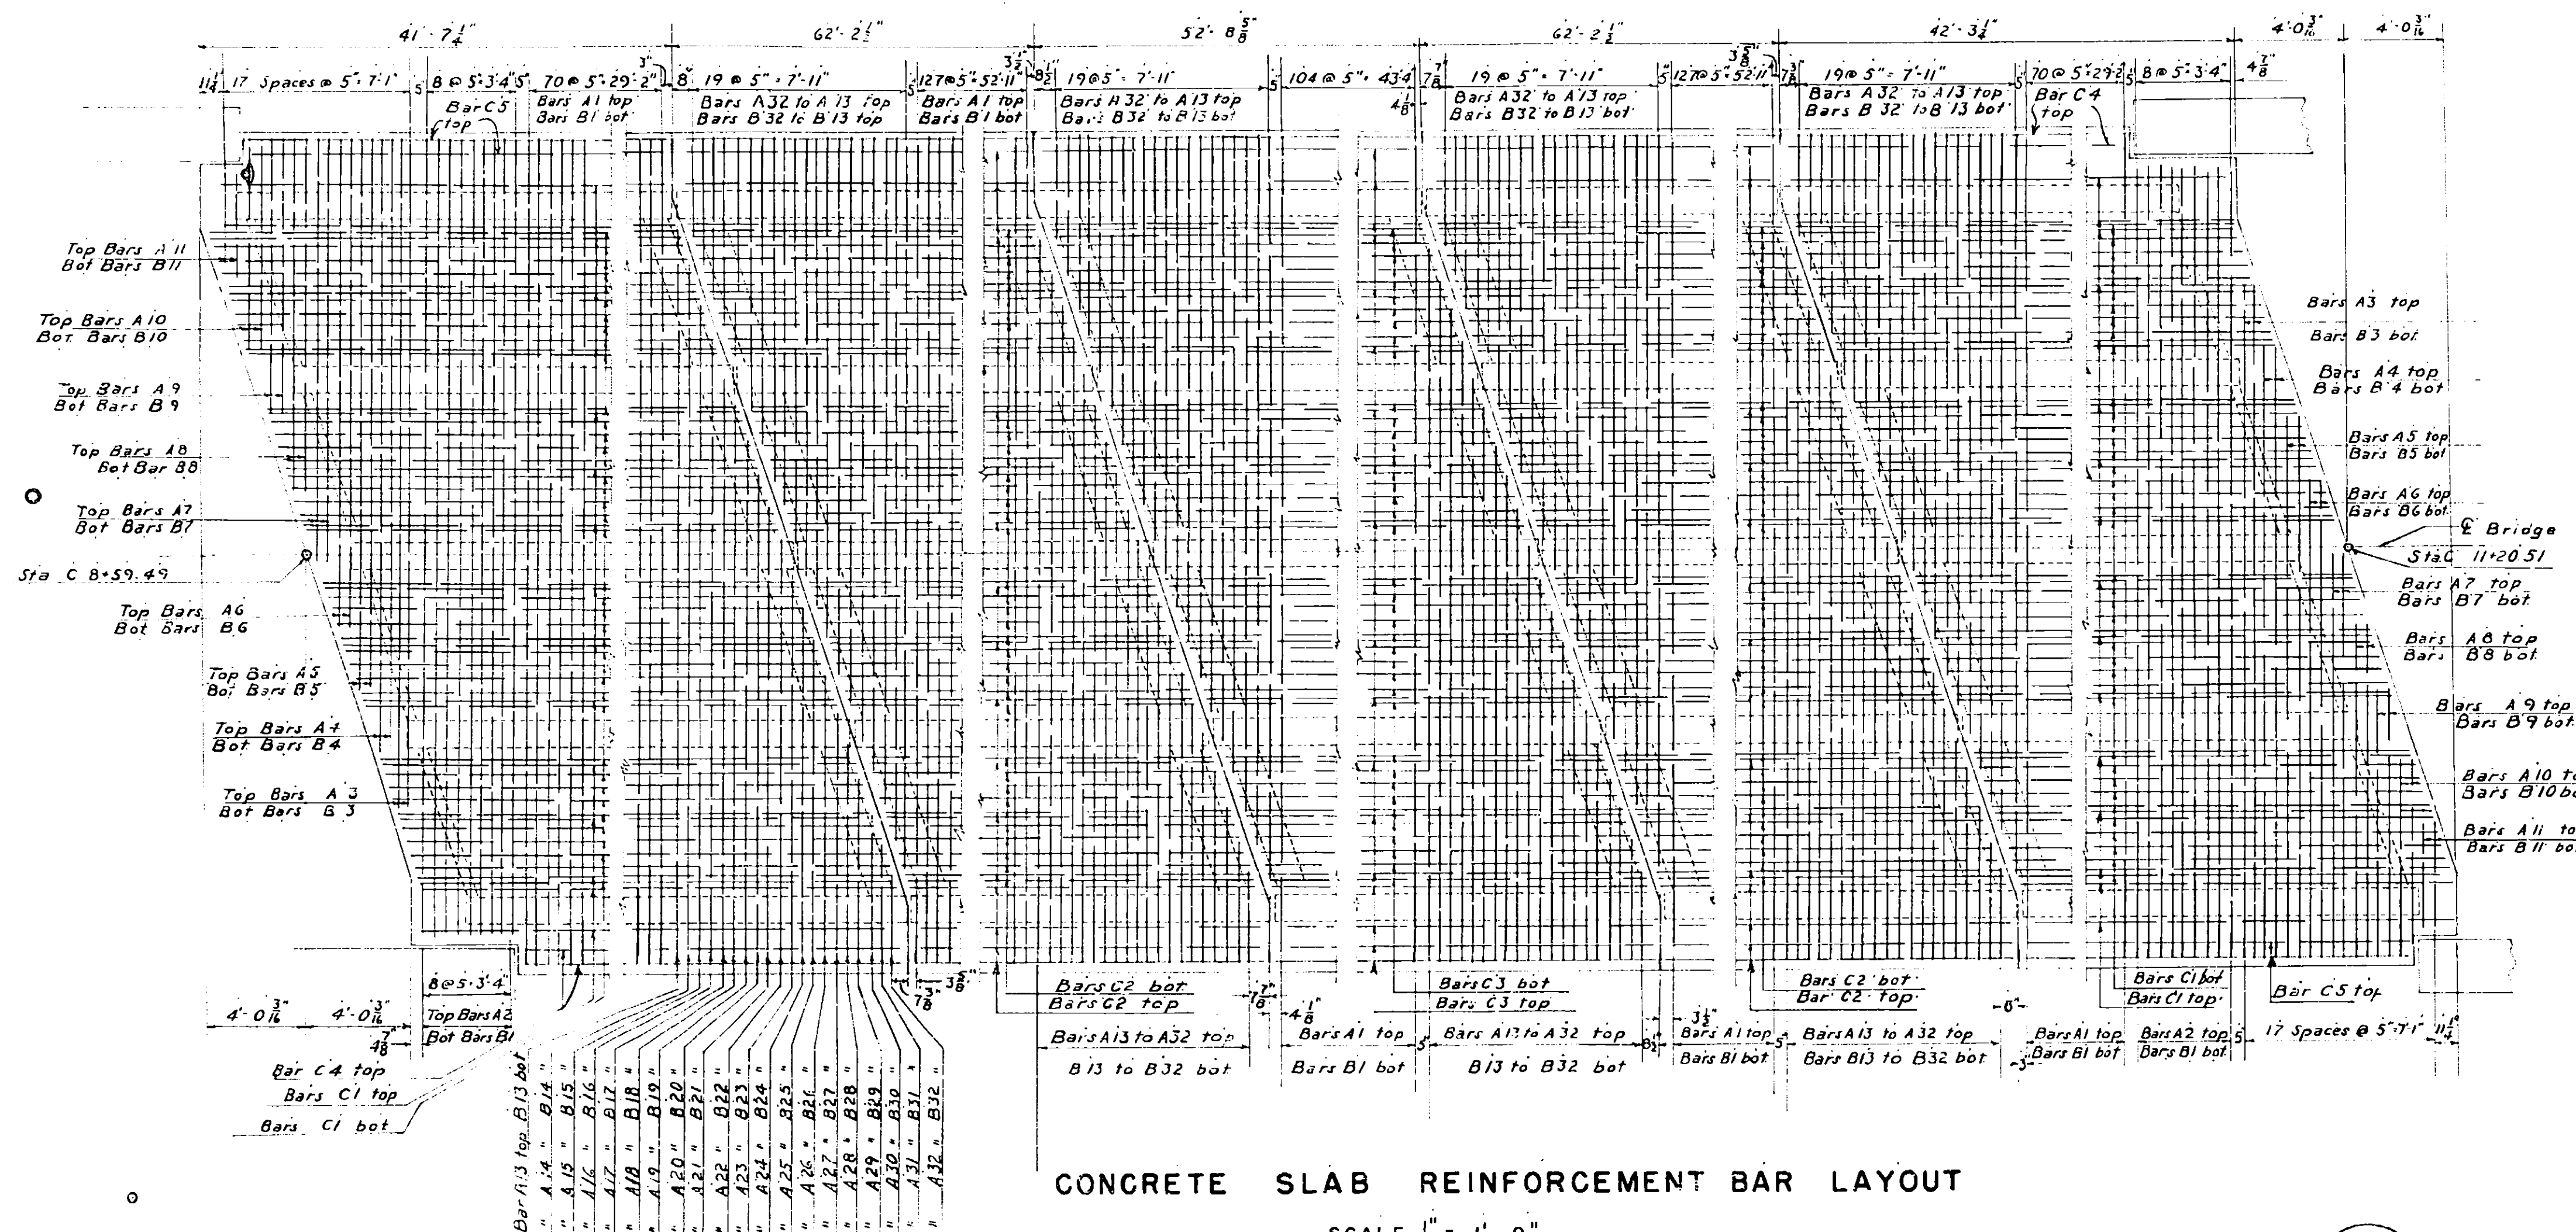

CONCRETE SLAB REINFORCEMENT BAR LAYOUT

SCALE $\frac{1}{4}'' = 1' - 0''$

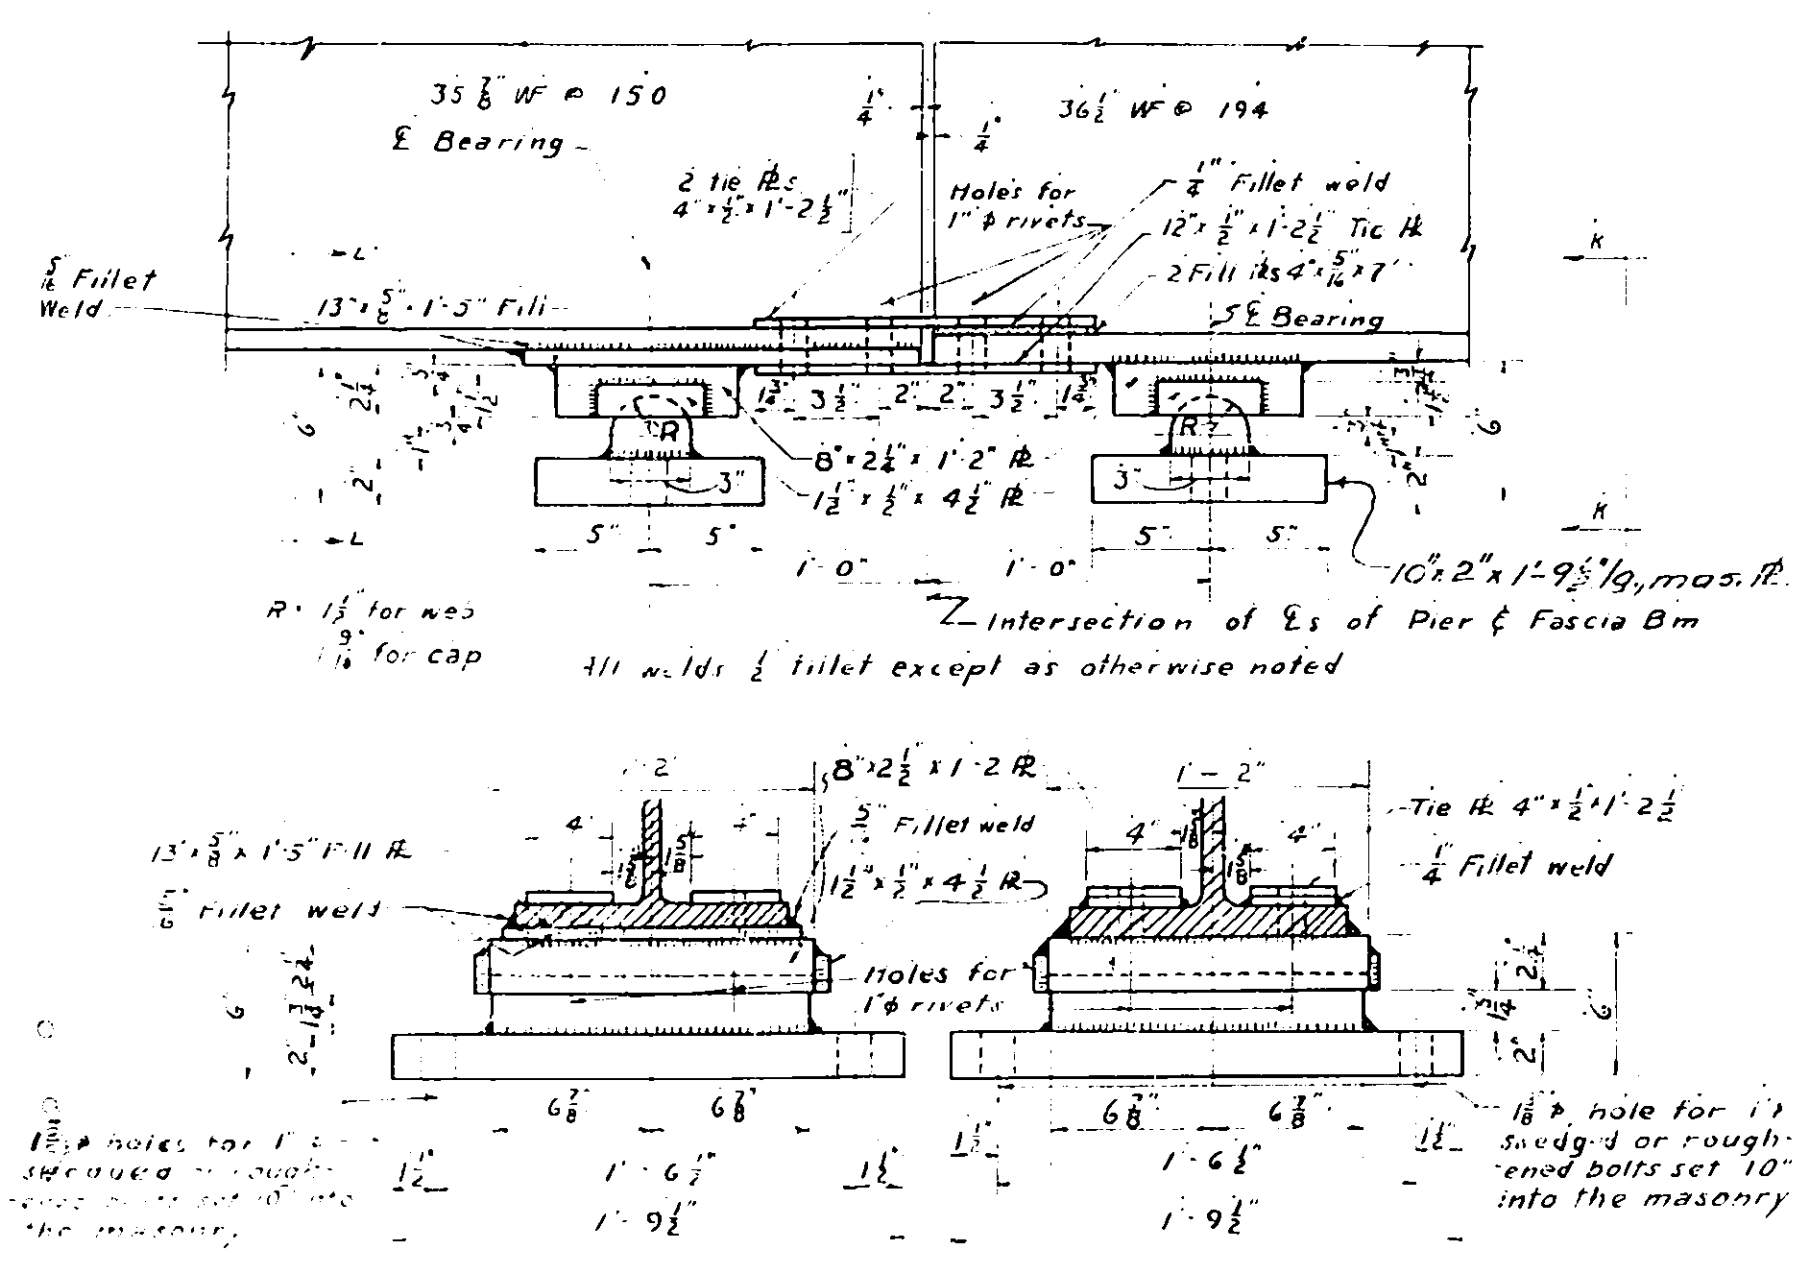

SECTION LL SECTION K-K

FIXED BEARING NO. 2

SCALE $1\frac{1}{2}'' = 1' - 0''$

Thanks
Dossidy
Becker

3/8" thickness of the overlaying concrete shall replace the waterproofing.

No construction joints other than those shown on these plans will be permitted without the written permission of the Deputy Chief Engineer.

The contract shall include installing joint material including caulking compound, elastic cement, premoulded bituminous joint material, bituminous material Item 718, molten lead and copper flashing shall be included in the price bid for Item 10.

Reinforcement bars may be spliced in places approved by the Deputy Chief Engr. bars so spliced shall be lap welded diameters.

Three parts red lead and one part first tierd coal to be battleship gray. Second tierd coal to be gray green paint.

Rivet bolts or equal may be used. Rivets to be 5/8" diameter unless otherwise noted.

Open holes 1/4" diameter unless otherwise noted.

The camber provided in steel beams to compensate for deflection may not correspond with the actual deflection under dead load.

To insure uniform grade on roadway and sidewalk surfaces on multiple spans under dead load, corrections must be made in the thickness of wearing surface of pavement and height of curbs. The thickness is to be increased over the piers in cases where there is excessive camber in the beams and increased at the center of the spans where there is insufficient camber. The normal thickness of the normal thickness of the wearing surface and sidewalk thickness is to be used. In no case shall a thickness of pavement or height of curb be used that is less than is shown on the plans.

Railing will be paid for under Item 37. Railing post sockets will be paid for under Item 29.

Designing and detailing have been done in accordance with the AASHO Specifications 1944 for Highway bridges.

This structure has been designed for a series of 20 ton trucks in each traffic lane, trucks spaced 30 feet apart between axes. Dimensions and distribution as specified in the AASHO Specifications, 1944.

For all structural work in accordance with "Public Works Specifications" Jan 2, 1951 and current modifications.


Anchor bolts will be paid for under Item 29.

Immediately before placing pavement concrete, the concrete surfaces upon which it is to be placed shall be thoroughly wetted down continuously for one hour, if the air temperature is above 50°. Payment to be made under Items 1 W and 1 W A in highway estimate.

Where steel exceeding one inch in thickness is to be welded mild steel arc-welding electrodes with covering of low-hydrogen type shall be used. These electrodes must comply with A.S.T.M. (A 233) requirements for Classification E 6015 or E 6016.


N.I.C. means not in this contract.

Item 6.2 is not in this contract (N.I.C.). Thickness of overlaying concrete shall be increased 3/8".

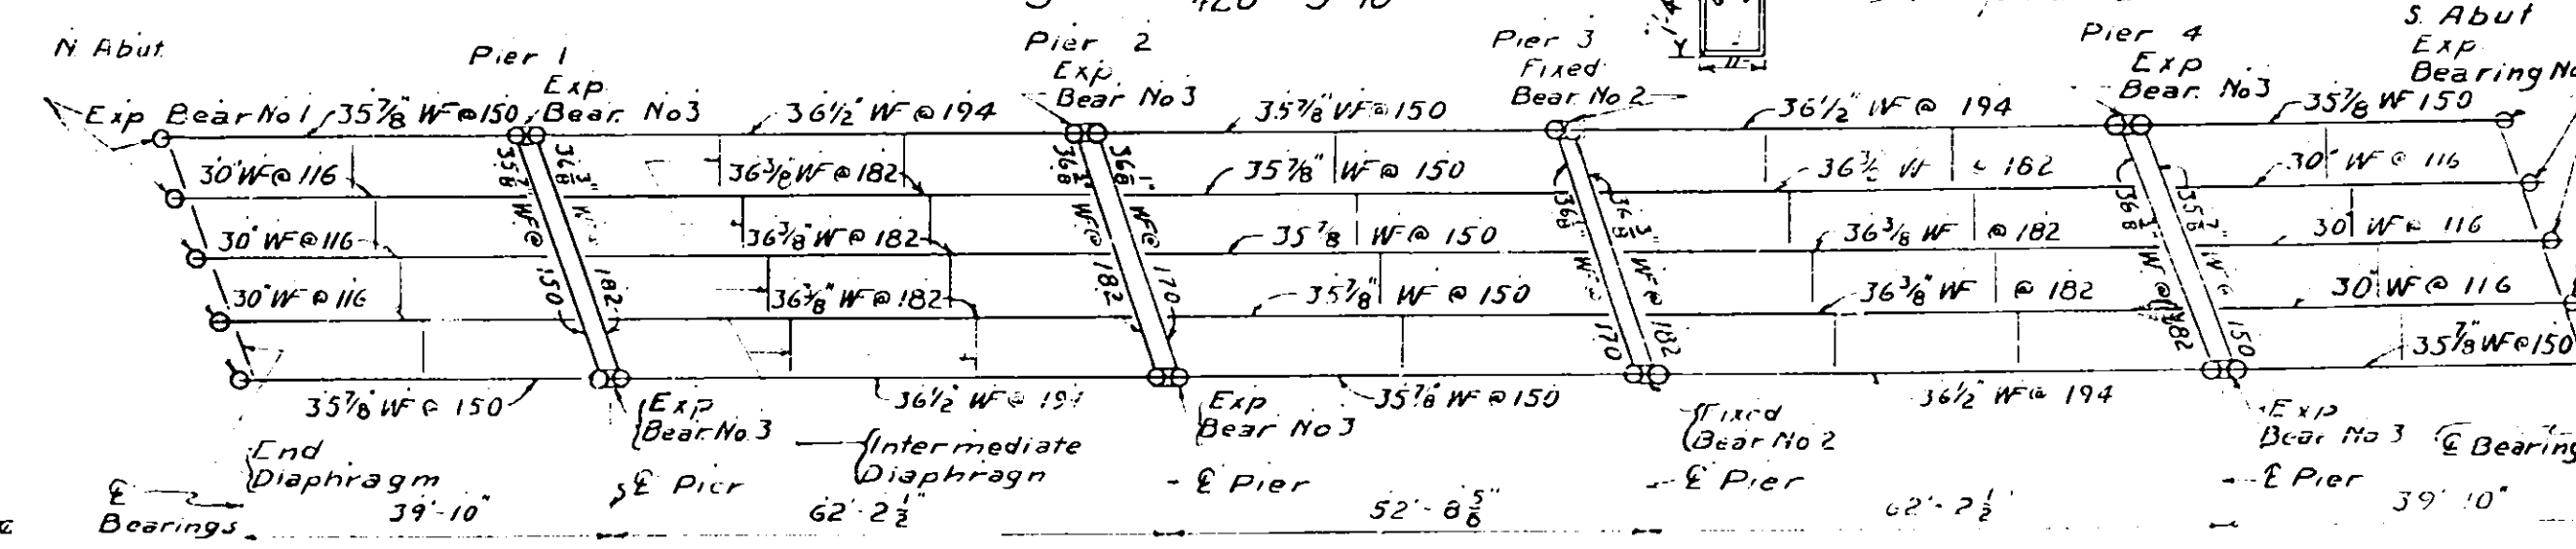

STEEL LAYOUT
PINEPLAIN - KIRKVILLE ROAD
STA. 64 + 36
SUPERSTRUCTURE

Fed. Rd. Div. No.	State	Fed. Aid Proj. No.	County	Sheet No.	Total Sheets
	N.Y.		Madison	9	67
MOHAWK THRUWAY - N. MANLIUS - N. CHITTENANGO Pine Plains - Kirkville - County Rd.					

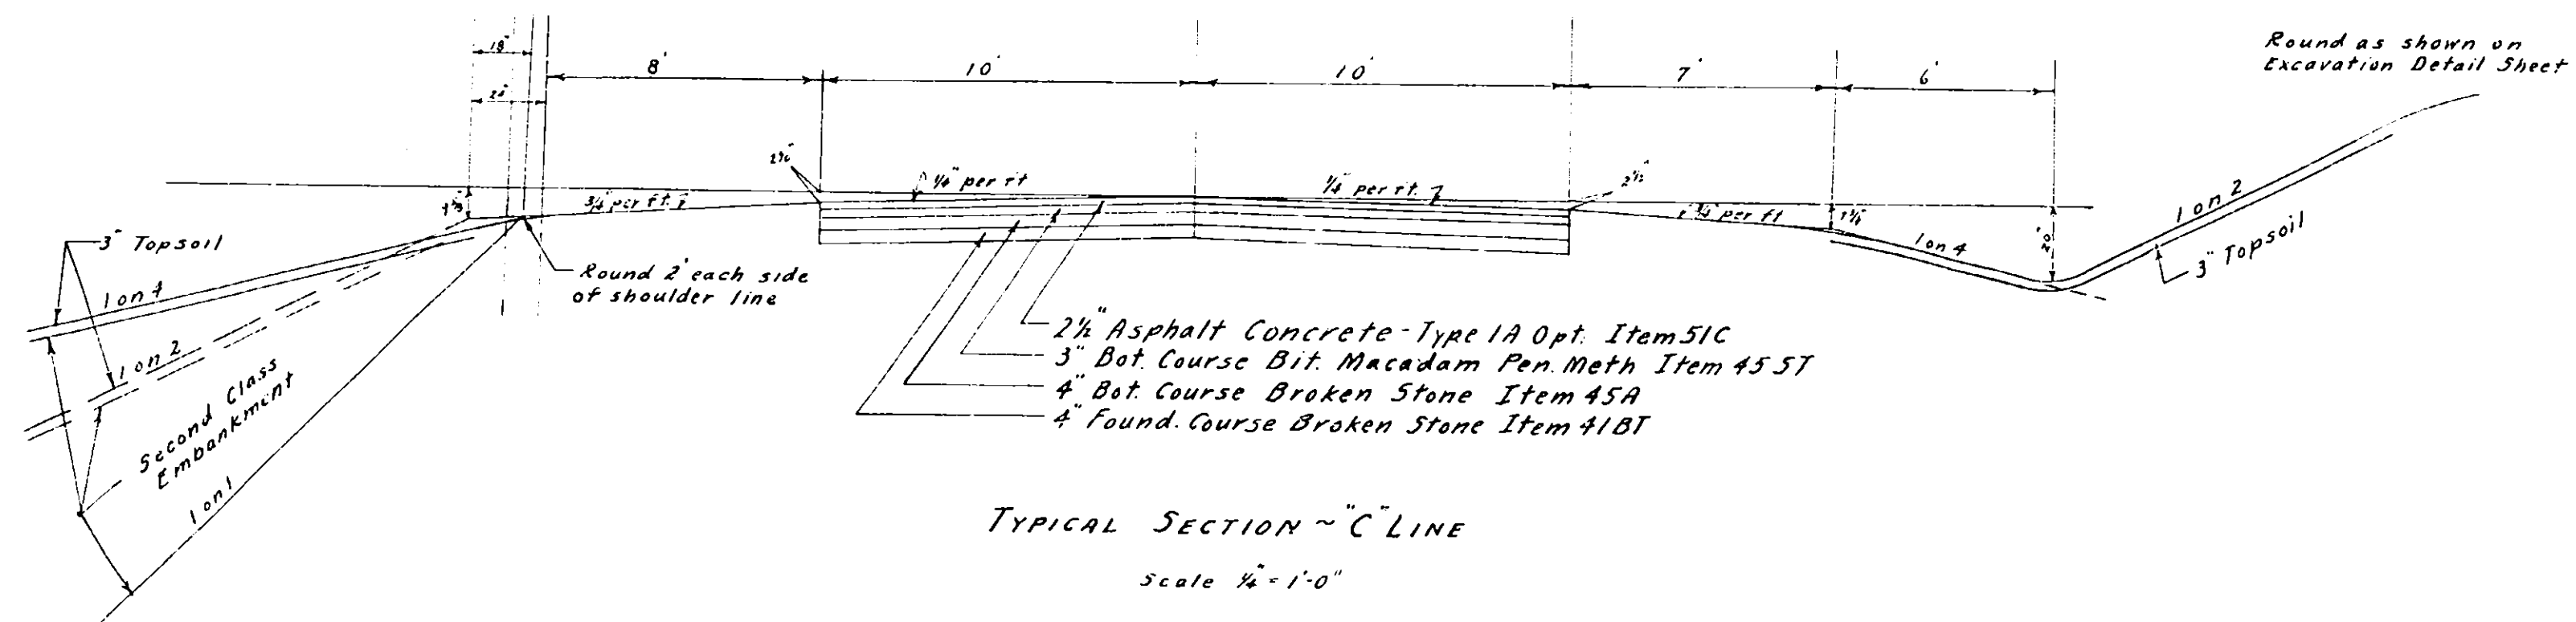

Slopes outside of roadway adjacent to ends of cuts and fills to be flattened and warped as ordered by the Engineer.

At intervals of 100 ft. or at such intervals as the Engineer may direct, lateral trenches or weep holes four feet in width shall be opened up thru the shoulders to the ditches to effectively drain the subgrade before the pavement is constructed. These shall be filled with Item 41BT, Found. Course, Broken Stone and the excavation will be paid for under Item 2B, Unclassified Excavation.

Second Class Embankment shall be used between the lines indicated if ordered by the Engineer. Second Class Embankment is material stripped from cuts and under embankments as ordered, but shall not include stumps, logs, brush nor other objectionable material.


Item 2B - UNCLASSIFIED EXCAVATION		
From		Cu. Yds.
Road Excavation	-	271
Borrow	-	28345
Remove Temp. Intersection	-	1000
" Old Pavement	-	180
Estimate	-	3204
TOTAL	-	33000

TABLE of LENGTHS			
Station to Station	Road Lin. Ft. Miles	Bridge Lin. Ft. Miles	
C 0+00 - C 8+59.5	859.5	0.163	
C 8+59.5 C 11+20.5		261.0	0.049
C 11+20.5 C 16+37	516.5	0.958	
C 16+37 - C 20+50	370.	0.670	
TOTALS	1746.0	C.331	261.0 C.049

Item 32D - OPTIONAL GUIDE RAILING				
Station to Station	Side	Side	Side	Lin. Ft.
4+00 - 8+40	L	I		440
4+00 - 8+50	R	I		460
11+25 - 16+98	L	I		530
11+35 - 16+98	R	I		520
				1950
4 Anchors @ 20'				80
For Estimate				100
TOTAL				2130


Item 5 - TRENCH, CULVERT and BRIDGE EXCAVATION		
From		Cu. Yds.
Drainage Sheet	-	75
Estimate	-	50
TOTAL	-	125

DRAINAGE STRUCTURES		
Present Structure	Station	REMARKS
18" R.C.C.P. Culvert	C 8+30	Remove and store on the R.O.W. existing 18" R.C.C.P. Culvert on the left.
12" Corr. Metal Pipe Culvert	C 9+70	Remove and store on the R.O.W. existing 12" Corr. Metal Pipe Culvert on the left.

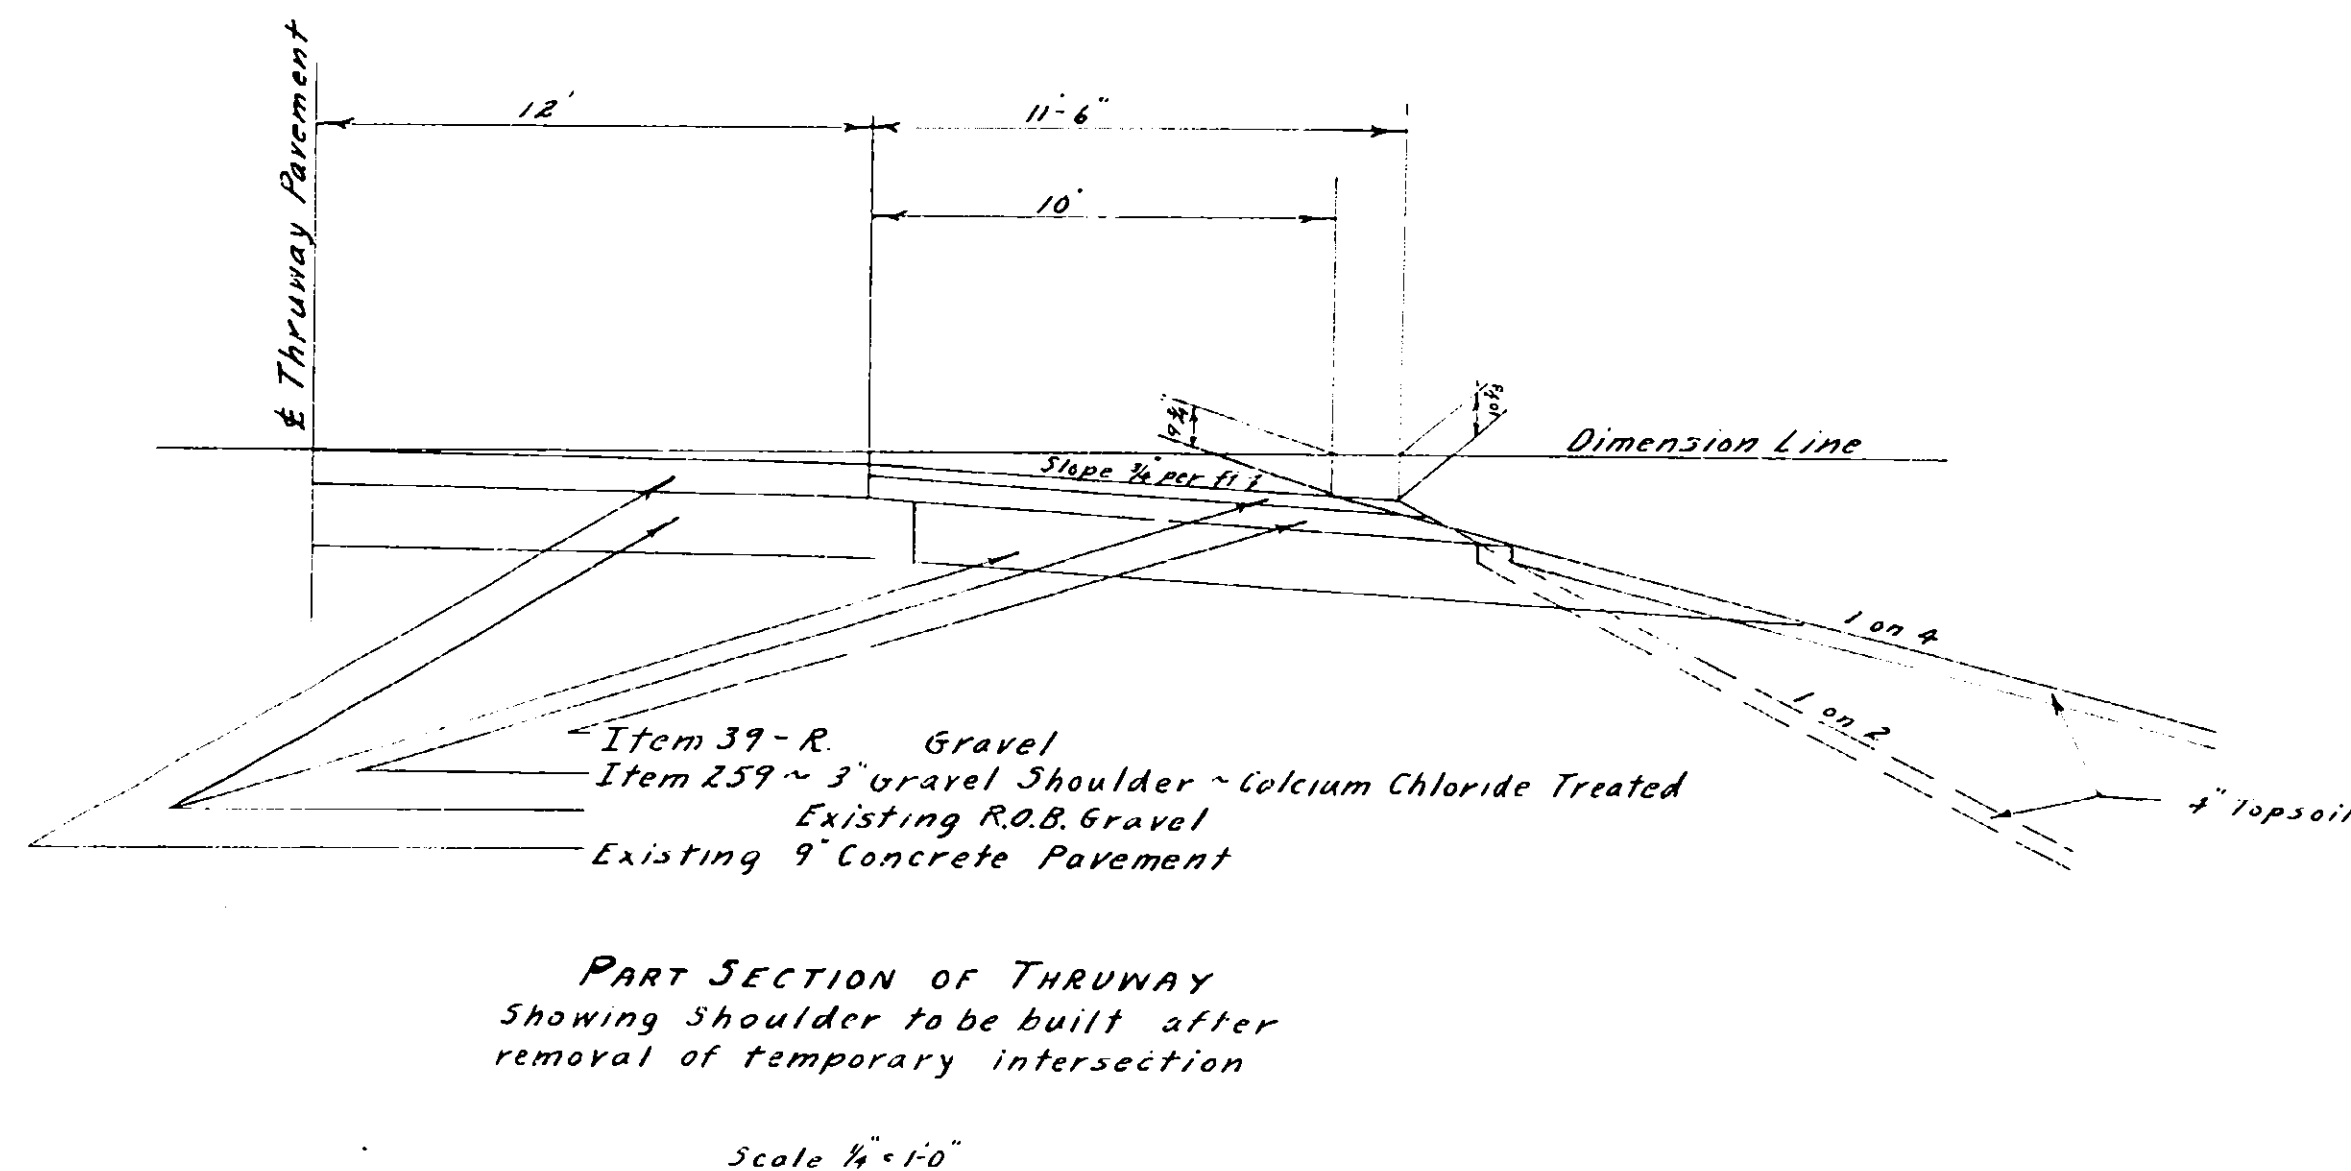

MADE BY Traced By Checked By
PLAN E. White Colangelo L. Piron
PROFILE


PREPARED PURSUANT TO THE HIGHWAY LAW & RECOMMENDED BY
DATE
ENGINEER DISTRICT No 2

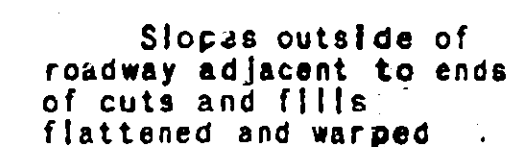

At intervals of 100 ft.

lateral trenches or weep holes four feet in width opened up thru the shoulders to the ditches to effectively drain the subgrade before the pavement constructed. These filled with item 418T, Found. Course, Broken Stone and the excavation paid for under item 28, Unclassified Excavation.

Second Class Embankment shall be used between the lines indicated if ordered by the Engineer. Second Class Embankment is material stripped from cuts and other embankments as ordered, but shall not include stumps, logs, brush nor other objectionable material.

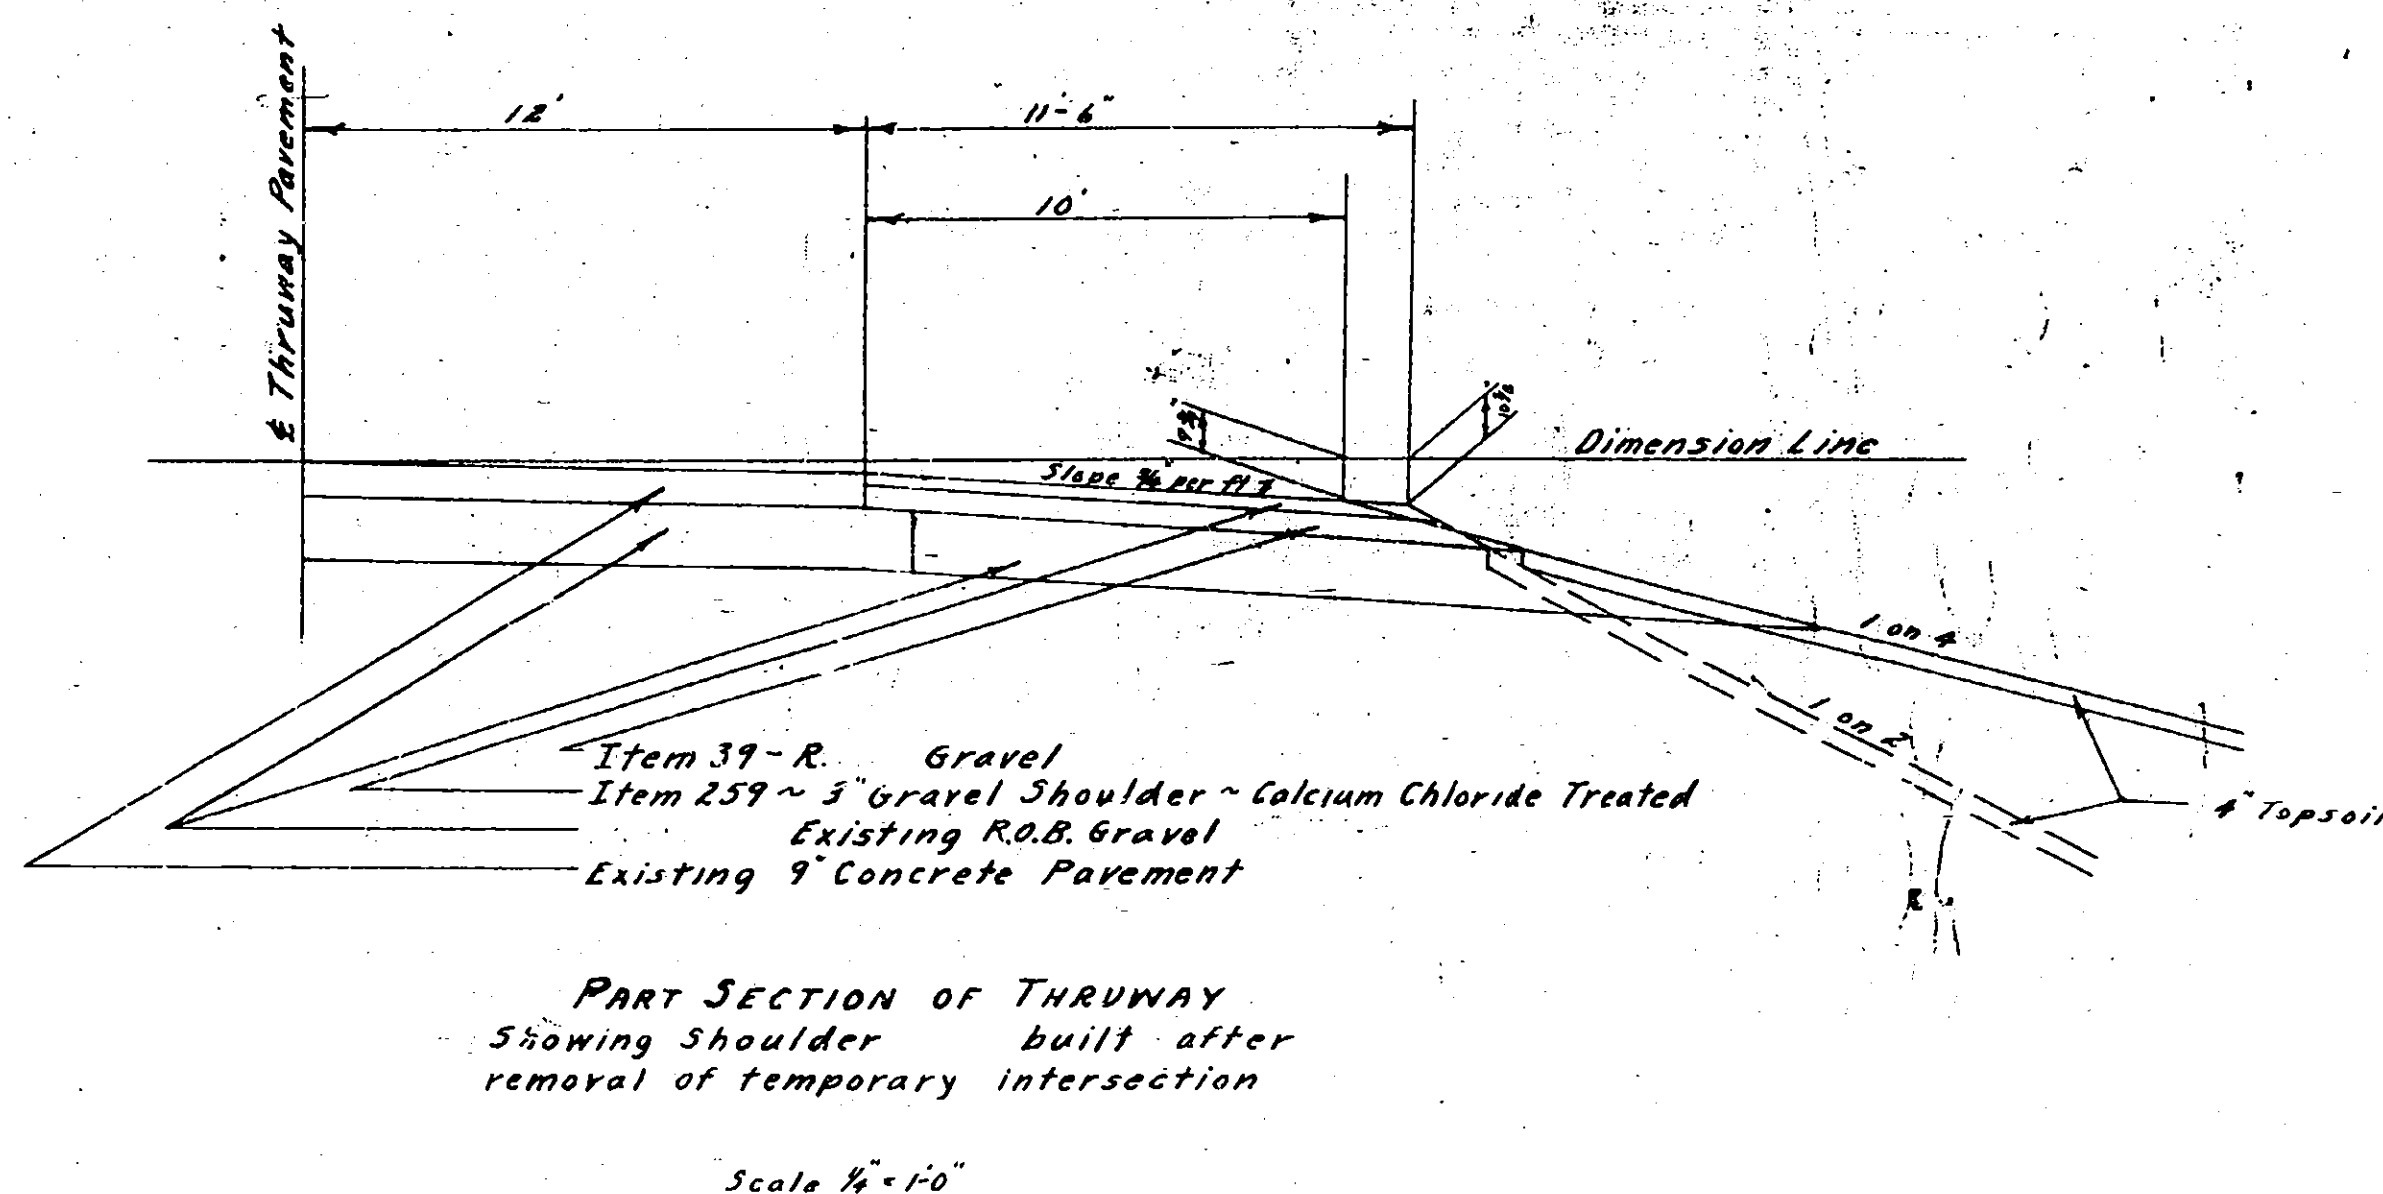

Item 2B - UNCLASSIFIED EXCAVATION

From		Cu. Yds
Road Excavation	-	2,400
Borrow	-	1,200
Remove Temp. Intersection	-	
	-	
	-	
TOTAL	-	3,600

TABLE of LENGTHS

Station to Station	Road		Bridge	
	Lin.Ft.	Miles	Lin.Ft.	Miles
C 0+00 - C 8+59.5	859.	0.163		
C 8+59.5 C 11+20.5			261.0	0.049
C 11+20.5		0.098		
C - C 20+50		0.070		
TOTALS		0.331	261.0	0.049

Item 32D - OPTIONAL GUIDE RAILING

Station	to Station	Side	Anchor	Lin. Ft.
-	-	8+		
-	-	8+		
11+25	-	16+	L	530
11+35	-	16+	R	
4 Anchors @ 25'				80
TOTAL				2

Item 5 - TRENCH, CULVERT and BRIDGE EXCAVATION

From	Cu. Yds.
TOTAL	

DRAINAGE STRUCTURES

Present Structure	Station	REMARKS
18" R.C.C.P. Culvert	C 8+30	Remove existing 18" R.C.C.P. Culvert on the left.
12" Corr. Metal Pipe Culvert	C 8+70	Remove existing 12" Corr. Metal Pipe Culvert on the left.

SCHEDULE A

C 0+00 - C 7+92	L&R	121	329 C.Y.	Break in shoulder to end of road section
C 11+88 - C 20+50	L&R	121	387 C.Y.	ditto
C 4+60 - C 8+60	L&R	121	82 C.Y.	Cover old road
C 0+00 - C 7+92	L&R	123	0.85 Acres	Edge of pavement to end of road section
C 11+88 - C 20+50	L&R	123	1.08 Acres	ditto
C 4+60 - C 8+60	L&R	123	0.20 Acres	Old road
C 2+00 - C 7+92	L&R	124	992 S.Y.	Sodded berm gutters, slope channels and sod strips
C 11+88 - C 18+50	L&R	124	1352 S.Y.	See Standard Sheet 50-34
C 2+00 - C 9+00	L&R	IWA	14 M Gals.	In areas where Item 124 is used.
C 10+80 - C 18+50	L&R	IWA	22 M Gals	ditto
From BRIDGE PLANS				
C 7+92 - C 9+00	L&R	121	133 C.Y.	Break in shoulder to end of road section
C 10+80 - C 11+88	L&R	121	134 C.Y.	ditto
C 7+92 - C 9+00	L&R	123B	0.19 Acres	Edge of pavement to end of road section
C 10+80 - C 11+88	L&R	123B	0.19 Acres	ditto
C 7+92 - C 9+00	L&R	124	298 S.Y.	Sodded berm gutters, slope channels and sod strips. See Sheet of Plans.
C 10+80 - C 11+88	L&R	124	298 S.Y.	ditto
TOTAL	IWA		36 M Gals	Neat
TOTAL	121		798 C.Y.	Rounded
TOTAL	121		900 C.Y.	Neat) - Highway
TOTAL	121		267 C.Y.	Neat) - Bridge
TOTAL	123		2.13 Acres	Neat) - Highway
TOTAL	123B		0.38 Acres	Rounded) - Highway
TOTAL	123B		0.50 Acres	Rounded) - Bridge
TOTAL	124		2344 S.Y.	Neat) - Highway
TOTAL	124		2650 S.Y.	Rounded) - Highway
TOTAL	124		596 S.Y.	Neat) - Bridge
TOTAL	124		650 S.Y.	Rounded) - Bridge

SCHEDULE B

DETAIL SPECIFICATIONS TO ACCOMPANY PUBLIC WORKS SPECIFICATIONS

ITEM	DESCRIPTION
IW	FURNISHING WATER EQUIPMENT
IWA	APPLYING WATER
a	Areas - See Schedule A.
	Rates - As specified
121	TOPSOIL PLACED FROM STOCKPILES
a	Areas - See Schedule A.
c1	Subgrade scarified as directed by Engineer.
3	Topsoil thickness - 3 inches loose measure
123	SEEDING
a	Areas - See Schedule A.
b	Seeds - See Schedule D.
	Fertilizer - M-55, Type No. 2 (10-10-10)
	Mulch - M-59, Hay or M-60, Straw
c2	No inoculation required for Alsike Clover.
c3	Rate of seeding - 50 lbs. pure live seed per acre
	Rate of fertilizer - 600 lbs. per acre
c4	Rate of mulch - 2 tons per acre
123B	SEEDING ON PREPARED AREAS
a	Areas - See Schedule A.
124	SODDING
a	Areas - See Schedule A.
c3	Sodding shall be as shown on Standard Sheet 50-34, Bridge Plans, or as directed by Engineer.

LOCATION of TOPSOIL STOCKPILES

Station	Side	Approx. Quantity
7+00	Lt.	500 C.Y.
15+00	Lt.	200 C.Y.
30+00	Rt.	2000 C.Y.
44+00	Rt.	800 C.Y.
87+00	Rt.	1500 C.Y.
198+00	Lt.	800 C.Y.

NOTE: All areas disturbed by removing topsoil from stockpiles will be regraded and seeded as directed by Engineer. No direct payment will be made for this work but the cost thereof shall be included in the price bid for the various items in the contract.

SCHEDULE C

DETAIL SPECIFICATIONS FOR PLANTS

FED. ROAD DIST. NO.	STATE	FED. AID PROJ. NO.	FISCAL YEAR	SHEET NO.	TOTAL SHEETS
				10	67
ROADSIDE DEVELOPMENT SHEET					
MOHAWK THRUWAY					
North Manlius - North Chttenango					
PINE PLAINS - KIRKVILLE CO. RD.					

SCHEDULE D


DETAIL SPECIFICATIONS FOR SEEDS

NAME	PURITY	GERMINATION	POUNDS PURE LIVE SEED PER ACRE
Creeping Red Fescue (Festuca rubra)	Commercial		95 75 3
Redtop (Agrostis alba)	Commercial		90 85 10
Perennial Ryegrass (Lolium perenne)	Commercial		95 75 7
Alsike Clover (Trifolium hybridum)	Commercial	Max. 25% Hard Seed	95 85 3
Wild White Clover (Trifolium repens var.)	Kent Wild, N.Y.	Wild, N. Zealand Wild	95 95 5
		Max. 25% Hard Seed	
		RATE	50

IW	Nec.	Furnishing Water Equipment
IWA	36 M. Gal.	Applying Water
121	1190 C.Y.	Topsoil Placed from Stockpiles
123	3.50 Acres	Seeding
123B	0.50 Acres	Seeding on Prepared Areas
124	3250 S.Y.	Sodding

Lacy Hetherington

Fed Rd Div. No.	State	Fed Aid Proj. No.	County	Sheet No.	Total Sheets
	NK		Madison	11	67
Mohawk Thruway ~ North Manlius - North Chittenango Pine Plains - Kirkville Co. Road					

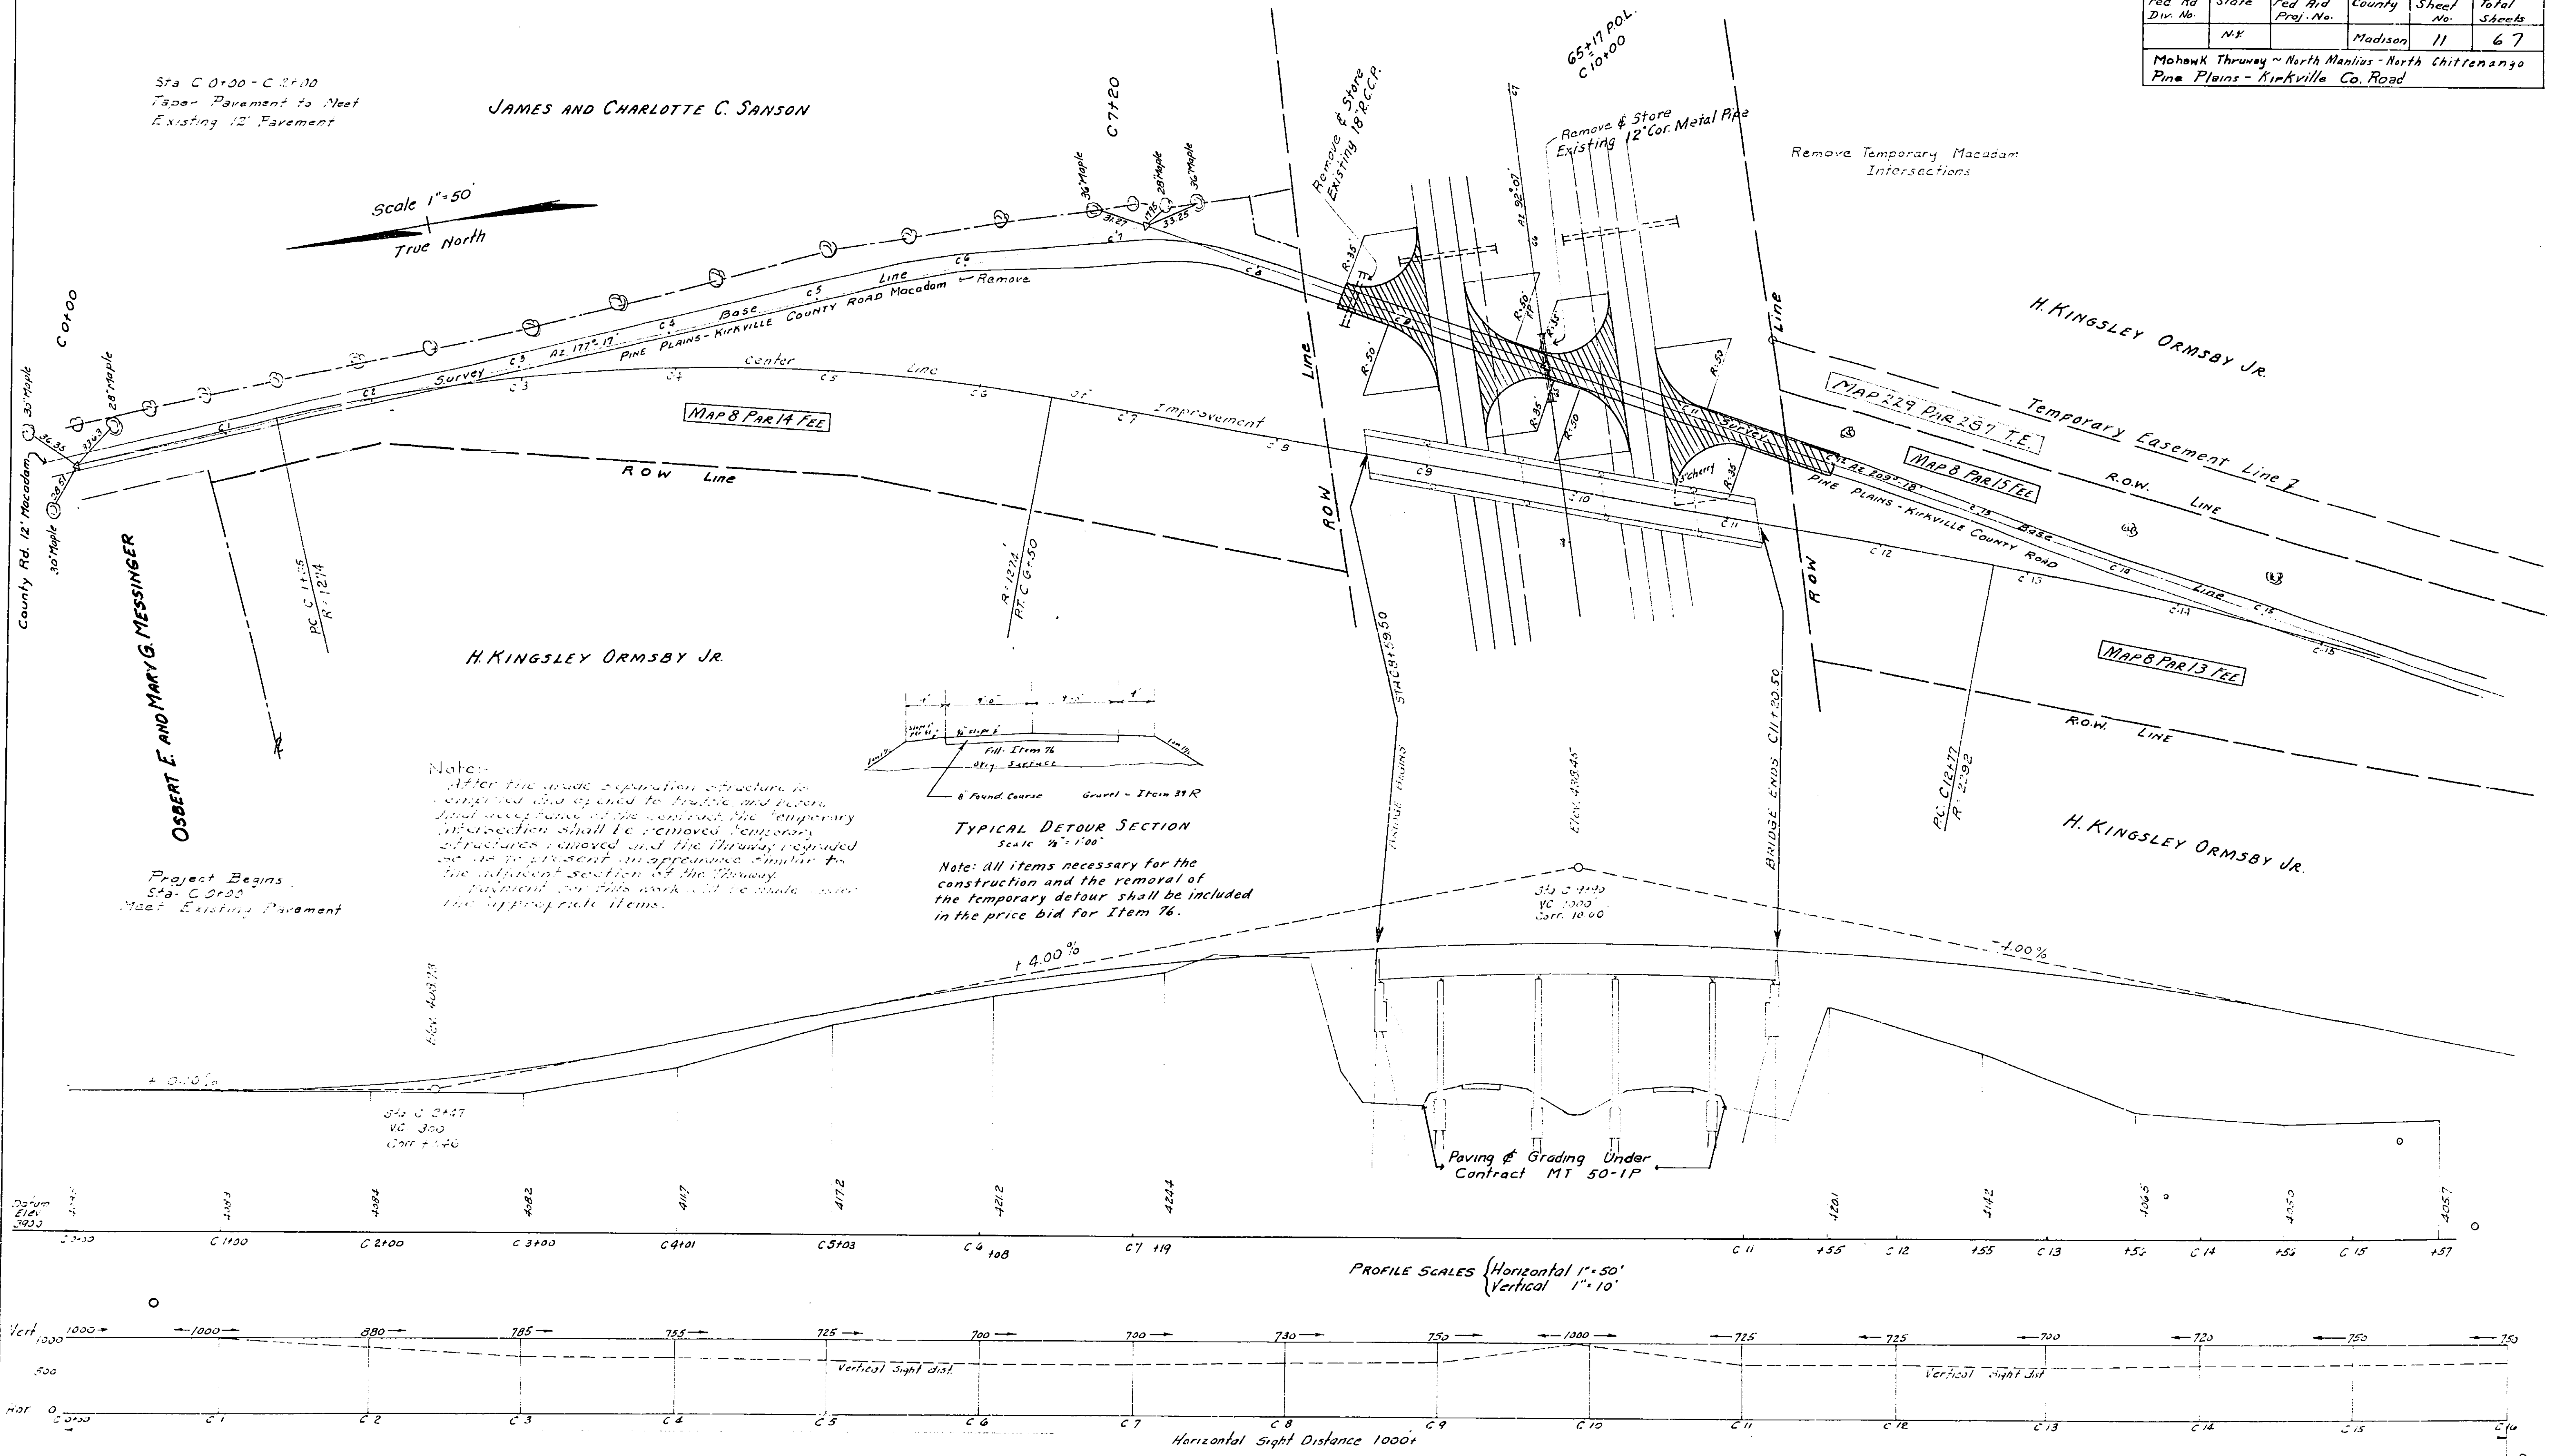

Scale 1"=50'
True North

Stationing: C+0+00, C+1+00, C+2+00, C+3+00, C+4+00, C+5+00, C+6+00, C+7+00, C+8+00, C+9+00, C+10+00, C+11+00, C+12+00, C+13+00, C+14+00, C+15+00

Profile Scales: Horizontal 1"=50', Vertical 1"=10'


SIGHT DISTANCE GRAPH
5 Feet to 5 Feet

Prepared pursuant to the Highway Law & Recommended By



Date

Engineer Dist. No. 2


Drawn By: J.J. Dwyer
Traced By: J.J. Dwyer
Checked By: J.J. Dwyer

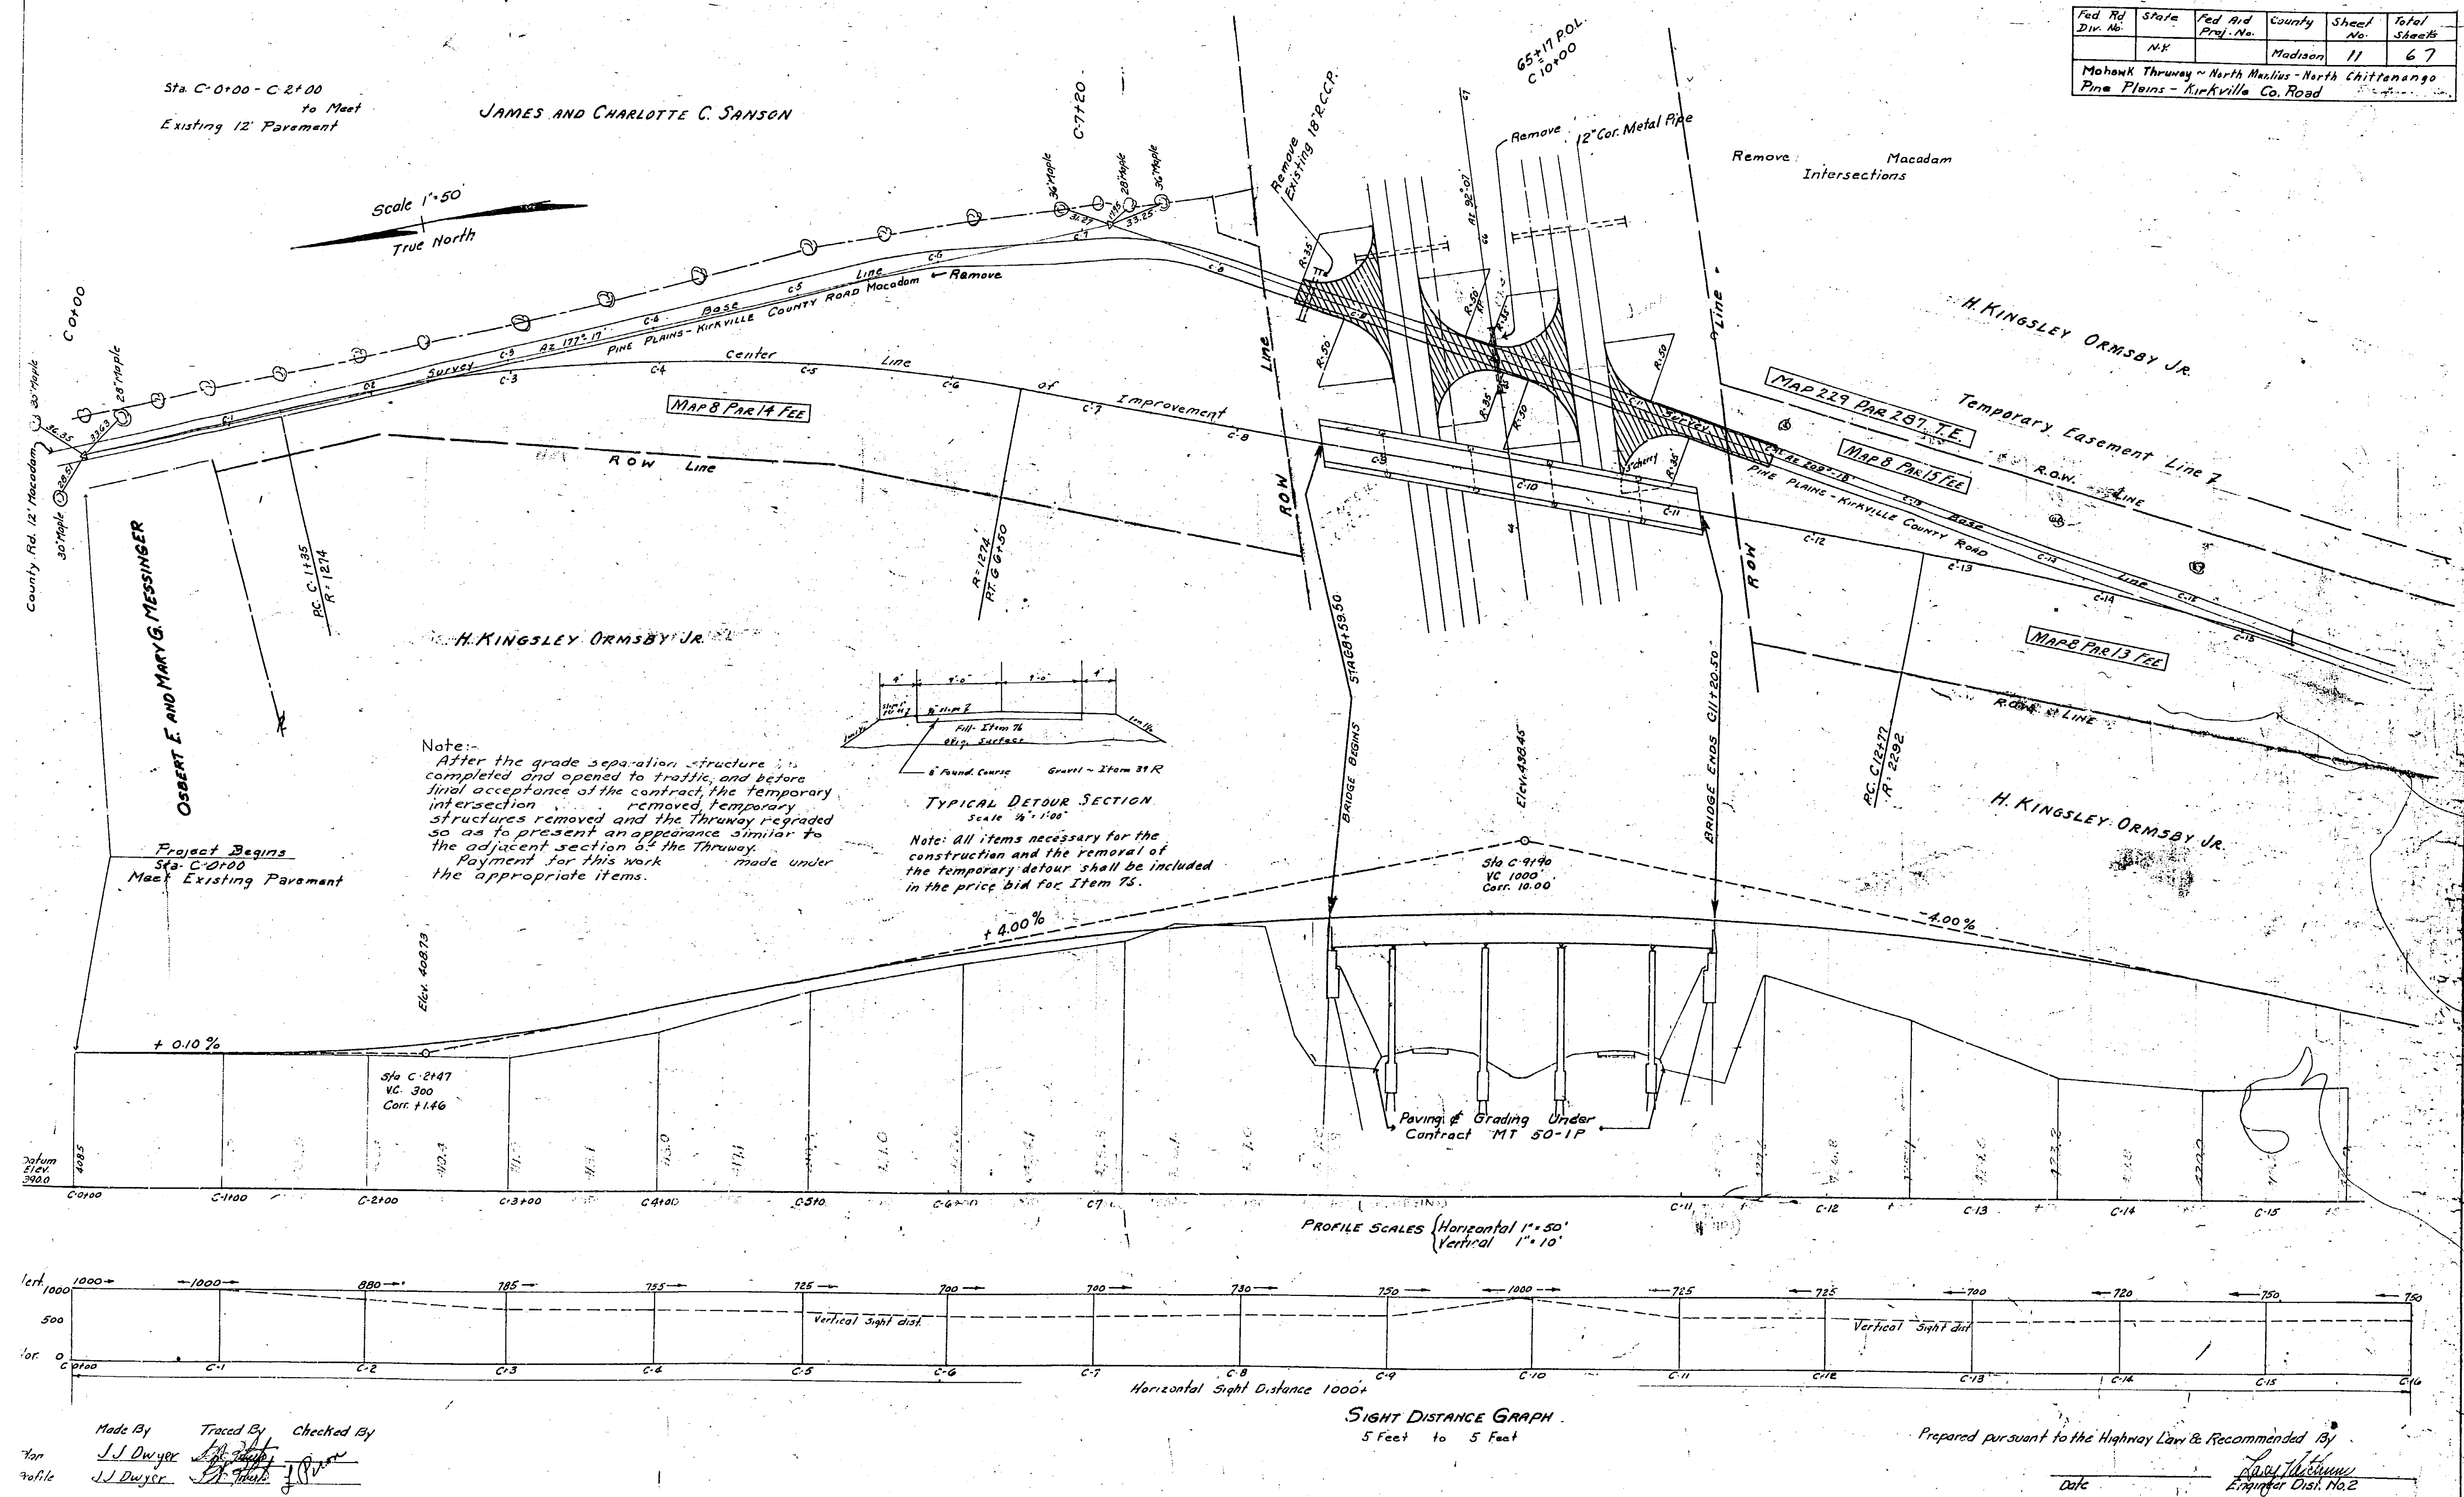

Fed Rd Dir. No.	State	Fed Aid Proj. No.	County	Sheet No.	Total Sheets
	NK		Madison	12	67
Mohawk Thruway - North Manlius - North Chittenango Pine Plains Kirkville Co. R.					

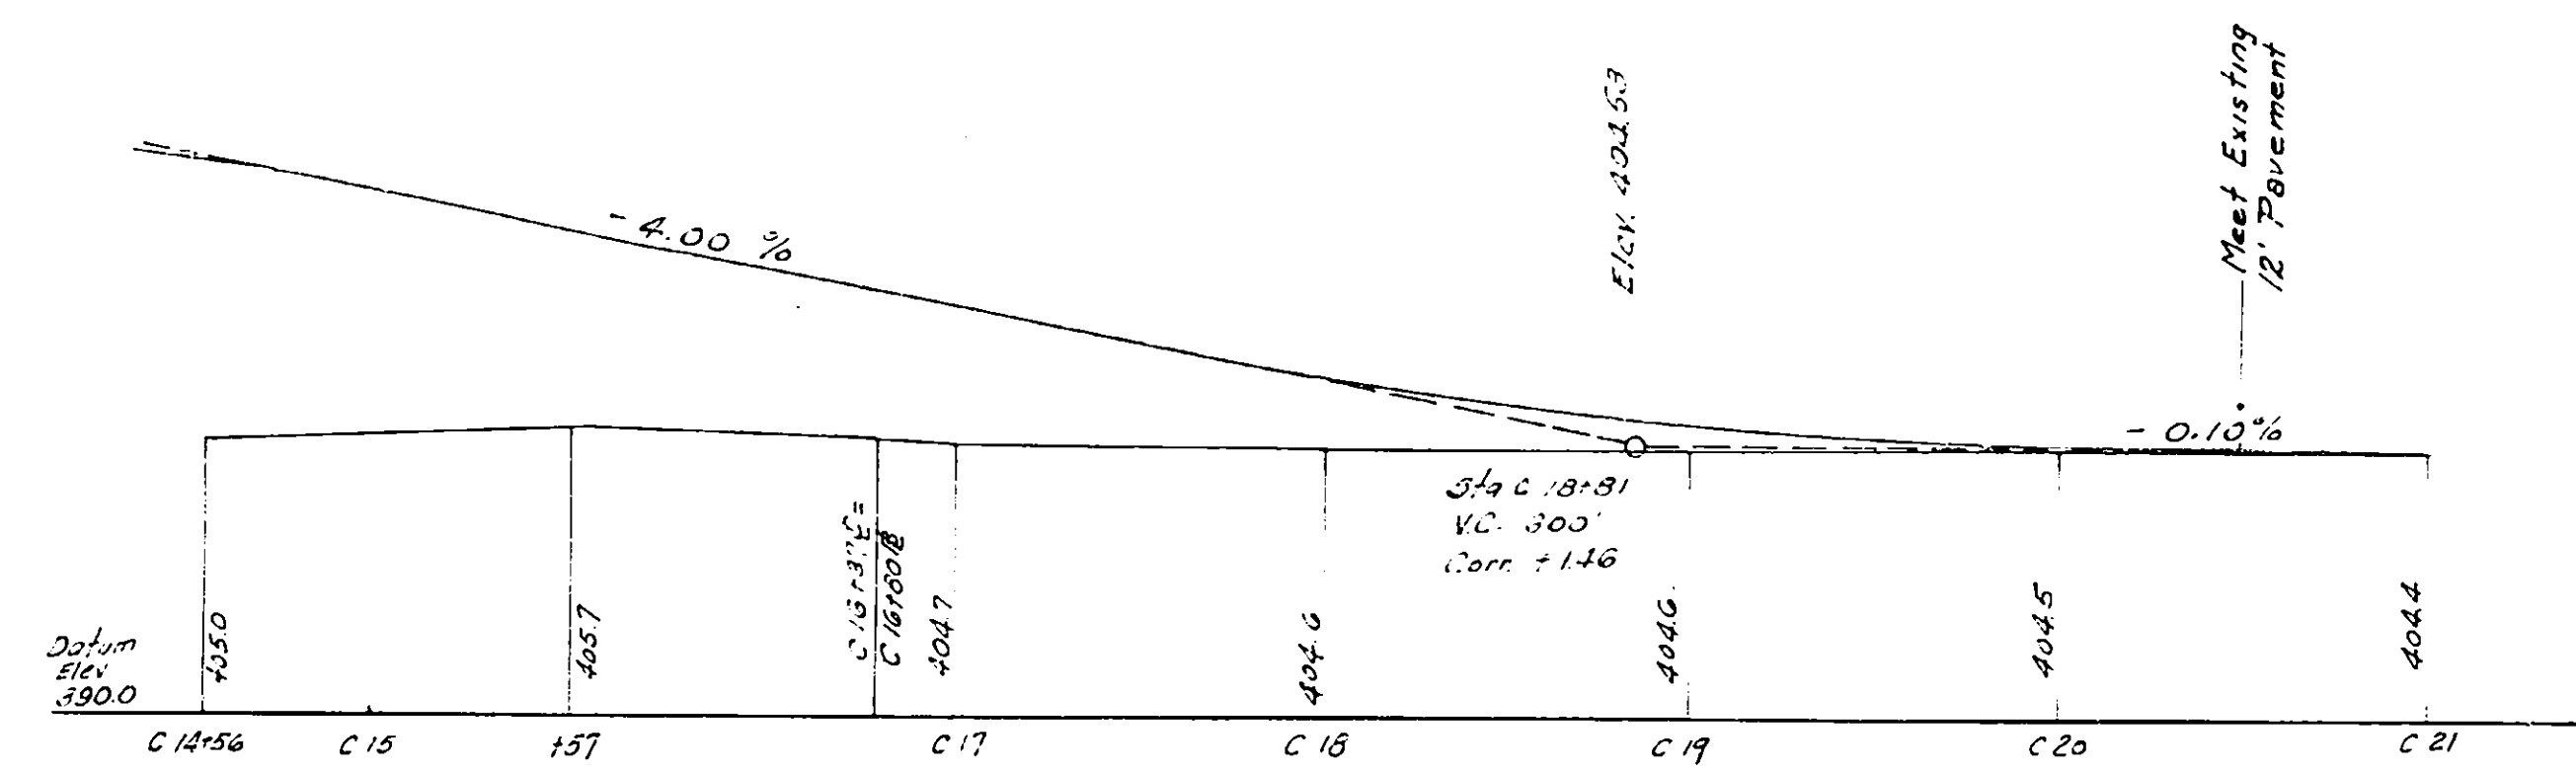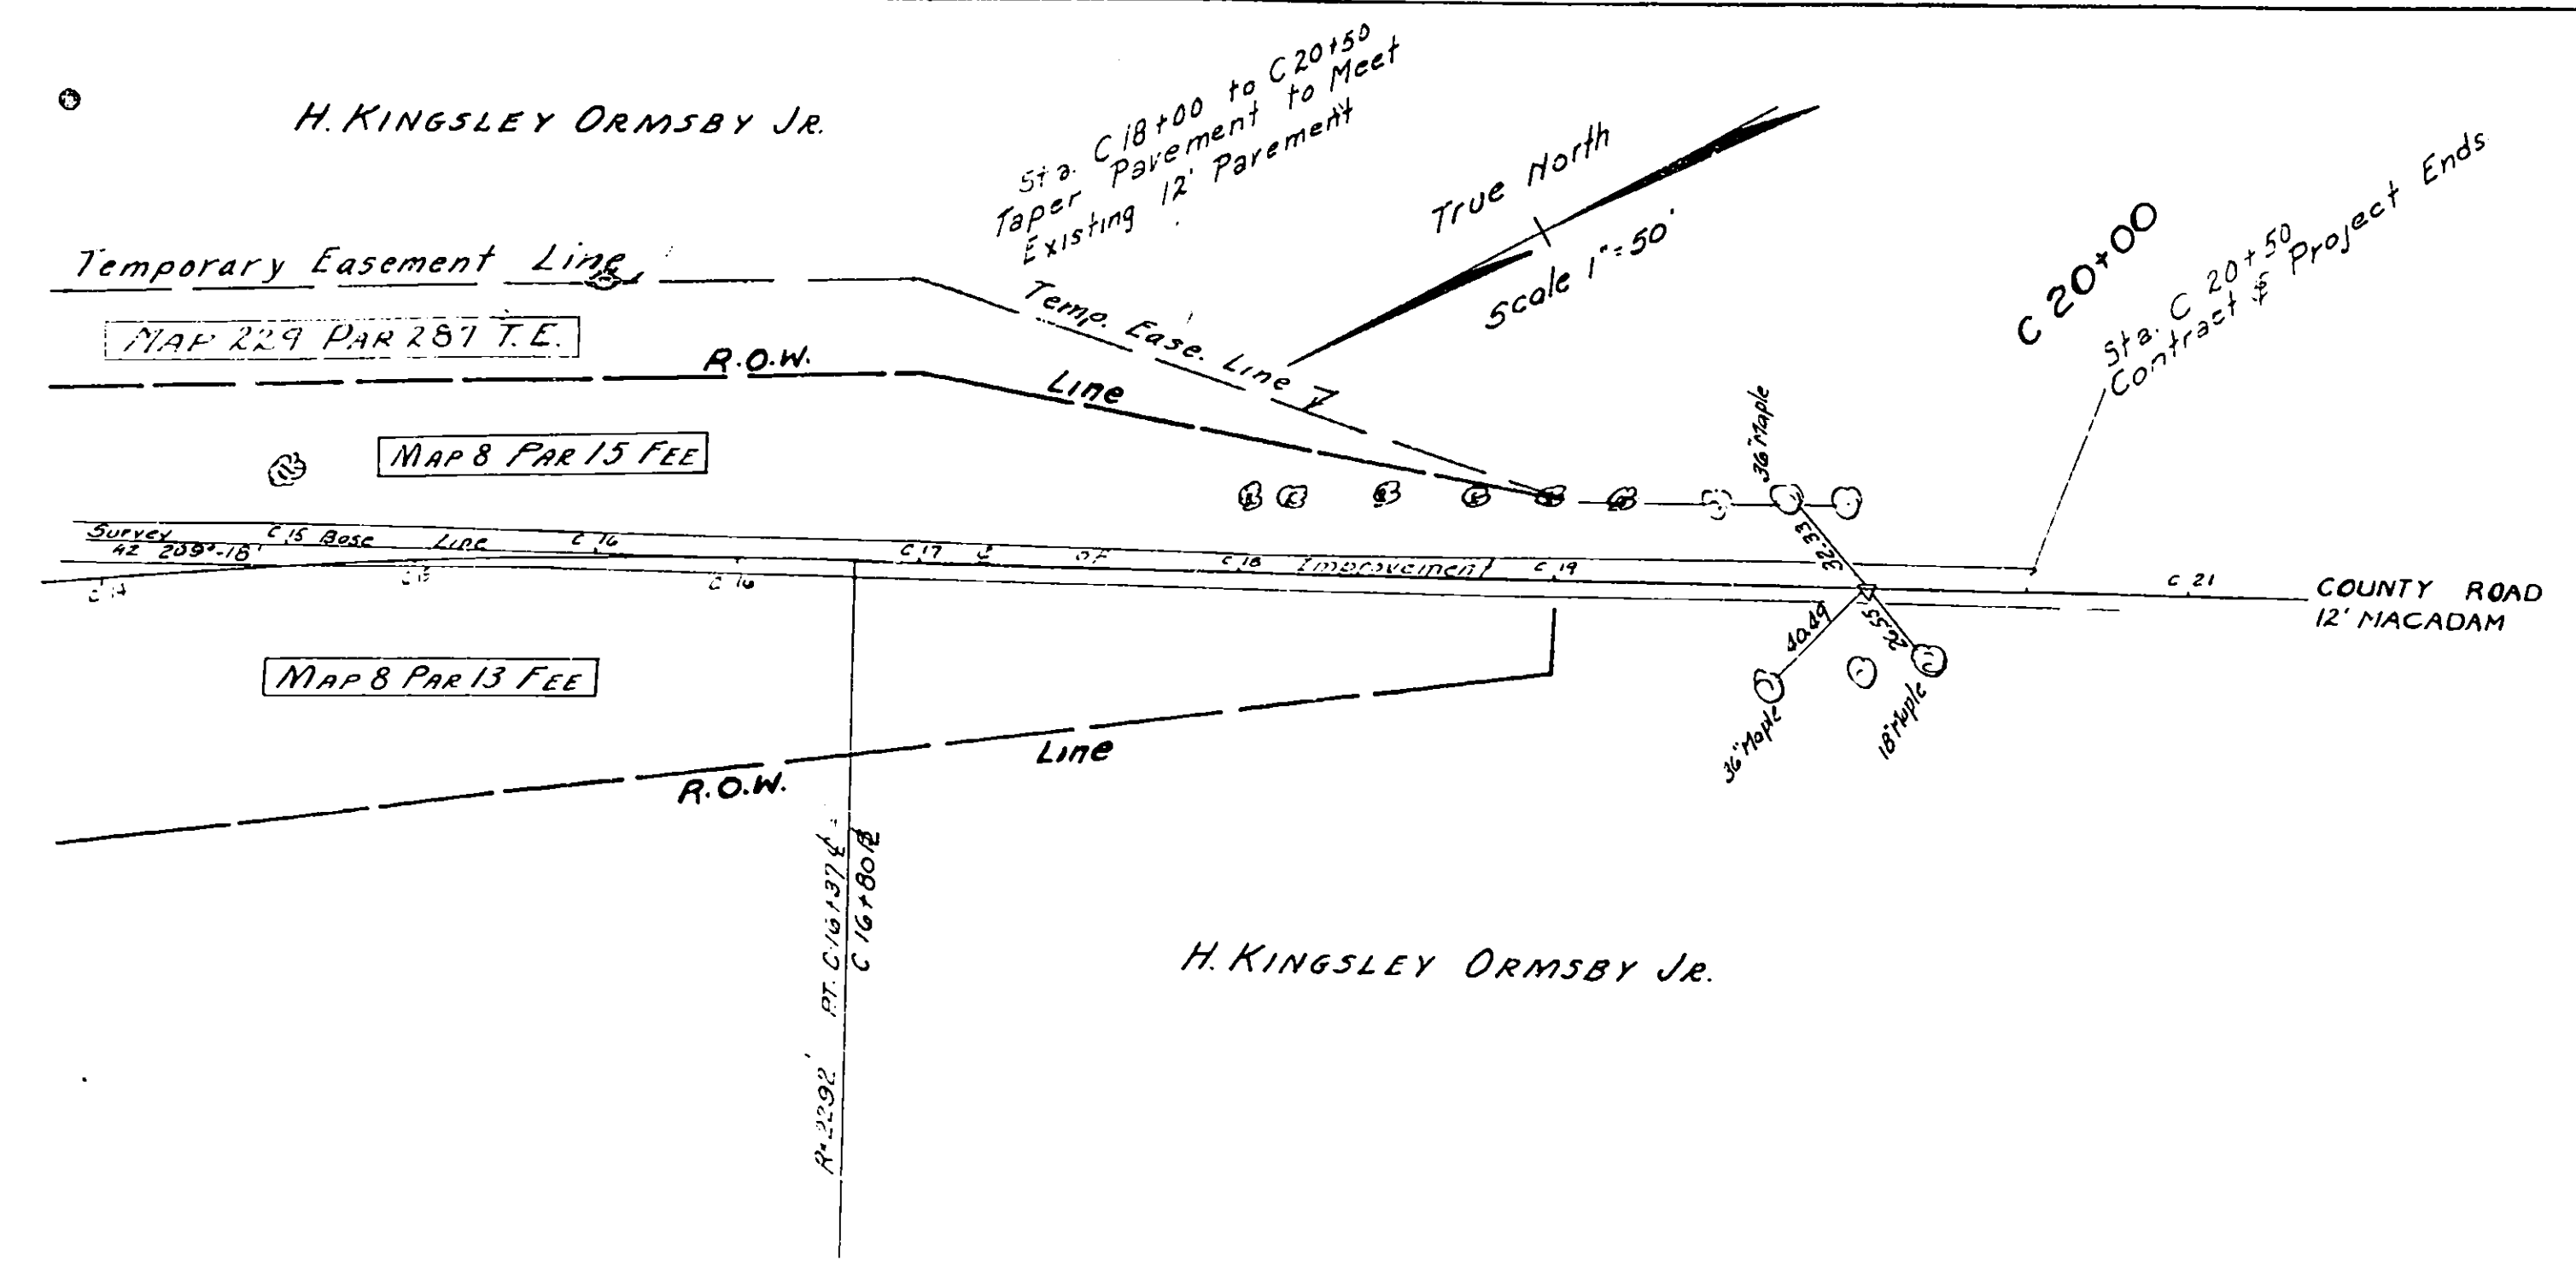



PROFILE SCALES { Horizontal 1"=50'
Vertical 1"=10'

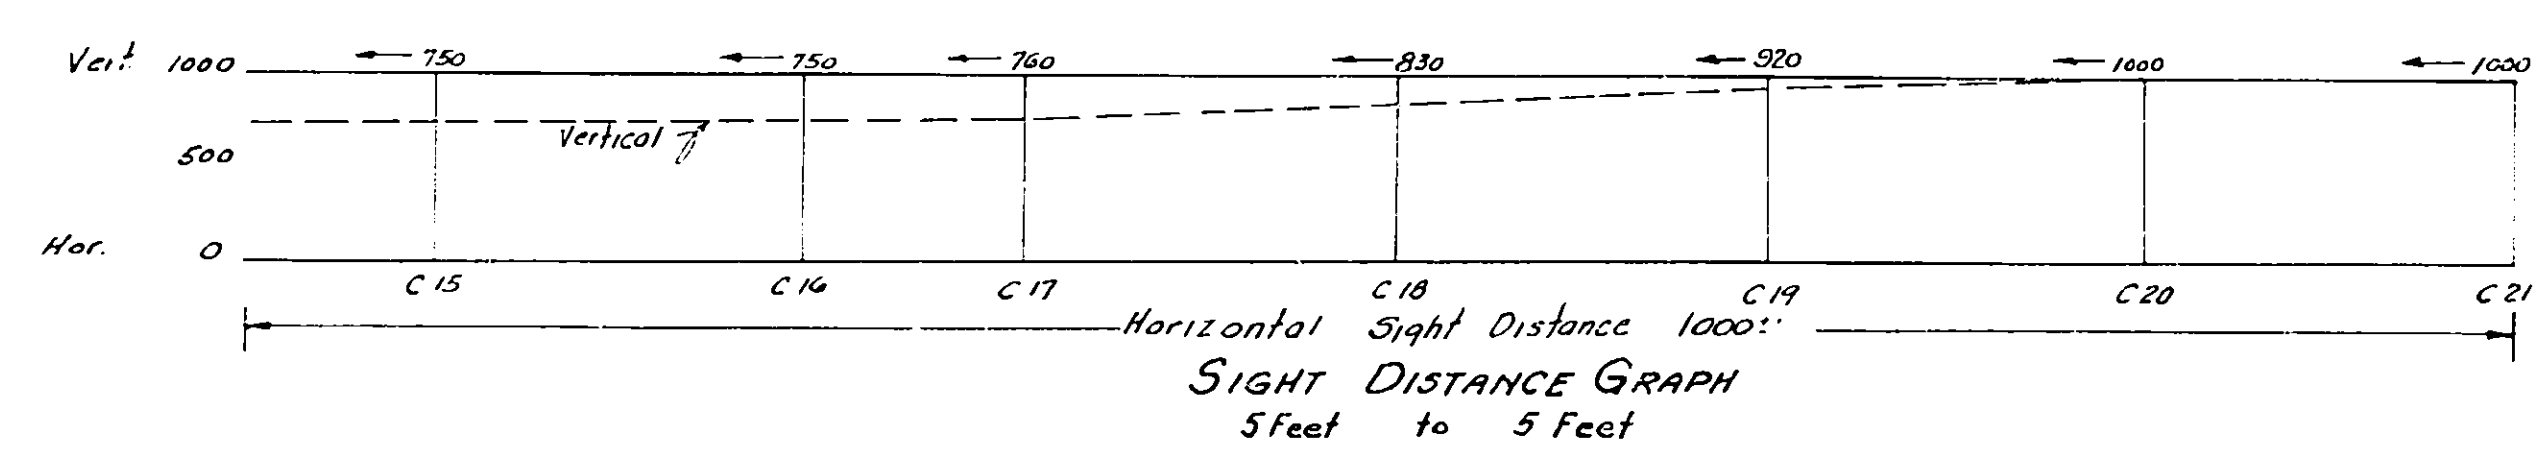


Drawn By: J. J. Dwyer
Traced By: J. J. Dwyer
Checked By: J. J. Dwyer

Prepared pursuant to the Highway Law & Recommended By: J. J. Dwyer
Date: _____ Engineer's Dist. No. 2

Fed Rd Dir. No.	State	Fed Aid Proj. No.	County	Sheet No.	Total Sheets
	N.Y.		Madison	12	67
Mohawk Thruway - North Manlius - North Chittenango Pine Plains Kirkville Co.R.					

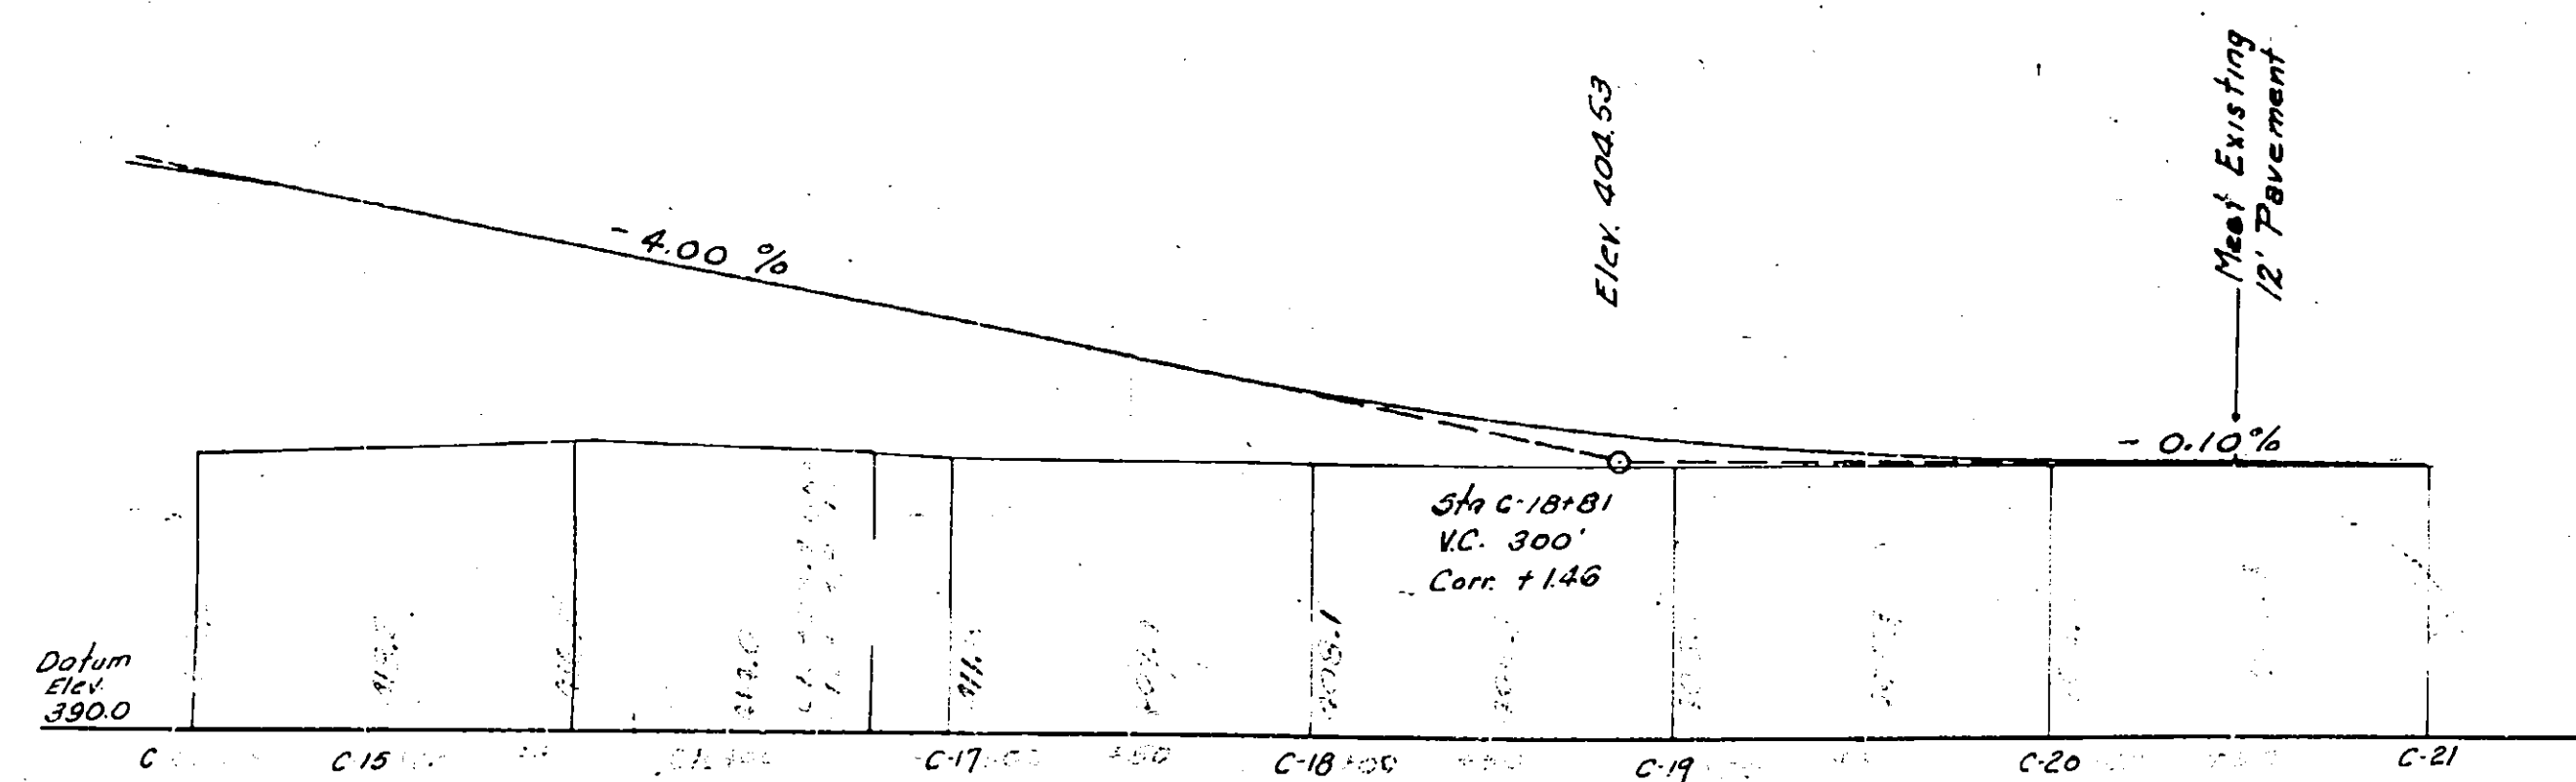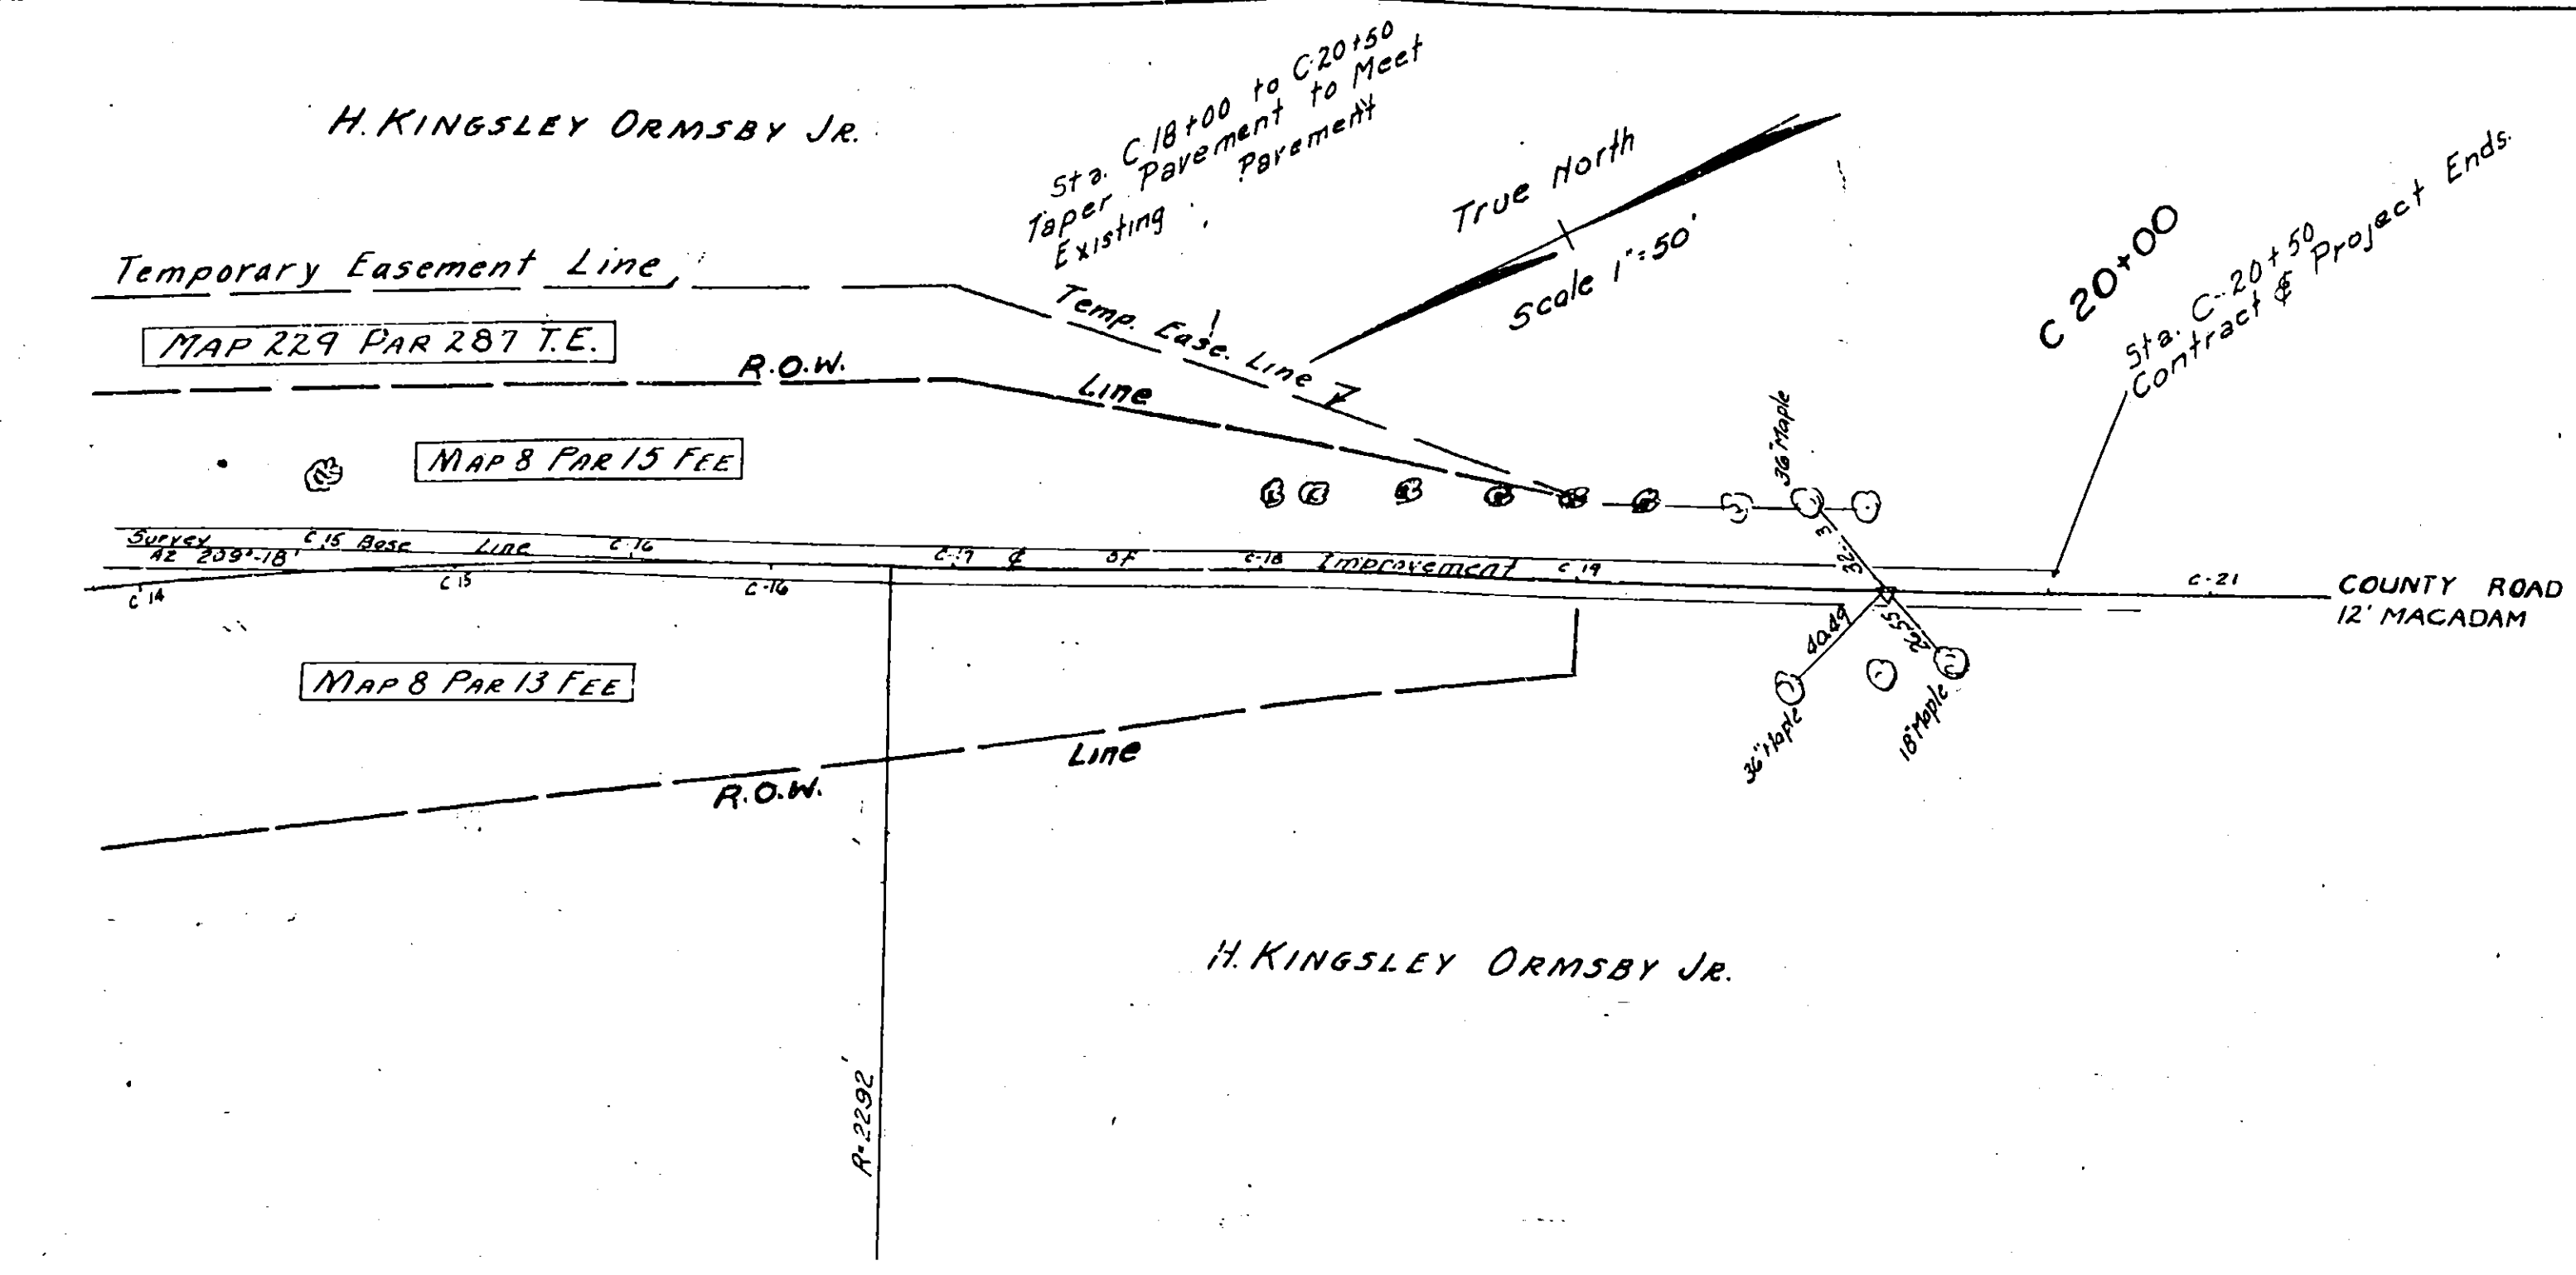

PROFILE SCALES { Horizontal 1"=50'
Vertical 1"=10'

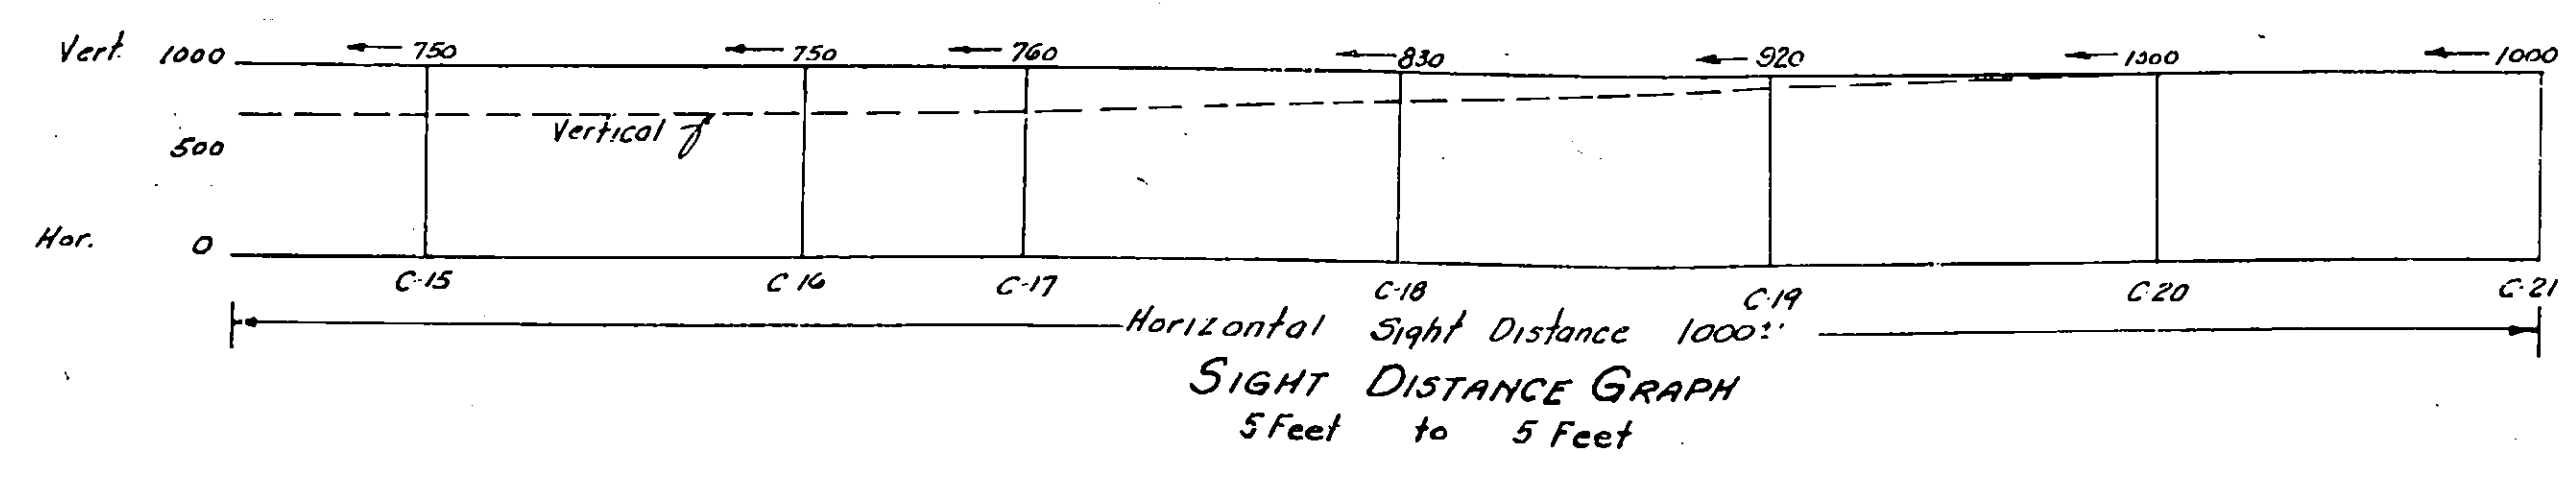

SIGHT DISTANCE GRAPH
5 feet to 5 feet

Made By J. J. Dwyer Traced By J. J. Dwyer Checked By J. J. Dwyer
on 1/1/54 file 1/1/54

Prepared pursuant to the Highway Law & Recommended By Ray G. Schuman
Date 1/1/54 Engineer Dist No 2

FYLER SETTLEMENT ROAD
STA. 200+06
ARCHITECTURAL ELEVATION


Wm. Stevz 6/13/50
C.W. Dayton
J. J. - Masi
H. Fields

Note: Item 62 is not in this contract (N.I.C.)
Thickness of overlaying concrete shall be increased $\frac{3}{8}$ "


Immediately before placing pavement concrete, the concrete surface or surfaces upon which it is to be placed shall be thoroughly wetted down continuously for one hour, if the air temperature is above 50°F. Paving to be made under Items 1W and 1WA in highway estimate

Wm. Steeve 6-9-50
 J. E. Kalligan Oct. 47
 J. J. & M. M.
 G. H. Fields
 Steeve 6/9/50


FED. AID DIST. NO.	STATE	FED. AID PROJ. NO.	FISCAL YEAR	SHEET NO.	TOTAL SHEETS
	N.Y.			14	67
FROM MOHAWK THRUWAY TO MADISON COUNTY					

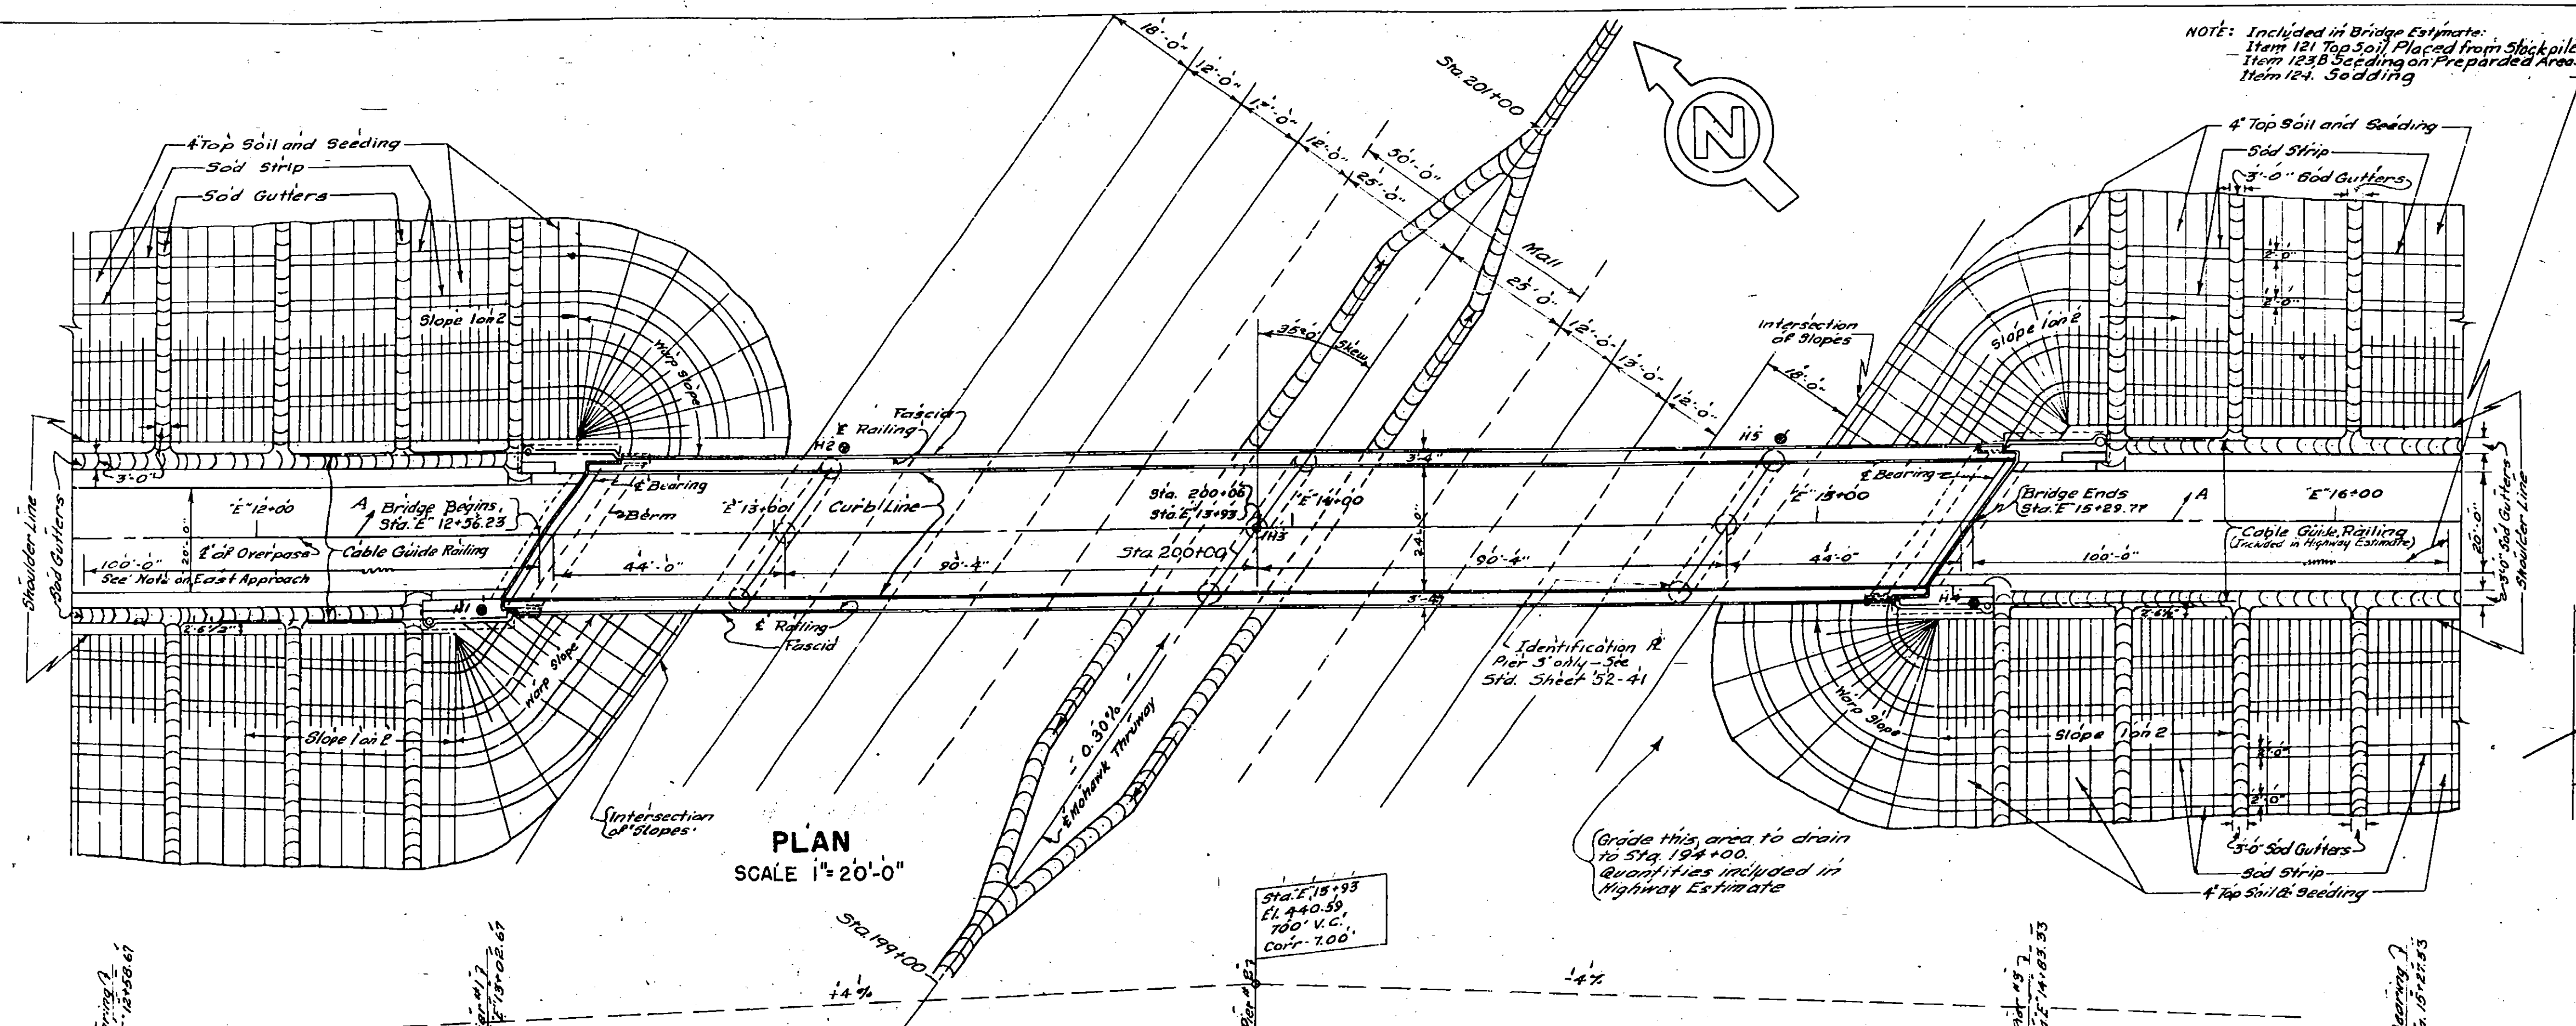


PLAN
SCALE 1"=20'-0"

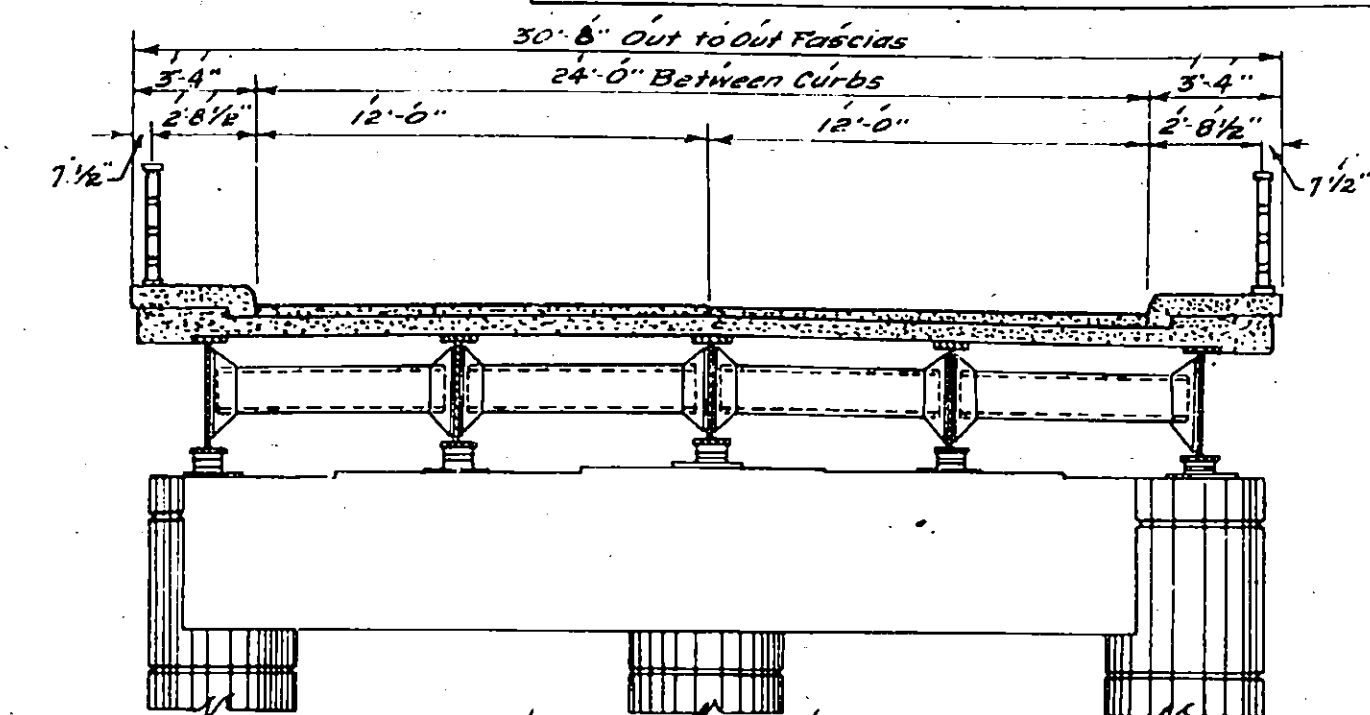

TRANSVERSE SECTION
SCALE 1"=5'-0"

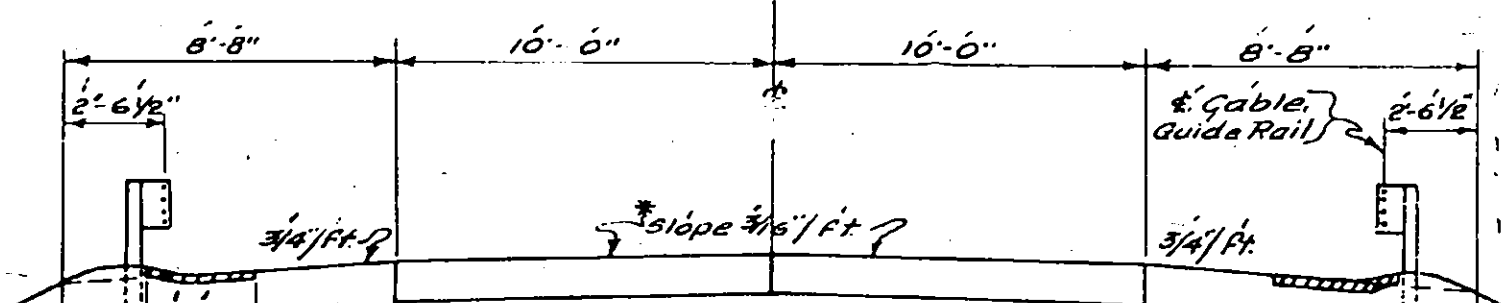


SECTION ADJACENT TO BRIDGE
SCALE 1"=5'-0"

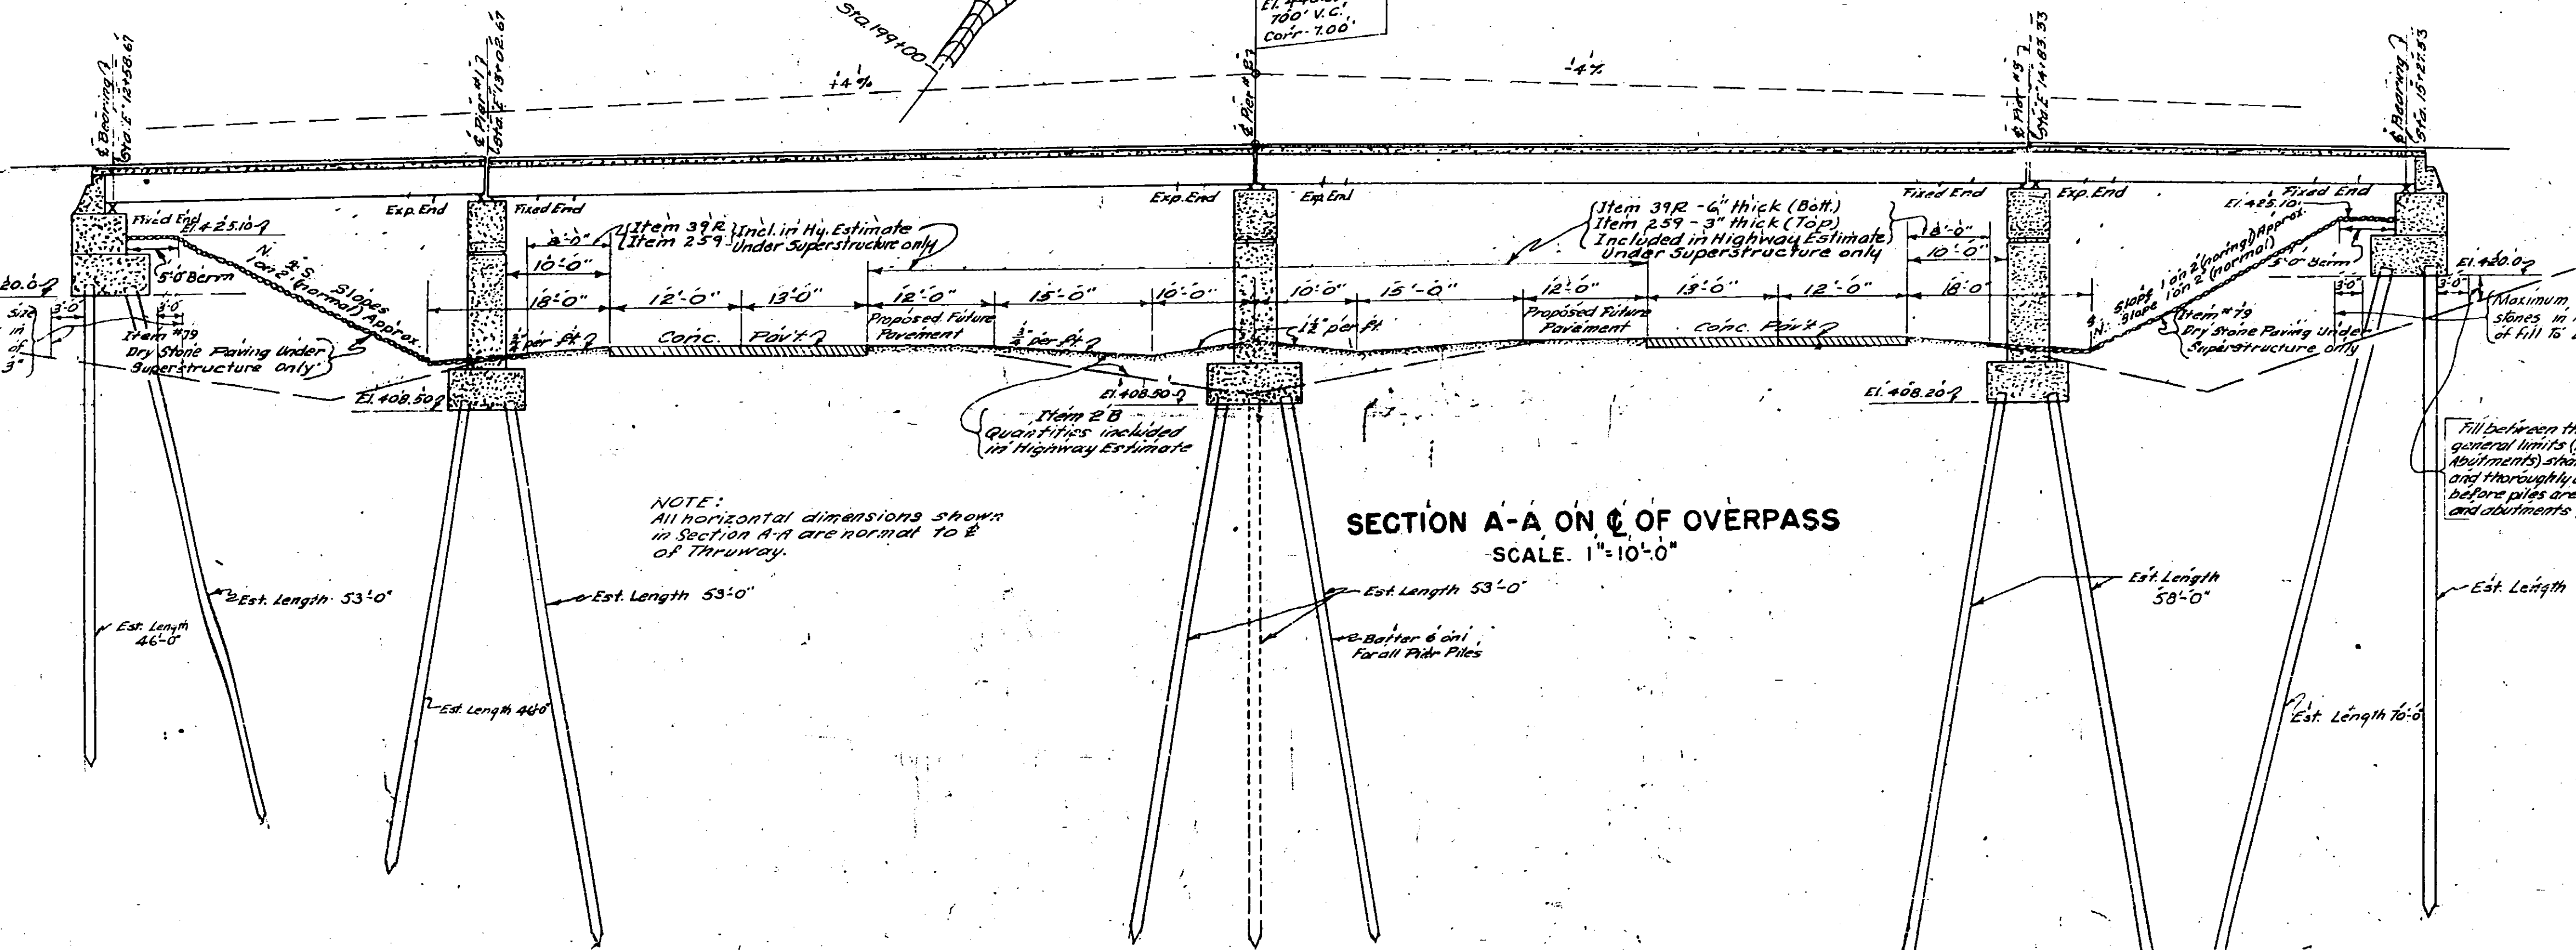

SECTION A-A ON C. OF OVERPASS
SCALE 1"=10'-0"

SUBSTRUCTURE AND SUPERSTRUCTURE			
ITEM NO.	ITEM	UNIT	QUANTITY
5	Trench, Culvert and Bridge Excavation	Cu. Yd.	12.1
15-E	Portland Cement, Type 2	Bbl.	1.2
15-N	Natural Cement, Type N	Bbl.	1.2
18	Class 1A Concrete for Structures (1:2:3 approx.)	Cu. Yd.	1.2
20	Class 1 Concrete (1:2:4 approx.)	Cu. Yd.	1.2
25F	Steel Fabric Reinforcement	Sq. Yd.	1.2
26	Bar Reinforcement for Structures	Lbs.	1.2
28A	Spiral Bar Shear Connectors	Lbs.	1.2
29	Structural Steel	Lbs.	1.2
37	Metal Roofing	Sq. Ft.	1.2
47B	Cement Concrete Pavement (1:1 1/2:3 1/4 approx.)	Cu. Yd.	1.2
79	Dry Stone Paving	Sq. Yd.	1.2
85C	Cast-in-Place Concrete Piles	Lbs.	1.2
87	Furnishing Equipment for Driving Piles	L.S.	1.2
121	Top Soil Placed from Stockpiles	Cu. Yd.	1.2
123B	Seeding on Prepared Areas	Acres	1.2
124	Seeding	Sq. Yd.	1.2

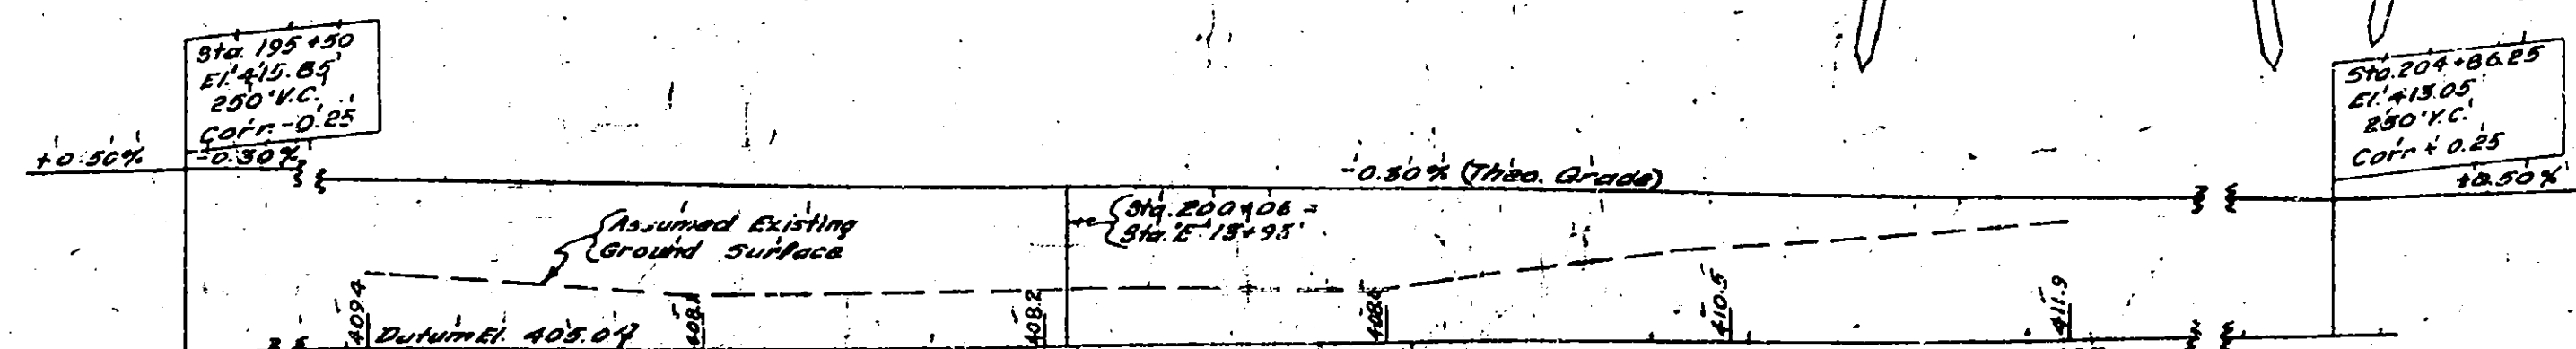


PROFILE OF THRUWAY
SCALE 1"=50'-0" HOR.
1"=10'-0" VERT.


FYLER SETTLEMENT ROAD BRIDGE
STA. 200 +06
PLAN & PROFILE

W. H. Sullivan, 6-9-50
S. H. Sullivan, Oct. 47
G. H. Fields
Sullivan 6/9/50


FED. AID DIST. NO.	STATE	FED. AID PROJ. NO.	FISCAL YEAR	SHEET NO.	TOTAL SHEETS
	N.Y.			15	67
FROM MOHAWK THRUWAY TO MADISON COUNTY					

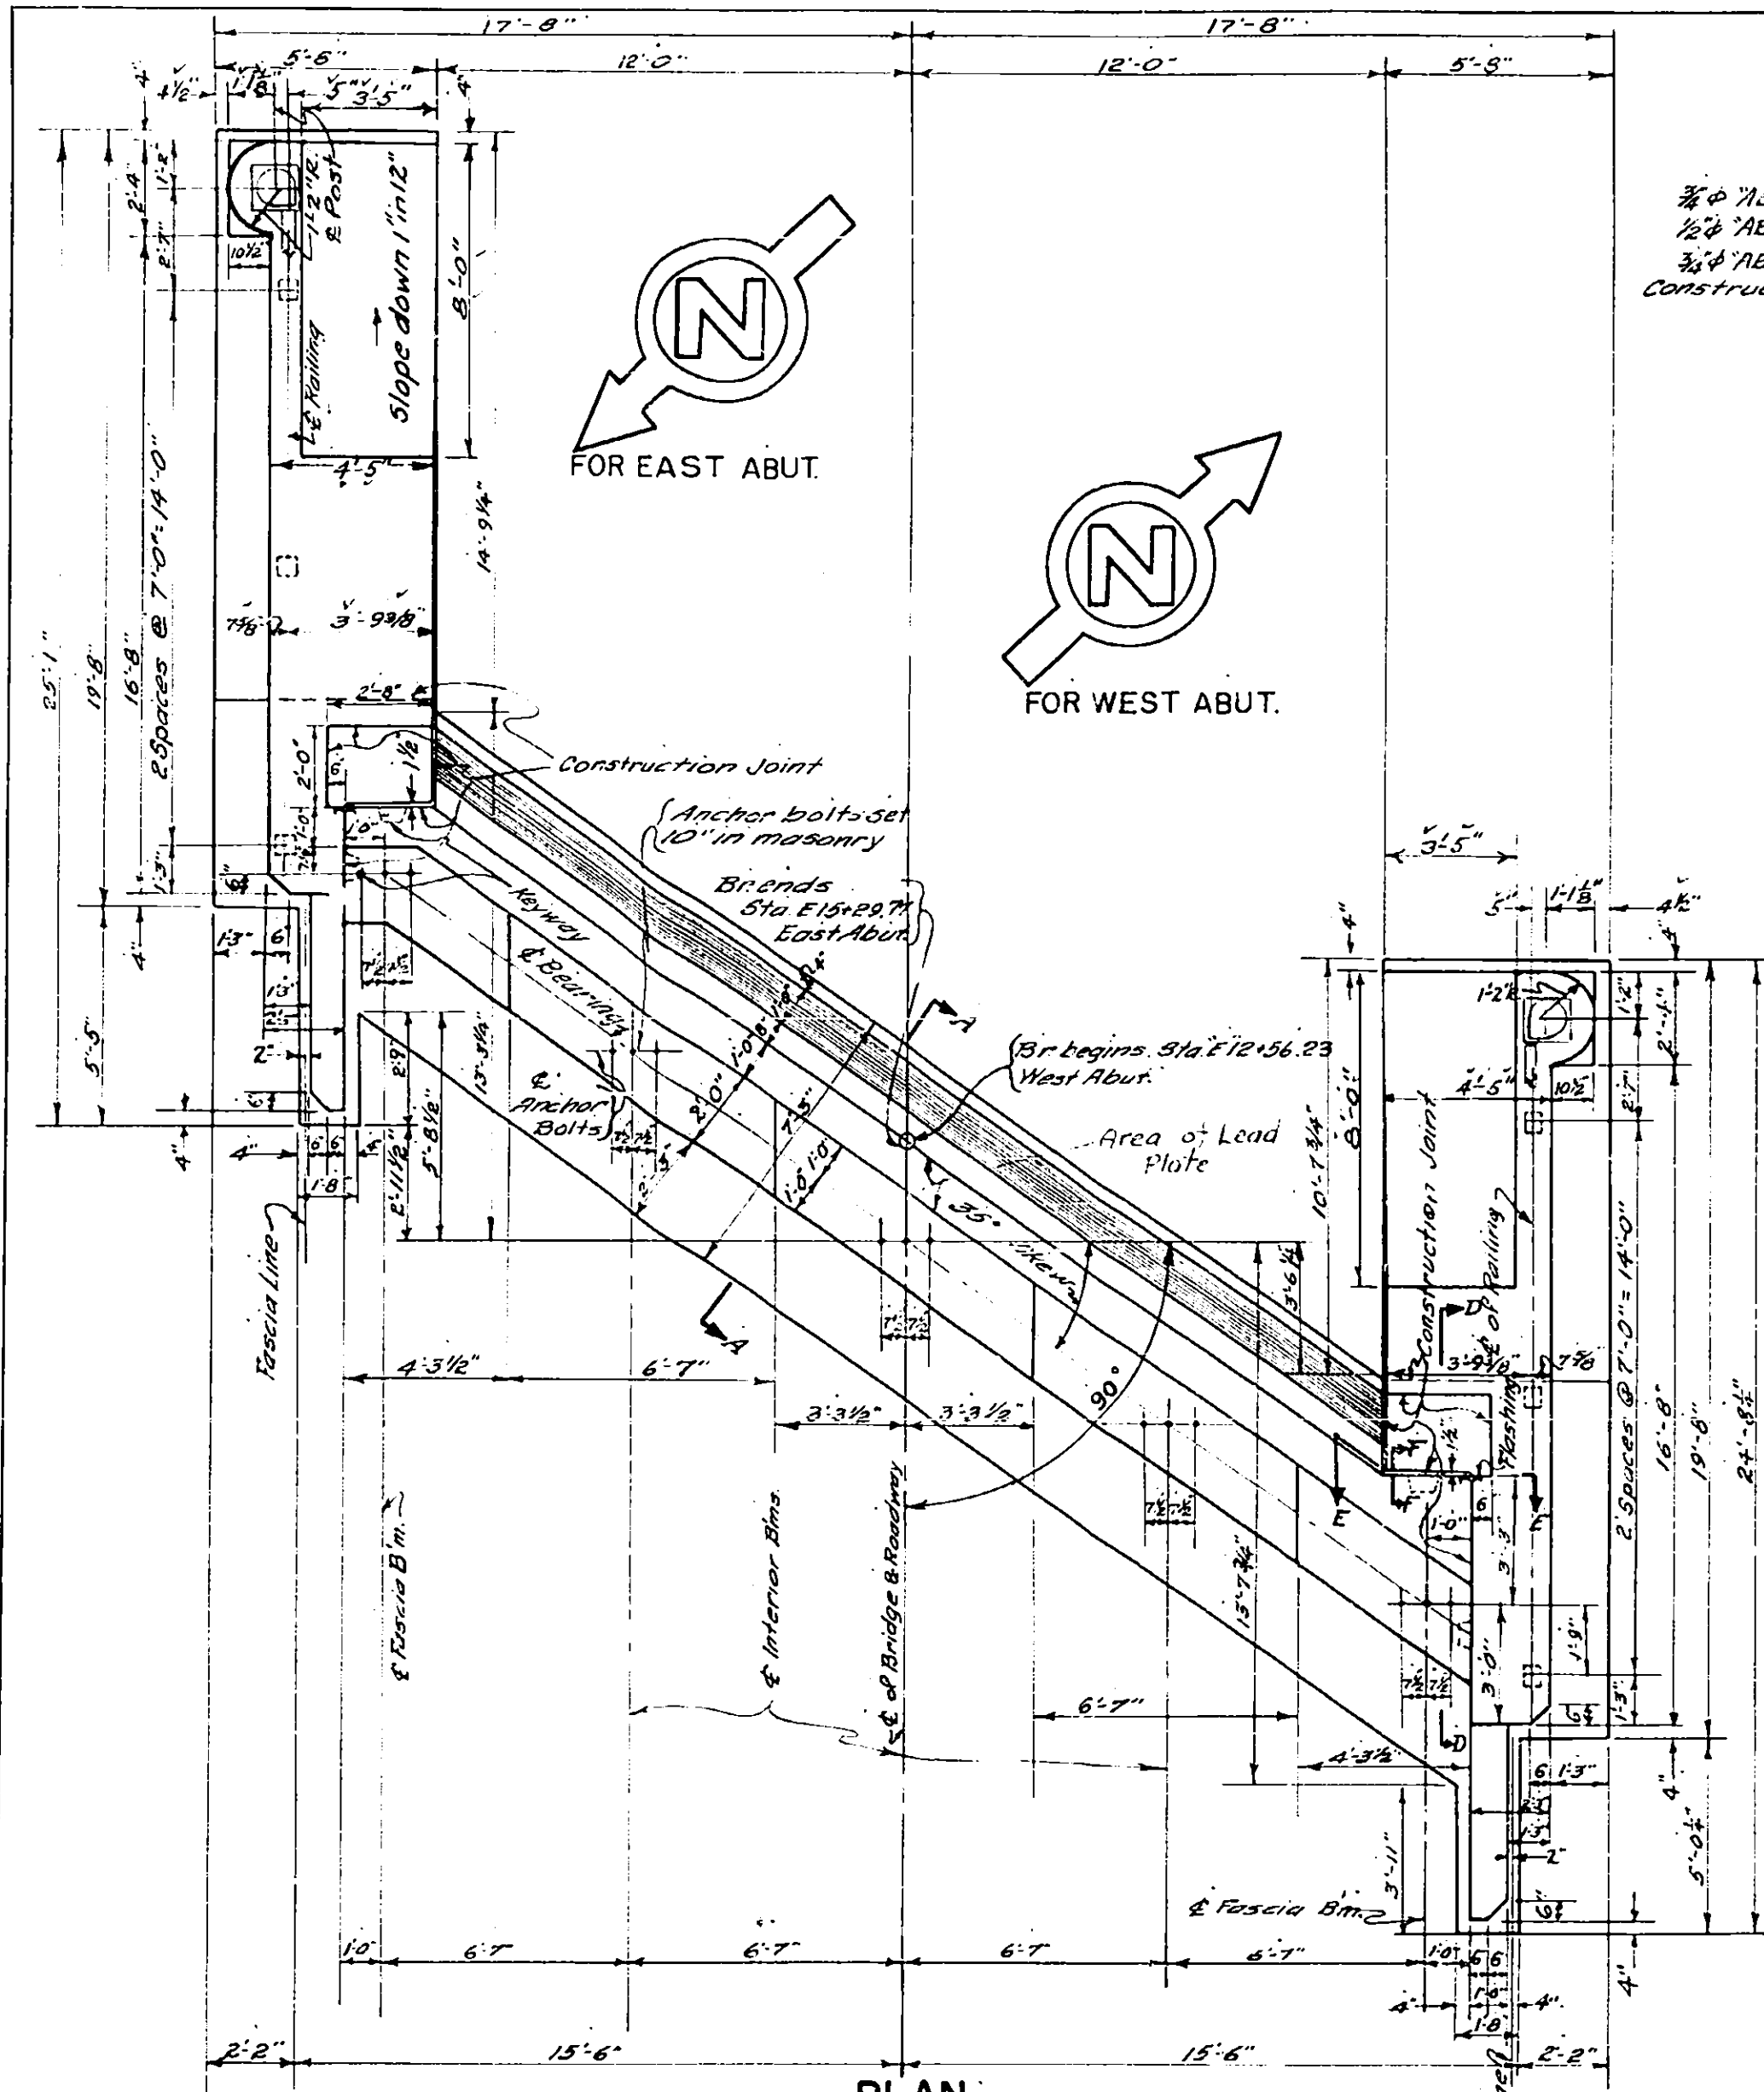


PLAN
SCALE: 1/4" = 1'-0"

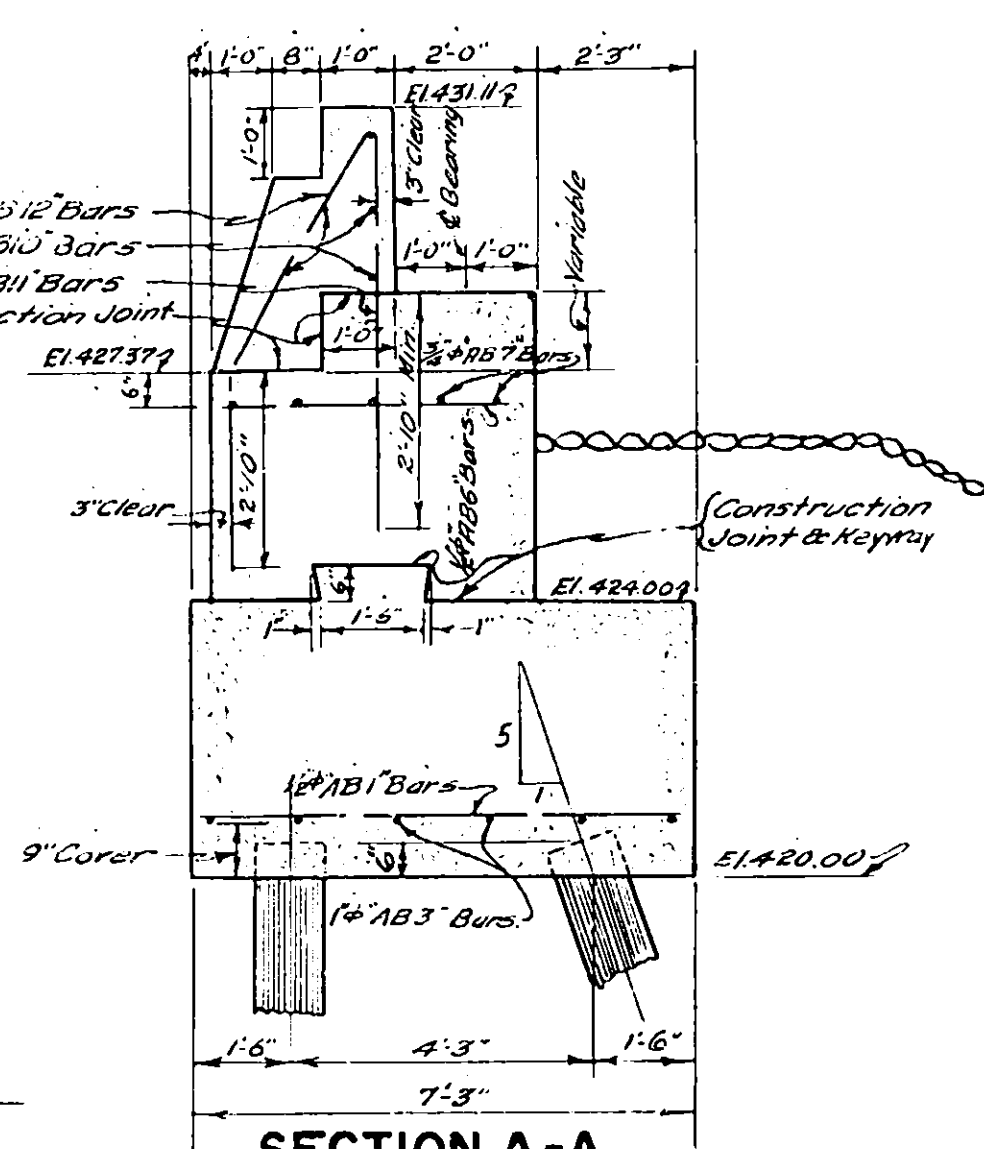

SECTION A-A
SCALE: 3/8" = 1'-0"

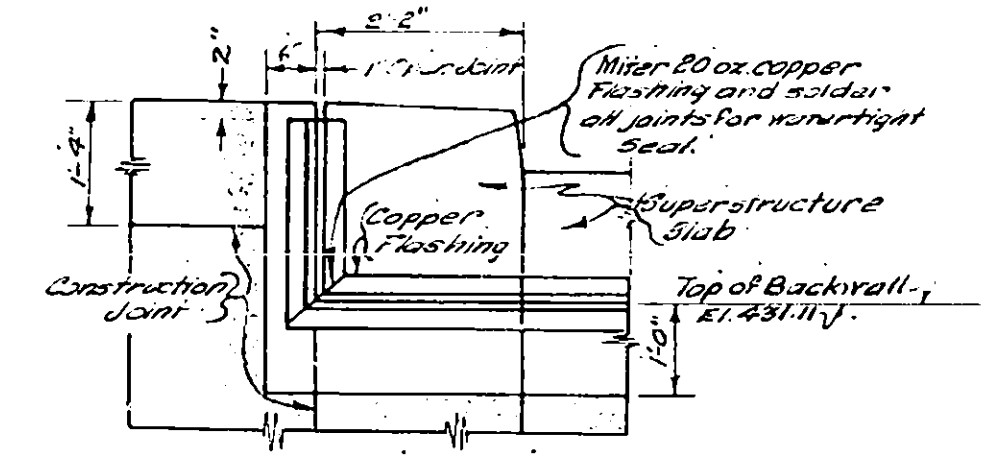


SECTION E-E
SCALE: 1/2" = 1'-0"

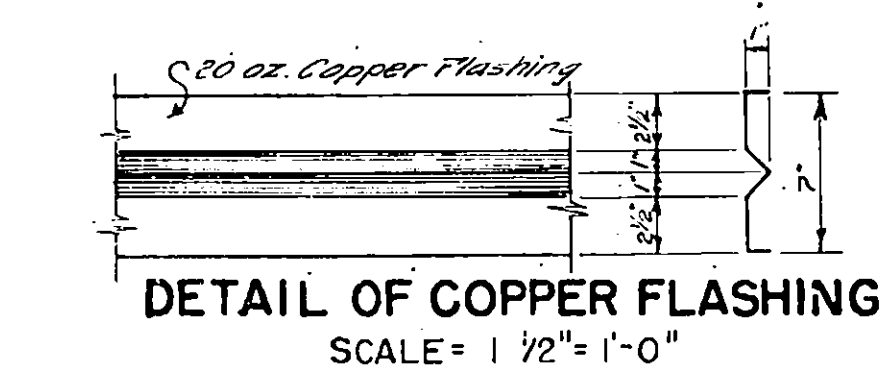


DETAIL OF COPPER FLASHING
SCALE: 1/2" = 1'-0"

BAR LIST ABUTMENTS ONLY				
MARK	SIZE	NO.	LGTH.	LOCATION & DESCRIPTION
AB1	1/2"	34	6'-9"	Straight transverse bars in footings at abutments.
AB2	1/2"	40	5'-2"	Straight transverse bars in footings at wingwalls.
AB3	1/2"	12	37'-8"	Straight longitudinal bars in footings at wingwalls.
AB4	1"	8	24'-2"	Straight longitudinal bars in footings at abutments.
AB5	1"	8	19'-2"	Straight longitudinal bars in footings at wingwalls.
AB6	1/2"	22	4'-2"	Straight transverse bars in abutments under bridge seat.
AB7	1/2"	10	38'-10"	Straight longitudinal bars in abutments under bridge seat.
AB8	3/4"	24	9'-7"	Straight vertical bars in curtain walls.
AB9	40	7'-7"		Straight horizontal bars in curtain walls.
AB10	1/2"	10	30'-0"	Straight longitudinal bars in backwalls.
AB11	3/4"	22	5'-10"	Straight vertical bars in front face of backwalls.
AB12	20	6'-11"		Bent vertical bars in rear face of abutment backwalls.

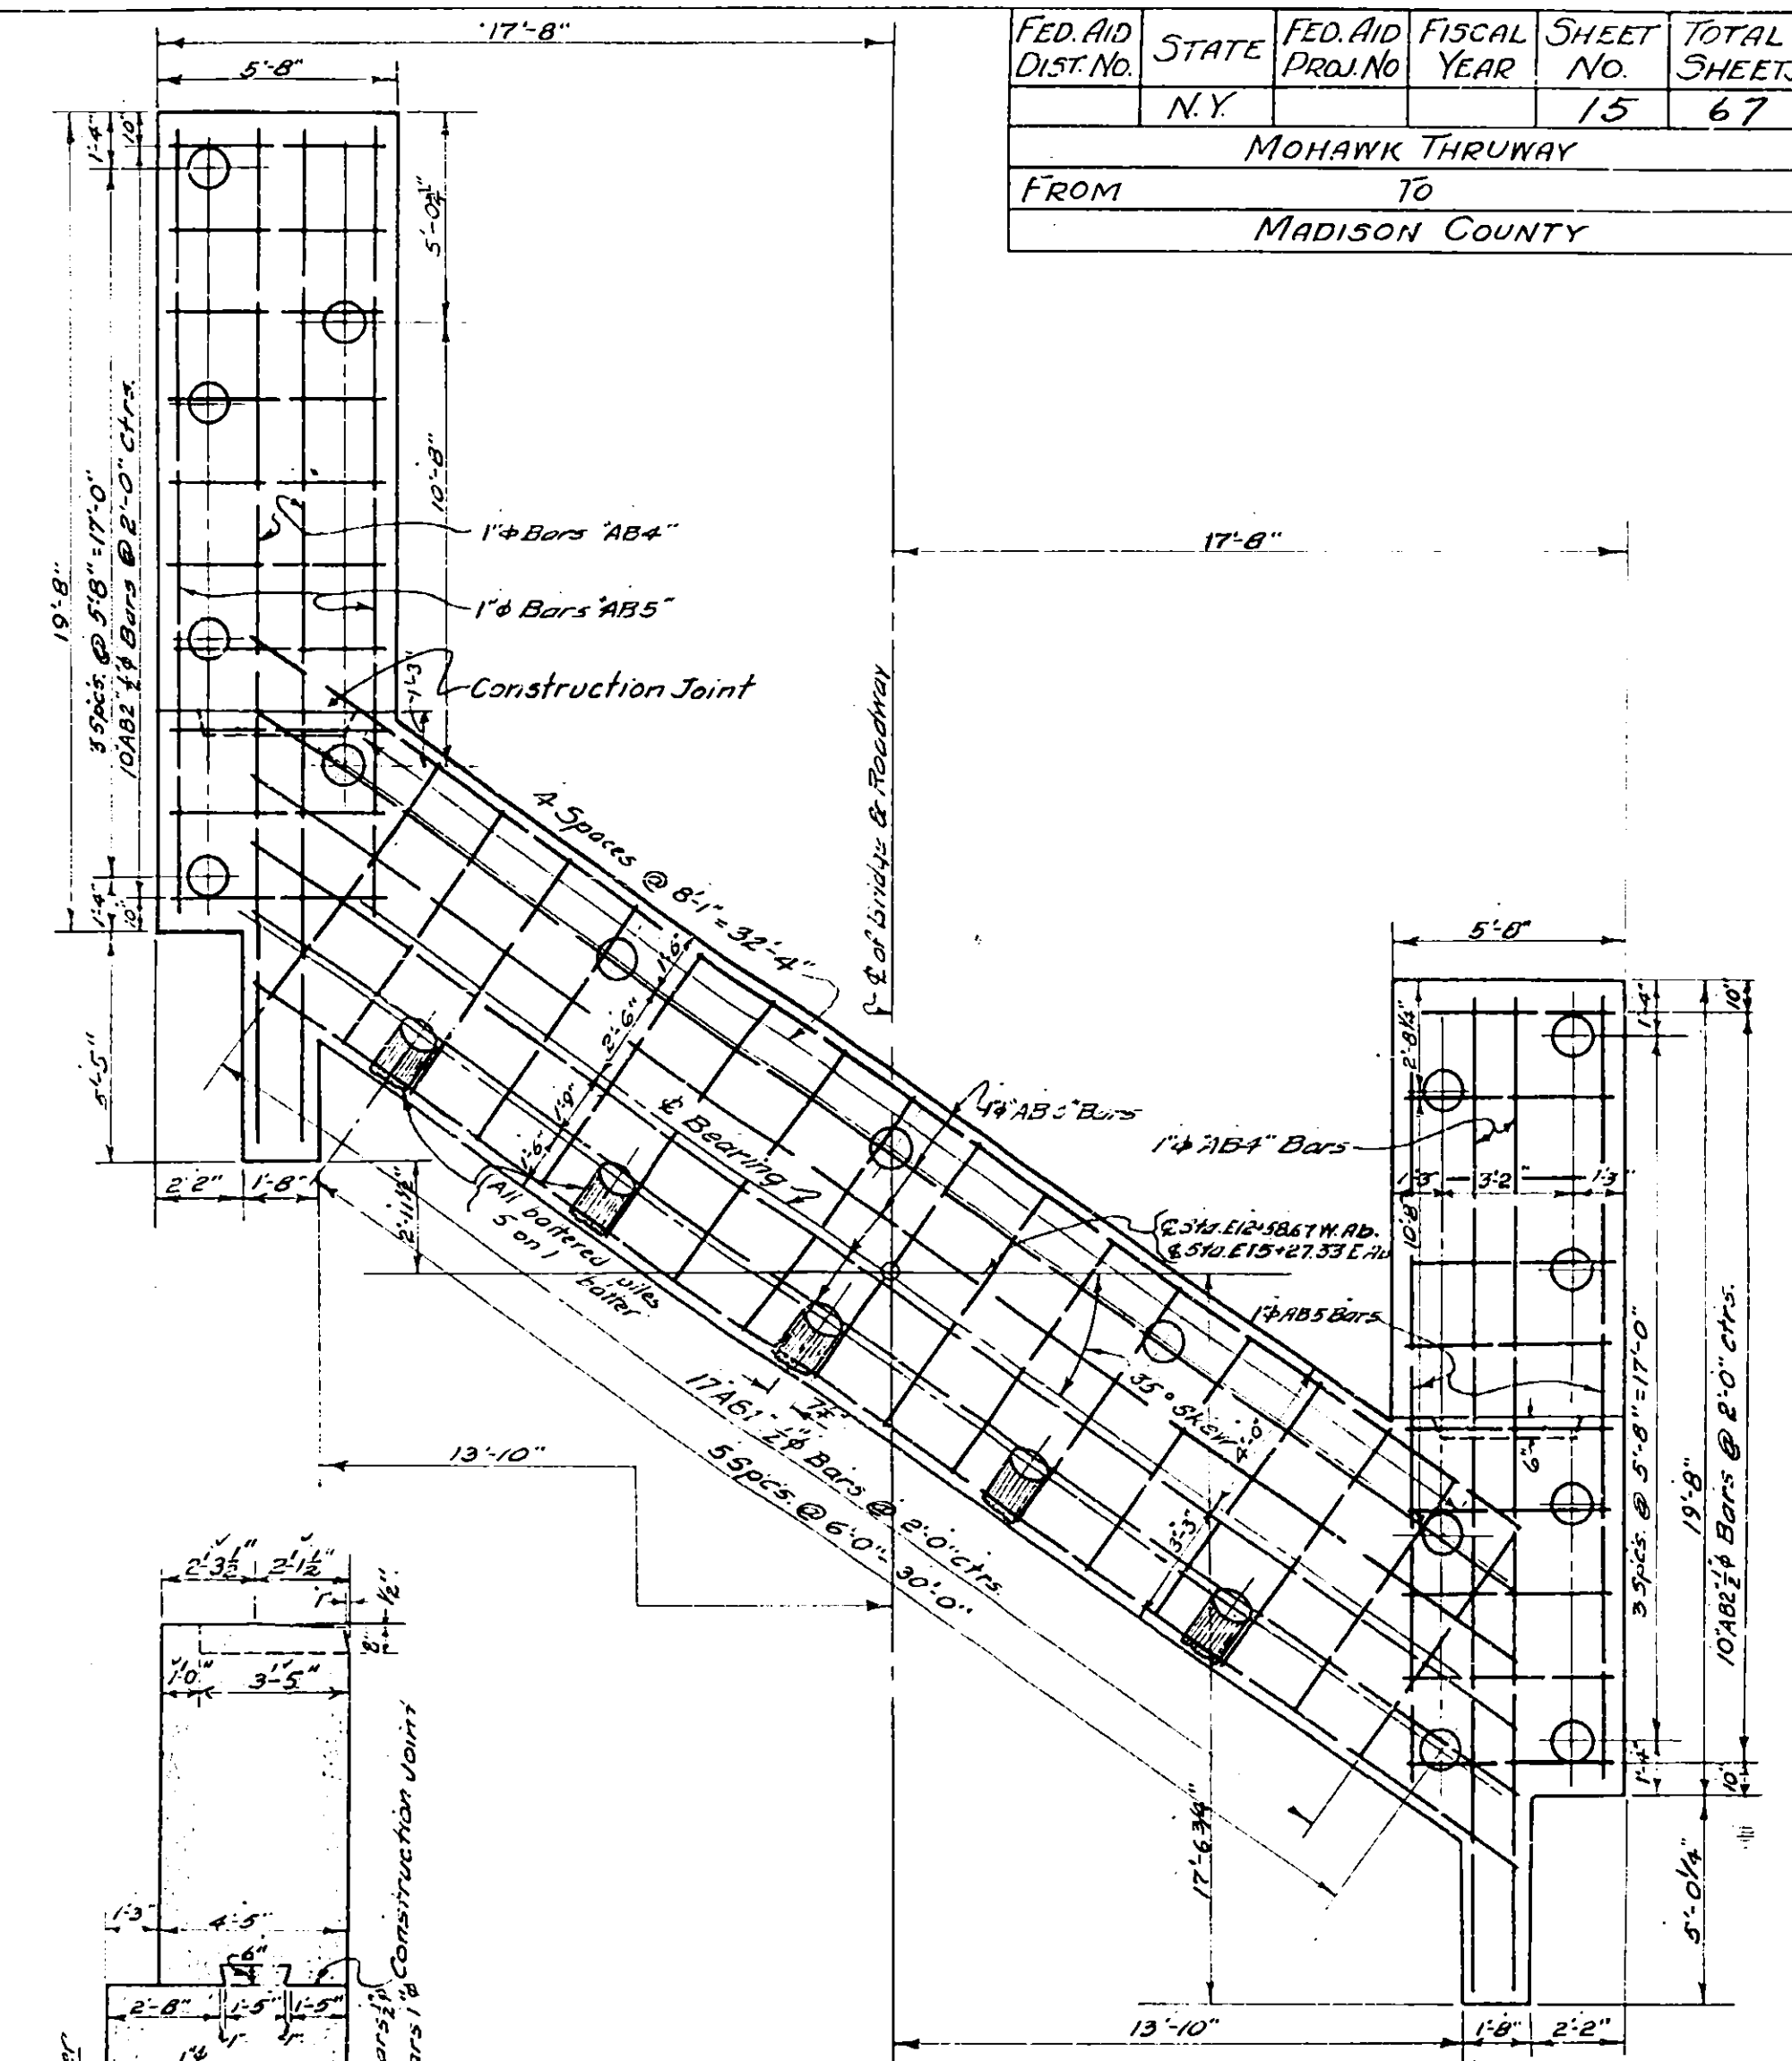


LAYOUT OF PILES AND BAR REINFORCEMENT IN FOOTINGS
SCALE: 1/4" = 1'-0"


NOTE: FOR DETAILS OF C.I.P. CONCRETE PILES & REINFORCEMENT FOR PILES SEE SHEET SHOWING "DETAILS OF PIERS."

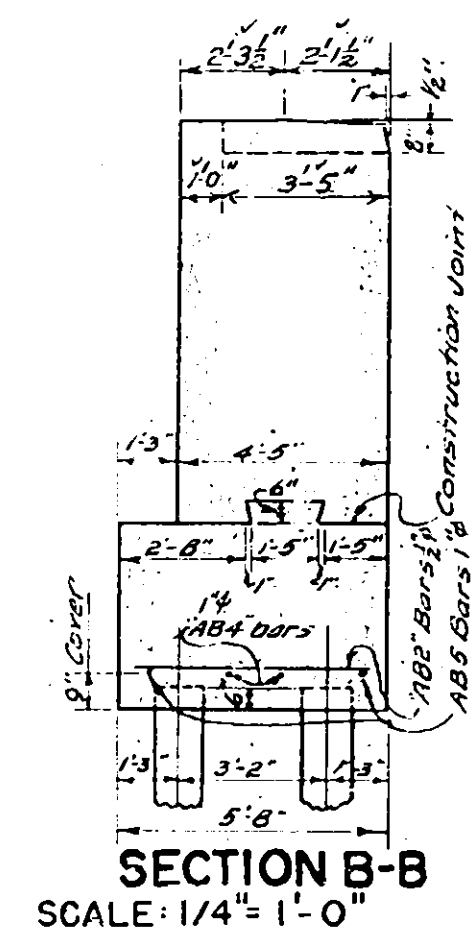


SECTION B-B
SCALE: 1/4" = 1'-0"

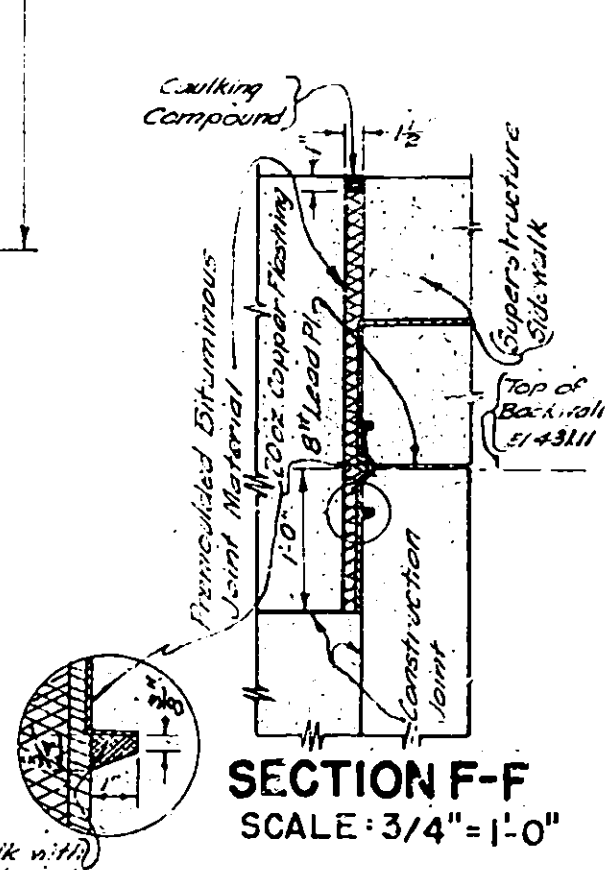


SECTION F-F
SCALE: 3/4" = 1'-0"

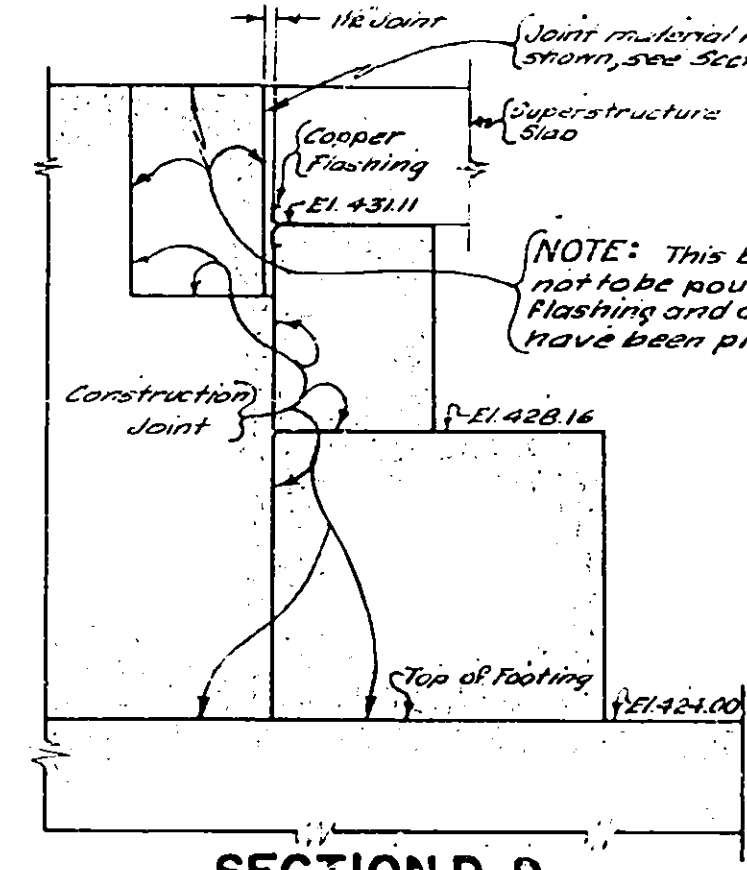


SECTION D-D
SCALE: 3/8" = 1'-0"

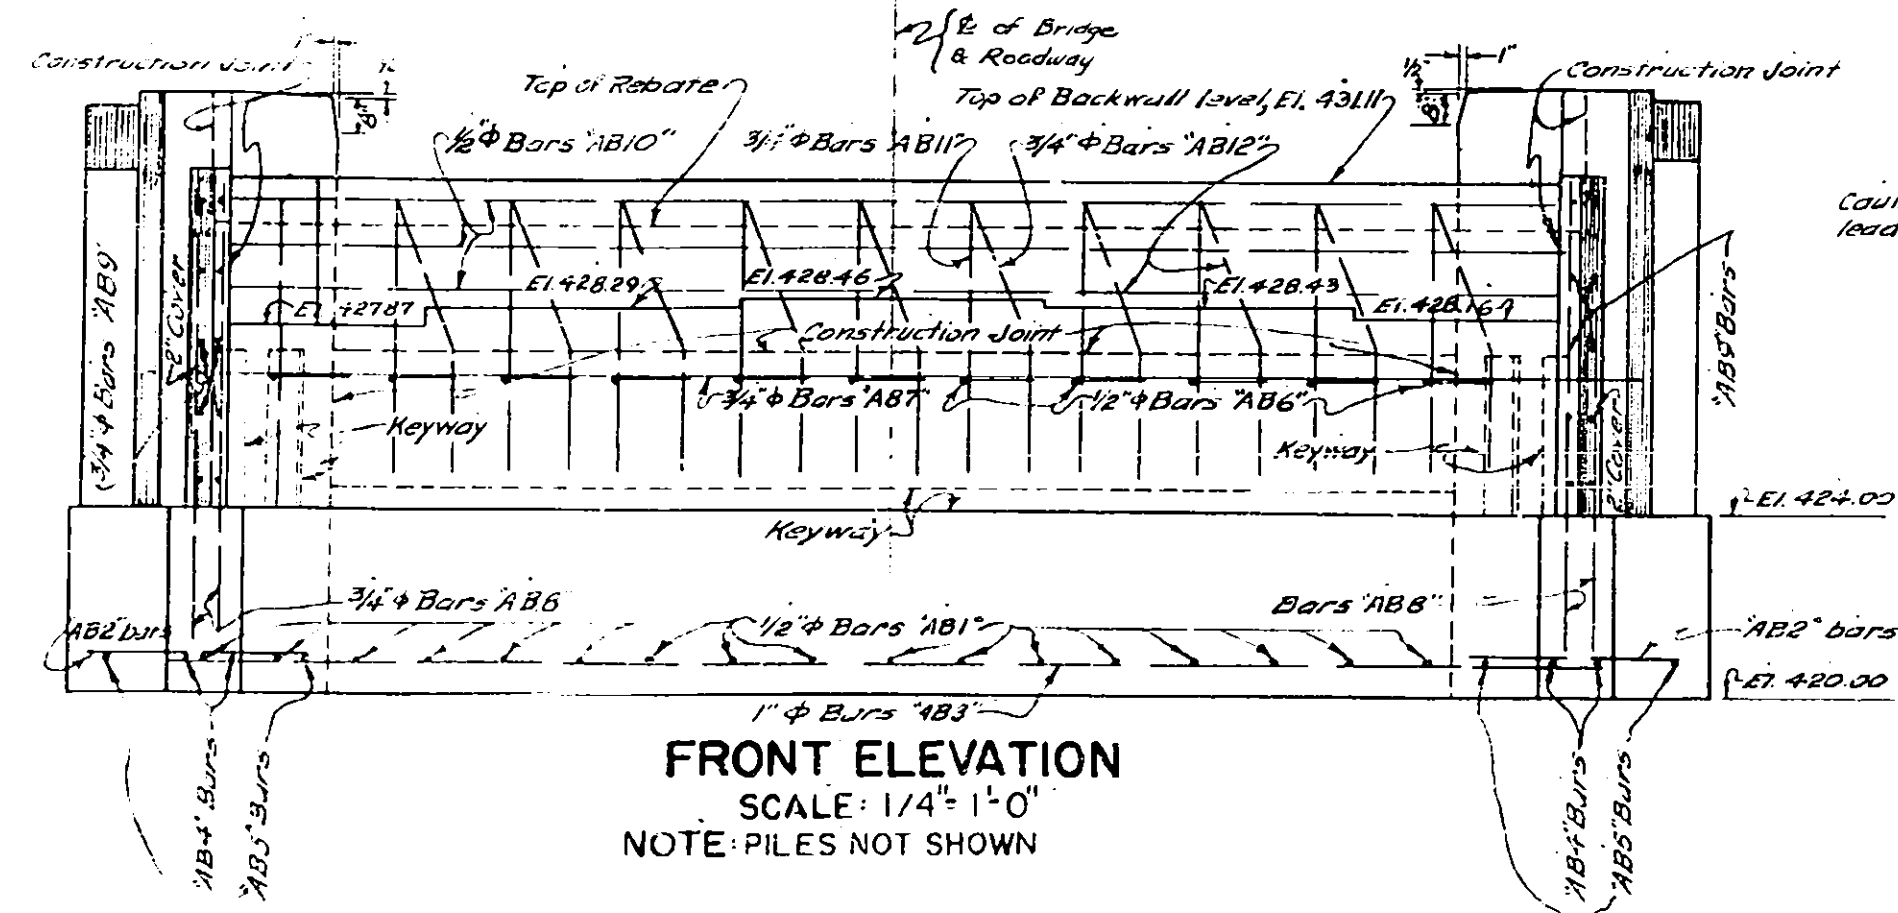

FRONT ELEVATION
SCALE: 1/4" = 1'-0"
NOTE: PILES NOT SHOWN

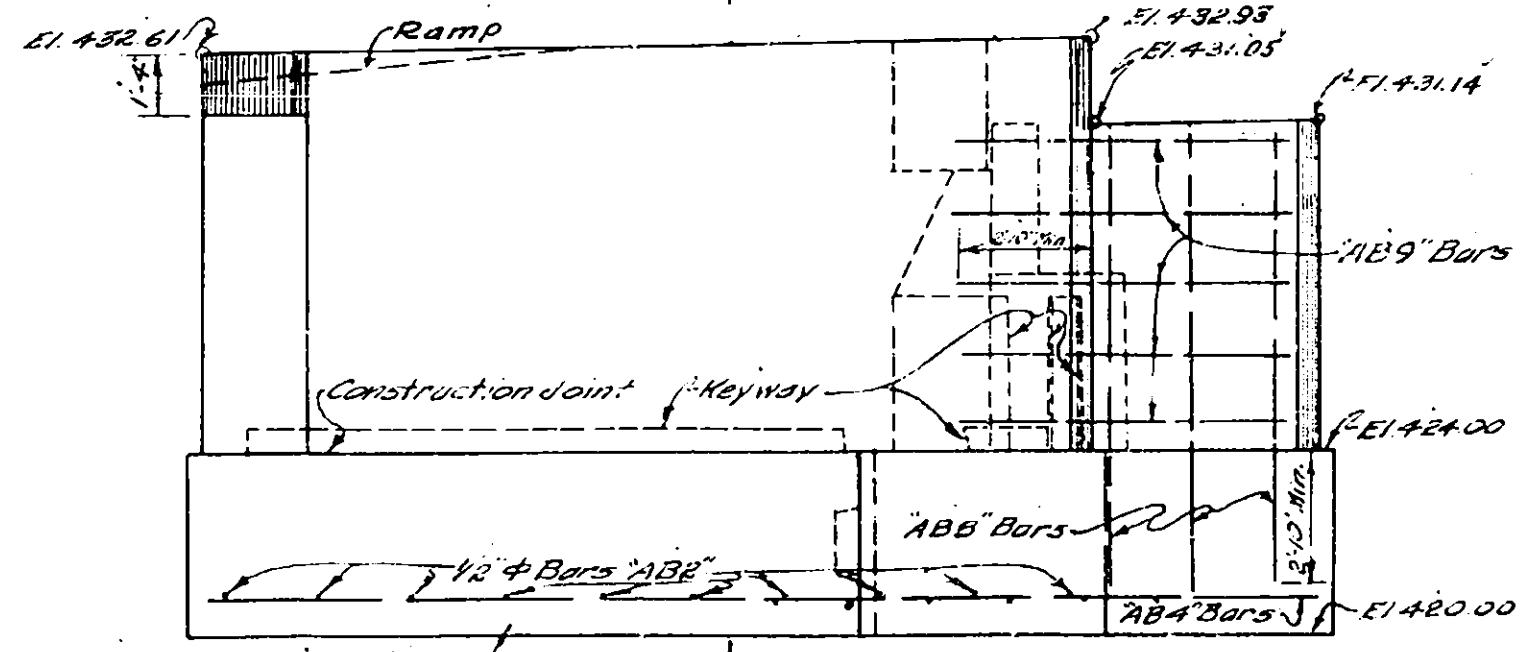

SOUTH SIDE ELEV. WEST ABUT.
NORTH SIDE ELEV. EAST ABUT.
SCALE: 1/4" = 1'-0"


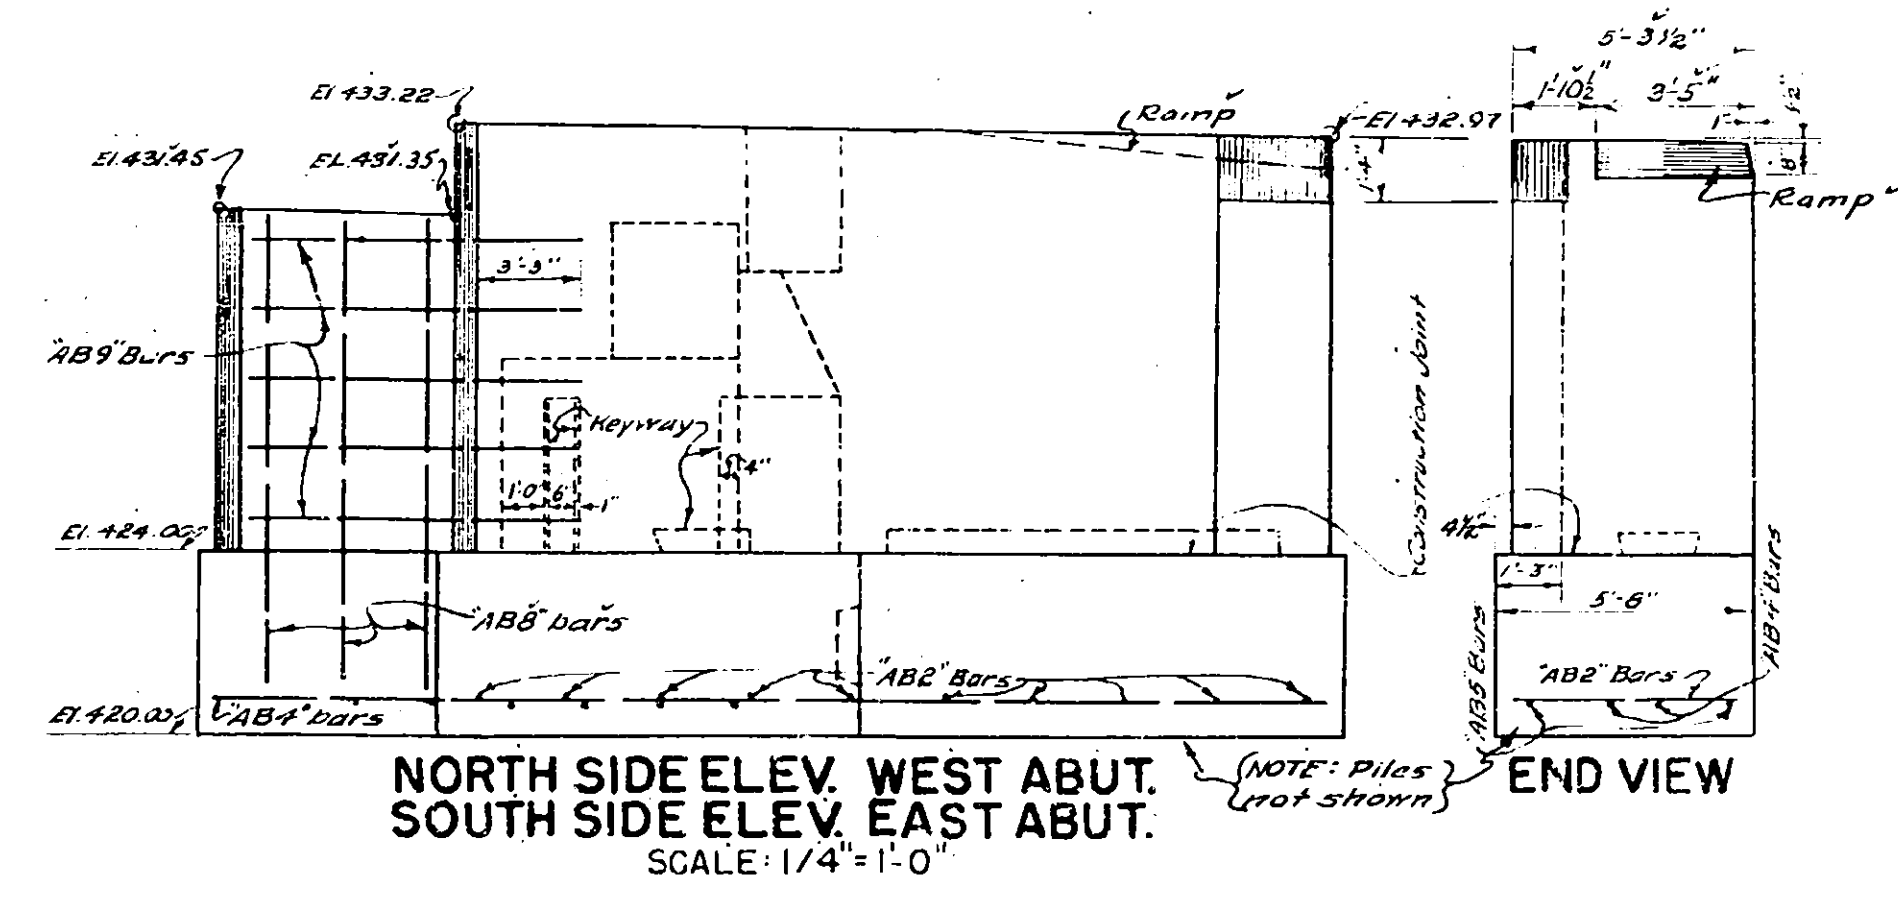


NORTH SIDE ELEV. WEST ABUT.
SOUTH SIDE ELEV. EAST ABUT.
SCALE: 1/4" = 1'-0"


END VIEW

FYLER SETTLEMENT ROAD BRIDGE
STA. 200+06
ABUTMENTS


FED. AID DIST. NO.	STATE	FED. AID PROJ. NO.	FISCAL YEAR	SHEET NO.	TOTAL SHEETS
	N.Y.			16	67
MOHAWK THRUWAY					
FROM TO					
MADISON COUNTY					

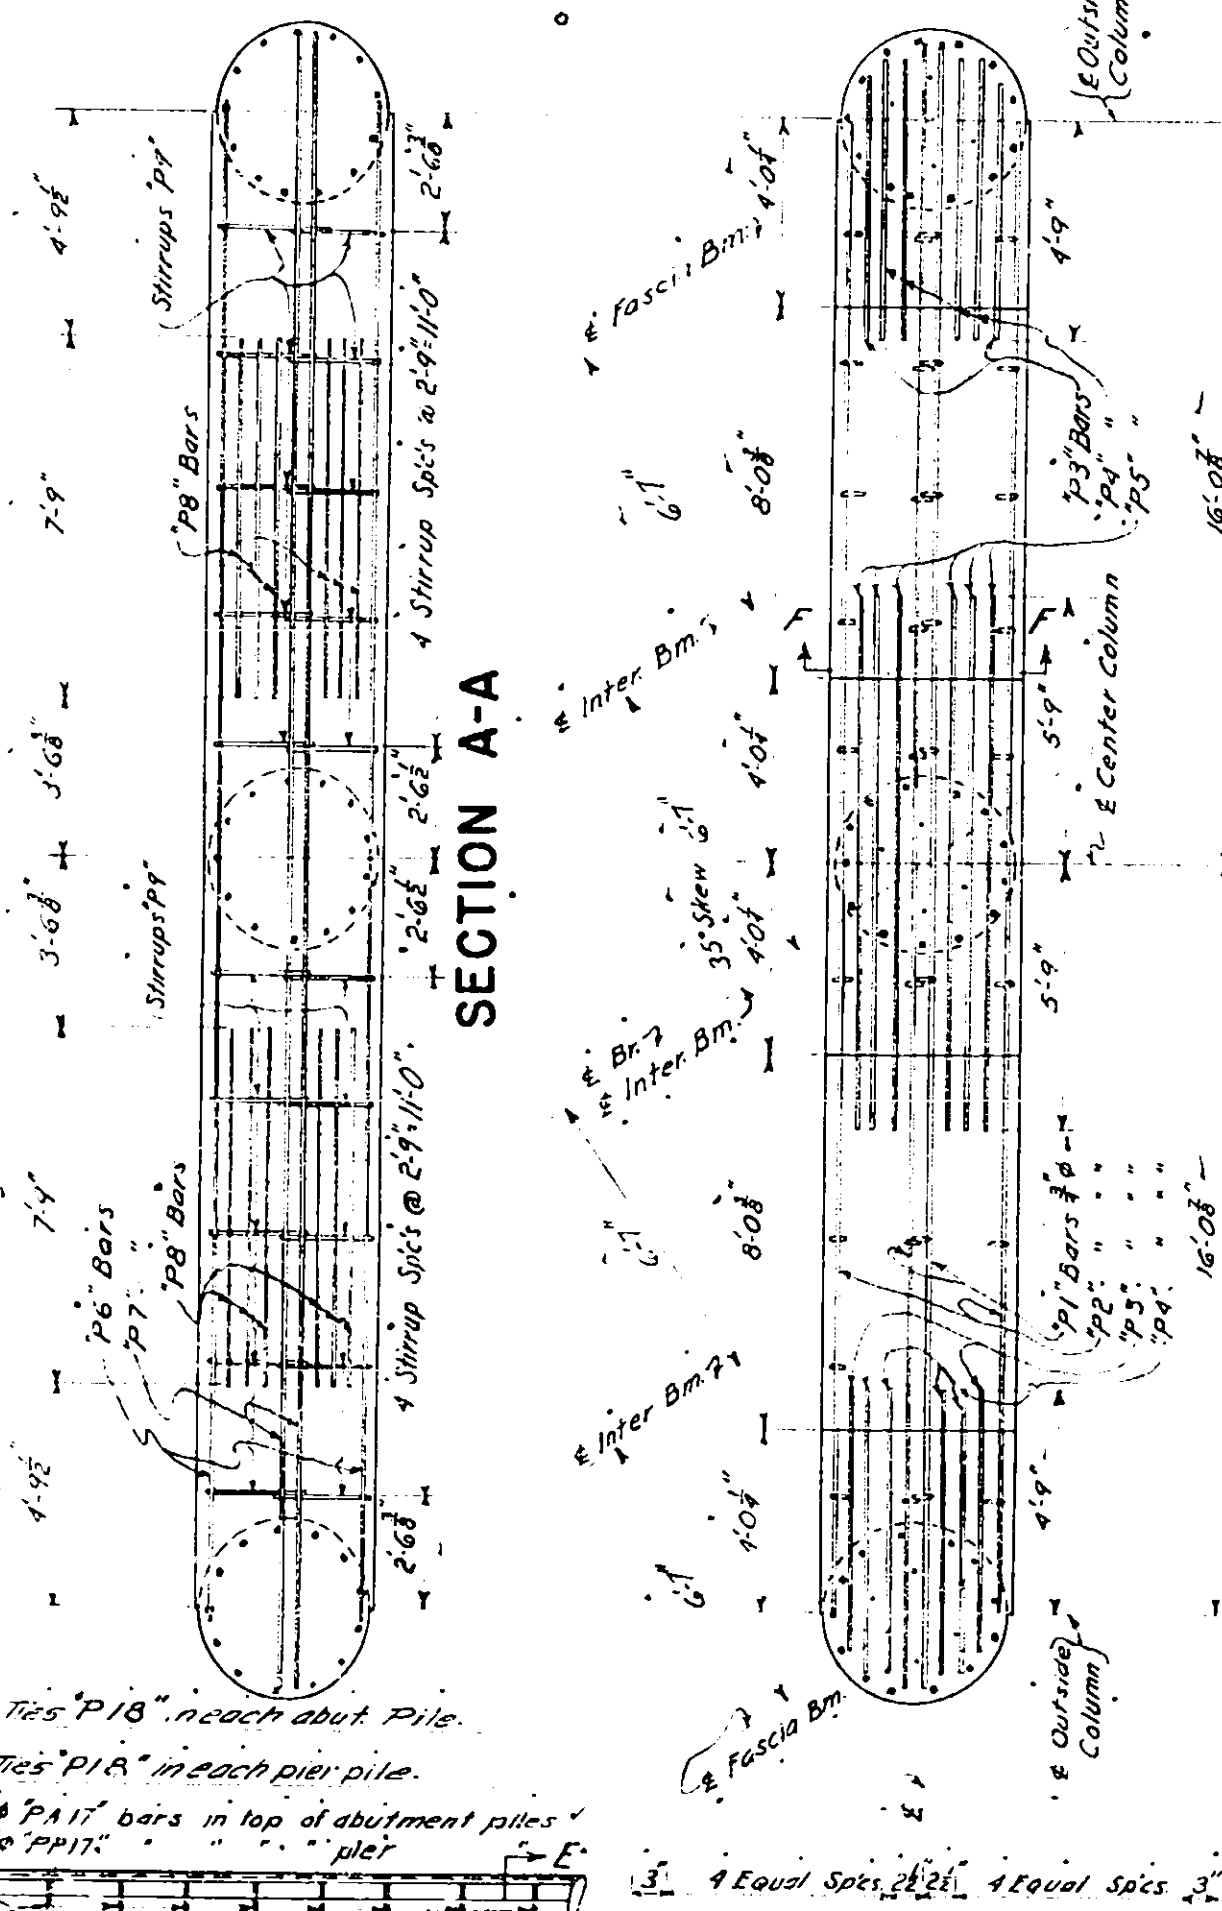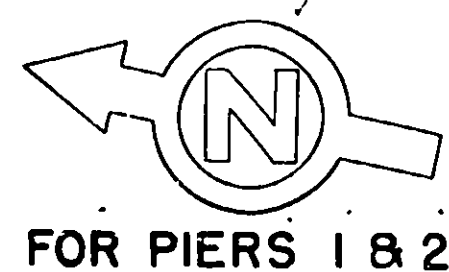


PLAN - ALL PIERS
SCALE: 1/4"=1'-0"

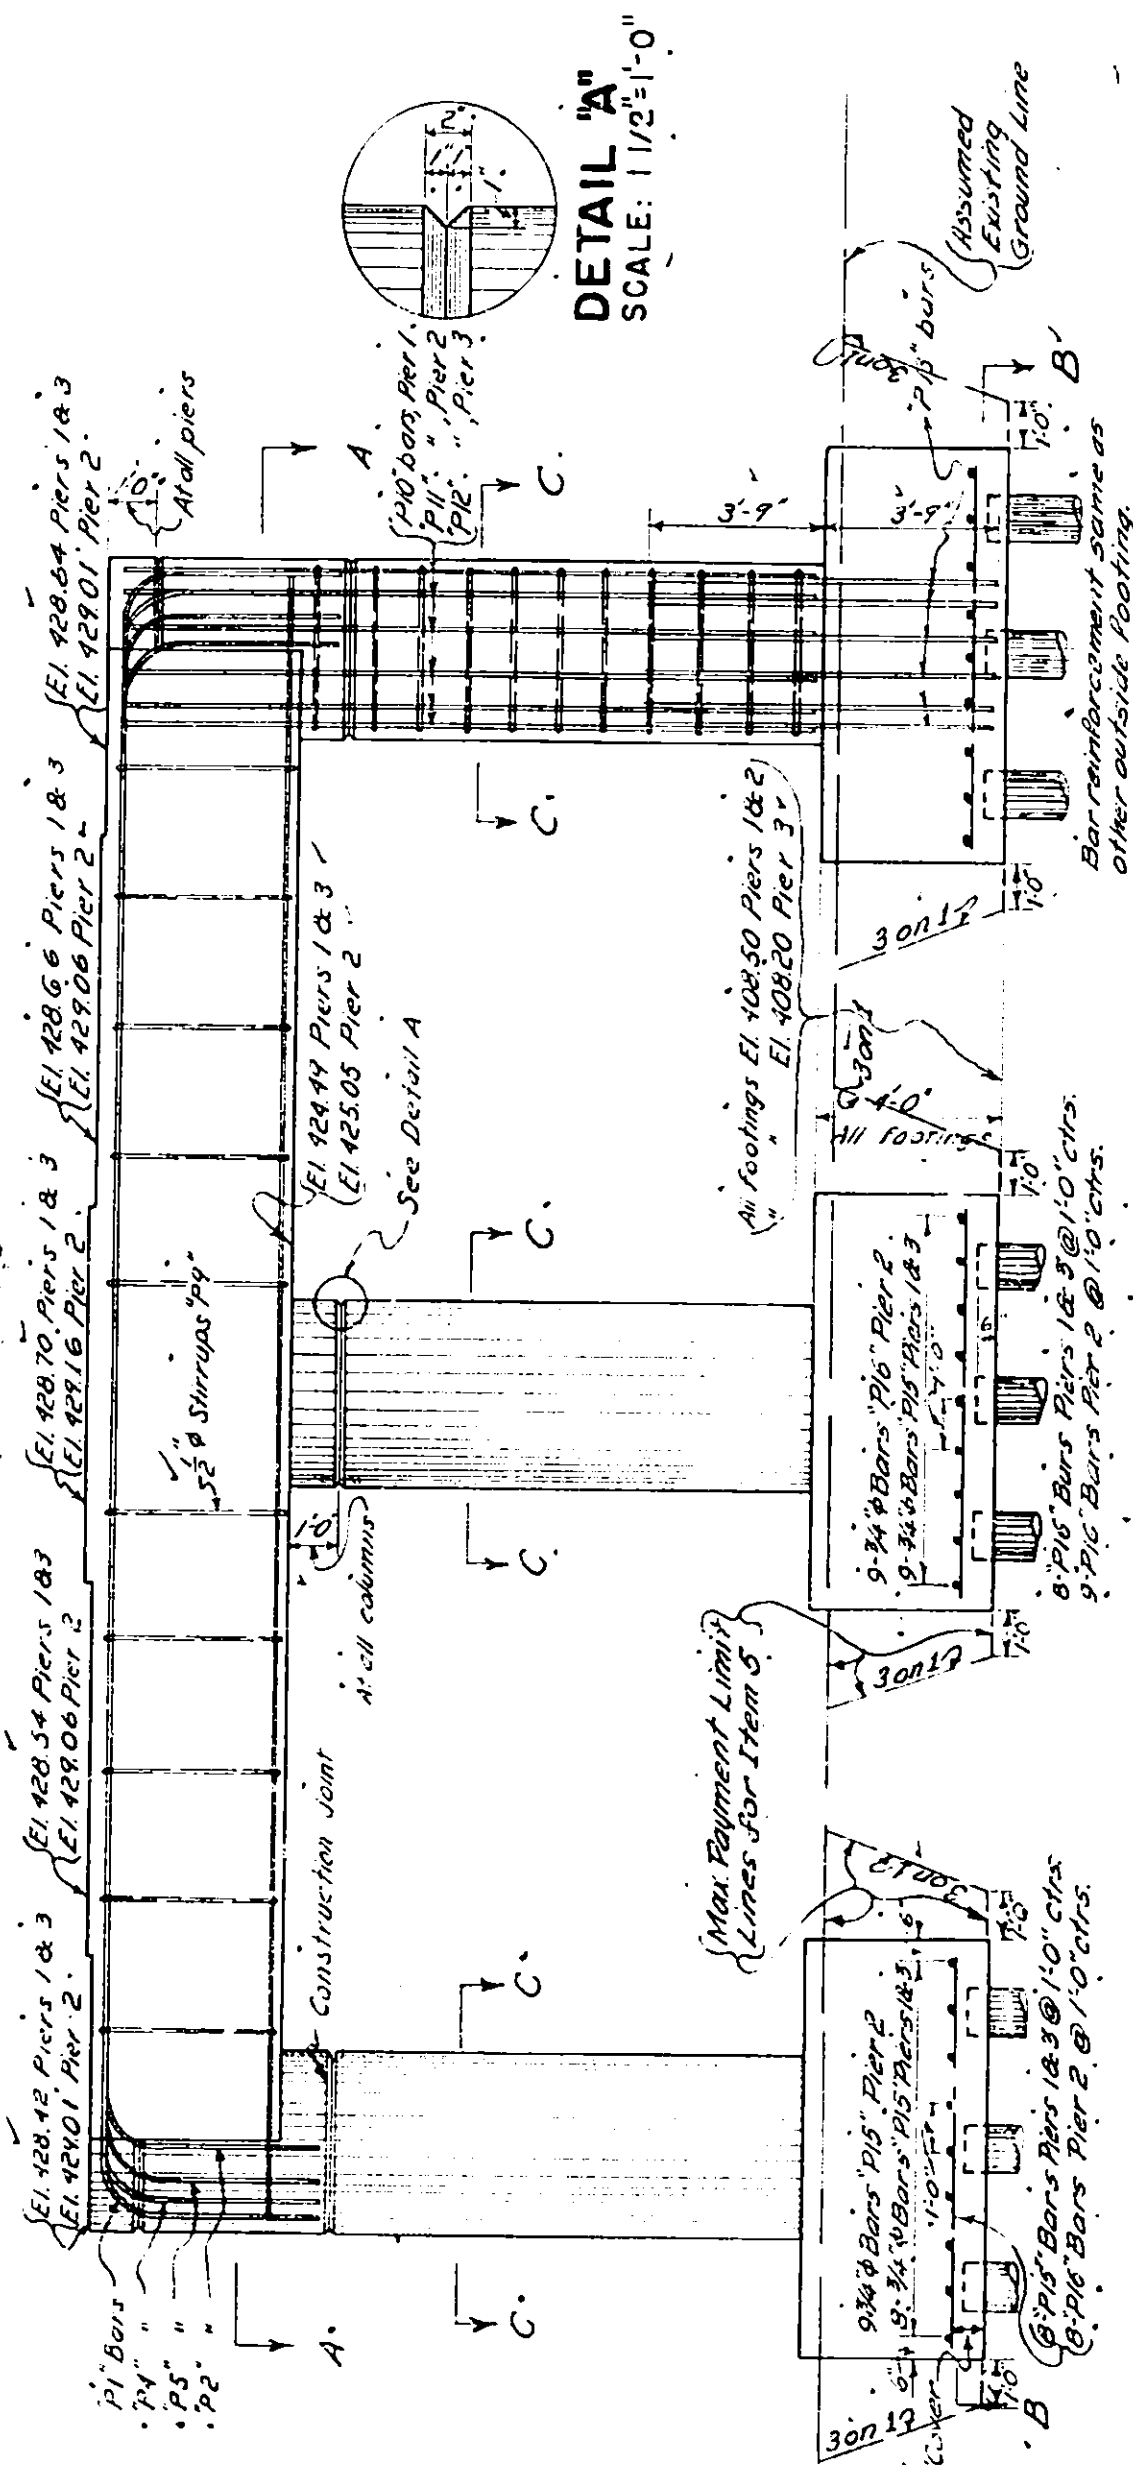


ELEVATION PIER 2
(ELEVATION OF PIER 1 & 3 SIMILAR)
SCALE: 1/4"=1'-0"

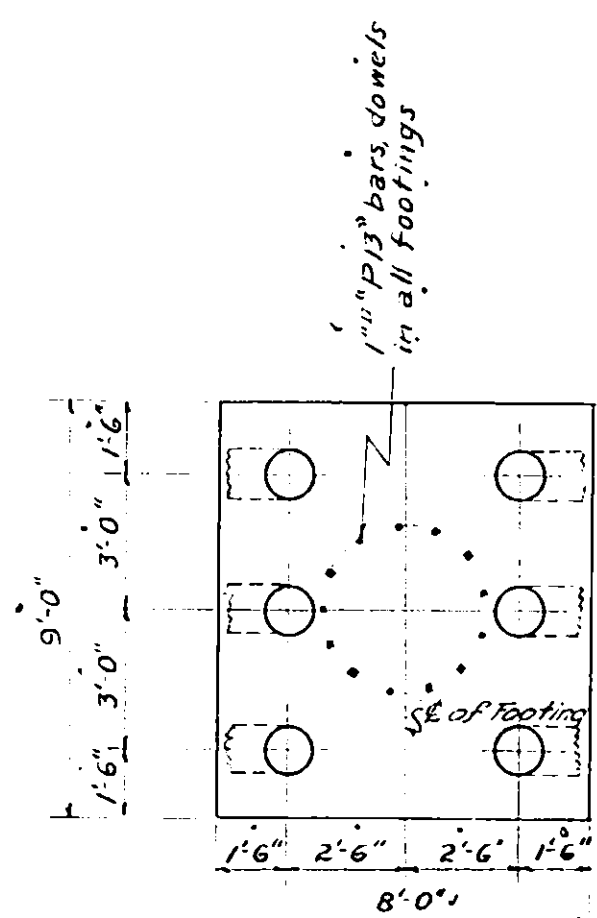



SECTION B-B, PIER 2
SCALE: 1/4"=1'-0"

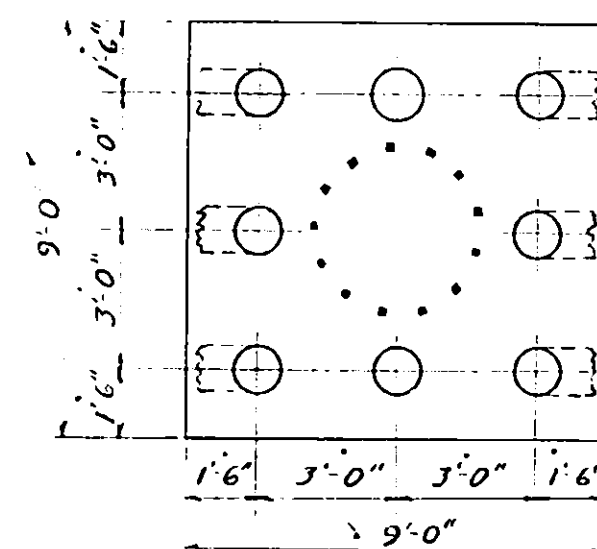

SECTION B-B, PIERS 1 & 3
SCALE: 1/4"=1'-0"

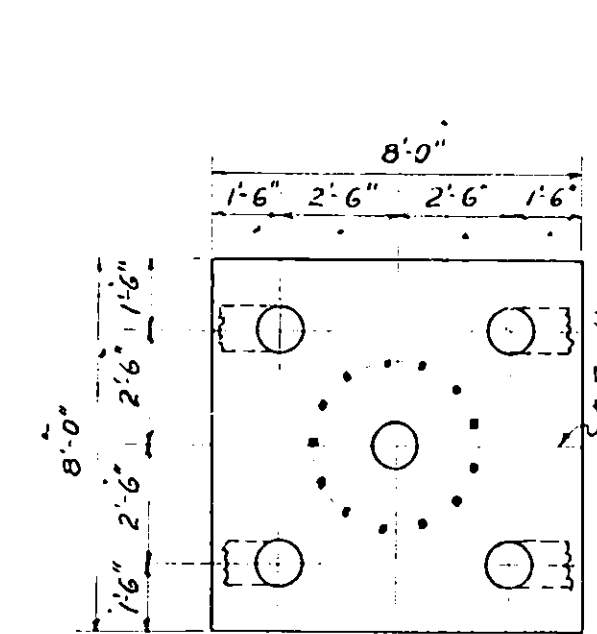

SECTION C-C ALL PIERS
SCALE: 3/8"=1'-0"

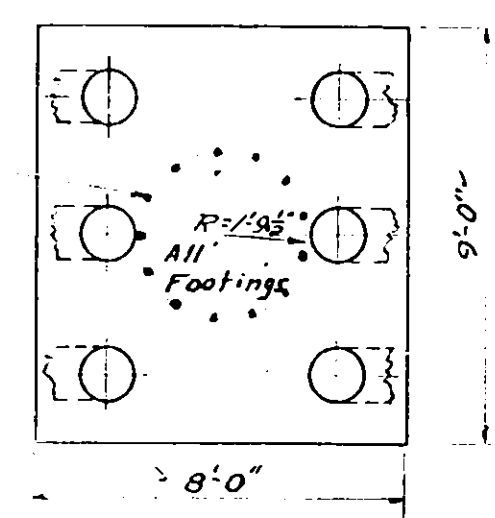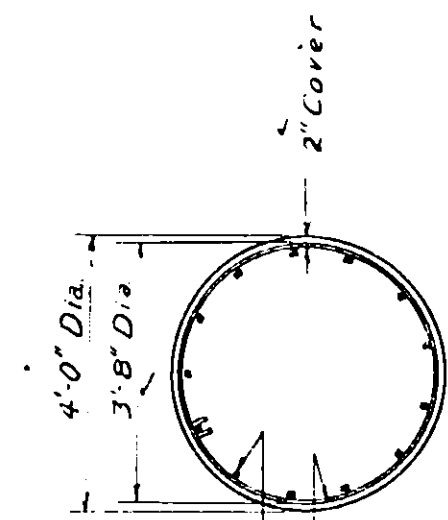

SECTION D-D
SCALE: 3/8"=1'-0"

MARK	SIZE	NO.	LGTH.	LOCATION & DESCRIPTION
P14	1/4"	99	12'-2"	3'-8" Dia. (Outside) Hoops in all columns.
P15	3/4"	100	2'-6"	Straight bars in all footings, Piers 1 & 3.
P16	3/4"	50	8'-6"	Straight bars in outside footings, Pier 2.

MARK	SIZE	NO.	LGTH.	LOCATION & DESCRIPTION
PA17	3/8"	252	25'-0"	Straight bars in top of concrete piles, both abutments.
PP17	3/8"	312	14'-0"	Straight bars in top of concrete piles, all piers.
P18	1/2"	150	2'-9"	Ties in Piles.


MARK	SIZE	NO.	LGTH.	LOCATION & DESCRIPTION
P1	3/8"	6	44'-1"	33'-8" P1 Bars, 30'-1" P2
P2	3/8"	6	40'-6"	Longitudinal bars in top of bridge seat - all piers
P3	3/8"	12	10'-1"	1'-0" Rad to outside
P4	3/8"	24	10'-5"	Longitudinal bars in top of bridge seat at ends - all piers
P5	3/8"	18	11'-0"	Longitudinal straight bars in top of bridge seat over center column - all piers
P6	3/8"	6	32'-1"	Longitudinal straight bars in bottom of bridge seat, full length - all piers
P7	3/8"	6	35'-9"	Longitudinal straight bars in bottom of bridge seat between columns - all piers
P8	3/8"	36	7'-9"	Longitudinal straight bars in bottom of bridge seat between columns - all piers
P9	3/8"	60	12'-0"	Stirrups in bridge seat - all piers
P10	3/8"	39	15'-8"	Vertical straight bars in columns & bridge seat - Pier 1
P11	3/8"	39	16'-2"	Vertical straight bars in columns & bridge seat - Pier 2
P12	3/8"	39	15'-4"	Vertical straight bars in columns & bridge seat - Pier 3
P13	3/8"	117	7'-6"	Dowel bars in columns and bridge seat

NOTES FOR PIERS & ABUTMENTS

Concrete in abutments and wing walls shall be Item 80. Concrete in piers shall be Item 15.
 Payment for furnishing and placing anchor bolts and nuts will be made under Item 89. For details of anchor bolts see superstructure sheets.
 For estimated lengths of cast-in-place piles under abutments and piers - see plan and profile sheet for design purposes the assumed load per pile does not exceed 30 tons.
 Bridge seat areas directly under bearing shoes shall be backfilled with bedding (provided by the Engineer).
 Placing of any piles for the structure will not be permitted until the highway embankment adjacent to the structure has been placed and consolidated in a manner and for a time satisfactory to the Deputy Chief Engineer, Bridges, Drains, Separations and Structures.
 Waterproofing or treatment shall be applied to all exposed surfaces of concrete on the abutments and piers except the face of backwalls and bridge seats.
 The Contractor's attention is directed to the special notes for this structure which appear in the proposal. Particular attention should be given to the Foundation notes which describe the anticipated subsurface conditions of the site of the structure and which specify certain requirements relative to construction.

FYLER SETTLEMENT ROAD BRIDGE
STA. 200+06
PIERS

PILE REINFORCEMENT DETAIL
SCALE: 3/8"=1'-0"

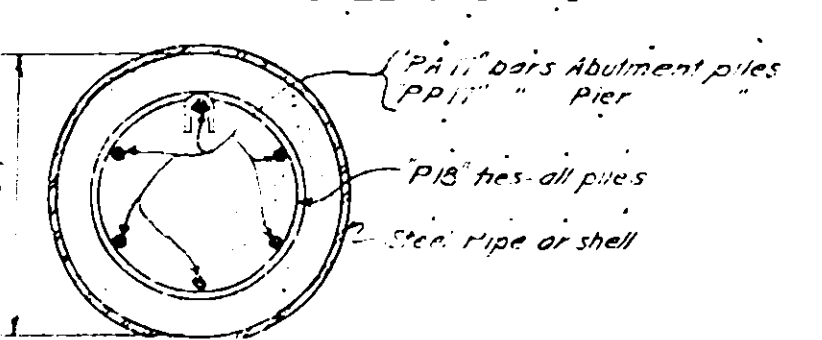


SECTION E-E
SCALE: 1 1/2"=1'-0"

NOTE FOR PILE REINFORCEMENT

Reinforcement cages shall be fabricated before being placed and shall be held in position while the concrete is poured.
 Reinforcement shall be provided to hold bars in position. The cost of furnishing and placing wire chairs shall be included in the price bid for Item 20.
 The reinforcement has been detailed for a cylindrical pile. If a tapered pile is desired, the main reinforcement as given above shall be used and adjustment in length and diameter of ties shall be made.

SECTION F-F
SCALE: 3/4"=1'-0"


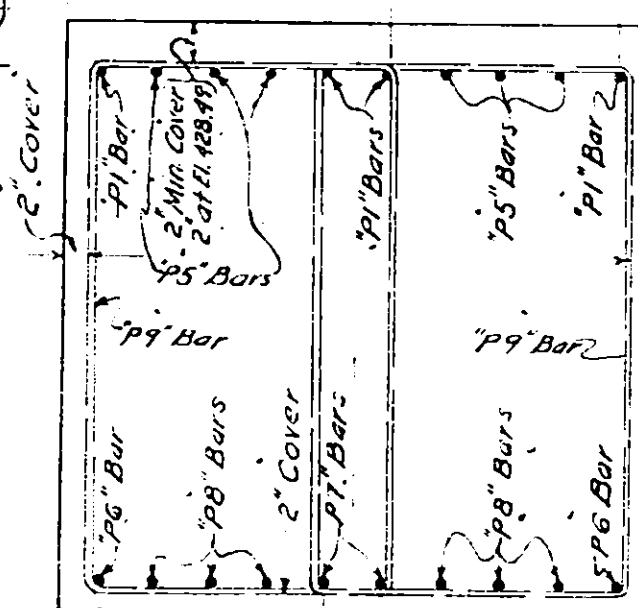


SECTION F-F
SCALE: 3/4"=1'-0"













Shirley Lee 6/15/50
R. G. Halligan 6/14/50
M. J. Seaman
R. G. Halligan 6/15/50

Note: Rivet bolts or equal may be used for field connections.

FED AID DIST. NO.	STATE	FED AID FISCAL YEAR	SHEET NO.	TOTAL SHEETS
	N.Y.		17	67
MOHAWK THRUWAY				
FROM				
TO				
MADISON COUNTY				

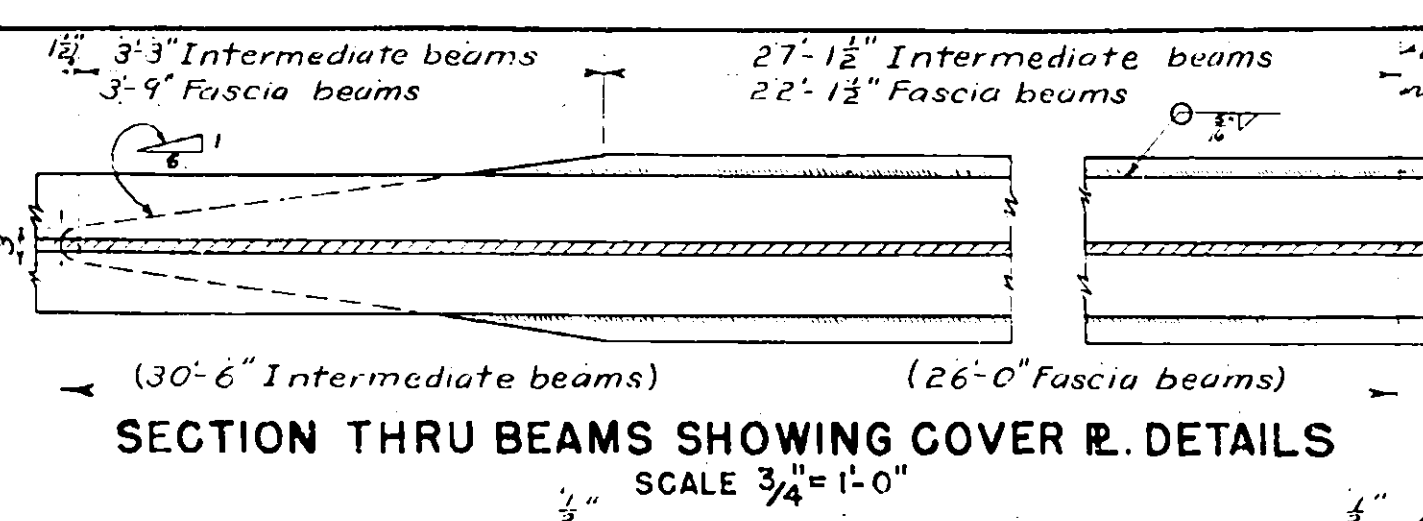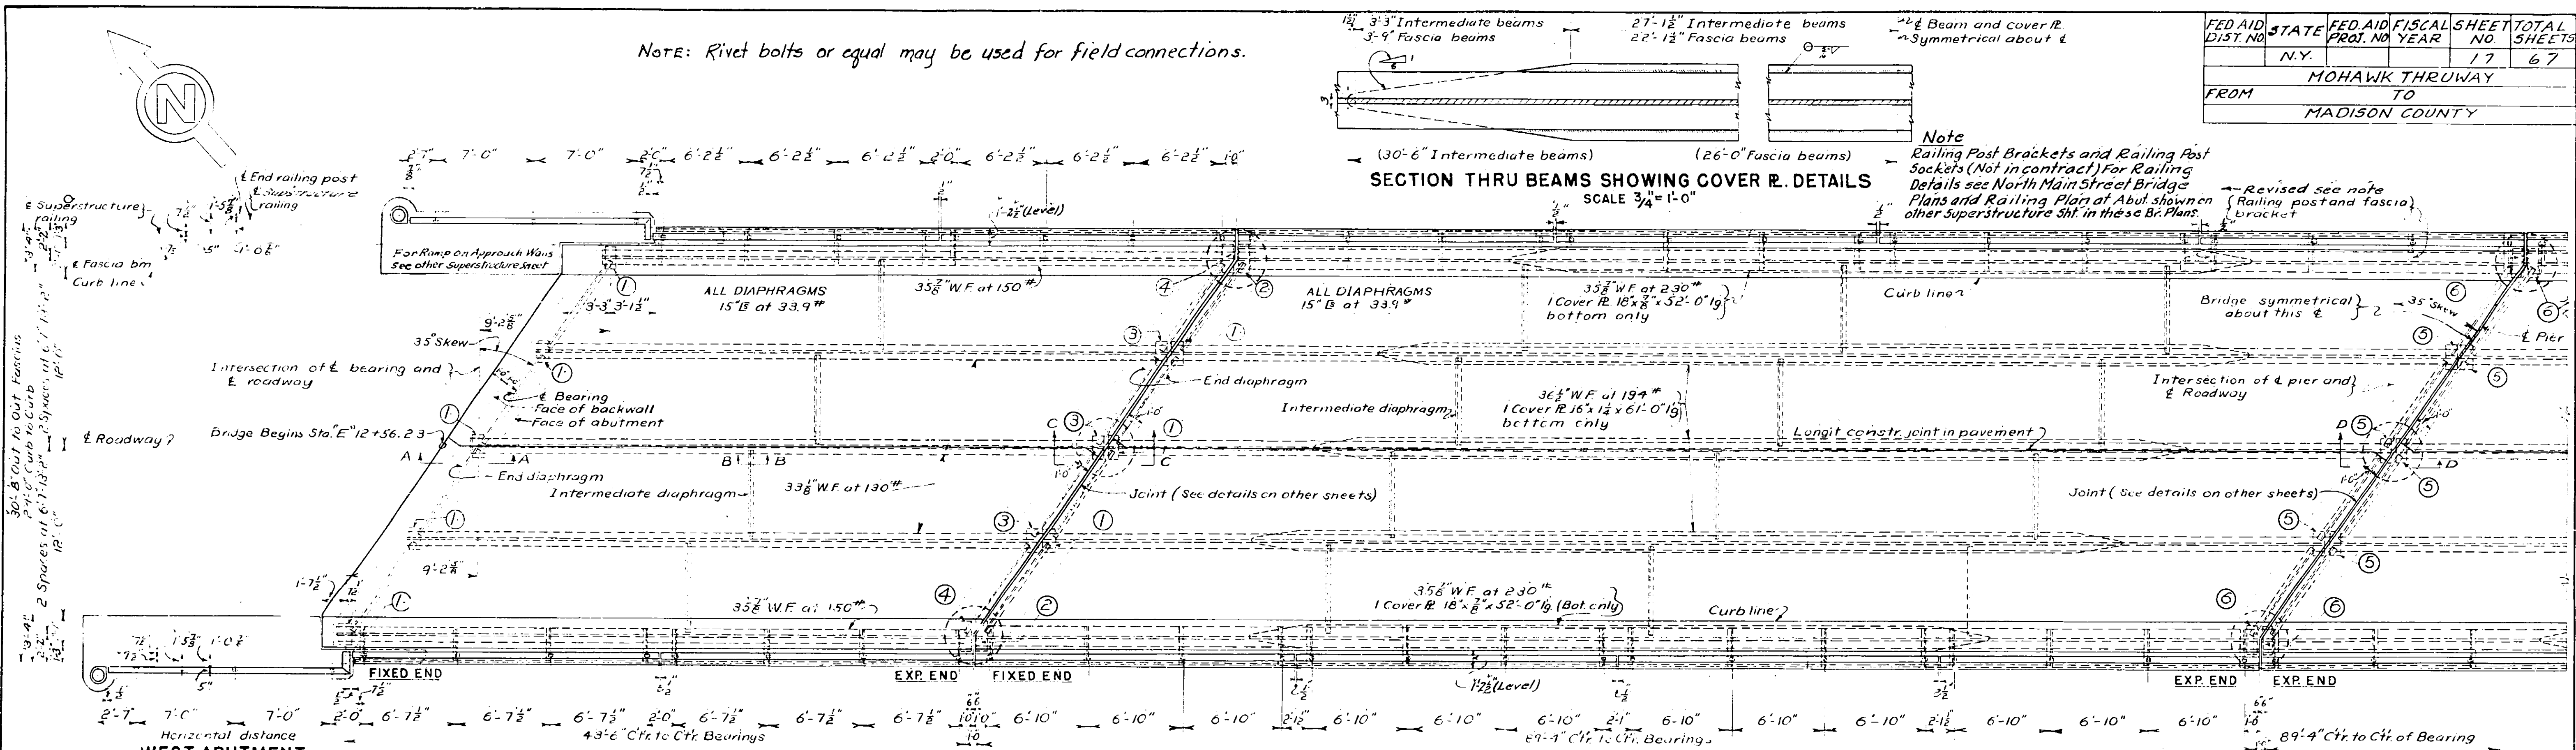

Note: Railing Post Brackets and Railing Post Sockets (Not in contract) For Railing Details see North Main Street Bridge Plans and Railing Plan at Abut. shown in other superstructure Sht. in these Br. Plans. Revised see note Railing post and fascia bracket

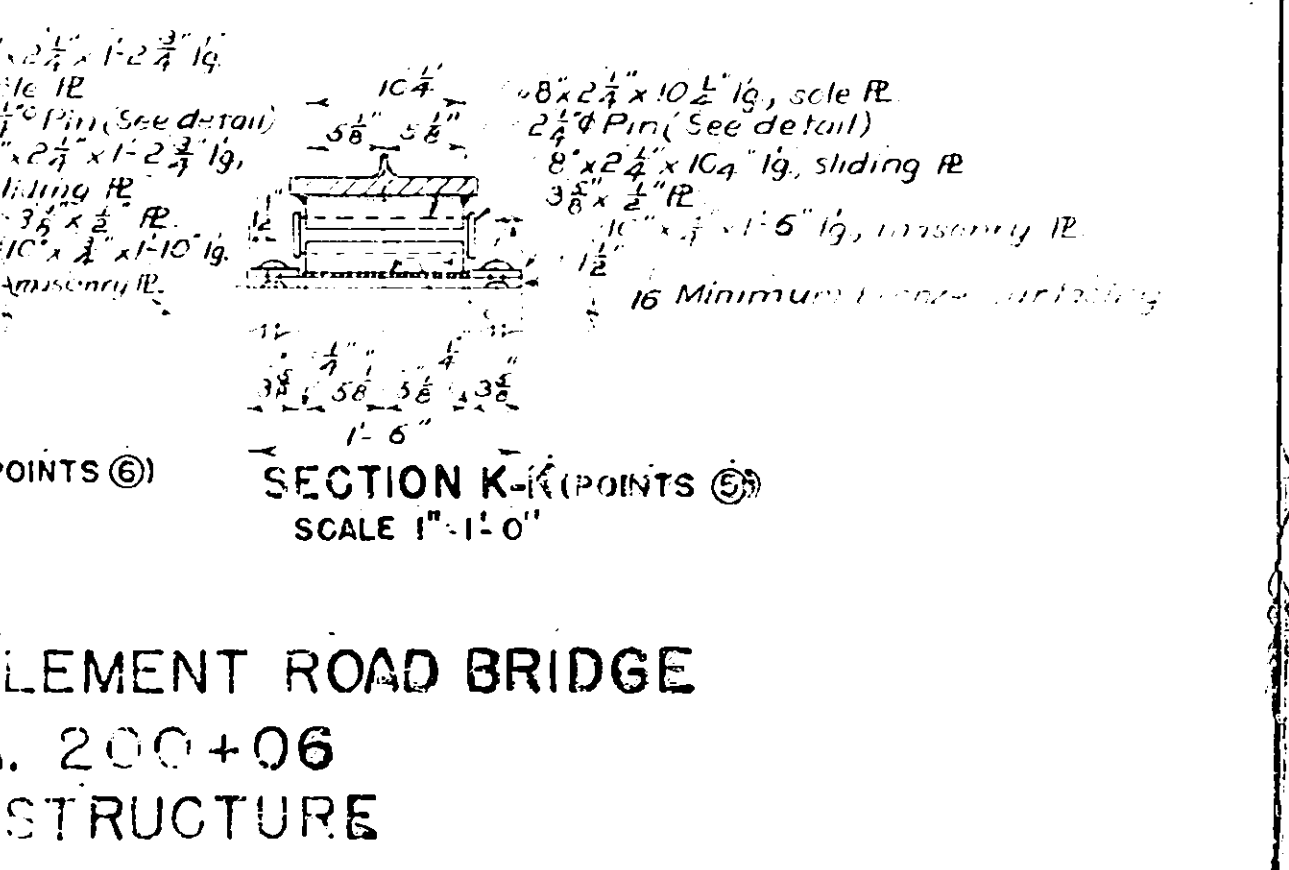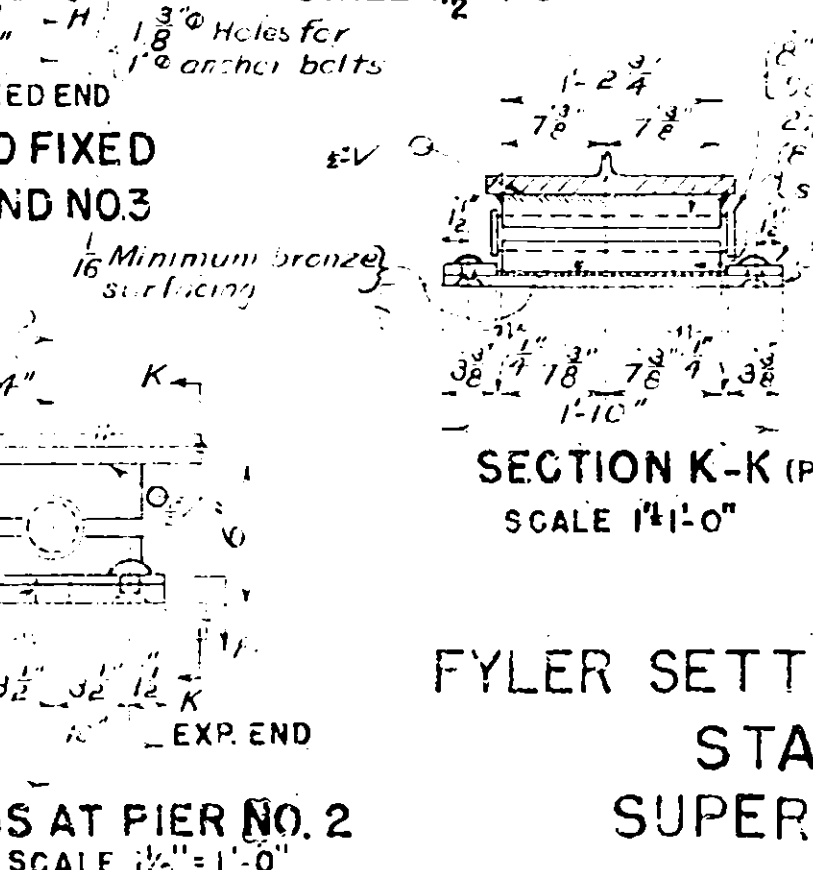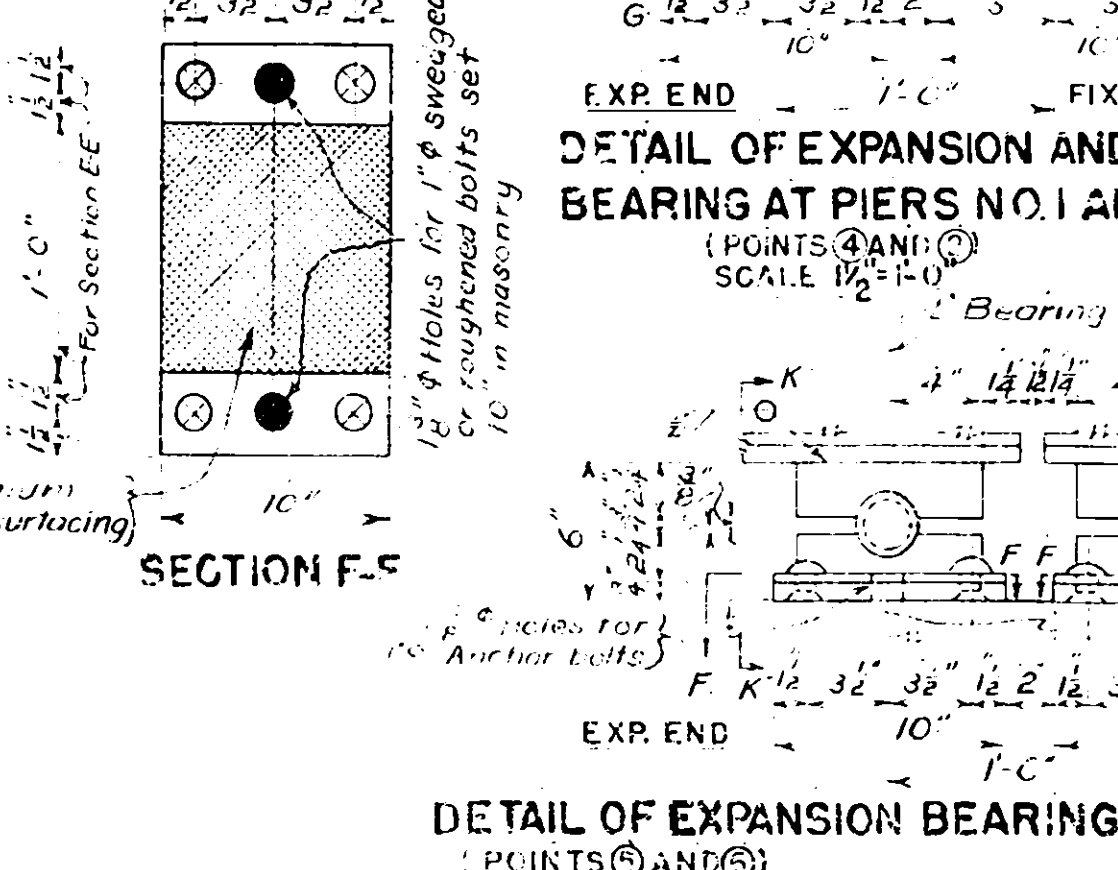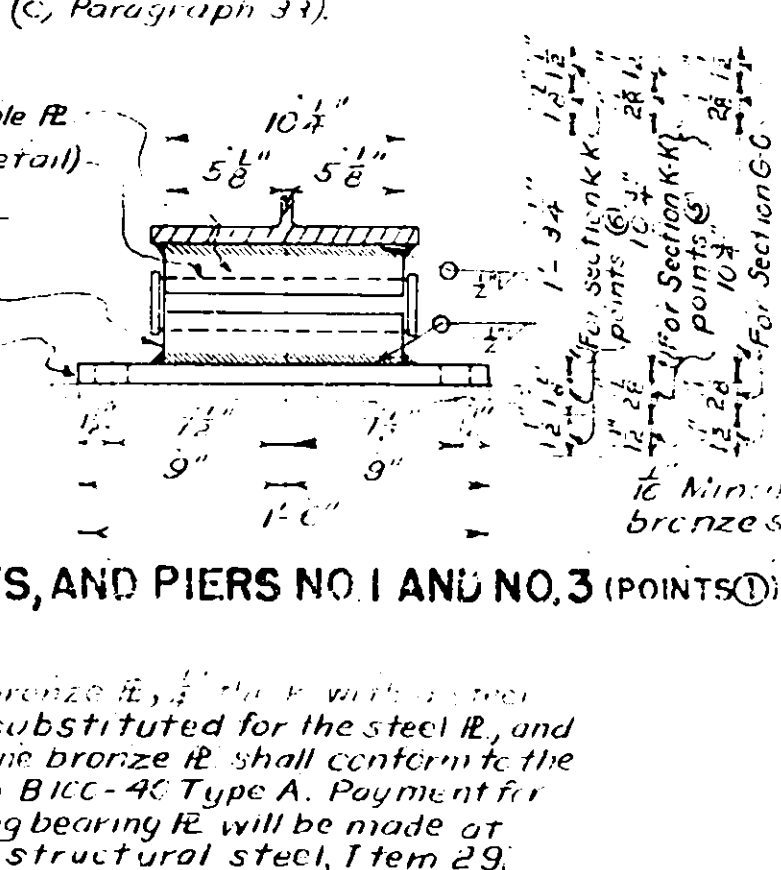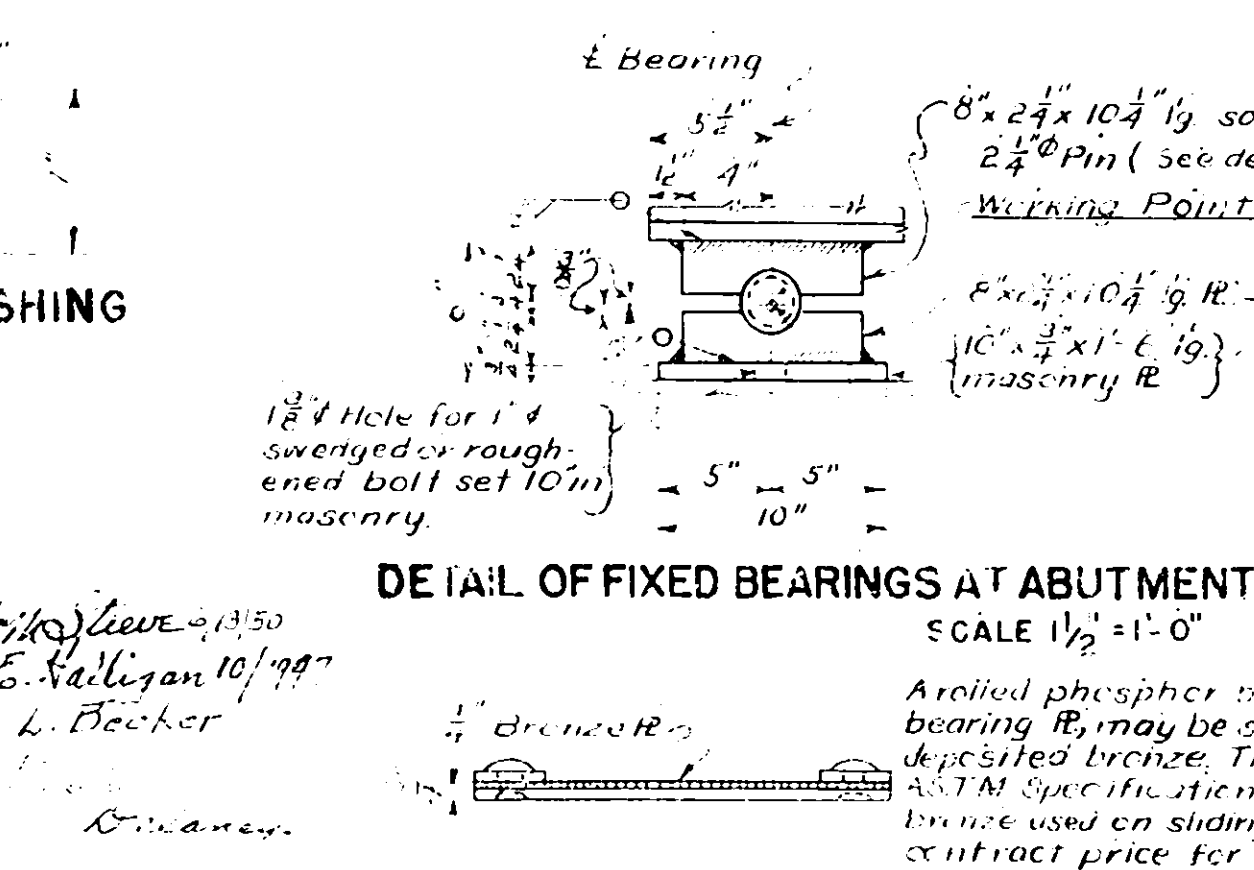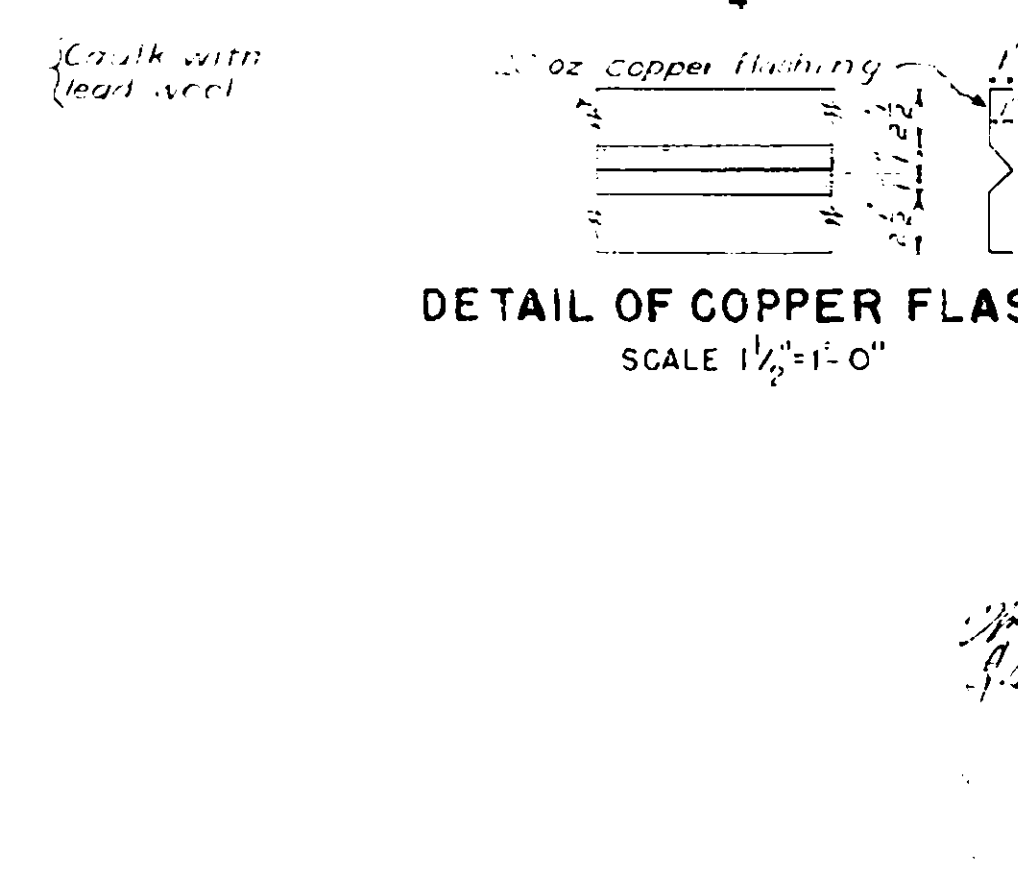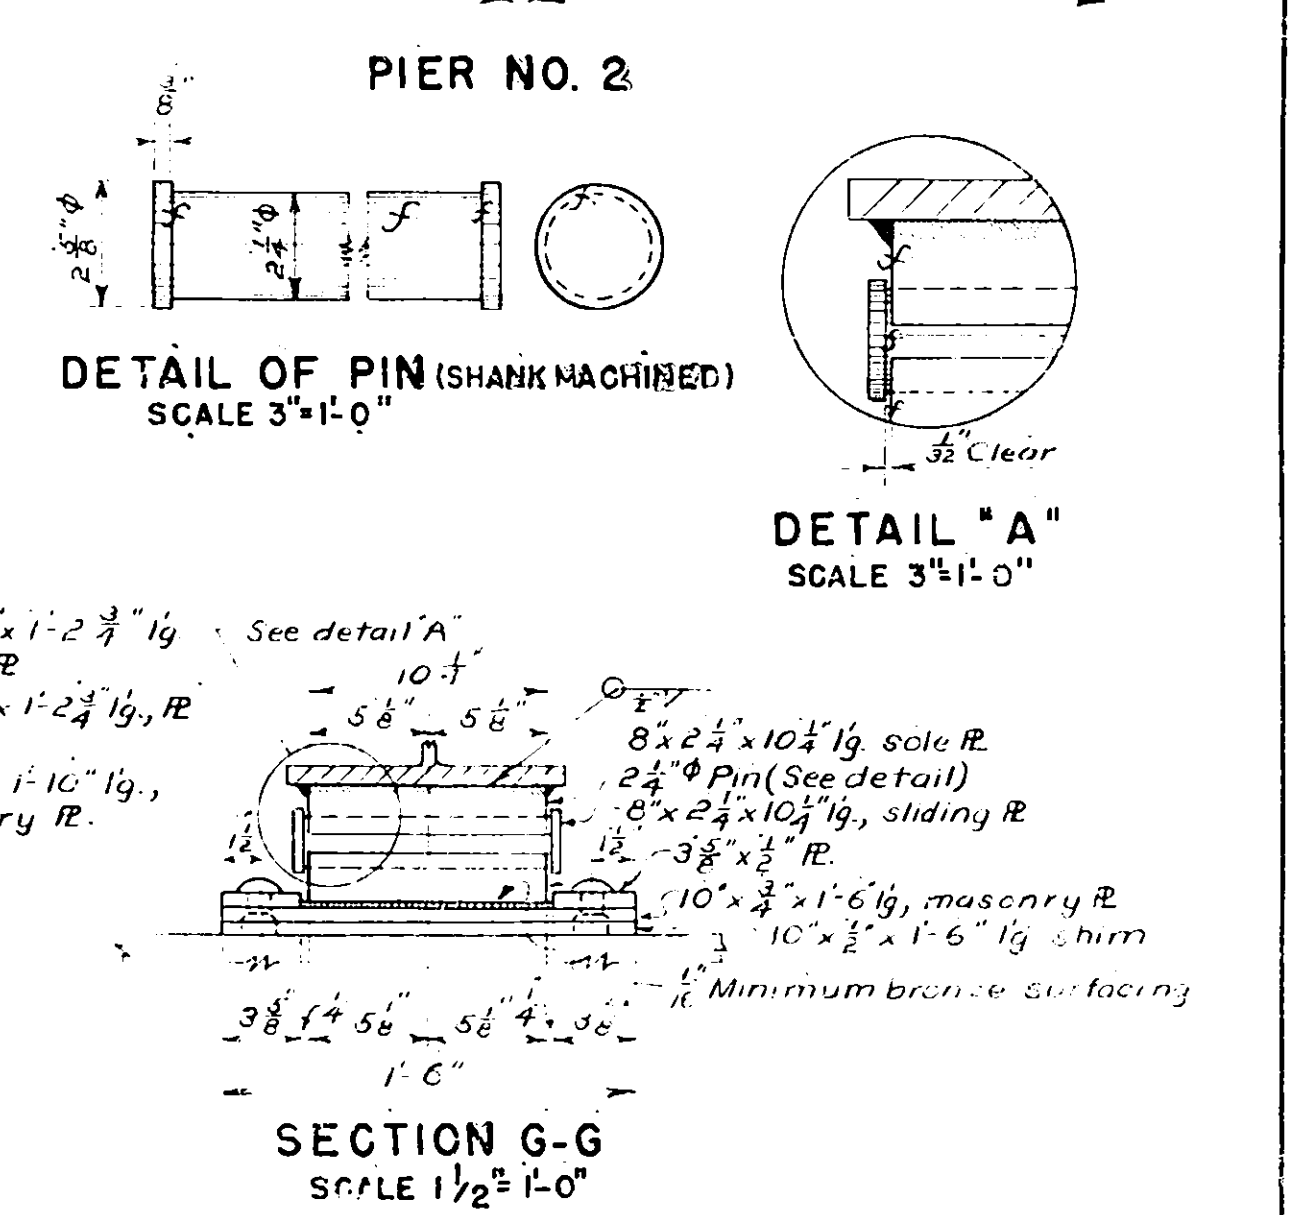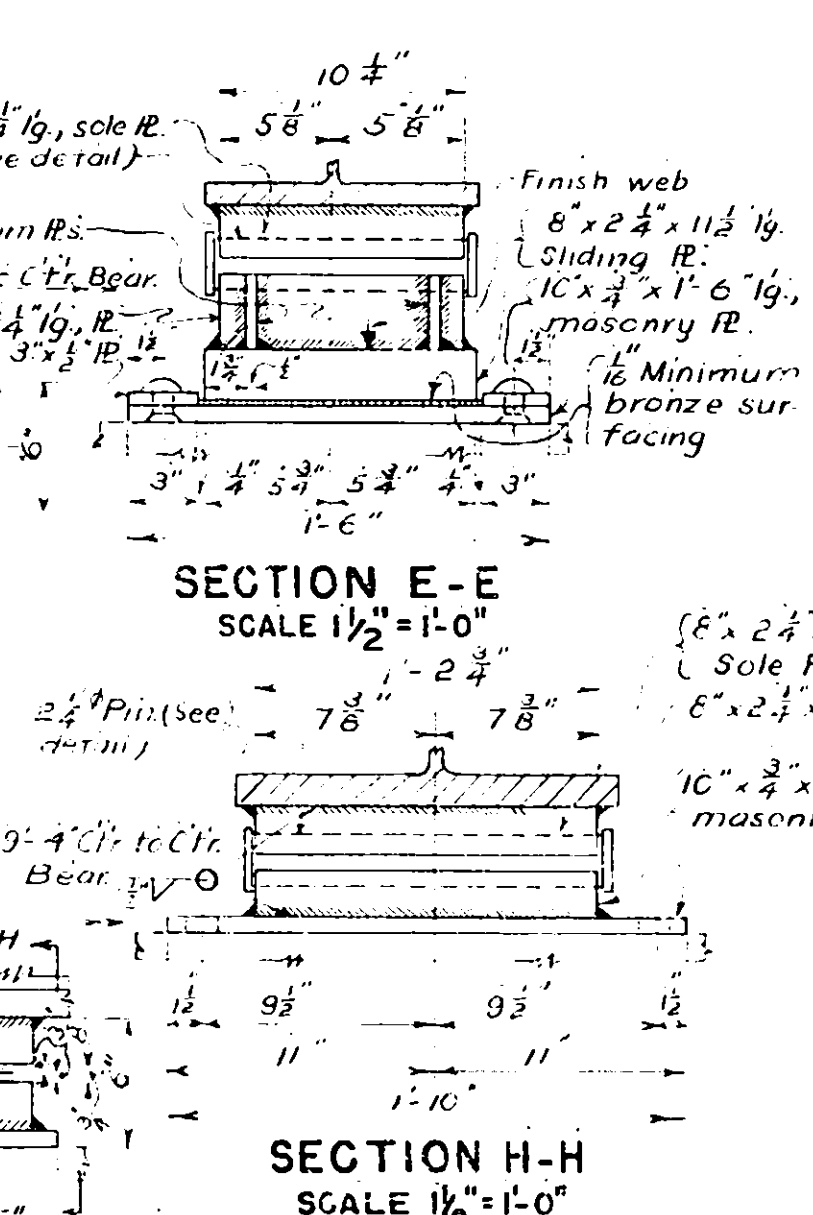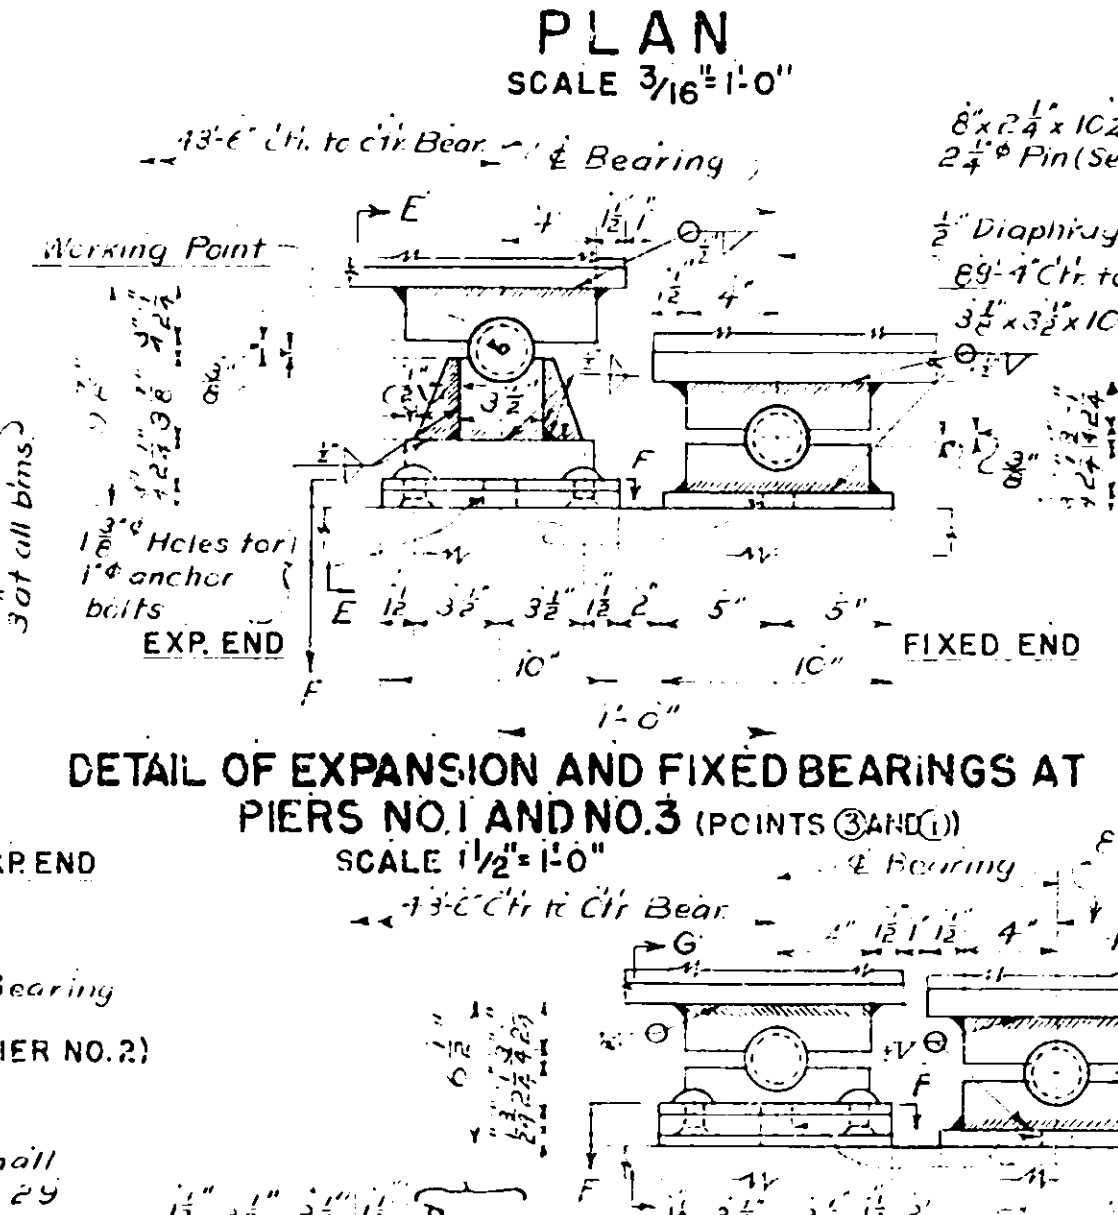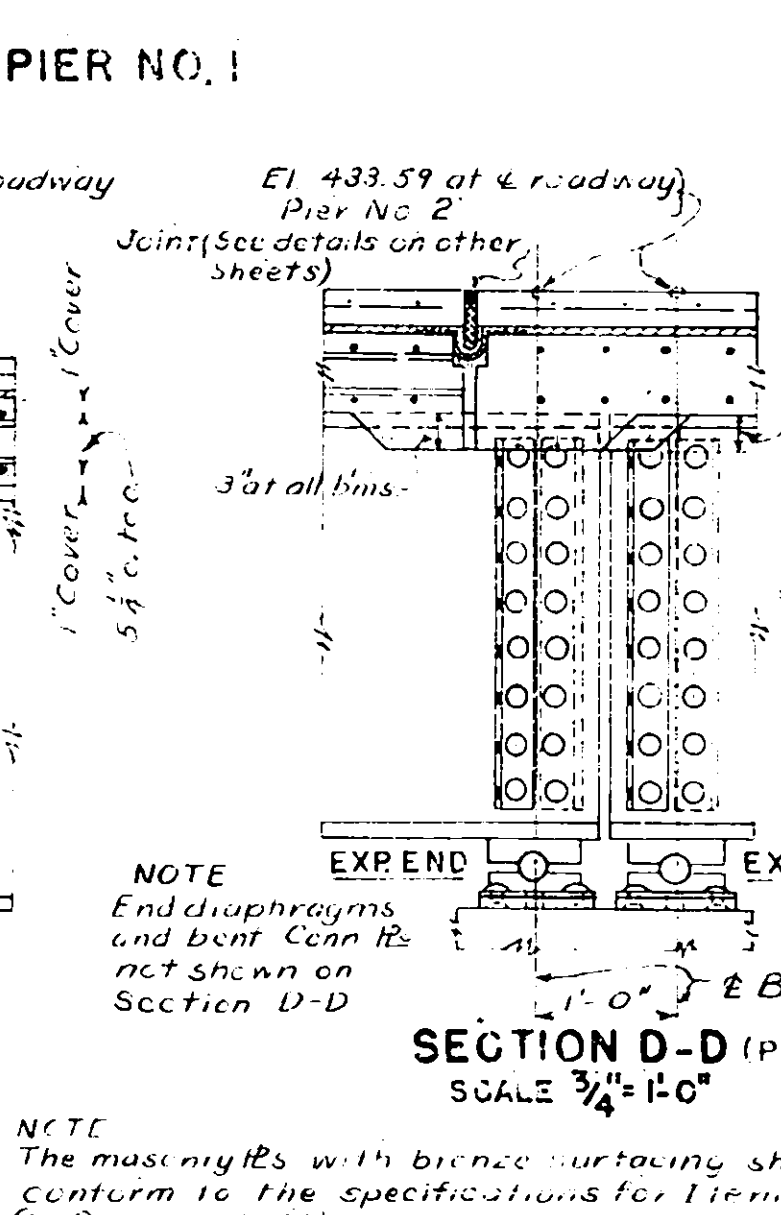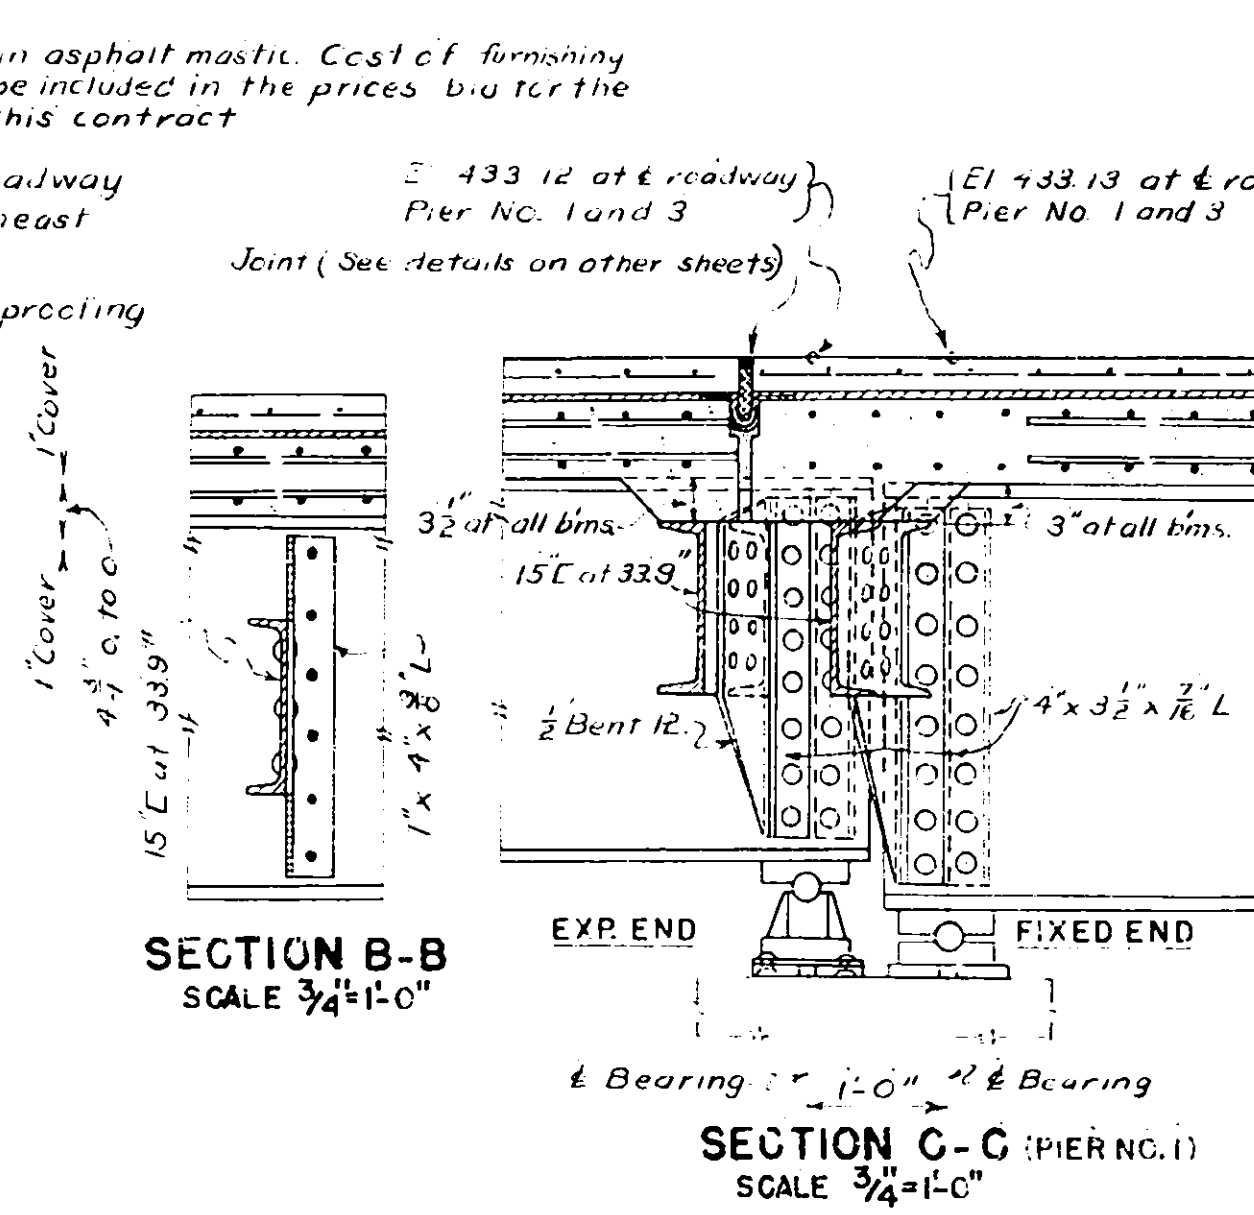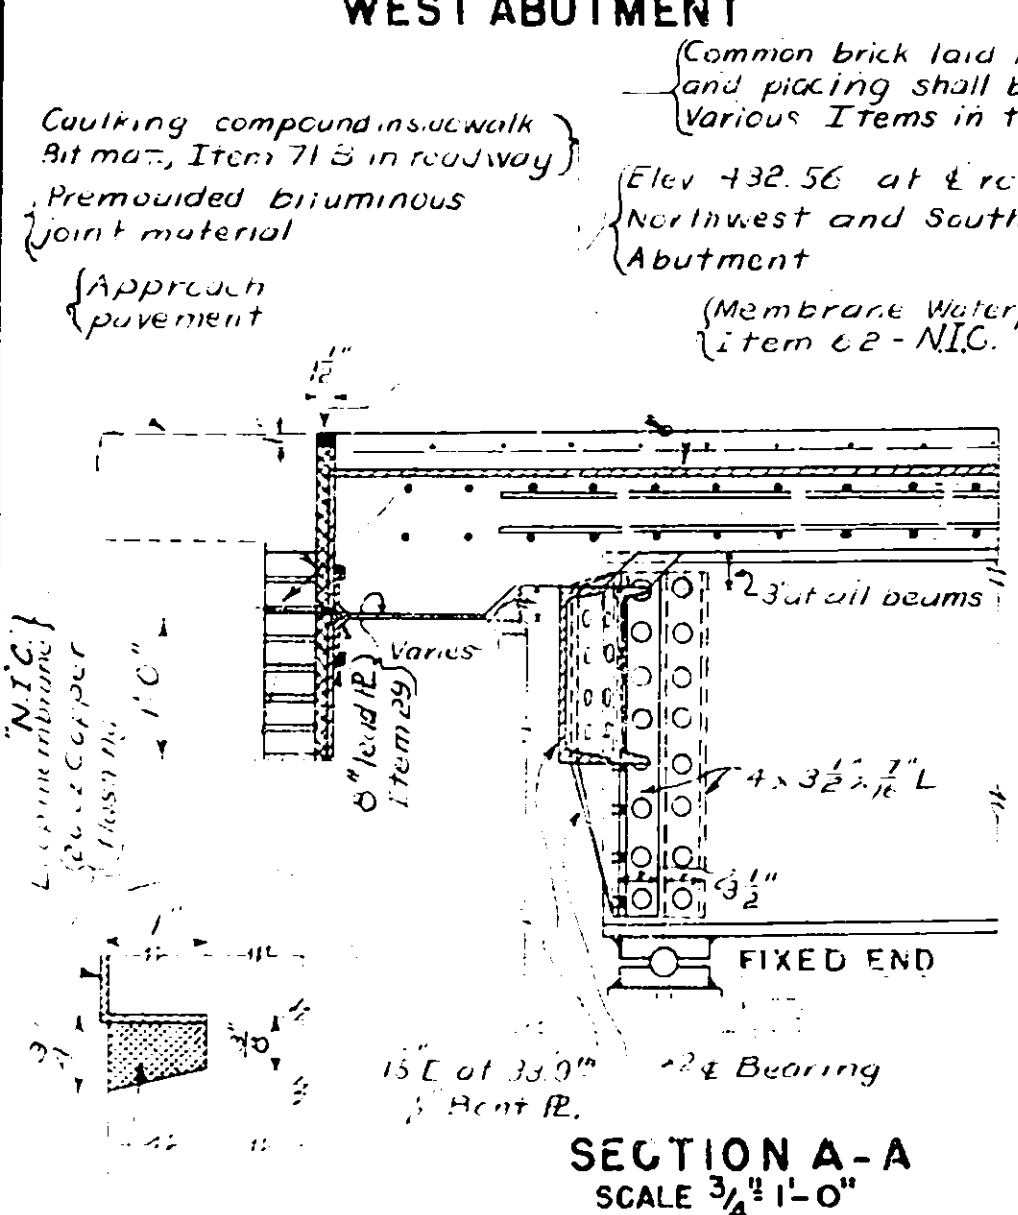

FYLER SETTLEMENT ROAD BRIDGE
STA. 200+06
SUPERSTRUCTURE

Note:-
Railing details in enclosed areas are not in this contract (N.T.C.). Use Railing Details and Railing Submittal shown on North Main St Bridge Plans except as shown. In plan this sheet shows location of railing posts and railing joints see Superstructure Plan for this bridge.

RAILING NOTES


Shop or field welding may be used in the fabrication and erection of the railing. Dimensions for tubing are outside dimensions.

All railings are to be fabricated and erected so that the rails are parallel to each other and to the fasciae and the rails are parallel to each other.

Material for posts and rails shall be copper bearing steel or alternate material as specified under, Materials of Construction for Pipe and Rectangular Tubing, page 99 of N.Y. State, "Public Works Specifications, January 2, 1947 and current modifications."




All welding to be electric arc and shall conform to the American Welding Society Specifications for Welded Highway and Railway Bridges, 1947, and current modifications.

FED.AID	STATE	FED.AID PROJ.NO	FISCAL YEAR	SHEET NO.	TOTAL SHEETS
	N.Y.			18	67
MOHAWK THRUWAY					
FROM		TO			
MADISON COUNTY					

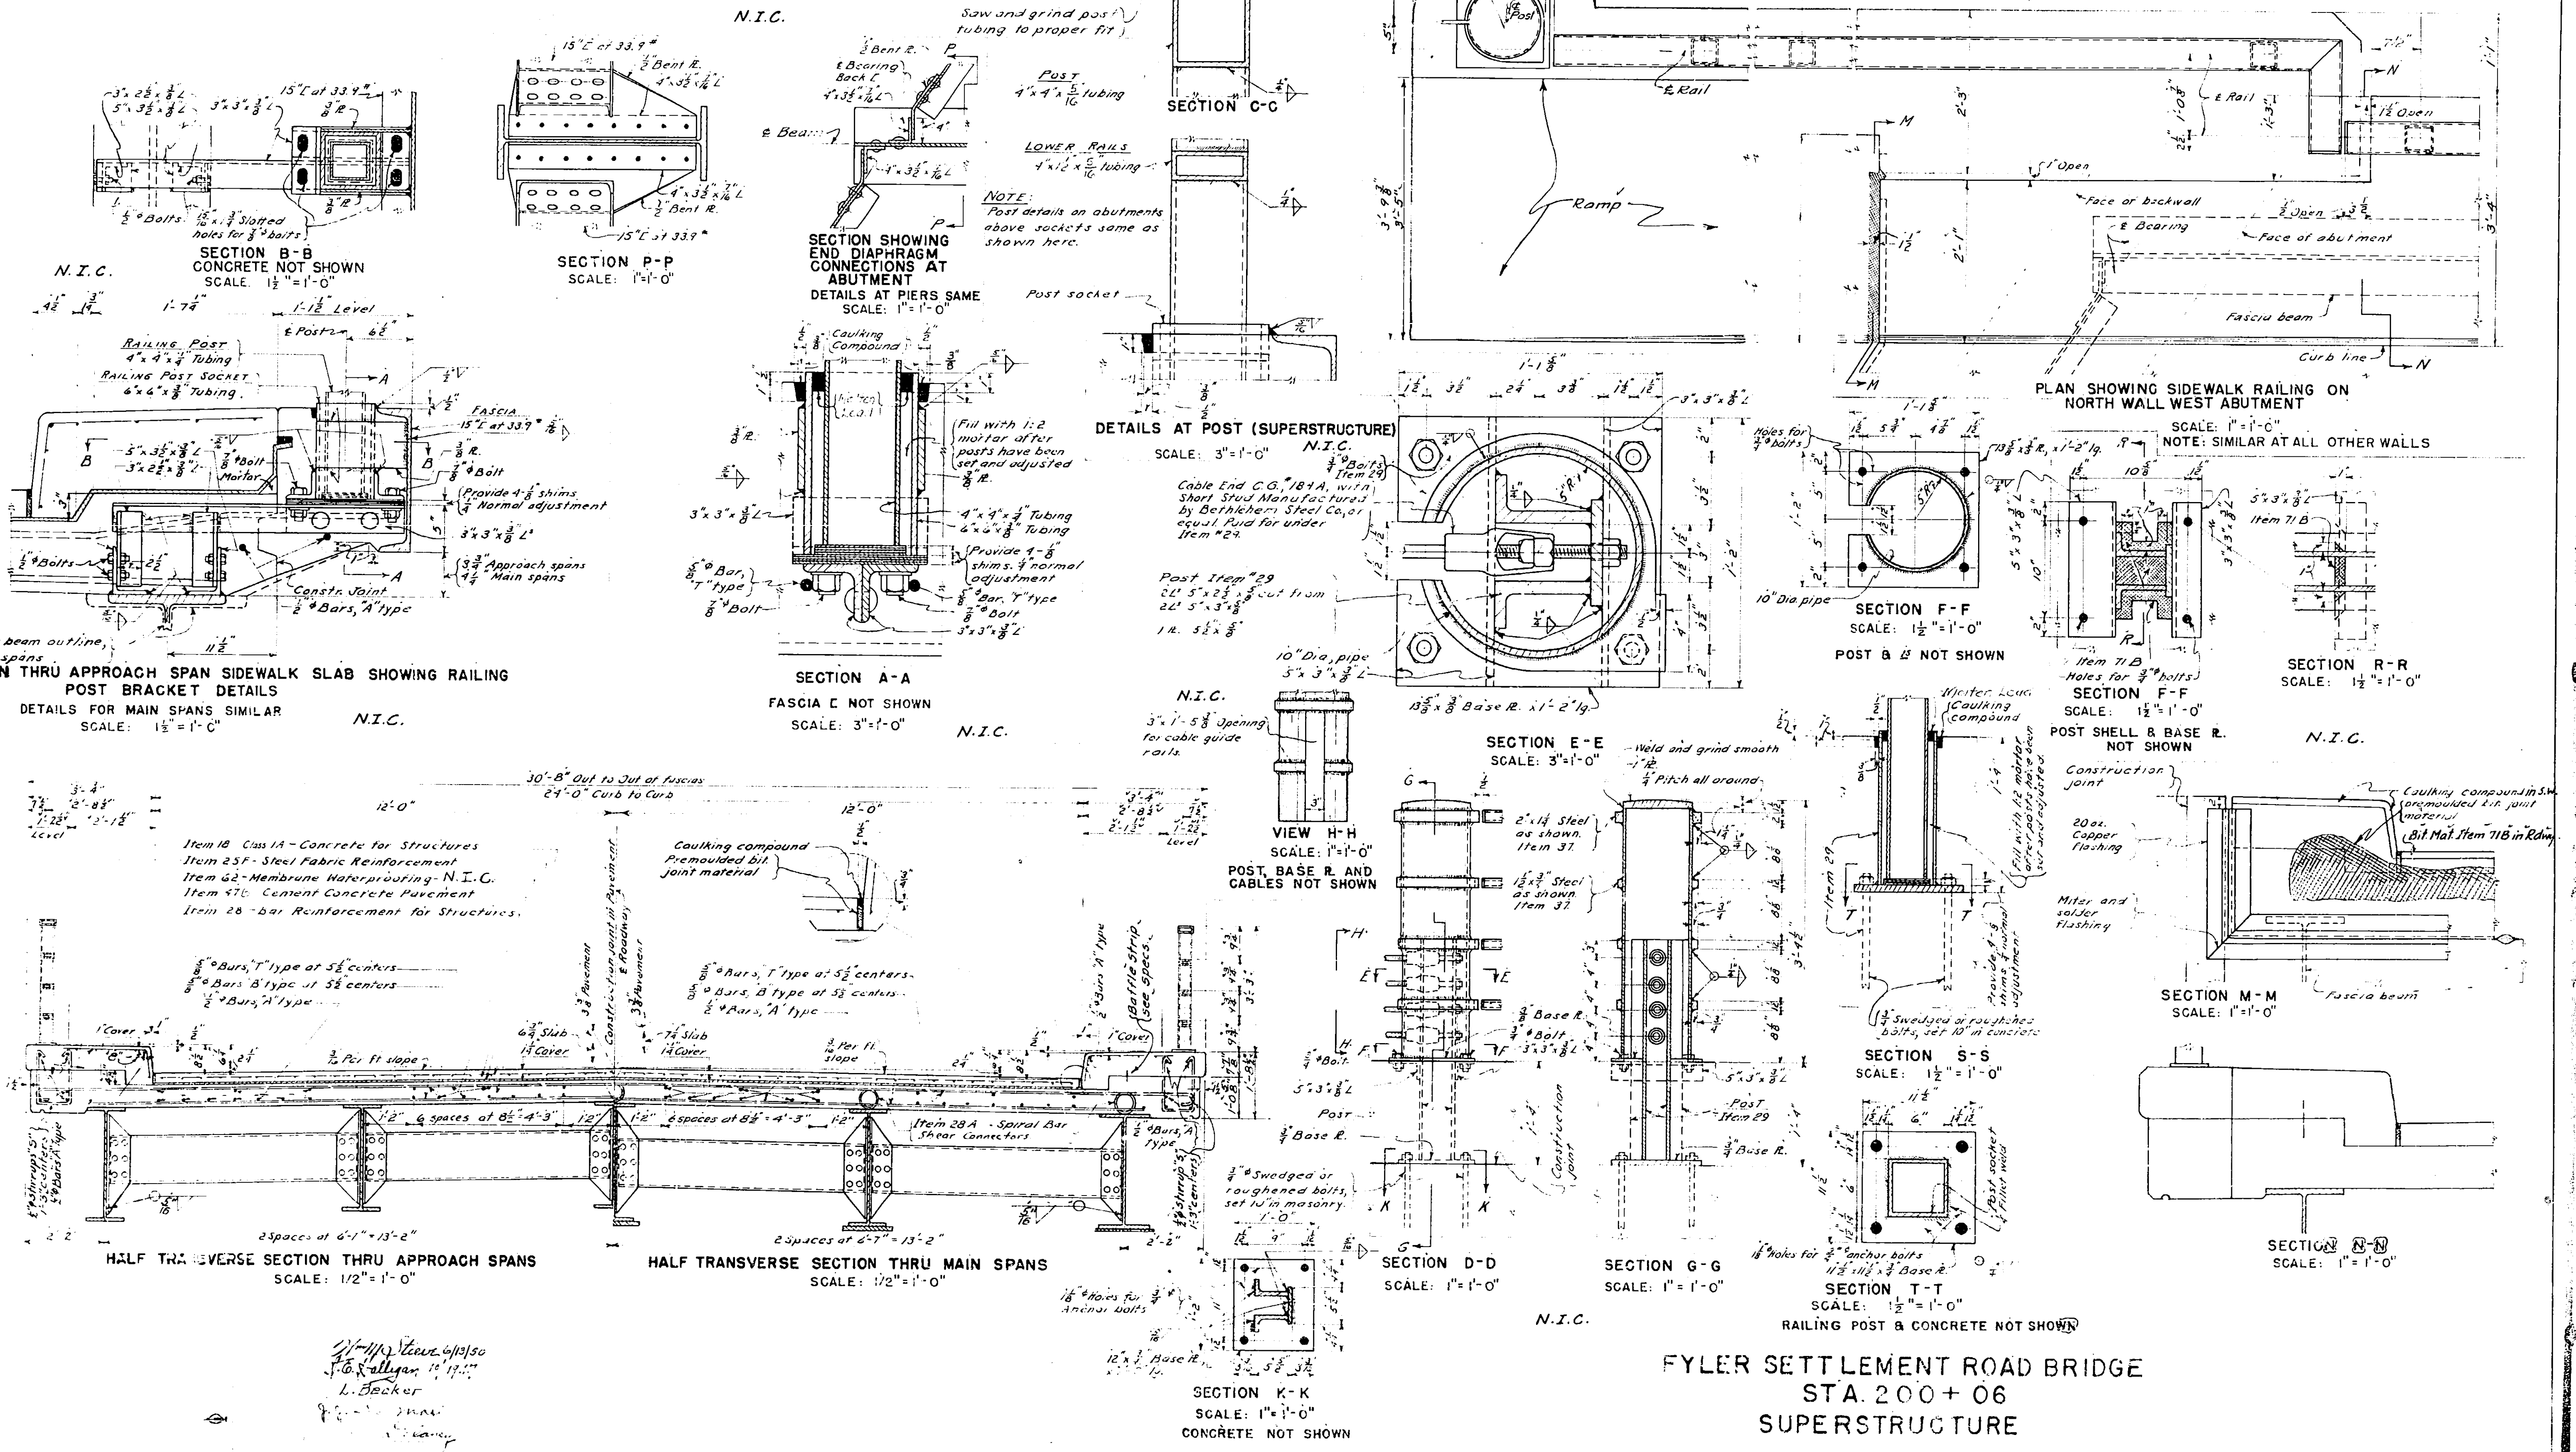

FYLER SETTLEMENT ROAD BRIDGE
STA. 200+06
SUPERSTRUCTURE

FED. AID DIST. NO.	STATE	FED. AID PROJ. NO.	FISCAL YEAR	SHEET NO.	TOTAL SHEETS
	N.Y.			19	67
MOHAWK THRUWAY					
FROM TO					
MADISON COUNTY					

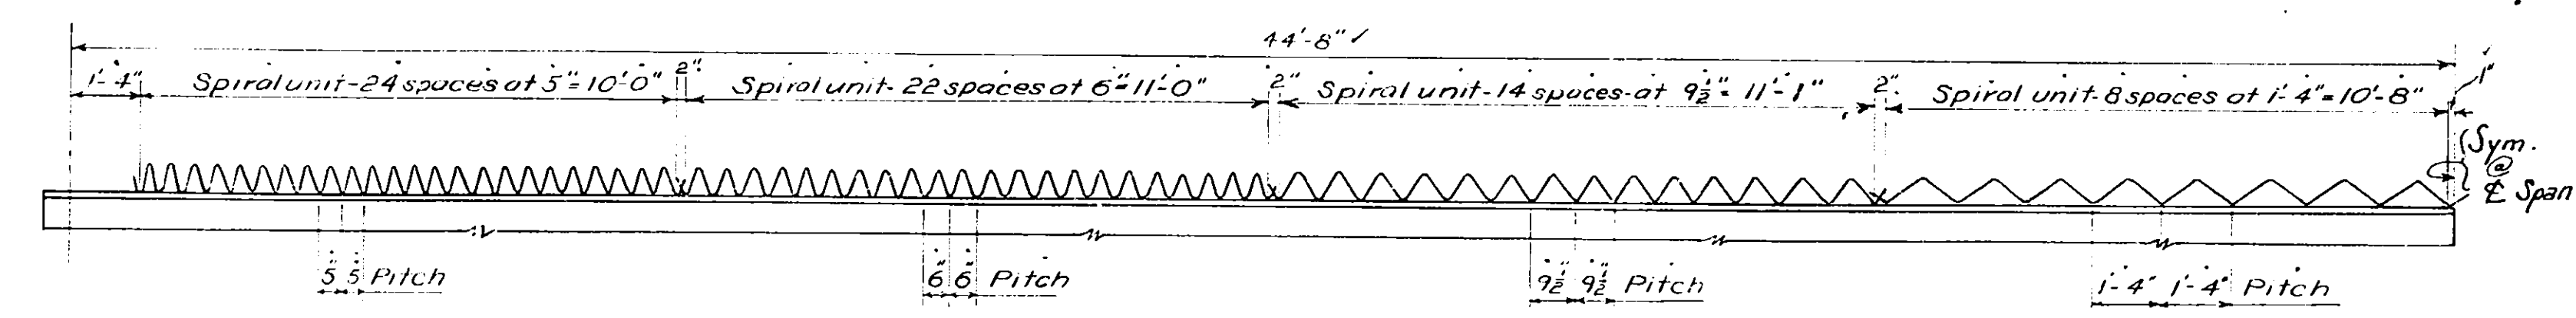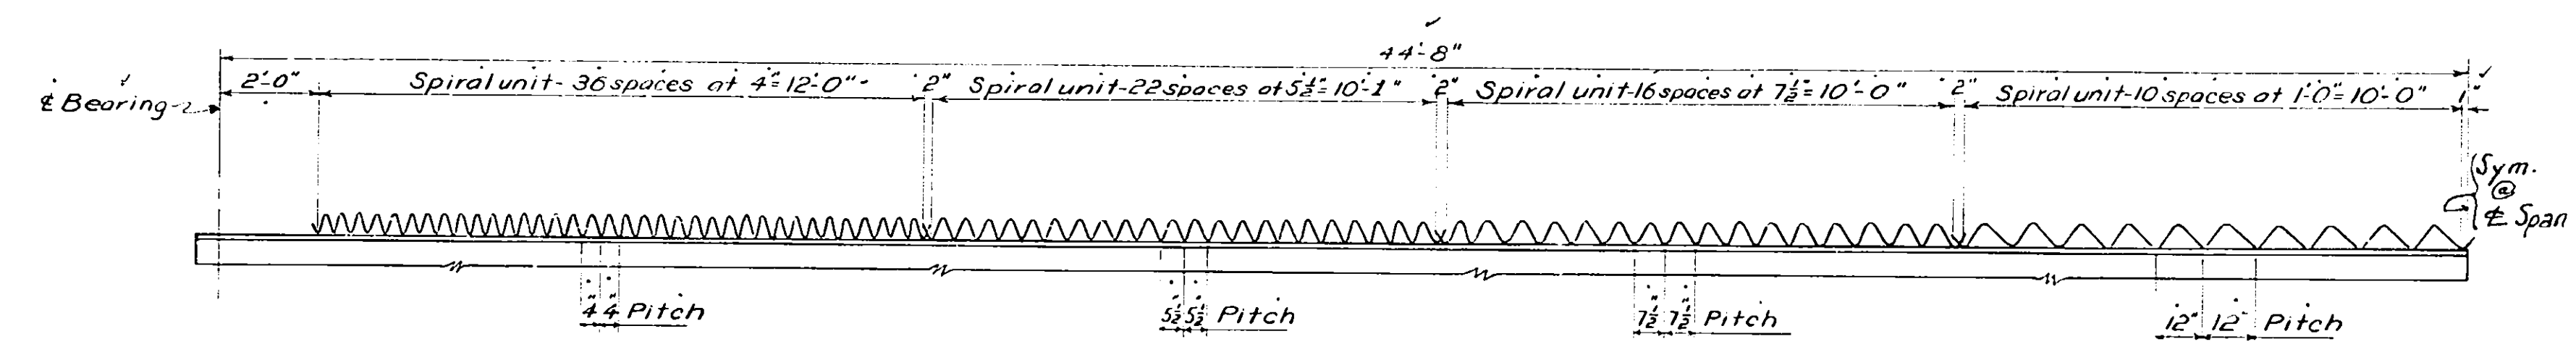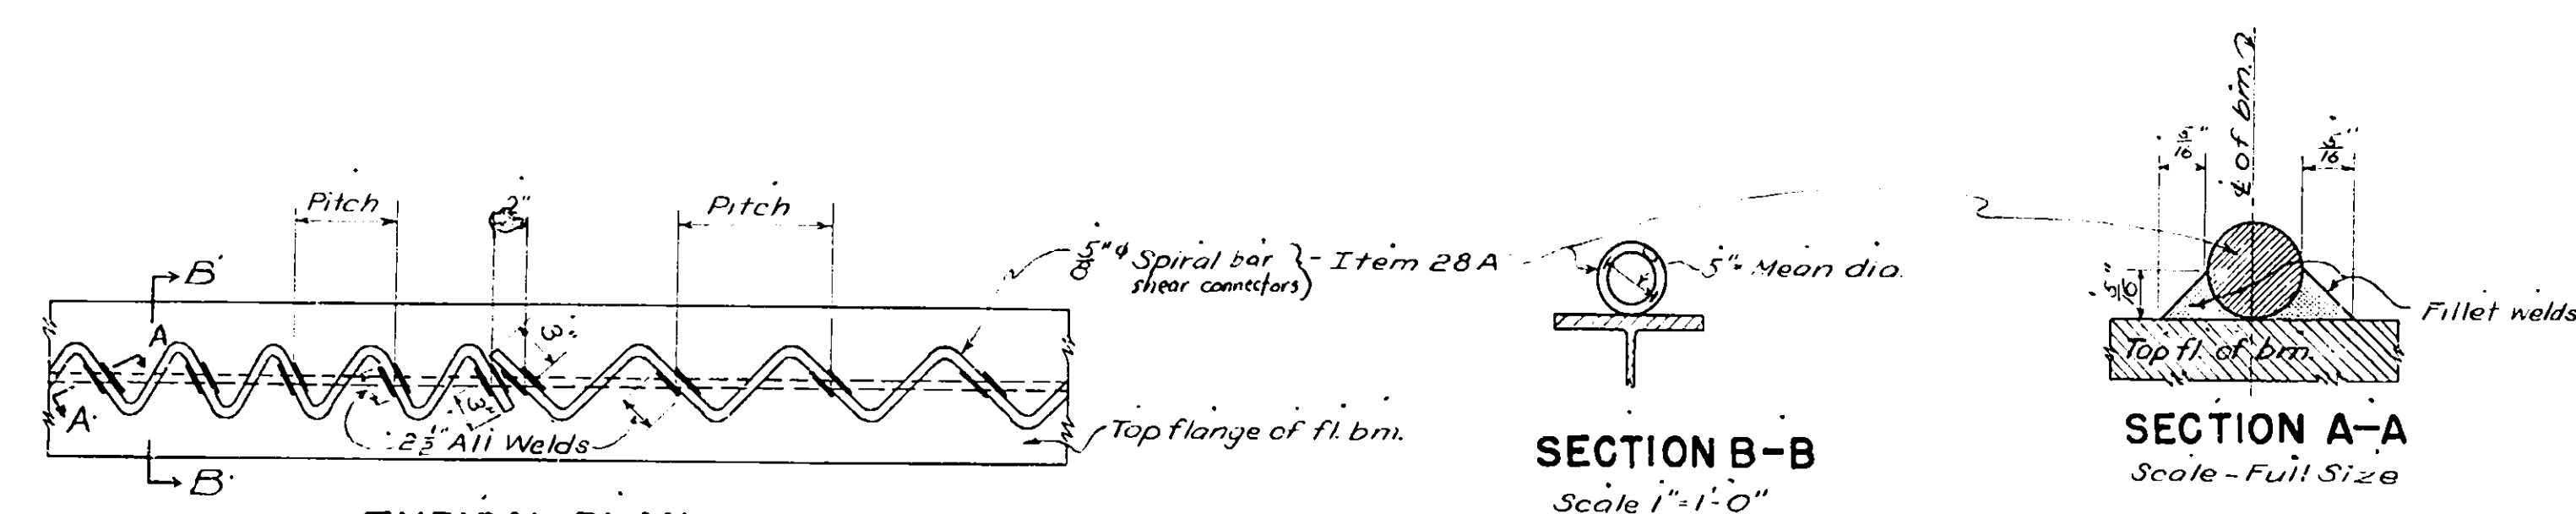

NOTES FOR SUPERSTRUCTURE

No construction joints other than those shown on the plans will be permitted without written permission of the Deputy Chief Engineer, Bridges.

The cost of furnishing and installing joint material, including elastic cement, Lead Wool, Caulking compound, pre-moulded bituminous joint material, bituminous material Item 71B, sponge rubber joint material and copper flashing, shall be included in the price bid for Item 15 class 1A.

Reinforcing bars may be spliced at places approved by the Engineer. Bars so spliced shall be lapped at least .45 diameters.

Rivets 3/8" open holes 1/2" unless otherwise noted.

Shoppaint, red lead and oil. First field coat to be per specification. Second field coat to be per specifications.

Railing, railing posts will be paid for under Item 37.

Shims and anchor bolts will be paid for under Item 29.

Designing and detailing have been done in accordance with the A.A.S.H.O. Specifications 1944 For Highway Bridges.

Material and fabrication are in accordance with "Public Works Specifications" of January 2, 1931 and current modifications.

This structure has been designed for a series of H 20-44 trucks in each traffic lane. Dimensions and distribution as specified in the A.A.S.H.O., 1944 Specifications. Trucks spaced 30'-0" apart between adjacent axles.

Camber Int. and fascia bms. main and approach spans for dead load deflection and Vert. Curve.

Main Span { Camber Interm. Bm. 4 3/4" } Approach Span { Camber Interm. Bm. 1" }
 { Camber Fascia Bm. 4 3/4" } { Camber Fascia Bm. 1" }

Thickness of cement concrete pavement and concrete curbs may be varied slightly as directed by the Engineer in the field in order to conform to the roadway grade, but a 3/8" minimum thickness of pavement must be maintained.


N.I.C. means not in this contract.

Electrodes of AWS. Class E 6015 or E 6016 shall be used for welding steel exceeding 1" in thickness.

Wm. S. Kiser 6/13/50
 H.E. Halligan Oct. 1947
 L. Becker
 K.C. Halligan
 H.E. Halligan


FYLER SETTLEMENT ROAD BRIDGE
 STA. 200 + 06
 SUPERSTRUCTURE

FED AID DIST NO	STATE	FED AID PROJ NO	FISCAL YEAR	SHEET NO	TOTAL SHEETS
	N.Y.			20	67
MOHAWK THRUWAY					
FROM TO					
MADISON COUNTY					

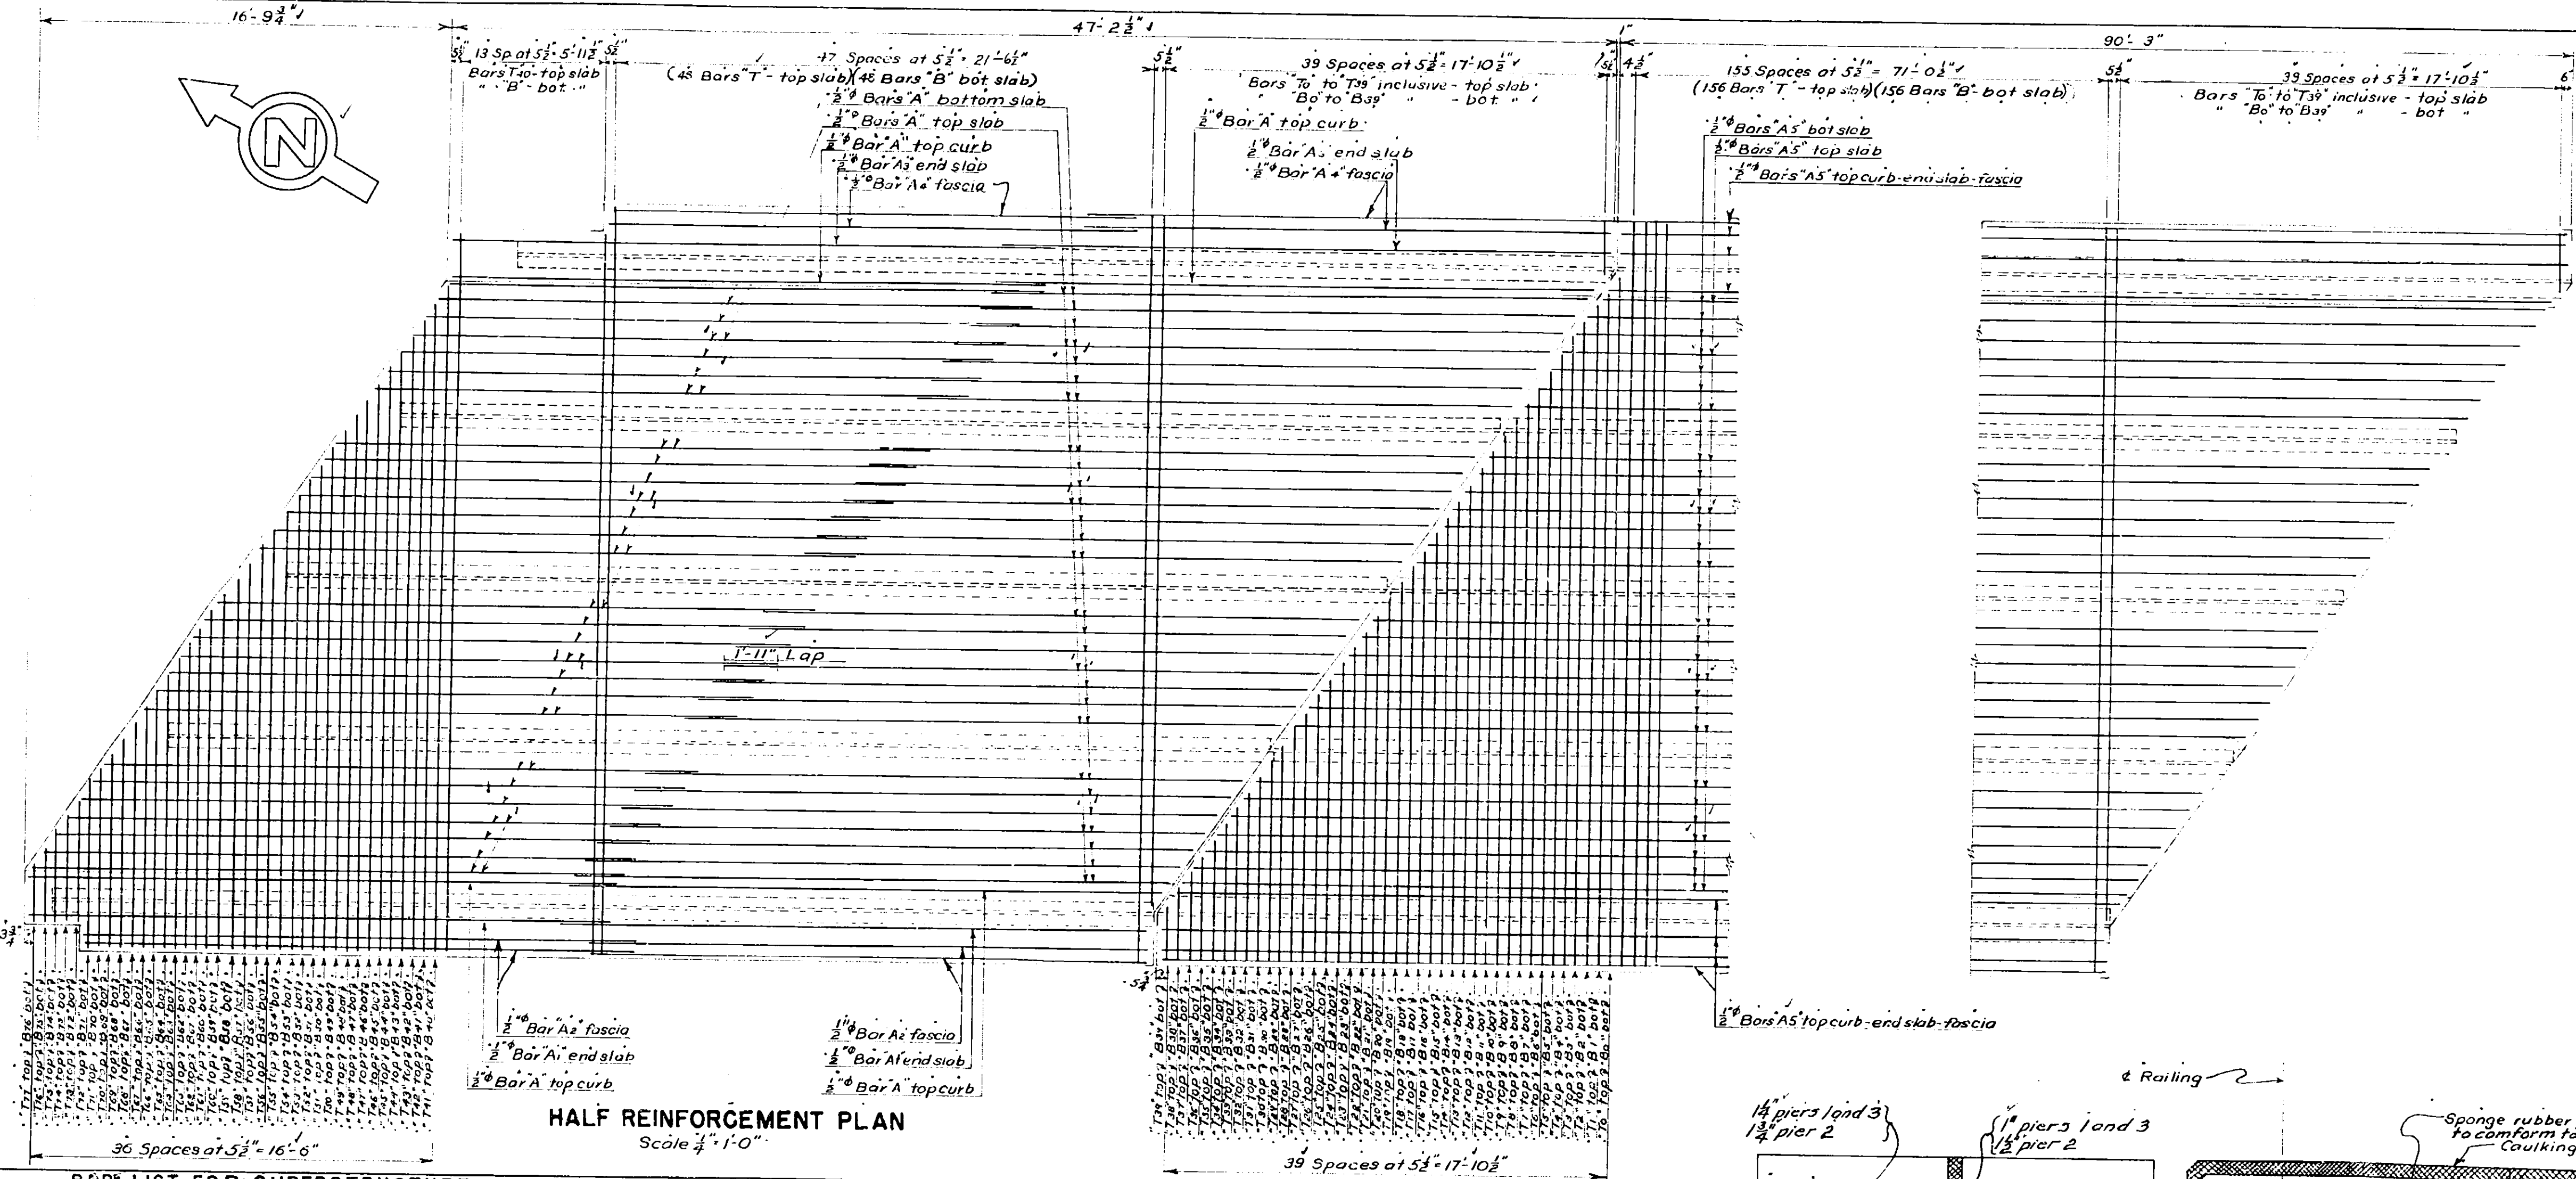


HALF REINFORCEMENT PLAN
Scale 1/2" = 1'-0"


BAR LIST FOR SUPERSTRUCTURE											
Mark	Size	No.	Length	A'	Description & Location	Mark	Size	No.	Length	A'	Description & Location
T1	6	408	31'-4"		Transverse main bars-top	T11	6	8'-0"	7'-2"		Transverse main bars-top
T2	6	28'-3"	27'-5"		Transverse main bars-top	T12	6	7'-4"	6'-6"		Transverse main bars-top
T3	6	27'-8"	26'-10"		Transverse main bars-top	T13	6	6'-8"	5'-10"		Transverse main bars-top
T4	6	27'-0"	26'-2"		Transverse main bars-top	T14	6	6'-0"	5'-2"		Transverse main bars-top
T5	6	26'-4"	25'-6"		Transverse main bars-top	T15	6	5'-5"	4'-7"		Transverse main bars-top
T6	6	25'-8"	24'-10"		Transverse main bars-top	T16	6	4'-9"	3'-11"		Transverse main bars-top
T7	6	25'-0"	24'-2"		Transverse main bars-top	T17	6	4'-1"	3'-3"		Transverse main bars-top
T8	6	24'-4"	23'-6"		Transverse main bars-top	T18	6	3'-5"	2'-7"		Transverse main bars-top
T9	6	23'-9"	22'-11"		Transverse main bars-top	T19	6	2'-9"	1'-11"		Transverse main bars-top
T10	6	23'-1"	22'-3"		Transverse main bars-top	T20	20	29'-7"	28'-9"		Longitudinal main bars
T11	6	22'-5"	21'-7"		Transverse main bars-top	T21	20	27'-4"	26'-6"		Longitudinal main bars
T12	6	21'-9"	20'-11"		Transverse main bars-top	T22	20	26'-8"	25'-10"		Longitudinal main bars
T13	6	21'-1"	20'-3"		Transverse main bars-top	T23	20	26'-0"	25'-2"		Longitudinal main bars
T14	6	20'-5"	19'-7"		Transverse main bars-top	T24	20	25'-4"	24'-6"		Longitudinal main bars
T15	6	19'-9"	18'-11"		Transverse main bars-top	T25	20	24'-8"	23'-10"		Longitudinal main bars
T16	6	19'-1"	18'-3"		Transverse main bars-top	T26	20	24'-0"	23'-2"		Longitudinal main bars
T17	6	18'-5"	17'-7"		Transverse main bars-top	T27	20	23'-4"	22'-6"		Longitudinal main bars
T18	6	17'-9"	17'-0"		Transverse main bars-top	T28	20	22'-8"	21'-10"		Longitudinal main bars
T19	6	17'-1"	16'-3"		Transverse main bars-top	T29	20	22'-0"	21'-2"		Longitudinal main bars
T20	6	16'-5"	15'-7"		Transverse main bars-top	T30	20	21'-4"	20'-6"		Longitudinal main bars
T21	6	15'-9"	15'-0"		Transverse main bars-top	T31	20	20'-8"	19'-10"		Longitudinal main bars
T22	6	15'-1"	14'-3"		Transverse main bars-top	T32	20	20'-0"	19'-2"		Longitudinal main bars
T23	6	14'-5"	13'-7"		Transverse main bars-top	T33	20	19'-4"	18'-6"		Longitudinal main bars
T24	6	13'-9"	13'-0"		Transverse main bars-top	T34	20	18'-8"	17'-10"		Longitudinal main bars
T25	6	13'-1"	12'-3"		Transverse main bars-top	T35	20	18'-0"	17'-2"		Longitudinal main bars
T26	6	12'-5"	11'-7"		Transverse main bars-top	T36	20	17'-4"	16'-6"		Longitudinal main bars
T27	6	11'-9"	11'-0"		Transverse main bars-top	T37	20	16'-8"	15'-10"		Longitudinal main bars
T28	6	11'-1"	10'-3"		Transverse main bars-top	T38	20	16'-0"	15'-2"		Longitudinal main bars
T29	6	10'-5"	9'-7"		Transverse main bars-top	T39	20	15'-4"	14'-6"		Longitudinal main bars
T30	6	9'-9"	9'-0"		Transverse main bars-top	T40	20	14'-8"	13'-10"		Longitudinal main bars
T31	6	8'-1"	7'-3"		Transverse main bars-top	T41	20	14'-0"	13'-2"		Longitudinal main bars
T32	6	7'-5"	6'-7"		Transverse main bars-top	T42	20	13'-4"	12'-6"		Longitudinal main bars
T33	6	6'-9"	6'-0"		Transverse main bars-top	T43	20	12'-8"	11'-10"		Longitudinal main bars
T34	6	6'-1"	5'-3"		Transverse main bars-top	T44	20	12'-0"	11'-2"		Longitudinal main bars
T35	6	5'-5"	4'-7"		Transverse main bars-top	T45	20	11'-4"	10'-6"		Longitudinal main bars
T36	6	4'-9"	4'-0"		Transverse main bars-top	T46	20	10'-8"	9'-10"		Longitudinal main bars
T37	6	4'-1"	3'-3"		Transverse main bars-top	T47	20	10'-0"	9'-2"		Longitudinal main bars
T38	6	3'-5"	2'-7"		Transverse main bars-top	T48	20	9'-4"	8'-6"		Longitudinal main bars
T39	6	2'-9"	1'-11"		Transverse main bars-top	T49	20	8'-8"	7'-10"		Longitudinal main bars
T40	20	29'-7"	28'-9"		Longitudinal main bars	T50	20	8'-0"	7'-2"		Longitudinal main bars
T41	20	27'-4"	26'-6"		Longitudinal main bars	T51	20	7'-4"	6'-6"		Longitudinal main bars
T42	20	26'-8"	25'-10"		Longitudinal main bars	T52	20	6'-8"	5'-10"		Longitudinal main bars
T43	20	26'-0"	25'-2"		Longitudinal main bars	T53	20	6'-0"	5'-2"		Longitudinal main bars
T44	20	25'-4"	24'-6"		Longitudinal main bars	T54	20	5'-4"	4'-6"		Longitudinal main bars
T45	20	24'-8"	23'-10"		Longitudinal main bars	T55	20	4'-8"	3'-10"		Longitudinal main bars
T46	20	24'-0"	23'-2"		Longitudinal main bars	T56	20	4'-0"	3'-2"		Longitudinal main bars
T47	20	23'-4"	22'-6"		Longitudinal main bars	T57	20	3'-4"	2'-6"		Longitudinal main bars
T48	20	22'-8"	21'-10"		Longitudinal main bars	T58	20	2'-8"	1'-10"		Longitudinal main bars
T49	20	22'-0"	21'-2"		Longitudinal main bars	T59	20	2'-0"	1'-2"		Longitudinal main bars
T50	20	21'-4"	20'-6"		Longitudinal main bars	T60	20	1'-4"	0'-6"		Longitudinal main bars
T51	20	20'-8"	19'-10"		Longitudinal main bars	T61	20	0'-8"	0'-0"		Longitudinal main bars
T52	20	20'-0"	19'-2"		Longitudinal main bars	T62	20	0'-0"	0'-0"		Longitudinal main bars
T53	20	19'-4"	18'-6"		Longitudinal main bars	T63	20	0'-0"	0'-0"		Longitudinal main bars
T54	20	18'-8"	17'-10"		Longitudinal main bars	T64	20	0'-0"	0'-0"		Longitudinal main bars
T55	20	18'-0"	17'-2"		Longitudinal main bars	T65	20	0'-0"	0'-0"		Longitudinal main bars
T56	20	17'-4"	16'-6"		Longitudinal main bars	T66	20	0'-0"	0'-0"		Longitudinal main bars
T57	20	16'-8"	15'-10"		Longitudinal main bars	T67	20	0'-0"	0'-0"		Longitudinal main bars
T58	20	16'-0"	15'-2"		Longitudinal main bars	T68	20	0'-0"	0'-0"		Longitudinal main bars
T59	20	15'-4"	14'-6"		Longitudinal main bars	T69	20	0'-0"	0'-0"		Longitudinal main bars
T60	20	14'-8"	13'-10"		Longitudinal main bars	T70	20	0'-0"	0'-0"		Longitudinal main bars
T61	20	14'-0"	13'-2"		Longitudinal main bars	T71	20	0'-0"	0'-0"		Longitudinal main bars
T62	20	13'-4"	12'-6"		Longitudinal main bars	T72	20	0'-0"	0'-0"		Longitudinal main bars
T63	20	12'-8"	11'-10"		Longitudinal main bars	T73	20	0'-0"	0'-0"		Longitudinal main bars
T64	20	12'-0"	11'-2"		Longitudinal main bars	T74	20	0'-0"	0'-0"		Longitudinal main bars
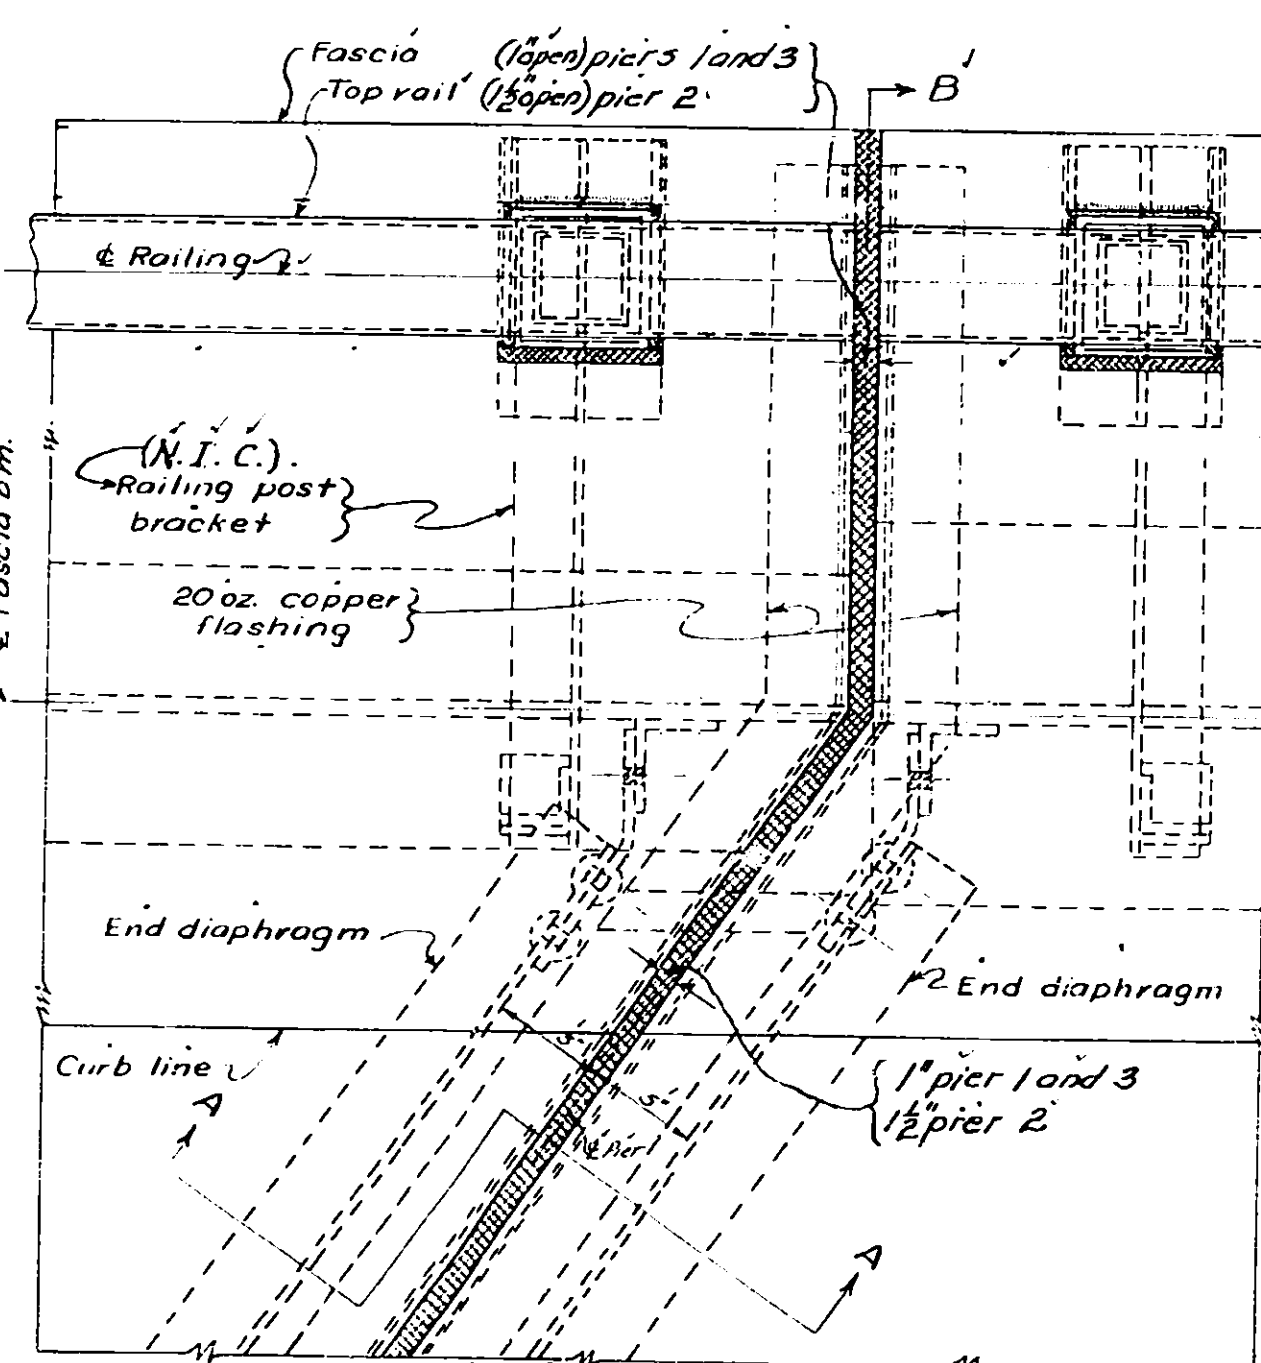

PLAN AT PIER NO. 1 (Piers 2 & 3 Similar)
Scale 1/2" = 1'-0"

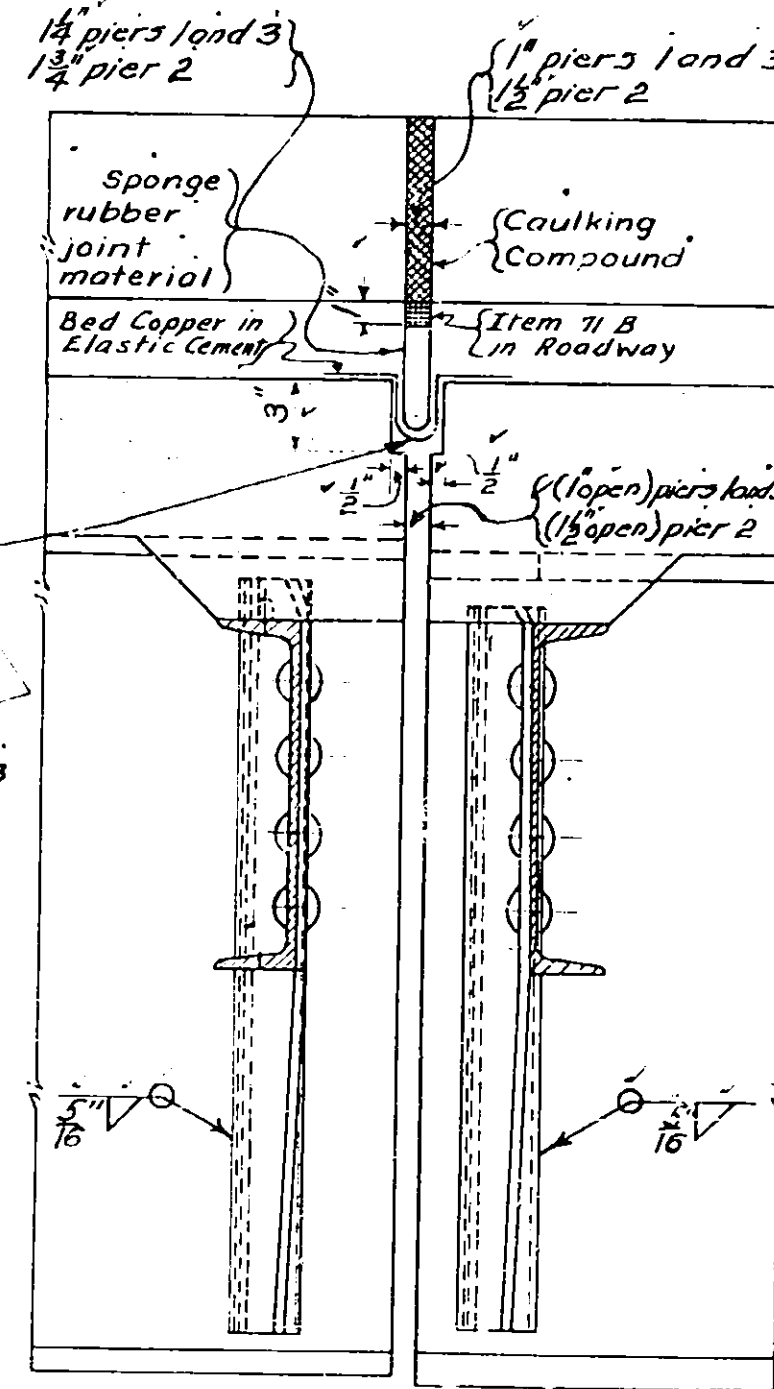

SECTION A-A
Scale 1/2" = 1'-0"

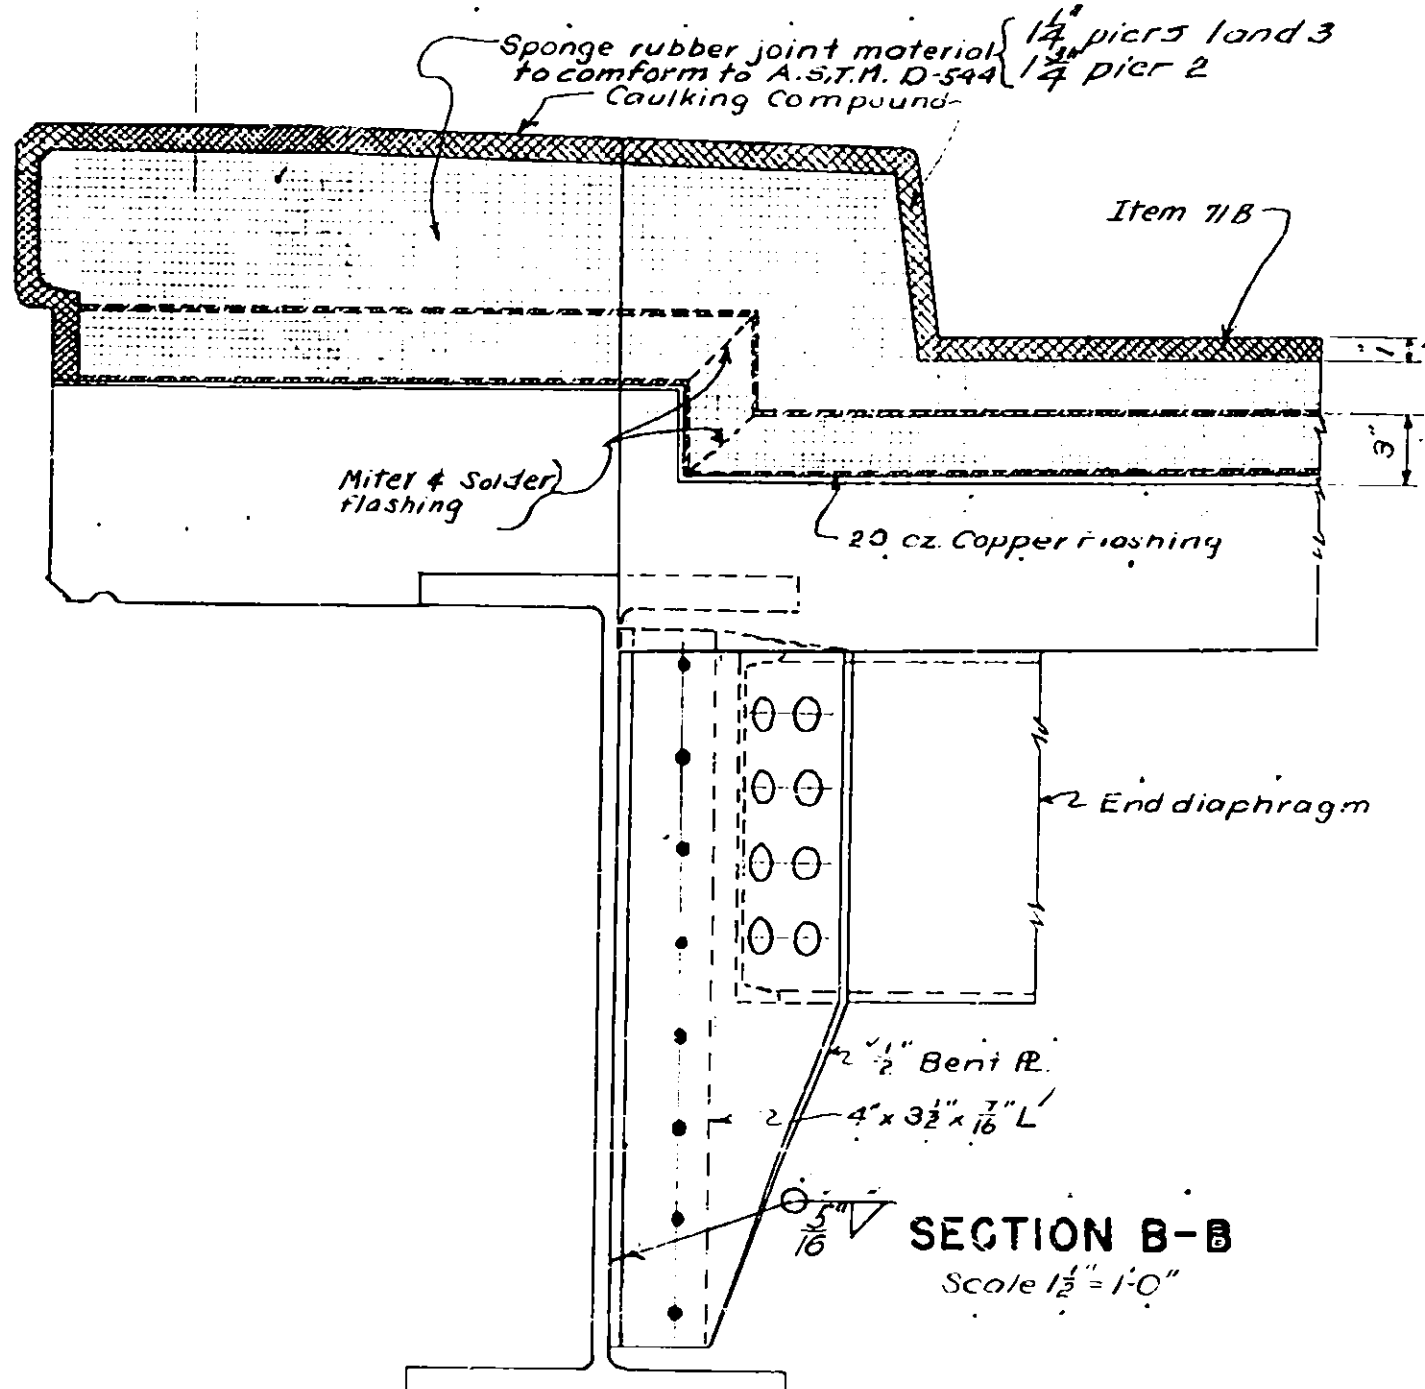

SECTION B-B
Scale 1/2" = 1'-0"

Dr. M. J. Stevens, Jr.
A.E. Sullivan, Jr.
L. Becker

FYLER SETTLEMENT ROAD BRIDGE
STA. 200+06
SUPERSTRUCTURE BAR PLAN

Fed Rd. Dist. No.	State	Fed Aid Proj. No.	County	Sheet No.	Total Sheets
	N.Y.		Madison	21	67
Mohawk Thruway N. Marius - N. Chittenango Fyler Settlement Road					

In general 1 on 4 slopes are provided for fills under 10 feet. Slopes shall be as shown on cross-sections or as ordered by Engineer.

Slopes outside of roadway adjacent to ends of cuts and fills to be flattened and warped as ordered by the Engineer.

At intervals of 100 ft. or at such intervals as the Engineer may direct, lateral trenches or weep holes four feet in width shall be opened up thru the shoulders to the ditches to effectively drain the subgrade before the pavement is constructed. These shall be filled with Item 41B7, Found Course, *Broken Stone* and the excavation will be paid for under Item 2B, Unclassified Excavation.


Maintenance and Protection of Traffic

The contractor shall maintain and protect traffic in accordance with Item No. 76 for the duration of the contract within the limits of the Fyler Settlement Road for the entire length of the contract; also within the limits of the Thruway and any and all intersecting roads so far as the limits of work extend.

Signs shall be erected in accordance with Standard Structure Sheet No. 49-42 on both the Thruway and Fyler Settlement Road.

Any traffic required to use the Thruway shall be so routed that movement will be only in same direction as Thruway traffic.

Second Class Embankment shall be used between the lines indicated if ordered by the Engineer. Second Class Embankment is material stripped from cuts and under embankments as ordered, but shall not include stumps, logs, brush nor other objectionable material.

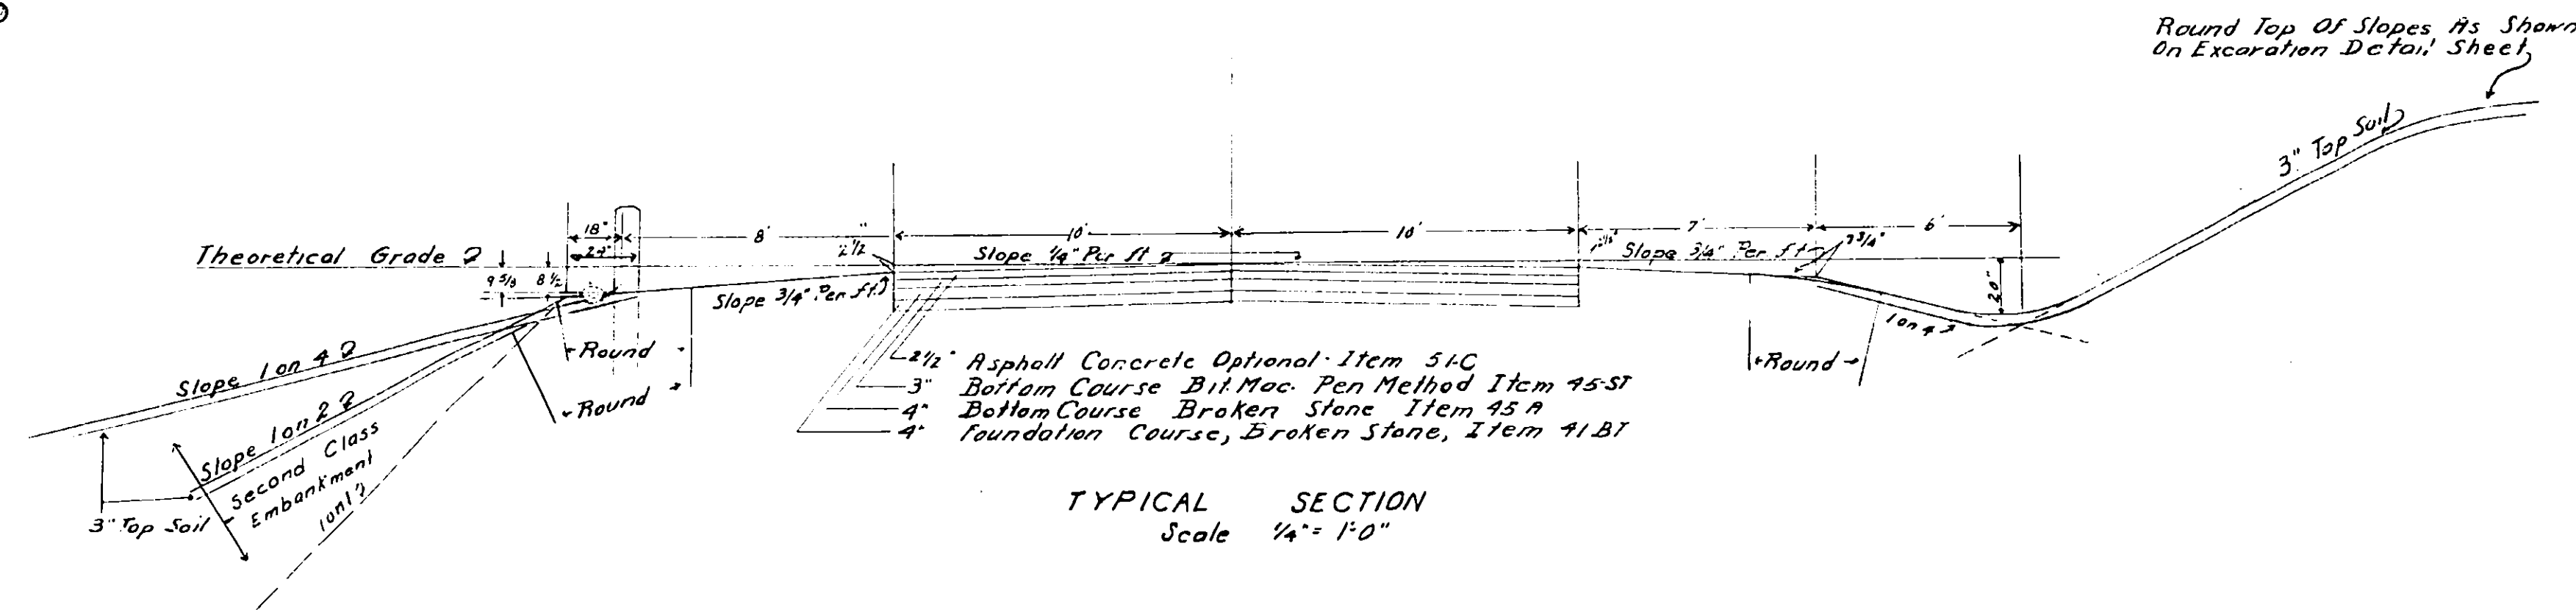


Item 2B UNCLASSIFIED EXCAVATION	
From	Cu. Yds.
Road Excavation	2902
Borrow	11690
Sod	100
Drainage Structures	5
Ditch Thruway Wall	100
Benching	1370
Removing Temp. Intersection	640
Estimate	1793
TOTAL	16500

Item 320 CABLE GUIDE RAILING, OPTIONAL				
Station	Station	Side	Anchors	Lin. Ft.
E 8+52	E 12+52	L	1	400
E 8+36	E 12+36	R	1	400
E 15+56	E 22+56	L	3	700
E 15+34	E 22+54	R	3	720
				2220
8 Anchors @ 20'				= 160
Estimate				40
TOTAL				2420

TABLE		of	LENGTHS		B R I D G E	
Station to	Station		R O A D			
			Lin. Ft.	Miles	Lin. Ft.	Miles
E 2+00	E 12+56.23		1056.23	0.200		
E 12+56.23	E 15+29.77				273.54	0.052
E 15+29.77	E 35+14		1984.23	0.376		
			3040.46	0.576	273.54	0.052
			273.54	0.052		
	TOTAL		3314.00	0.628		

Item 5 - TRENCH, CULVERT and BRIDGE EXCAVATION	
From	Cu. Yds.
Drainage Sheet	276
Estimate	24
TOTAL	300

DRAINAGE STRUCTURES			REMARKS
Present Structure	Station		
None	E 7+00		Relay 44' of R.C.C.P. from Sta. G 0+74 $\frac{1}{2}$ and extend with 4' of 18" S.R.C.P.
24" S.R.C. Pipe Culv.	E 30+50		Lengthen 4' on Rt. with 24" R.C.C.P. with standard conc. connection and headwall I.O.B.E.
18" S.R.C. Pipe Culv.	G 0+74		Remove and relay at Sta. E 7+00.
None	E 29+65		Build new 18" R.C.C.P. Culv. under gravel drive on left 28" long I.O.B.E.
24" R.C.C.P. 76' long	E 14+00		Remove existing 24" R.C.C.P. on right and store within R.P.W.
24" R.C.C.P. 80' long	E 15+25		Remove existing 24" R.C.C.P. on right and store within R.P.W.

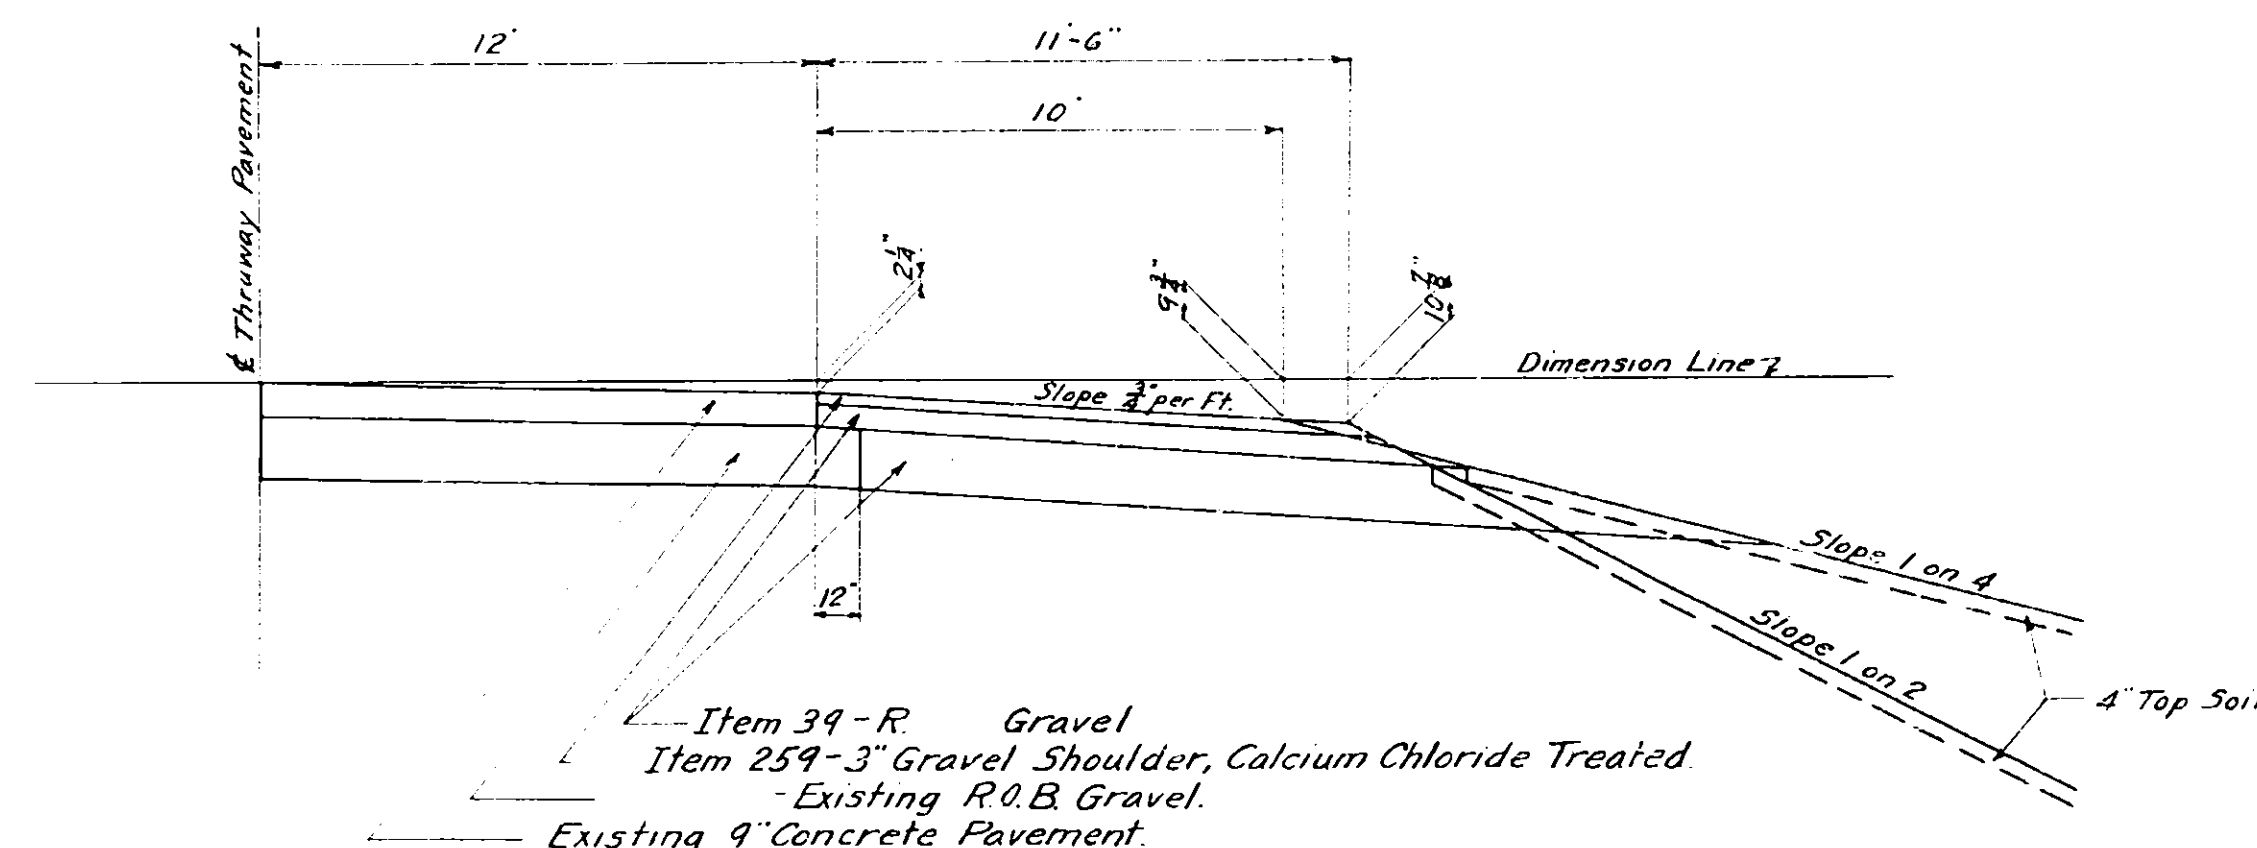


PART SECTION OF THRUWAY
SHOWING SHOULDER TO BE BUILT AFTER
REMOVAL OF TEMPORARY INTERSECTION

Prepared Pursuant To The Highway Law & Recommended by

 Nancy Williams

Date Engineer District No 2

Made by Tracy Checked by C. J. J. J.
J. F. Chambliss & Son

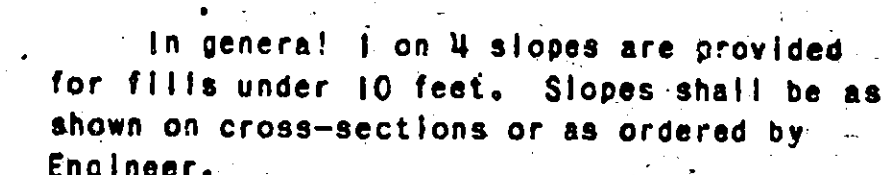

Slopes outside of roadway adjacent to ends of cuts and fills to be flattened and warped as ordered by the Engineer.

At intervals of 100 ft.

lateral trenches or weep holes four feet in width, ~~was~~ opened up thru the shoulders to the ditches to effectively drain the subgrade before the pavement is constructed. These ~~were~~ filled with Item 41BT, Found Course, *Broken Stone* and the excavation ~~was~~ paid for under Item 28, *Unclassified Excavation*.

Maintenance and Protection of Traffic

The contractor shall maintain and protect traffic in accordance with Item No. 78 for the duration of the contract within the limits of the Fyler Settlement Road for the entire length of the contract; also within the limits of the Thruway; and any and all interesting roads so far as the limits of work extend.

Signs shall be erected in accordance with Standard Structure Sheet No. 40-43 on both the Thruway and *Fyler Settlement Road.*

Any traffic required to use the Thruway shall be so routed that movement will be only in same direction as Thruway traffic.

Second Class Embankment shall be used between the lines indicated by the Engineer. Second Class embankment is material stripped from cuts and under embankments as ordered, but shall not include stumps, logs, brush nor other objectionable material.

Item 2B UNCLASSIFIED EXCAVATION

From	Cu. Yds.
Road Excavation	74.10
Borrow	0.7
Sod	

Removing Temp. Interaction Estimate

TOTAL

Item 320 CABLE GUIDE RAILING, OPTIONAL

Station to	Station	Side	Anchors	Lin. Ft.
E 12+18	E 12+52	R		34
E 12+27	E 12+36			9
E 15+58	E 12+34	L		324
E 15+34	E 12+12	R		22
E 12+45	E 21+45			

B Anchors # 20

TOTAL

TABLE of		LENGTHS		B R I D G E	
Station to	Station	Lin. Ft.	Miles	Lin. Ft.	Miles
E 2+00	E 12+56.23	105			
E 12+56.23	E 15+29.77			273.5	0.052
E 15+29.77	E 33+14	104			
		3040	0.57	273.5	0.052
		273	0.052		
		3314	0.6		
TOTAL					

Item 5 - TRENCH, CULVERT and BRIDGE EXCAVATION

From Cu, Yds.

TOTAL

DRAINAGE STRUCTURES

Present Structure
None

Station
E 7:00

REMARKS

24" S.R.C. Pipe Cslv. E 30+50

18th S.R.C. Pipe Culv. 6 0+74


2048

24- R.C.C.F. E 14+00

24th R.C.C.P. E 15+25

Remove
Bull. new 18" R.C.C.P. Culv. under gravel, 18" on left 28" long

45. Built
PART SECTION OF THRUWAY
SHOWING SHOULDER BUILT AFTER
REMOVAL OF TEMPORARY INTERSECTION

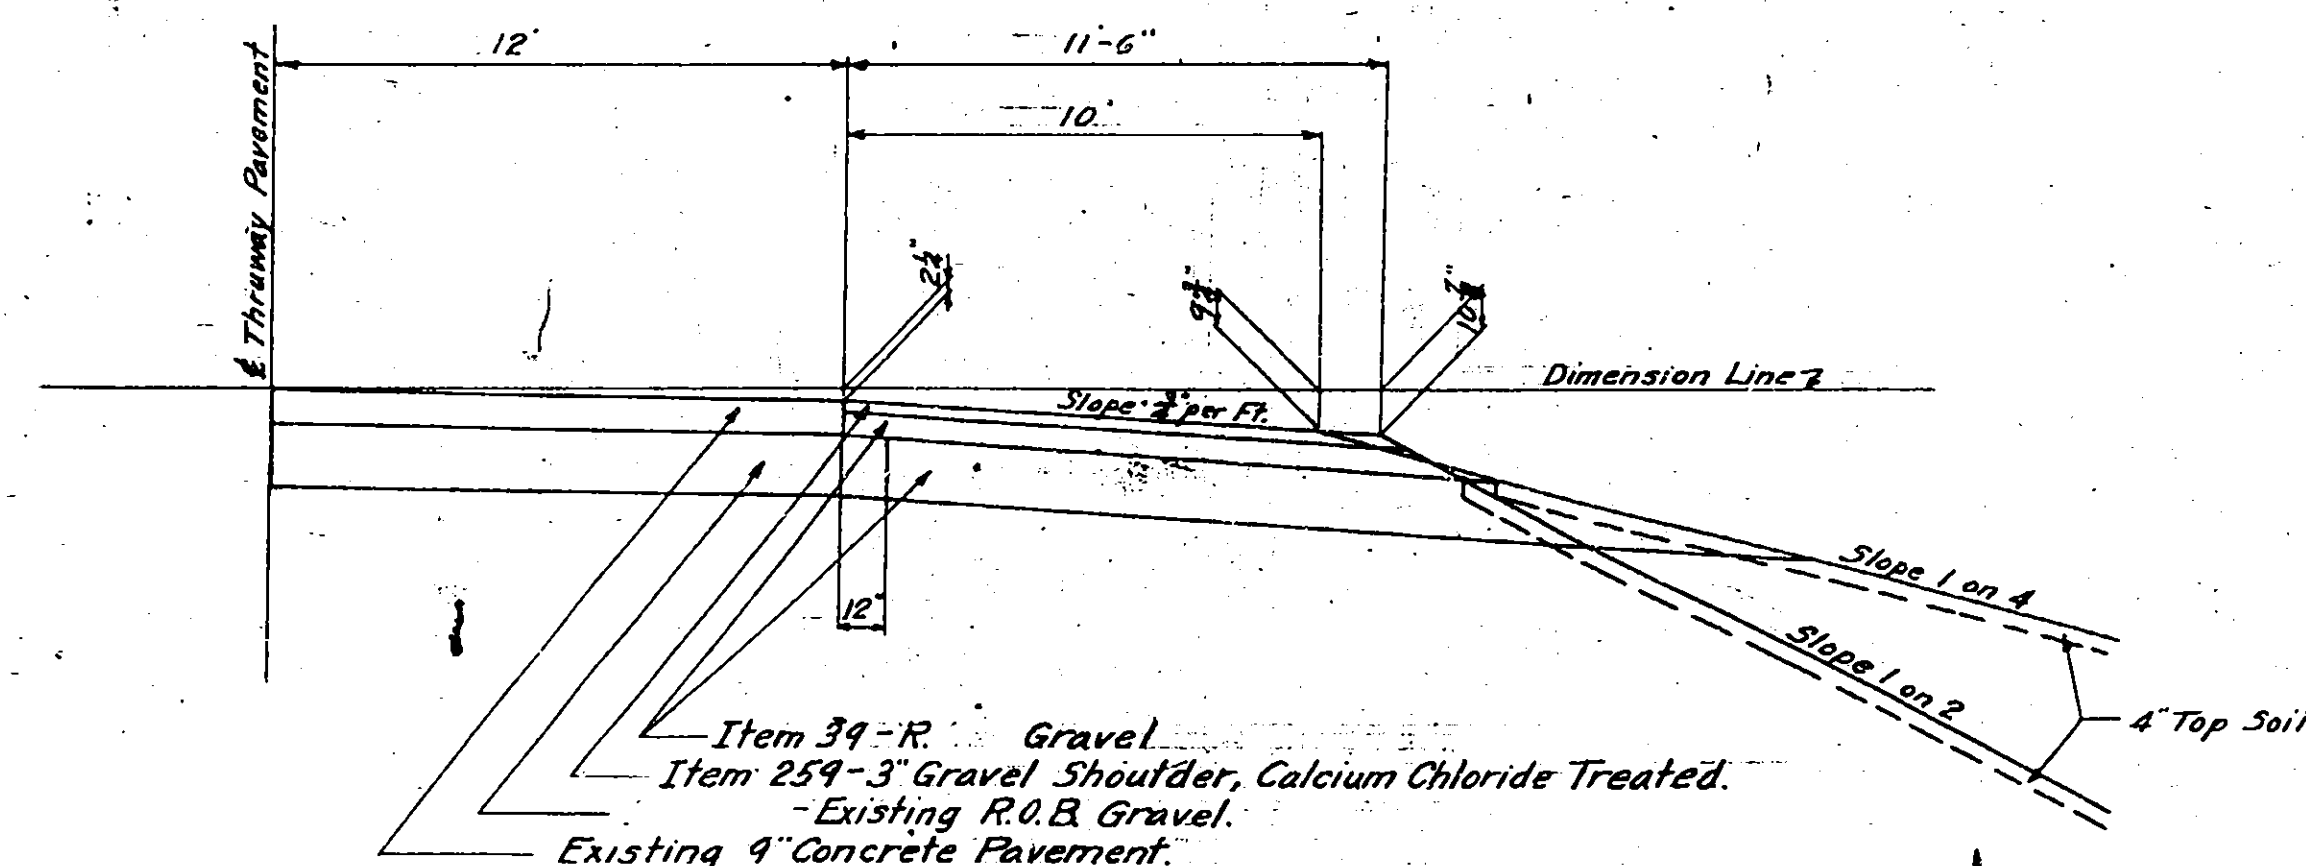

Made by J. E. Chamberlain Traced by E. Goyner Checked by Colangelo

Prepared Pursuant To The Highway Law & Recommended by
Ray, Williams
 Date _____ Engineer (District No 2)

SCHEDULE A

LOCATION AND QUANTITY OF PAYMENT ITEMS

STATION TO STATION	SECTION	ITEM	QUANTITY	REMARKS
			A UNIT	
197+00 - 201+22		121	161 C.Y.	Thruway Mall
E 2+00 - E 11+56	L&R	121	311 C.Y.	Break in shoulder to end of road section
E 16+30 - E 33+80	L&R	121	532 C.Y.	ditto
E 2+00 - E 11+56	L&R	123	1.00 Acres	Edge of pavement to end of road section
E 16+30 - E 33+80	L&R	123	1.82 Acres	ditto
197+00 - 201+22		123	.40 Acres	Thruway Mall
E 10+00 - E 11+56	L&R	124	552 S.Y.	Sodded berm gutters, slope channels and sod strips
E 16+30 - E 21+00	L&R	124	794 S.Y.	ditto
E 10+00 - E 13+00	L&R	IWA	10 M Gal.	In areas where item 124 is used.
E 15+00 - E 21+00	L&R	IWA	14 M Gal.	ditto
From BRIDGE PLANS				
E 11+56 - E 13+00	L&R	121	125 C.Y.	Break in shoulder to end of road section
E 15+00 - E 16+30	L&R	121	125 C.Y.	ditto
E 11+56 - E 13+00	L&R	123B	0.24 Acres	Edge of pavement to end of road section
E 15+00 - E 16+30	L&R	123B	0.23 Acres	ditto
E 11+56 - E 13+00	L&R	124	383 S.Y.	Sodded berm gutters, slope channels and sod strips
E 15+00 - E 16+30	L&R	124	383 S.Y.	ditto

TOTAL	121	1004 C.Y.	Neat)
		105 J C.Y.	Rounded) Highway
TOTAL	121	250 C.Y.	Neat)
		275 C.Y.	Rounded) Bridge
TOTAL	123	3.22 Acres	Neat)
		3.50 Acres	Rounded) Highway
TOTAL	123B	0.47 Acres	Neat)
		0.52 Acres	Rounded) Bridge
TOTAL	124	1346 S.Y.	Neat)
		1450 S.Y.	Rounded) Highway
TOTAL	124	766 S.Y.	Neat)
		843 S.Y.	Rounded) Bridge
TOTAL	IWA	24 M Gal.	Neat
		24 M Gal.	Rounded

SCHEDULE B

DETAIL SPECIFICATIONS TO ACCOMPANY PUBLIC WORKS SPECIFICATIONS

ITEM	DESCRIPTION
IW	FURNISHING WATER EQUIPMENT
IWA	APPLYING WATER
a	Areas - See Schedule A.
	Rates - As specified.
121	TOPSOIL PLACED FROM STOCKPILES
a	Areas - See Schedule A.
c1	Subgrade scarified as directed by Engineer.
c3	Topsoil Thickness - 3 inches, loose measure
123	SEEDING
a	Areas - See Schedule A.
b	Seeds - See Schedule D.
	Fertilizer - M-55, Type No. 2 (10-10-10)
	Mulch - M-59, Hay or M-60, Straw
c2	No inoculation required for Alsike Clover.
c3	Rate of Seeding - 50 lbs. pure live seed per acre
	Rate of Fertilizer - 600 lbs. per acre
c4	Rate of Mulch - 2 tons per acre
123B	SEEDING ON PREPARED AREAS
a	Areas - See Schedule A.
124	SODDING
a	Areas - See Schedule A.
c3	Sodding shall be as shown on Standard Sheet 50-34, Bridge Plans, or as directed by Engineer.

LOCATION of TOPSOIL STOCKPILES

Station	Side	Approx. Quantity
7+00	Lt.	500 C.Y.
15+00	Lt.	200 C.Y.
30+00	Rt.	2000 C.Y.
44+00	Rt.	800 C.Y.
87+00	Rt.	1500 C.Y.
198+00	Lt.	800 C.Y.

NOTE: All areas disturbed by removing topsoil from stockpiles will be regraded and seeded as directed by Engineer. No direct payment will be made for this work but the cost thereof shall be included in the price bid for the various items in the contract.

SCHEDULE C

MOHAWK THRUWAY

Sect. I

FYLER SETTLEMENT ROAD

SCHEDULE C

ITEM	DESCRIPTION	UNIT	QUANTITY	RATE	AMOUNT
Creeping Red Fescue (Festuca rubra)	Commercial		95	75	25
Redtop (Agrostis alba)	Commercial		90	85	10
Perennial Ryegrass (Lolium perenne)	Commercial		95	75	7
Alsike Clover (Trifolium hybridum)	Commercial		95	85	3
Wild White Clover (Trifolium repens var.)	Kent Wild, N.Y. Wild, N. Zealand Wild		95	95	5
	Max. 25% Hard Seed				
	RATE				50

IW	Nec.	Furnishing Water Equip
IWA	24 M. Gals.	Applying Water
121	1325 C.Y.	Topsoil placed from stockpiles
123	3.50 Acres	Seeding
123B	0.52 Acres	Seeding on prepared areas
124	2203 S.Y.	Sodding


Dittan

K. Keil

F.E. White

John P. ...

Fed Rd Dist No.	State	Fed Aid Proj No.	County	Sheet No.	Total Sheets
	N.Y.		Madison	23	67
Mohawk Thruway N. Manlius - N. Chittenango Fyler Settlement Road					

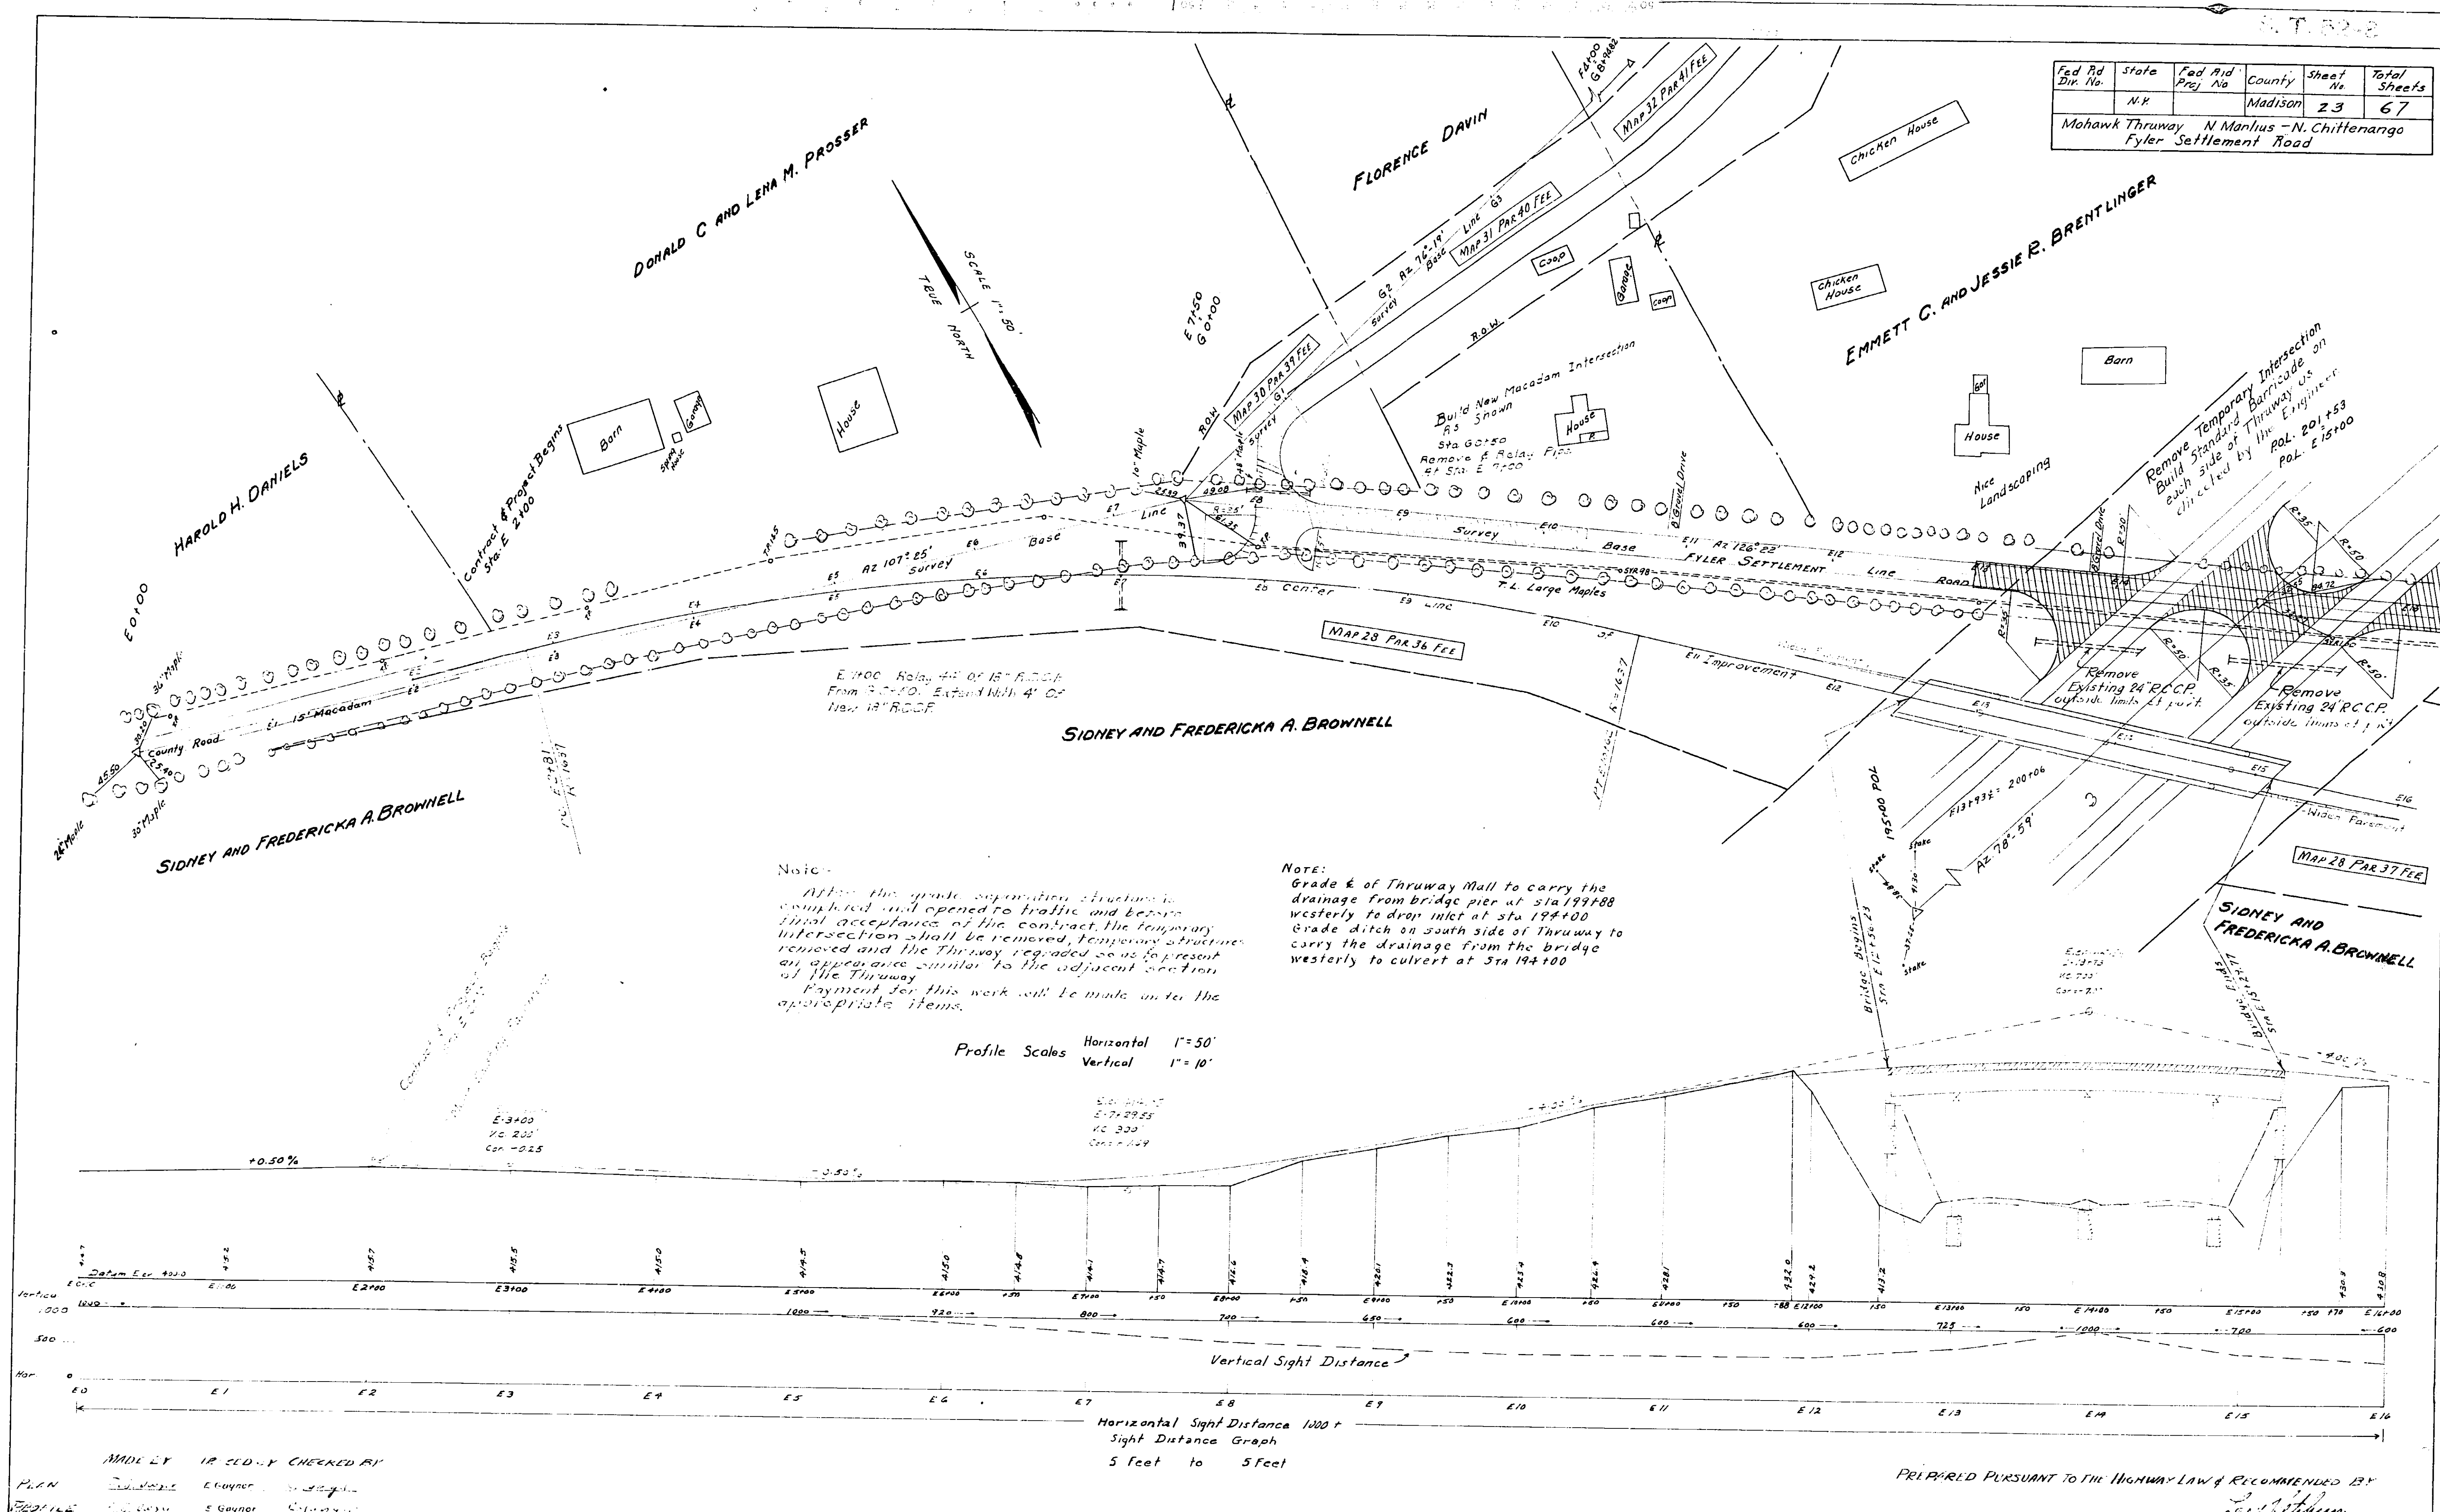

NOTE:
After the grade separation structure is completed and opened to traffic and before final acceptance of the contract, the temporary intersection shall be removed, temporary structures removed and the Thruway regraded so as to present an appearance similar to the adjacent section of the Thruway.
Payment for this work will be made under the appropriate items.

NOTE:
Grade & of Thruway Mall to carry the drainage from bridge pier at Sta 19+88 westerly to drop inter at Sta 19+00.
Grade ditch on south side of Thruway to carry the drainage from the bridge westerly to culvert at Sta 19+00.


Profile Scales
Horizontal 1" = 50'
Vertical 1" = 10'

MADE BY IR SEDLEY CHECKED BY
PLAN
PROFILE

PREPARED PURSUANT TO THE HIGHWAY LAW & RECOMMENDED BY
DATE
ENGINEER DISTRICT NO. 2

Fed Rd Dir. No.	State	Fed Aid Proj. No.	County	Sheet No.	Total Sheets
	N.Y.		Madison	23	67
Mohawk Thruway N. Manlius - N. Chittenango Fyler Settlement Road					

23R

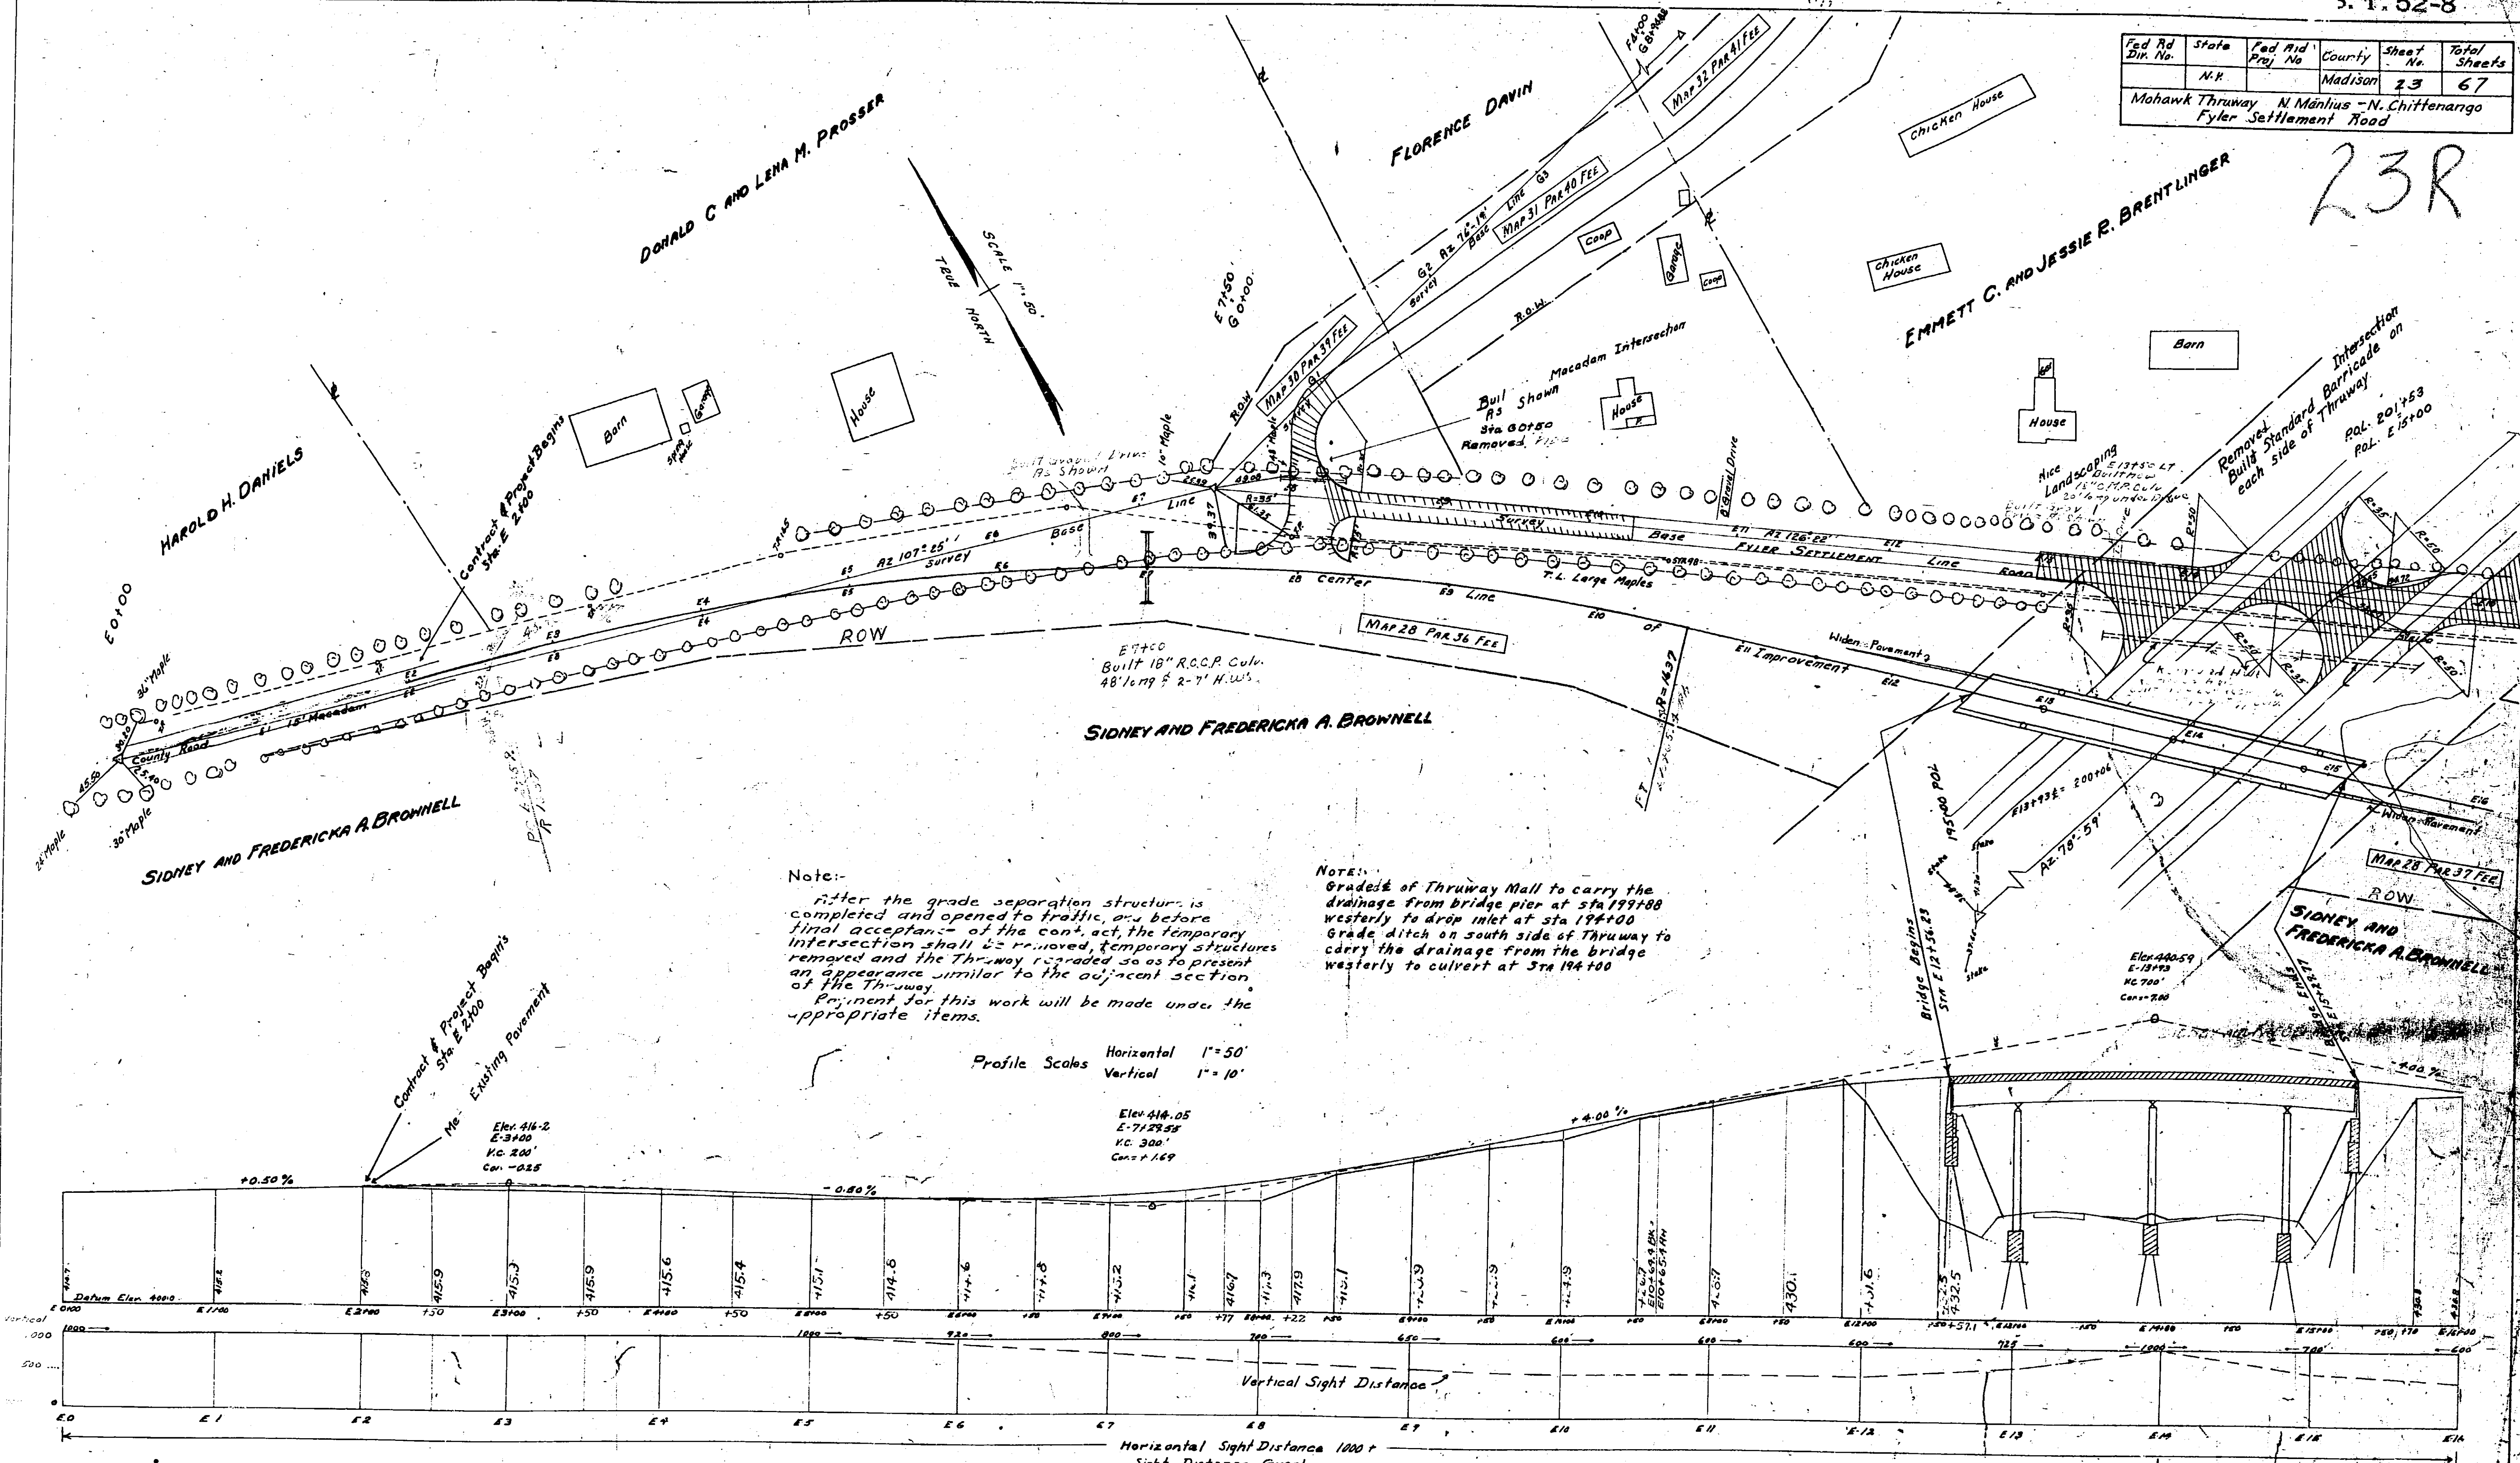

Note:

After the grade separation structure is completed and opened to traffic, and before final acceptance of the contract, the temporary intersection shall be removed, temporary structures removed and the Thruway regraded so as to present an appearance similar to the adjacent section of the Thruway. Payment for this work will be made under the appropriate items.

NOTE:


Grade of Thruway Mall to carry the drainage from bridge pier at Sta 199+88 westerly to drop inlet at Sta 194+00. Grade ditch on south side of Thruway to carry the drainage from the bridge westerly to culvert at Sta 194+00.

Profile Scales Horizontal 1" = 50' Vertical 1" = 10'

MADE BY TRACED BY CHECKED BY
J. J. Dwyer E. G. Dwyer S. L. Dwyer
J. J. Dwyer E. G. Dwyer S. L. Dwyer

PREPARED PURSUANT TO THE HIGHWAY LAW & RECOMMENDED BY
R. H. Dwyer
ENGINEER DISTRICT NO.
DATE




Fed Rd. Dist. No.	State	Fed Aid Proj. No.	County	Sheet No.	Total Sheets
	N.Y.		Madison	24	67
Mohawk Thruway, N. Manlius - N. Chittenango Fyler Settlement Road					

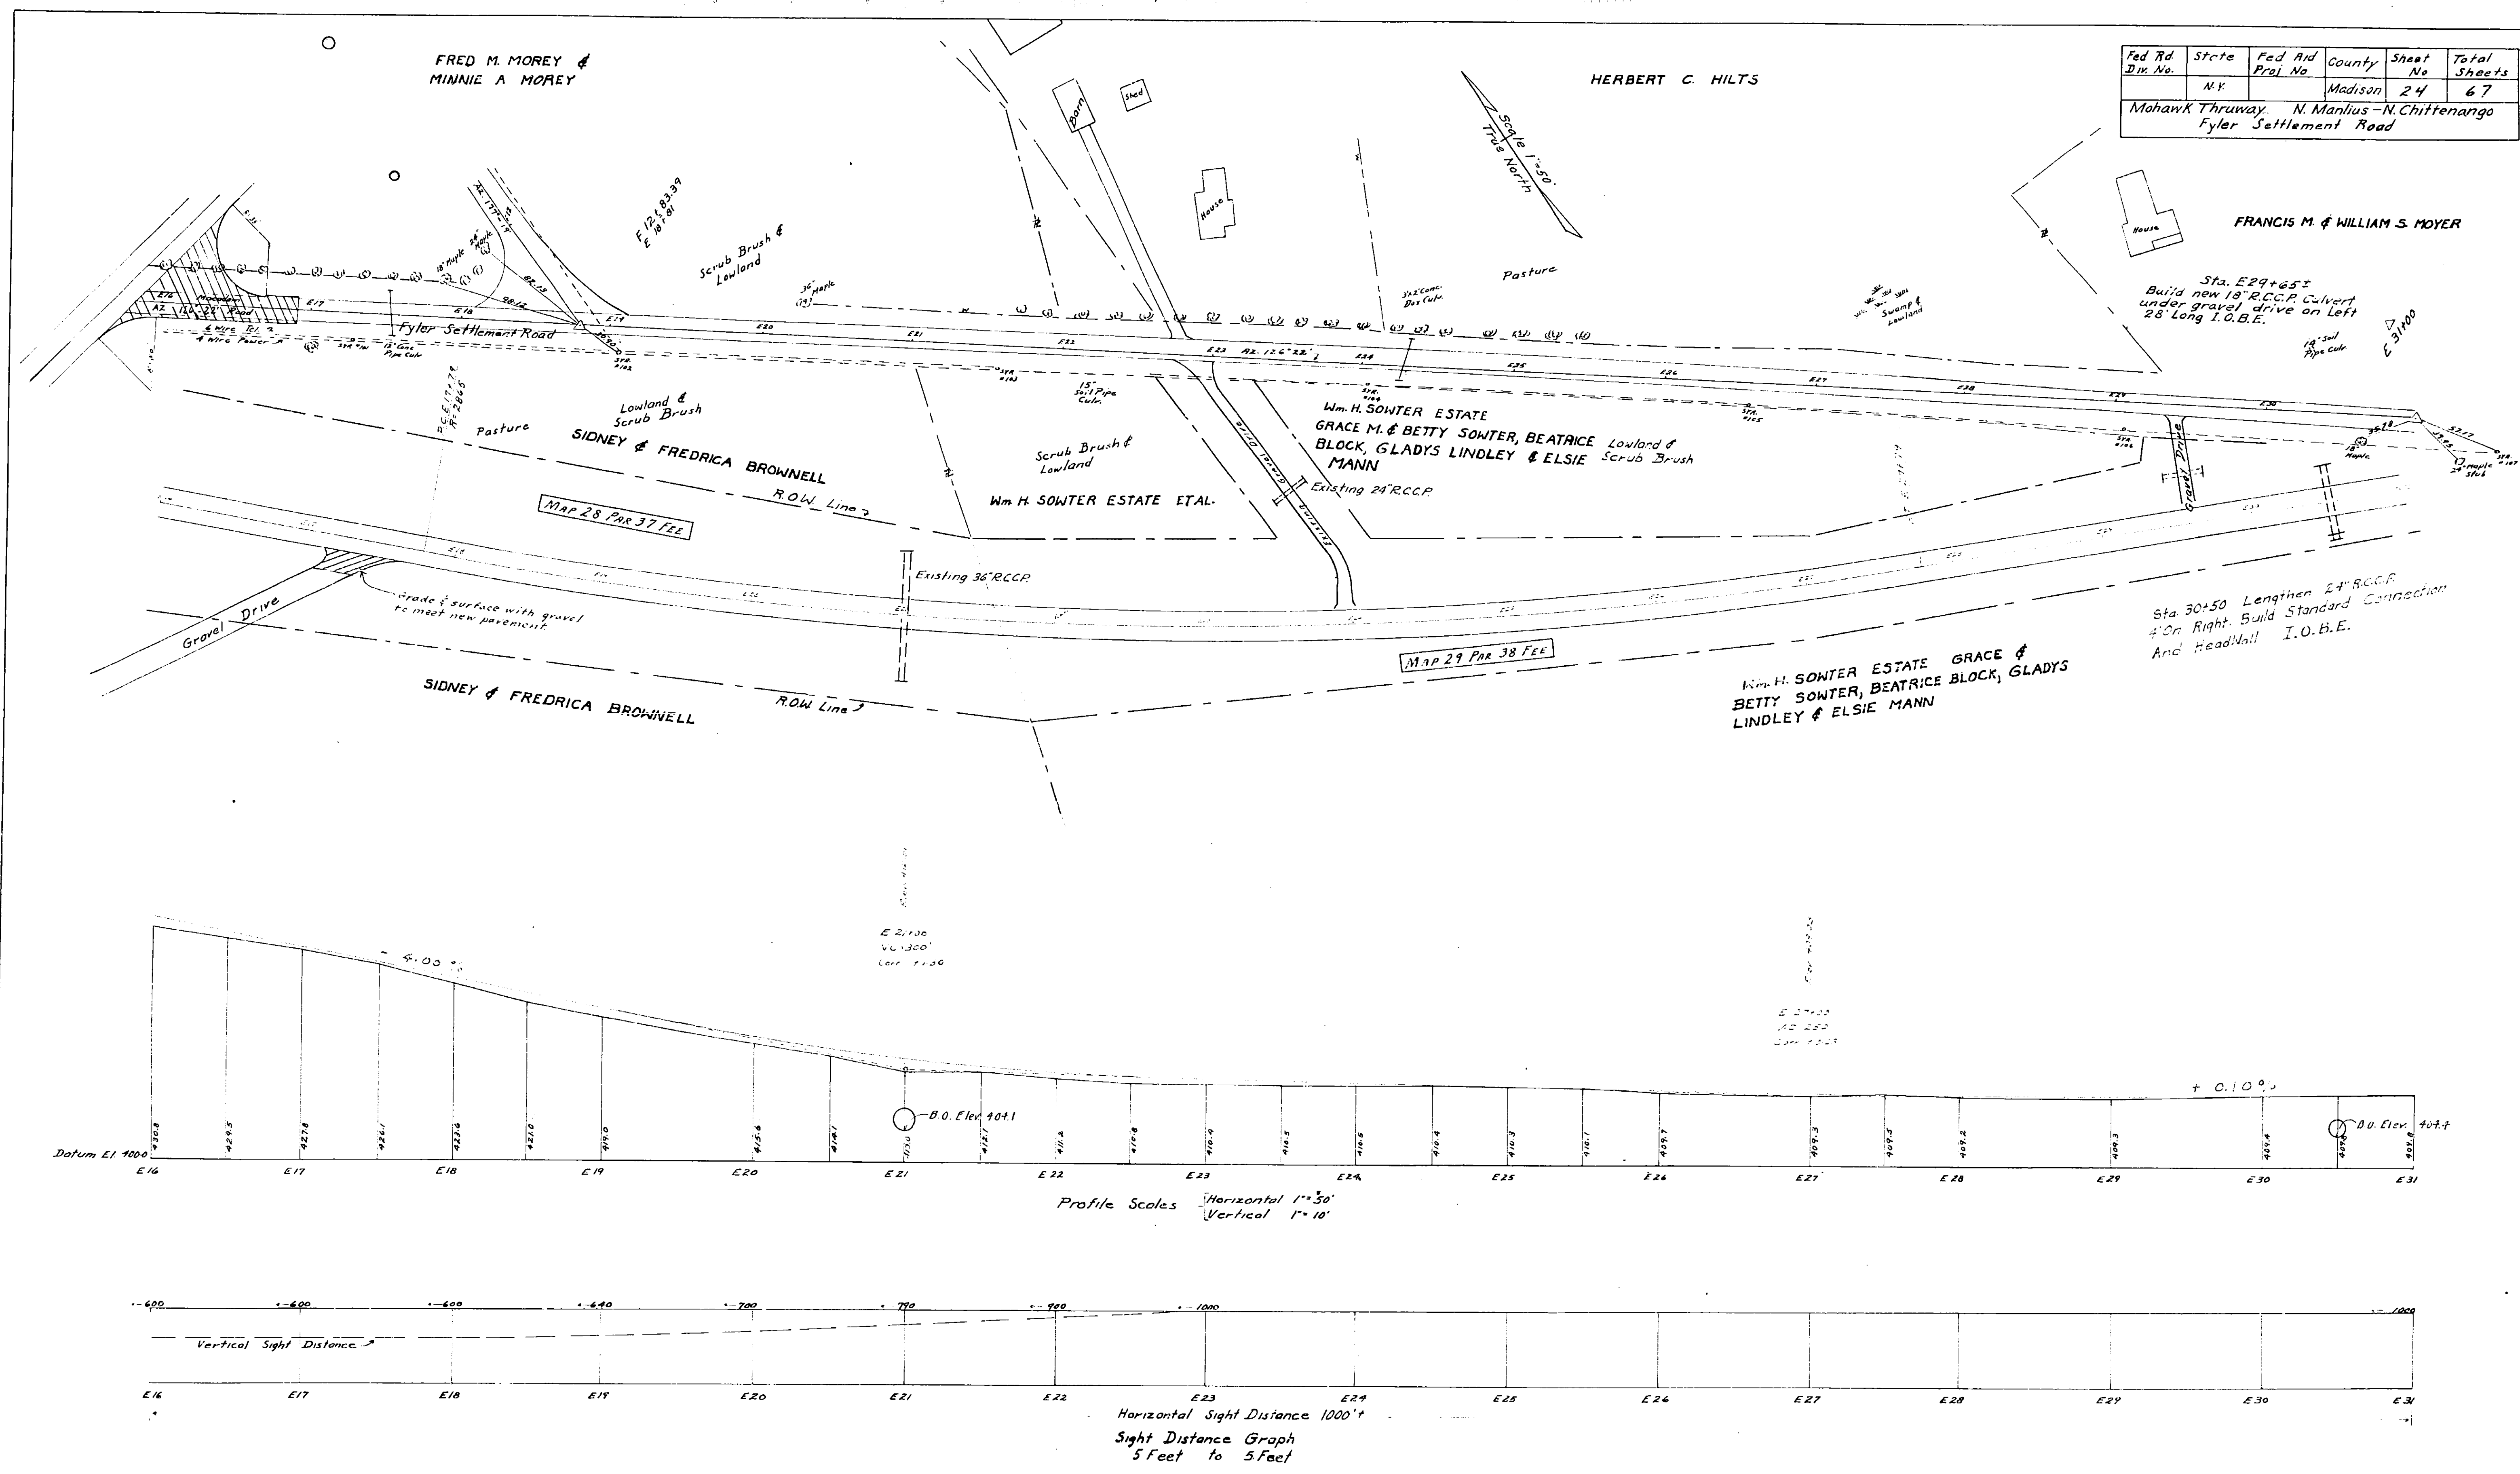

Fed Rd. Div. No.	State	Fed Aid Proj. No.	County	Sheet No.	Total Sheets
	N.Y.		Madison	24	67

Mohawk Thruway - N. Manlius - N. Chittenango
Fyler Settlement Road

24R
FRANCIS M. & WILLIAM S. MOYER

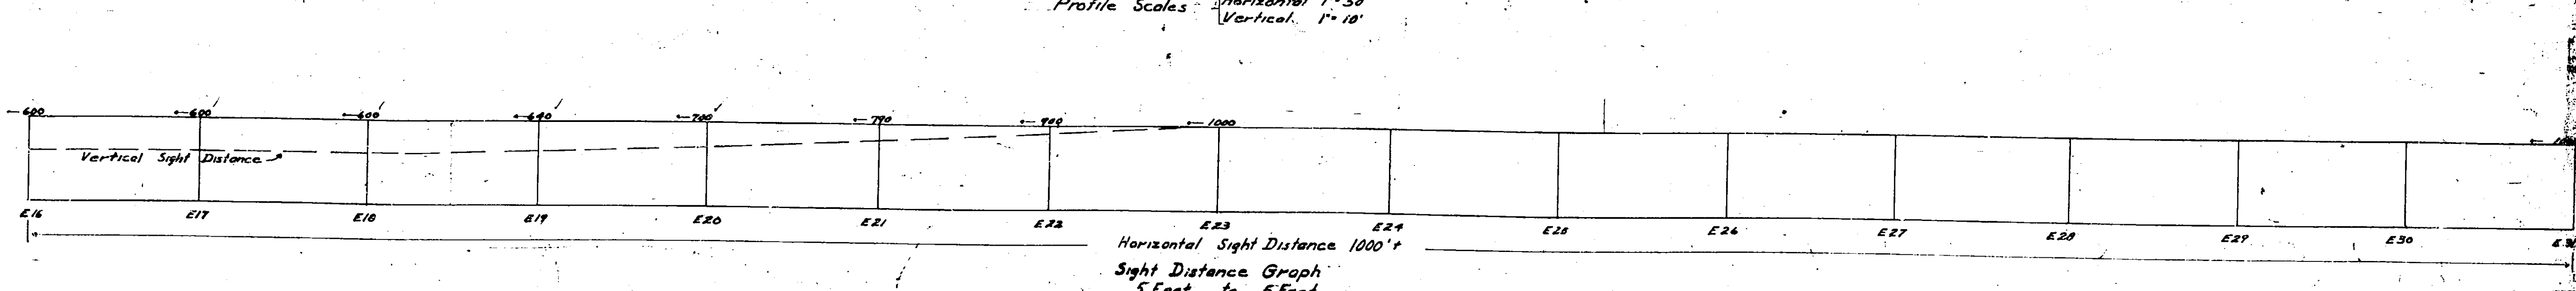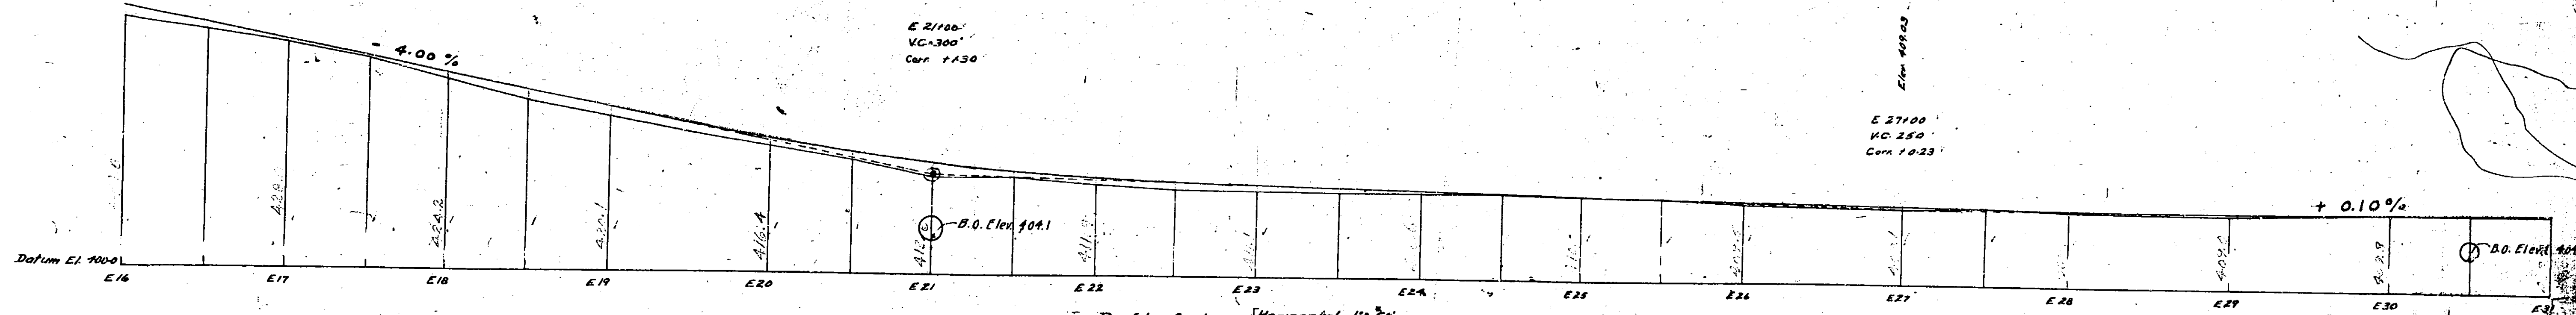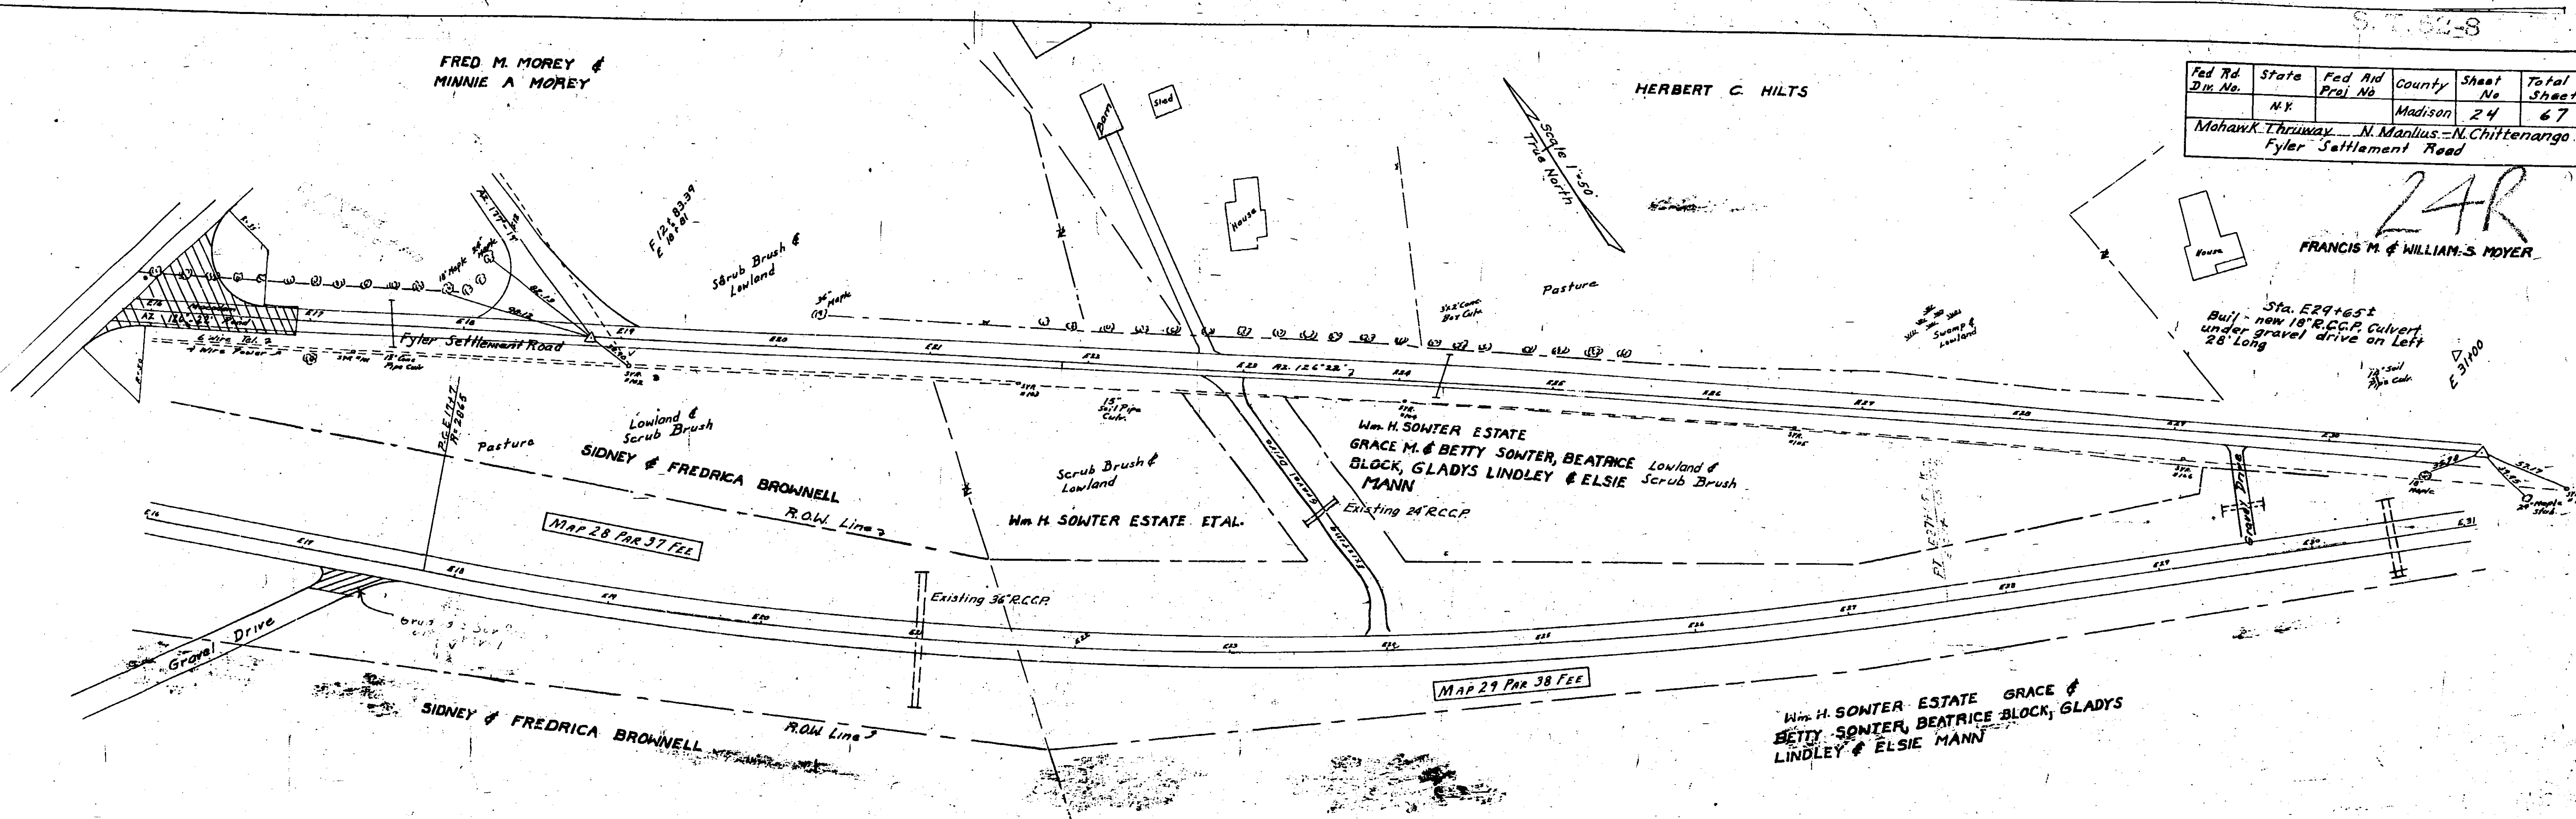

MADE BY TRACED BY CHECKED BY

J.J. DWYER E. GAYARD C. LANGELA



J.J. DWYER E. GAYARD C. LANGELA

PREPARED PURSUANT TO THE HIGHWAY LAW & RECOMMENDED BY


DATE

ENGINEER DISTRICT NO. 2

Fed Rd Div. No.	State	Fed Aid Proj. No.	County	Sheet No.	Total Sheets
	NY		Madison	25	67
Mohawk Thruway N. Manlius - N. Chittenango Fyler Settlement Road					

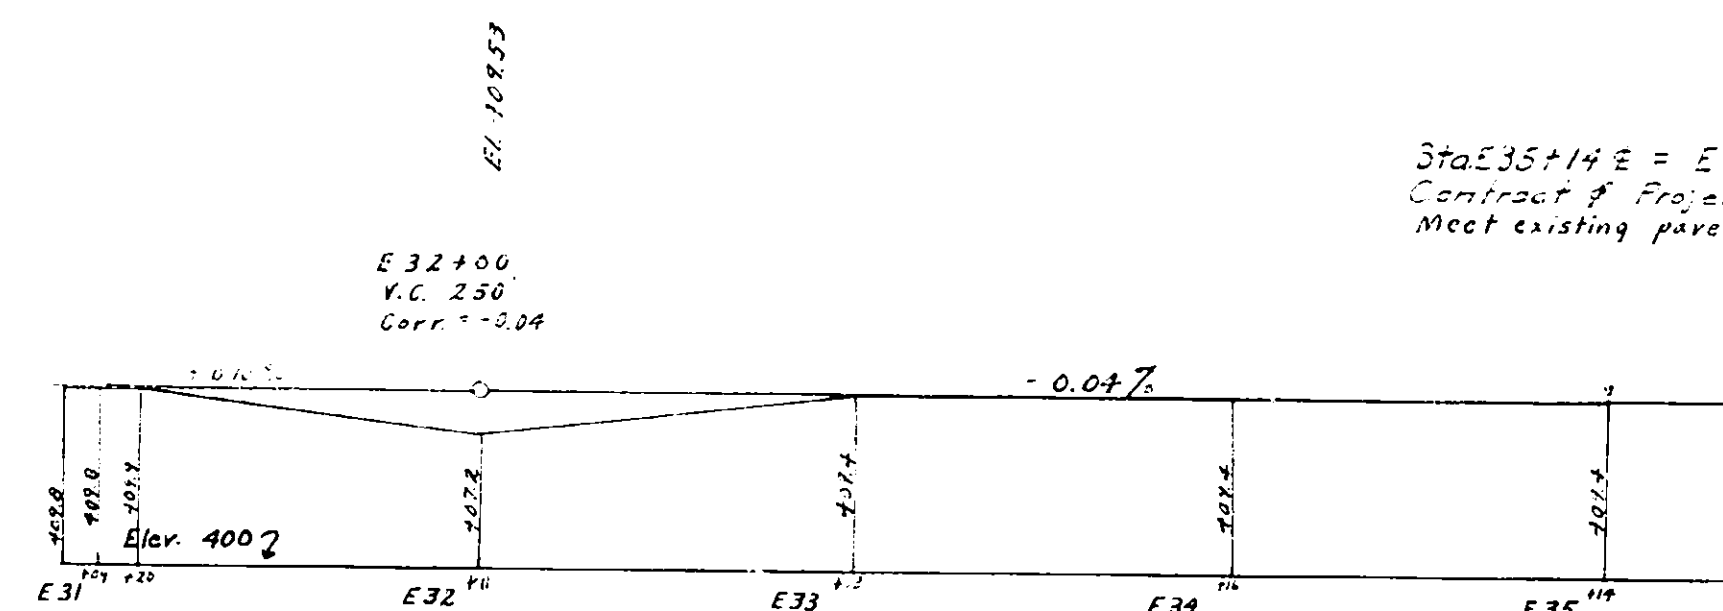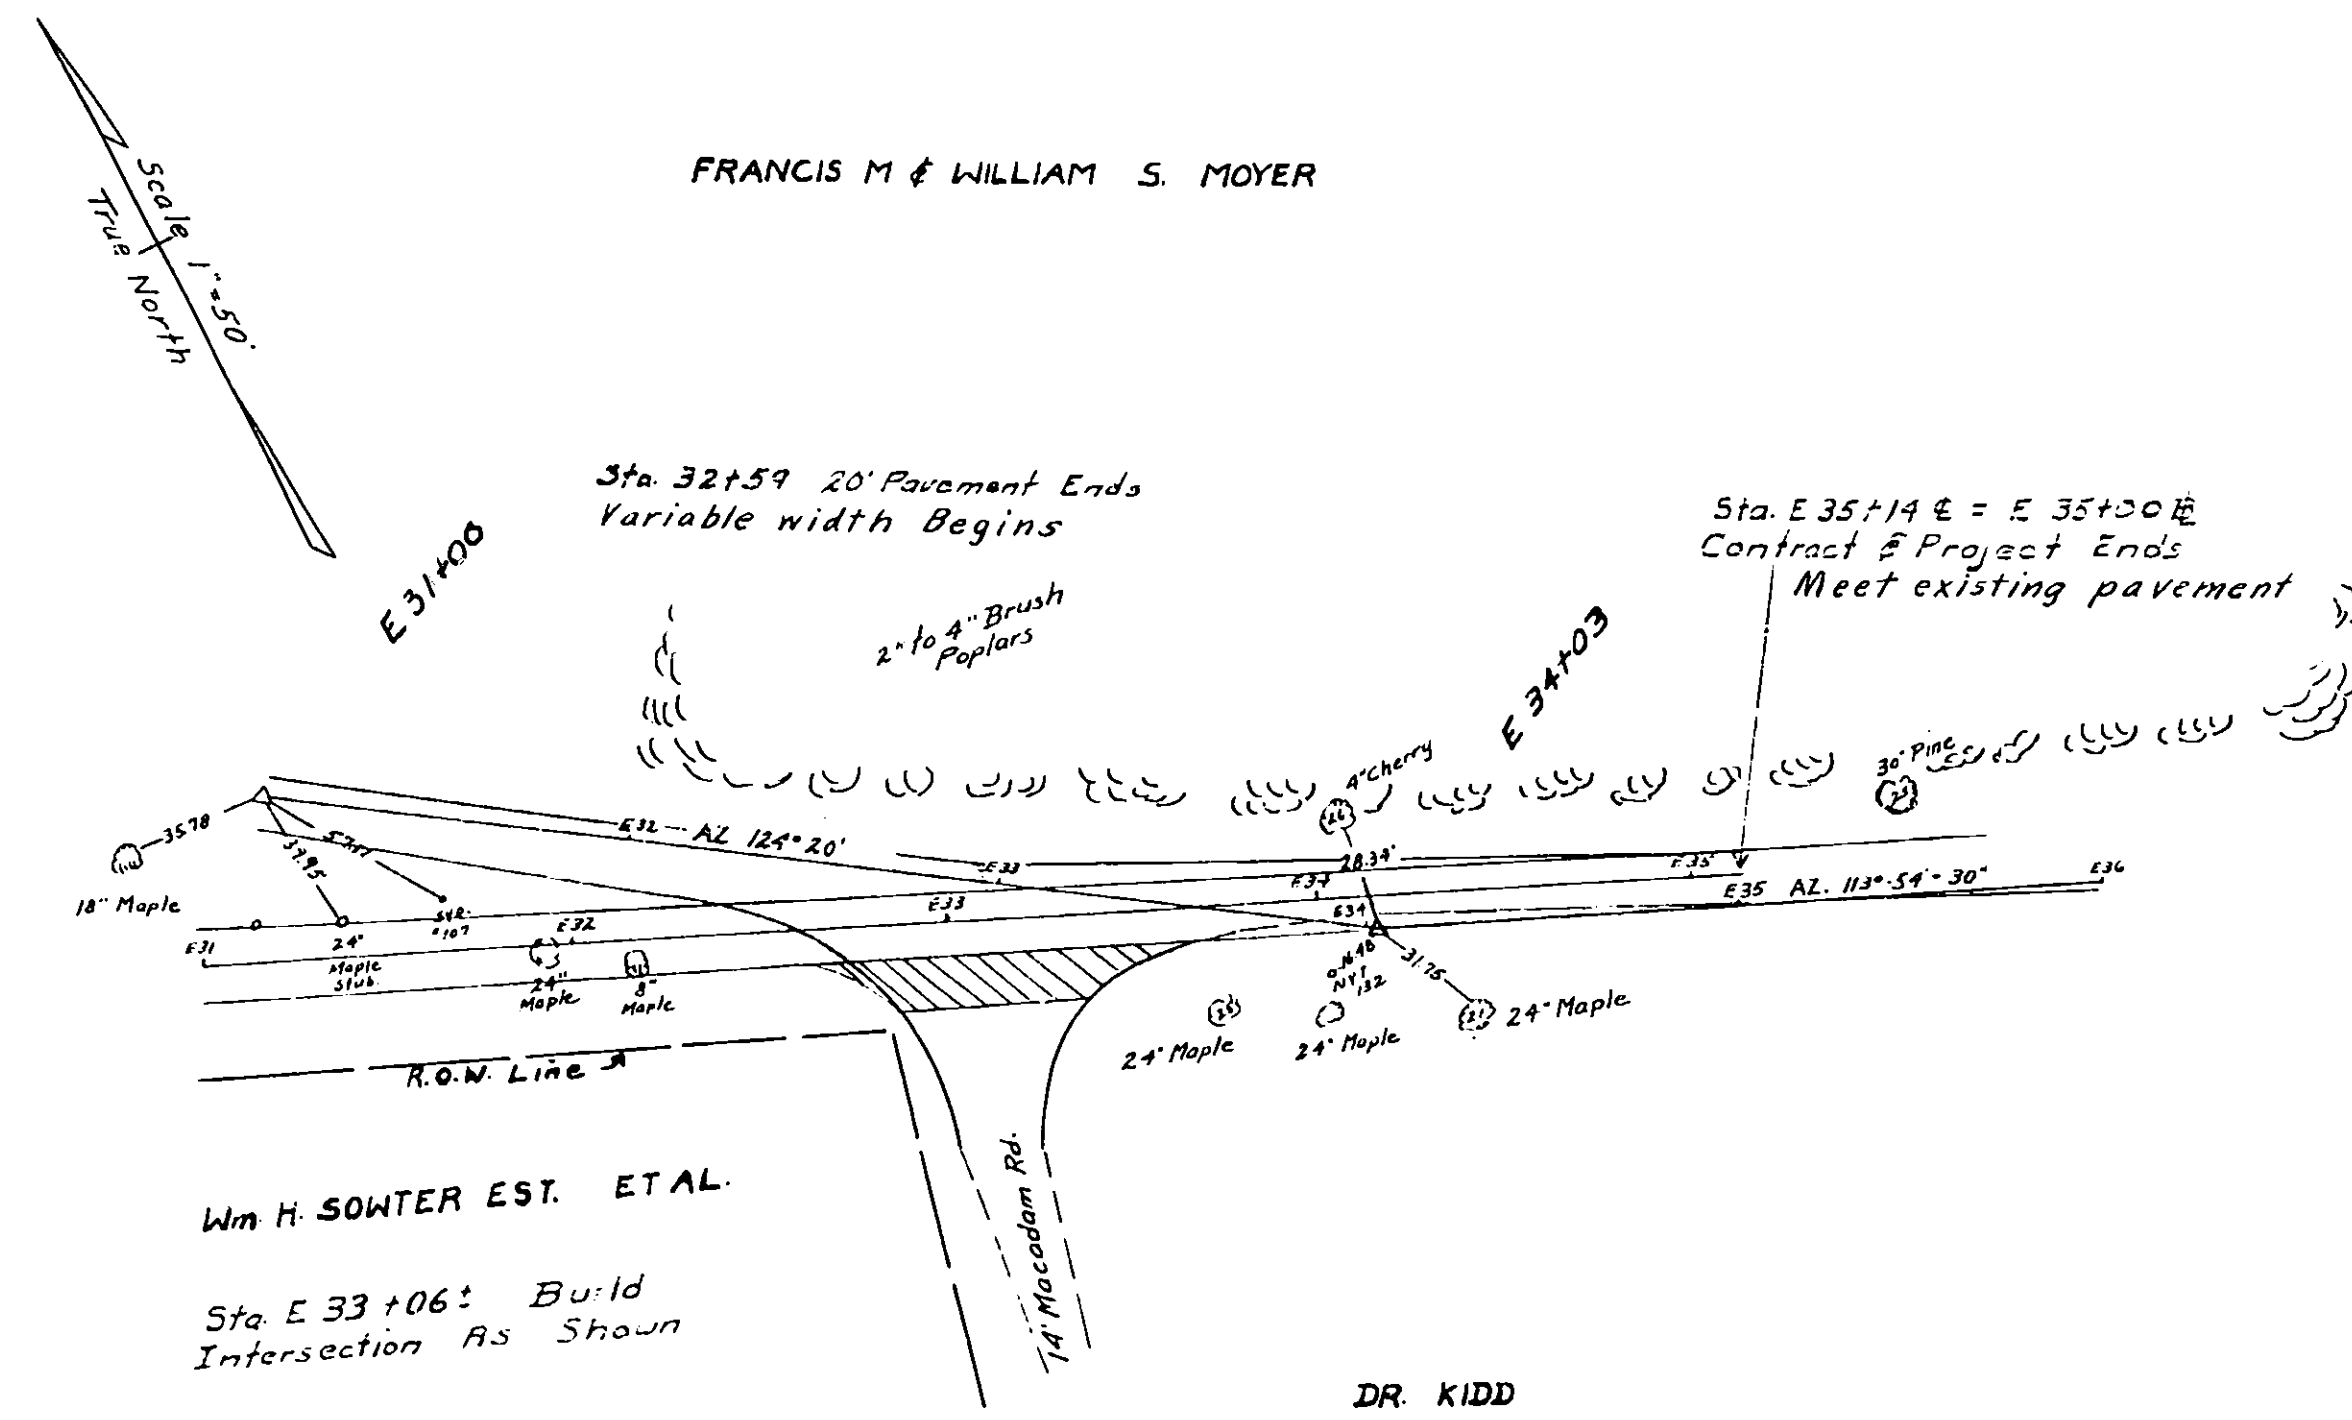

Profile Scales Horizontal 1" = 50'
Vertical 1" = 10'

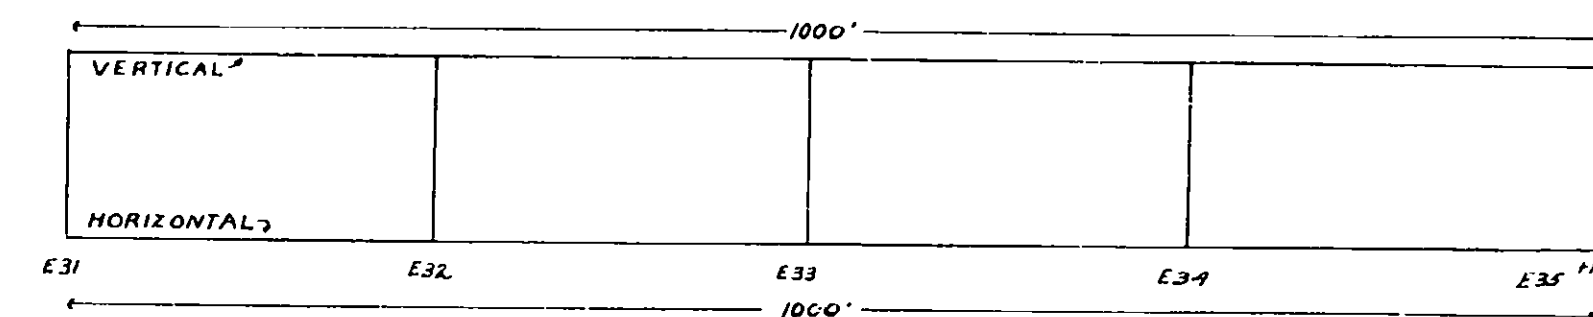



Sight Distance Graph
5 Feet to 5 Feet

Made by Traced by Checked by
Plan J. J. Dwyer Guyner Colangelo
Profile J. J. Dwyer Guyner Colangelo


Prepared Pursuant To The Highway Law & Recommended By
Date Engineer District No. 2

Fed Rd Dir. No.	State	Fed Aid Proj. No.	County	Sheet No.	Total Sheets
	NK		Madison	25	67
Mohawk Thruway N. Manlius - N. Chittenango Fyler Settlement Road					

25R

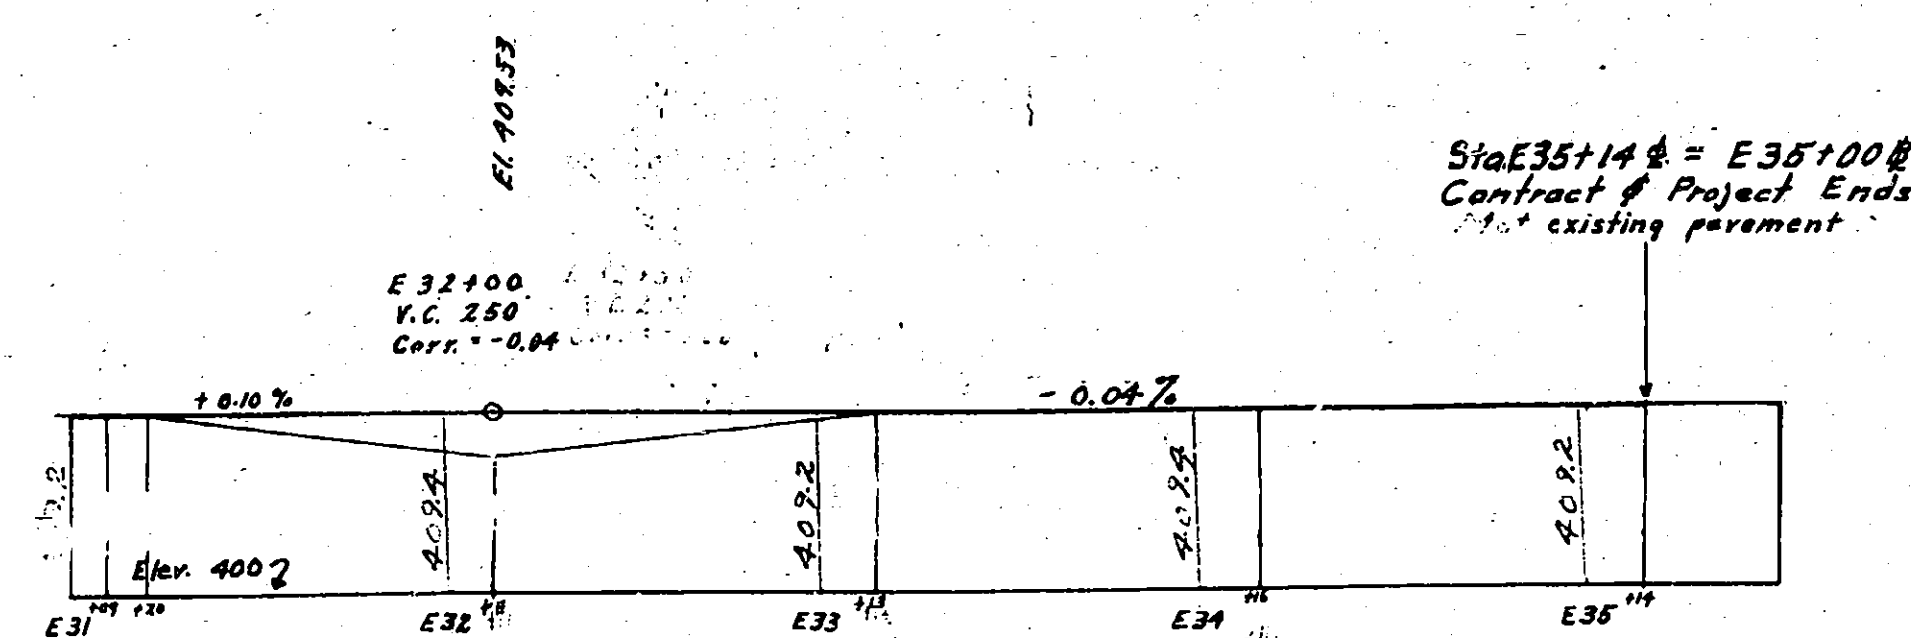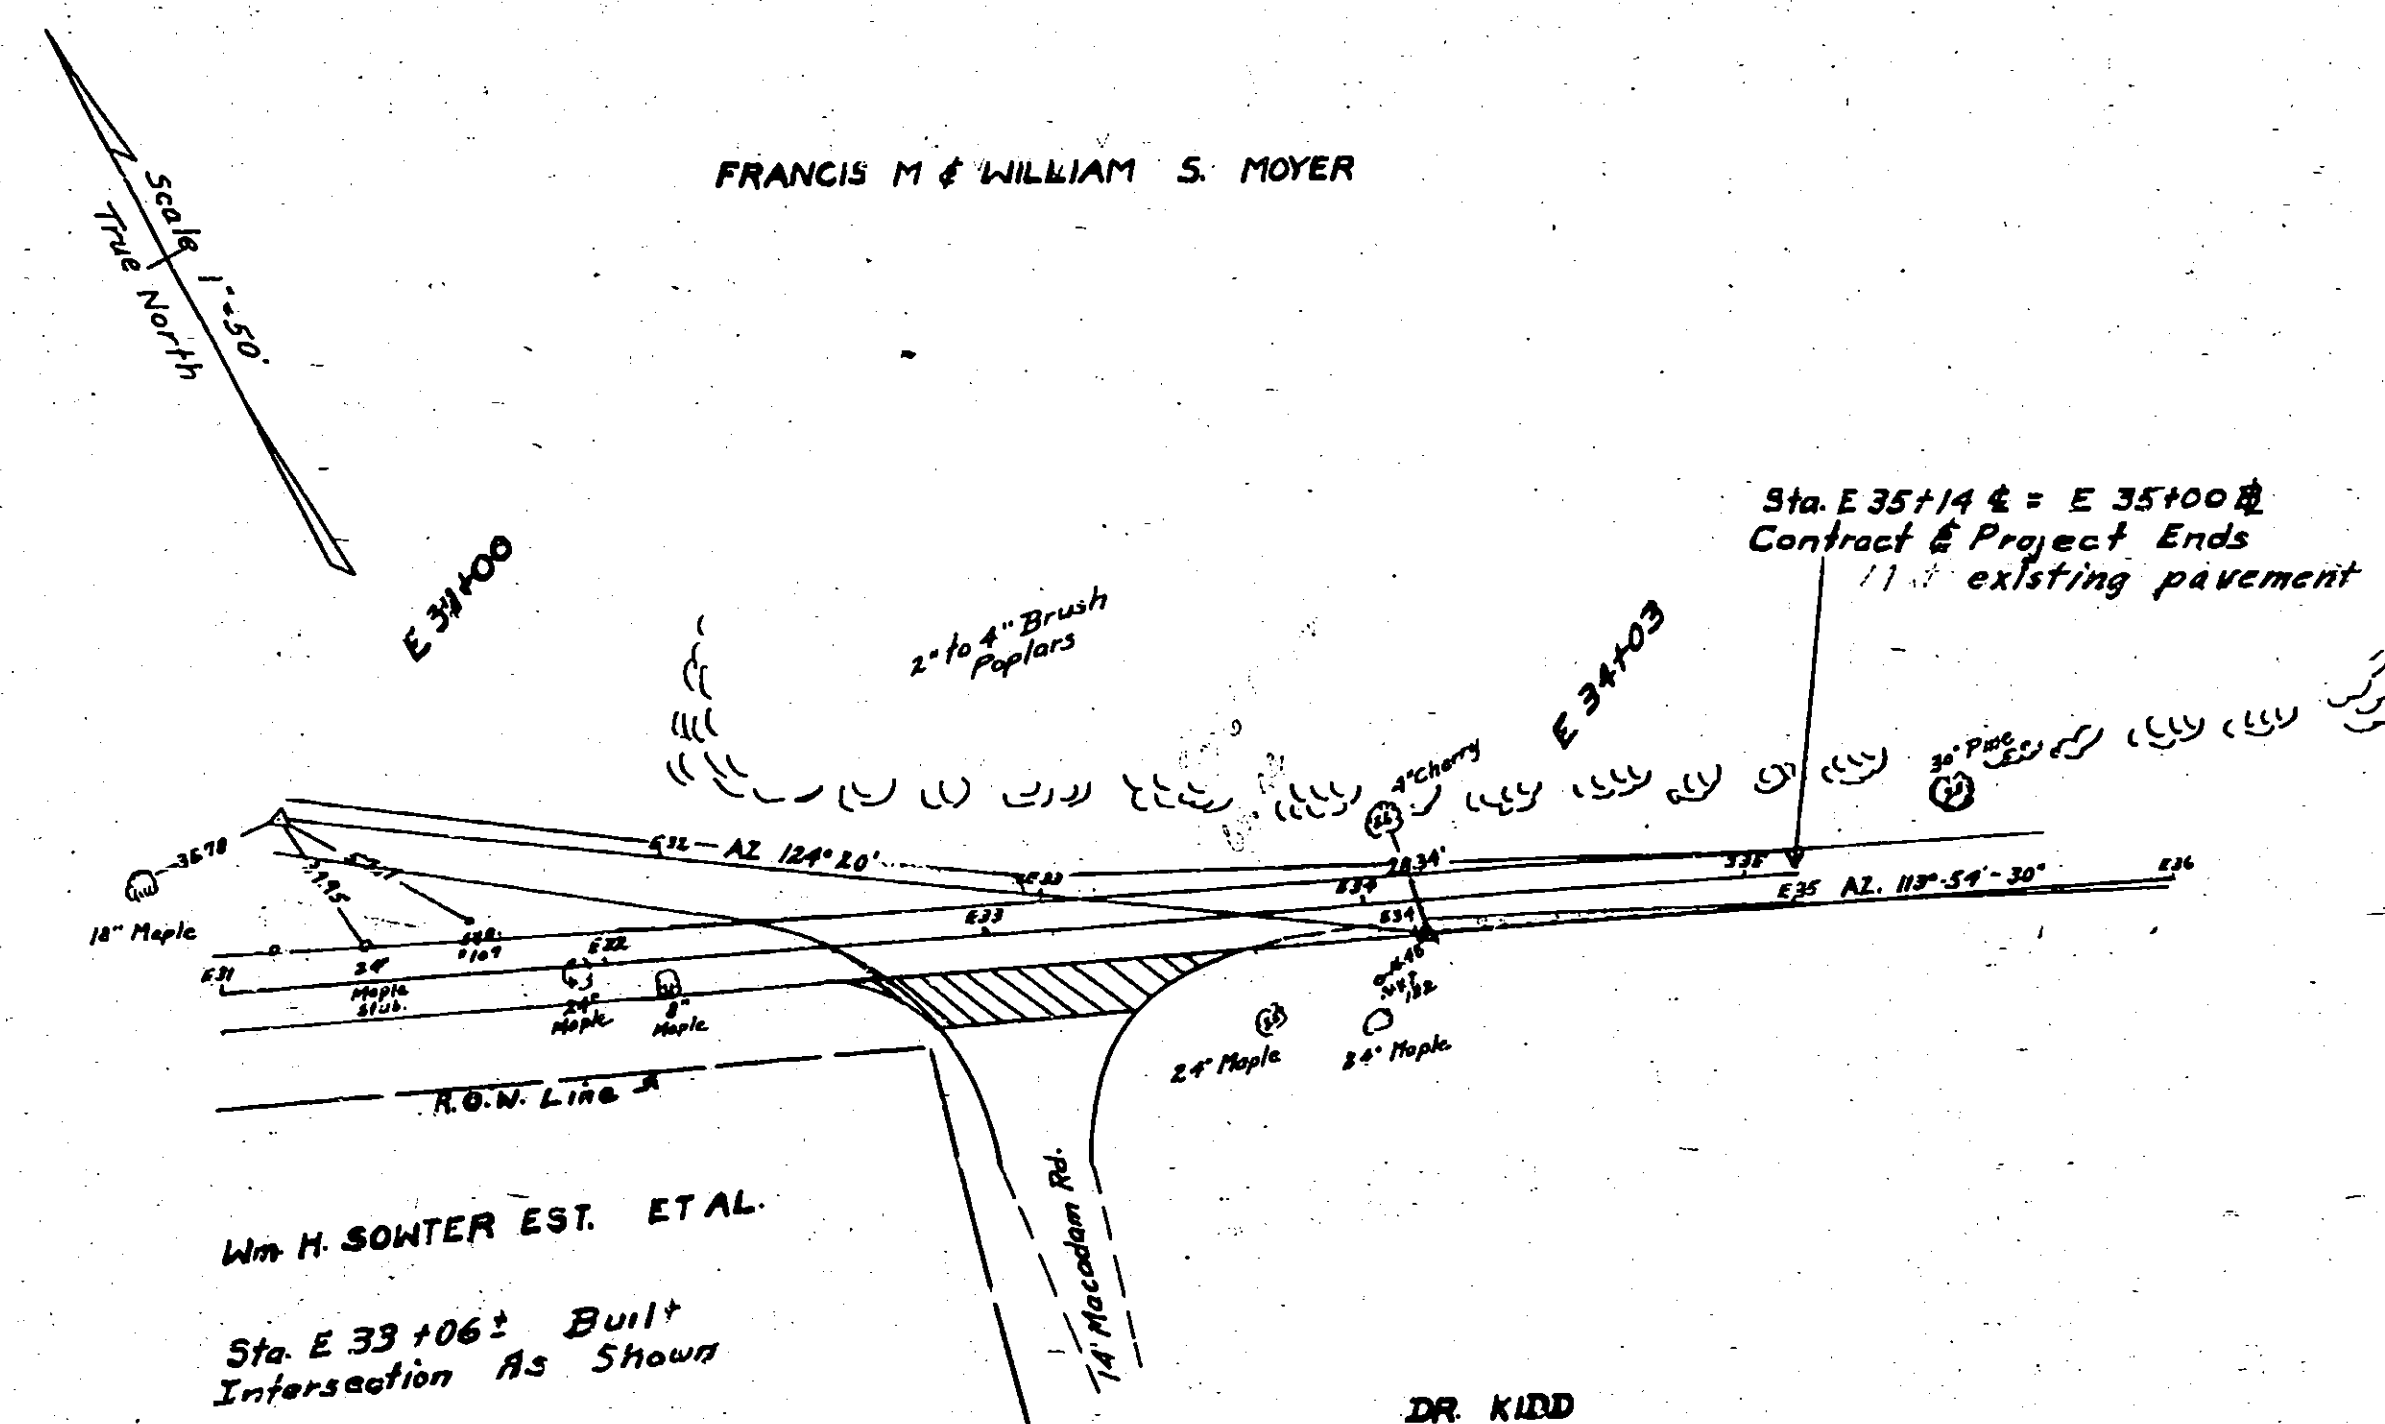

Profile Scales Horizontal 1" = 50'
Vertical 1" = 10'

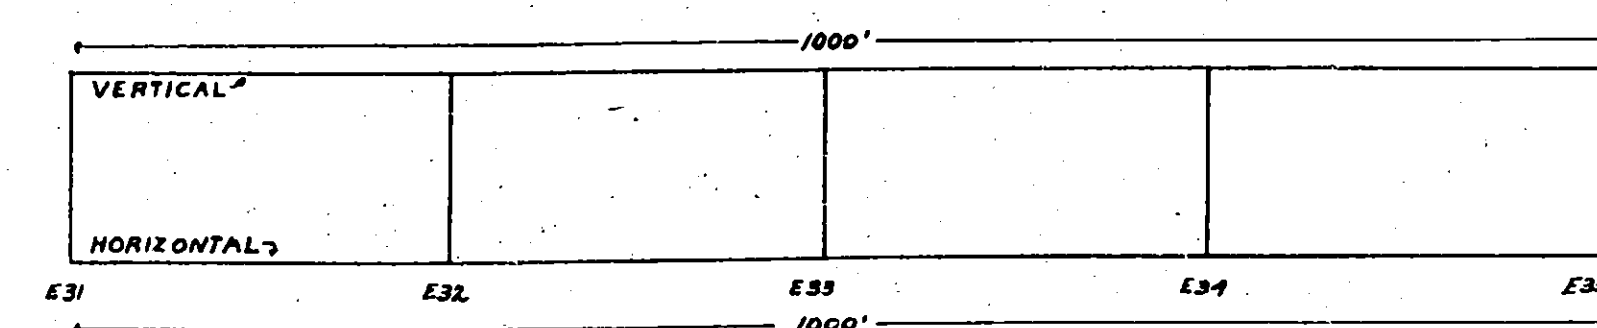

Sight Distance Graph
5 feet to 5 feet

Made by Traced by Checked by



Plan J. Dwyer Gaynor Colangelo
Profile J. Dwyer Gaynor Colangelo

Prepared by The Highway Law & Recommended By


Date

Engineer District No. 2


FED. AID DIST. NO.	STATE	FED. AID PROJ. NO.	FISCAL YEAR	SHEET NO.	TOTAL SHEETS
	N.Y.			26	67
FROM MOHAWK			TO THRUWAY		
MADISON			COUNTY		

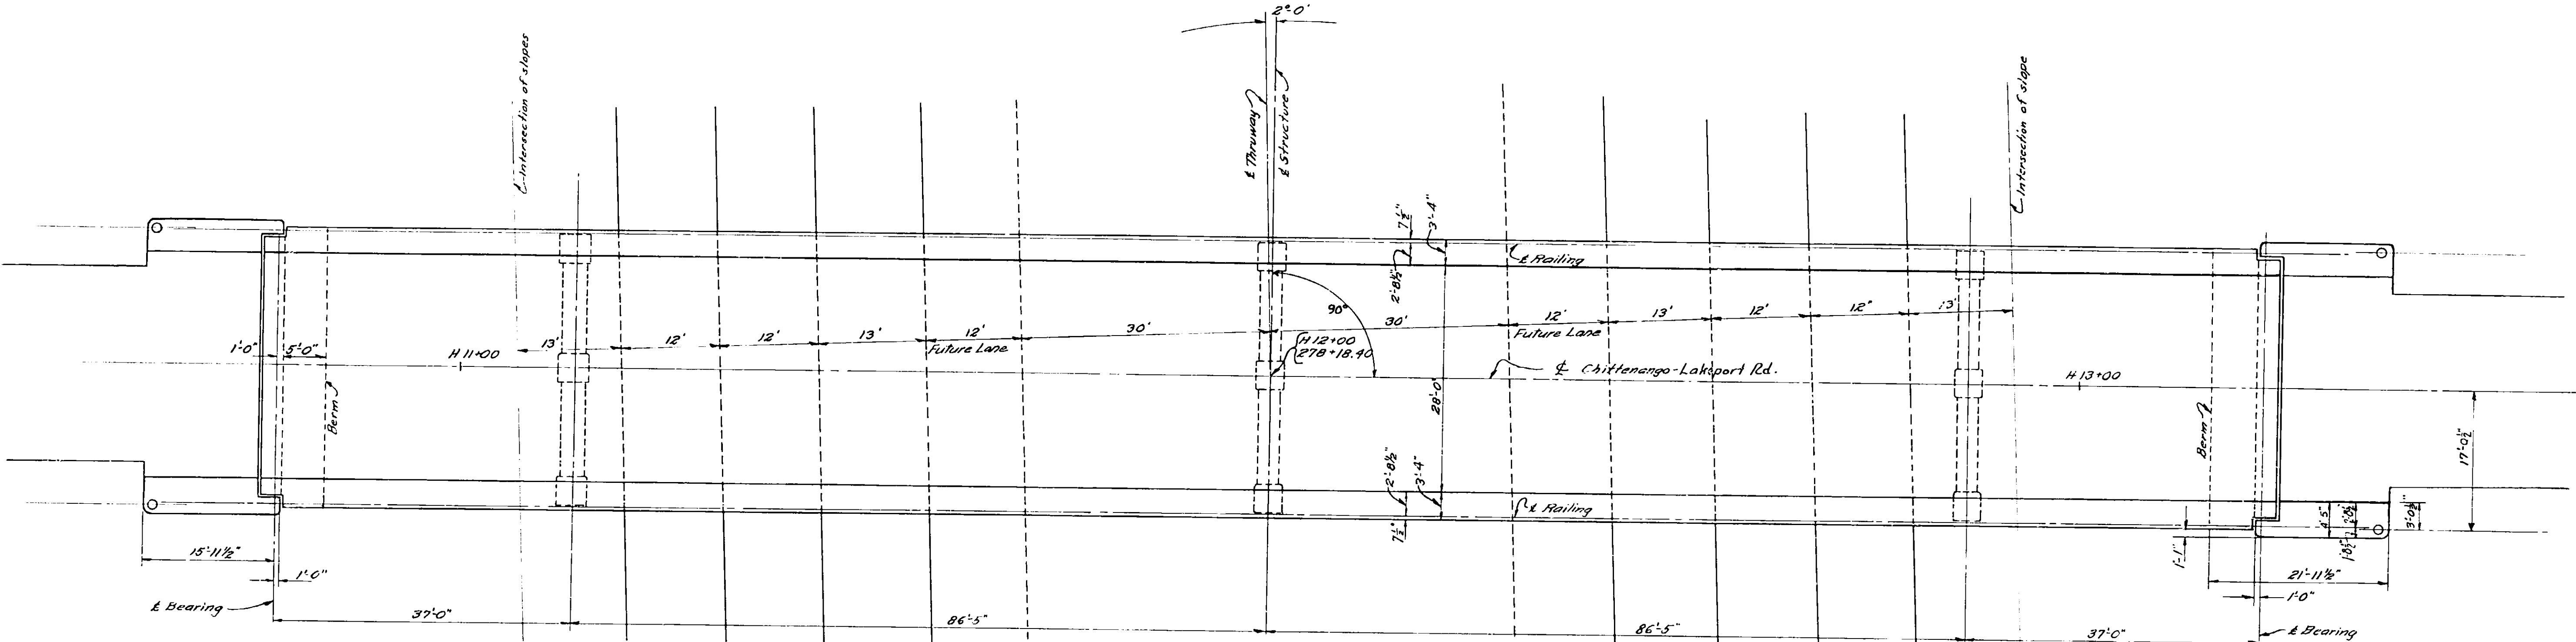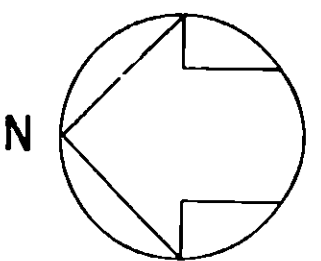

PLAN
SCALE: 1" = 10'-0"

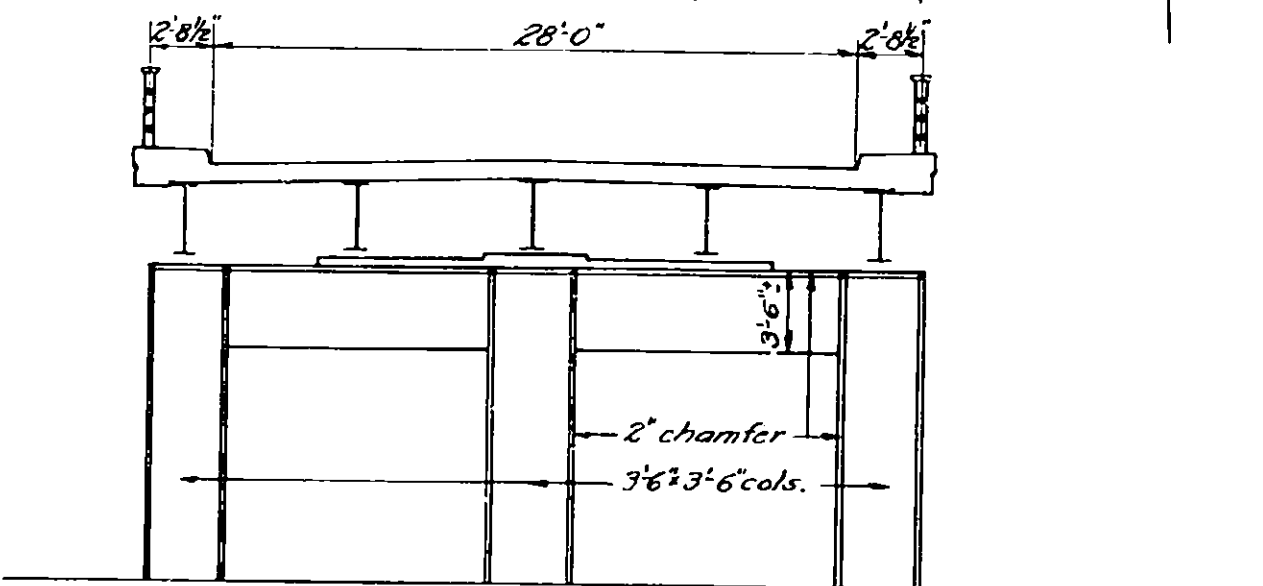

TYPICAL SECTION
SCALE: 1/8" = 1'-0"

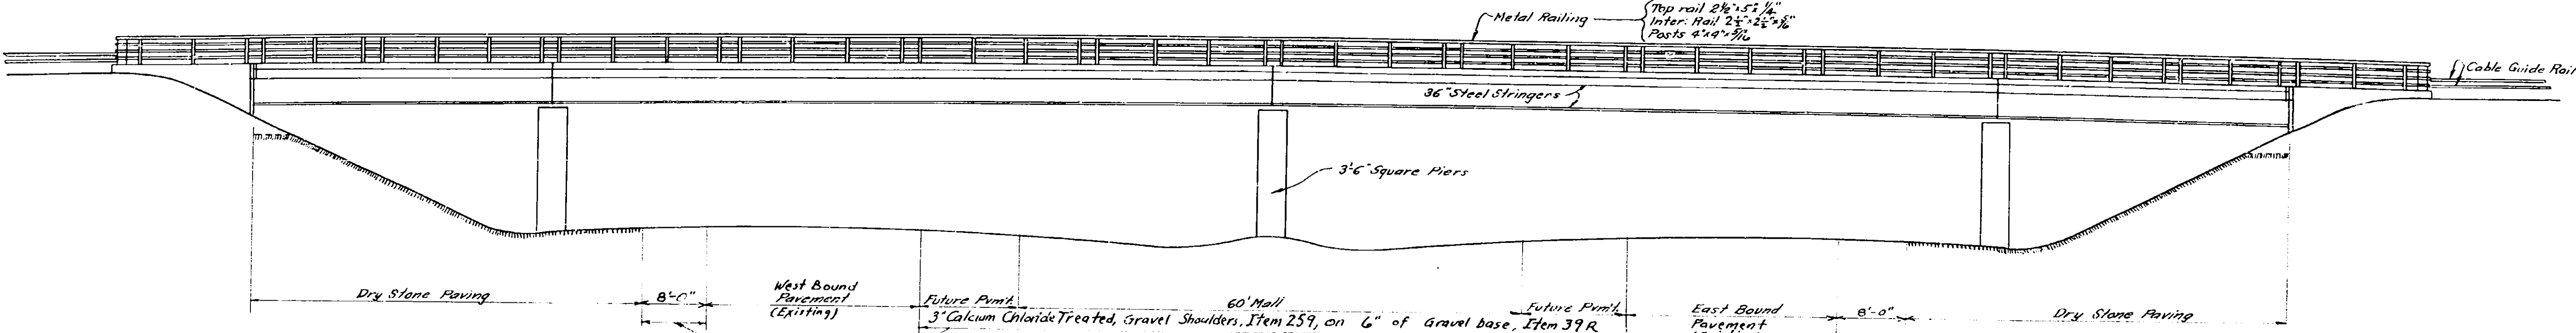

ELEVATION EAST PORTAL
(WEST PORTAL SIMILAR)
SCALE: 1" = 10'-0"

CHITTENANGO - LAKEPORT ROAD BRIDGE
STA. 278+18.40
ARCHITECTURAL LAYOUT

Dayton
T.A. LaZot
me:unat

FED. AID DIST. NO.	STATE	FED. AID PROJ. NO.	FISCAL YEAR	SHEET NO.	TOTAL SHEETS
	N.Y.			27	67
MOHAWK			THRUWAY		
FROM			TO		
MADISON			COUNTY		

THRUWAY PROFILE ALONG THEORETICAL GRADE

CHITTENANGO-LAKEPORT ROAD
SECTION ADJACENT TO BRIDGE
Scale: 1"=5'-0"

ESTIMATE OF QUANTITIES

ITEM	DESCRIPTION	UNIT	NEAT	ROUNDED
5	Trench Culvert & Bridge Excavation	C.Y.	225	275
15-2	Portland Cement Type 2	bbf.	1120	1170
15-N	Natural Cement Type N	bbf.	160	188
18	Class 1A Concrete for Structures	C.Y.	453	465
20	Class 1 Concrete	C.Y.	254	270
25F	Steel Fabric Reinforcement	S.Y.	1003	1050
28	Bar Reinf. for Structures	lbs.	29867	30000
28A	Spiral Bar Shear Connectors	lbs.	1550	1600
29	Structural Steel	lbs.	296523	306000
37	Metal Railings	L.F.	552'-6"	560
41B	Cement Conc. Pavement	C.Y.	73	75
79	Dry Stone Paving	S.Y.	380	400
85	Steel Bearing Piles - 10"H @ 42"	ft.	5634	5650
87	Furnishing Equip. for Driving Piles	L.S.	Neg	Neg.
121	Top Soil Placed from Stock piles	C.Y.	183	200
123B	Seeding on Prepared Areas	Ac.	.271	.300
124	Sodding	S.Y.	329	350

LONGITUDINAL SECTION A-A
Scale: 1"=10'-0"CHITTENANGO - LAKEPORT ROAD BRIDGE
STA 278+13.40
LAYOUT


Location	Length	No. Piles	Size
North Vertical	72	11	10" @ 42"
Abut. Batter	74	5	10" @ 42"
North Pier (Batter)	65	19	10" @ 42"
Center Pier	59	10	10" @ 42"
South Pier	59	10	10" @ 42"
South Vertical	73	11	10" @ 42"
Abut. Batter	75	5	10" @ 42"

The contractor shall order & drive steel bearing piles of the size & length indicated above. Payments will be made under Item 85 for design purposes. The assumed load per pile does not exceed 37 tons.


Road fill to this general limit shall be placed and thoroughly compacted before the abutment excavation is made.

Placing of any piles for the structure will not be permitted until the highway embankments adjacent to the structure have been placed and consolidated in a manner and for a time satisfactory to the Deputy Chief Engineer - Bridges. Great care must be taken in structures.

Made by R. J. Smith
Checked by R. J. Smith
Approved by R. J. Smith

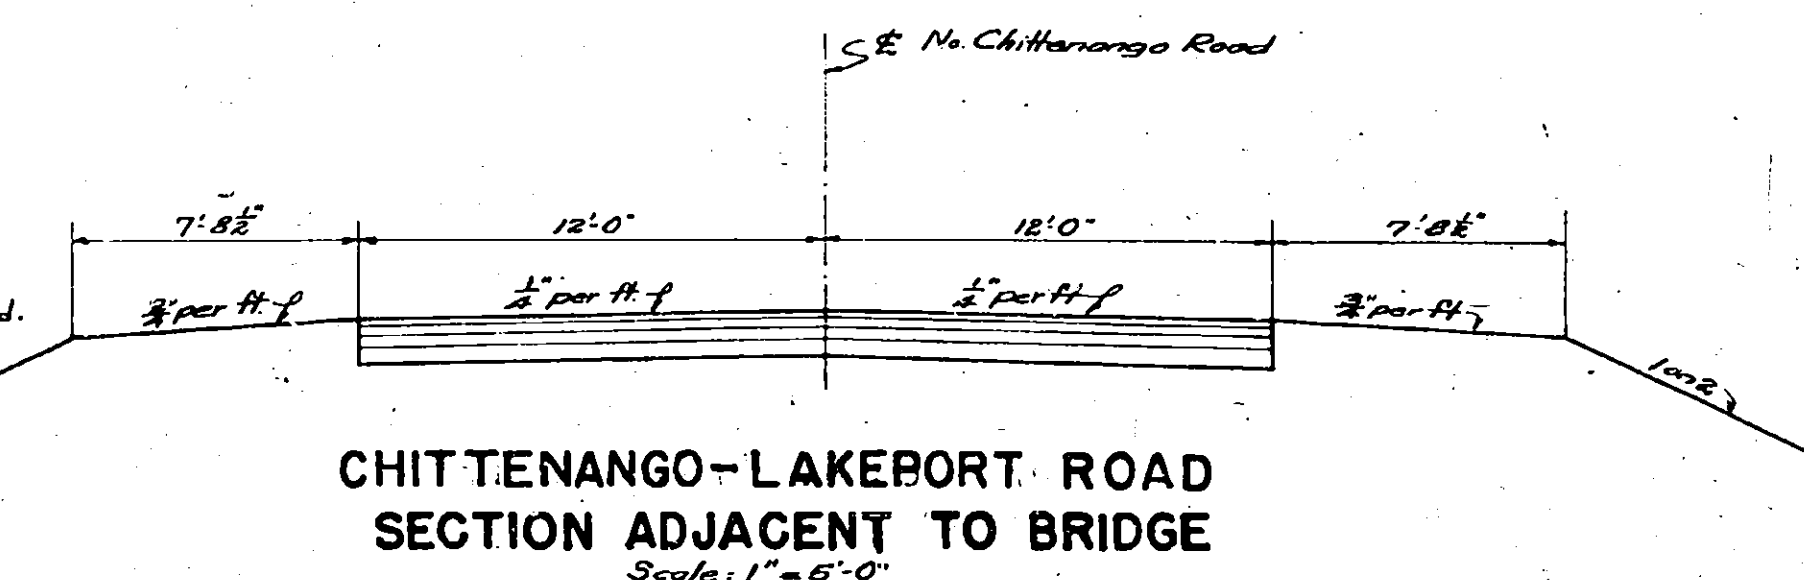

Final Total of Contract Quantities			
ITEM	DESCRIPTION	UNIT	Final Quantity
5	Trench Culvert & Bridge Extension	CY	352.3
15-2	Portland Cement Type 2	bbl	1,084.8
16-N	Natural Cement Type N	bbl	159.0
18	Class 1A Concrete for Structures	CY	453.37
20	Class 1 Concrete	CY	235.84
25F	Steel Fabric Reinforcement	SY	1,003.
28	Bar Reinf. for Structures	lbs.	84,473
28A	Spiral Bar Shear Connectors	lbs.	1,624
29	Structural Steel	lbs.	284,250
37	Metal Nailing	L.F.	560.00
47B	Cement Conc. Pavement	SY	89.67
79	Dry Stone Paving, 5"	SY	403.1
85	Steel Bearing Piles - 10"H @ 42#	ft.	5,634.0
87	Furnishing Equip. for Driving Piles	D.S.	20.76
121.	Top Soil Hauled from Stock piles	CY	142.1
123B	Seeding on Prepared Areas - 100% Seeding	Ac.	0.360
124.	Sodding	SY	247.1

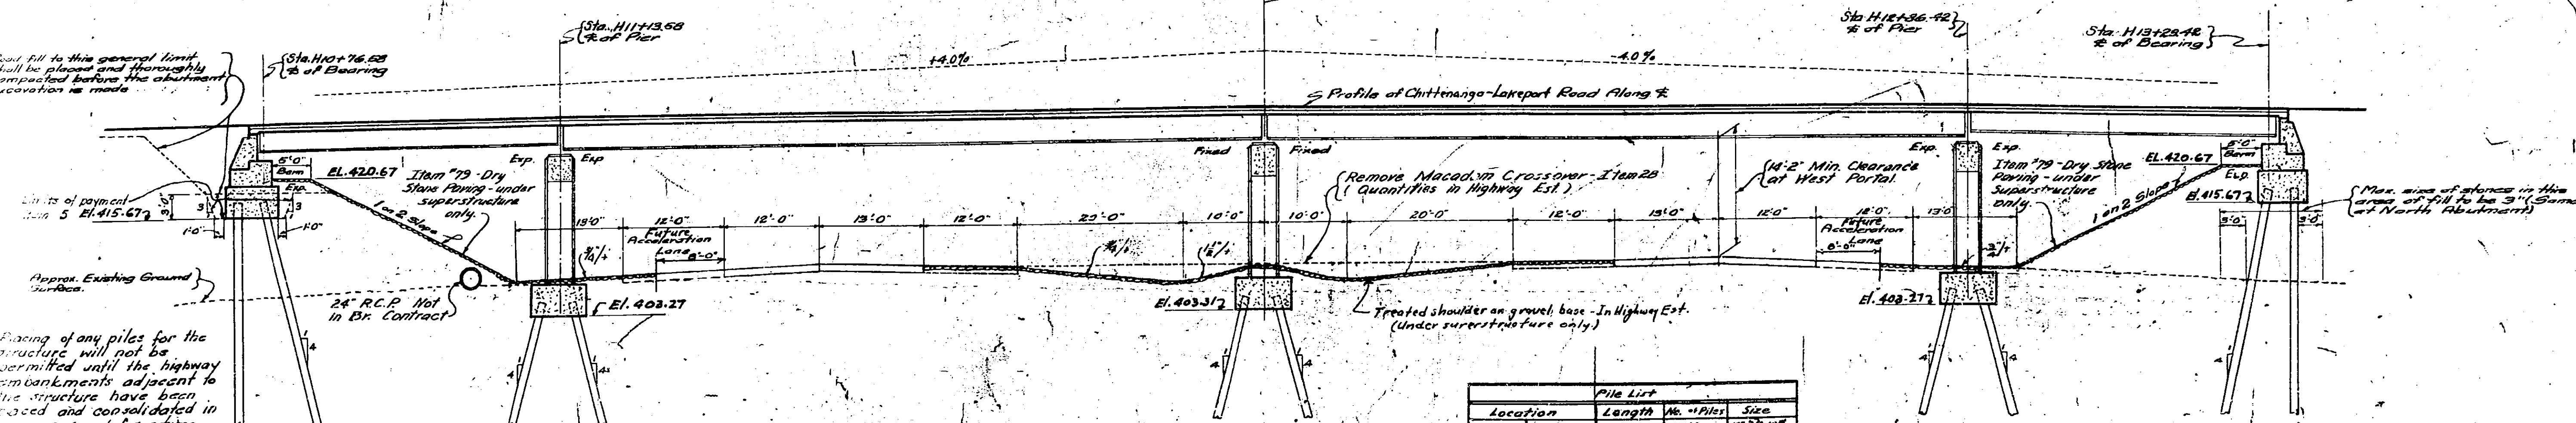


LONGITUDINAL SECTION A-A
Scale: 1" = 10'-0"

Pile List			
Location	Length	No. Piles	Size
North Vertical	72	11	10"BP 42
Abut. Batter	74	5	10BP 42
North Pier Vertical	65	10	10"BP 42
Center Pier "	53	10	10BP 42
South Pier "	53	10	10BP 42
South Vertical	72	11	10BP 42
Abut. Batter	75	5	10BP 42


The contractor shall order & drive steel bearing piles of the size & length indicated above. Payments will be made under Item B5. For design purposes the assumed load per pile does not exceed 38 Ton

CHITTENANGO LAKEPORT ROAD BRIDGE
STA. 278+18.40
LAYOUT


FED. AID DIST. NO.	STATE	FED. AID PROJ. NO.	FISCAL YEAR	SHEET NO.	TOTAL SHEETS
				28	67
MDHAWK THRUWAY					
FROM TO					
MADISON COUNTY					

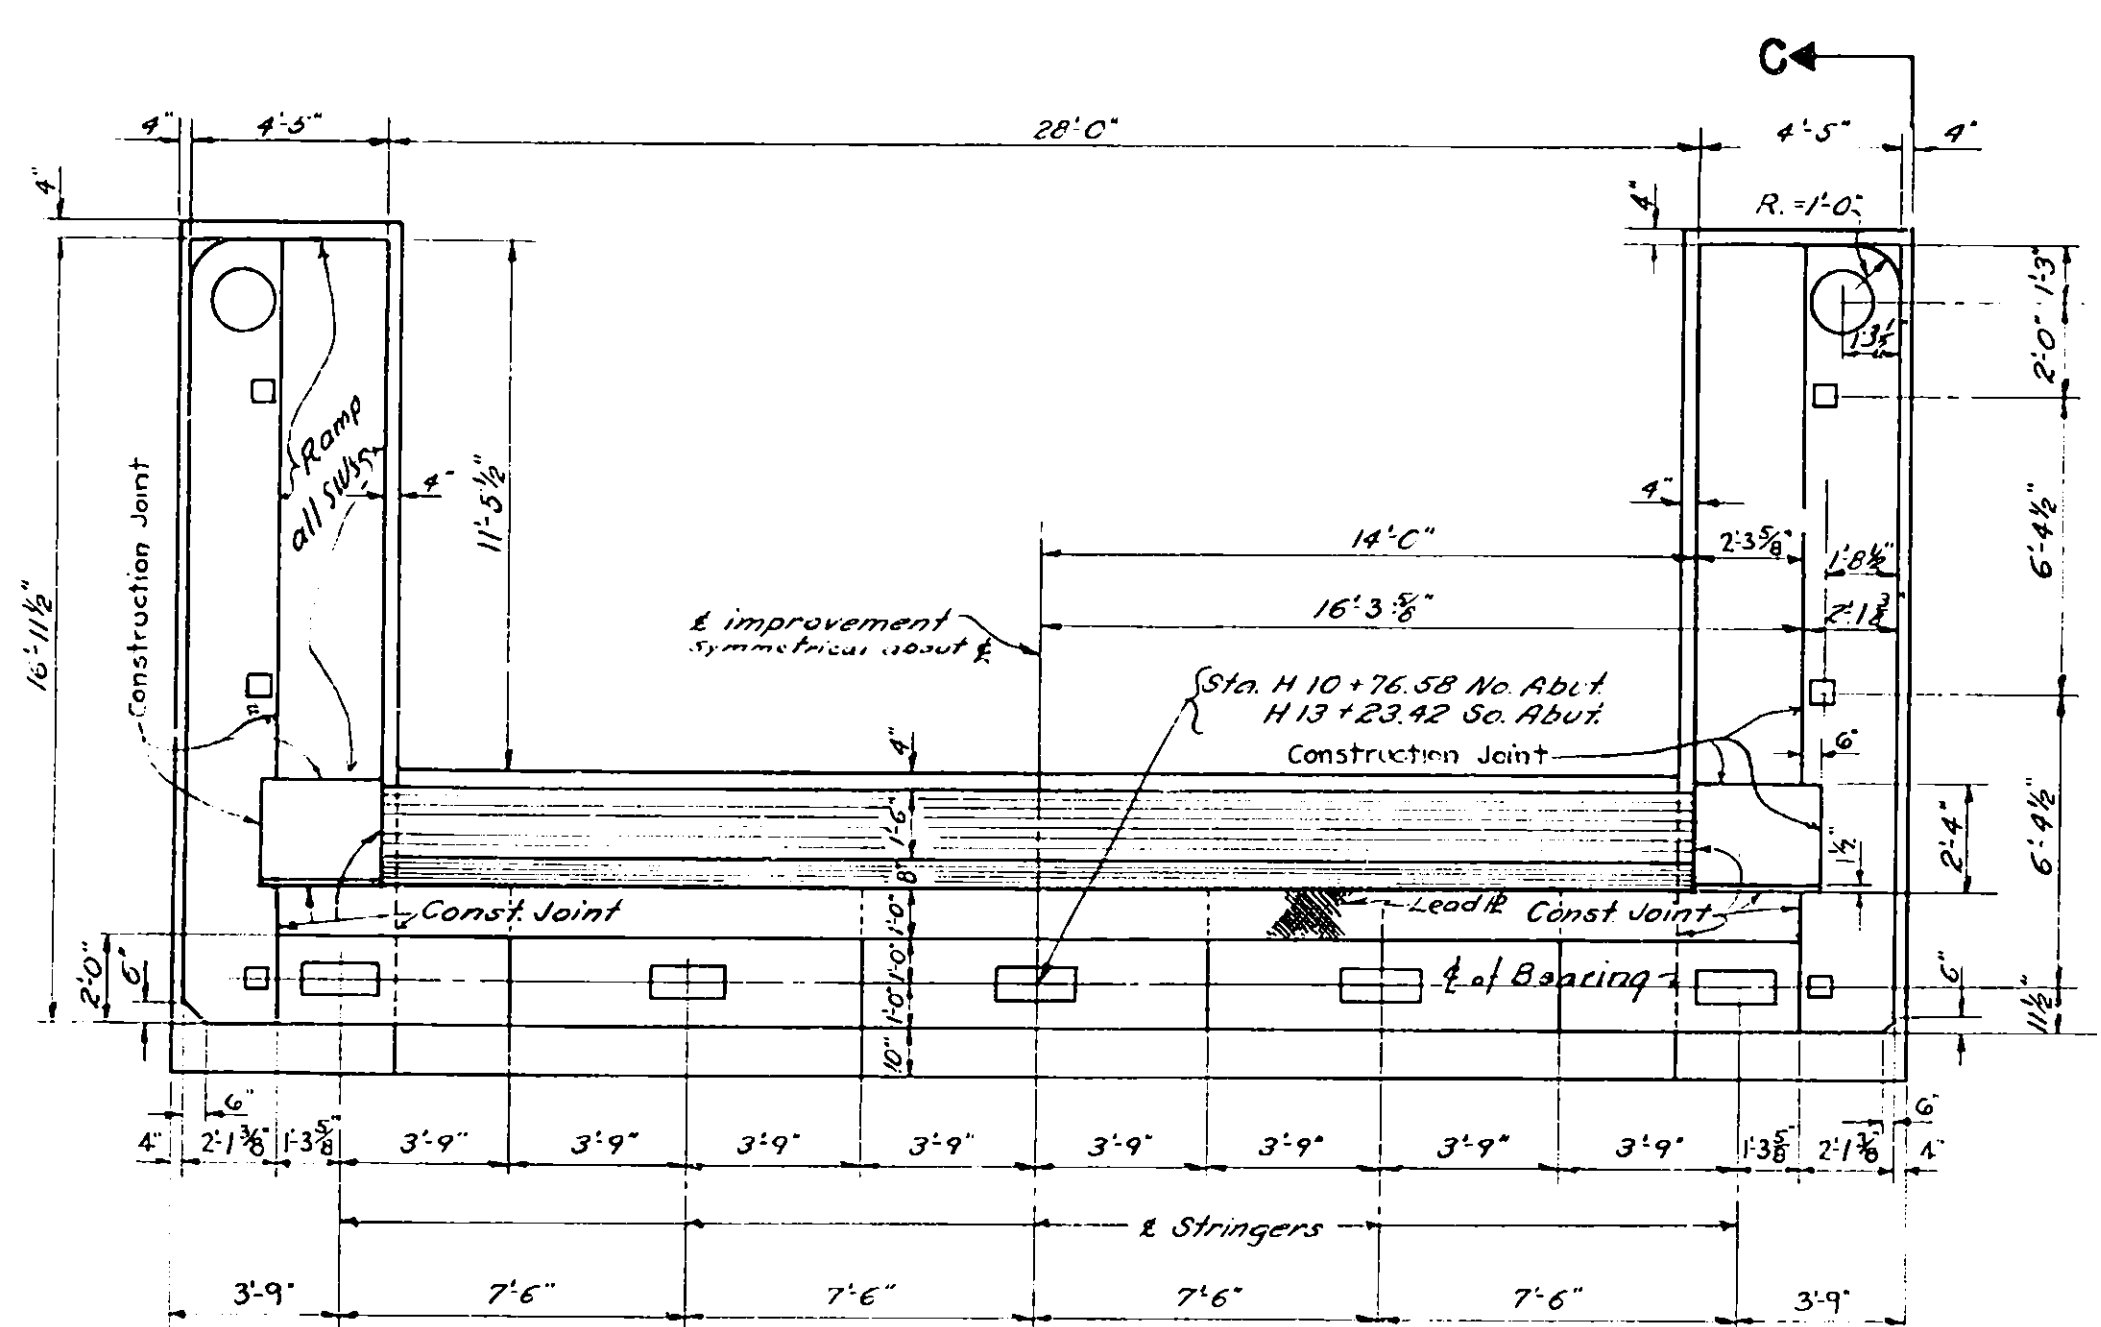


PLAN OF EITHER ABUTMENT
SCALE: 1/4" = 1'-0"

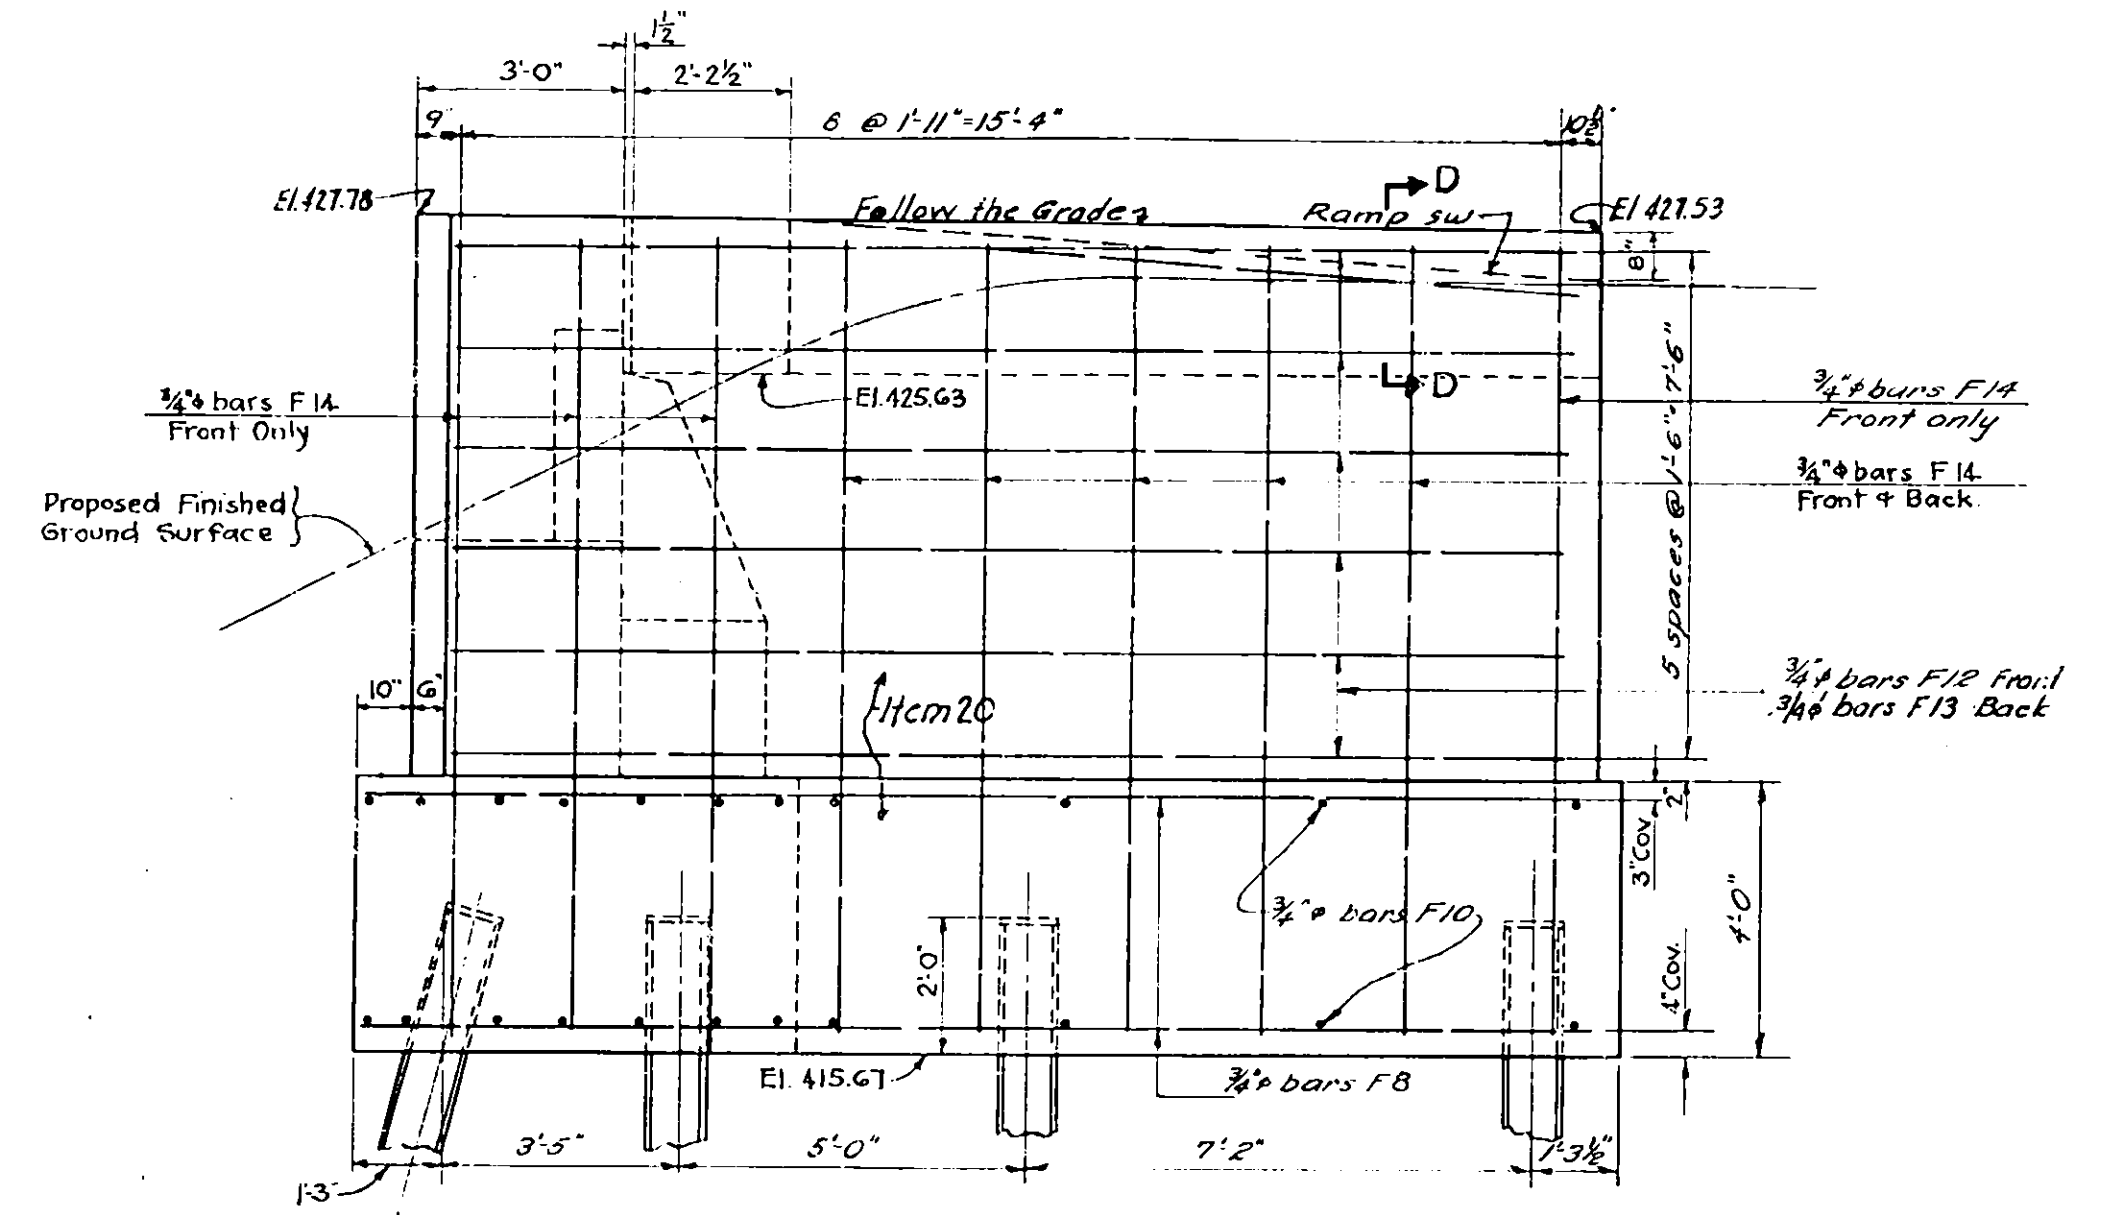


VIEW C-C
SCALE: 3/8" = 1'-0"

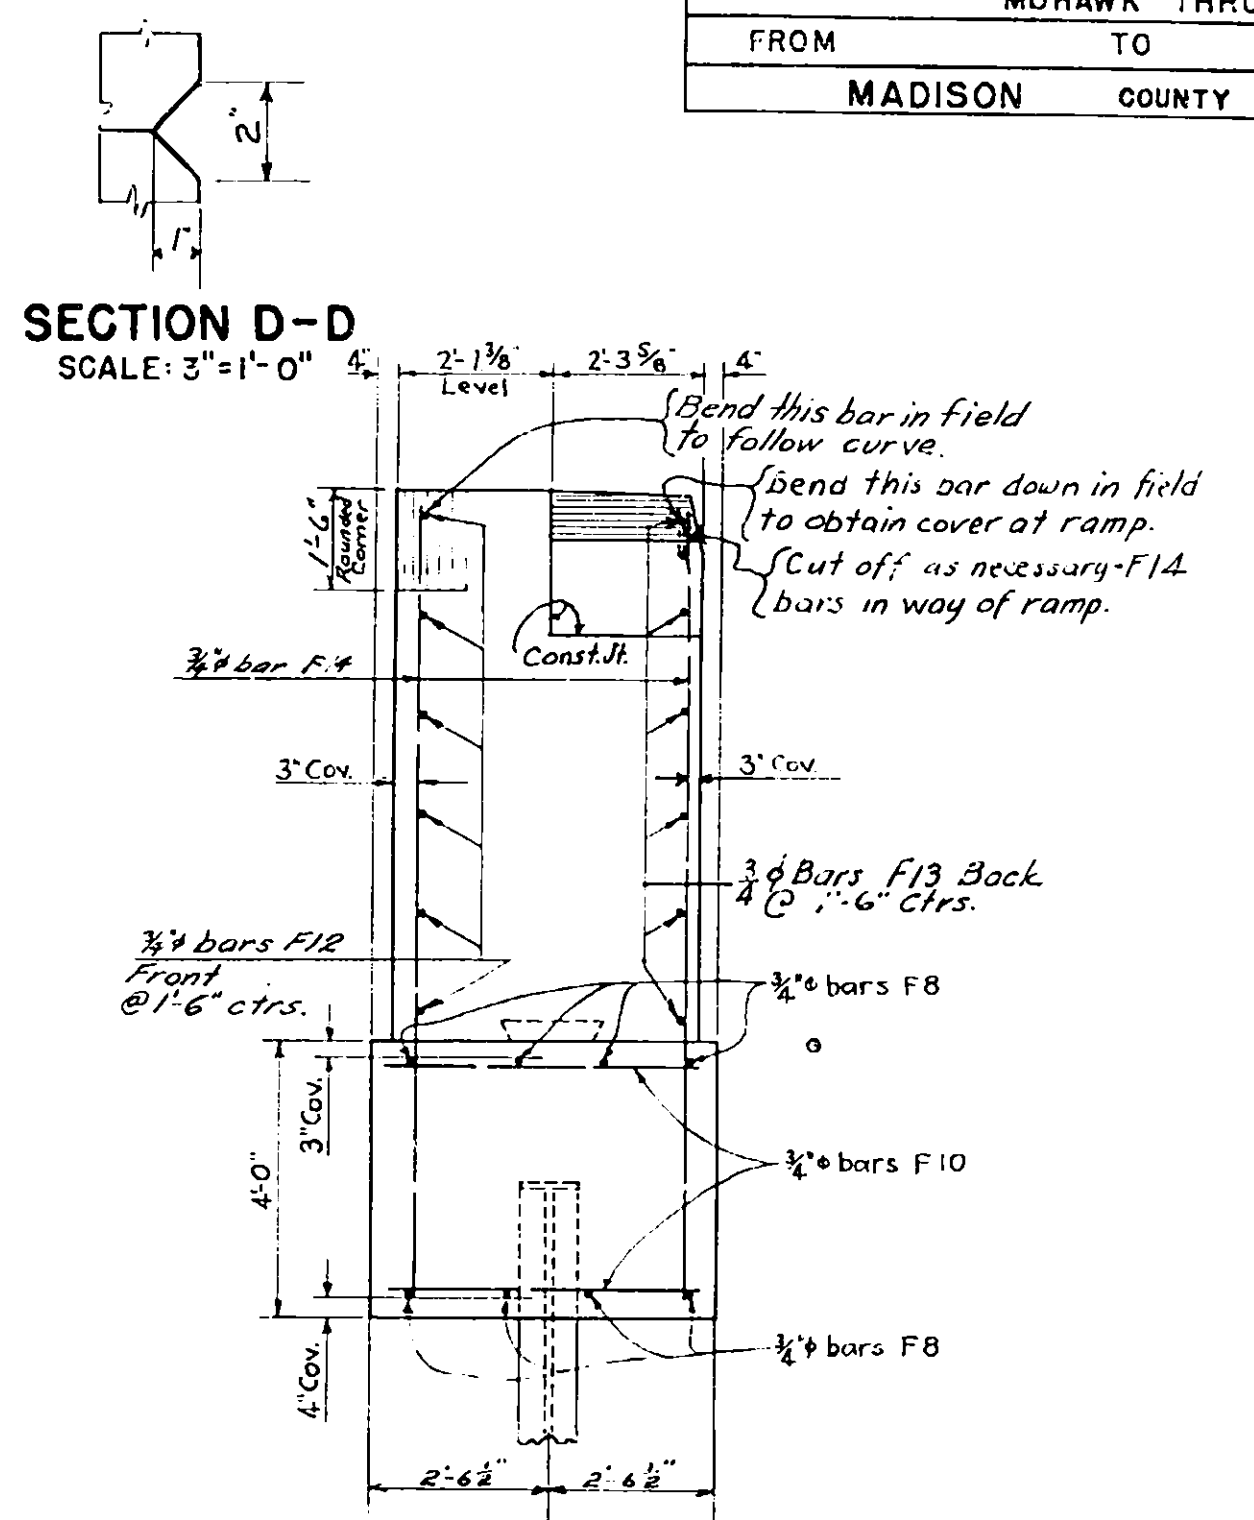


SECTION D-D
SCALE: 3" = 1'-0"

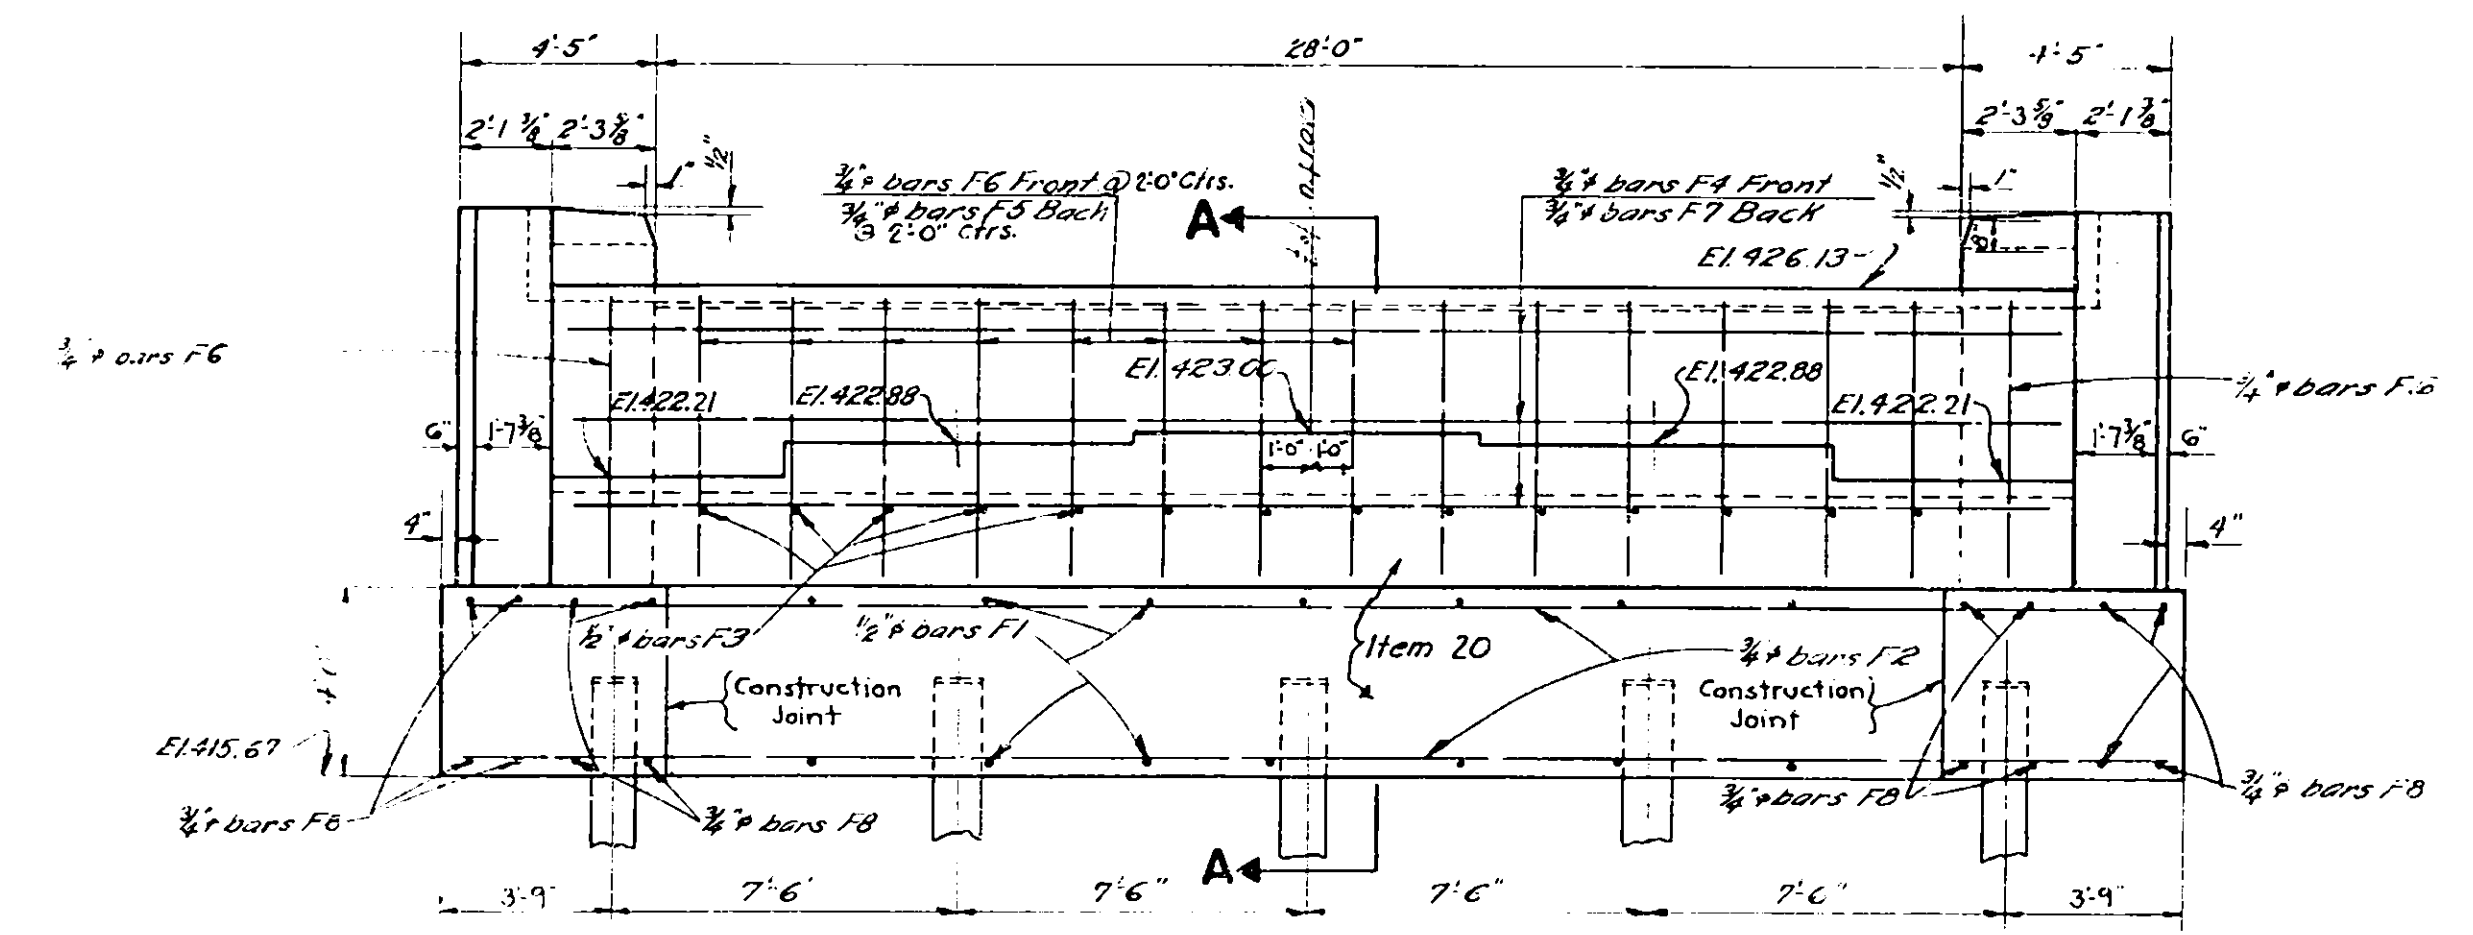


FRONT ELEVATION OF EITHER ABUTMENT
SCALE: 1/4" = 1'-0"

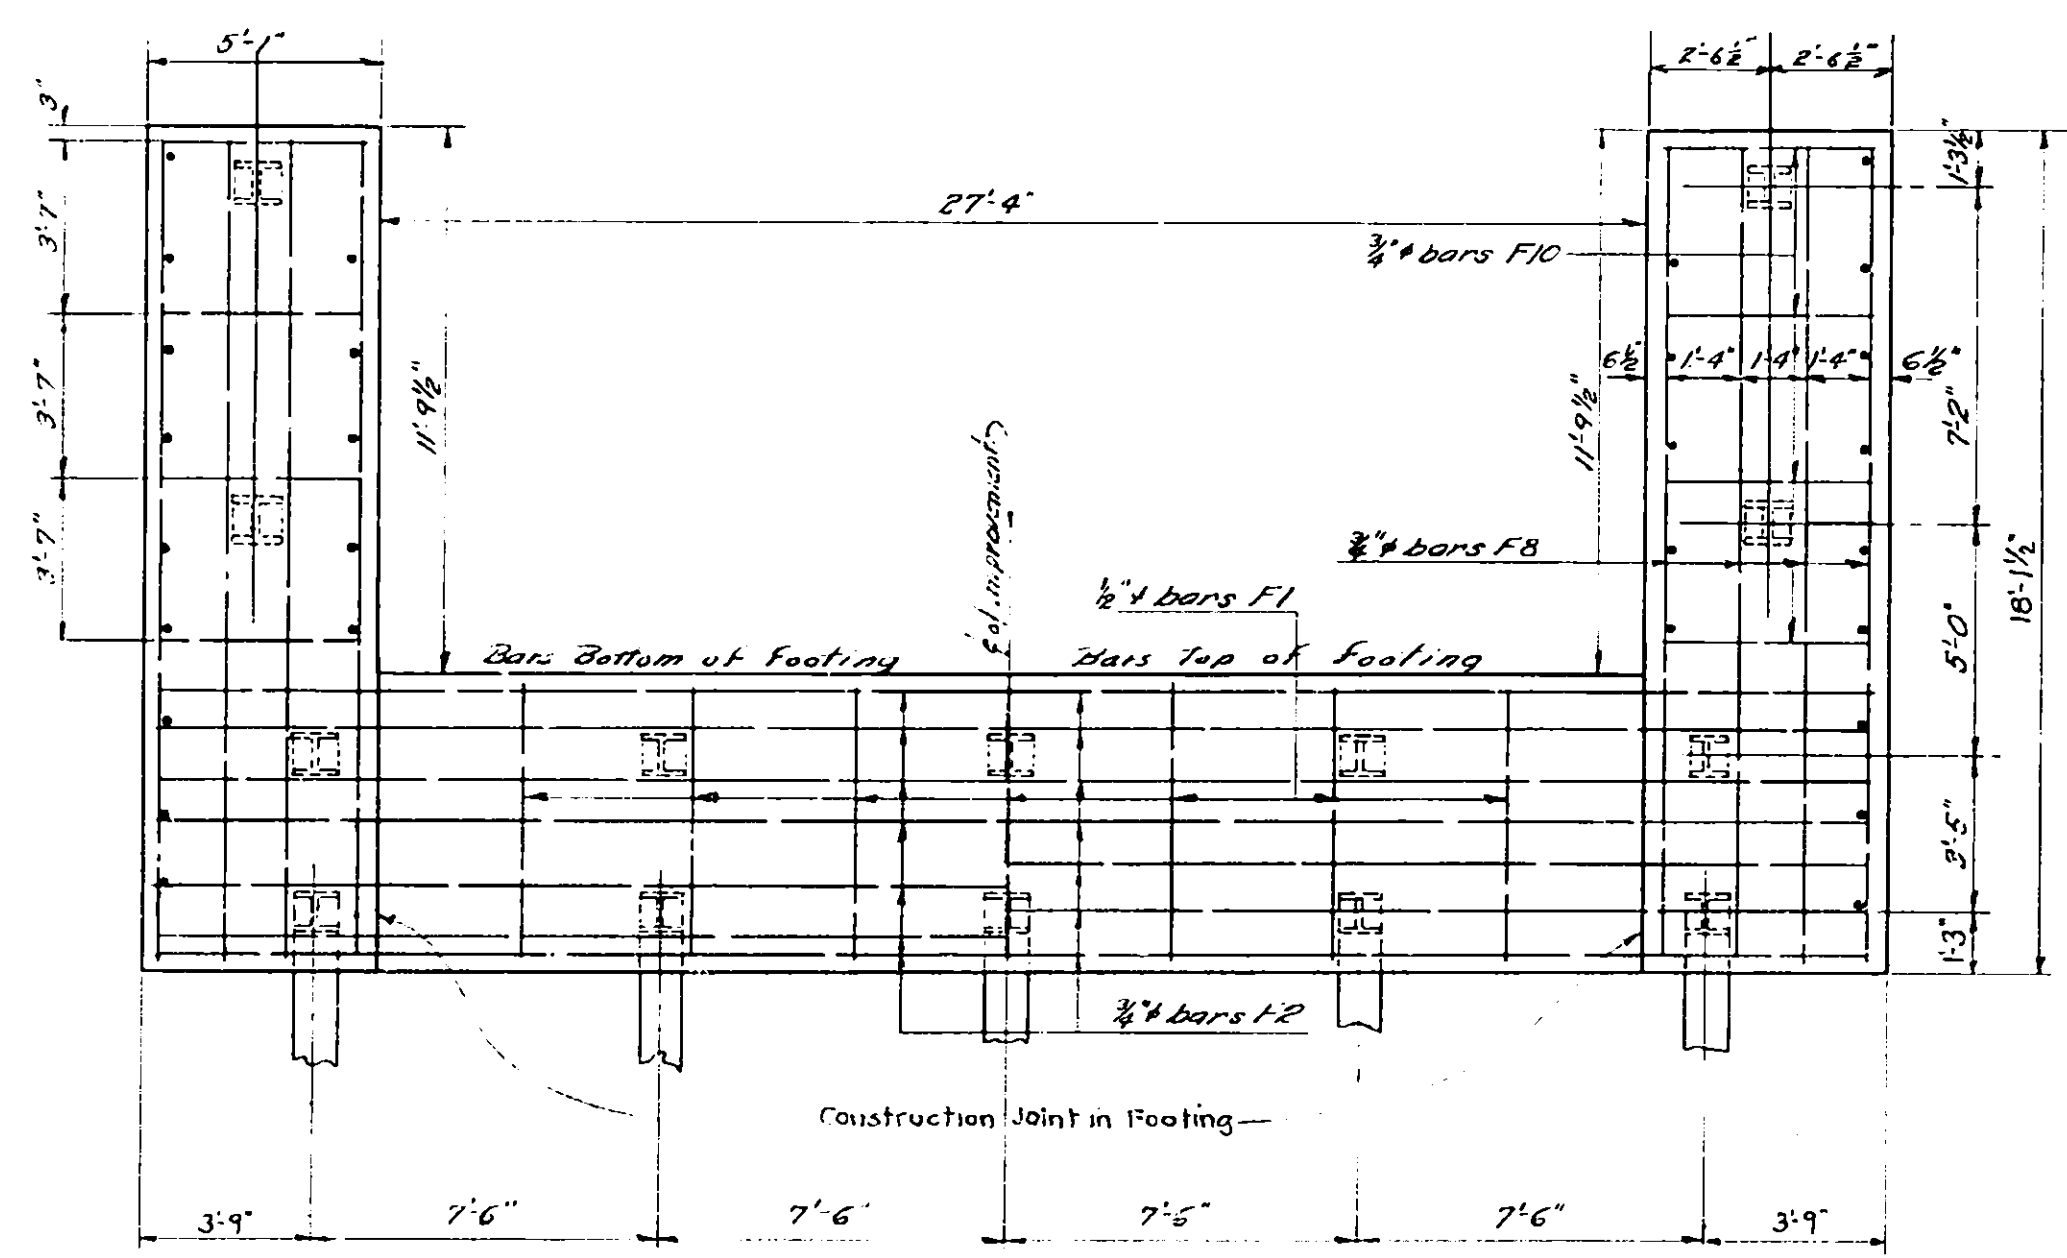


PILE AND BAR LOCATION PLAN
FOOTINGS
SCALE: 1/4" = 1'-0"

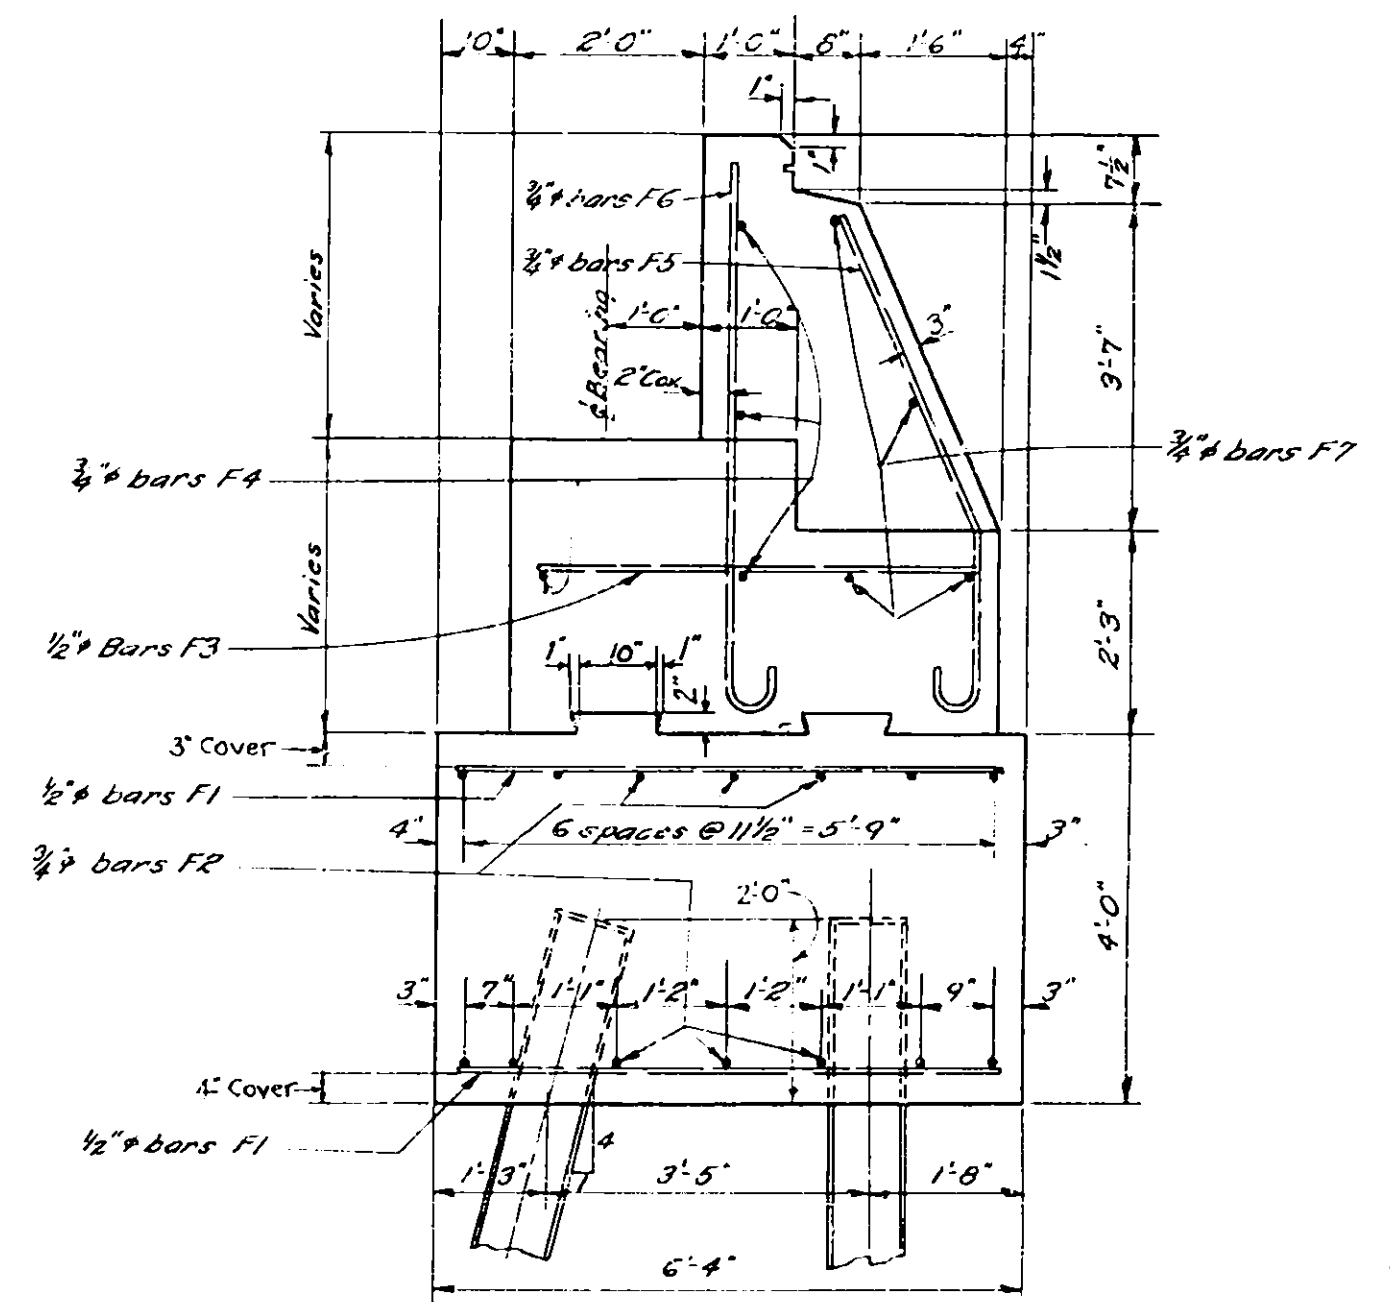


SECTION A-A
SCALE: 1/2" = 1'-0"

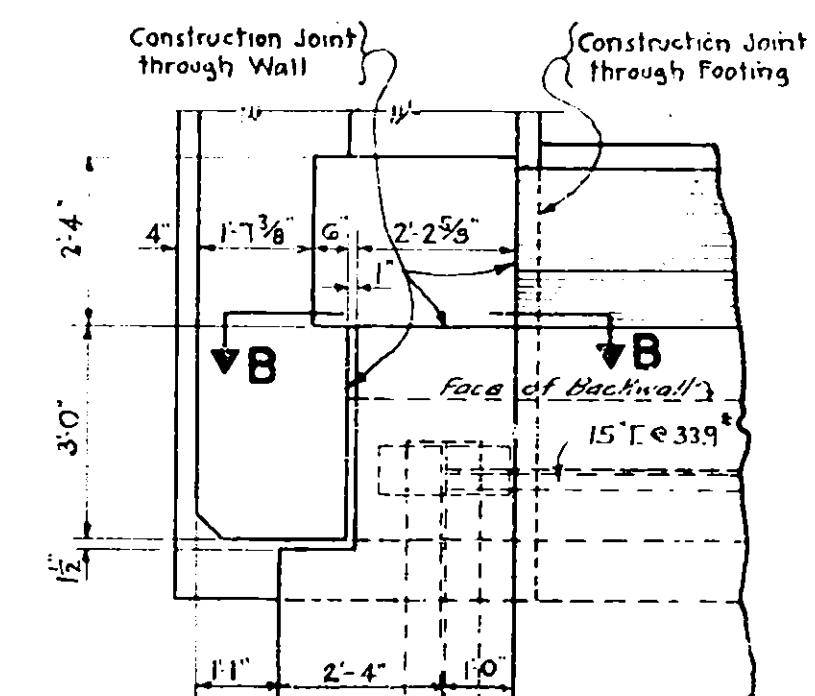

PARTIAL PLAN PRIOR TO PLACING FLASHING
SCALE: 3/8" = 1'-0"

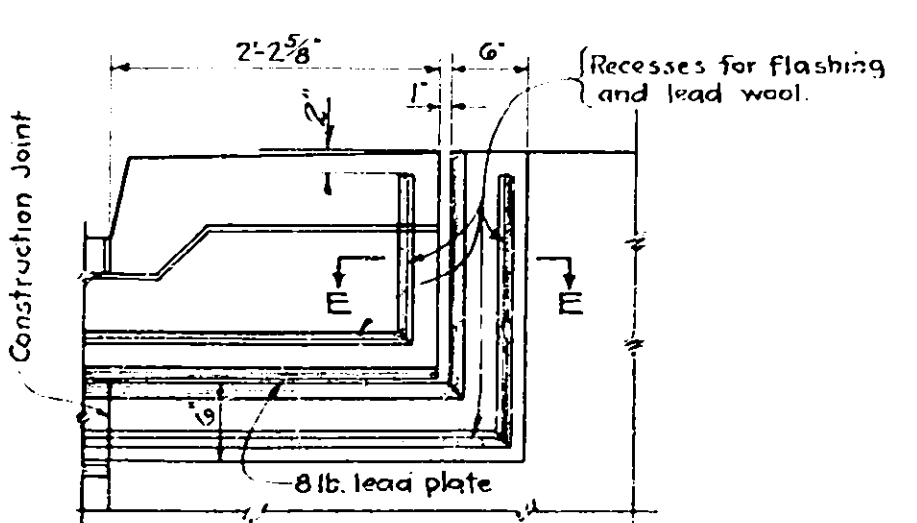

SECTION B-B
SCALE: 3/4" = 1'-0"

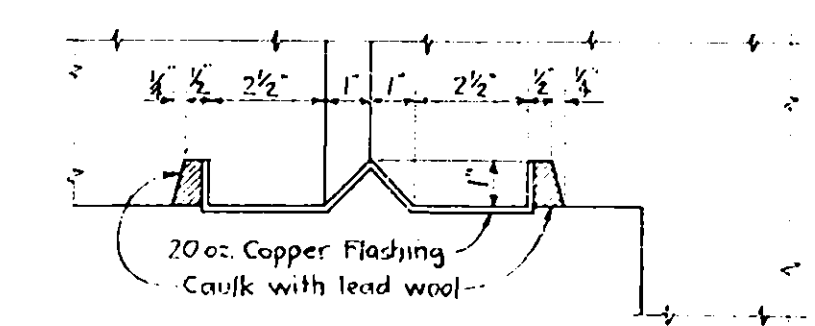

SECTION E-E
SCALE: 3" = 1'-0"

CHITTENANGO - LAKEPORT ROAD BRIDGE
STA. 278+18.40
ABUTMENTS

DESIGNED BY: J. S. WILSON
CHECKED BY: J. S. WILSON
DATE: 10/1/55

FED. AID DIST. NO.	STATE	FED. AID PROJ. NO.	FISCAL YEAR	SHEET NO.	TOTAL SHEETS
	N.Y.			29	67
MOHAWK			THURWAY		
FROM			TO		
MADISON			COUNTY		

Concrete in Abutments shall be Item 20.
Concrete in Piers shall be Item 18.
Concrete in Superstructure shall be Item 18, except the concrete pavement which shall be Item 47b.
Construction joints other than those shown on the plans will not be permitted except by written permission of the Deputy Chief Engineer.
All holes to be $\frac{1}{16}$ " except as noted.
Rivets to be $\frac{1}{2}$ " diameter unless otherwise noted.
Field connections to be made with rivet bolts or equal.

Camber all beams as indicated on the plans.
After the concrete is cured the contractor shall apply a waterproofing oil treatment of M-11W or M-415 to all exposed concrete surfaces, except the underside of slabs, in accordance with the specifications of Items 18, 20, and 47B.

Reinforcement bars may be spliced at places other than those shown on the plans if approved by the Engineer. Bars so spliced shall be lapped 45 diameters minimum.

The cost of furnishing and installing caulking compound, copper flashing, premoulded bituminous joint material, miscellaneous material not covered by Item nos. shall be included in the prices bid for the various items of the contract.

Items of the contract.

Caulking compound shall be "Vulcatex" or its approved equal. Joints must be thoroughly cleaned and dry before caulking with material. Caulking must be the minimum fraction of the caulking compound, 80 to 90 minutes before the caulking compound is placed. Work must be performed by workman experienced in this type of work. Vulcatex is manufactured by A.C. Horn Co. Long Island City, New York.

All welding to be electric arc welding and shall conform to the American Welding Society specifications for welded highway bridges 1947 and current modifications.

Material and fabrication specifications of N.Y. State Dept. of Public Works January 2, 1951 and current modifications.

37. Dimensions for tubing are outside dimensions.

Payment for furnishing and installing anchor bolts, nuts, washers, and anchor plates shall be made under Item 29.

Shop or field welding may be used in the fabrication and erection of the railing.

Design Specifications - AASHTO 1949 - Loading H20-44 and current modifications.

The contractor's attention is directed to the special notes for this structure which appear in the proposal. Particular attention should be

given to the foundation note, which briefly outlines the anticipated subsurface conditions at the site of the structure and which specifies certain requirements


Electrodes of A.W.S. Class E6015 or E6016 shall be used for welding steel exceeding 1" in thickness.

For design purposes the assumed load per pile


does not exceed 37 Tons.

Immediately before placing pavement concrete, the concrete surface(s) upon which it is to be placed shall be thoroughly and continuously wetted for one hour if the air temperature is above

continuously wetted for one hour, if the air temperature is above 50°F. Payment will be made under Items 1W and 1WA in highway estimate.

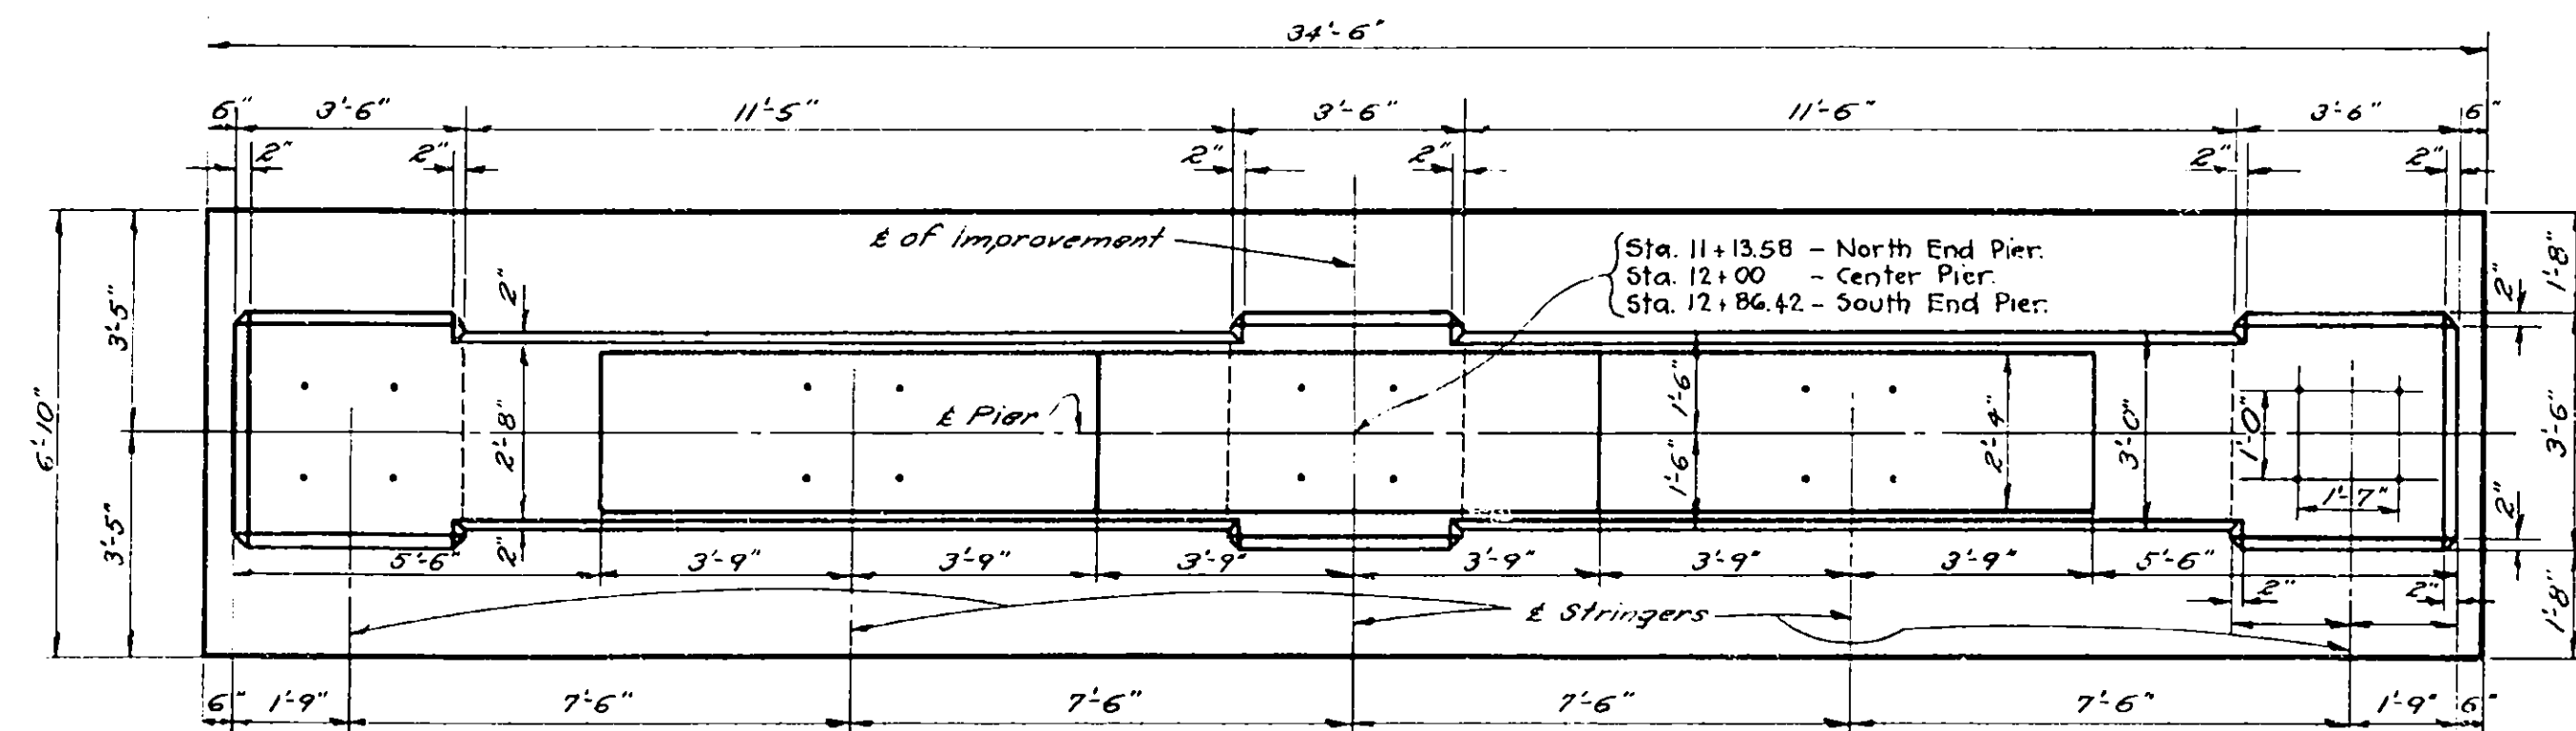


PIER PLAN
SCALE : 3/8"=1'-0"

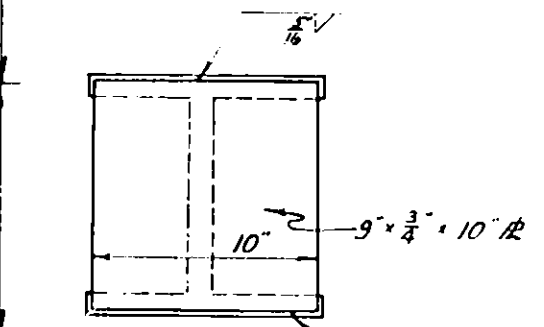


DETAIL OF PILE CAP


BAR - LIST									
MARK	TY.	SIZE	LENGTH	NO.	A	B	C	D	LOCATION
A1	STR.	#8	32'-5"	356					Transverse bars in slab. Bottom
A2	III	#8	35'-11"	356	10"	34'-3"	3'-3"	2'-1"	Transverse bars in slab. Top
B1	STR.	#8	38'-8"	152					Long. bar in end Span.
B2	STR.	#8	44'-2"	304					Long bar in Clr Span.
F1	STR.	#8	5'-10"	28					Trans. Bar T & B Footing.
F2	STR.	#8	37'-0"	28					Long. Bar T & B Footing.
F3	STR.	#8	4'-10"	28					Trans. bar in Abutment.
F4	STR.	#8	32'-0"	28					Long. bar in front of Abutment.
F5	I	#8	6'-3"	8					Vertical bar back of Backwall.
F6	I	#8	6'-9"	32	1'-0"	5'-9"	4'-8"	3"	Vertical bar front of Backwall.
F7	STR.	#8	27'-8"	8					Long. bar in back of Backwall.
F8	STR.	#8	17'-2"	32					Long. bar in Wall Footing
B3	IV	#8	4'-0"	404					Stirrups in fascia.
F10	STR.	#8	4'-7"	32					Trans. bar in Wall Footing.
F12	STR.	#8	15'-6"	24					Hor. bar in Front Ming Wall.
F13	STR.	#8	13'-0"	24					Hor. bar in back Ming Wall.
F14	STR.	#8	11'-4"	56					Pylon Vert. Bar in Ming Wall.
P1	STR.	#8	34'-0"	34					Long Bar in Pier Footing.
P2	STR.	#8	6'-4"	108					Trans. Bar in Pier Footing.
P3	I	#8	9'-1"	144	1'-4"	7'-2"	6'-3"	4'-8"	Vertical Bar in Pier Footing.
P4	I	#8	16'-5"	144	1'-6"	4'-11"	6'-3"	4'-8"	Vertical Bar in Pier Col.
P5	II	#8	13'-0"	144	3'-24"	3'-24"			Hoops in Pier Col.
P6	III	#8	34'-3"	24	1'-2"	3'-11"	5'-4"	3'-8"	Hor. bar in Top of Pier
P7	III	#8	34'-6"	24	1'-4"	3'-11"	6"	4"	Hor. bar in Bottom of Pier
P8	I	#8	11'-10"	30	3'-2"	8'-7"			Stirrups in Pier

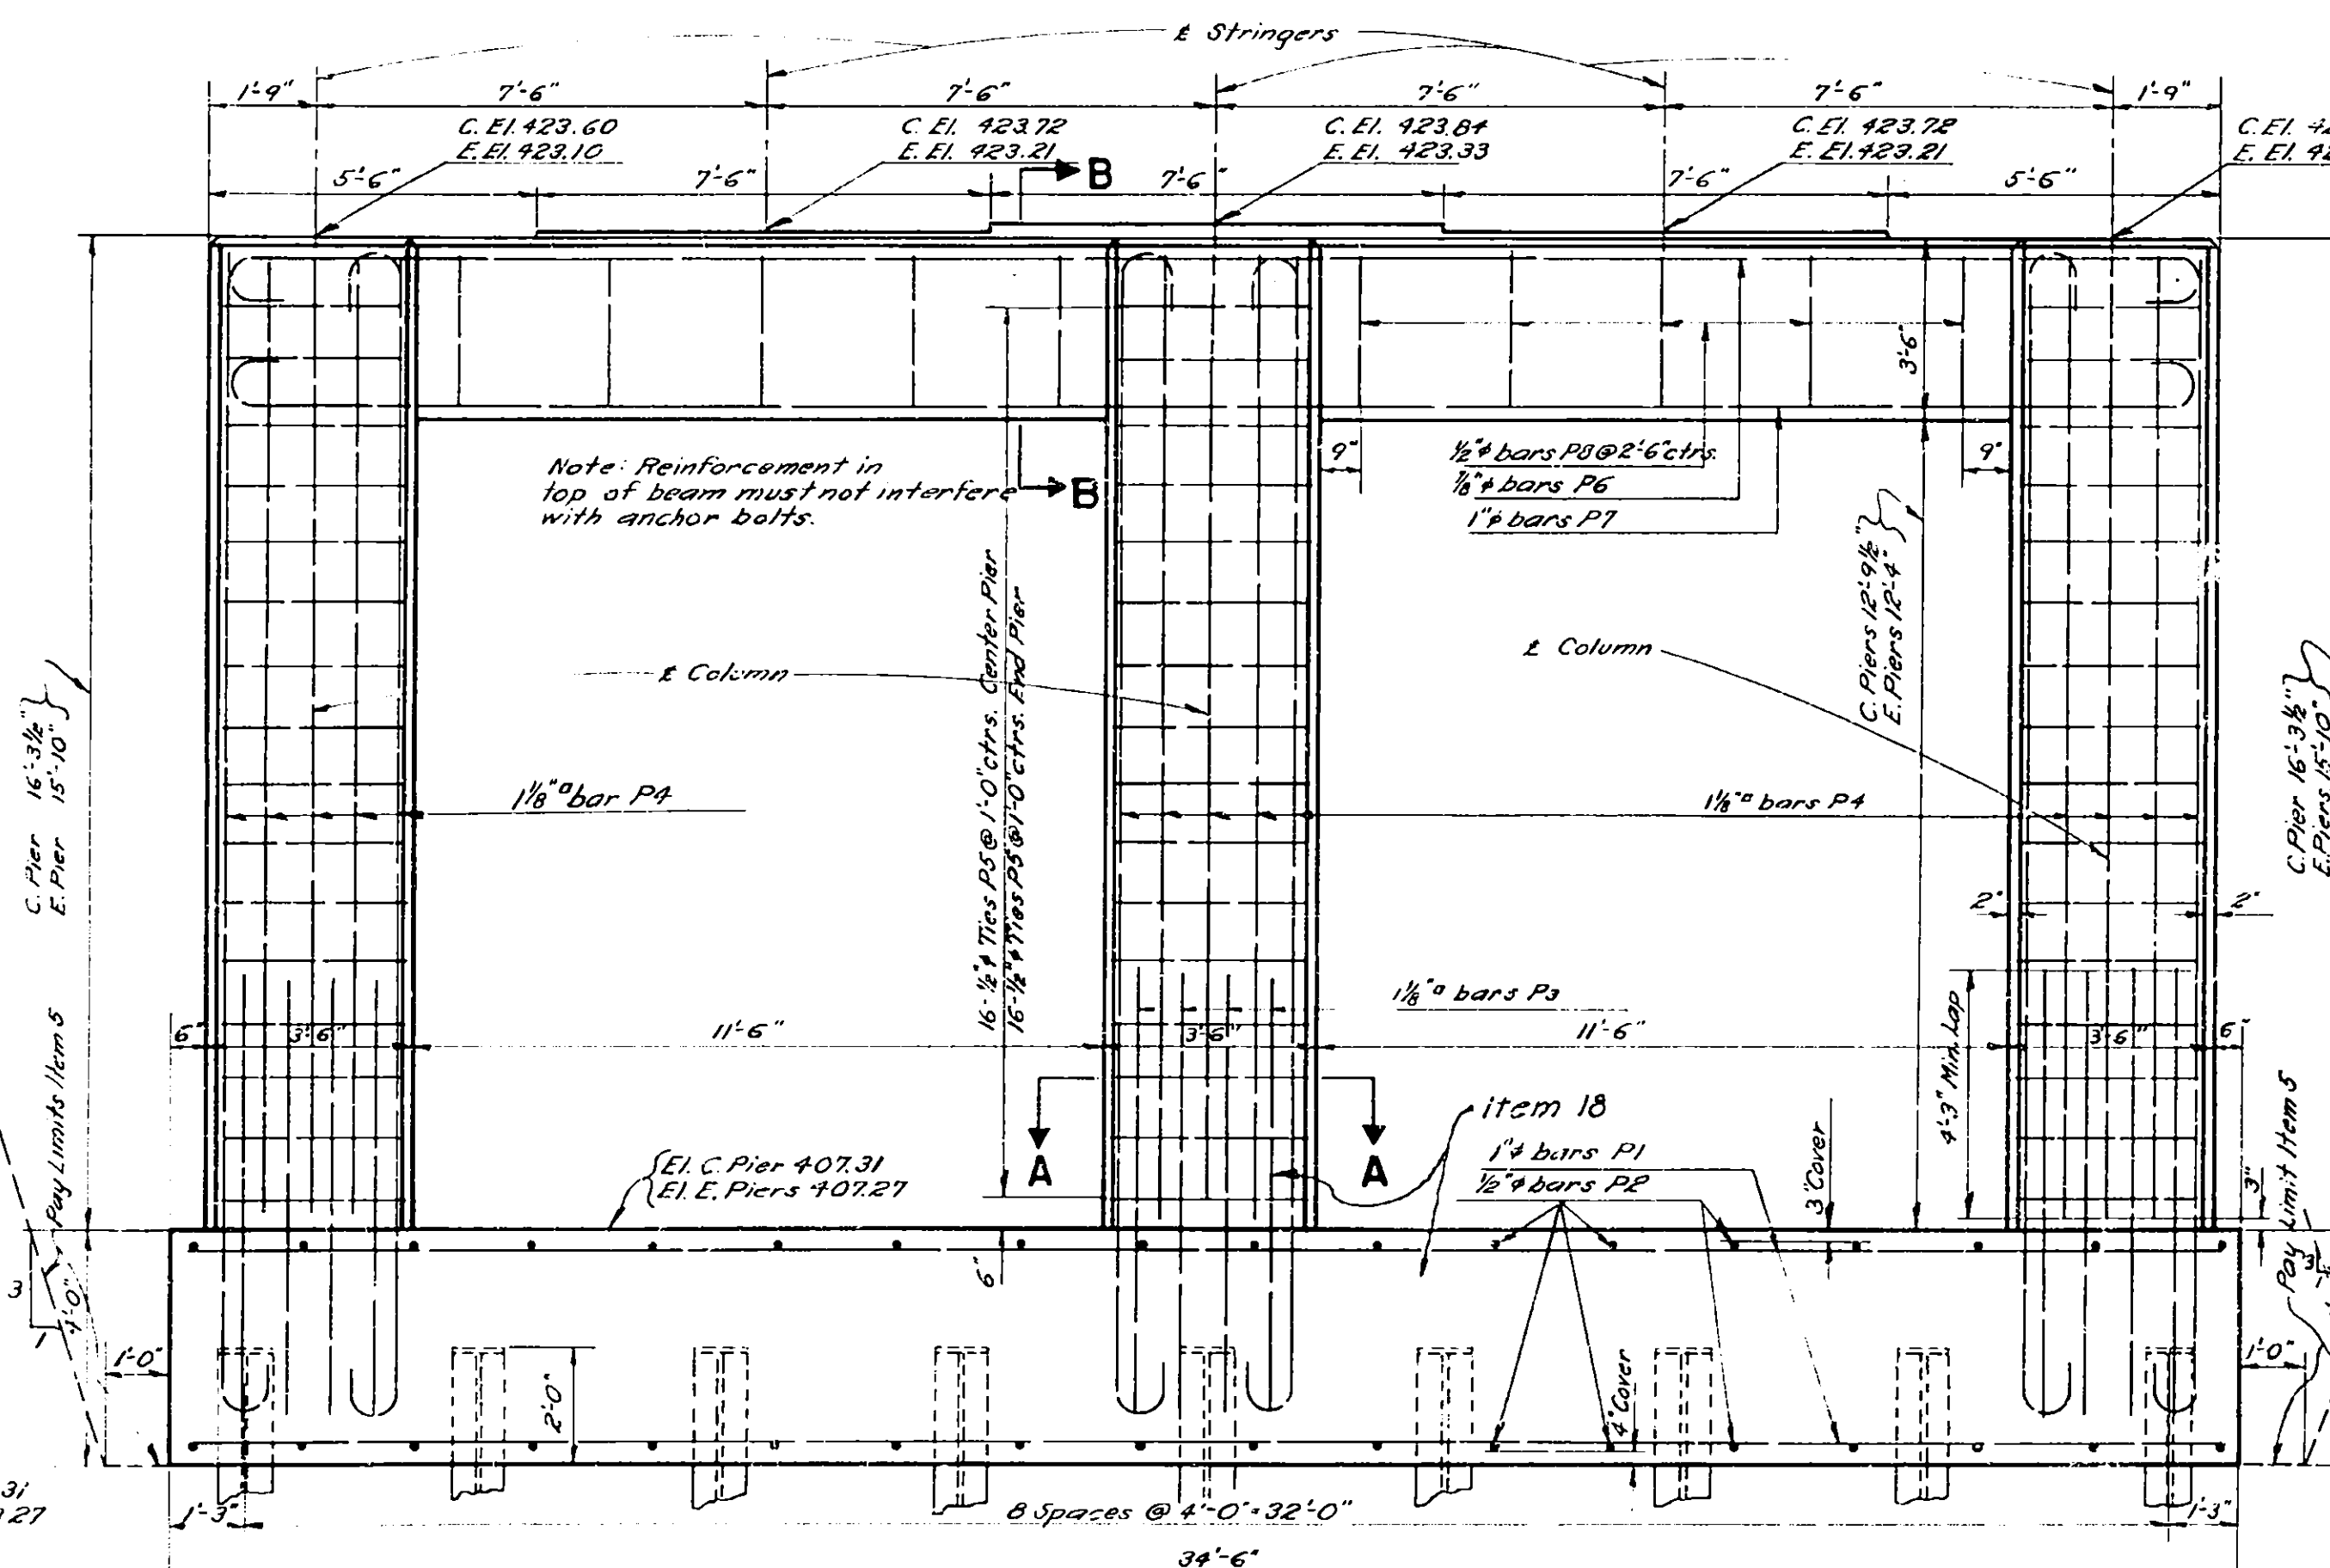


ELEVATION OF PIERS
SCALE: 3/8"=1'-0"

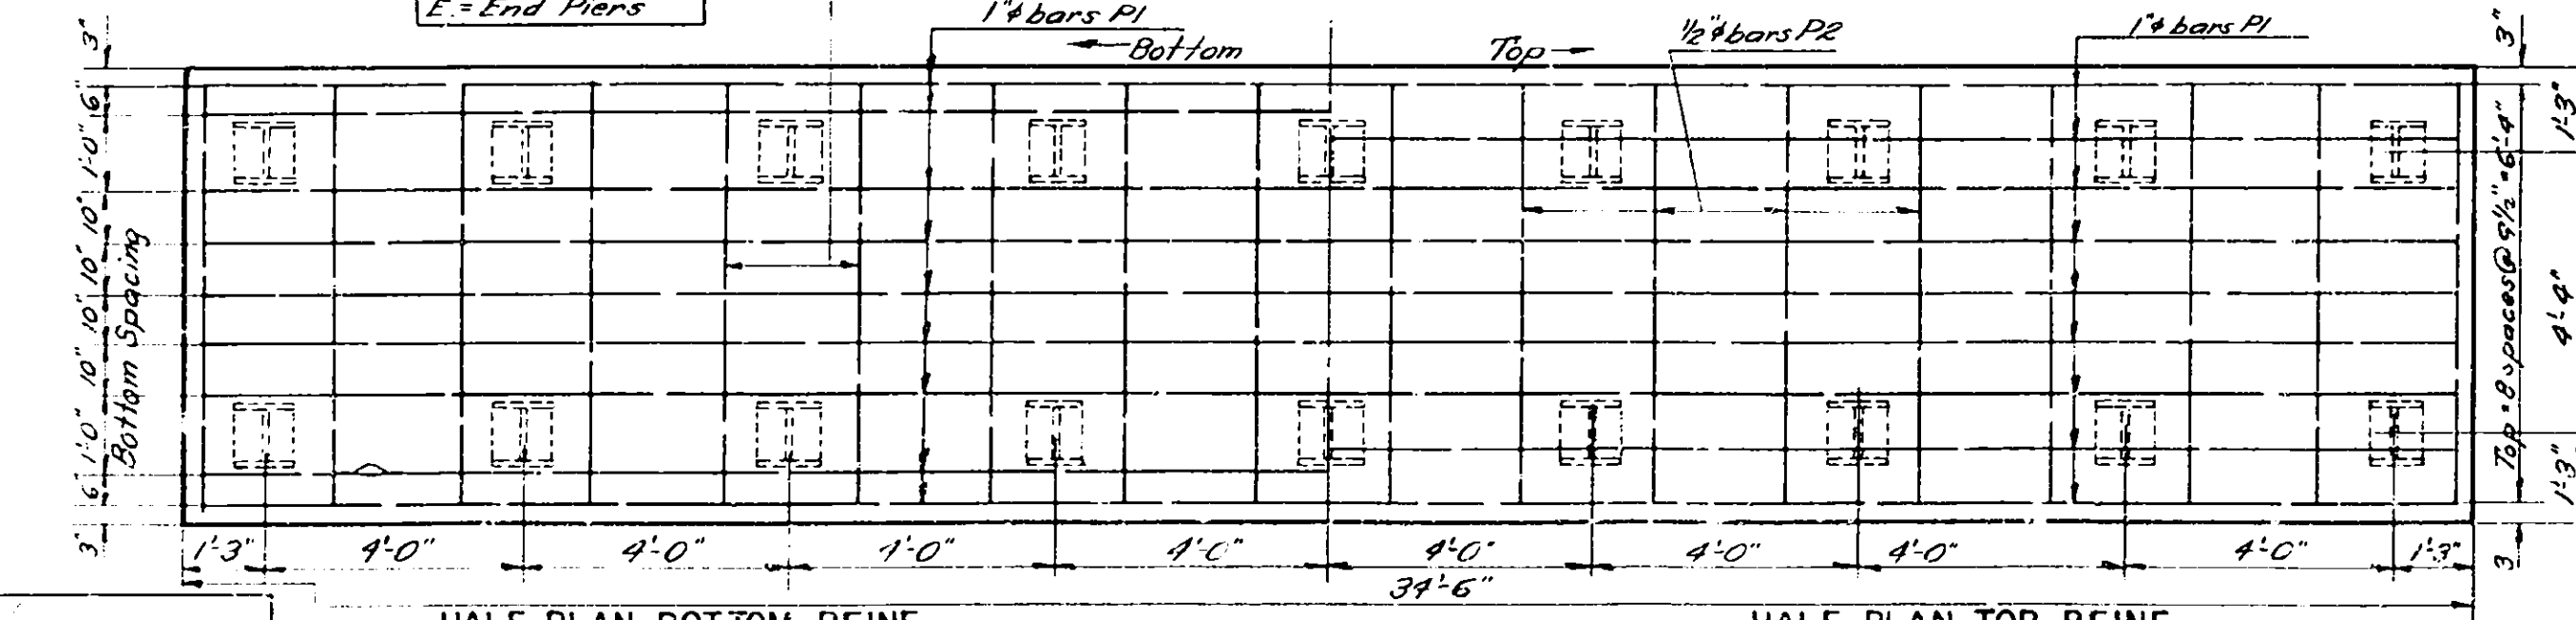


FOOTING PLAN
SCALE: 3/8"=1'-0"

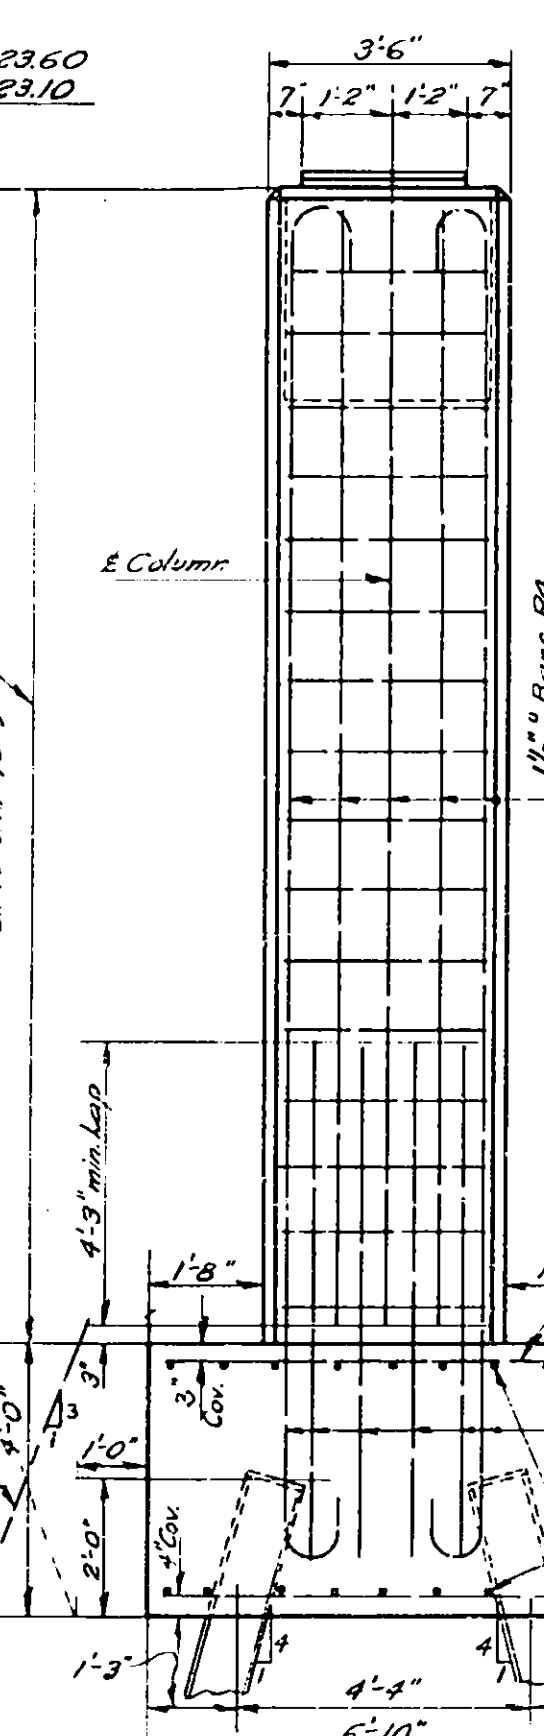





END VIEW

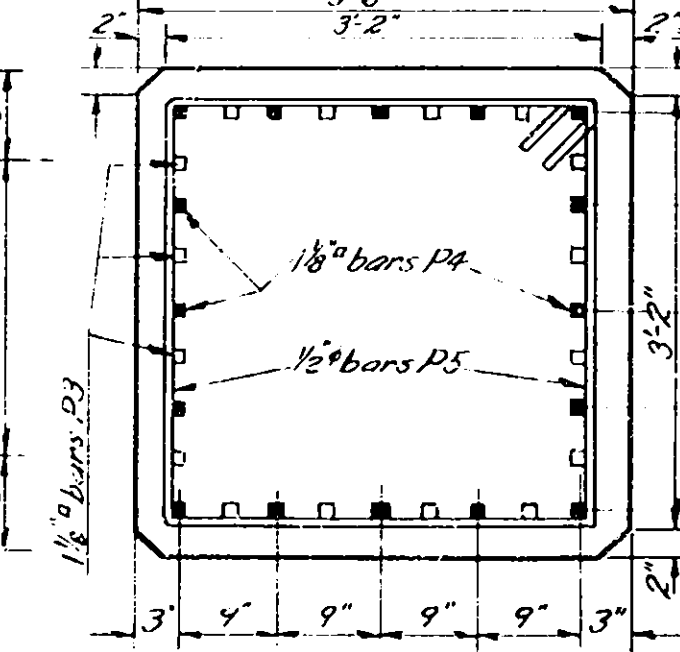


SECTION A-A
SCALE: 3/4" = 1'-0"

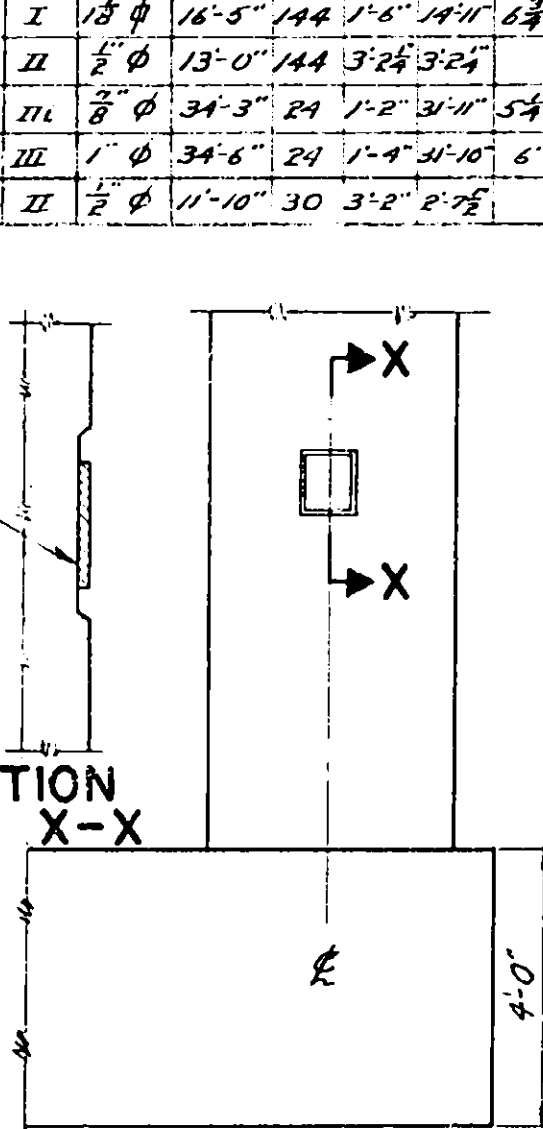

IDENTIFICATION & LOCATION
See Std. Sheet 52-41 for details

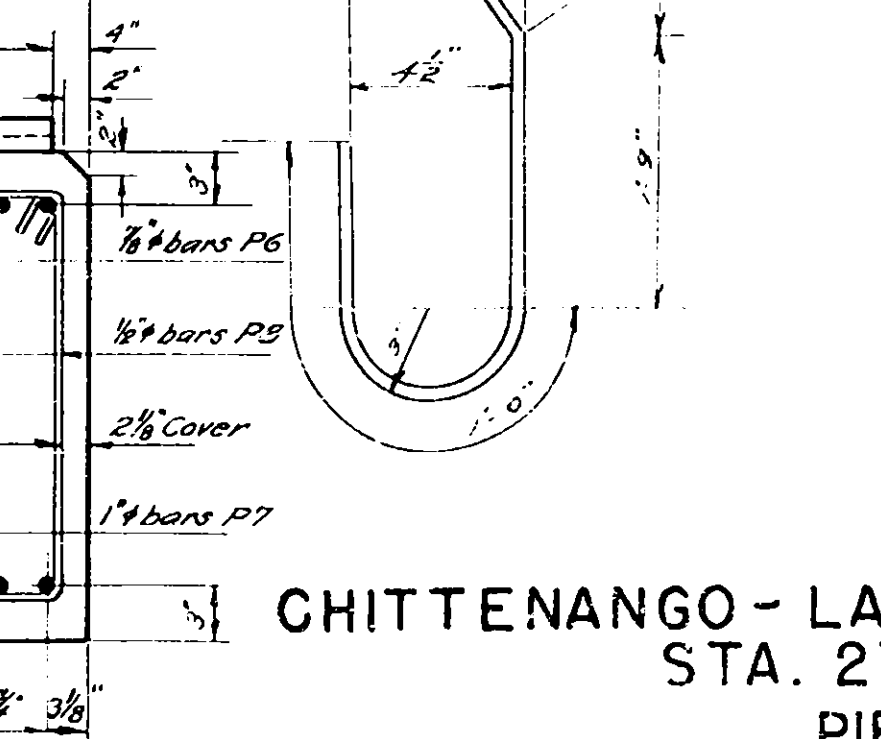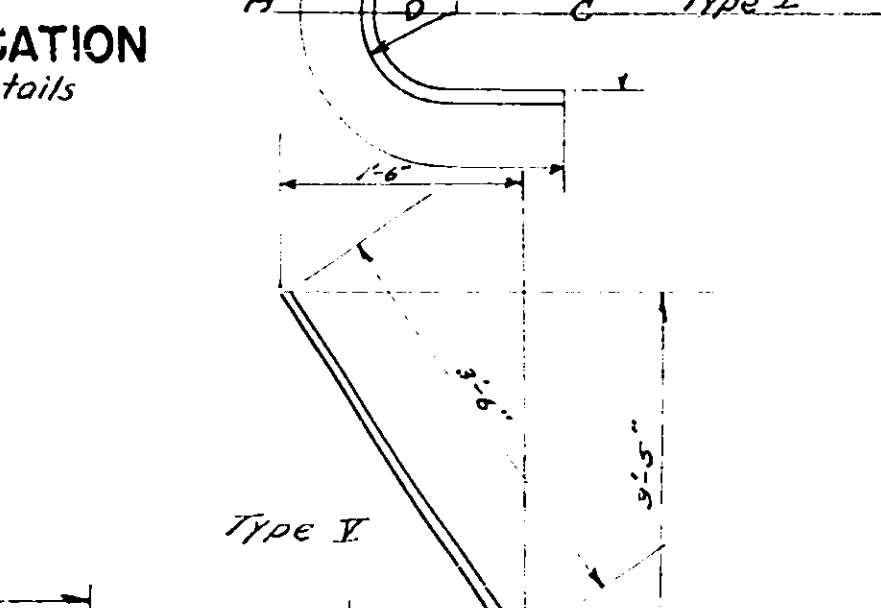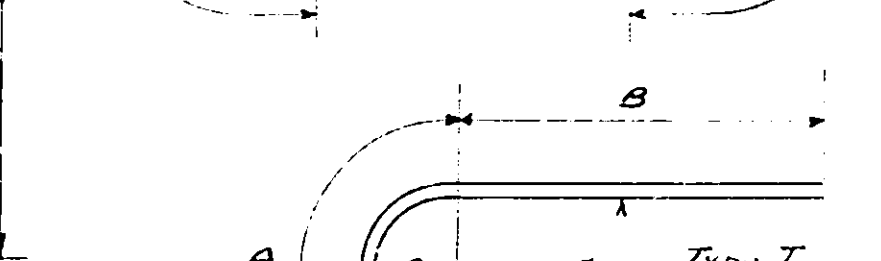
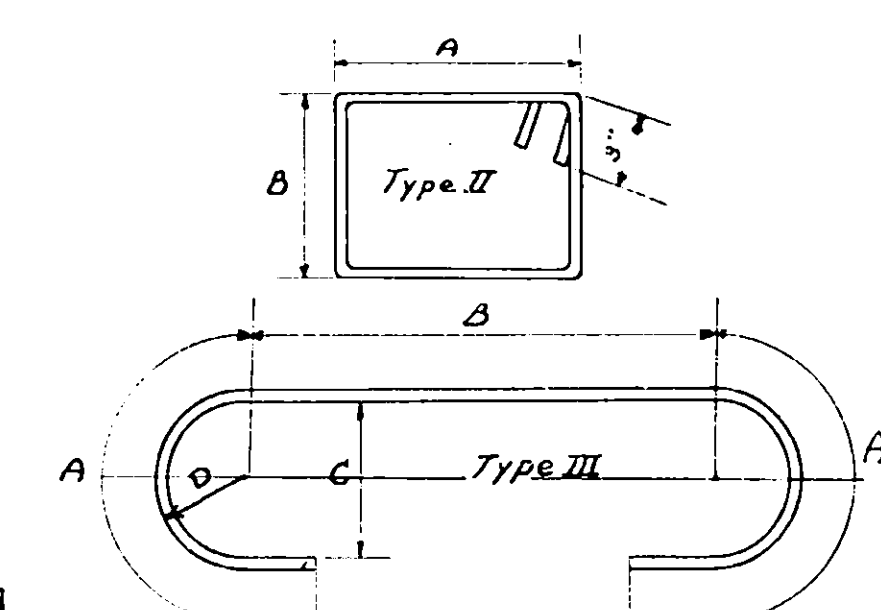


CHITTENANGO - LAKEPORT ROAD BRIDGE
STA. 278+18.40
PIERS




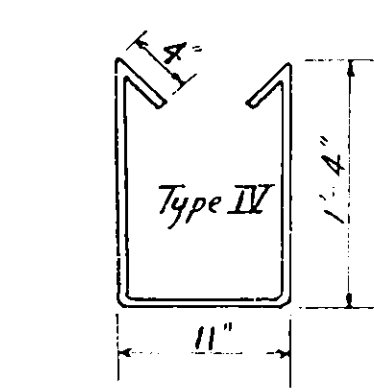


MADE BY _____
TRACED BY T. A. LAZOT
CHECKED BY _____



FED. AID DIST. NO.	STATE	FED. AID PROJ. NO.	FISCAL YEAR	SHEET NO.	TOTAL SHEETS
	N.Y.			30	67
FROM MOHAWK			THRUWAY		
MADISON			TO COUNTY		

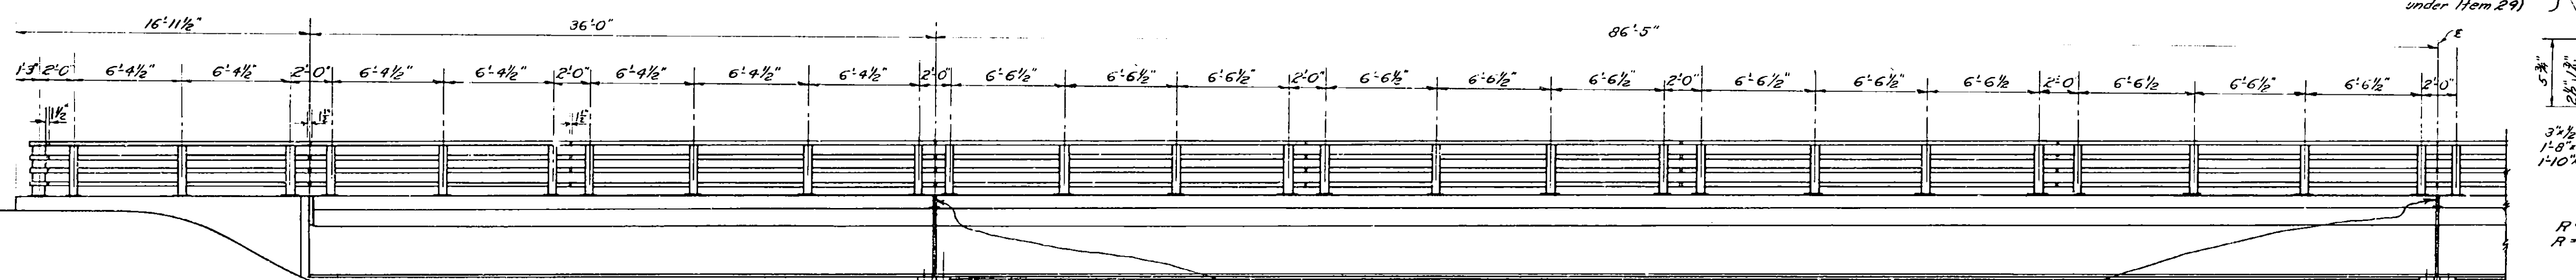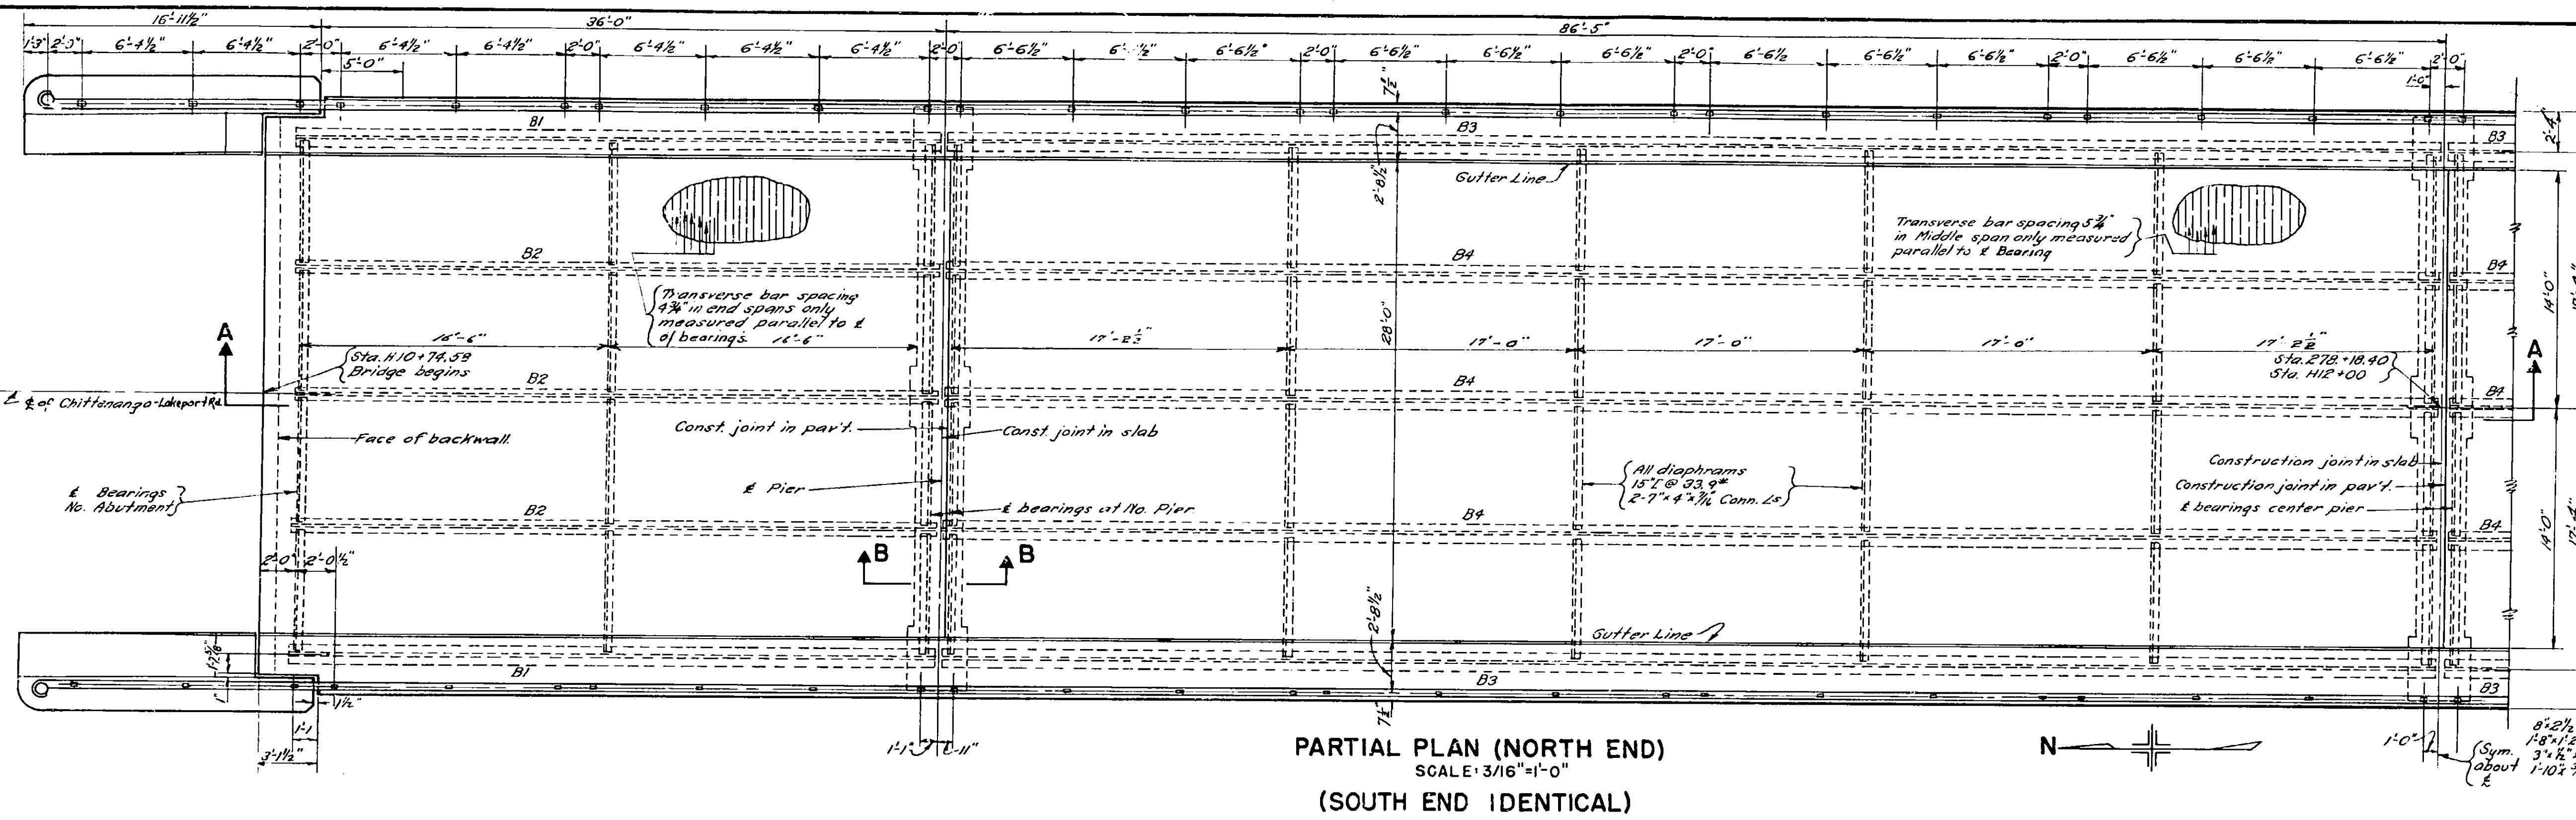

MARK	SECTION	COVER PLATES	CAMBER
B1	36\"W@150\"	No Plates	0\"
B2	30\"W@116\"	No Plates	0\"
B3	36\"W@182\"	8\"x3/8\"x29\"-0\"R Top 15\"x1 1/2\"R Bottom	4 1/4\"
B4	36\"W@162\"	5\"x3/8\"x28\"-0\"R Top 15\"x1 1/2\"x68\"-0\"Bottom	4 1/4\"

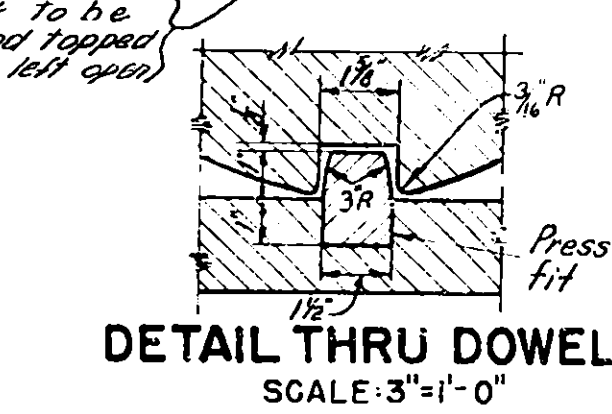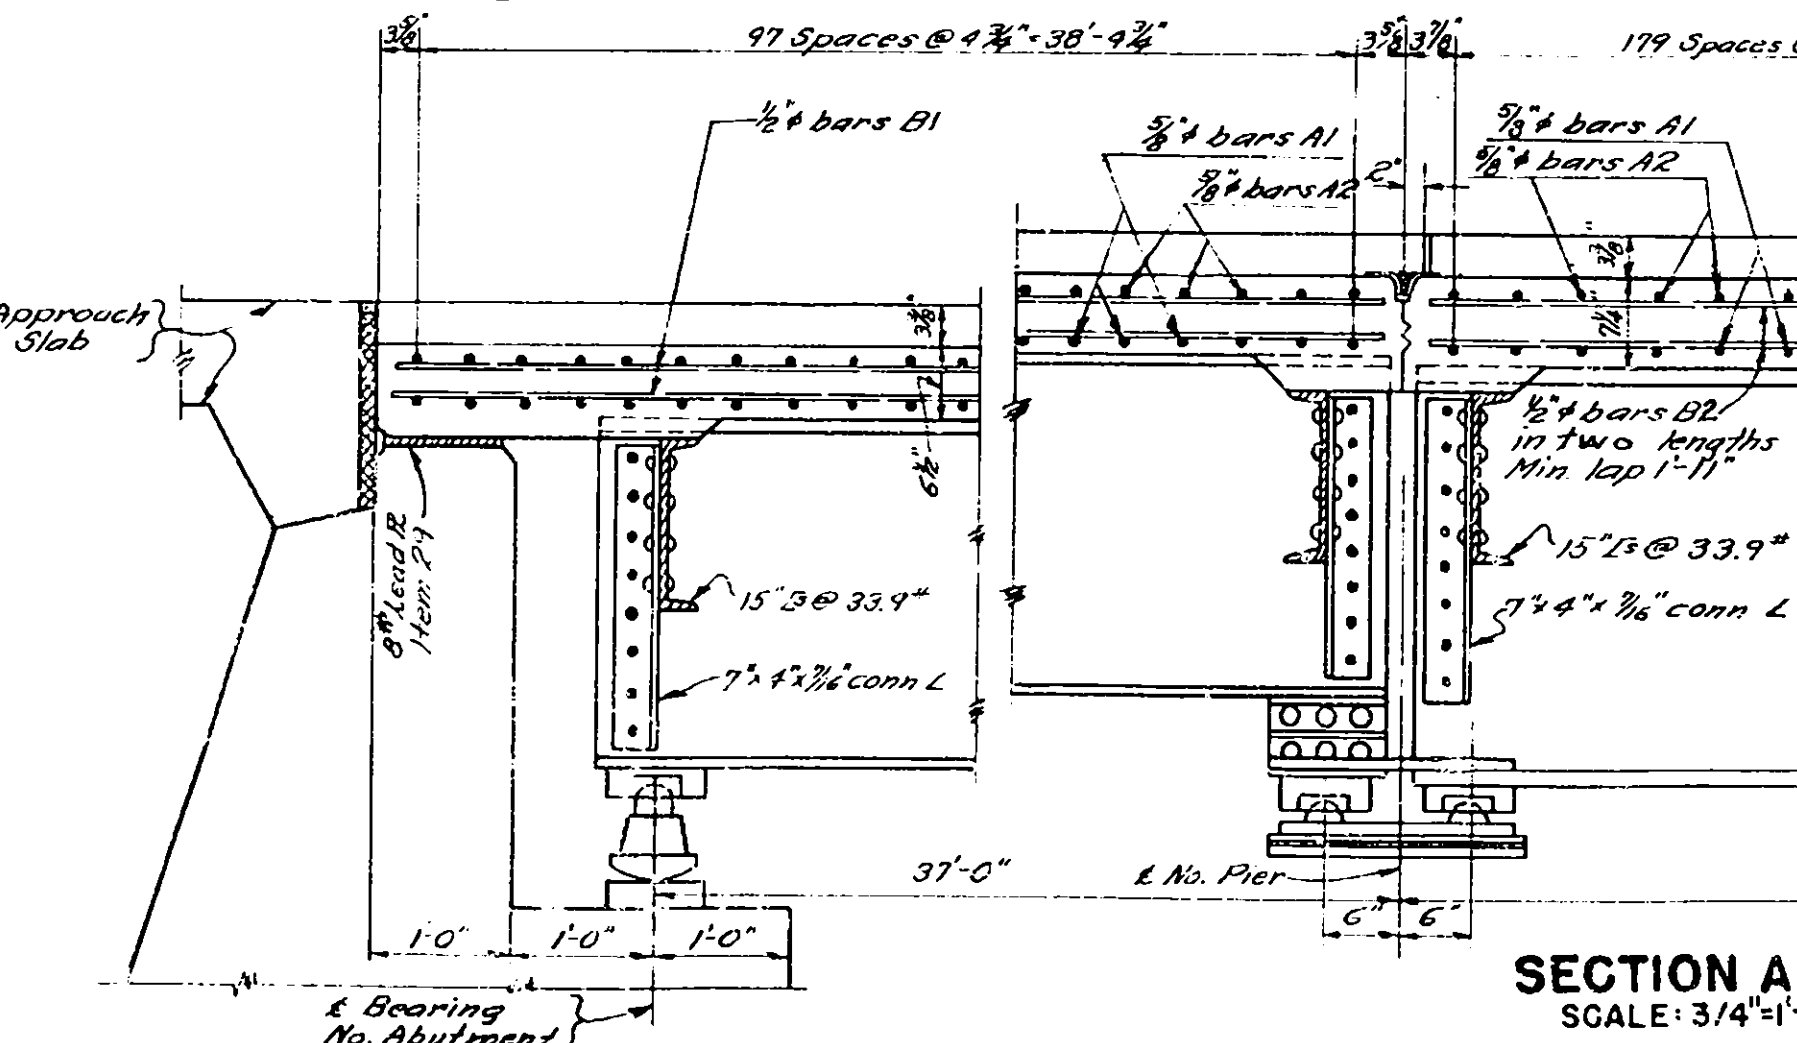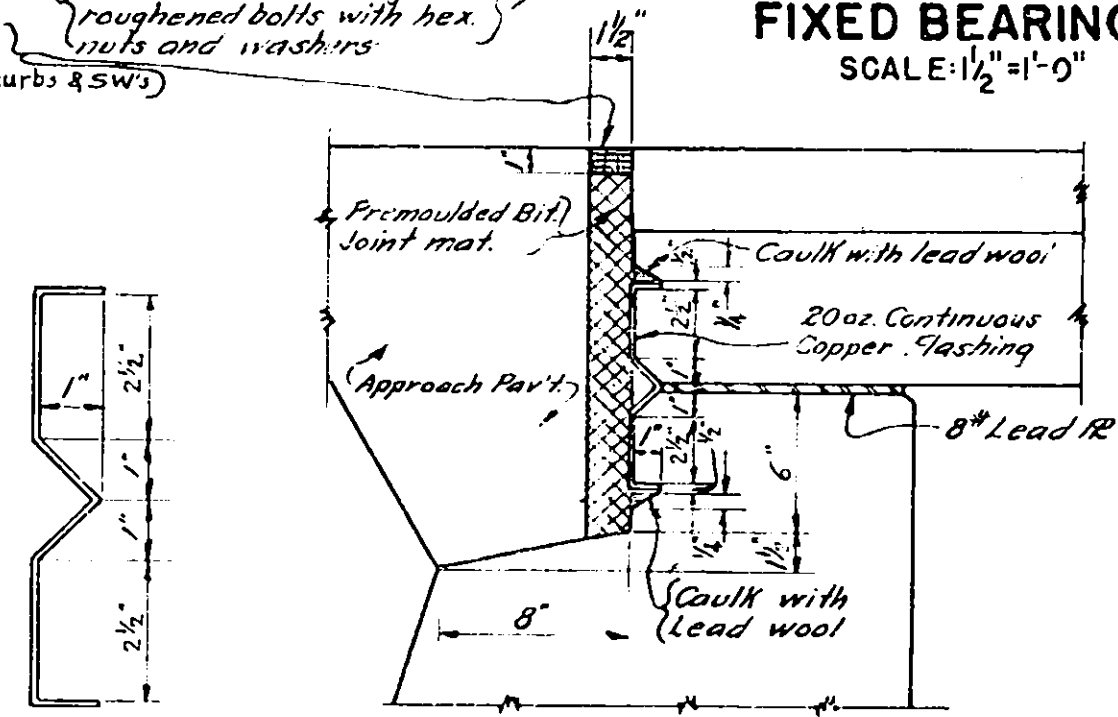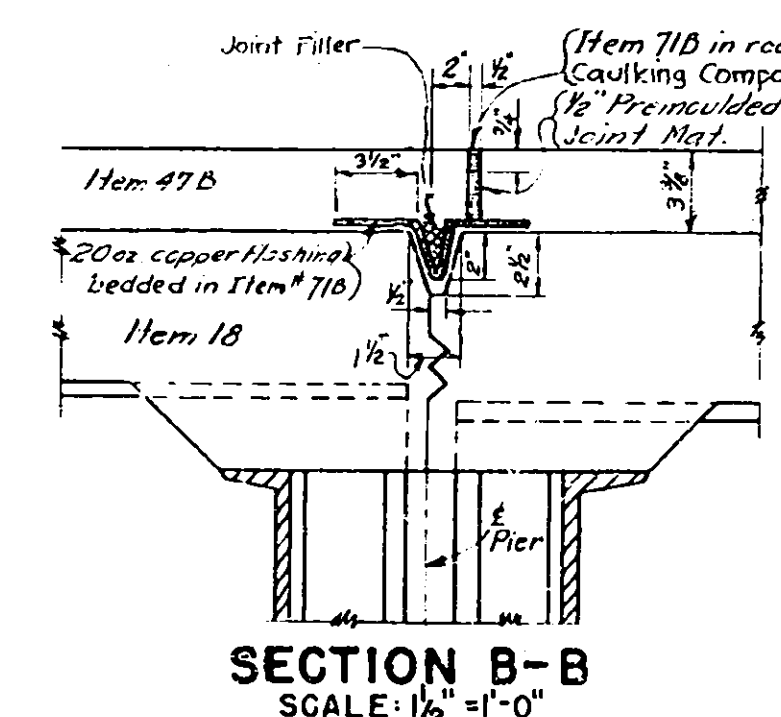


Set all anchor bolts accurately by template.

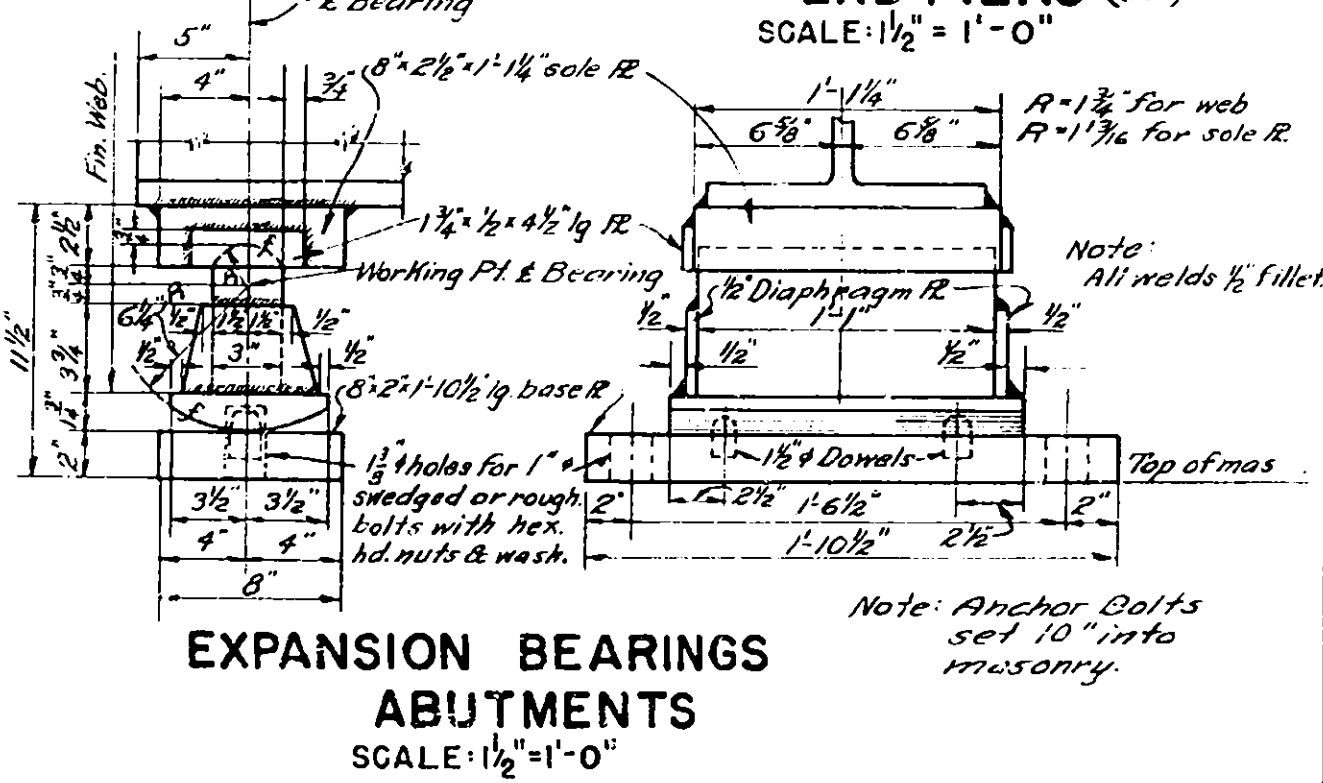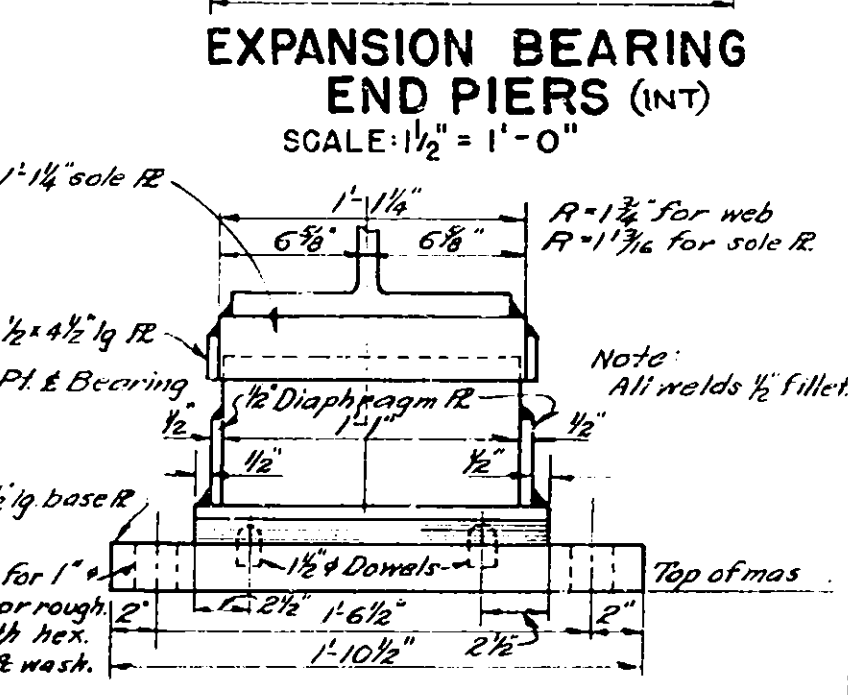


CHITTENANGO - LAKEPORT ROAD BRIDGE
STA. 278+18.40
SUPERSTRUCTURE DETAILS

MADE BY
TRACED BY T.A. LAZOT
CHECKED BY


FED. AID DIST. NO.	STATE	FED. AID PROJ. NO.	FISCAL YEAR	SHEET NO.	TOTAL SHEETS
	N. Y.			32	67
MOHAWK			THRUWAY		
FROM			TO		
MADISON			COUNTY		

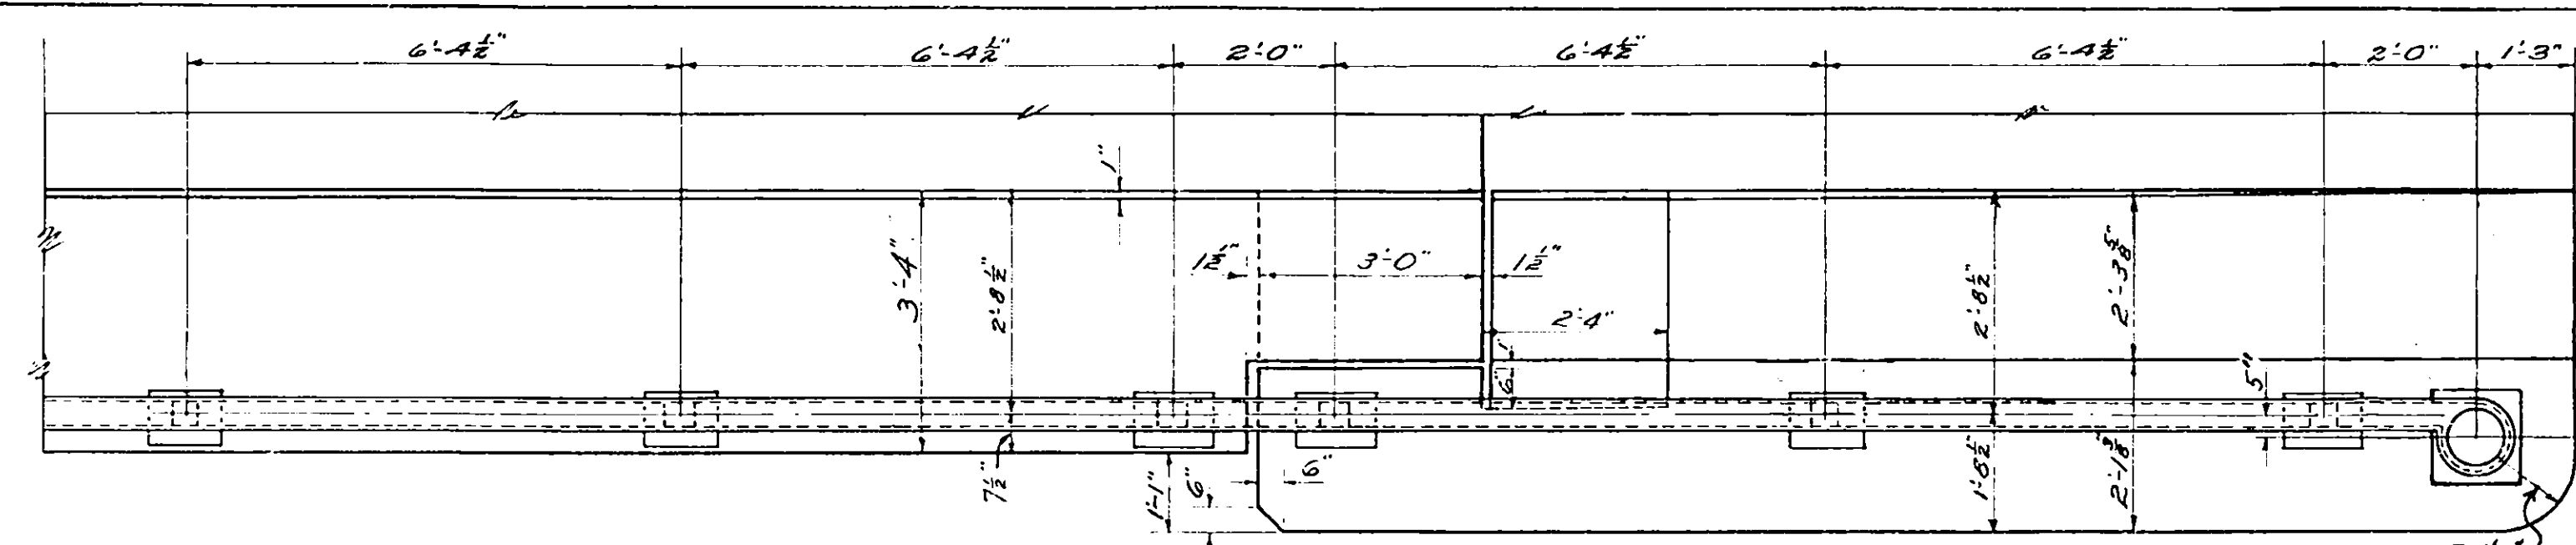


PARTIAL PLAN OF RAILING
Scale: 1/2" = 1'-0"

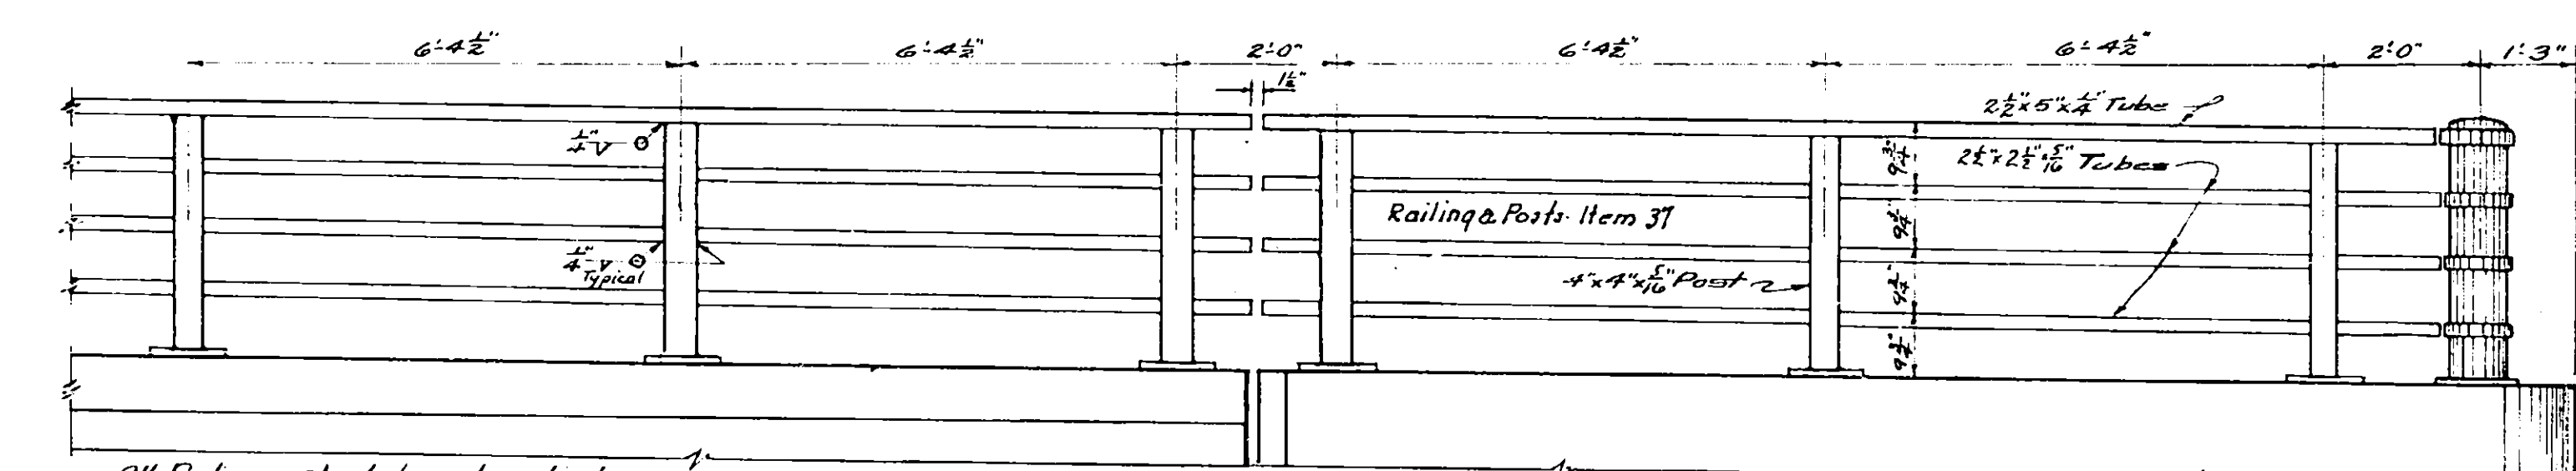


PARTIAL ELEVATION OF RAILING
Scale: 1/2" = 1'-0"

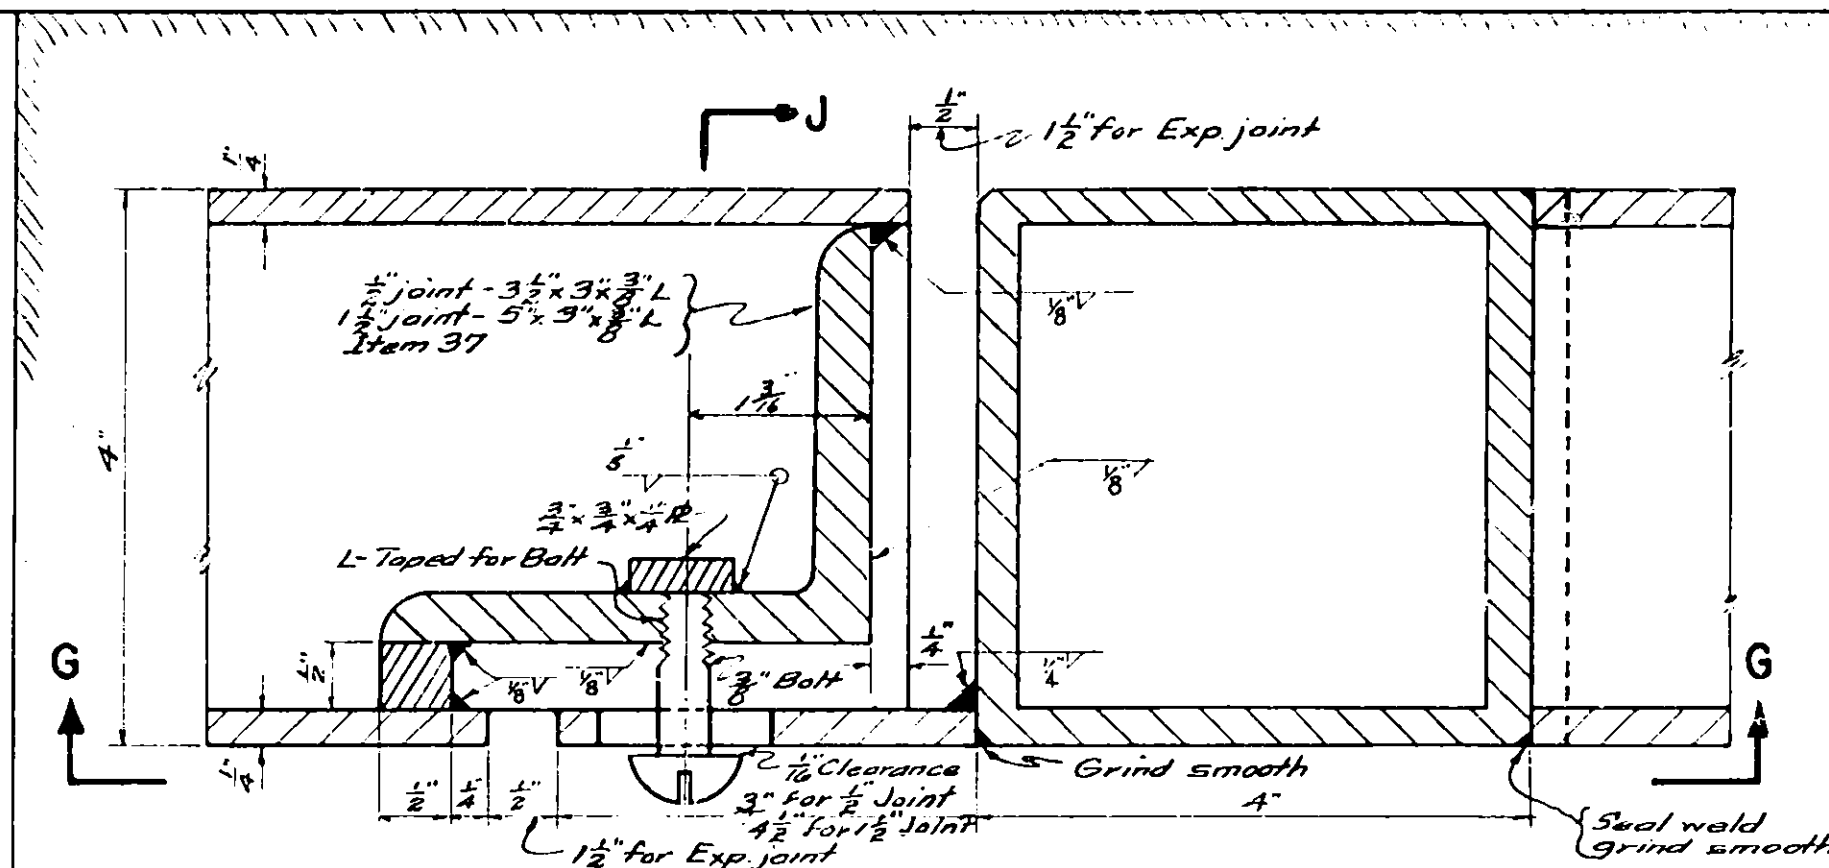


SECTION E-E
Scale: 3/4" = 1"

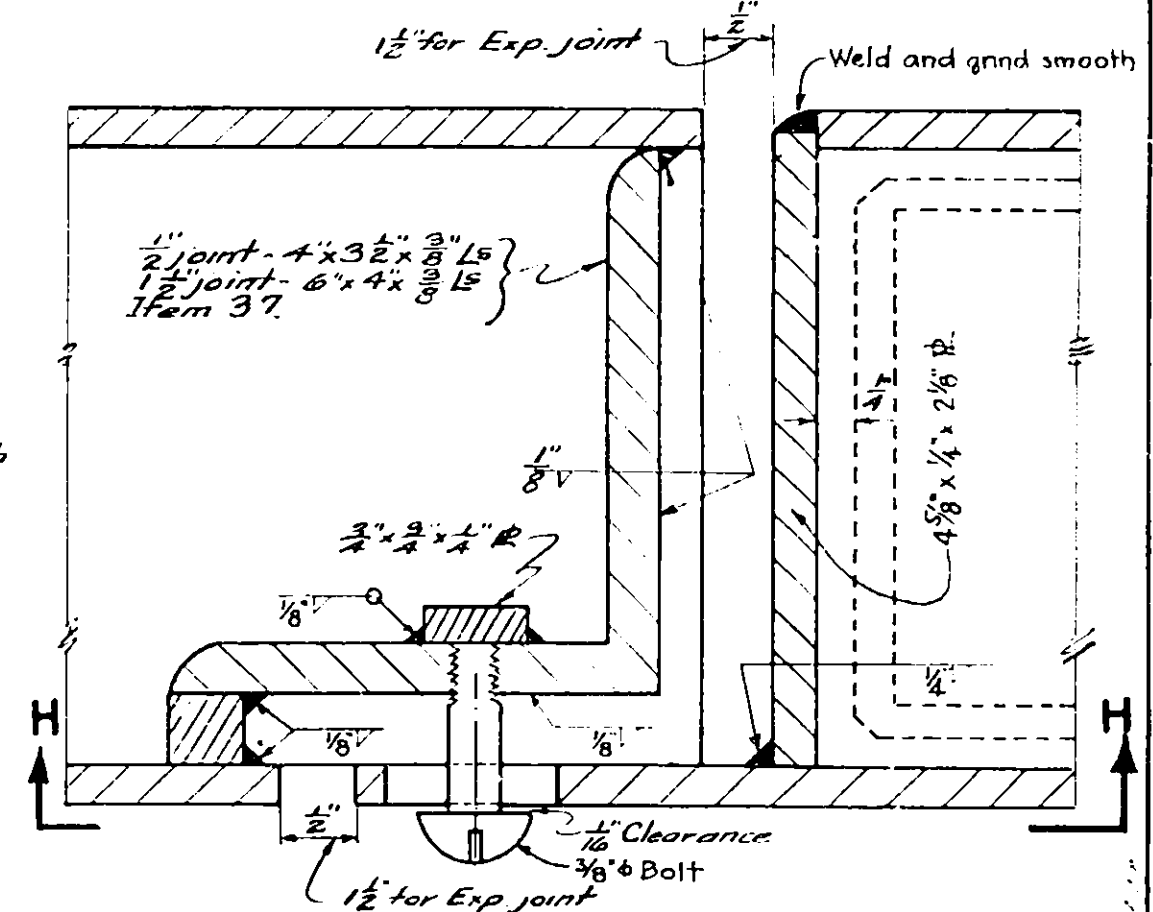


SECTION F-F
Scale: 3/4" = 1"

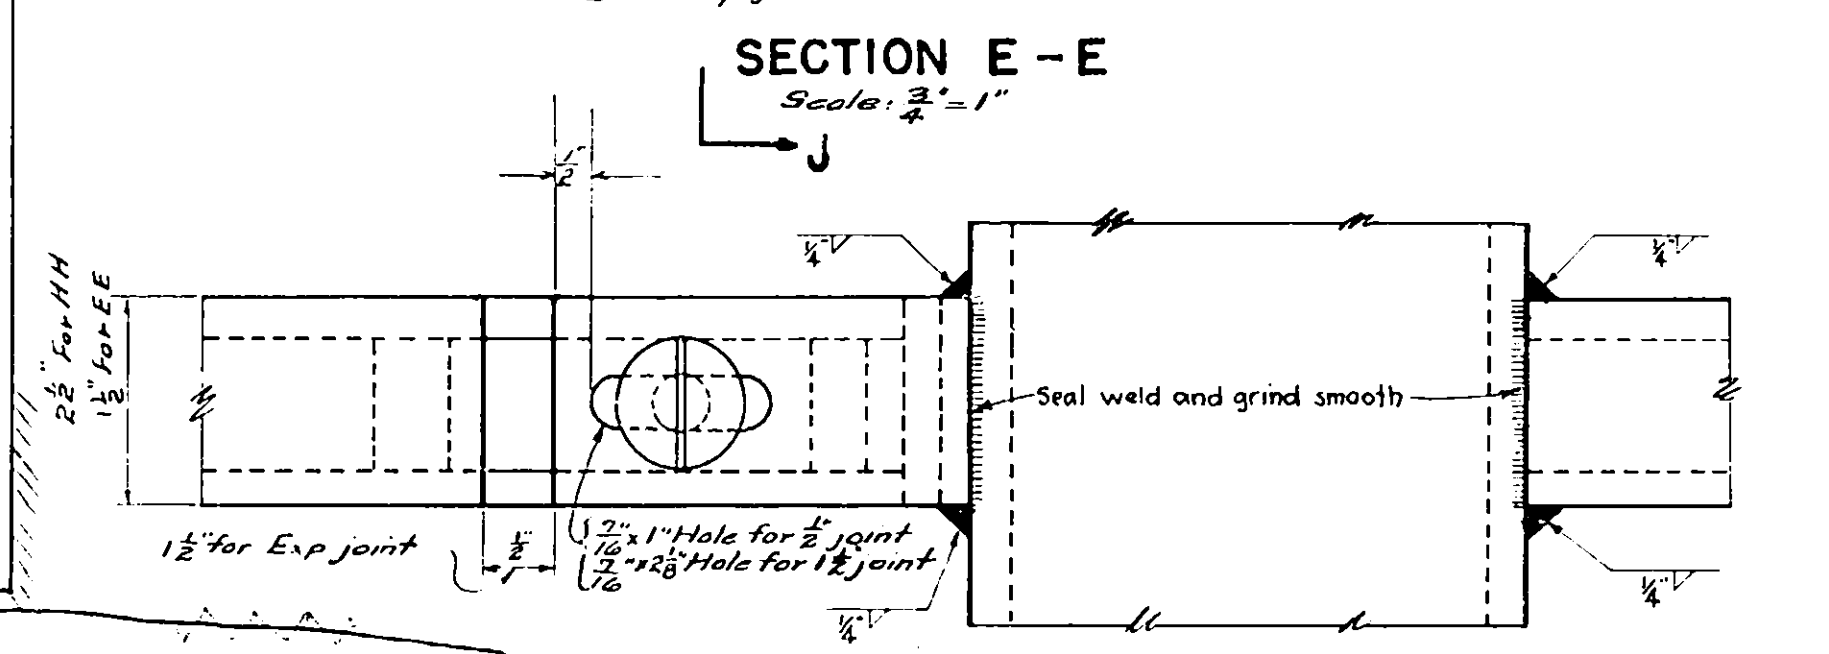


VIEW G-G
Scale: 3/4" = 1"

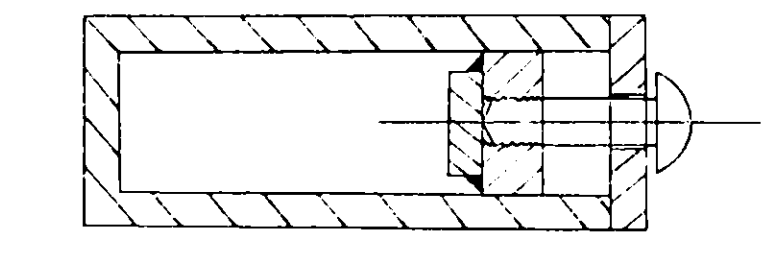

SECTION J-J
Scale: 3/4" = 1'-0"

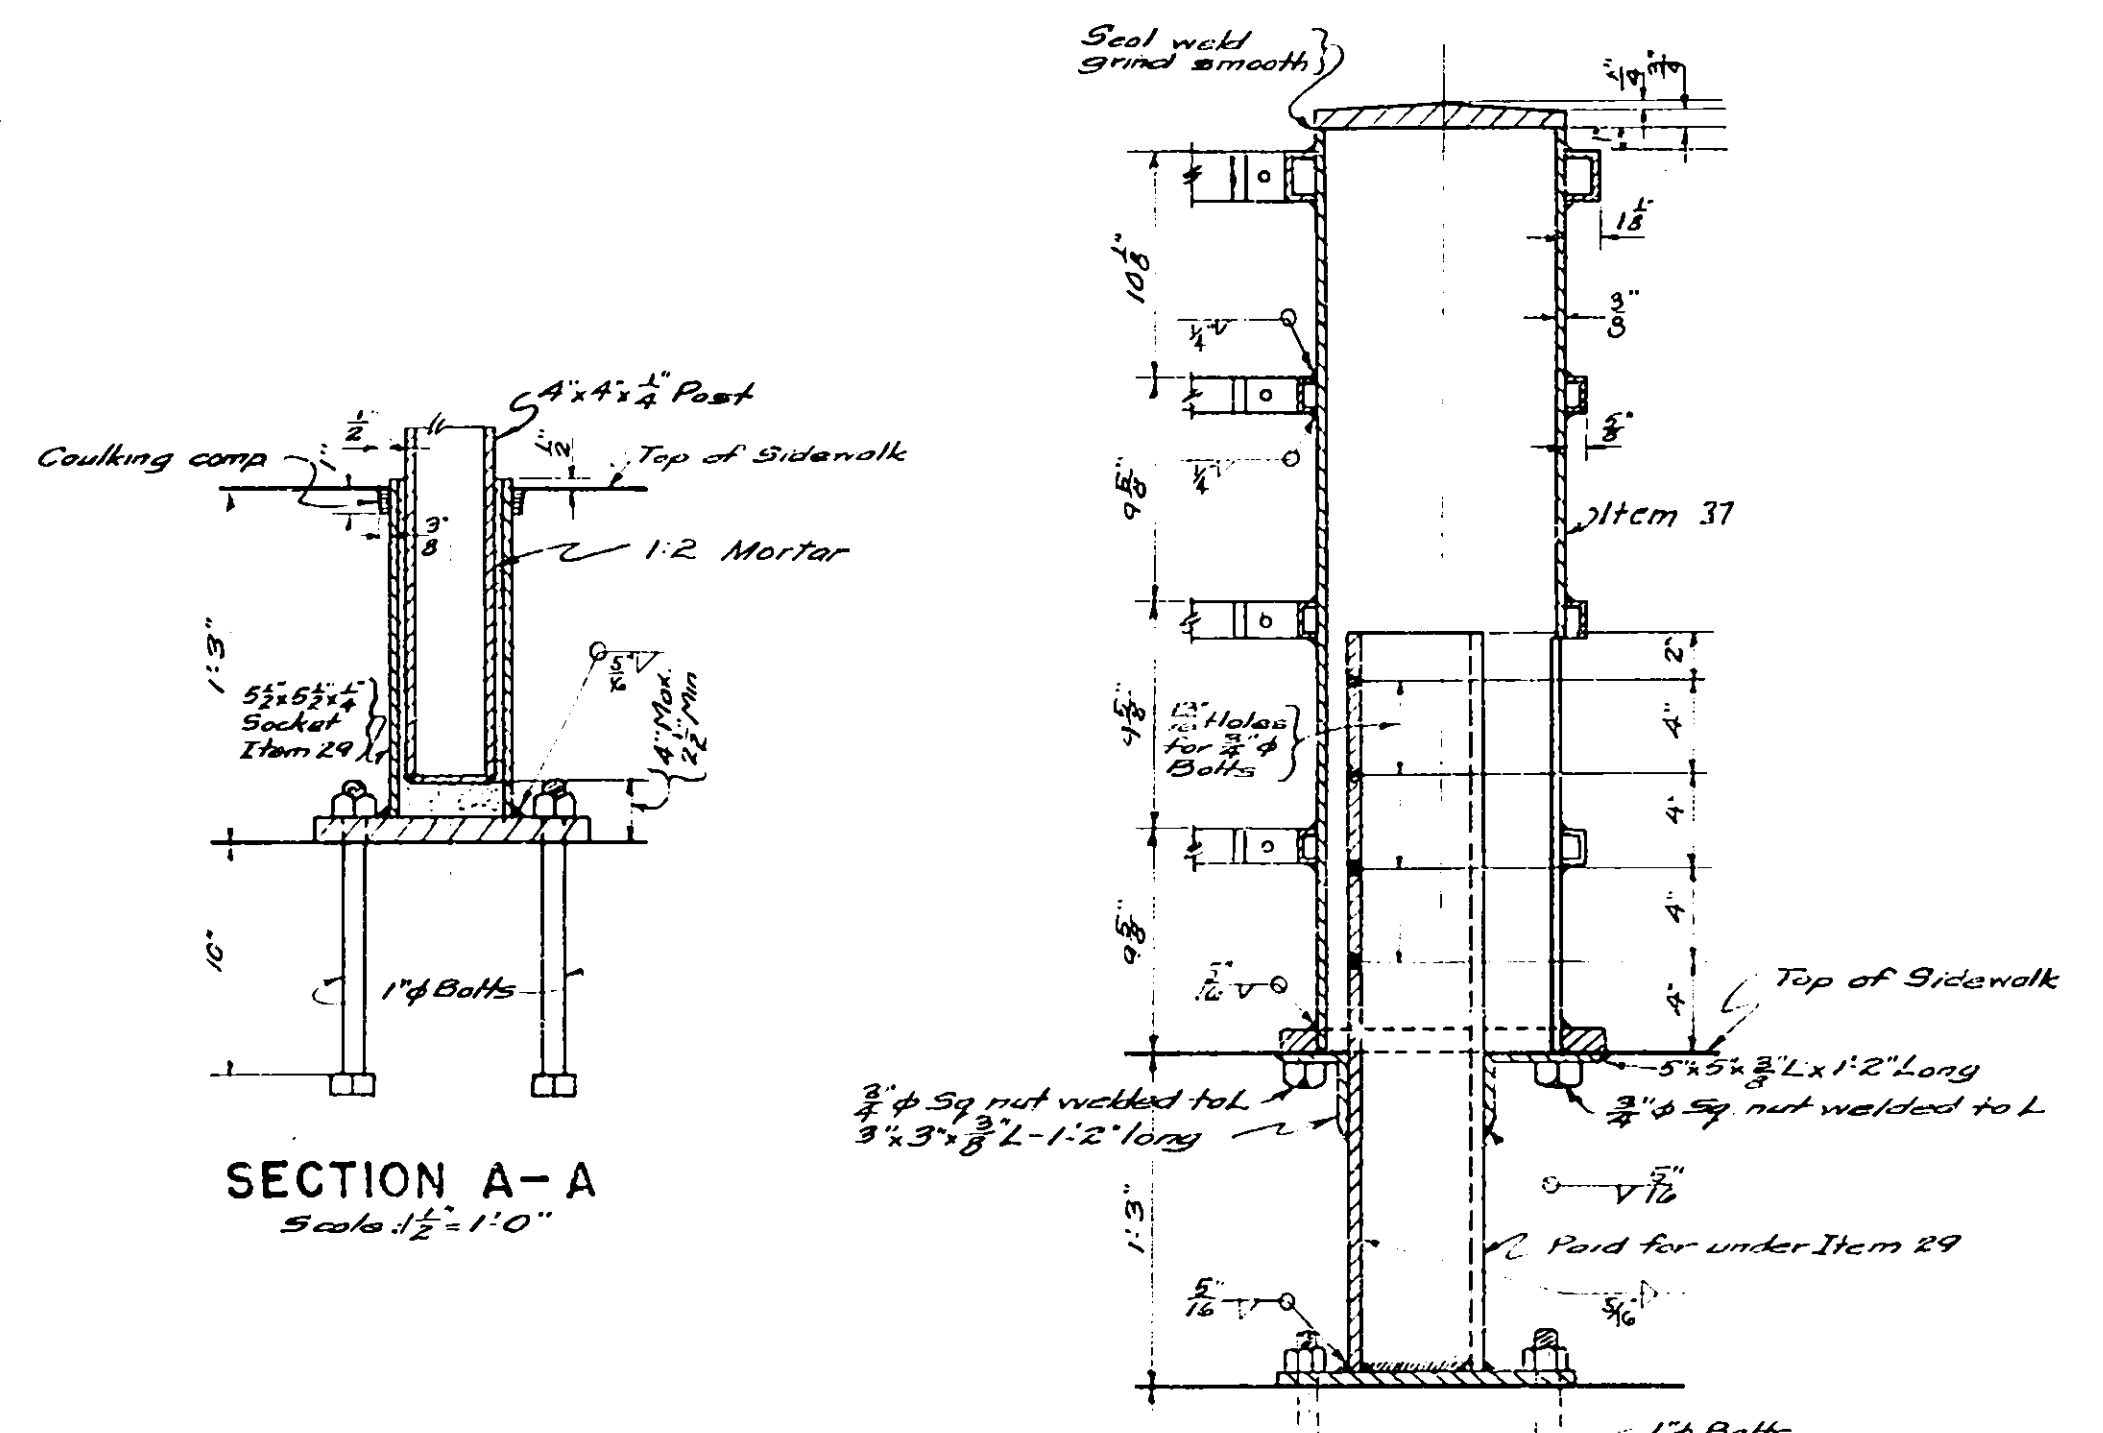


SECTION A-A
Scale: 1 1/2" = 1'-0"

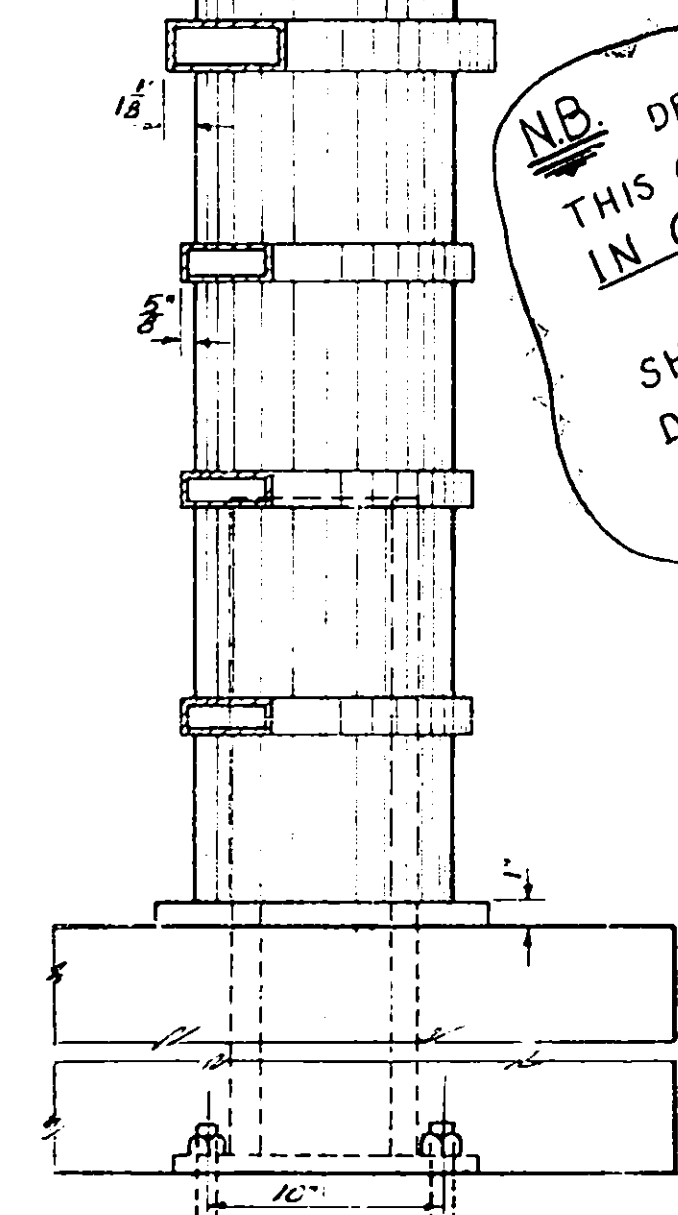


SECTION D-D
Scale: 1 1/2" = 1'-0"


NB. DETAILS WITHIN THIS OUTLINE ARE NOT IN CONTRACT. FOR RAILING DETAILS NOT SHOWN, USE CORRESPONDING DETAILS FROM NORTH MAIN STREET PLANS.

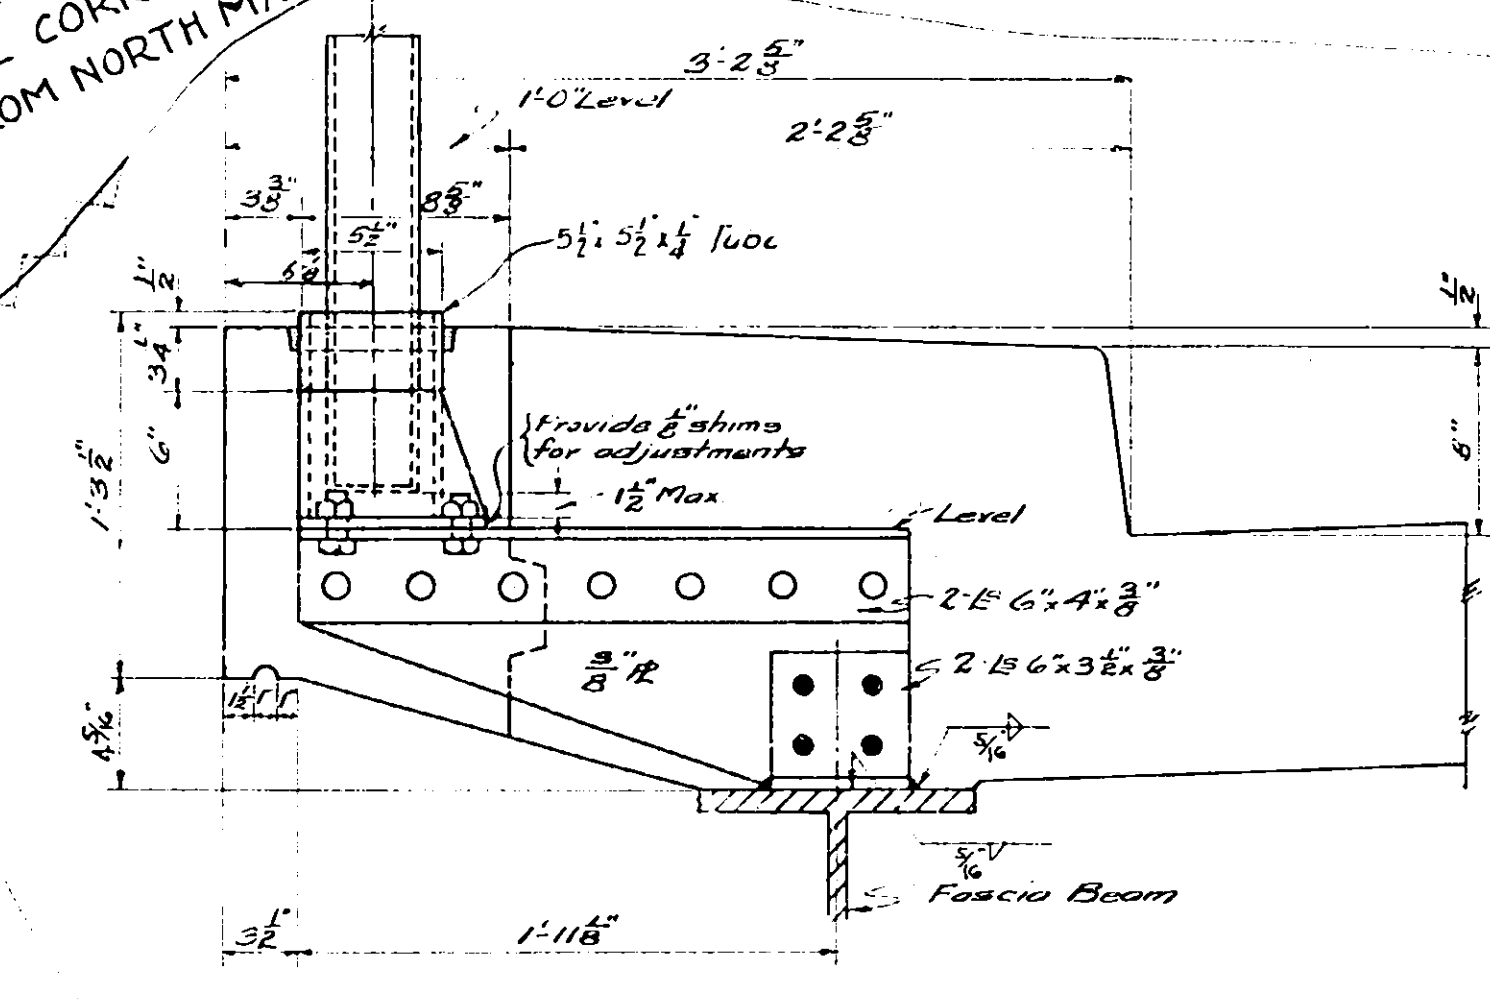


POST BRACKET DETAIL
Scale: 1 1/2" = 1'-0"

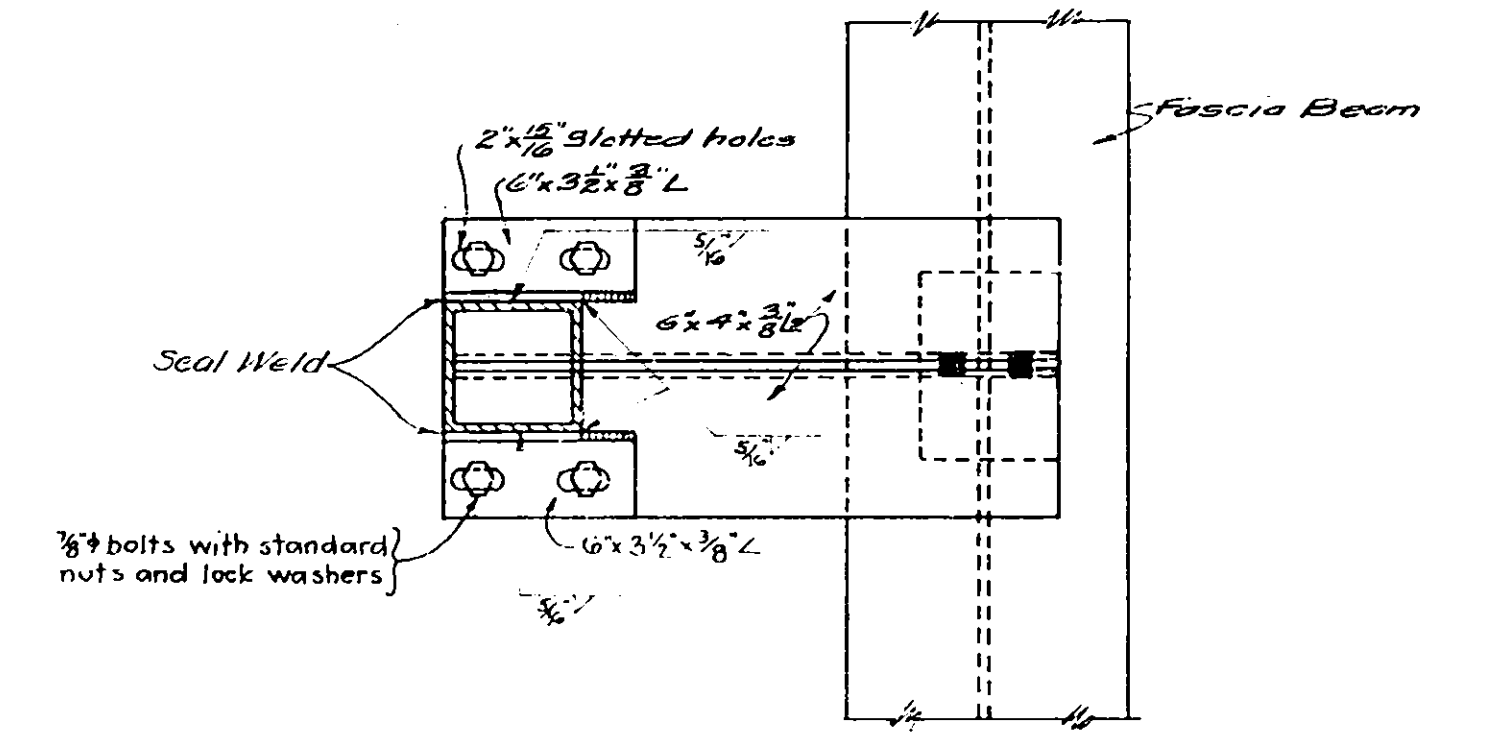


PART PLAN SECTION THRU FASCIA
Scale: 1 1/2" = 1'-0"

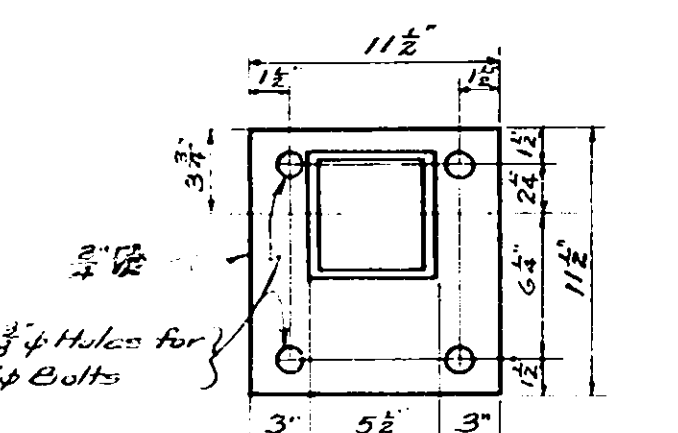


PLAN OF RAILING BASE
Scale: 1 1/2" = 1'-0"

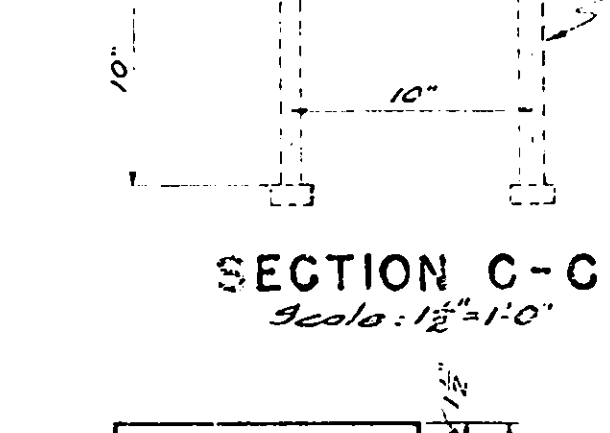


SECTION C-C
Scale: 1 1/2" = 1'-0"

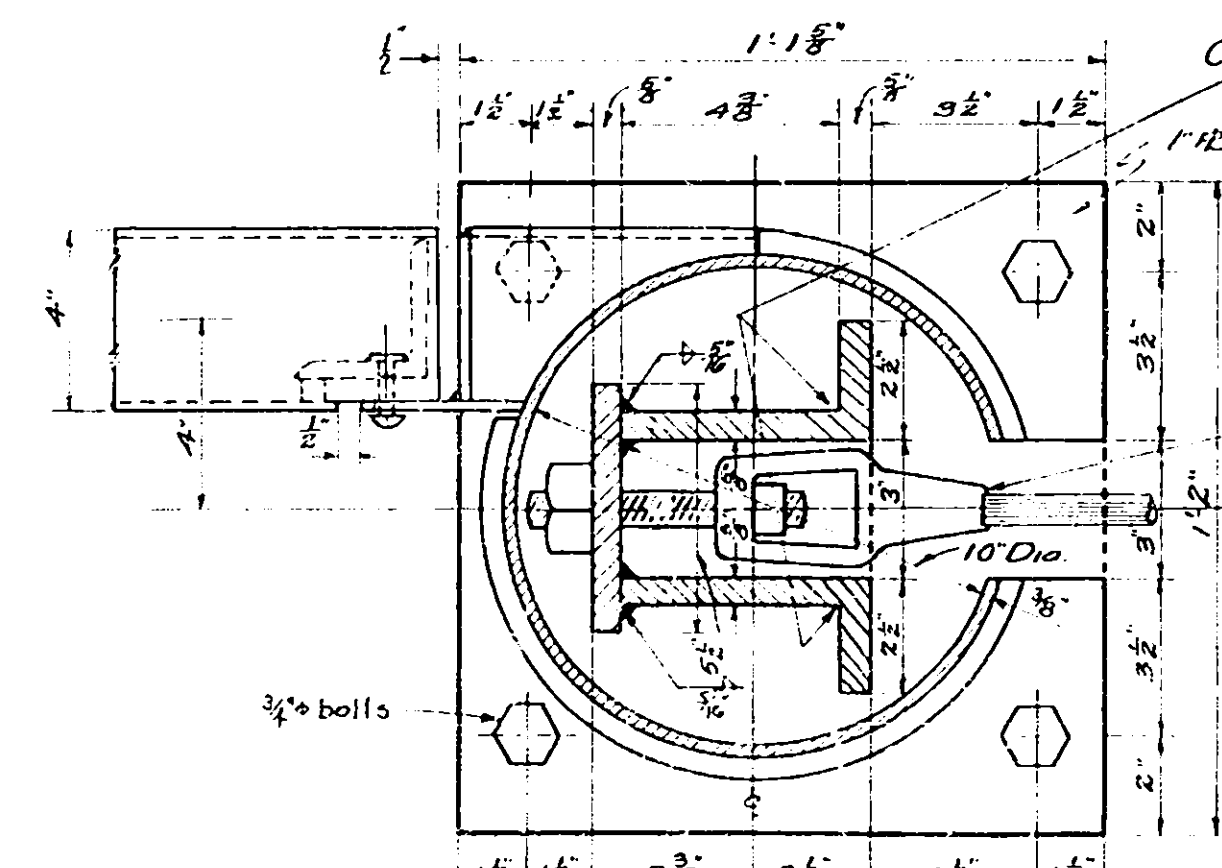

SECTION B-B
Scale: 1 1/2" = 1'-0"

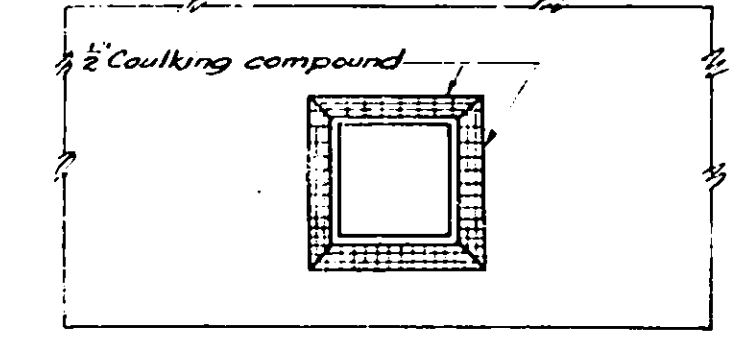

PLAN OF POST SOCKET
Scale: 1 1/2" = 1'-0"

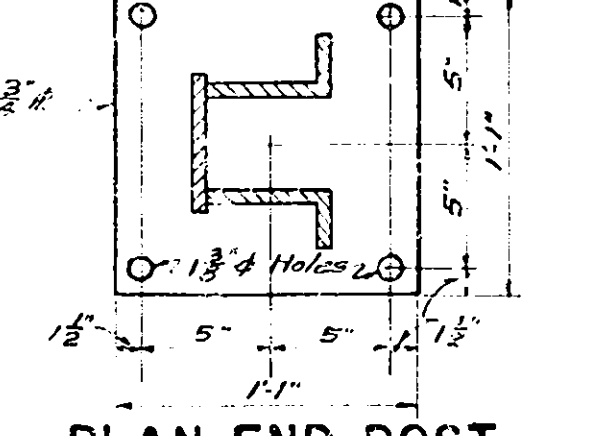


PLAN END POST BASE PLATE
Scale: 1" = 1'-0"

CHITTENANGO - LAKEPORT ROAD BRIDGE
STA. 278+18.40
RAILING DETAILS

Made by
Traced by
Checked by

FED. RD. DIV. NO.	STATE	FED. AID PROJ. NO.	COUNTY	SHEET NO.	TOTAL SHEETS
	N.Y.		Madison	33	67
MOHAWK THRUWAY N. CHITTENANGO ~ CANASTOTA CHITTENANGO - LAKEPORT ROAD					

At intervals of 100 feet or at such intervals as the Engineer may direct, lateral trenches or weep holes four feet in width shall be opened up thru the shoulders to the ditches to effectively drain the subgrade before the pavement is constructed. These shall be filled with Item 41BT, Foundation Course, Broken Stone and the excavation will be paid for under Item 2B, Unclassified Excavation.

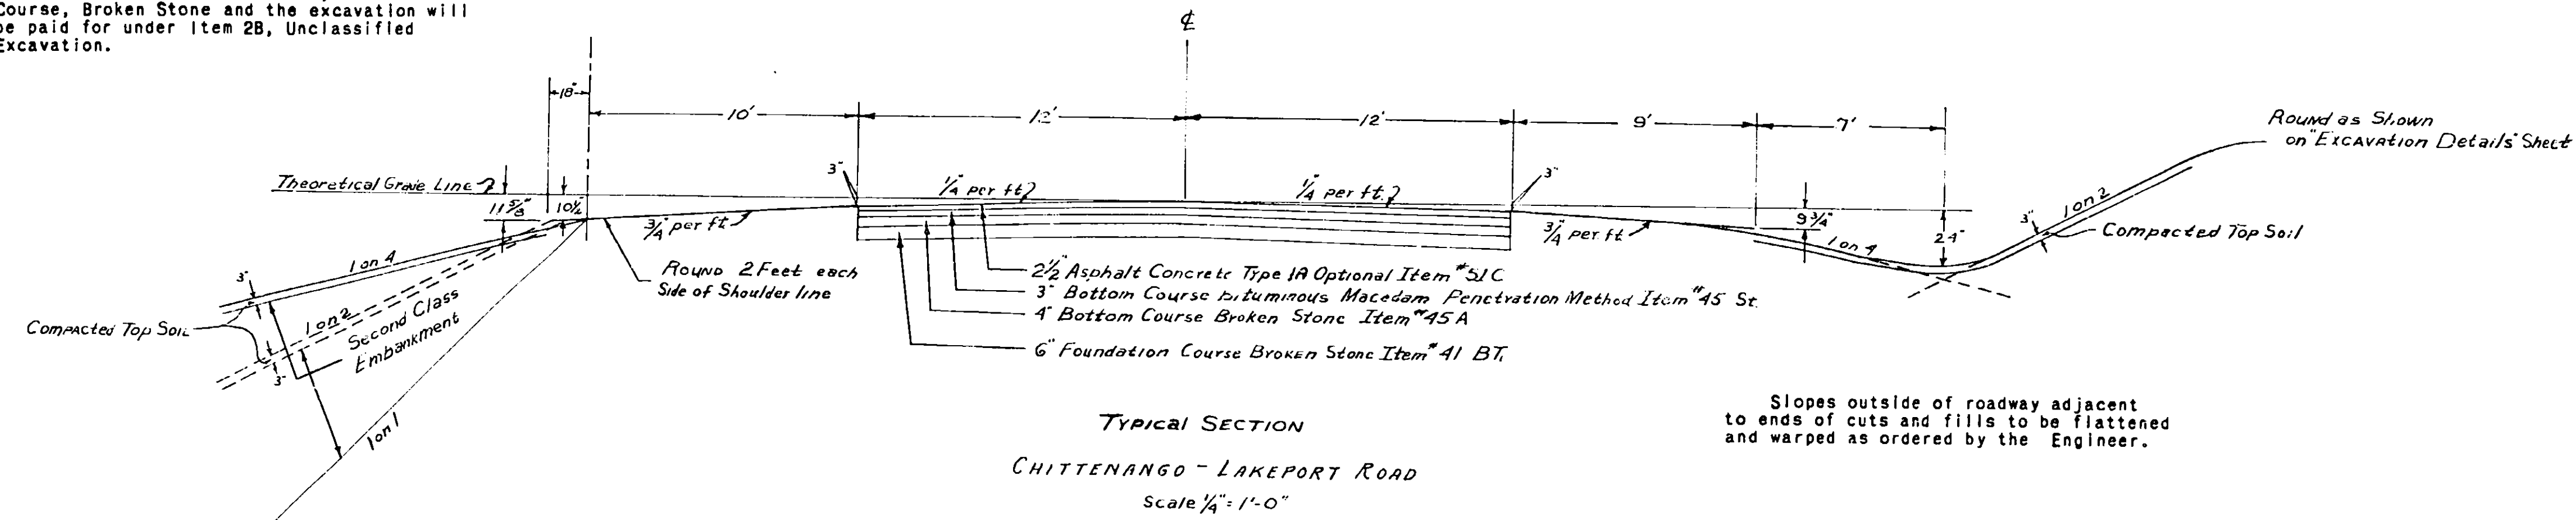

Second Class Embankment shall be used between the lines indicated if ordered by the Engineer. Second Class Embankment is material stripped from cuts and under embankments as ordered, but shall not include stumps, logs, brush nor other objectionable material.

MAINTENANCE and PROTECTION of TRAFFIC

The contractor shall maintain and protect traffic in accordance with Item 78 for the duration of the contract, within the limits of the Chittenango - Lakeport Road for the entire length of the contract and also within the limits of the Thruway so far as the limits of work extend.

Signs shall be erected in accordance with Standard Sheet No. 49-43 on both the Thruway and the Chittenango - Lakeport Road.

Any traffic required to use the Thruway shall be so routed that movement will be only in same direction as Thruway traffic.

Item 5 - TRENCH, CULVERT and BRIDGE EXCAVATION

From	Cu. Yds.
Pipe Underdrain	40
Drainage Sheet	340
Estimate	20
TOTAL	400

DRAINAGE STRUCTURES

Present Structure	Station	REMARKS
3' x 5' Conc. Box, 31' long	H 17+49	Remove existing culvert. Build 54" R.C.C.P. culvert 80 ft. long. Build Headwalls.
24" R.C.C.P. Culv. 76' long, No. Lane 80' long, So. Lane	277+90	Remove and store 24" R.C.C.P., - 76' long, No. Lane; 80' long, So. Lane.
None	H 11+03	Relay 80' of 24" R.C.C.P. (from Sta. 277+90) Build Headwalls.

DRIVEWAYS to be Re-ESTABLISHED

Station	Side	Station	Side
H 1+36	L	H 13+24	R
H 2+00	R	H 14+10 to)	
H 2+30	R	H 15+32)	L
H 2+50	R	H 16+45	L
H 3+48	R	H 19+85	R
H 9+00	R	H 4+85 to)	
H 10+75	L	H 10+75	R

Item 32D-CABLE GUIDE RAILING, OPTIONAL


Station to Station	Side	Length
H 7+02 H 10+62	R&L	720'
H 13+36 H 17+96	R	460'
H 13+36 H 20+16	L	680'
	4 anchors @ 20'	80'
	Estimate	40'
TOTAL		1980'

Item 2B-UNCLASSIFIED EXCAVATION

From	Cu. Yds.
Road Excavation	1251
Borrow	42452
Removing Temp. Intersections	400
Driveways	4857
Estimate	3040
TOTAL	52000

TABLE of LENGTHS

Station to Station	Feet	Miles	Feet	Miles
H 0+25 H 10+74.58	1049.58	0.199		
H 10+74.58 H 13+25.42			250.84	0.047
H 13+25.42 H 20+50	724.58	0.137		
	1774.16	0.336	250.84	0.047
Bridge	250.84	0.047		
TOTAL	2025.00	0.383		

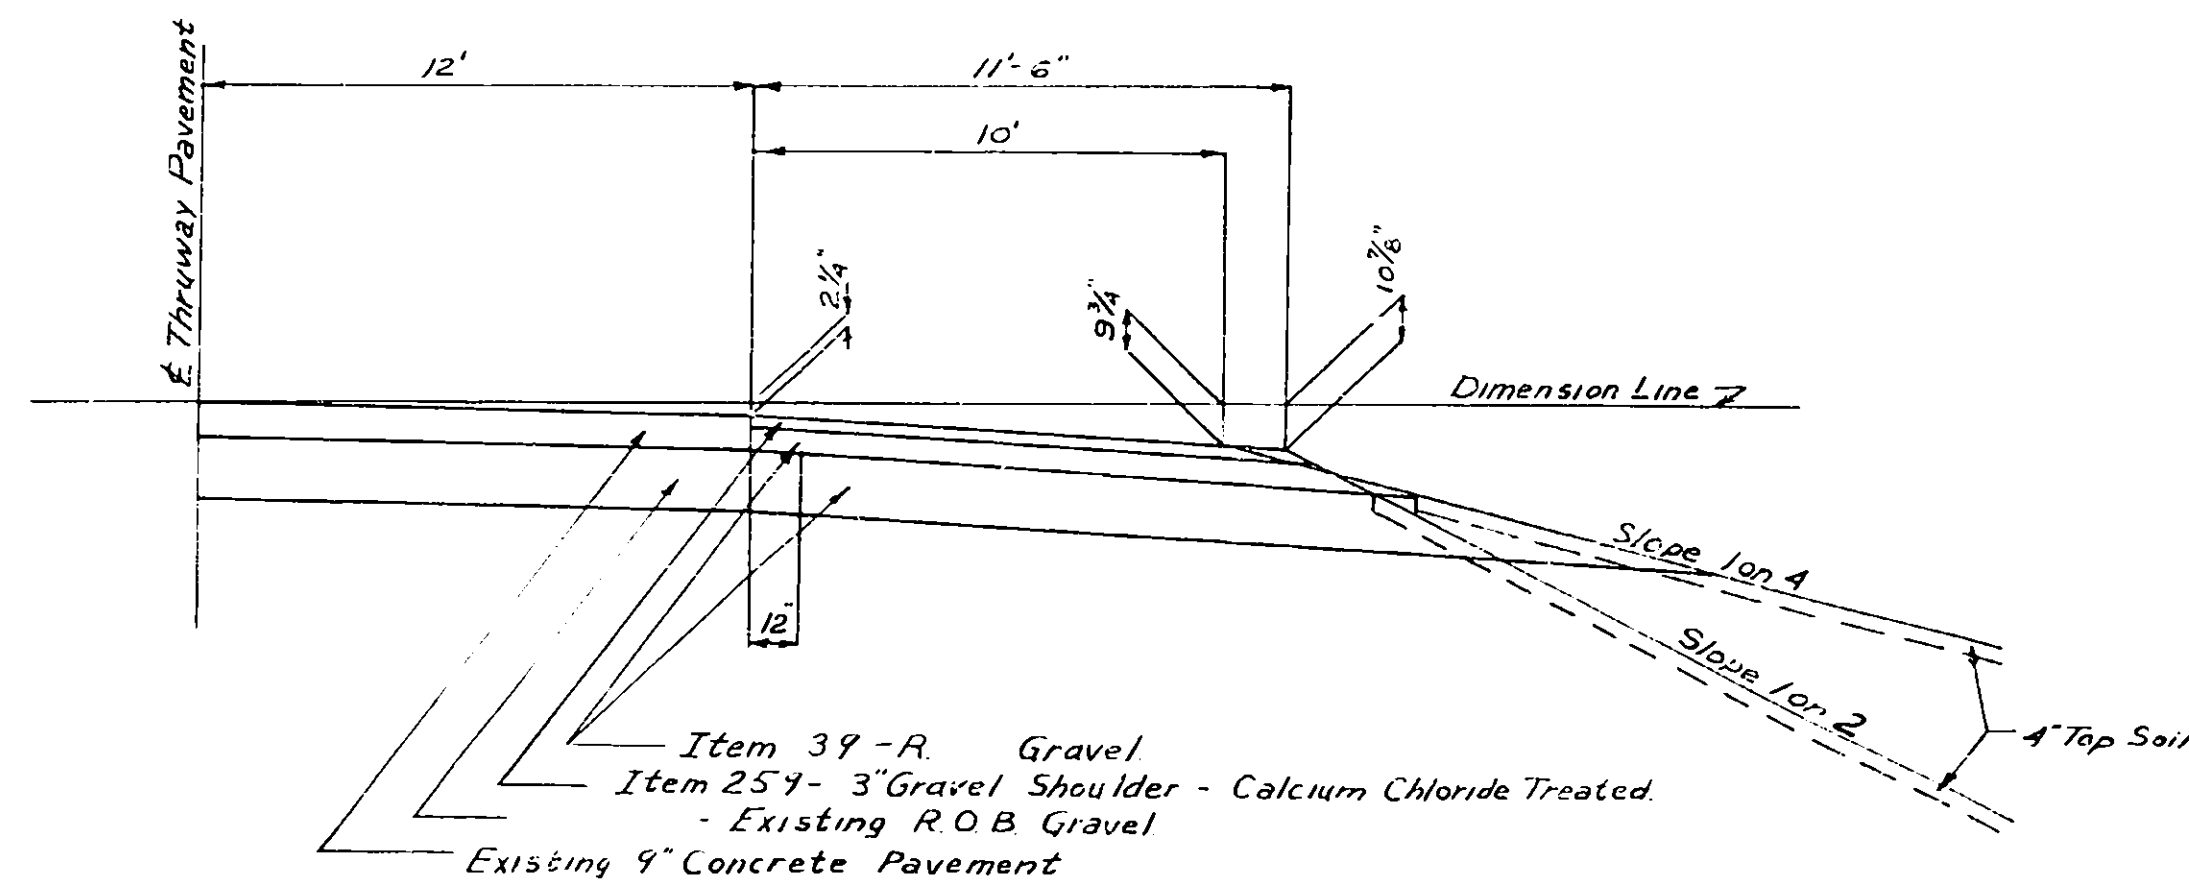

PART SECTION OF THRUWAY
SHOWING SHOULDER TO BE BUILT AFTER
REMOVAL OF TEMPORARY INTERSECTION
Scale 1/4" = 1'-0"


DESIGNED BY: [Signature]
CHECKED BY: [Signature]
DATE: [Signature]
PROFILE: [Signature]

PREPARED PURSUANT TO THE HIGHWAY LAW & RECOMMENDED BY

DATE: [Signature]
ENGINEER DISTRICT NO. 2

FED. RD. DIV. NO.	STATE	FED. AID PROJ. NO.	COUNTY	SHEET NO.	TOTAL SHEETS
	NY		Madison	33	47
MOHAWK THRUWAY N. CHITTENANGO ~ CANASTOTA CHITTENANGO - LAKEPORT ROAD					


At intervals of 100 feet
trenches or weep holes four feet in width
opened up thru the shoulders to
the ditches to effectively drain the subgrade
before the pavement constructed. These
filled with Item 41BT, Foundation
Course, Broken Stone and the excavation
paid for under Item 2B, Unclassified
Excavation.

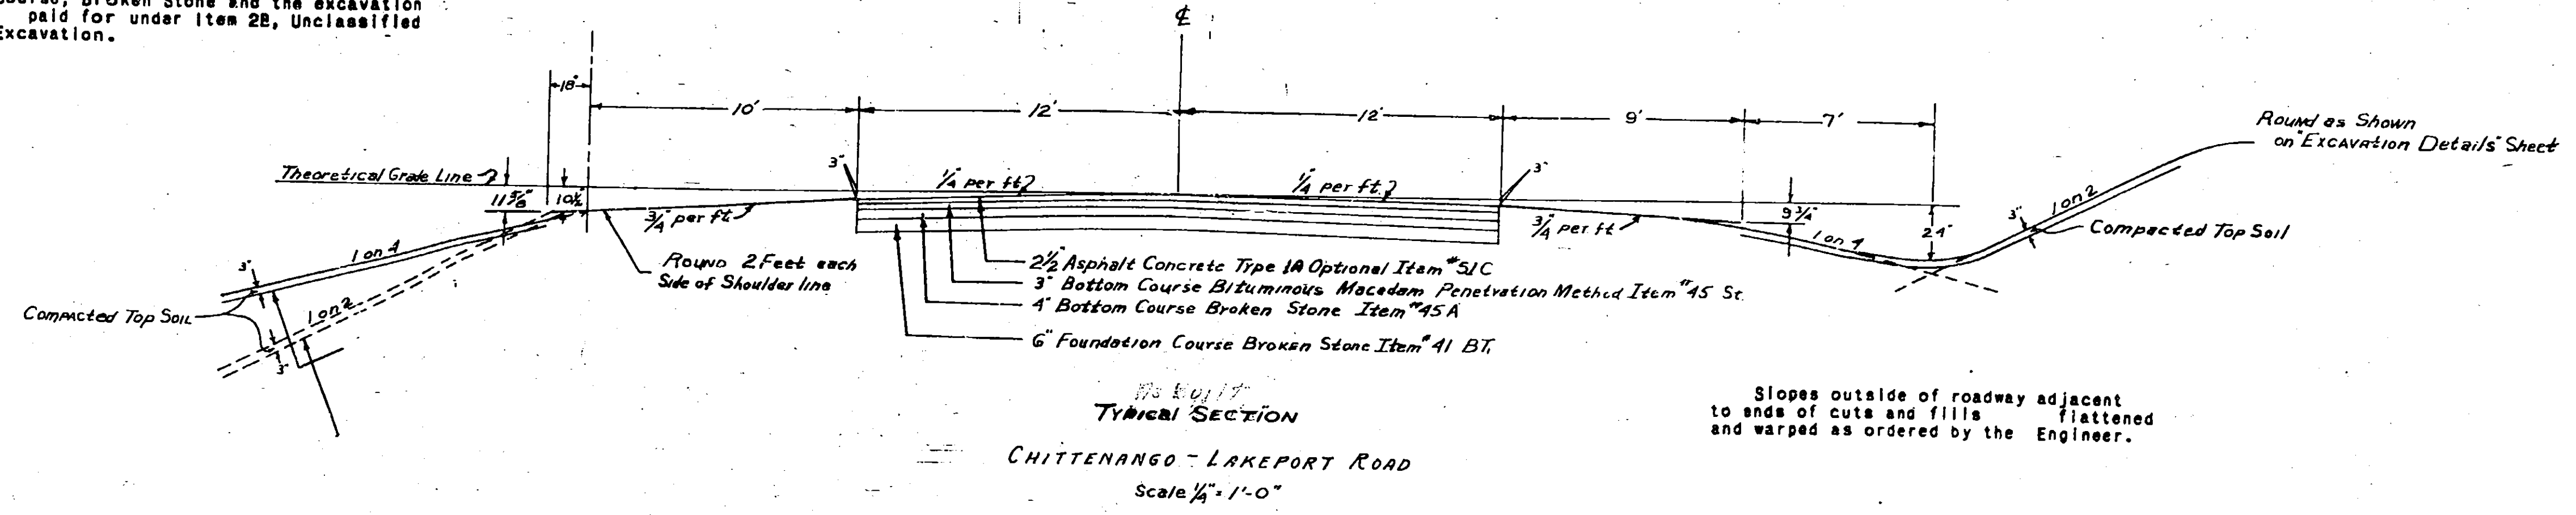

MAINTENANCE and PROTECTION of TRAFFIC
The contractor shall maintain and protect traffic in accordance with Item 76 for the duration of the contract within the limits of the Chittenango - Lakeport Road for the entire length of the contract and also within the limits of the Thruway so far as the limits of work extend.
Signs shall be erected in accordance with Standard Sheet No. 49-40 on both the Thruway and the Chittenango - Lakeport Road.
Any traffic required to use the Thruway shall be so routed that movement will be only in same direction as Thruway traffic.

Item 5 - TRENCH, CULVERT and BRIDGE EXCAVATION	
From	Cu. Yds.
TOTAL	7

DRAINAGE STRUCTURES		REMARKS
Present Structure	Station	
3' x 5' Conc. Box, 31' long	H 17+49	Remove existing culvert. Build 54" R.C.C.P. culvert 80 ft. long. Build
24" R.C.C.P. Culv. 76' long, No. Lane 80' long, So. Lane	277+80	Remove and store 24" R.C.C.P., - 76' long, No. Lane; 80' long, So. Lane.
None	H 11+03	Relay 80' of 24" R.C.C.P. (from Sta. 277+80) Build

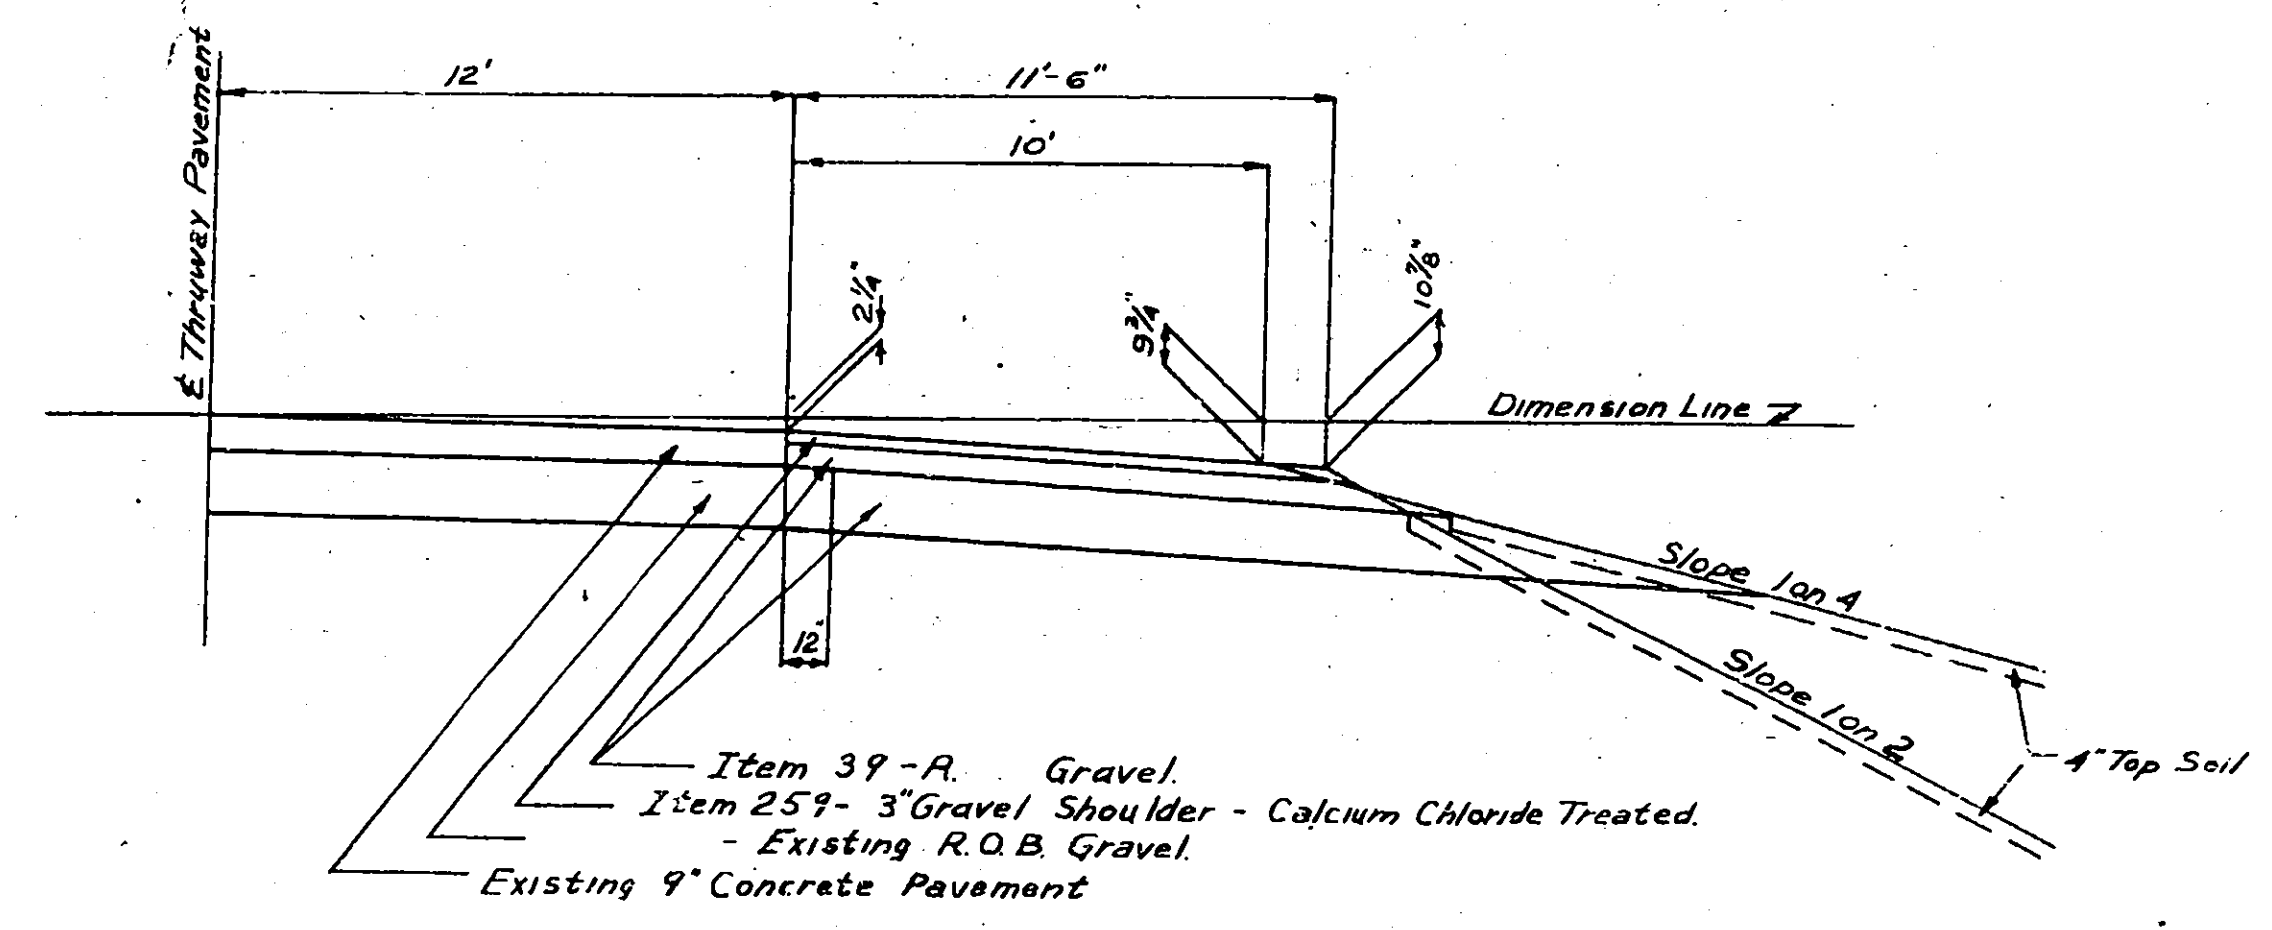

Item 2B-UNCLASSIFIED EXCAVATION	
From	Cu. Yds.
Road Excavation	
Borrow	
Removing Temp. Intersections	

DRIVEWAYS		Re-ESTABLISHED	
Station	Side	Station	Side
H 1+36	L	H 14+10 to	R
H 2+00	R	H 19+80	L
H 2+30	R	H 15+32	L
H 2+50	R	H 16+45	R
H 3+48	R	H 19+85	R
H 8+00	R	H 4+85 to	R
H 10+75	R	H 10+75	R

Item 32D-CABLE GUIDE RAILING, OPTIONAL			
Station to Station	Side	Length	
H 1+36 to H 2+00	L	66	
H 2+00 to H 2+30	R	30	
H 2+30 to H 2+50	R	20	
H 2+50 to H 3+48	R	98	
H 3+48 to H 8+00	R	452	
H 8+00 to H 10+75	R	275	
4 anchors @ 20'			
TOTAL			

TABLE of LENGTHS			
Station to Station		ROAD	BRIDGE
		Feet	Miles
H 0+25	H 10+74.58	1049.58	0.199
H 10+74.58	H 13+25.42	250.84	0.047
H 13+25.42	H 20+50	724.58	0.137
TOTAL		2025.00	0.383

MADE BY TRACED BY CHECKED BY
J.J. Dwyer D. LEWIS Colangelo

PREPARED PURSUANT TO THE HIGHWAY LAW & RECOMMENDED BY
DATE Larry Ketchum
ENGINEER DISTRICT No. 2

SCHEDULE A

LOCATION AND QUANTITY OF PAYMENT ITEMS

STATION TO STATION	SIDE	ITEM	QUANTITY	REMARKS
H 0+25 - H 10+37	L&R	121	370 C.Y.	Break in shoulder to end of road section.
H 13+62 - H 20+50	L&R	121	330 C.Y.	ditto
275+00 - 278+00		121	130 C.Y.	Thruway Mall.
H 0+25 - H 10+37	L&R	123	1.38 Acres	Edge of pavement to end of road section.
H 13+62 - H 20+50	L&R	123	1.14 Acres	ditto
275+00 - 278+00		123	.32 Acres	Thruway Mall.
H 7+00 - H 10+37	L&R	124	622 S.Y.	Sodded berm gutters, slope channels and sod strips.
H 13+62 - H 18+00	L&R	124	783 S.Y.	ditto
H 7+00 - H 10+75	L&R	IWA	9 M Gals.	In areas where item 124 is used.
H 13+25 - H 13+00	L&R	IWA	11 M Gals.	ditto

From B.R.I.D.G.E. P.L.A.N.S.

H 10+37 - H 10+75	L&R	121	91 C.Y.	Break in shoulder to end of road section.
H 13+25 - H 13+62	L&R	121	92 C.Y.	ditto
H 10+37 - H 10+75	L&R	123B	0.135 Acres	Edge of pavement to end of road section.
H 13+25 - H 13+62	L&R	123B	0.136 Acres	ditto
H 10+37 - H 10+75	L&R	124	164 S.Y.	Sodded berm gutters, slope channels and sod strips.
H 13+25 - H 13+62	L&R	124	165 S.Y.	ditto

TOTAL	121	830 C.Y.	Neat)	
		900 C.Y.	Rounded)	HIGHWAY
TOTAL	121	183 C.Y.	Neat)	
		200 C.Y.	Rounded)	BRIDGE
TOTAL	123	2.84 Acres	Neat)	
		3.50 Acres	Rounded)	HIGHWAY
TOTAL	123B	0.27 Acres	Neat)	
		0.30 Acres	Rounded)	BRIDGE
TOTAL	124	1405 S.Y.	Neat)	
		1550 S.Y.	Rounded)	HIGHWAY
TOTAL	124	329 S.Y.	Neat)	
		350 S.Y.	Rounded)	BRIDGE
TOTAL	IWA	20 M Gals.	Neat)	
		20 M Gals.	Rounded)	

SCHEDULE B

DETAIL SPECIFICATIONS TO ACCOMPANY PUBLIC WORKS SPECIFICATIONS

ITEM NO.	DESCRIPTION
IW	FURNISHING WATER EQUIPMENT
IWA	APPLYING WATER
a	Areas - See Schedule A.
	Rates - As specified.
121	TOPSOIL PLACED FROM STOCKPILES
a	Areas - See Schedule A
c1	Subgrade scarified as directed by Engineer
c3	Topsoil thickness - 3 inches loose measure
123	SEEDING
a	Areas - See Schedule A
b	Seeds - See Schedule D
	Fertilizer - M-55, Type No. 2 (10-10-10)
	Mulch - M-59, Hay or M-60, Straw
c2	No inoculation required for Alsike Clover.
c3	Rate of Seeding - 50 lbs. pure live seed per acre
	Rate of Fertilizer - 600 lbs. per acre
c4	Rate of Mulch - 2 tons per acre
123B	SEEDING ON PREPARED AREAS
a	Areas - See Schedule A
124	SODDING
a	AREAS - See Schedule A
c3	Sodding shall be as shown on Standard Sheet 50-34, Bridge Plans, or as directed by Engineer.

LOCATION OF TOPSOIL STOCKPILES

Station	Side	Approx. Quantity
7+00	Lt	500 C.Y.
15+00	Lt	200 C.Y.
30+00	Rt	2000 C.Y.
44+00	Rt	800 C.Y.
87+00	Rt	1500 C.Y.
198+00	Lt	800 C.Y.

NOTE: All areas disturbed by removing Topsoil from stockpiles will be regraded and seeded as directed by the Engineer. No direct payment will be made for this work but the cost thereof shall be included in price bid for the various items in the contract.

SCHEDULE C

DETAIL SPECIFICATIONS FOR PLANTS

ITEM NO.	PLANT NAME	SIZE	STOCK PLANT	REMARKS
----------	------------	------	-------------	---------

FED. ROAD DIST. NO. STATE PROJ. NO. FISCAL YEAR SHEET NO. TOTAL SHEETS

34 67

ROADSIDE DEVELOPMENT SHEET

MOHAWK THRUWAY - Sect. I

CHITTENANGO - LAKEPORT Road

SCHEDULE D

DETAIL SPECIFICATIONS FOR SEEDS

NAME	CERT.	1	2	3
Creeping Red Fescue (Festuca rubra)	Commercial	95	75	25
Redtop (Agrostis alba)	Commercial	90	85	10
Perennial Ryegrass (Lolium perenne)	Commercial	95	75	7
Alsike Clover (Trifolium hybridum)	Commercial	95	85	3
Wild White Clover (Trifolium repens var.)	Kent Wild, N.Y. Wild, N. Zealand Wild	95	95	5
	Max. 25% Hard Seed			
	RATE			50

SUMMARY




IW	Nec.	Furnishing Water Equipment
IWA	20 M. Gals.	Applying Water
121	1100 C.Y.	Topsoil placed from Stockpiles
123	3.50 Acres	Seeding
123B	0.30 Acres	Seeding on Prepared Areas
124	1900 S.Y.	Sodding

K. Keil

F. B. White

Fed Rd Div No.	State	Fed Aid Proj No.	County	Sheet No.	Total Sheets
	NY		Madison	35	67

Mohawk Thruway - N. Chittenango ~ Canastota
 Chittenango-Lakeport Road (Vly Road)

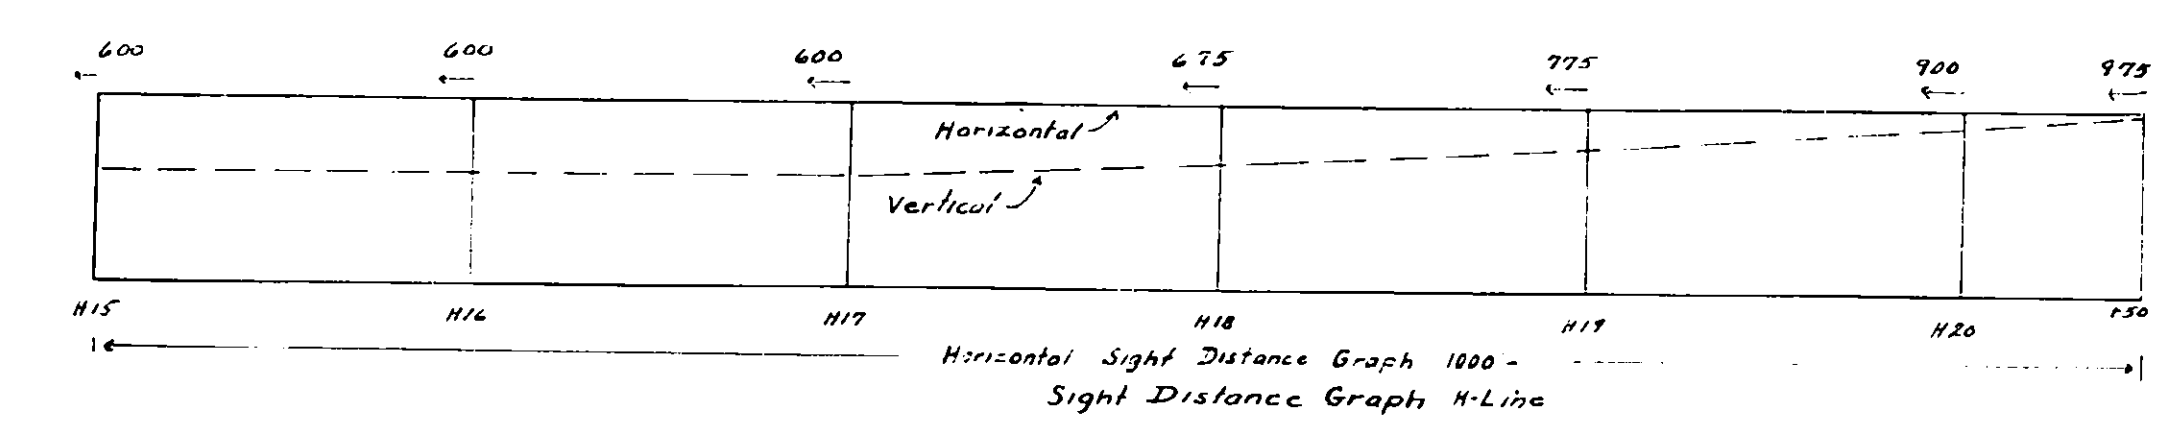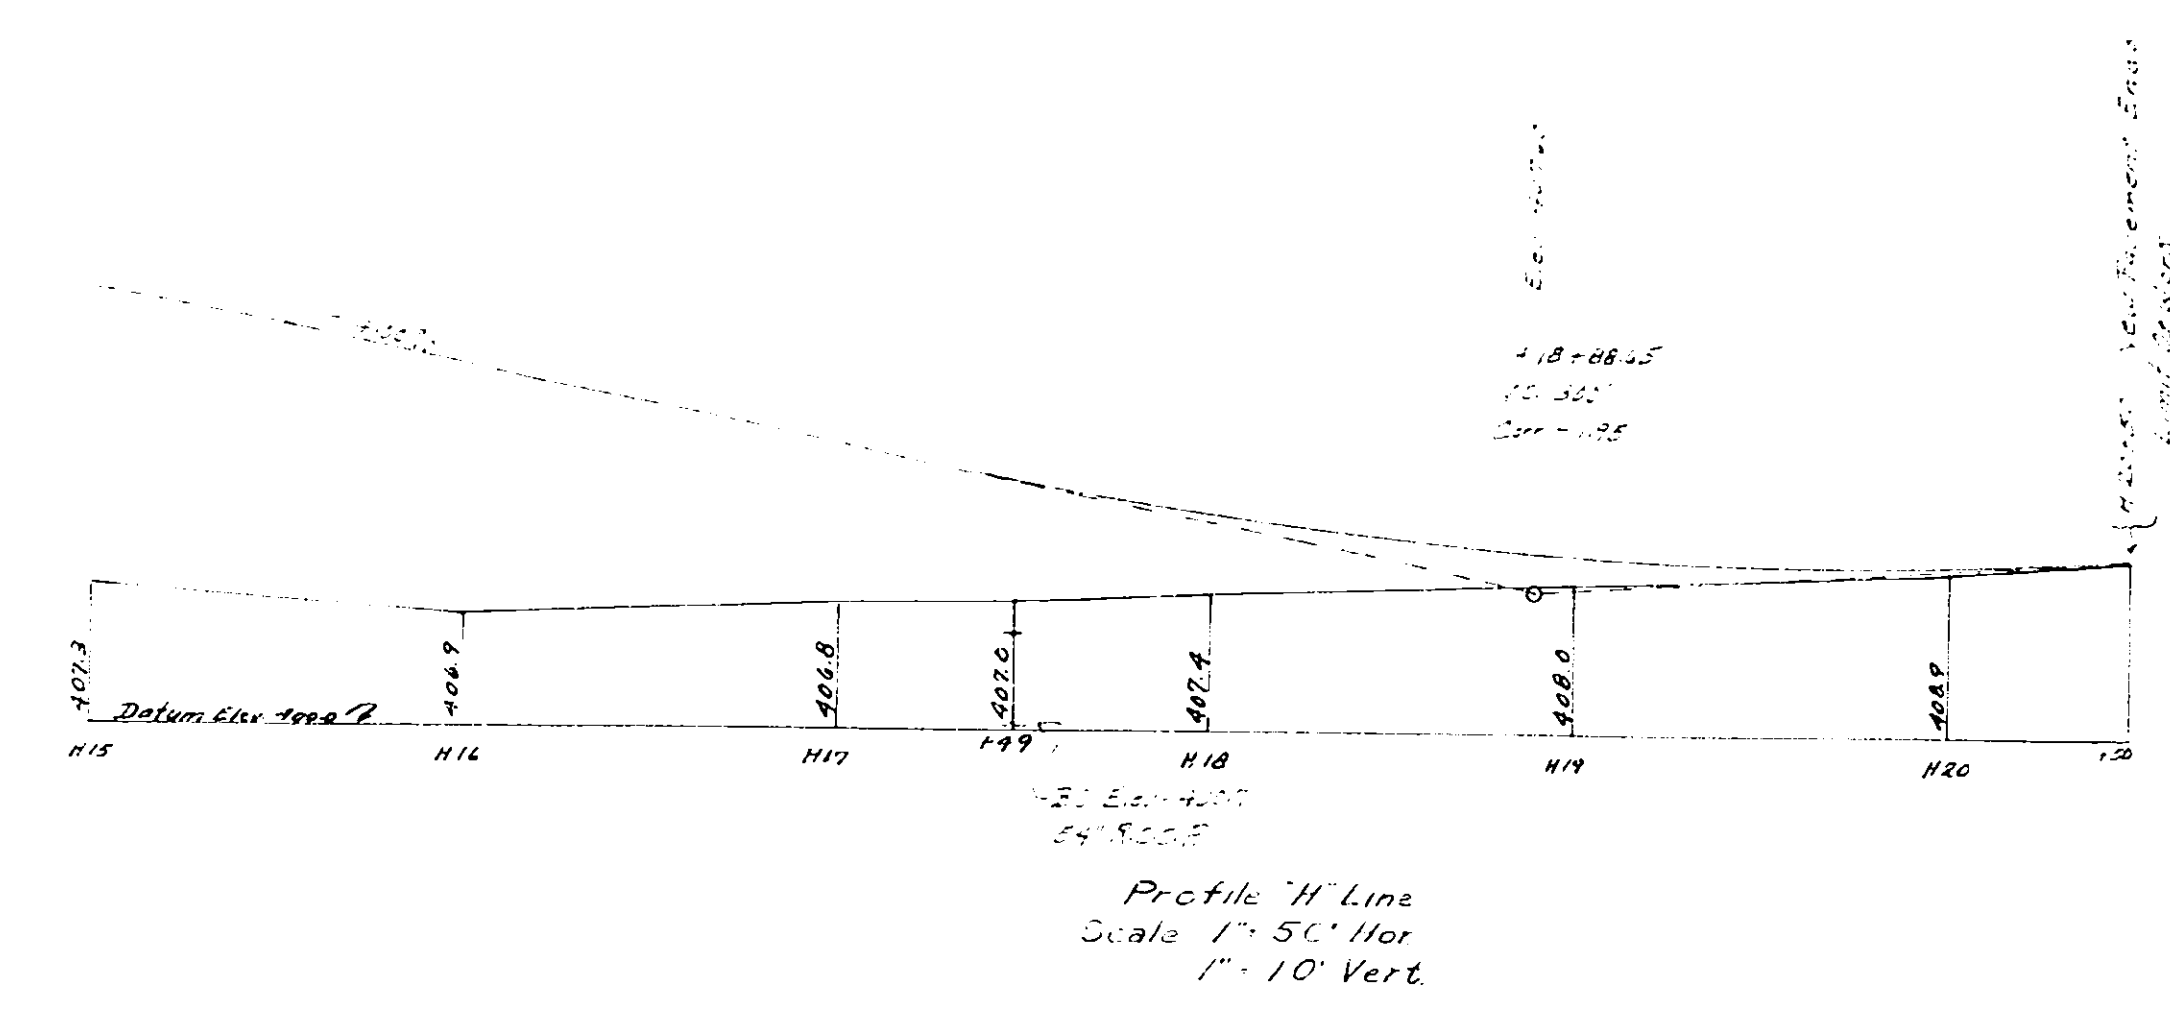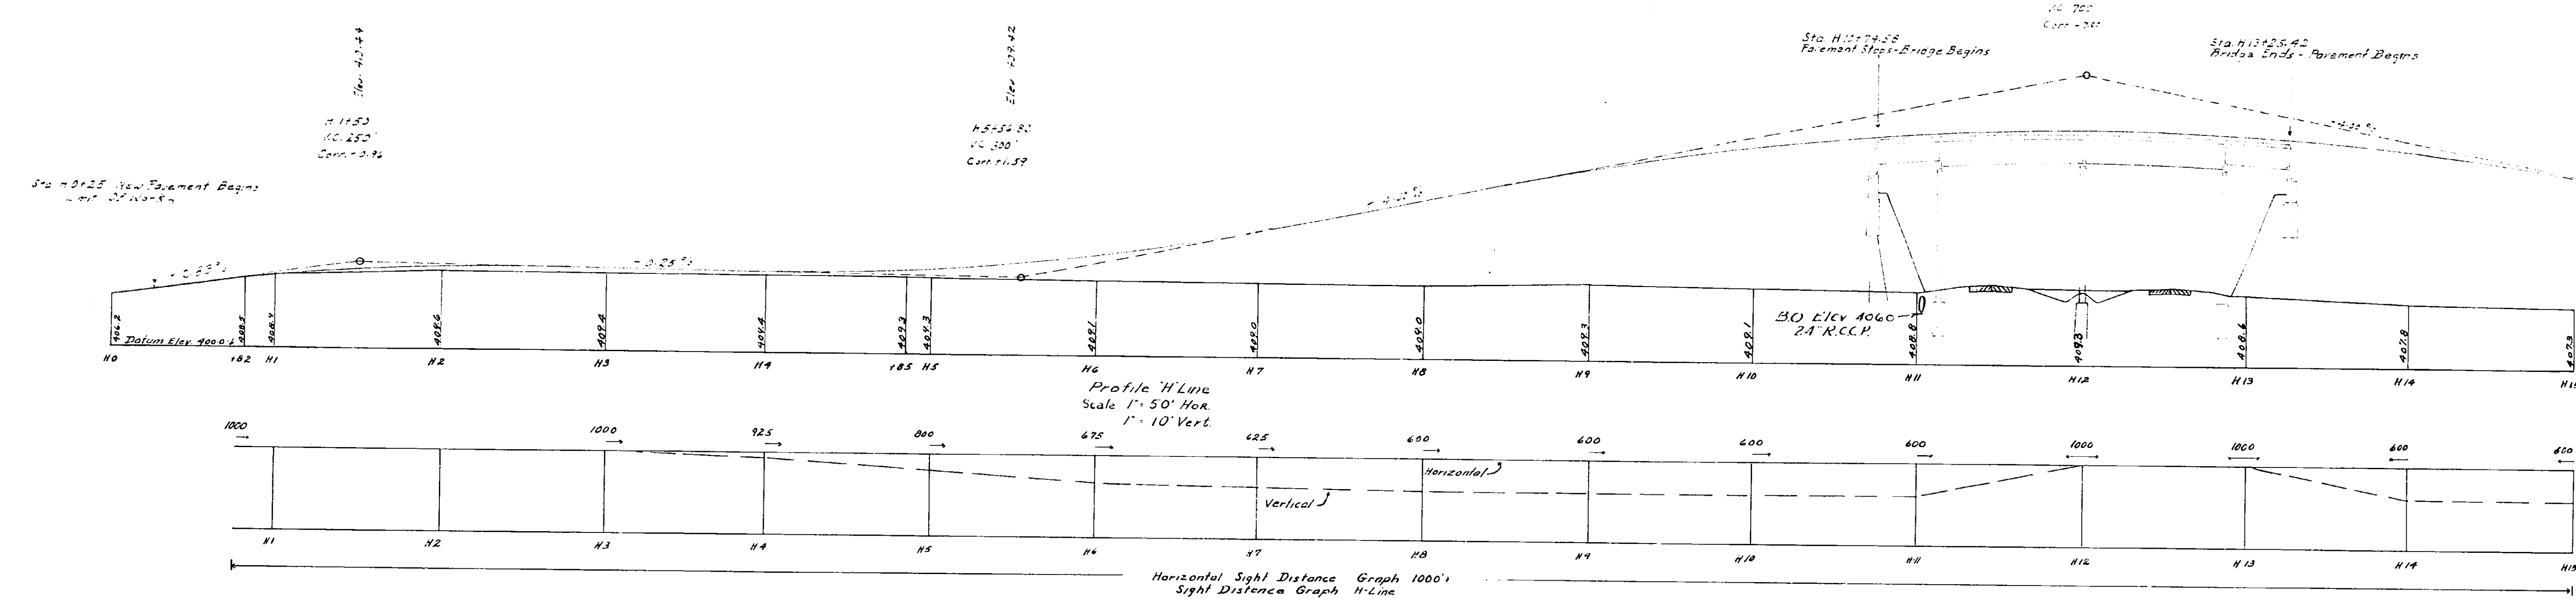




Made by _____ Traced by _____ Checked by _____
 Plan _____
 Profile _____

Prepared pursuant to the Highway Law & recommended by
 Date _____ Engineer District No. 2

Fed Rd Div. No.	State	Fed Aid Proj. No.	County	Sheet No.	Total Sheets
	N.K.		Madison	35	67

Mohawk Thruway - N. Chittenango - Canastota
Chittenango - Lakeport Road (Vly Road)

37R

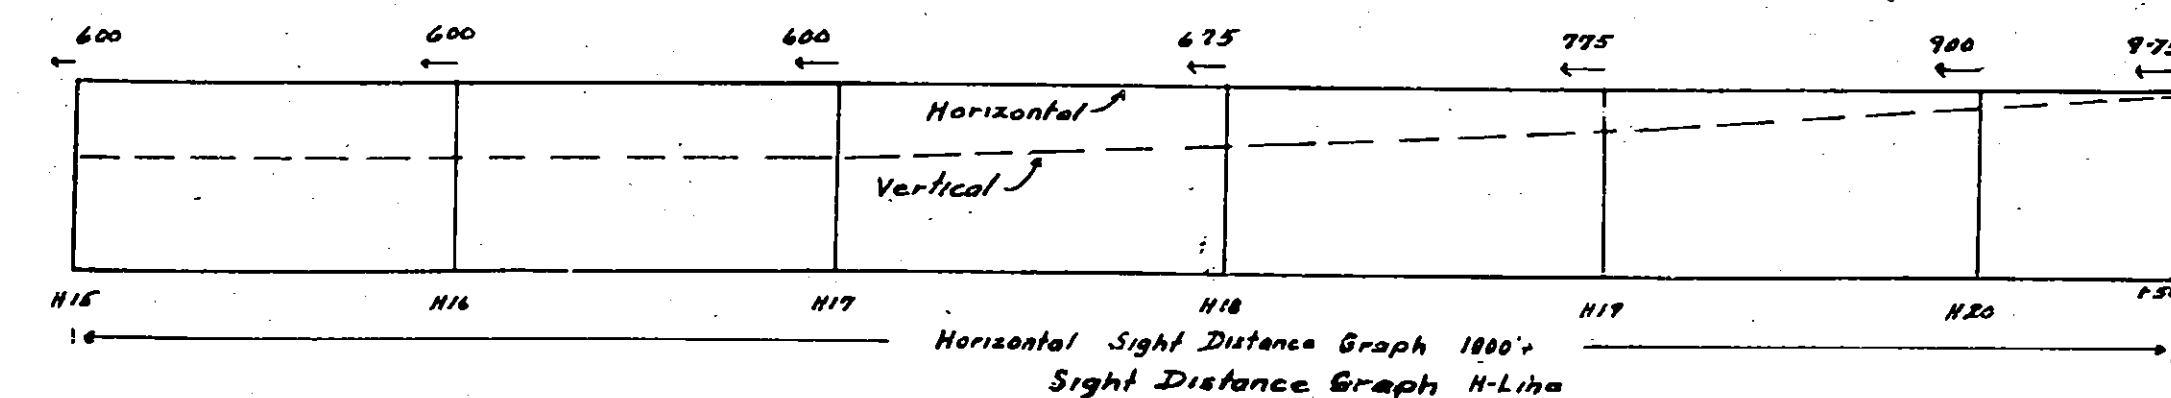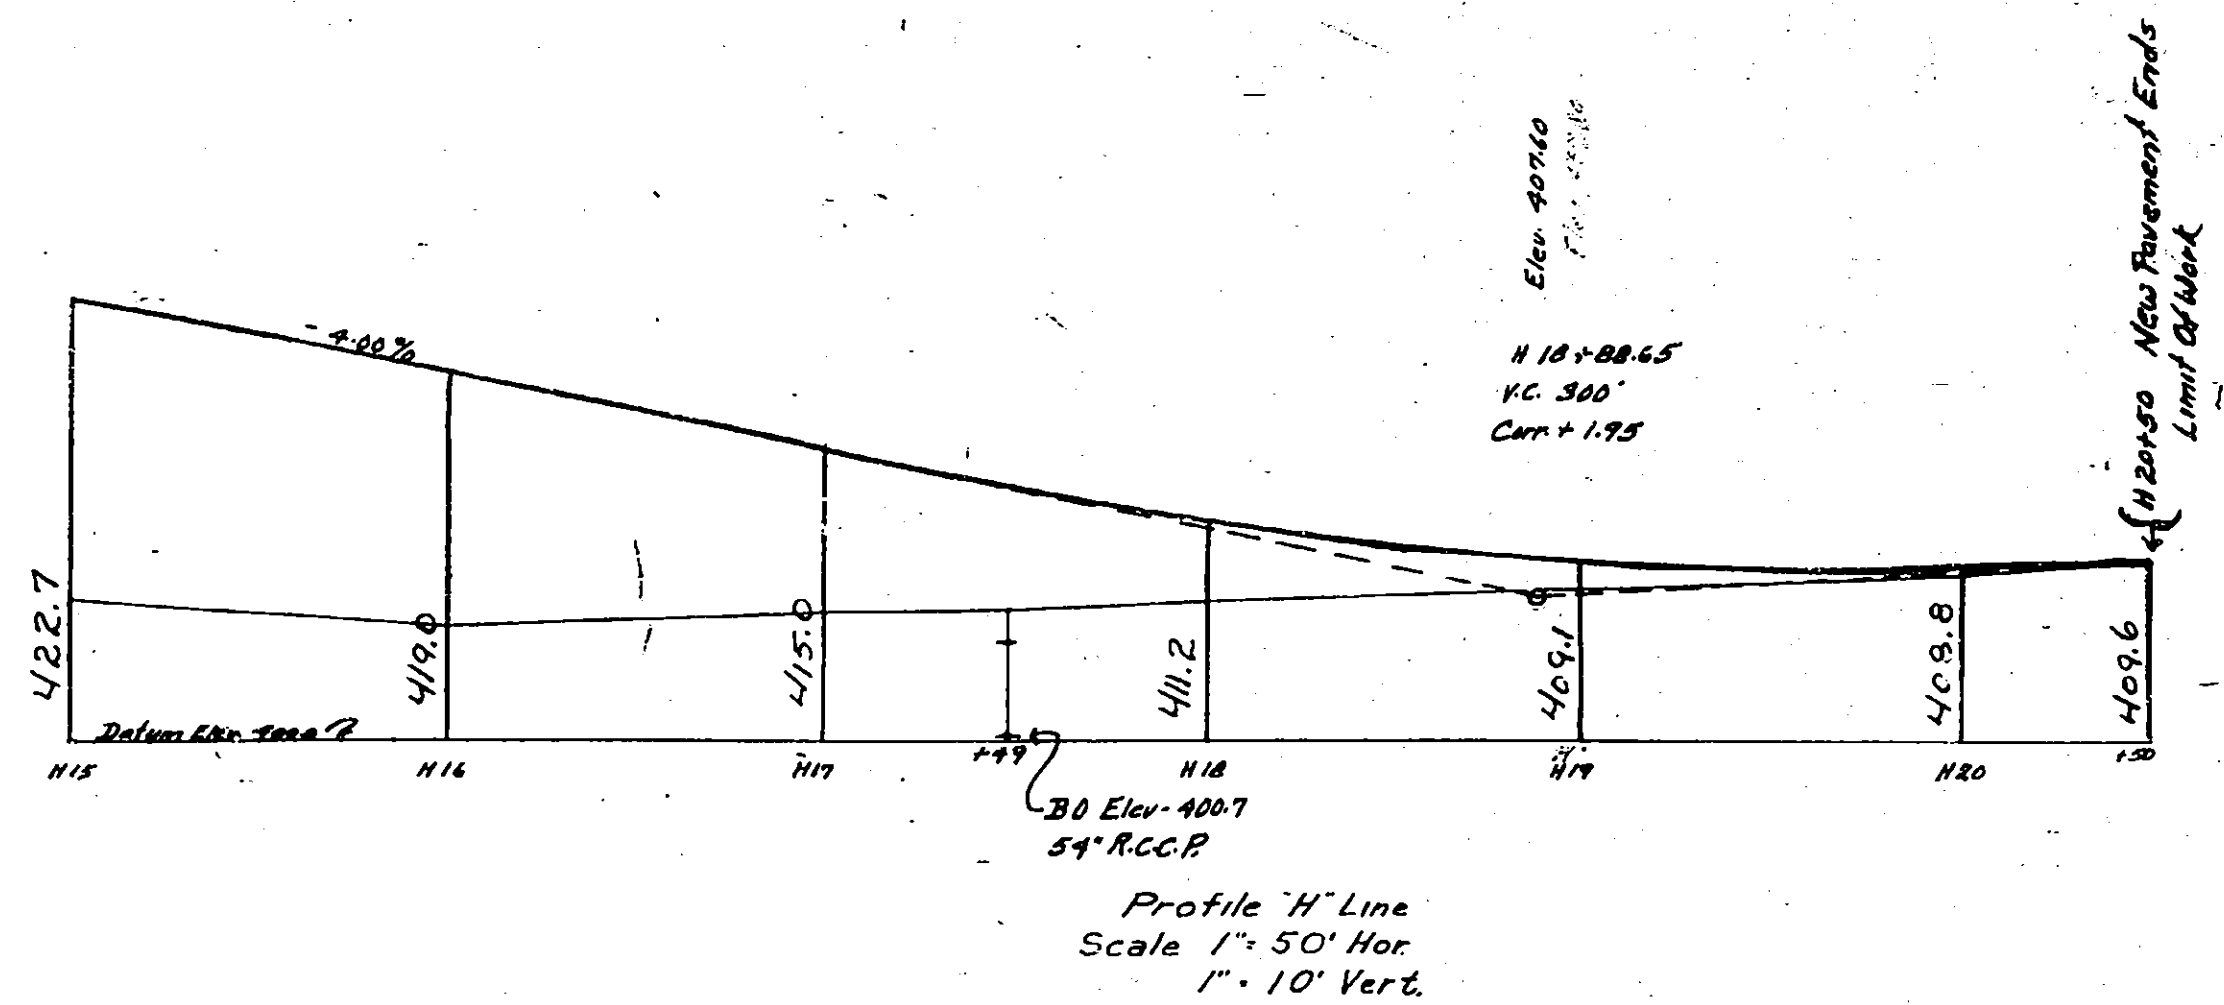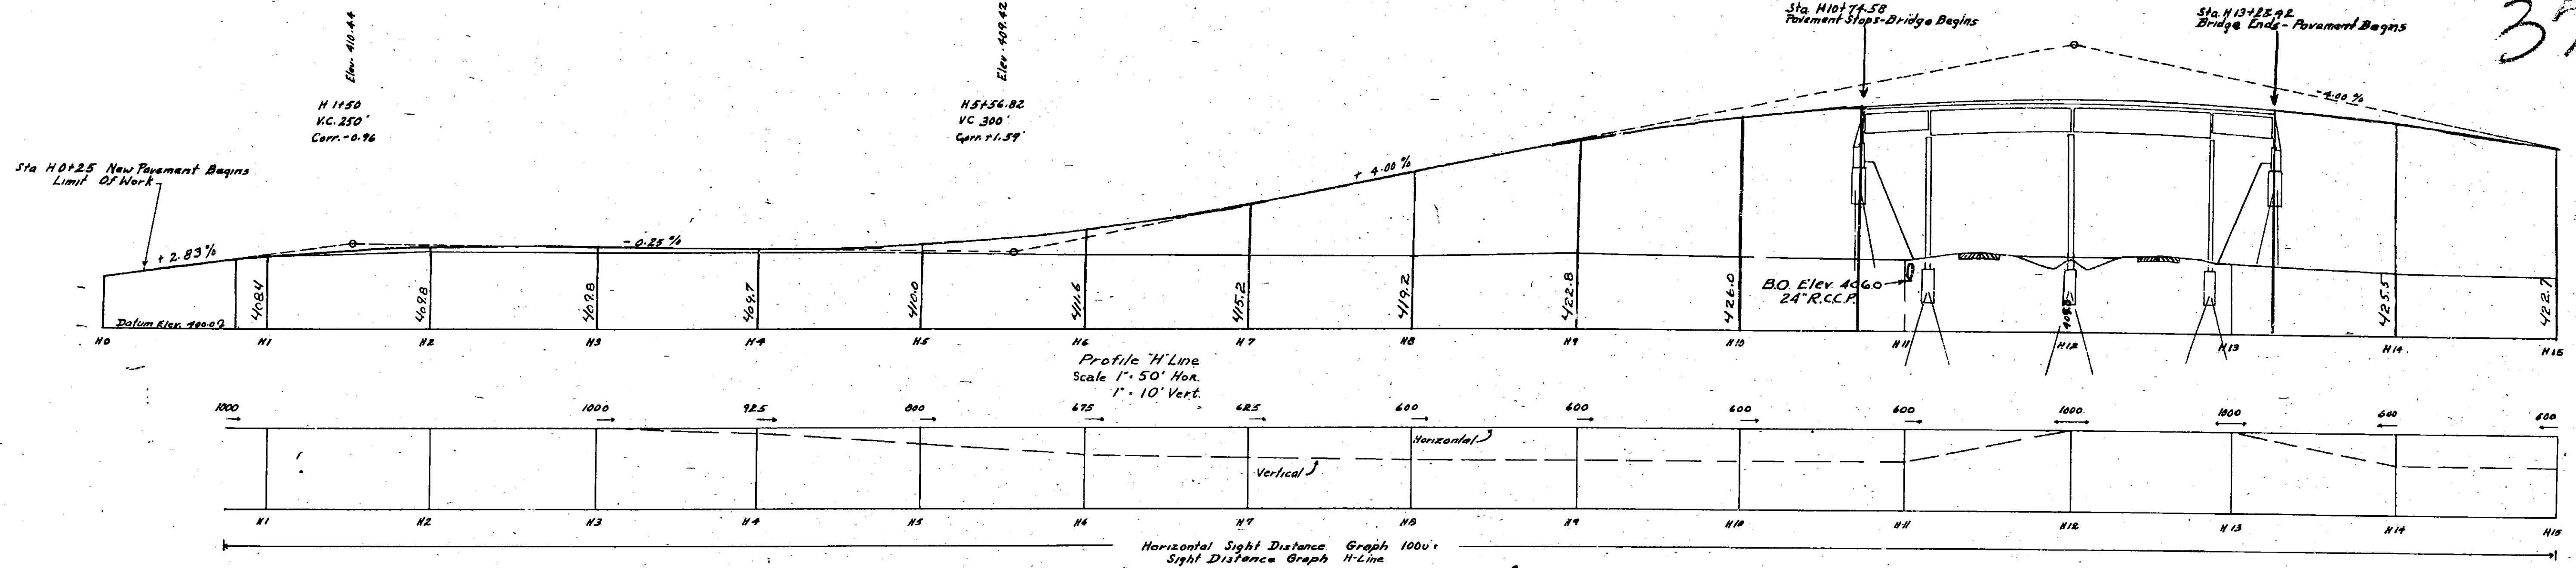


Made by Traced by Checked by

Plan Profile L. Colangelo Colangelo

Prepared pursuant to the Highway Law & recommended by

Date Engineer District No. 2

FED RD D.V. No	STATE	FED AID PROJ. No	COUNTY	SHEET No	TOTAL SHEETS
	N.Y.		Madison	36	67
MOHAWK THRUWAY N. Chittenango - Canastota Chittenango - Lakeport Road (Vly Road)					

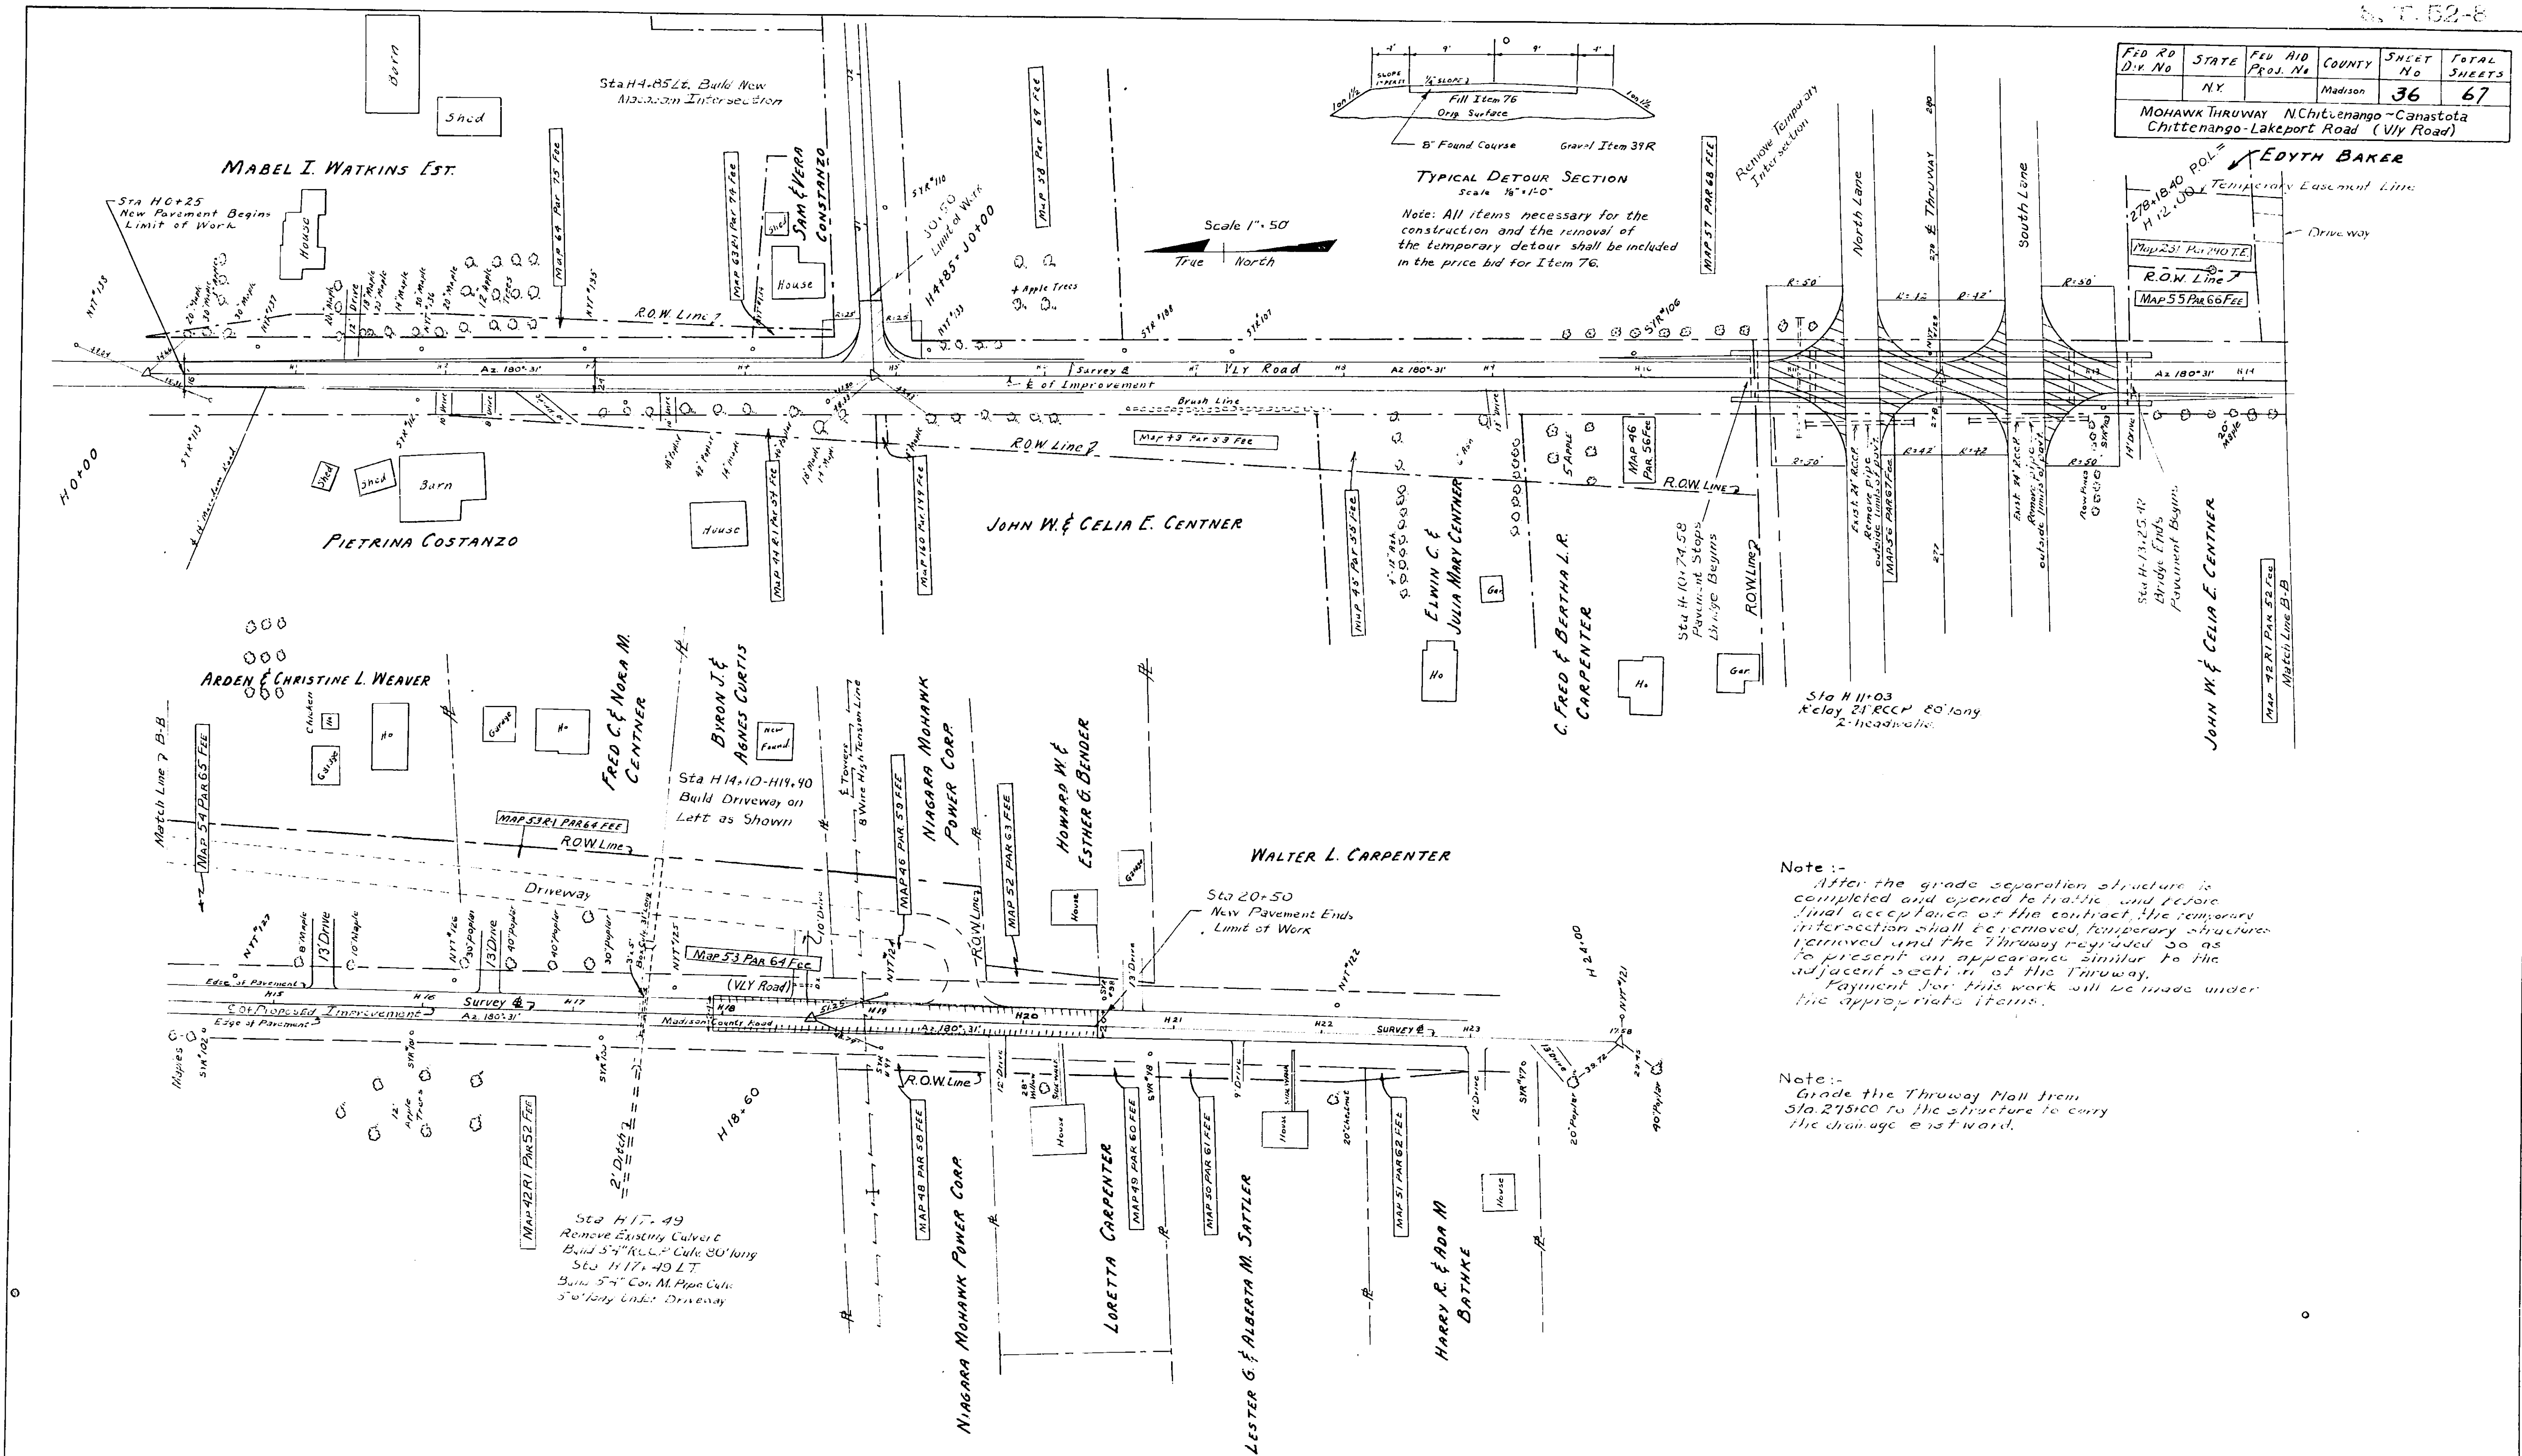


MADE BY TRAVELED BY CHECKED BY
PLAN J. J. DWYER D. L. WIS Colangelo
PROFILE

PREPARED PURSUANT TO THE HIGHWAY LAW & RECOMMENDED BY
D. J. T. C. ENGINEER DISTRICT No. 2

FED. RD. DIV. No.	STATE	FED. AID PROJ. No.	COUNTY	SHEET No.	TOTAL SHEETS
	N.Y.		Madison	36	67
MOHAWK THRUWAY N. Chittenango - Canastota Chittenango-Lakeport Road (Vly Road)					

EDYTH BAKER
278+18.00 Temporary Easement Line.
Map 231 Par 290 Fee
ROW Line 7
Map 55 Par 66 Fee

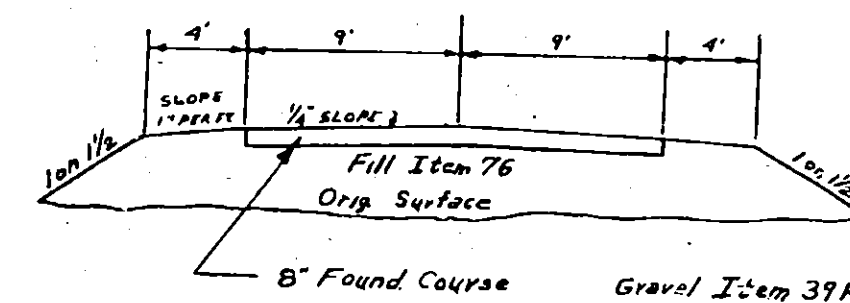


TYPICAL DETOUR SECTION

Scale 1/2"=1'-0"

Note: All items necessary for the construction and the removal of the temporary detour shall be included in the price bid for Item 76.

Scale 1"=50'

True North

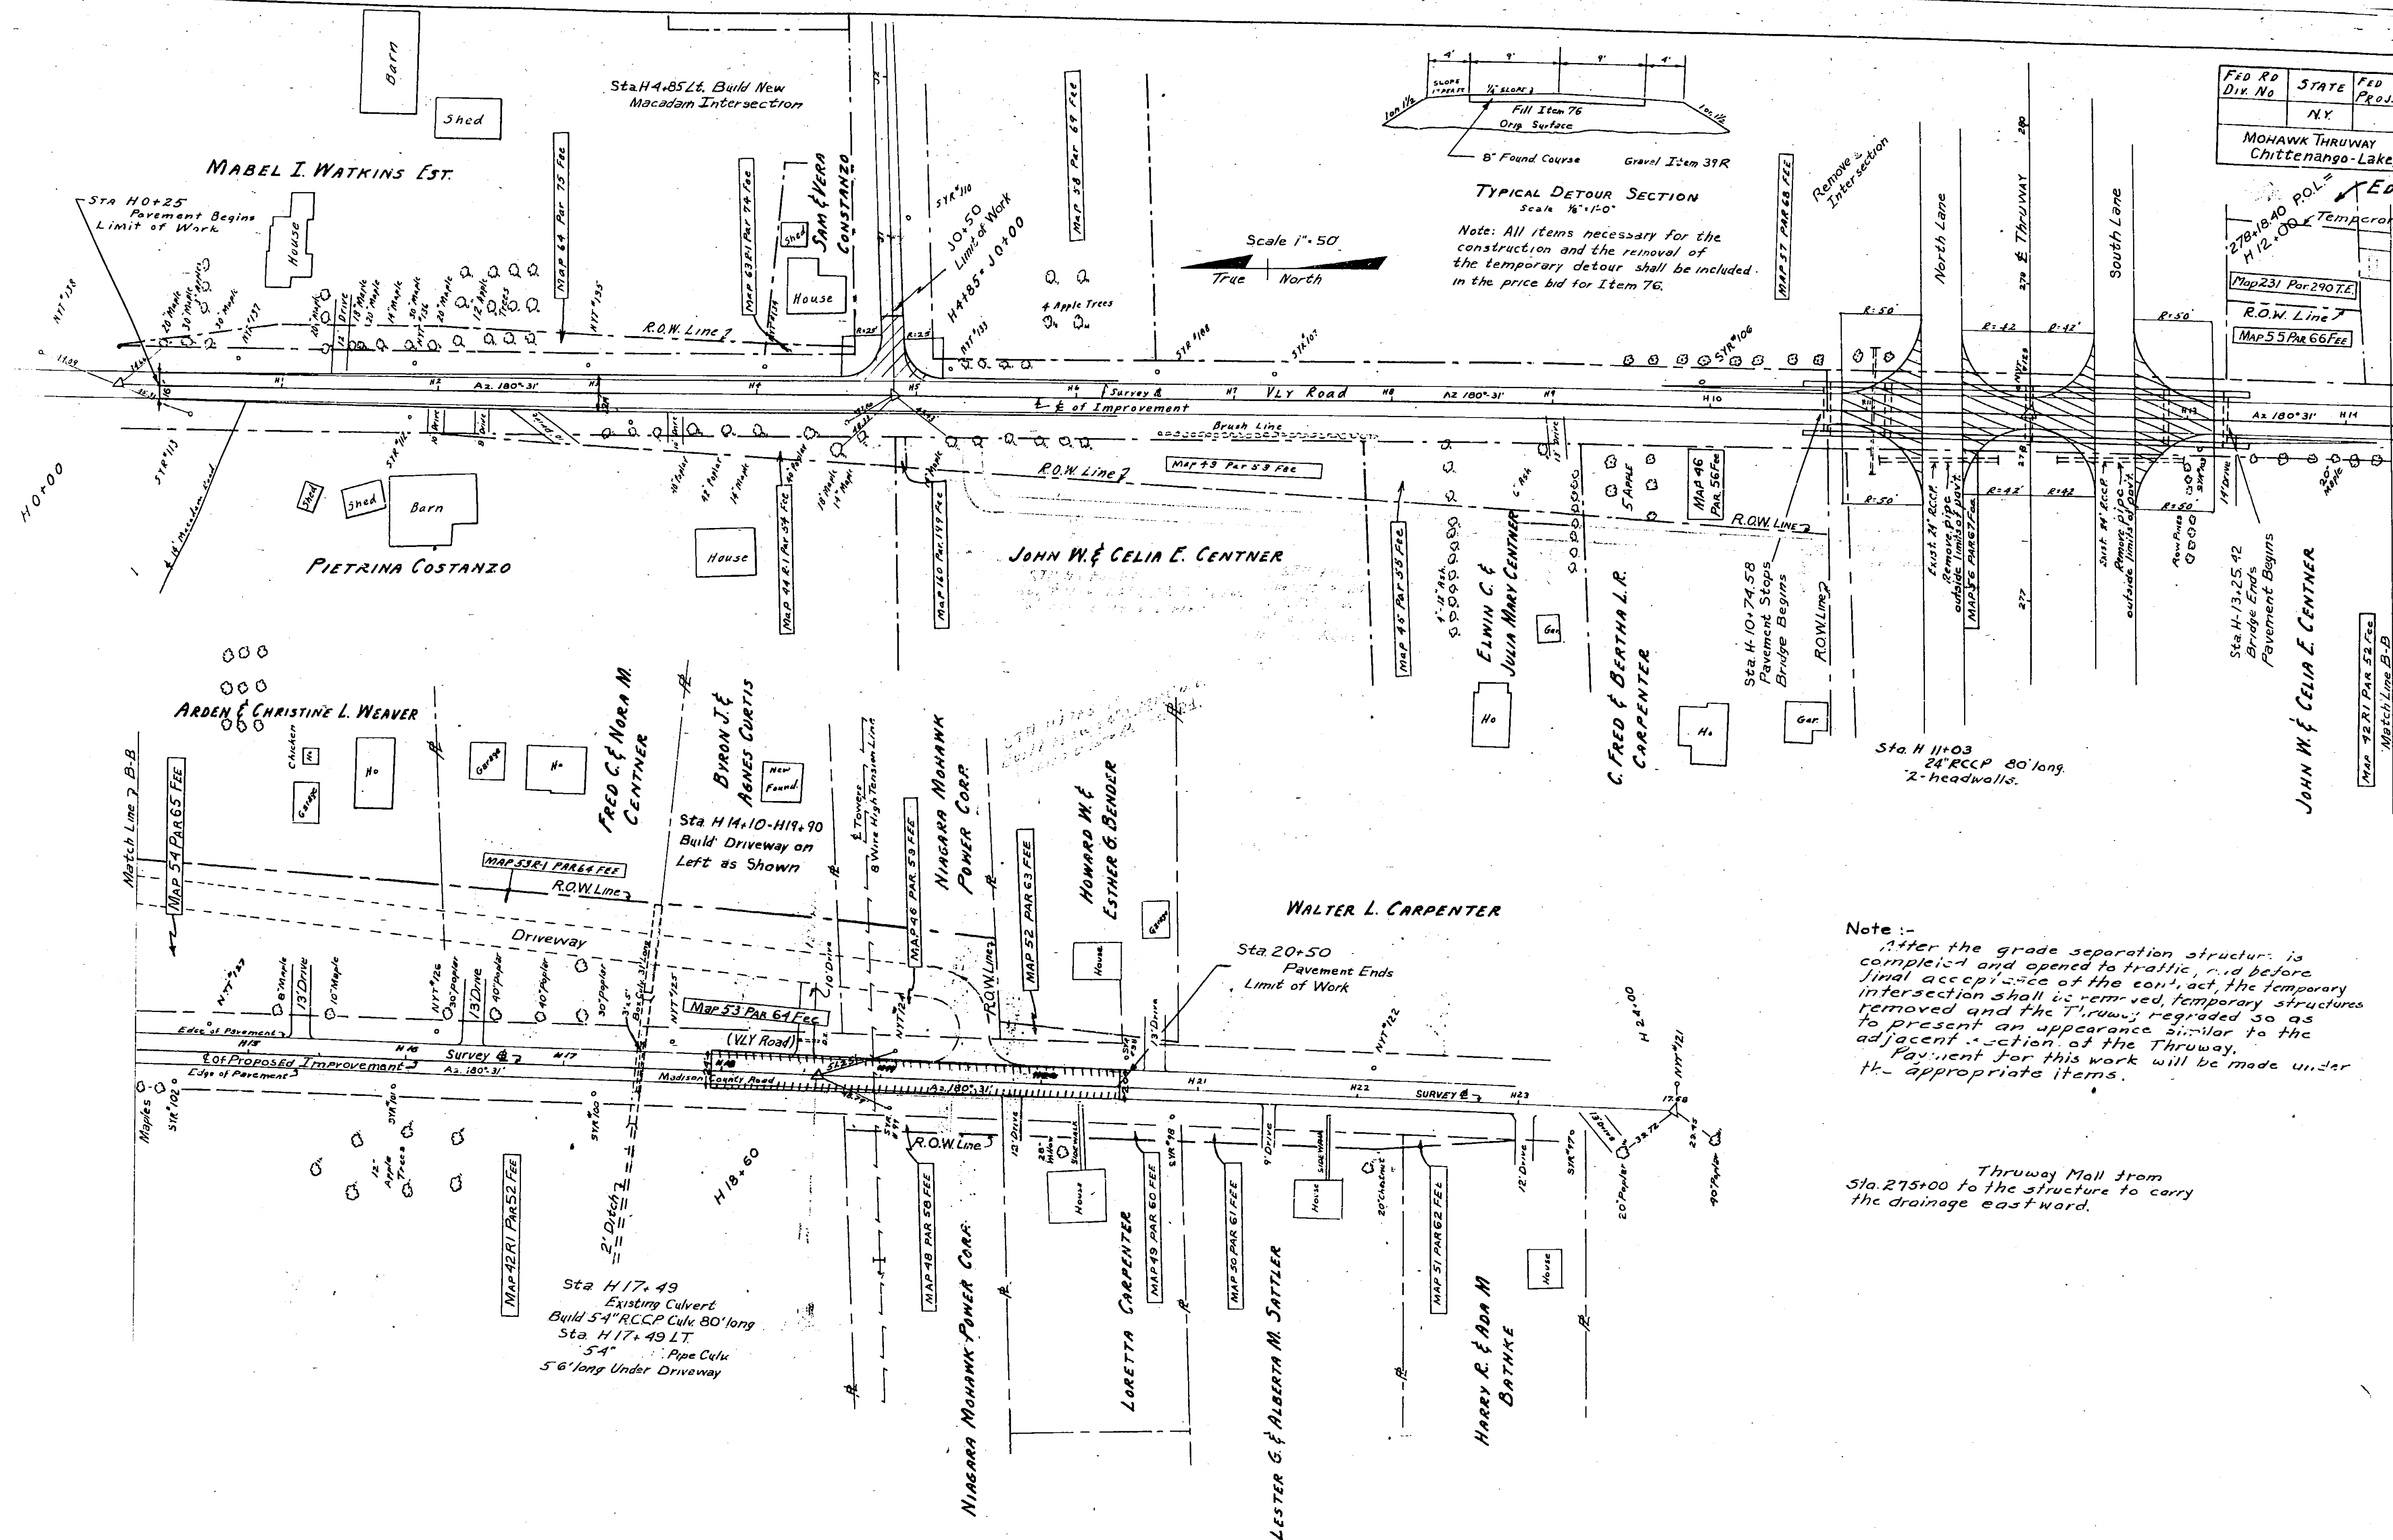

Note: -
After the grade separation structure is completed and opened to traffic, and before final acceptance of the contract, the temporary intersection shall be removed, temporary structures removed and the Thruway regraded so as to present an appearance similar to the adjacent section of the Thruway. Payment for this work will be made under the appropriate items.

Thruway Mail from Sta. 275+00 to the structure to carry the drainage eastward.



MADE BY TRACED BY CHECKED BY
J. J. Dwyer D. Lewis Colangelo

PREPARED PURSUANT TO THE HIGHWAY LAW & RECOMMENDED BY


DATE

ENGINEER DISTRICT No. 2

FED. AID DIST. NO.	STATE	FED. AID PROJ. NO.	FISCAL YEAR	SHEET NO.	TOTAL SHEETS
	N.Y.			37	67
MOHAWK THRUWAY					
FROM TO					
MADISON COUNTY					

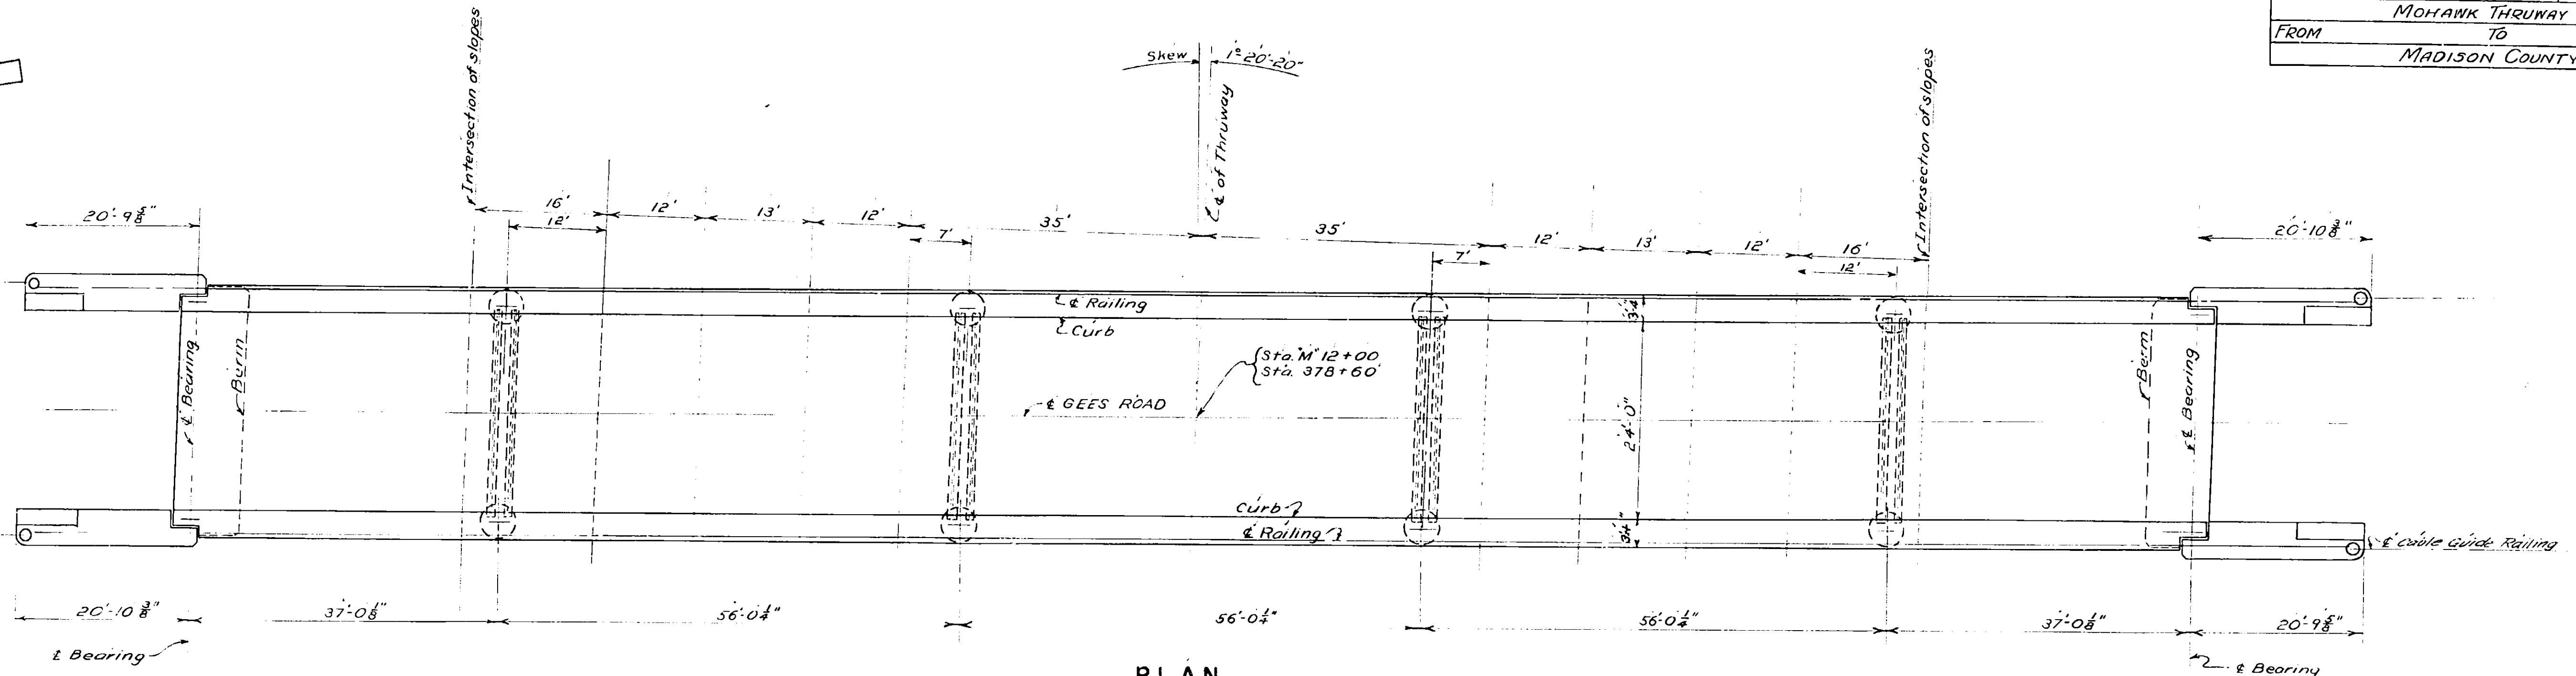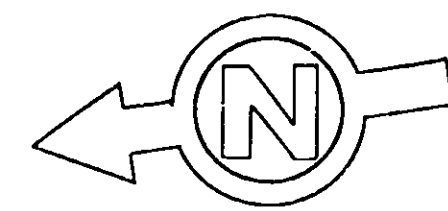

PLAN
SCALE $\frac{3}{32}'' = 1'-0''$

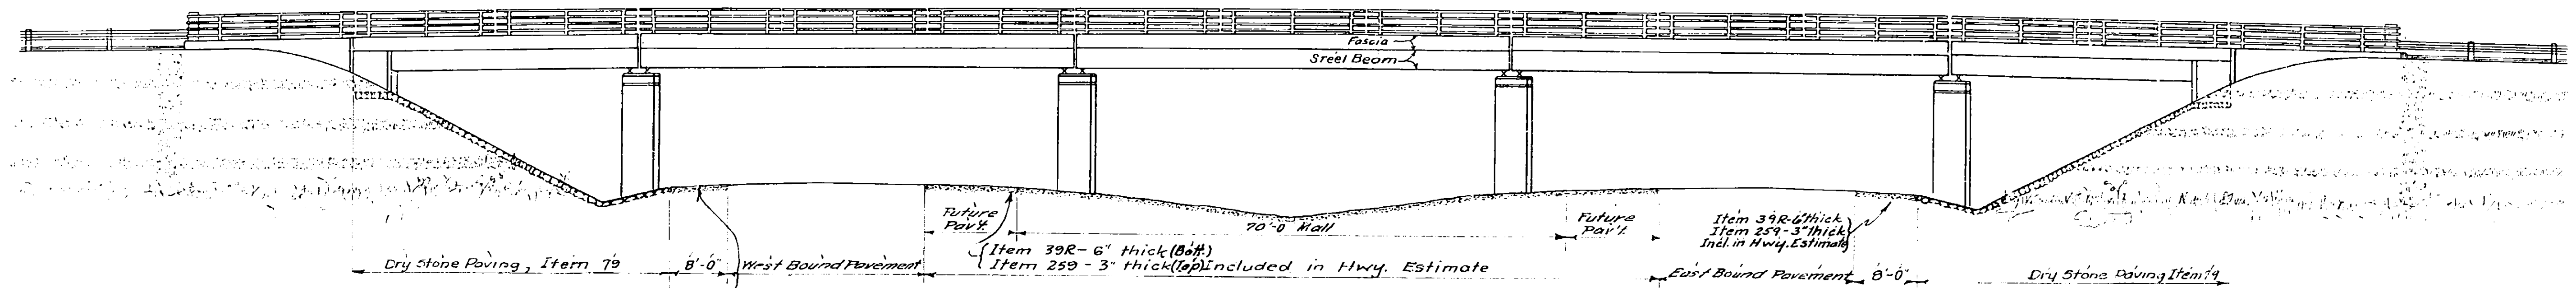





WEST ELEVATION
SCALE $\frac{3}{32}'' = 1'-0''$

Note: Item 42 is not in this contract (N.E.C.)
Thickness of overlaying concrete shall
be increased $\frac{3}{8}''$


Drawn by 1/31/50
F.C. Halligan 1/31/50
Checked by 1/4/50
J.E. Halligan 1/4/50

GEES ROAD BRIDGE
STA. 378+60
ARCHITECTURAL PLAN AND
ELEVATION

FED. AID DIST. NO.	STATE	FED. AID PROJ. NO.	FISCAL YEAR	SHEET NO.	TOTAL SHEETS
	N.Y.			38	67
MOHAWK THRUWAY					
FROM TO					
MADISON COUNTY					

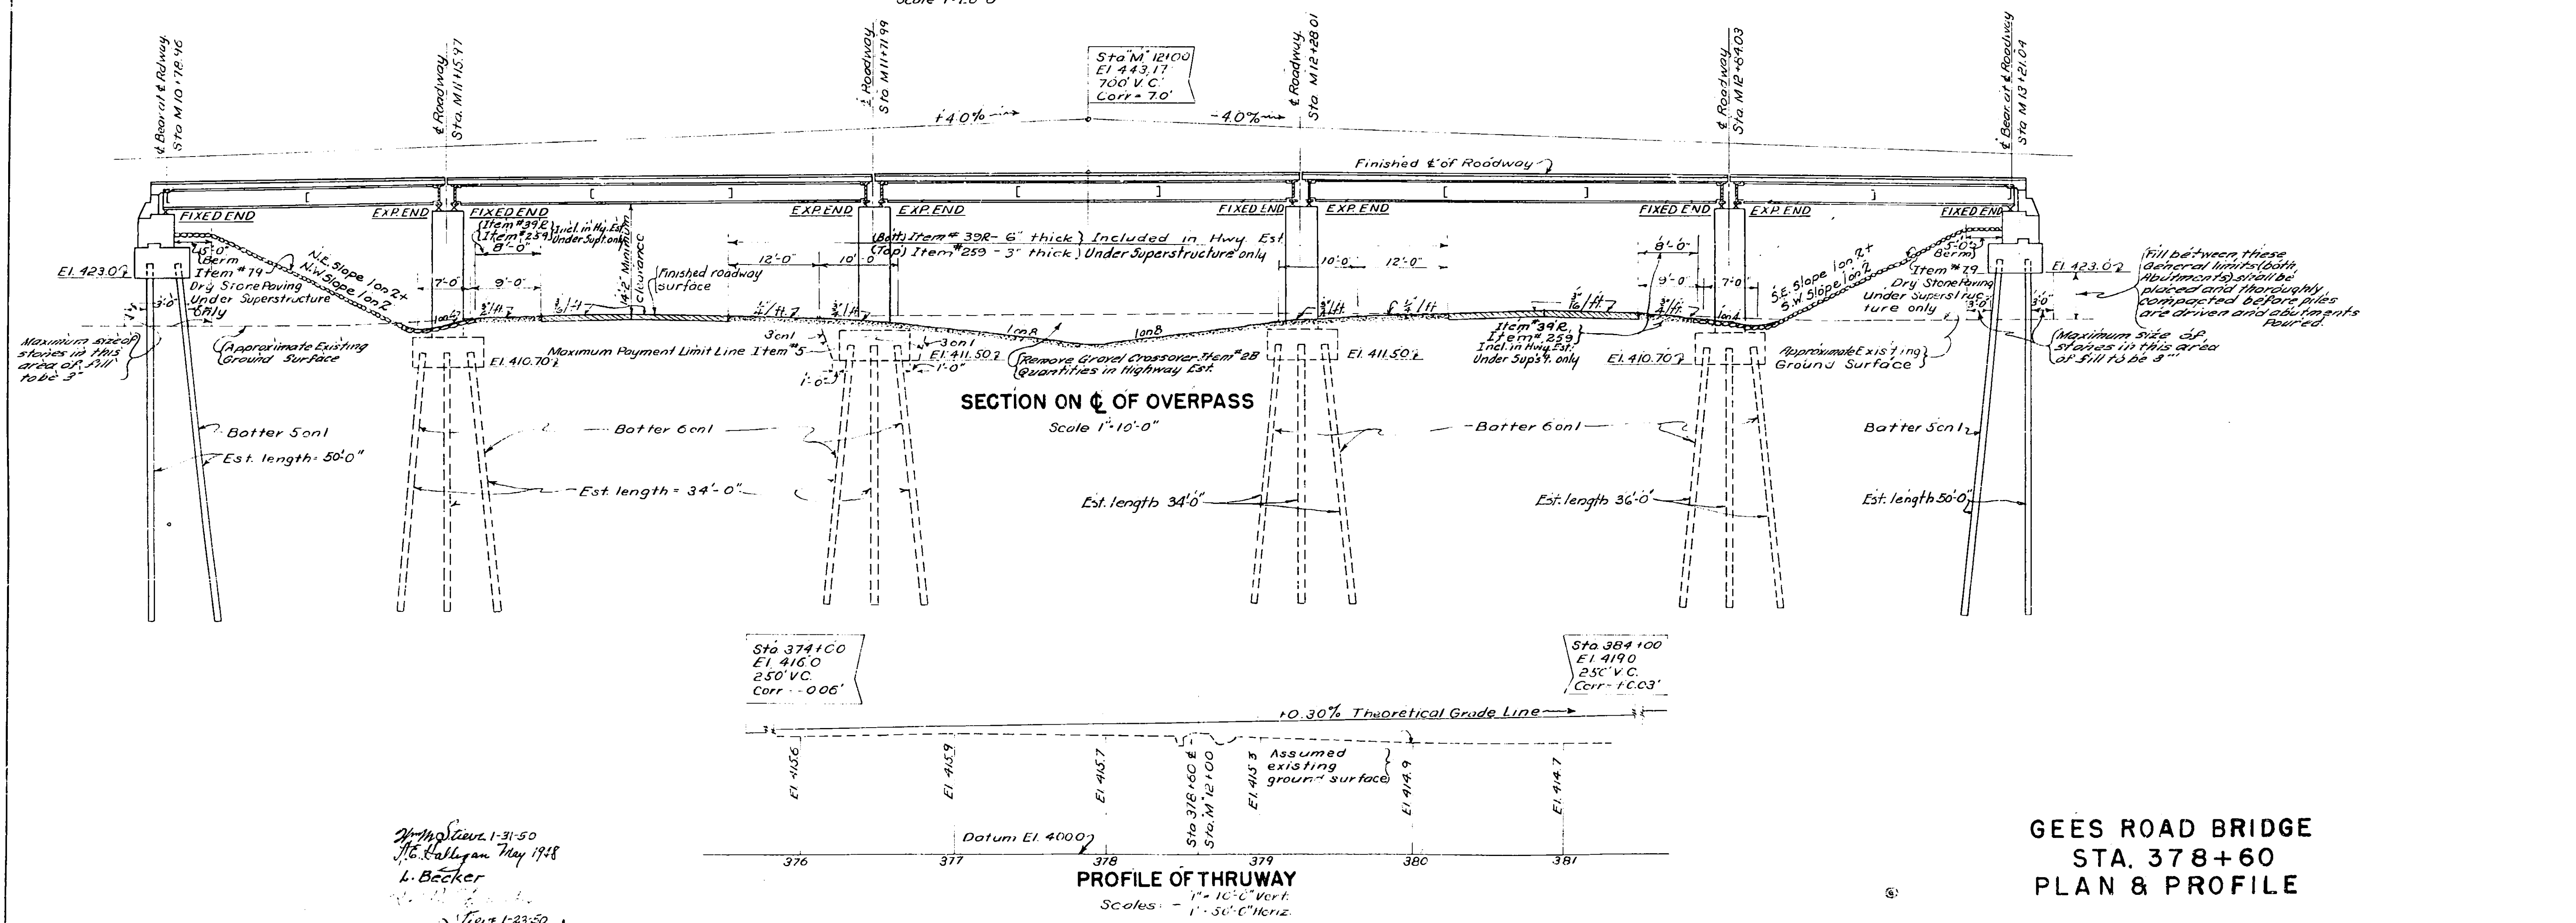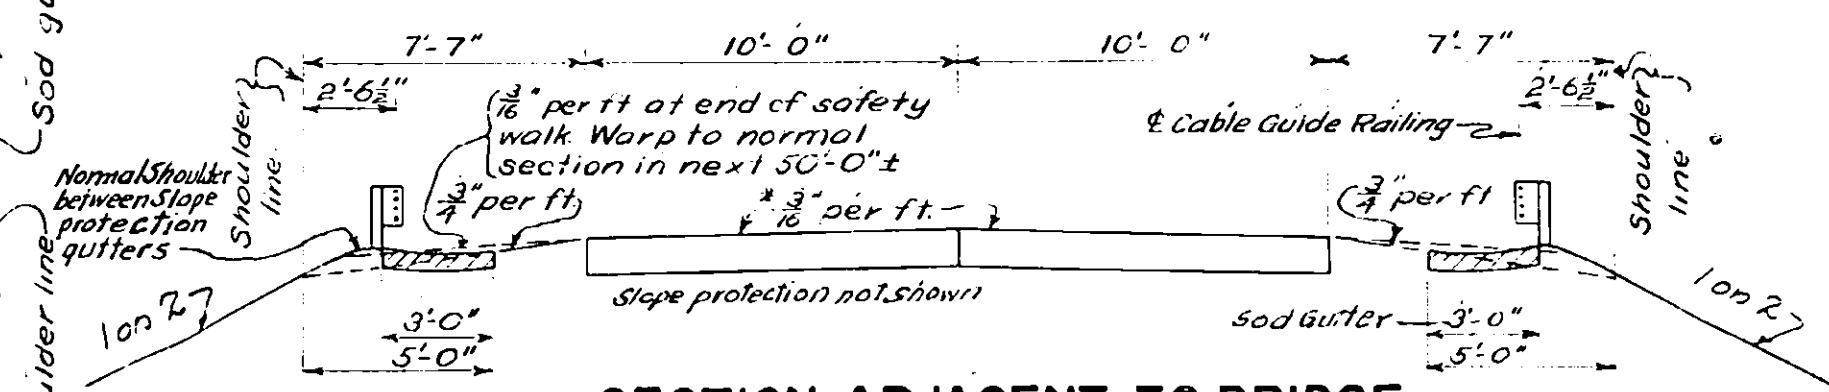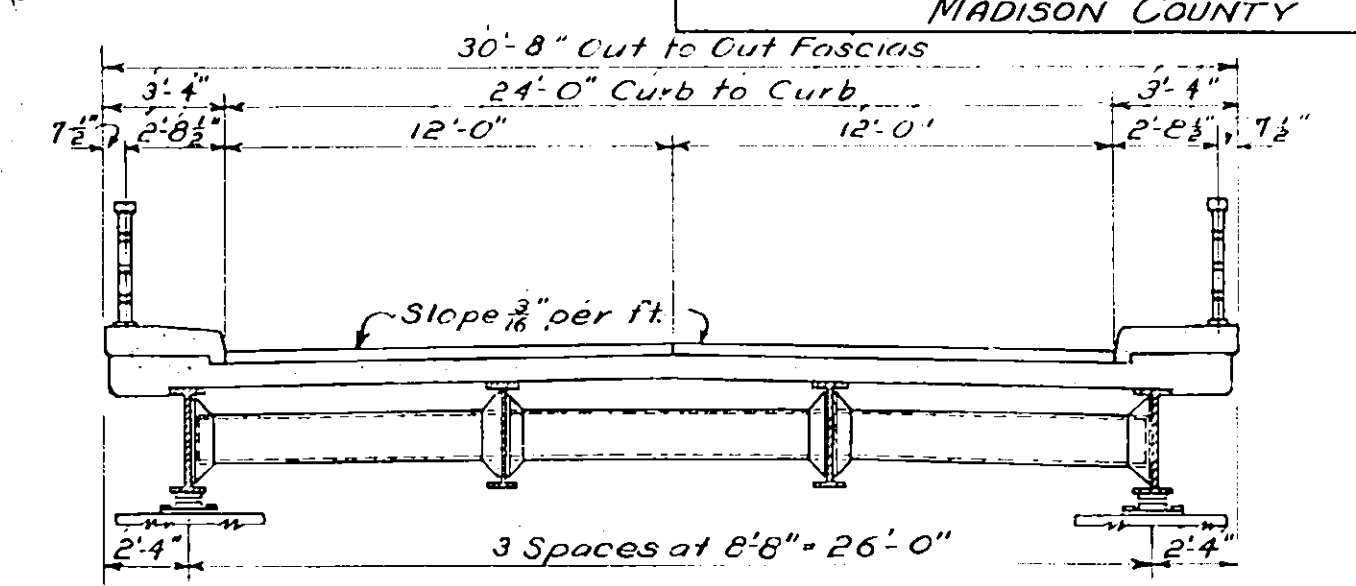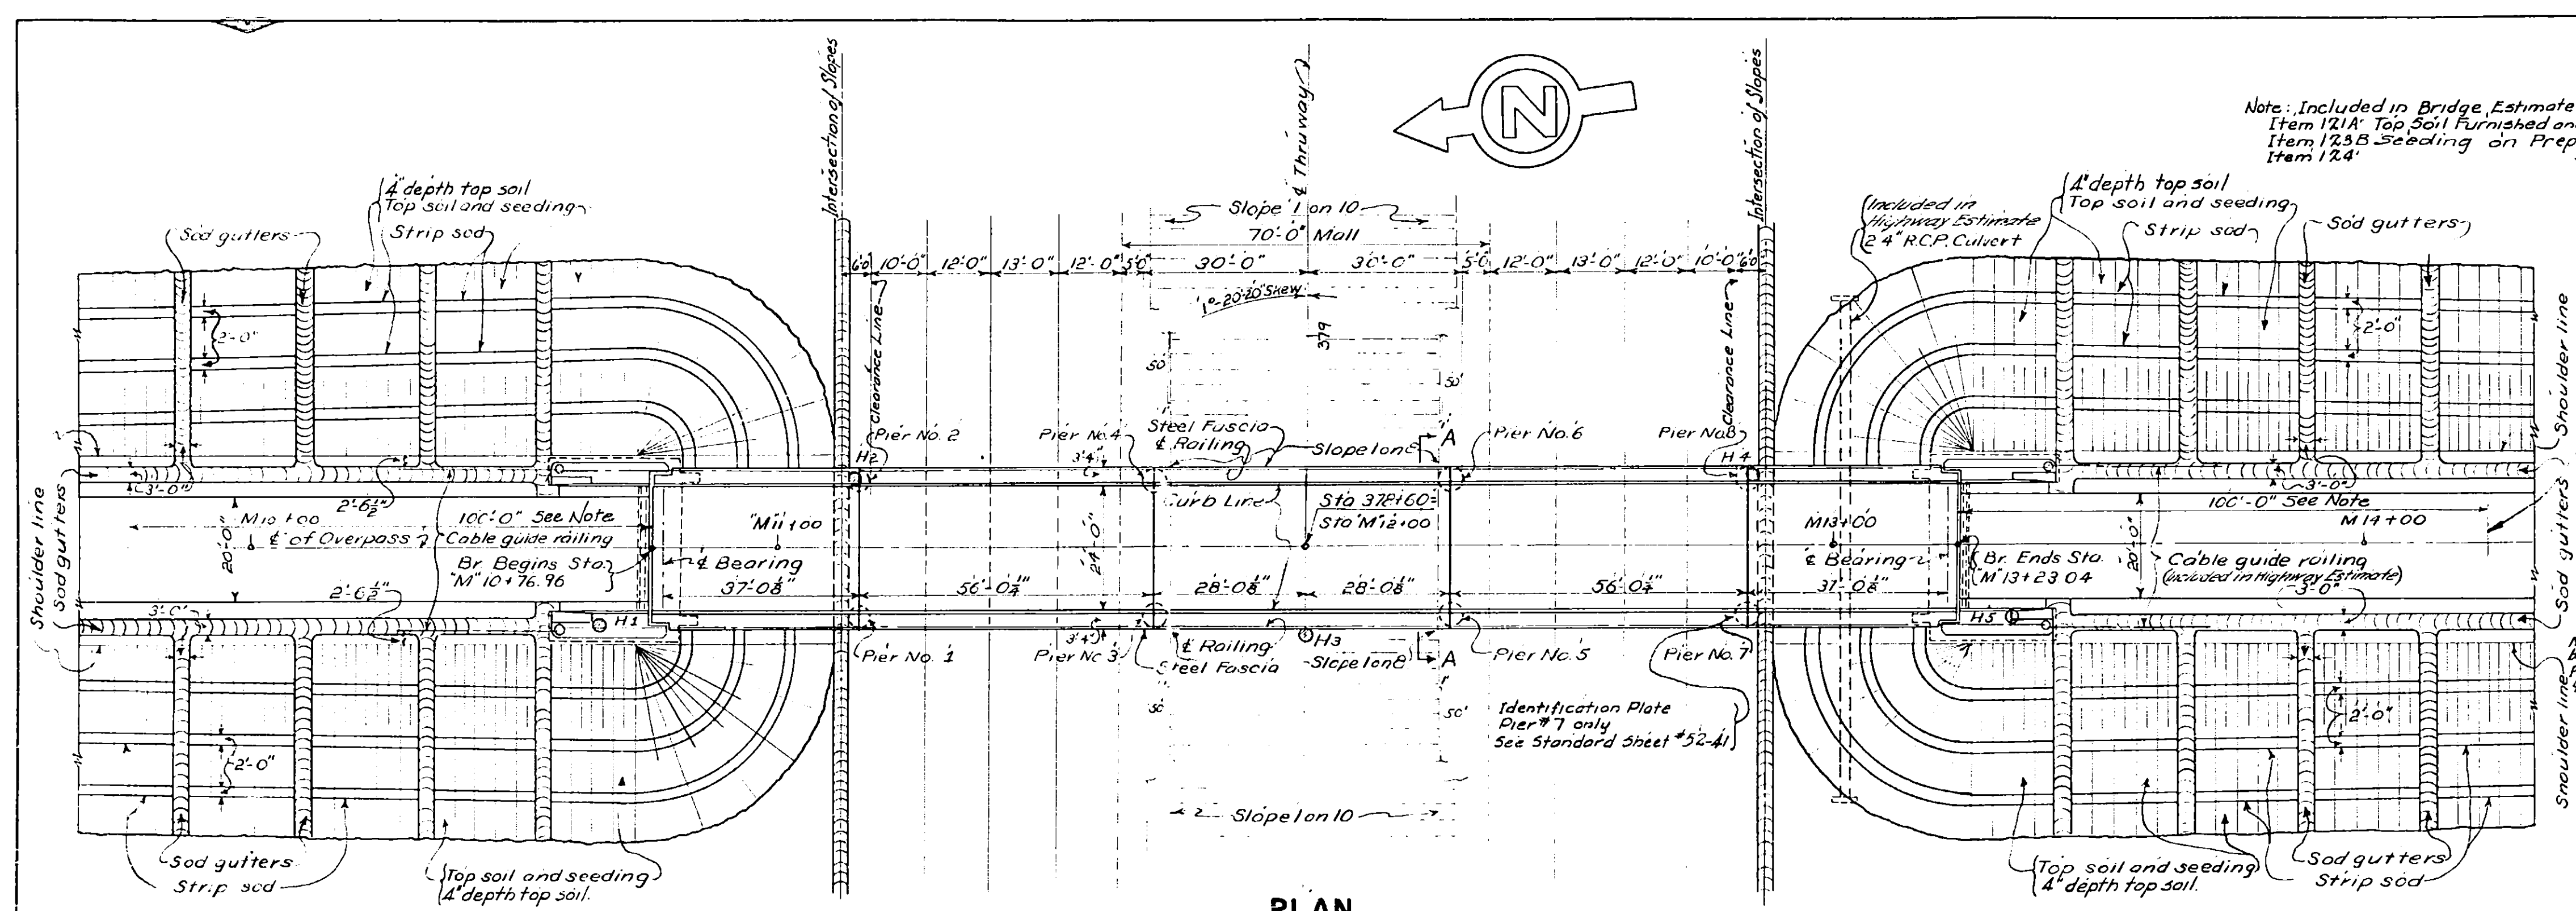


MOHAWK THRUWAY	
FROM	TO
MADISON COUNTY	

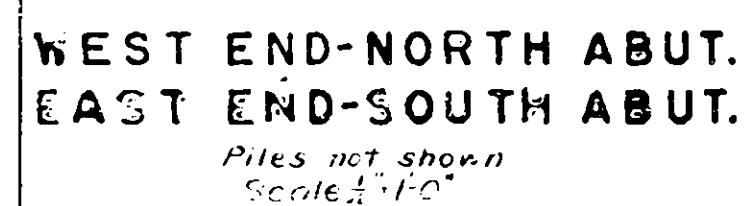
NOTES (CONTINUED)

The Contractor's attention is directed to the special notes for this structure which appear in the proposal. Particular attention should be given to the Foundation Note, which briefly outlines the anticipated subsurface conditions at the site of the structure and which specifies certain requirements relative to construction.


GEES ROAD BRIDGE
STA. 378+60
ABUTMENTS

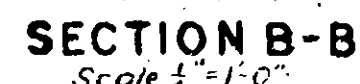


FED. AID DIST. NO.	STATE	FED. AID PROJ. NO.	FISCAL YEAR	SHEET NO.	TOTAL SHEETS
	N.Y.			440	67
MOHAWK THRUWAY					
FROM TO					
MADISON COUNTY					

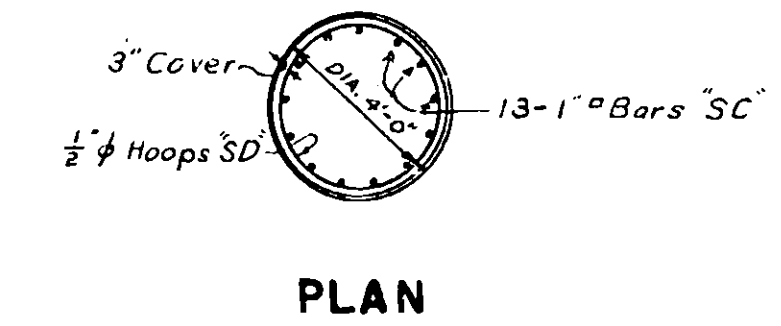


PLAN

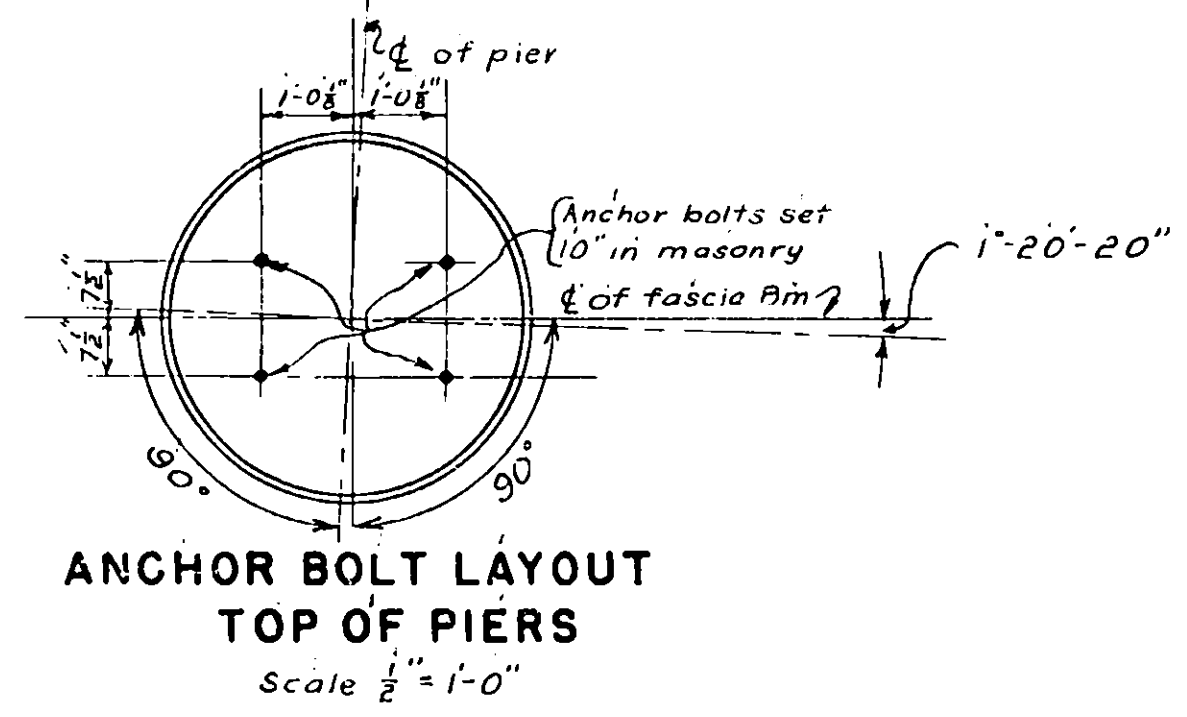


ANCHOR BOLT LAYOUT
TOP OF PIERS

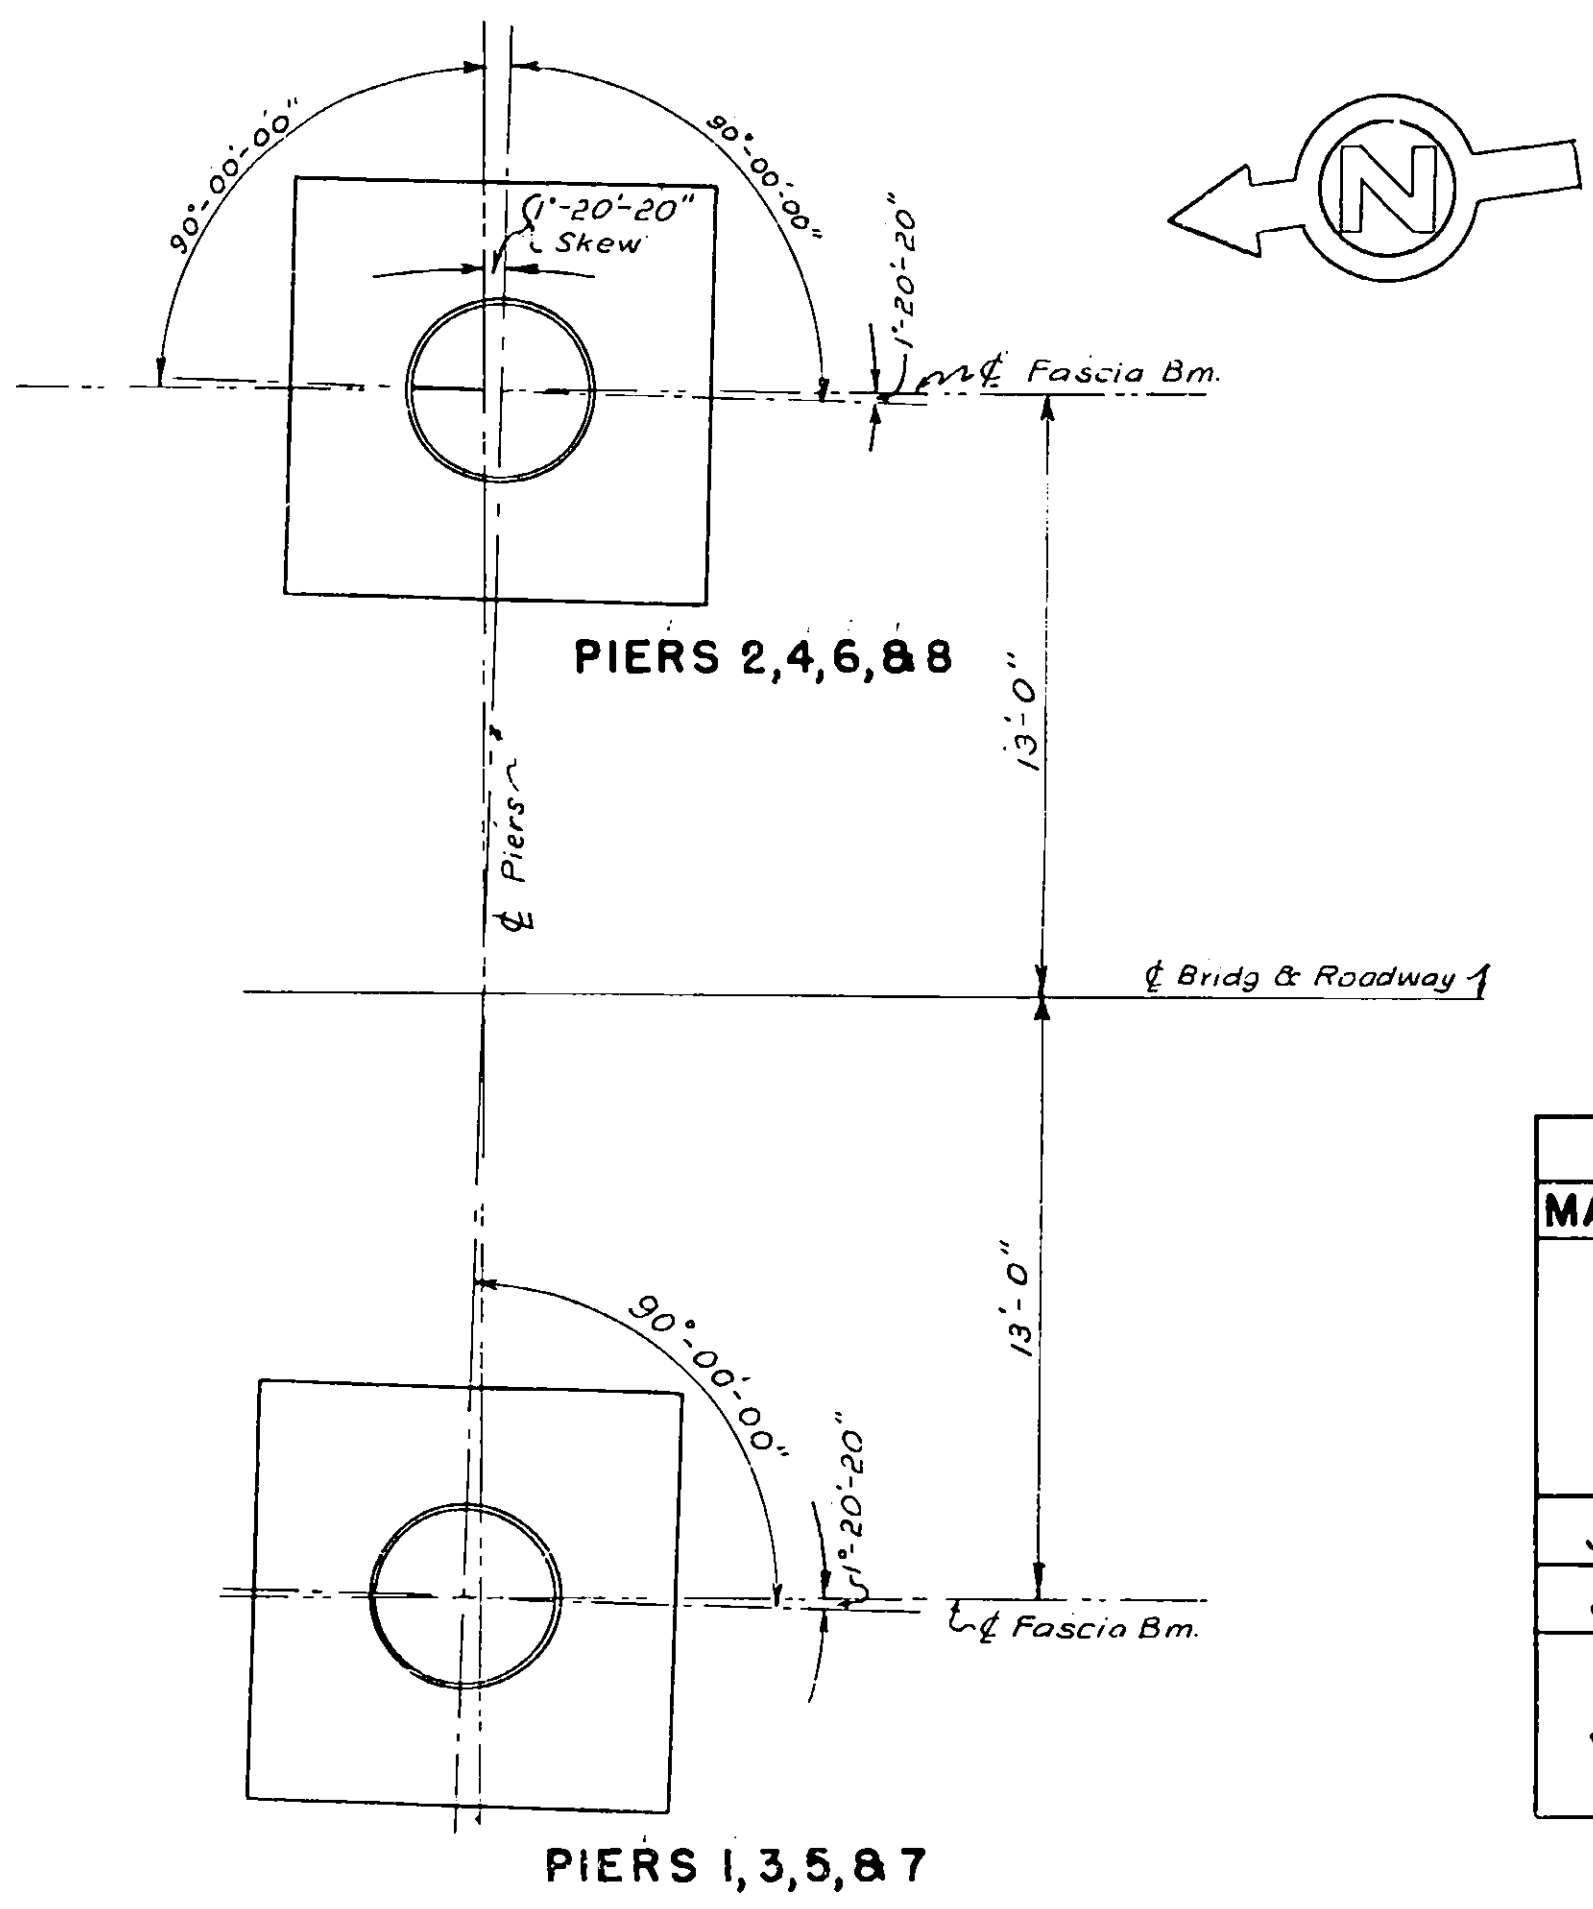

LAYOUT OF PIERS

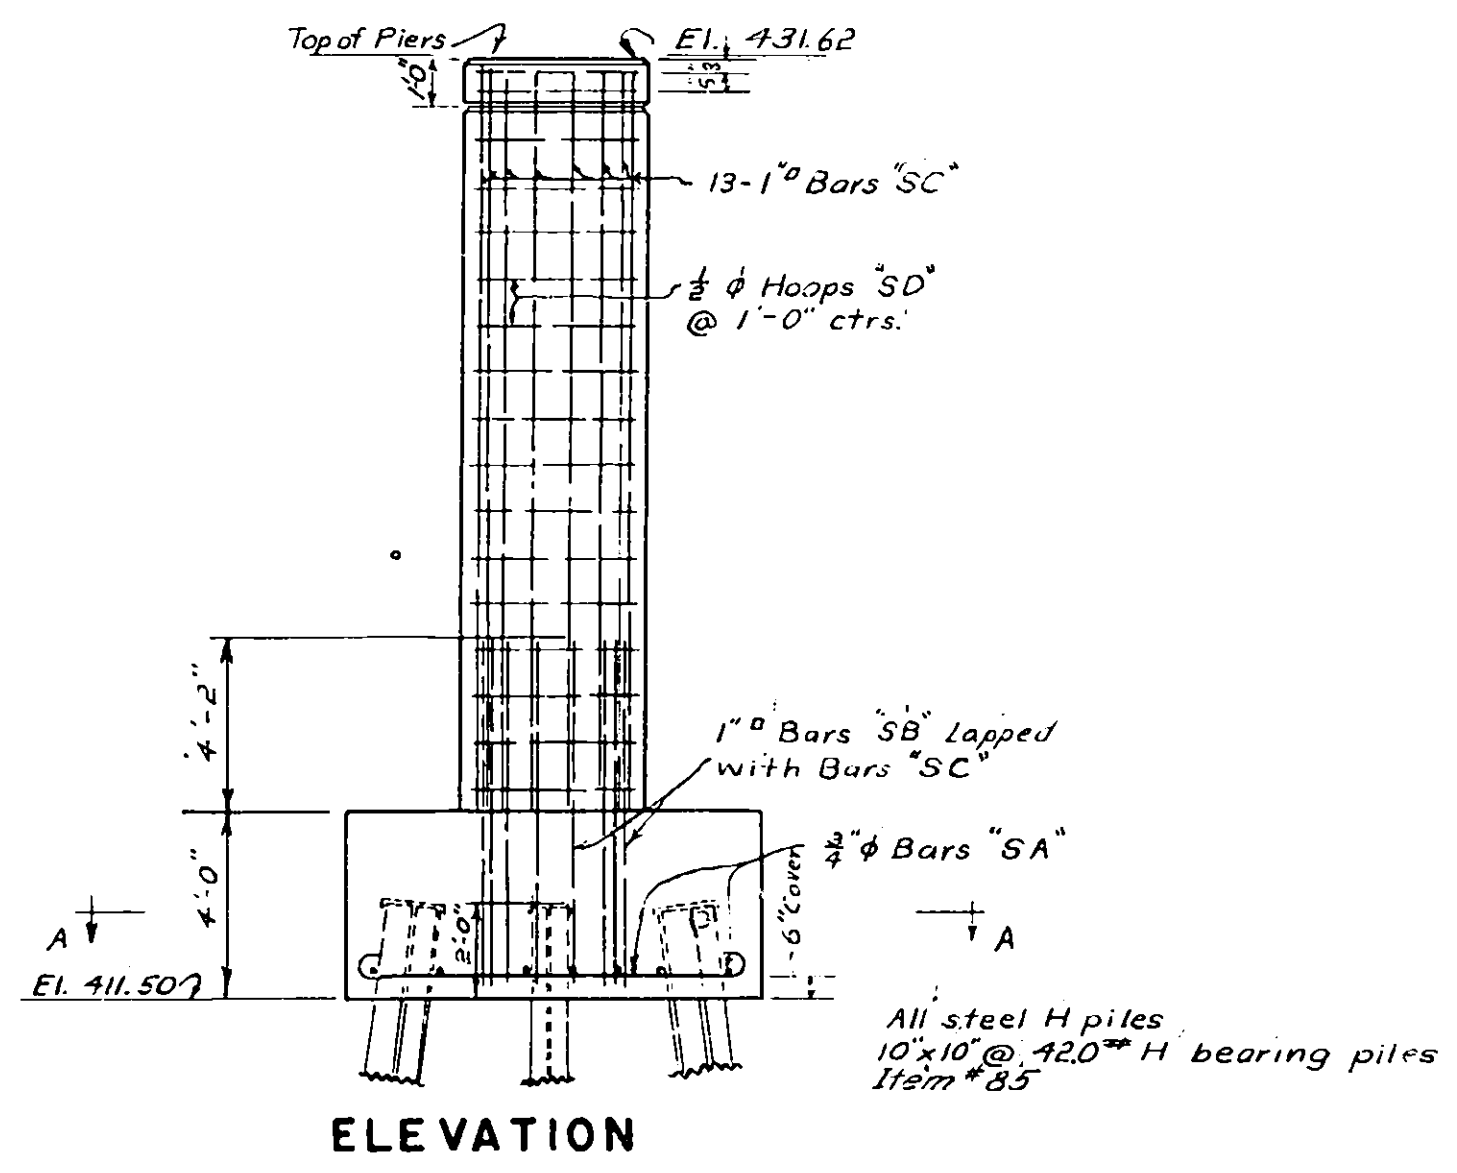


ELEVATION

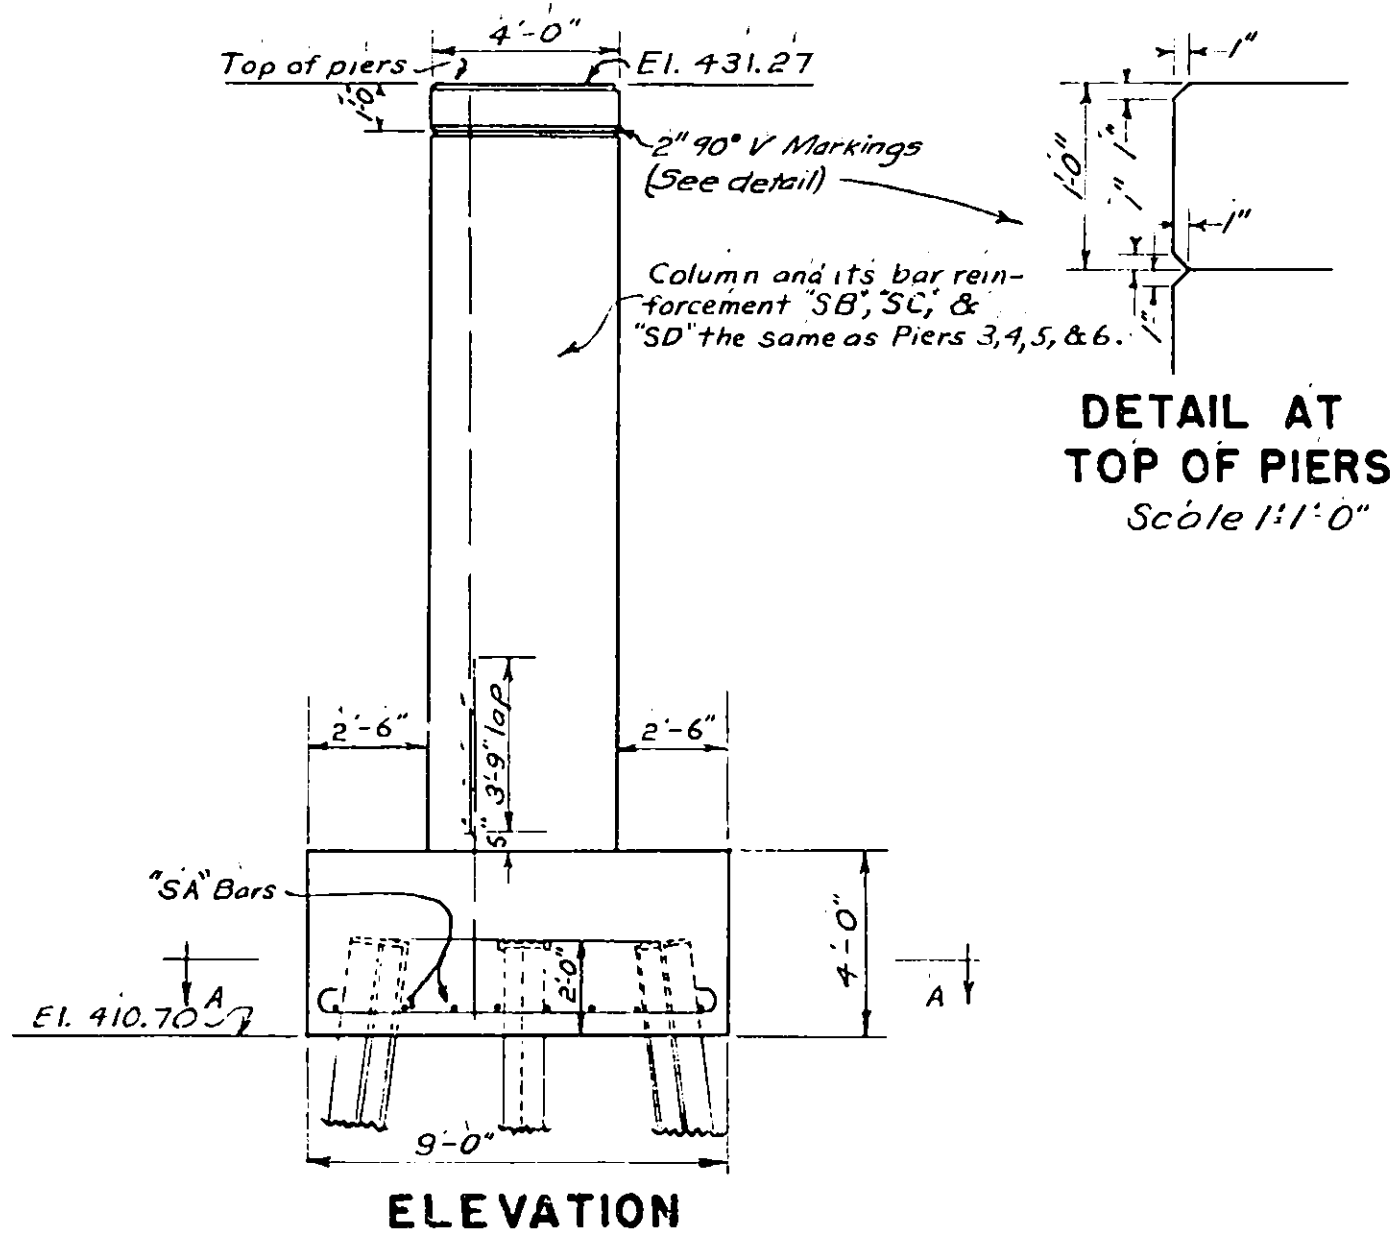


ELEVATION


BAR LIST FOR PIERS				
MARK	SIZE	NO.	LENGTH	LOCATION & DESCRIPTION
SA	3/4"	128	10'-0"	Hooked bars in bottom of footing at all piers.
SB	1"	104	7'-11"	Straight vertical dowels in bottom of columns and in footings of all piers.
SC	1"	104	16'-0"	Straight vertical bars in columns of all piers.
SD	1/2"	136	11'-6"	Hoops in columns of all piers.

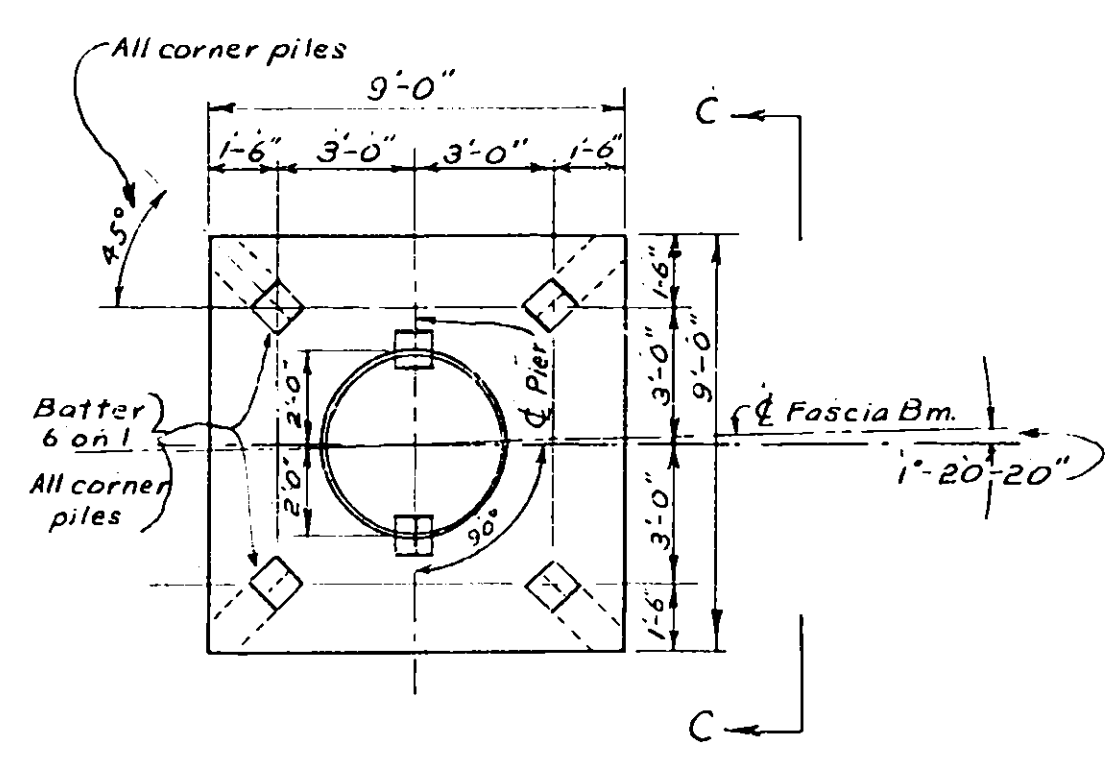


PILE PLAN (BARS NOT SHOWN)

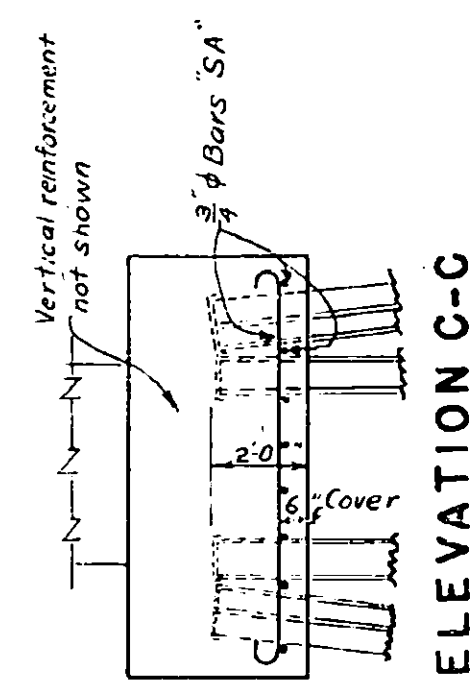

ELEVATION C-C

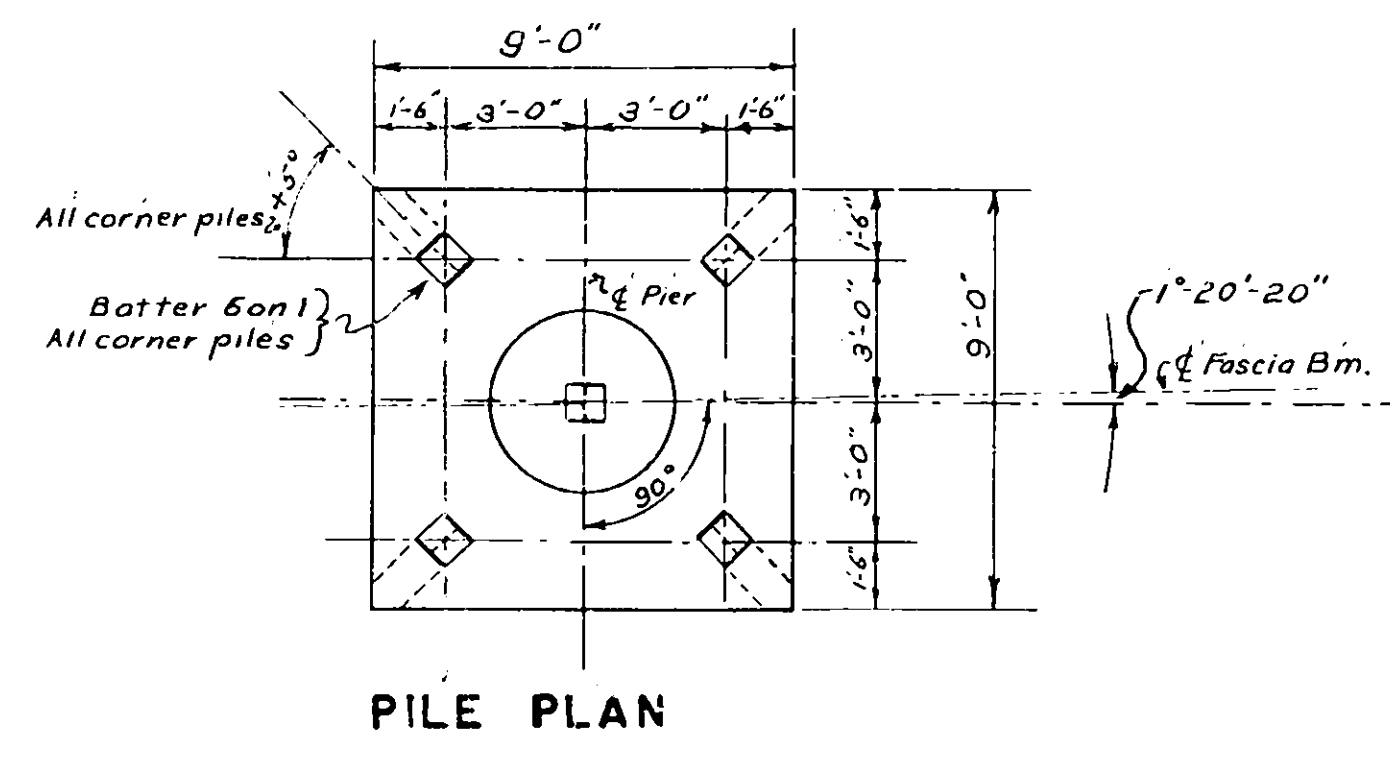


PILE PLAN

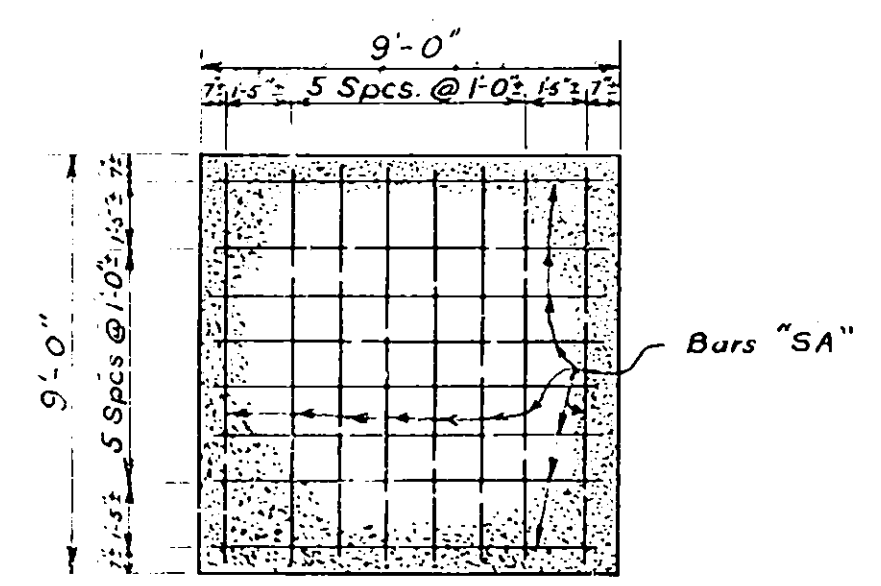


SECTION A-A (PILES NOT SHOWN) SAME FOR ALL PIERS

DETAILS OF PIERS NO'S 1, 2, 7, 8
Scale 1/4" = 1'-0"

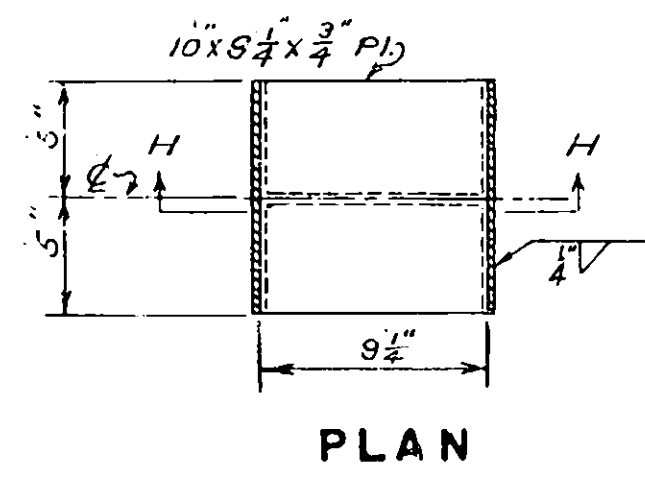

PLAN

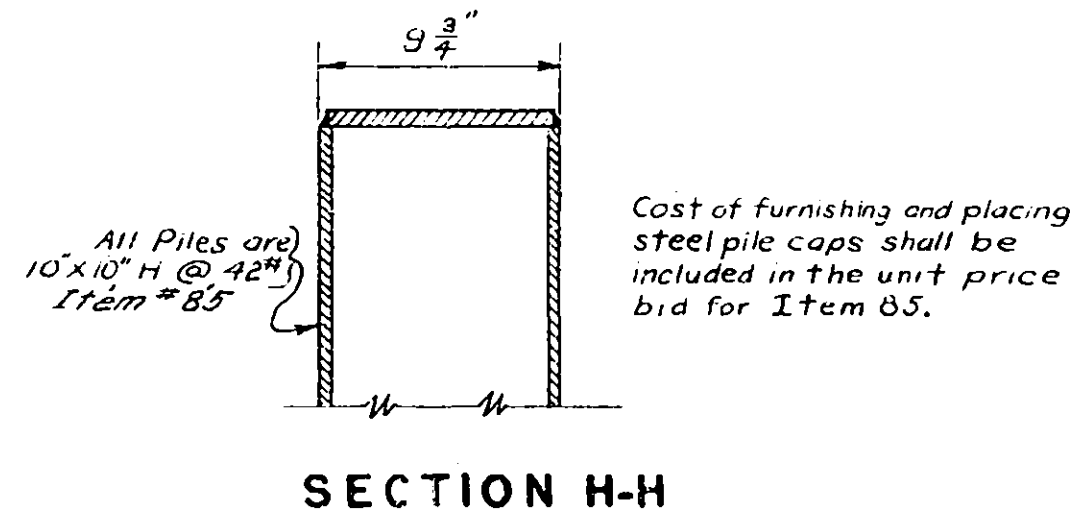

SECTION H-H

DETAIL OF PILE CAP
Scale 1 1/2" = 1'-0"


DETAILS OF PIERS NO'S 3, 4, 5, 6
Scale 1/4" = 1'-0"

24 May 1950
J. C. Valligan May 1948
J. C. Valligan
1/3/50


GEES ROAD BRIDGE
STA. 378+60
PIERS

FED AID DIST NO.	STATE	FED. AID PROJ. NO.	FISCAL YEAR	SHEET NO.	TOTAL SHEET.
	N.Y.			44	67
MOHAWK THRUWAY					
FROM			TO		
MADISON COUNTY					


Horizontal Distance
Spacing of Rolling Posts:

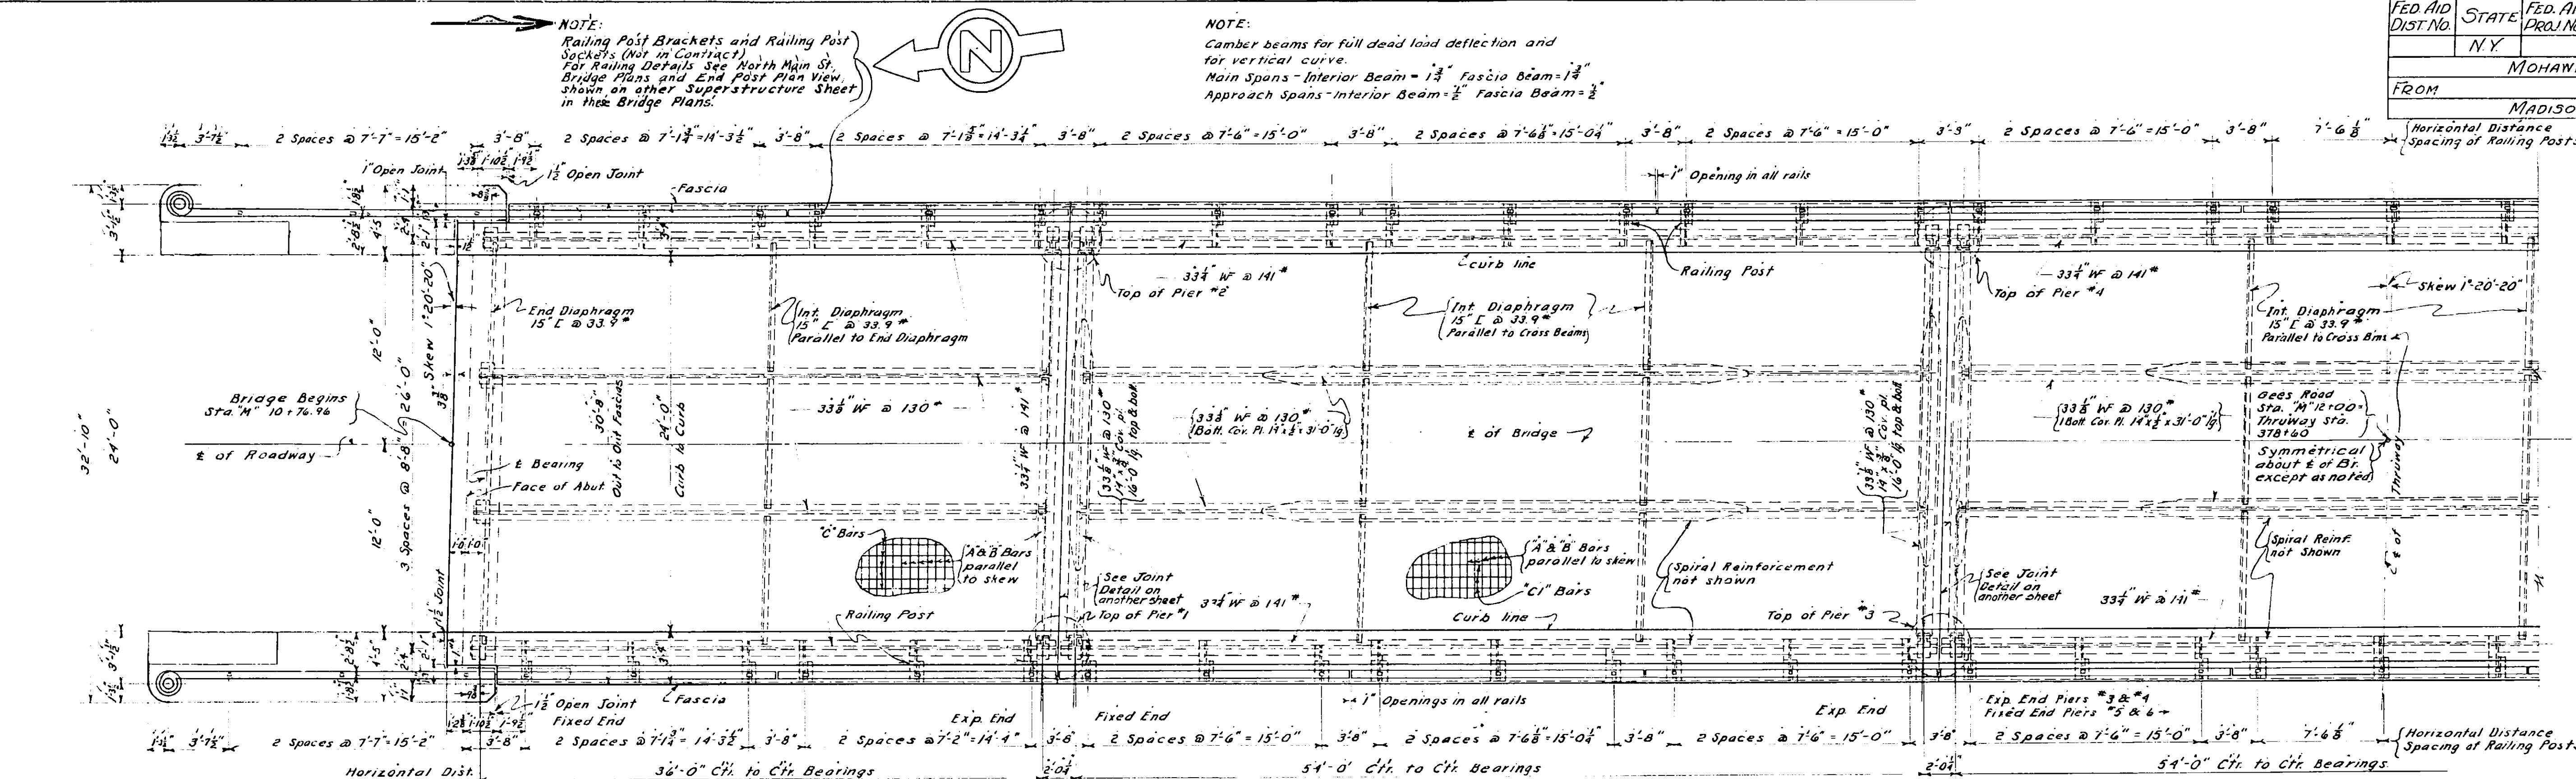


PLAN
SCALE: 3/16" = 1' - 0"

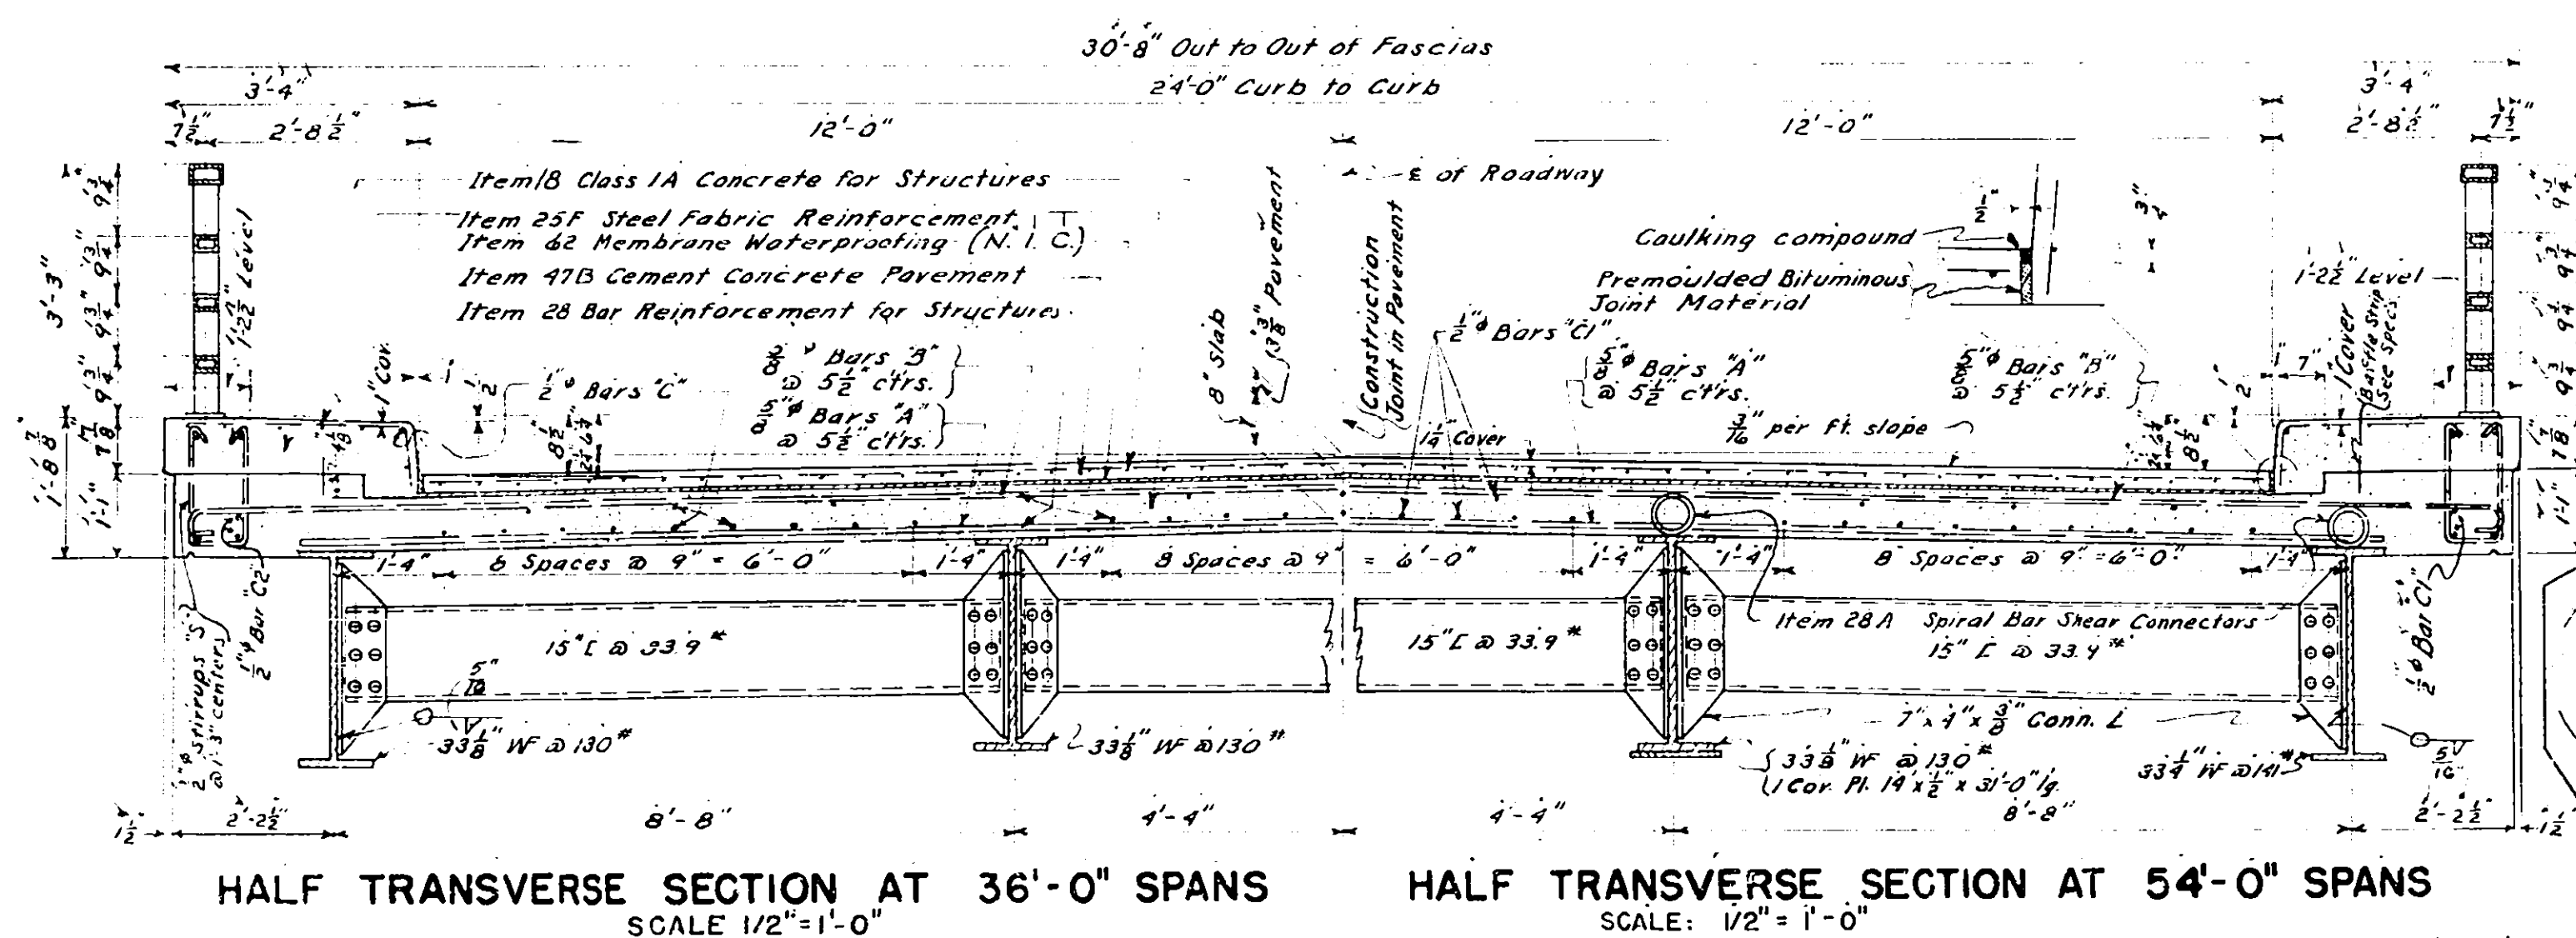

HALF TRANSVERSE SECTION AT 54'-0" SPANS
SCALE: 1/2" = 1'-0"

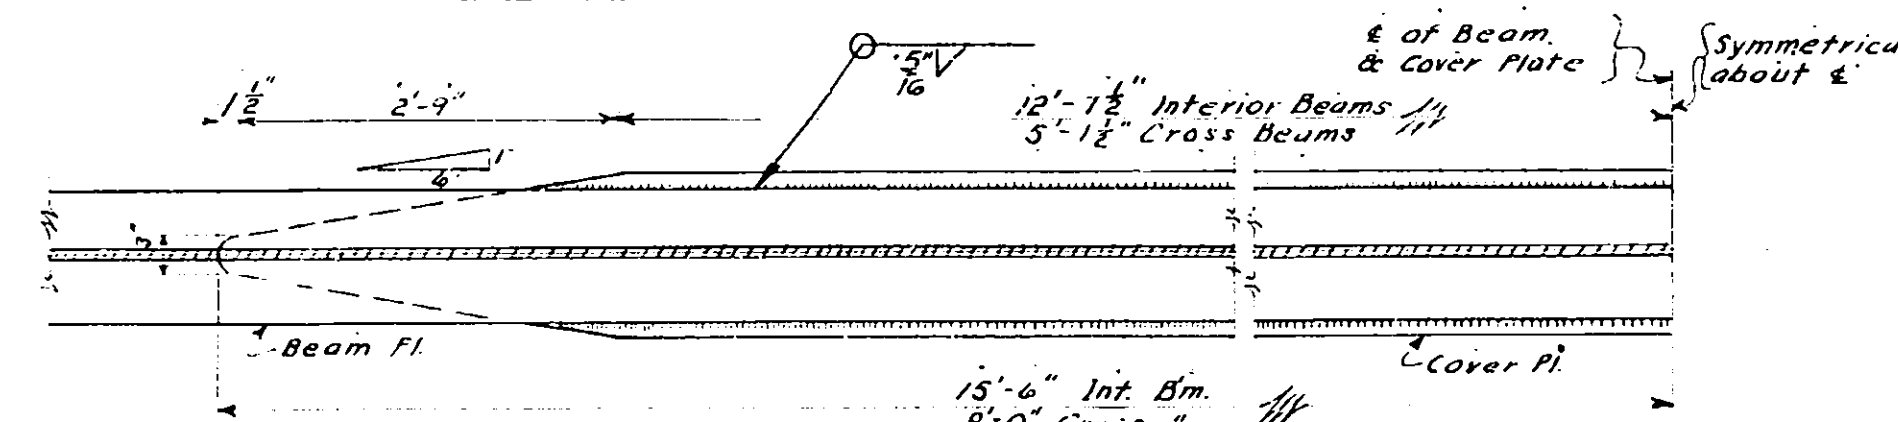

DETAILS OF BOTTOM COVER PLATE ON INTERIOR BEAMS
AND TOP AND BOTTOM COVER PLATES ON CROSS BEAMS
FOR 54'-0" SPANS
SCALE: 3/4"=1'-0"

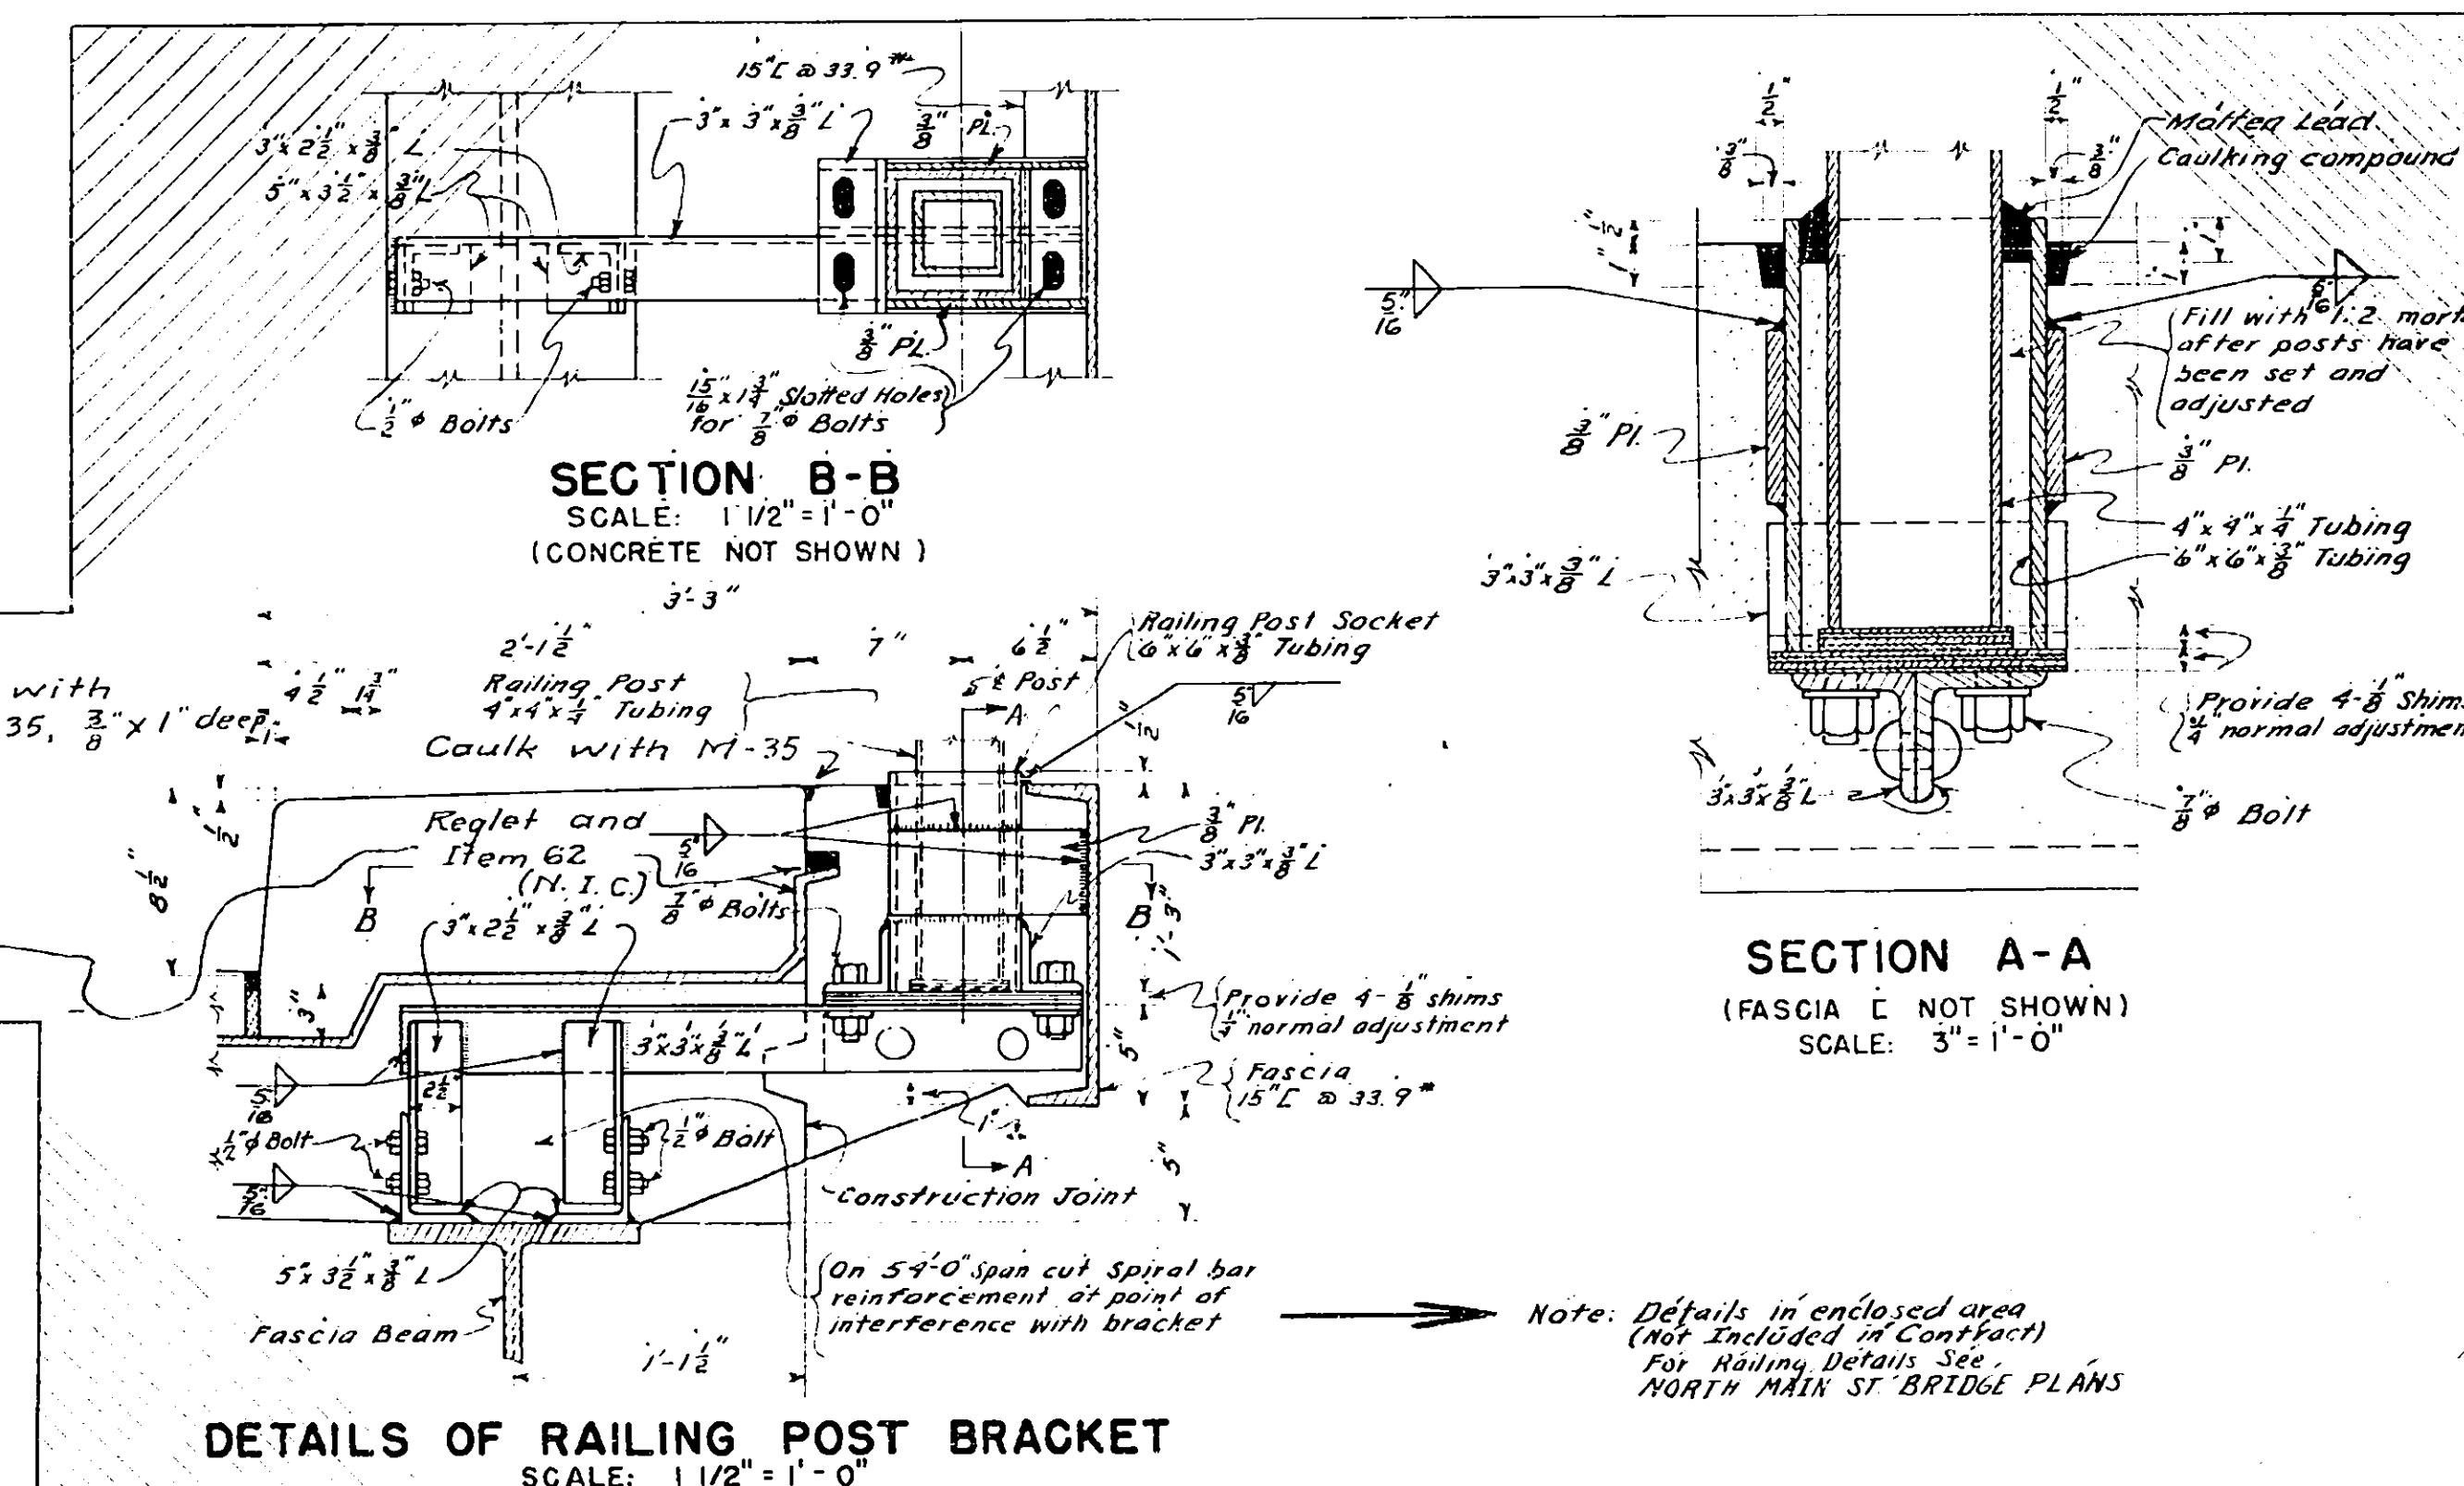


DETAILS OF RAILING POST BRACKET
SCALE: 1 1/2" = 1' - 0"

Note: Details in enclosed area
(Not Included in Contract)
For Railing Details See
NORTH MAIN ST. BRIDGE PLAN


GEES ROAD BRIDGE
STA. 378+60
SUPERSTRUCTURE

J. M. Stieve 1-31-50
 J. C. Sullivan May '48
 A. F. Blumenthal
 J. J. Maci
 M. J. Delaney


FED AID DIST NO	STATE	FED AID PROJ NO	FISCAL YEAR	SHEET NO	TOTAL SHEETS
	N.Y.			62	67
FROM TO					
MOHAWK THRUWAY					
MADISON COUNTY					

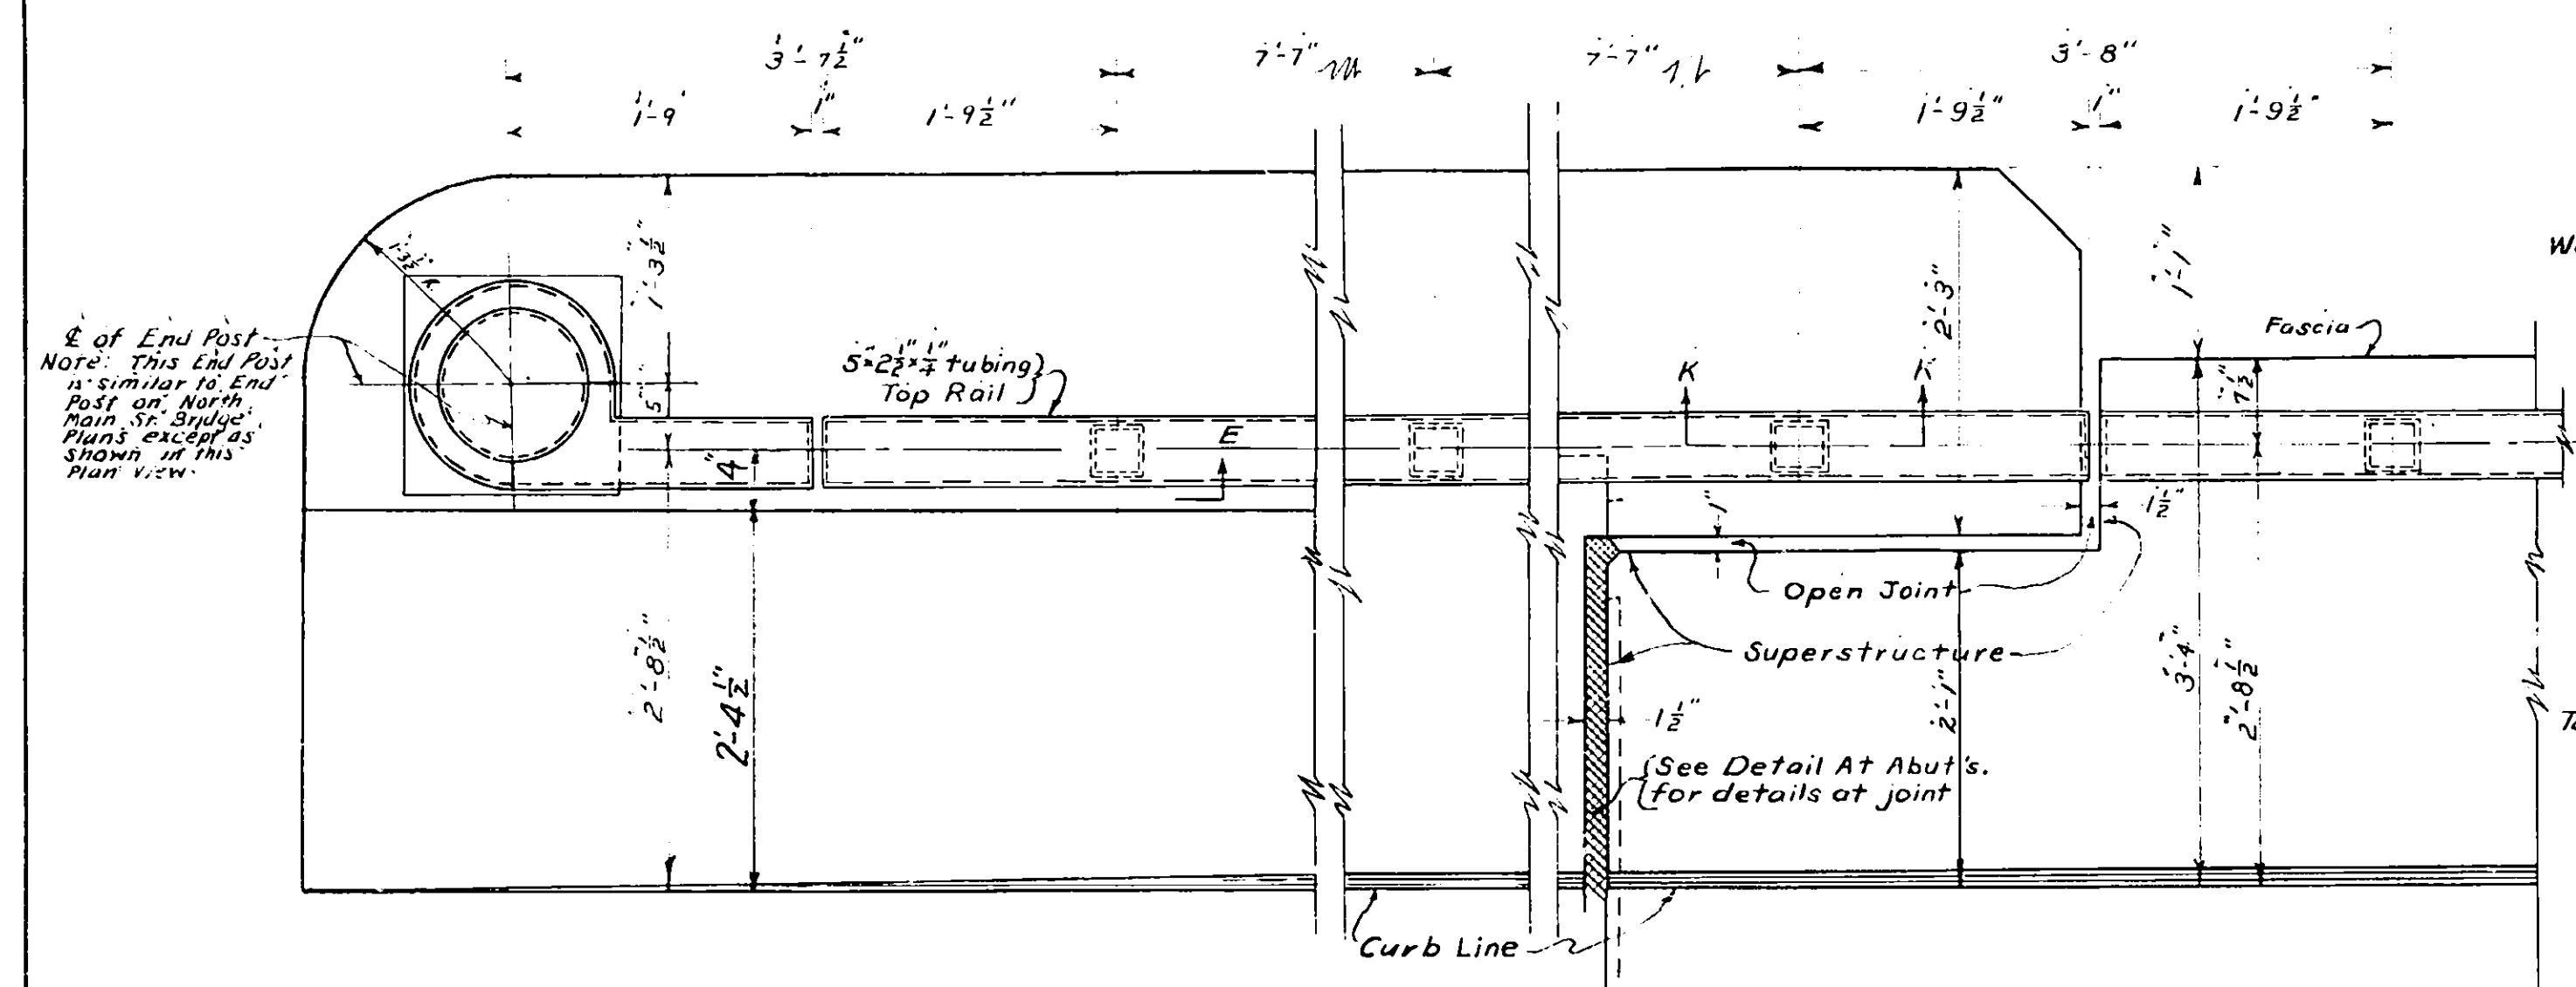


PLAN SHOWING SIDEWALK RAILING AT ABUTMENTS

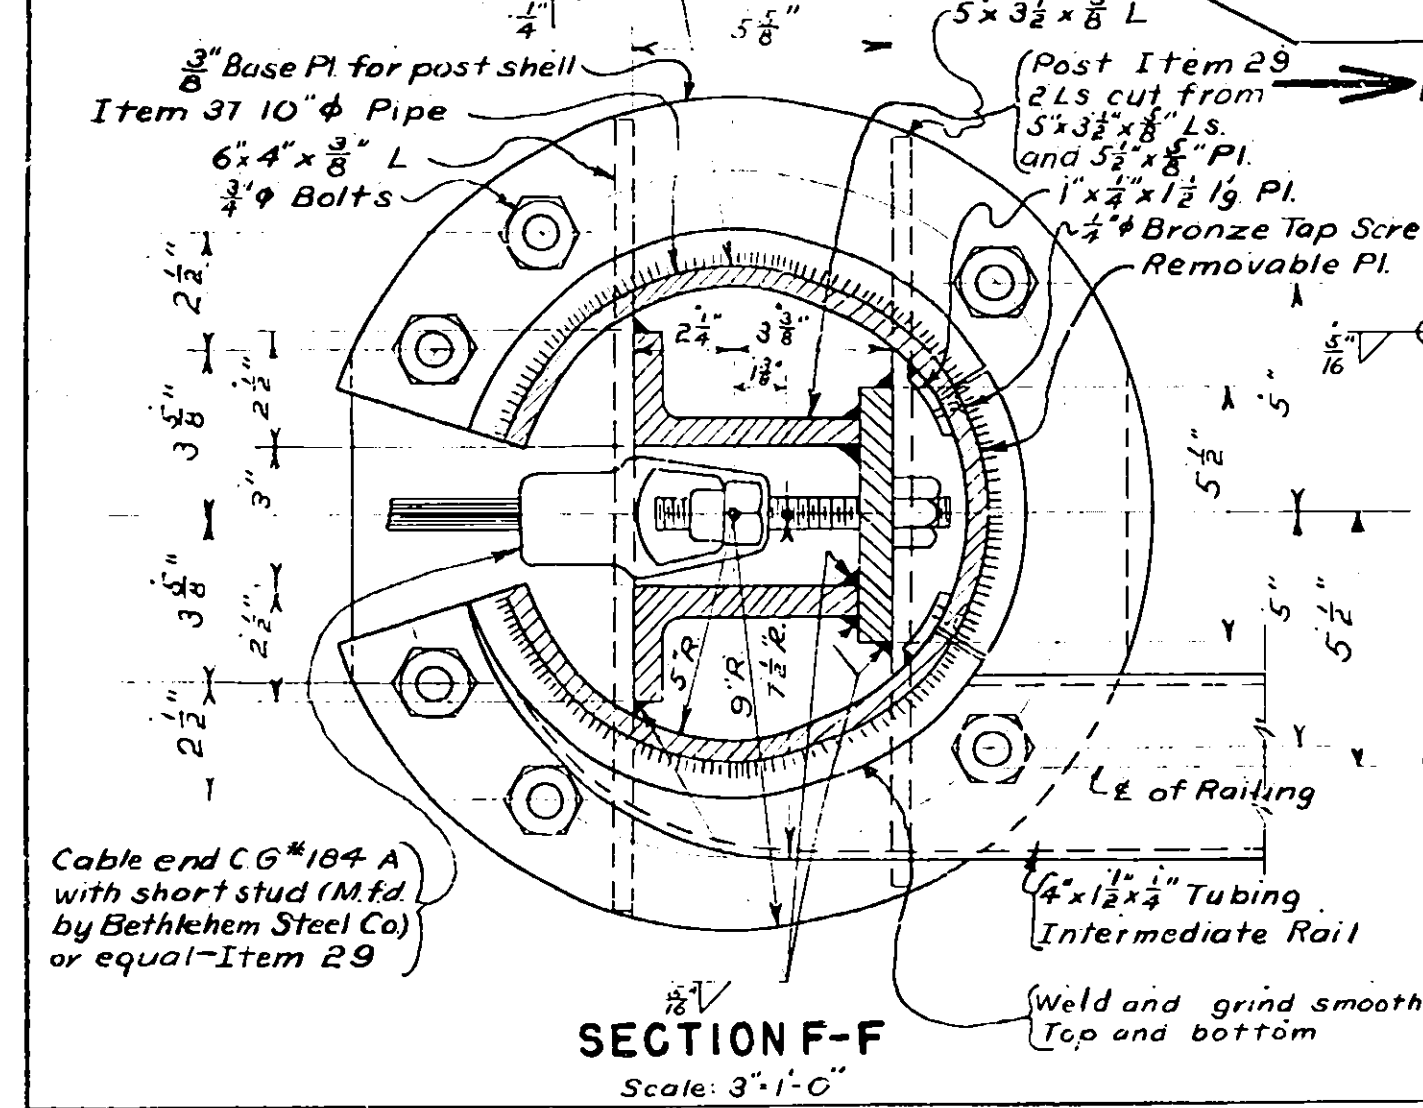


SECTION F-F

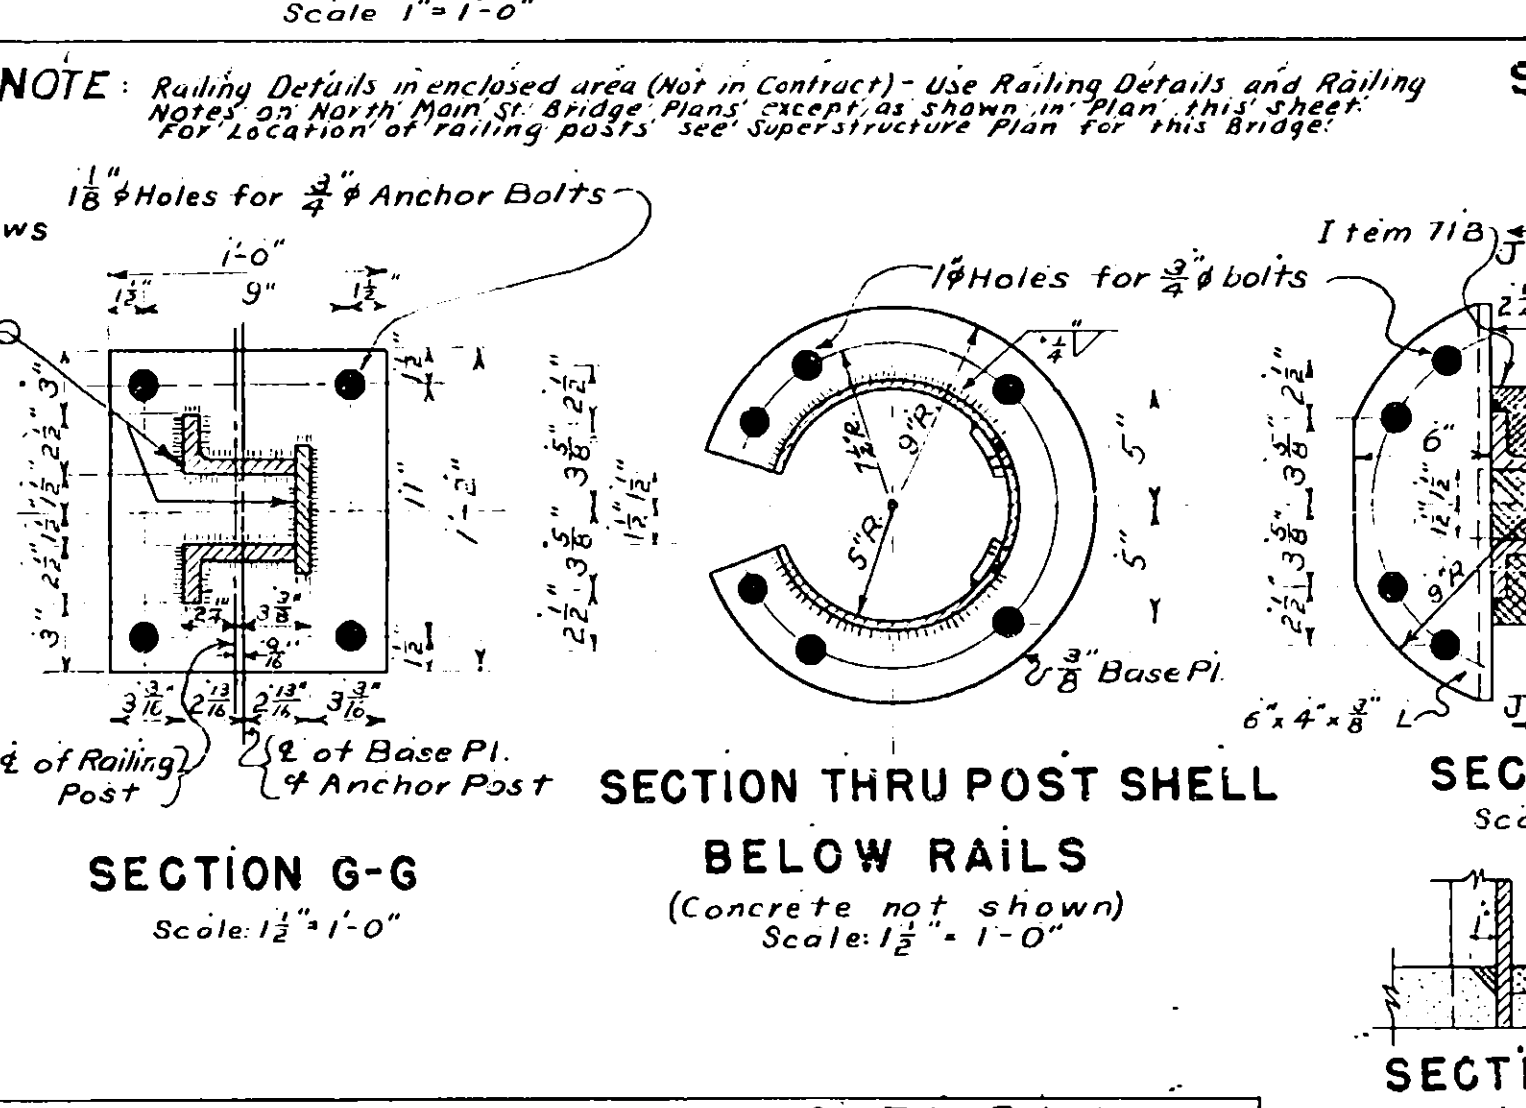


SECTION G-G

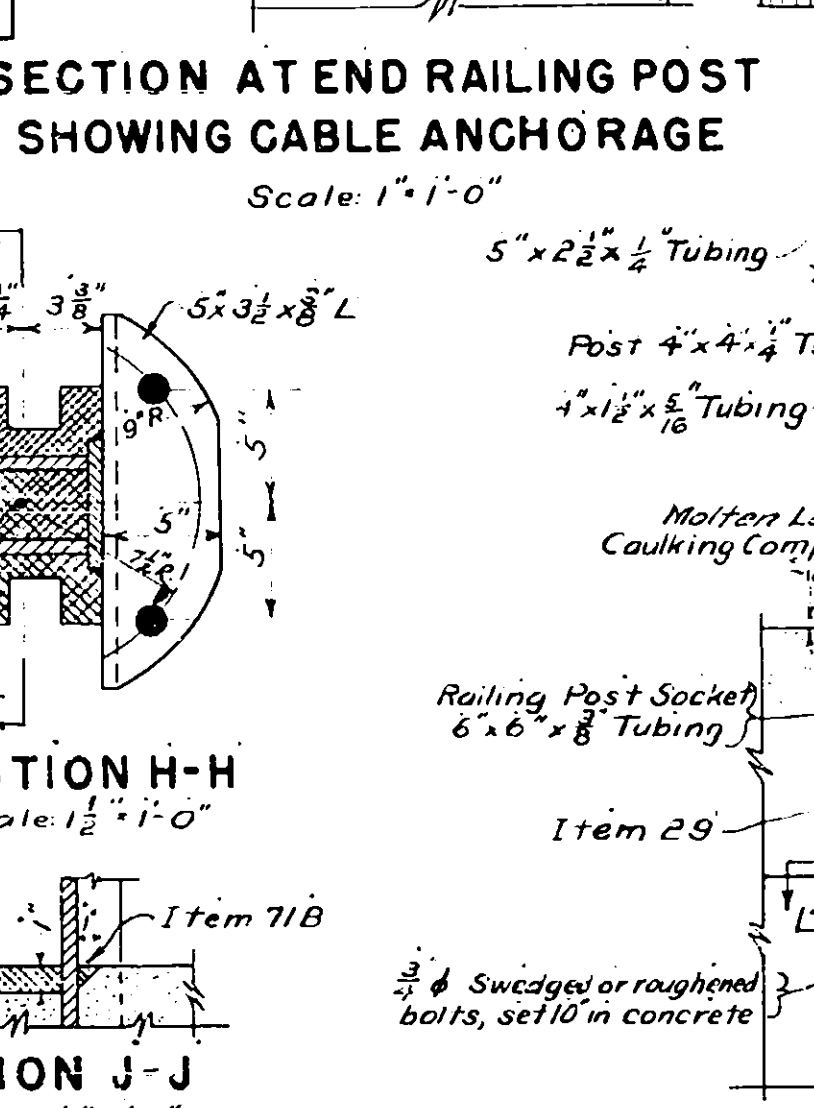


SECTION H-H

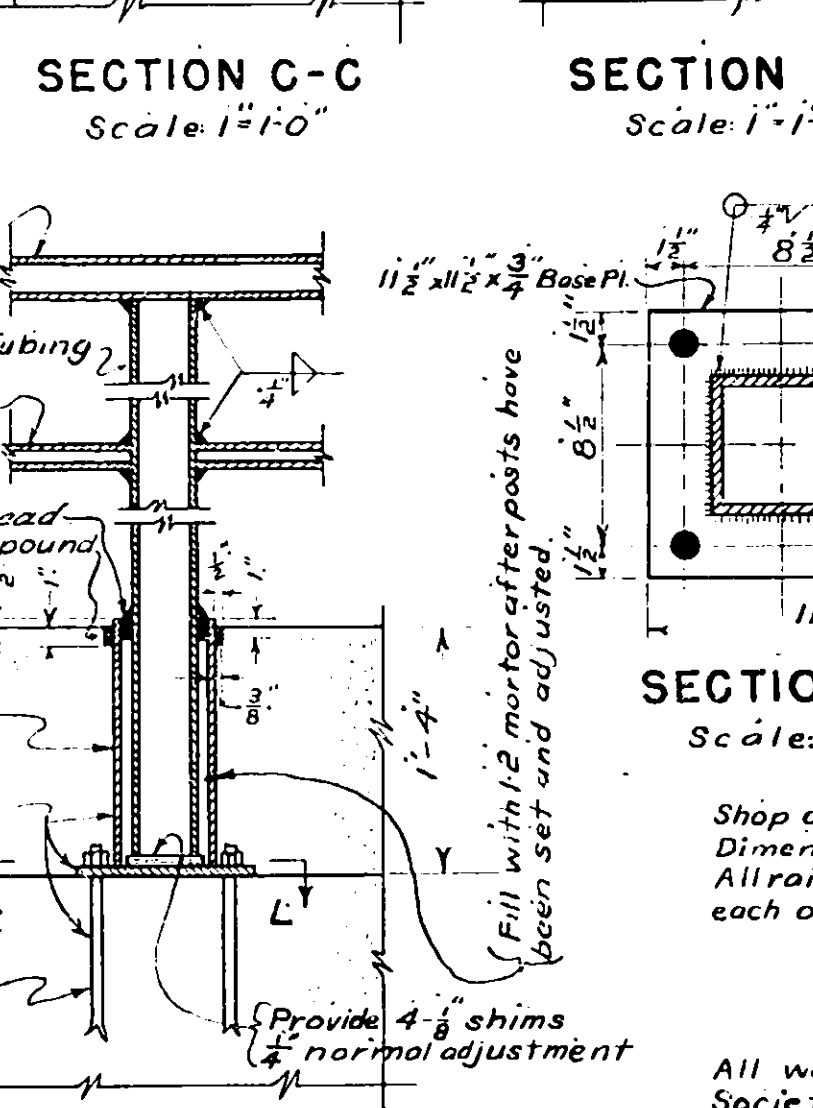


SECTION I-I

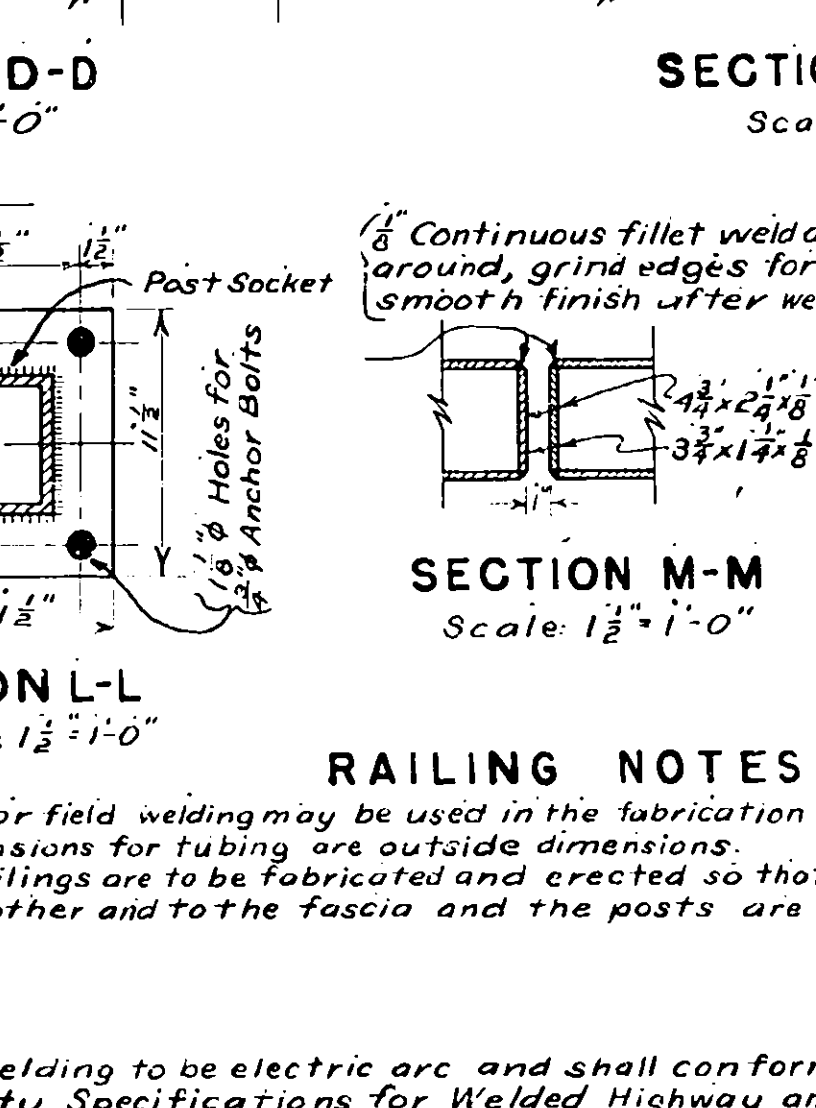


SECTION J-J

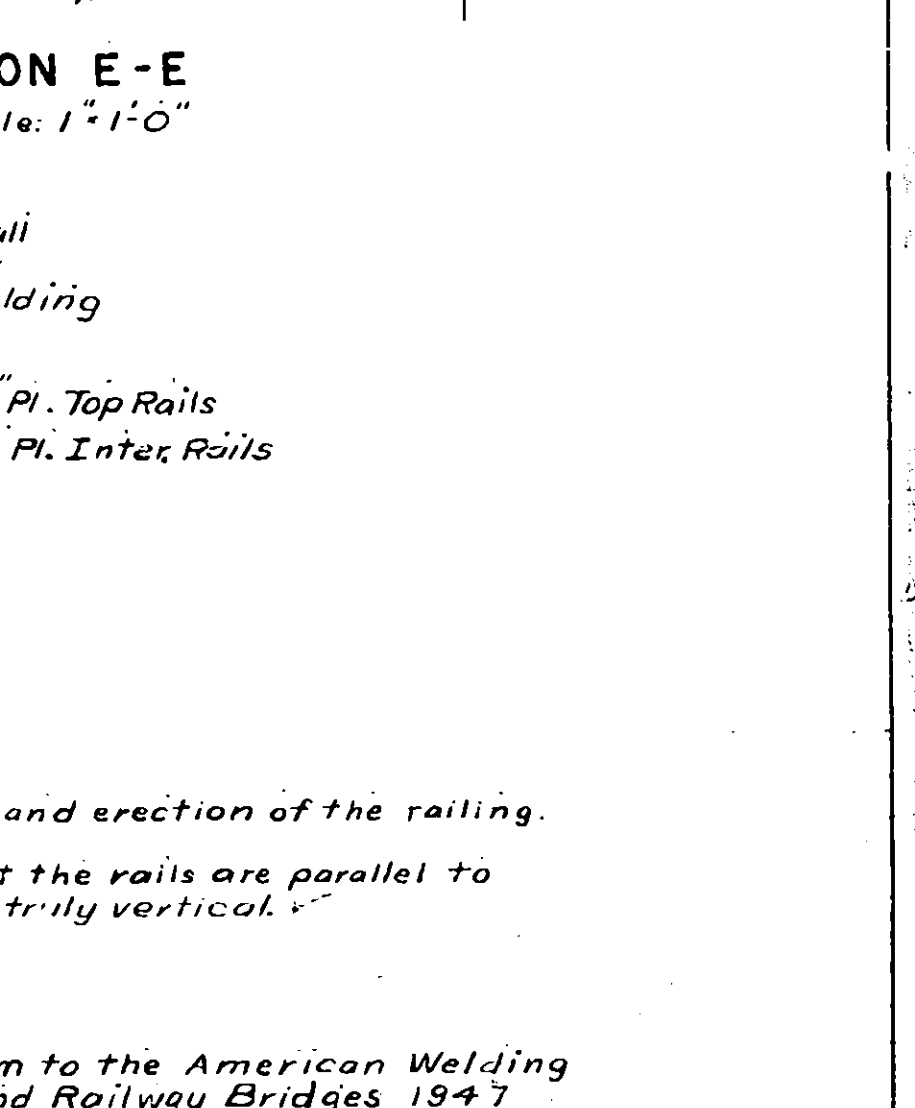


SECTION K-K

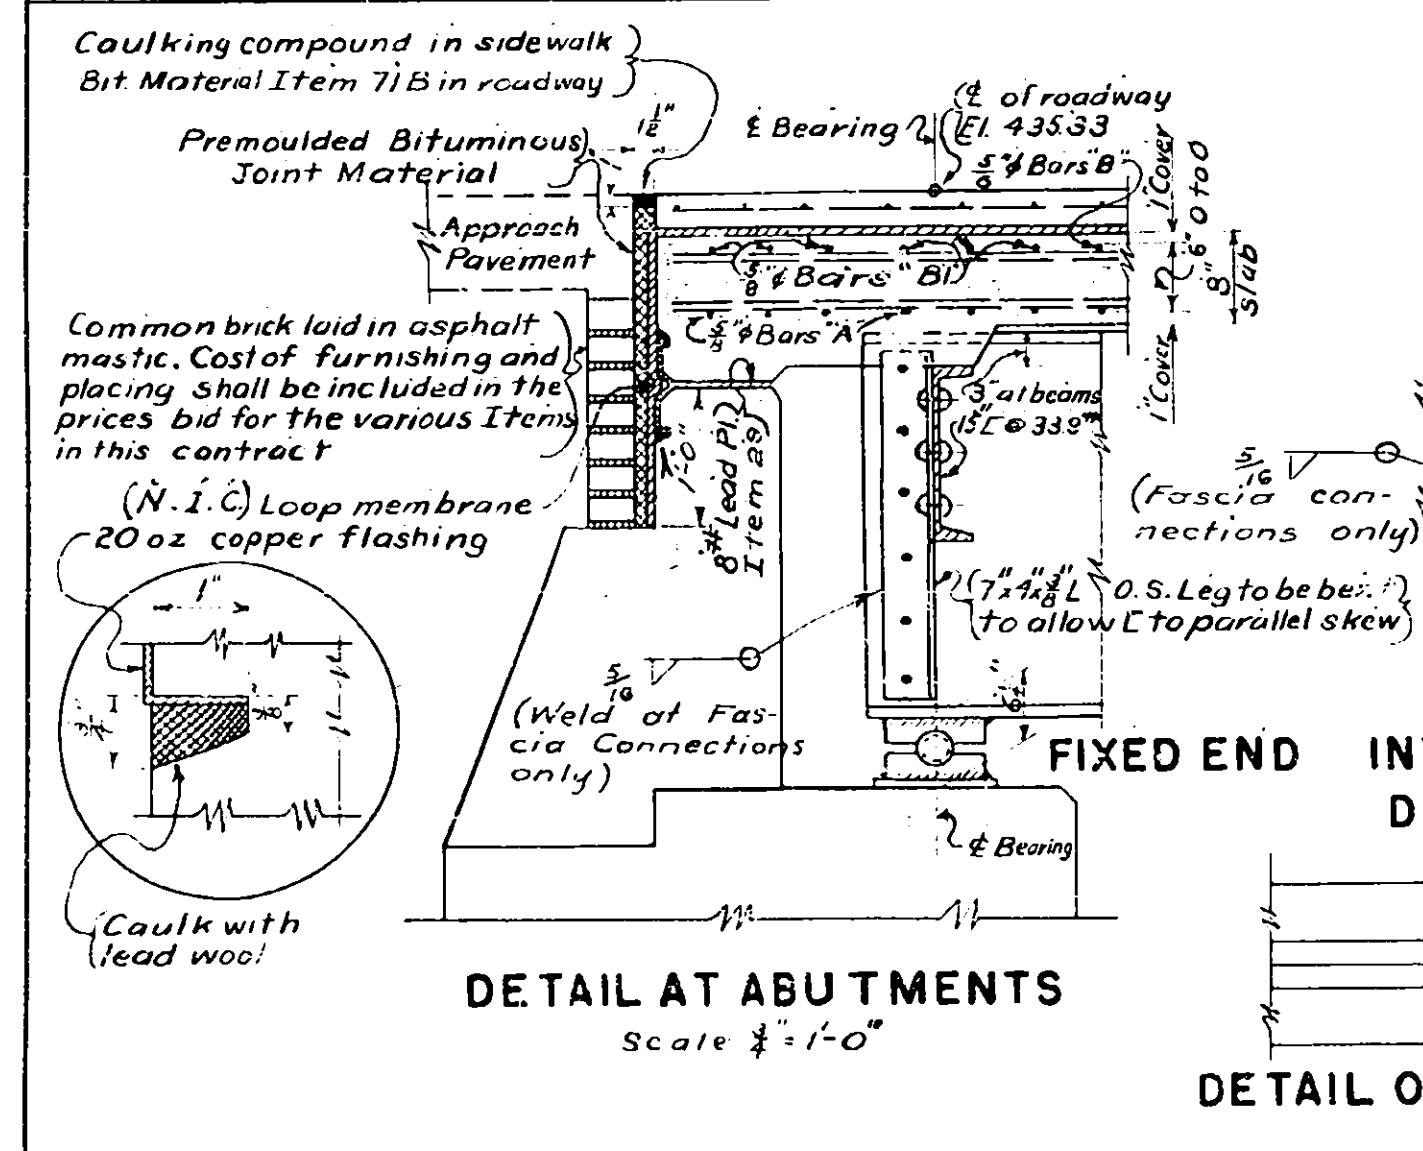


DETAIL AT ABUTMENTS

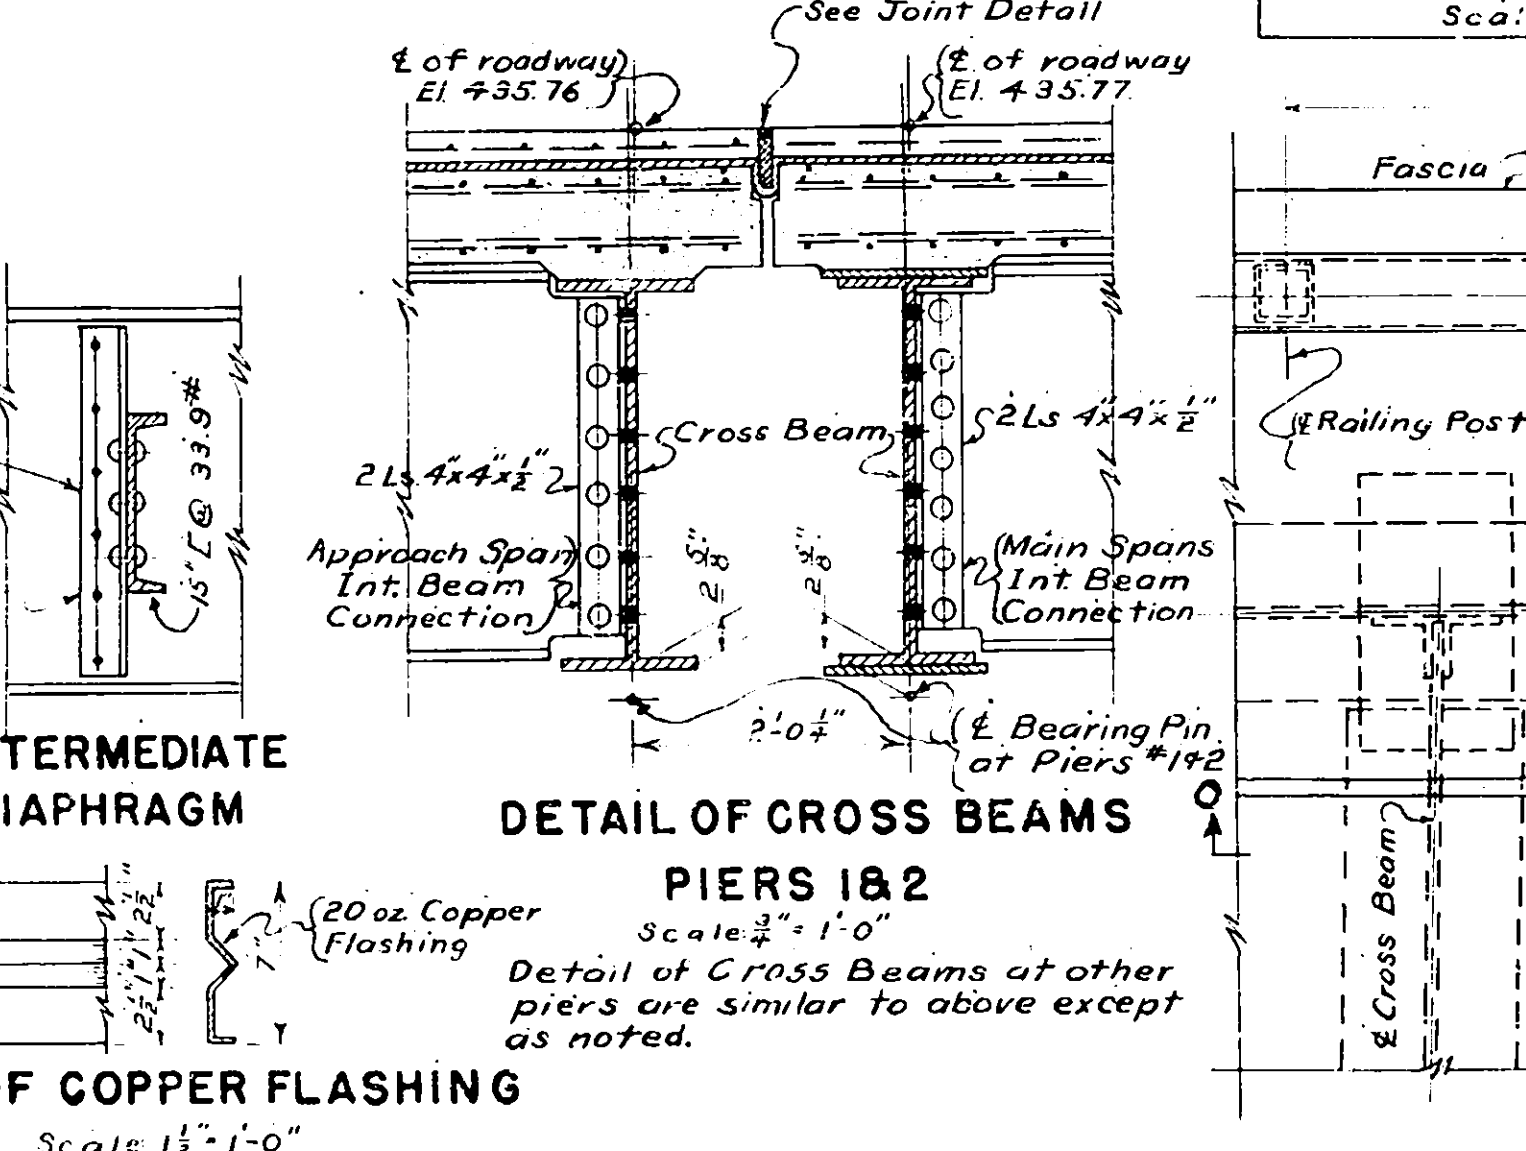


DETAIL OF CROSS BEAMS

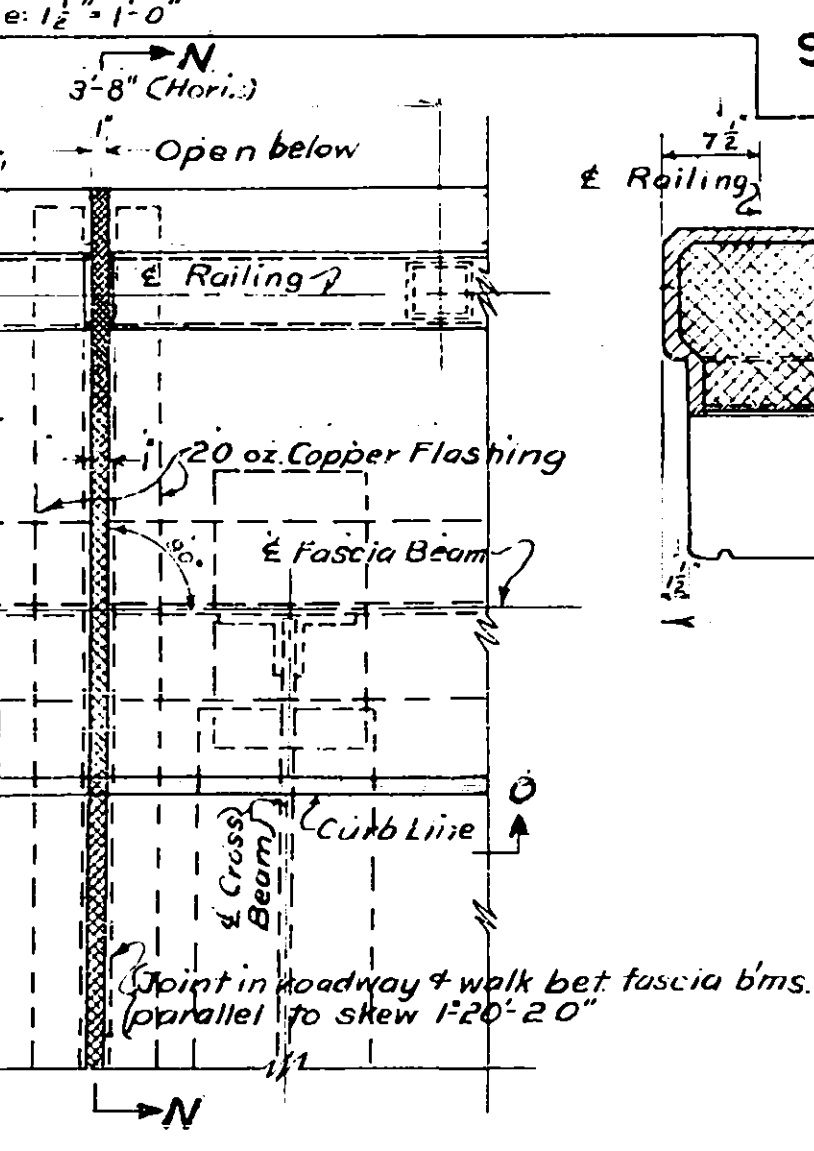


DETAIL OF COPPER FLASHING

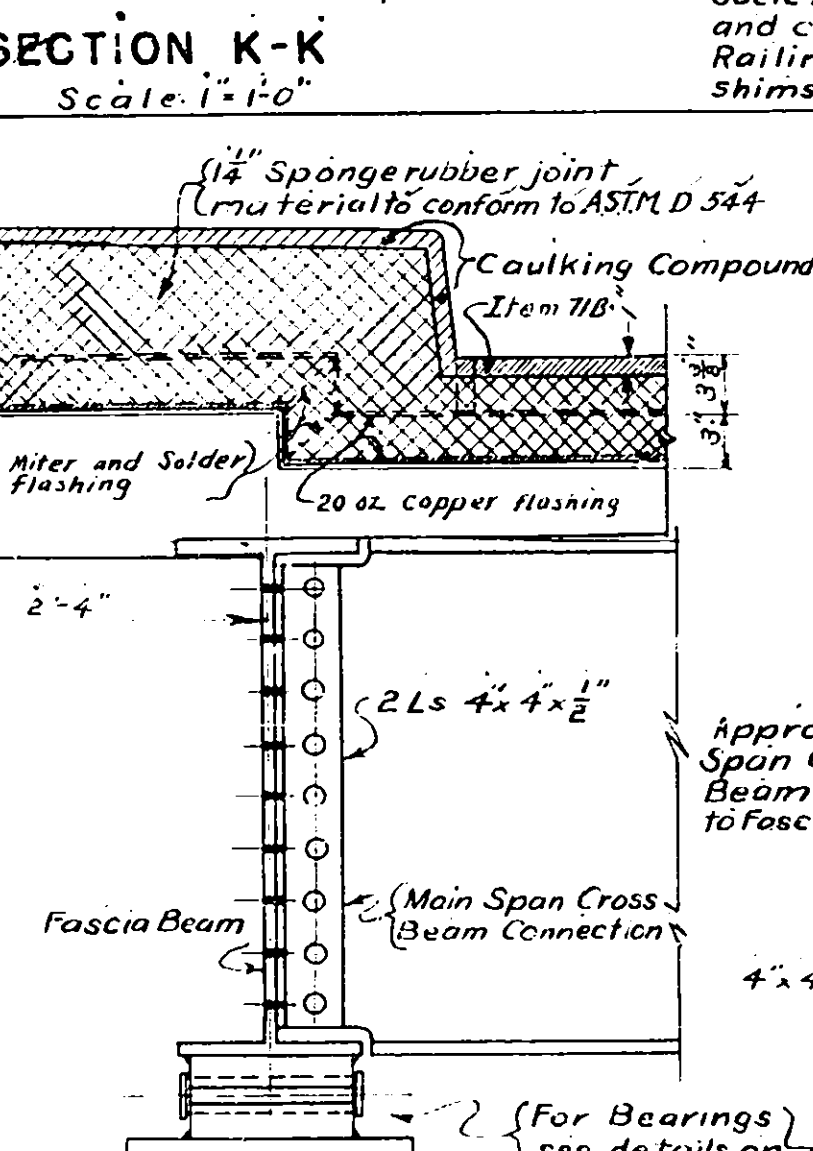

DETAIL OF EXPANSION JOINT

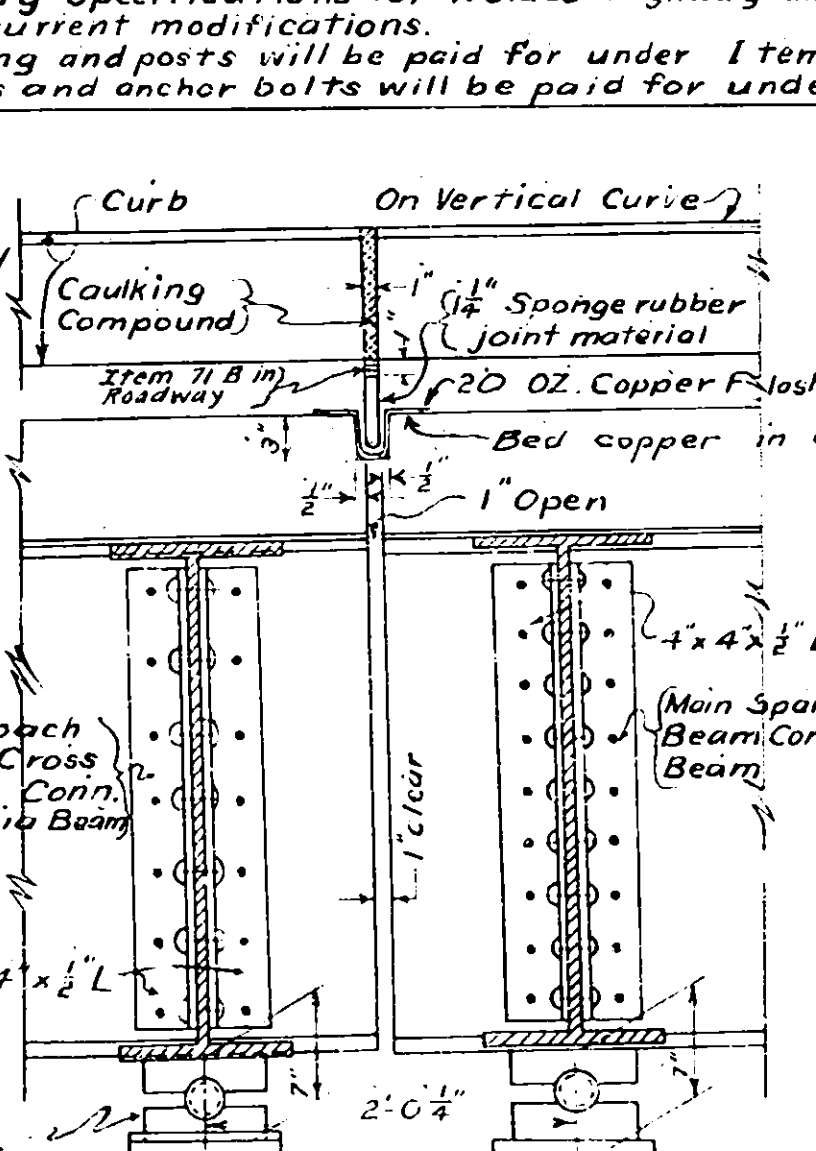

DETAIL OF RAILING POST

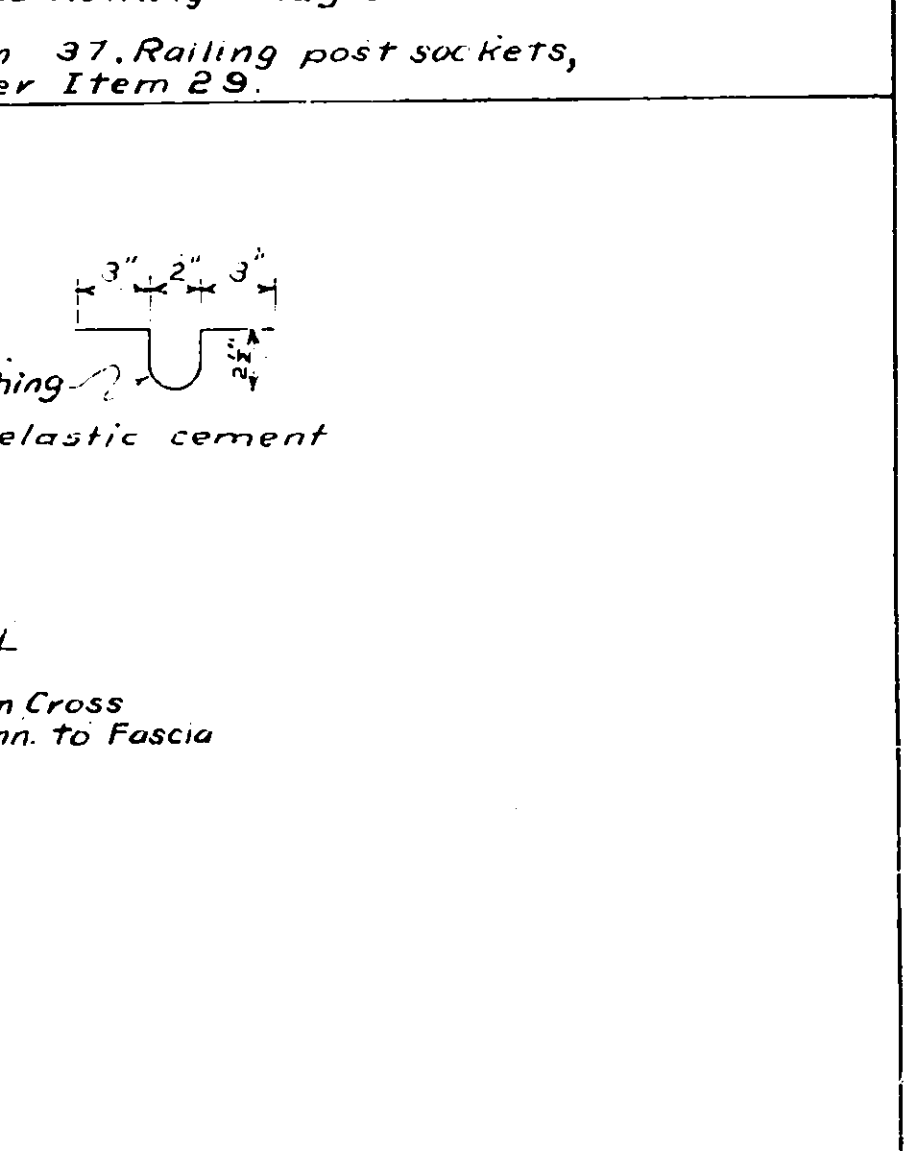

DETAIL OF TOP RAIL

RAILING NOTES


Shop or field welding may be used in the fabrication and erection of the railing. Dimensions of tubing are outside dimensions. All railings are to be fabricated and erected so that the rails are parallel to each other and to the fascia and the posts are truly vertical.

All welding to be electric arc and shall conform to the American Welding Society Specifications for Welded Highway and Railway Bridges 1947 and current modifications. Railing and posts will be paid for under Item 37. Railing post sockets, shims and anchor bolts will be paid for under Item 29.


For Bearings see details on another sheet

GEES ROAD BRIDGE
STA. 378+60
SUPERSTRUCTURE


FED. AID DIST. NO.	STATE	FED. AID PROJ. NO.	FISCAL YEAR	SHEET NO.	TOTAL SHEETS
	N.Y.			43	67
MOHAWK THRUWAY					
FROM			TO		
MADISON COUNTY					

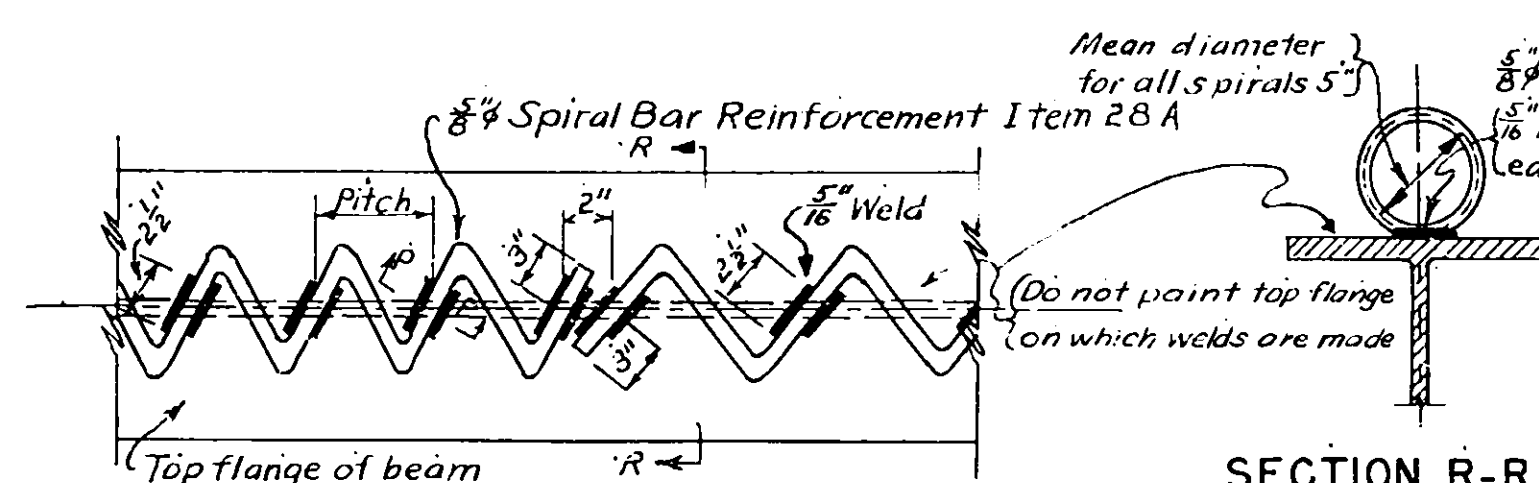


DETAILS OF SPIRAL BAR REINFORCEMENT

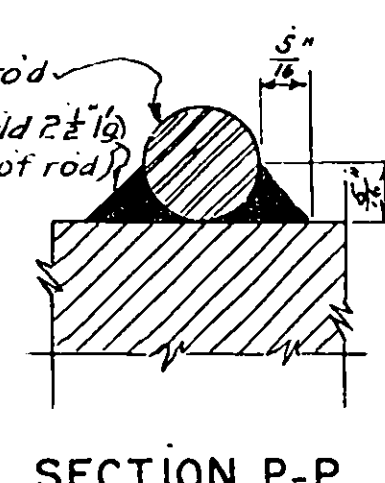


SECTION P-P

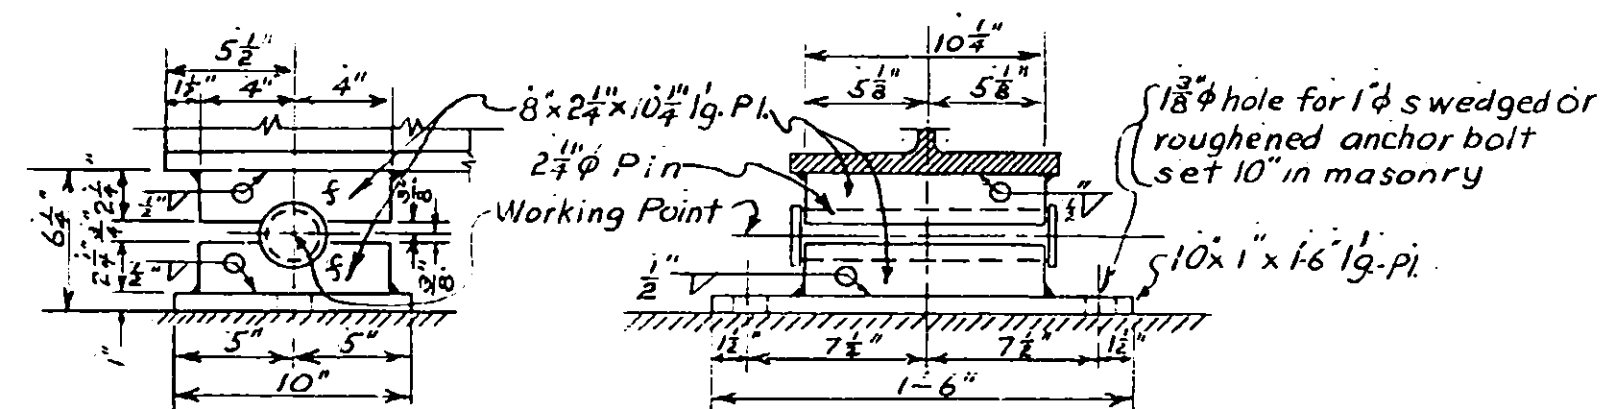


DETAIL OF FIXED BEARINGS AT ABUTMENTS
Scale: $1\frac{1}{2}" = 1'-0"$

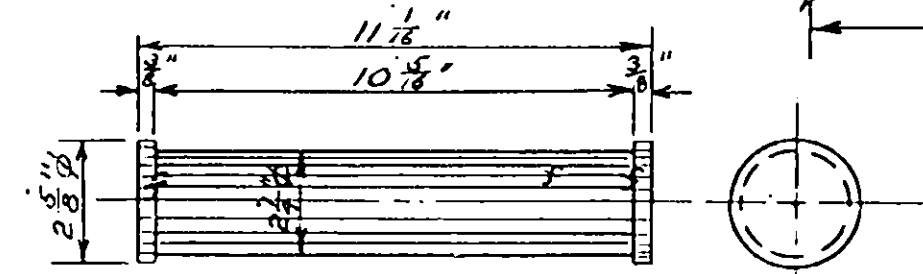

DETAIL OF PIN (*Shank Machined*)
Scale: 3" = 1'-0"

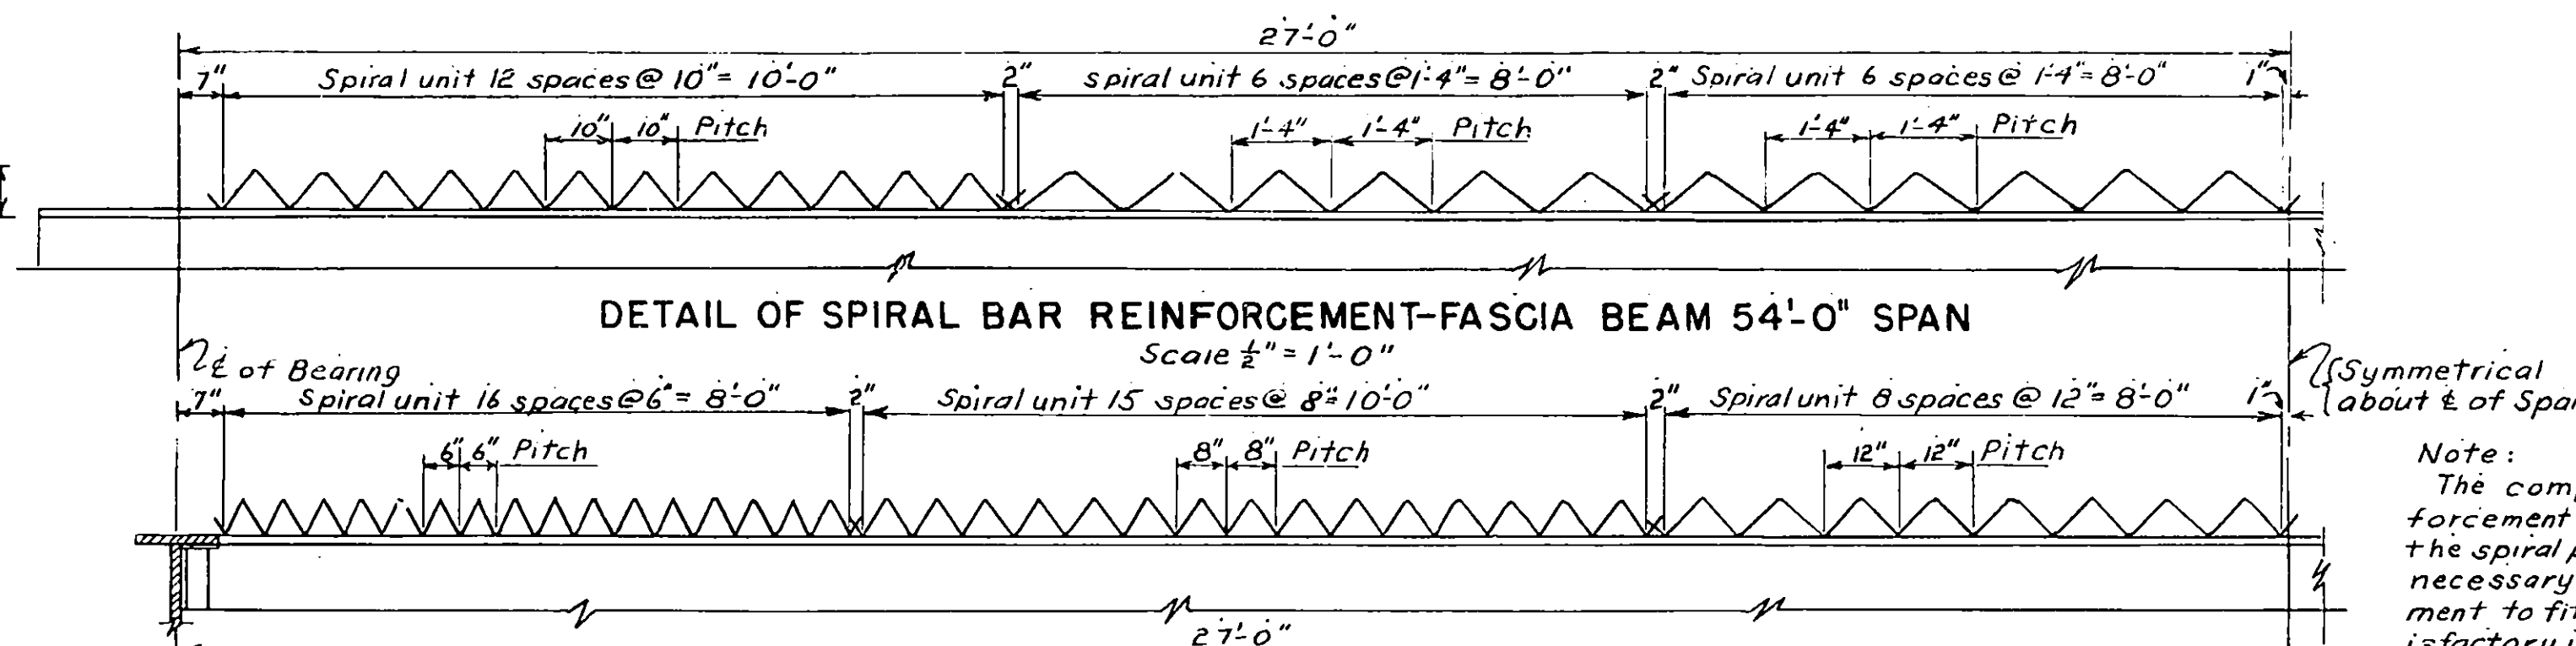


DETAIL OF SPIRAL BAR REINFORCEMENT-FASCIA BEAM 54'-0" SPAN

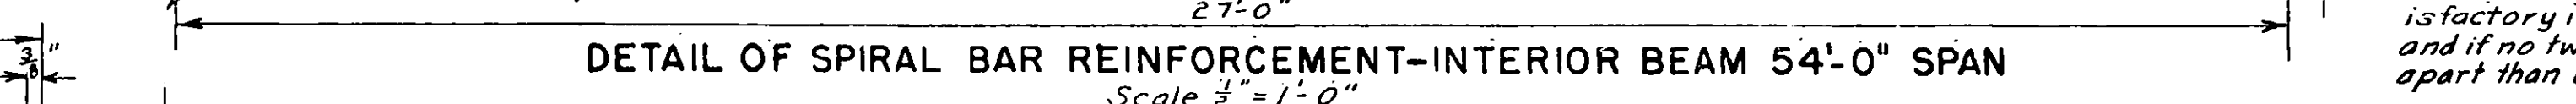


DETAIL OF SPIRAL BAR REINFORCEMENT-INTERIOR BEAM 54'-0" SPAN

Note:
The computed spacing of the transverse slab reinforcement is $5\frac{1}{2}"$. Since this spacing conflicts with the spiral pitches welded to the beam it will be necessary to vary the spacing of the slab reinforcement to fit. The slab bars will be considered satisfactory if there are 8 bars in each layer no dist. of 3'-0" and if no two bars are closer than $4\frac{1}{2}"$ centers or further apart than $6\frac{1}{2}"$ centers.

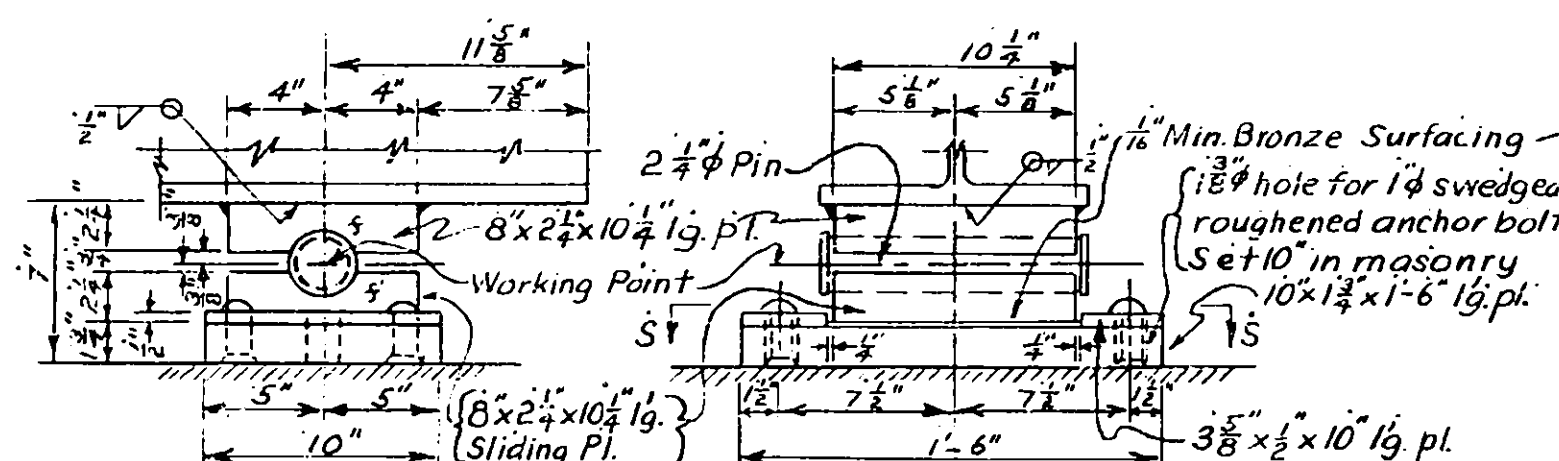


DETAIL OF EXPANSION BEARINGS AT PIERS
Scale: $1\frac{1}{2}" = 1'-0"$

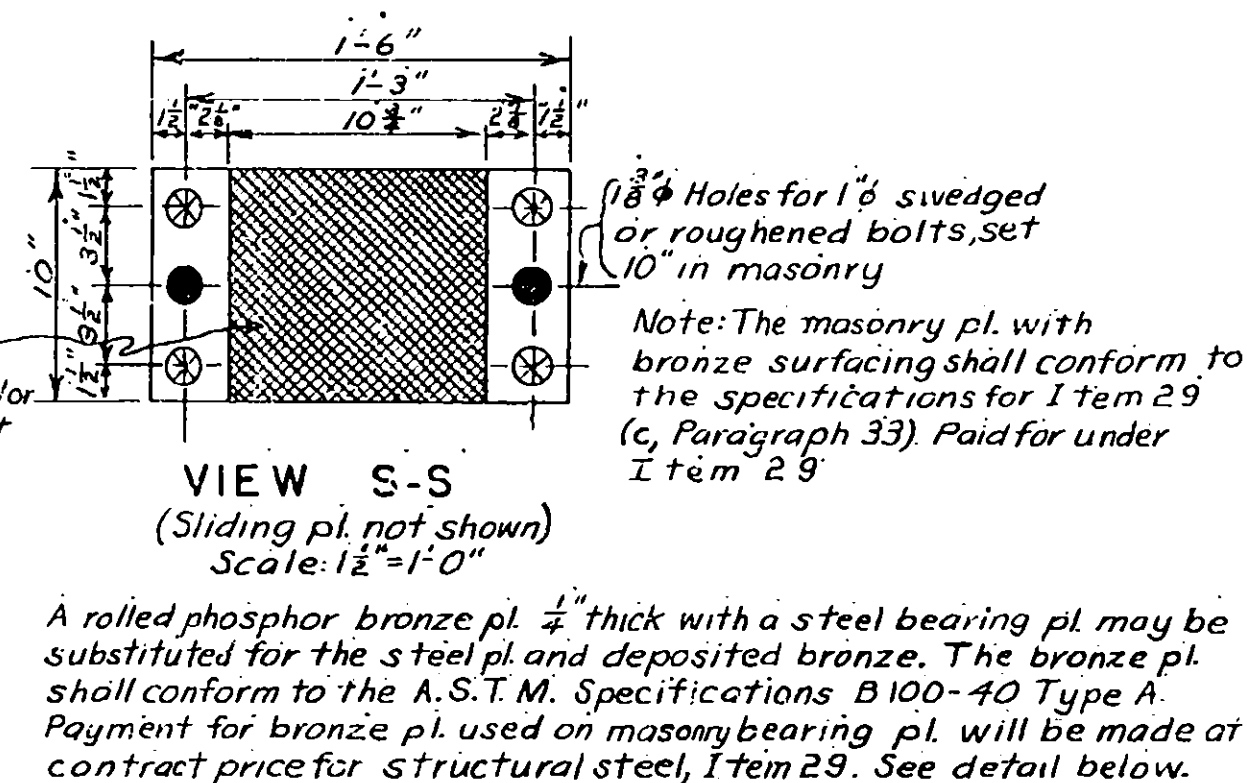

VIEW S-S
(Sliding pl. not shown)
Scale: $1\frac{1}{2}" = 1'-0"$

A rolled phosphor bronze pl. $\frac{1}{4}$ " thick with a steel bearing pl. may be substituted for the steel pl. and deposited bronze. The bronze pl. shall conform to the A.S.T.M. Specifications B100-40 Type A. Payment for bronze pl. used on masonry bearing pl. will be made at contract price for structural steel, Item 29. See detail below.

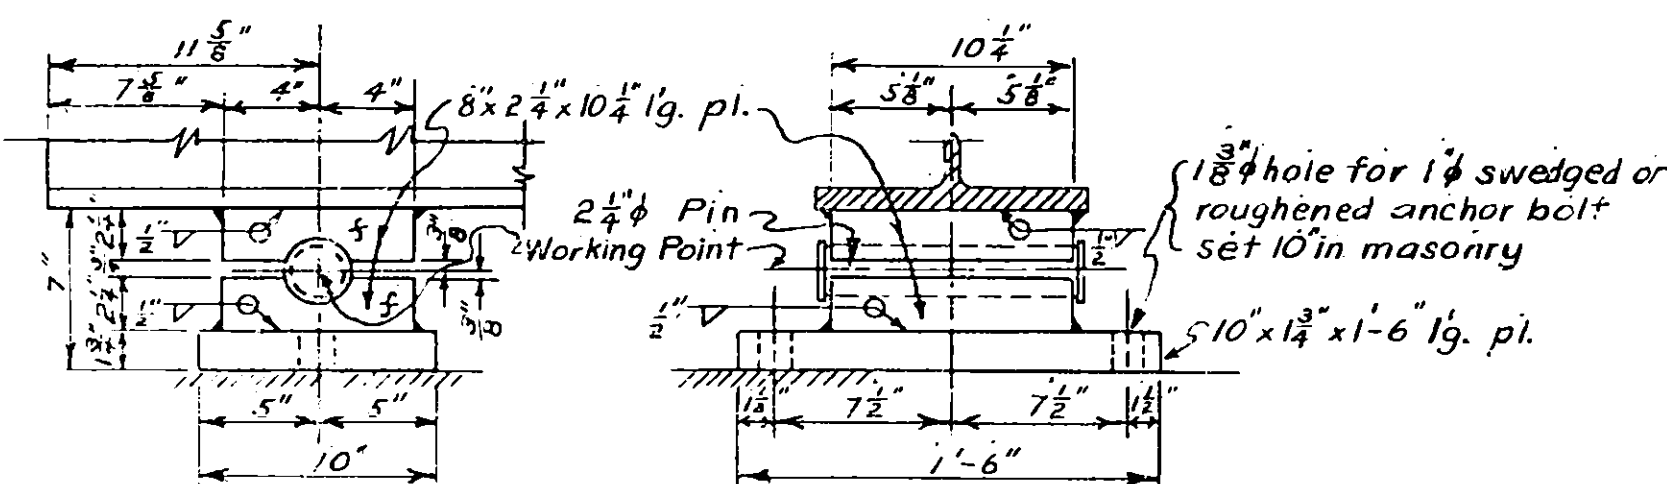

DETAIL OF FIXED BEARINGS AT PIERS
Scale $1\frac{1}{2}" = 1'-0"$

ESTIMATE OF QUANTITIES SUBSTRUCTURE & SUPERSTRUCTURE				
ITEM NO	DESCRIPTION	UNIT	NEAT	ROUND
5	Trench Culvert and Bridge Excavation	Cu.Yds	235'	259
15-2	Portland Cement, Type 2	Bbbls	104.0	112.0
15-N	Natural Cement, Type N	Bbbls	15.2	16.1
18	Class 1A Concrete for Structures (1:2:3 1/2 approx.)	Cu.Yds	406	425
20	Class 1 Concrete (1:2:4 approx.)	Cu.Yds	294	309
25F	Steel Fabric Reinforcement	Sq.Yds	865	908
28	Bar Reinforcement for Structures	Lbs	56,448	59,500
28A	Spiral Bar Shear Connectors	Lbs	12,90	1360
29	Structural Steel	Lbs	186,535	193,000
37	Metal Railing	L.F	565	568
47A	Cement Concrete Pavement (1:1 1/2:3 1/2 approx)	Cu.Yds	.62	.65
79	Dry Stone Paving	Sq.Yds	285	310
85	Steel Bearing Piles	L.F.	3416	3500
87	Furnishing Equipment for Driving Piles	L.S.	Nec.	Nec.
121A	Top Soil Furnished & Placed	Cu.Yds	230	253
123B	Seeding on Prepared Areas	Acres	0.42	0.46
124	Sodding	Sq.Yds	660	770

SUPERSTRUCTURE NOTES

All concrete in superstructure shall be Item 8 Class 1A Concrete for Structures except pavement. Pavement concrete to be Item 47B Cement Concrete Pavement.

The cost of furnishing and installing joint material including caulking compound, premoulded bituminous joint material, elastic cement, sponge rubber joint material, lead wool, bituminous material and copper flashing shall be included in the price bid for the various items affected.

All joints where caulking compound is to be placed must be thoroughly clean and dry before the priming coat is applied. The sides of the joint shall be primed 20 to 30 minutes before caulking compound is placed.

Rivets to be $\frac{3}{4}$ " diameter, holes $\frac{15}{16}$ " diameter unless otherwise noted.
Camber beams as shown on plans. The thickness of cement concrete pavement and height of concrete curbs may be varied slightly as directed by the Engineer in the field in order to follow closely the roadway grade.

Shop paint, red lead and oil. First field coat to be Battleship gray. Second field coat to be gray arden paint.

Designing and detailing have been done in accordance with the A. A. S. H. O. Specifications 1944 for Highway Bridges.

Material and fabrication are in accordance with New York State Department of Public Works Specifications of January 2, 1951 and current modification.

Loading: This structure has been designed for a series of H-20 Trucks in each traffic lane. Dimensions and distributions specified in the A.A.S.H.O. 1944 Specifications. Trucks spaced 30 feet apart between adjacent axles

1944 Specifications. Trucks spaced 30 feet apart between adjacent axles. No construction joints other than those shown on the plans will be permitted without written permission of the Deputy Chief Engineer, Bridges. Reinforcing bars may be spliced at places approved by the Engineer. Bars so spliced shall be lapped at least 15 diameters.

Immediately before placing pavement concrete, the concrete surface or surfaces upon which it is to be placed shall be thoroughly wetted down continuously for one hour, if the air temperature is above 50°F. Payment to be made under Item 1Wand 1WA in highway estimate.




Item 62 is not in this contract (N.I.C.). Additional $\frac{3}{8}$ " overlying concrete shall replace the waterproofing.


Sponge rubber shall comply with ASTM D544 specification. Where steel exceeding one inch in thickness is to be welded electrodes of classification number E6015 or E6016 shall be used.

Diaphragm connections to be rivet bolts or equal.
N.I.C. on drawings means not included in contract.

BAR LIST FOR SUPERSTRUCTURE				
Mark	Size	No	Length	Description and Location
A	$\frac{3}{8}$ "	526	26'-8"	Straight Transverse Bars in Bottom of Slab
B	$\frac{3}{8}$ "	524	37'-3"	Transverse Bars in Top of Slob, hooked
C	$\frac{3}{8}$ "	76	38'-6"	Str Longitudinal Bars in Approach Span
C1	$\frac{1}{4}$ "	258	29'-8"	Str Longitudinal Bars in Main Spans
Bl	$\frac{3}{8}$ "	12	27'-0"	Trans Bars in Top of Slab at Abut, hooked
C2	$\frac{3}{8}$ "	20	35'-6"	Str Long Bars in Approach Span Fascia's
S	$\frac{1}{2}$ "	386	4'-0"	Stirrups in Fascia



BAR BENDING DETAILS

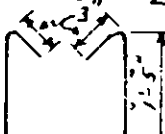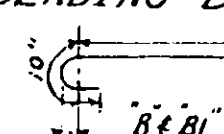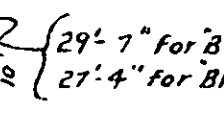


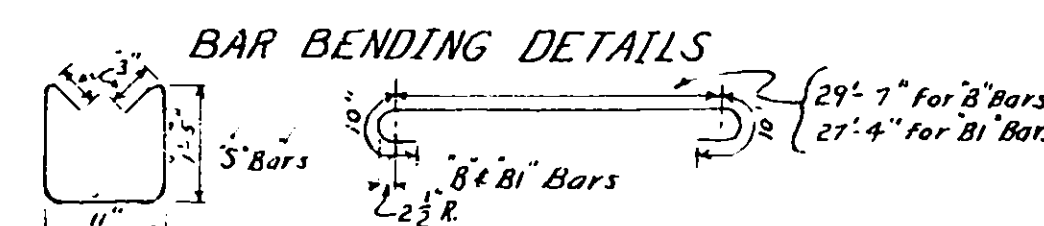J. M. Siev 1-31-50
 J. E. Halligan May '48
 J. E. Blumenthal
 K. Fleischer
 M. Delaney


FED. AID DIST. NO.	STATE	FED. AID PROJ. NO.	FISCAL YEAR	SHEET NO.	TOTAL SHEETS
	N.Y.			43	57
MOHAWK THRUWAY					
FROM			TO		
MADISON COUNTY					

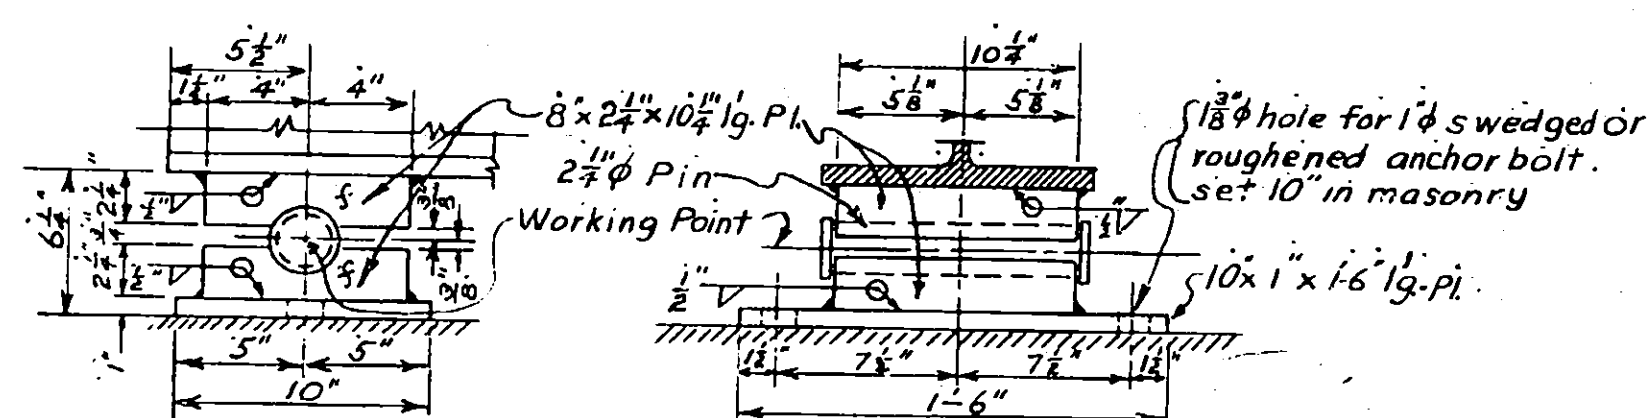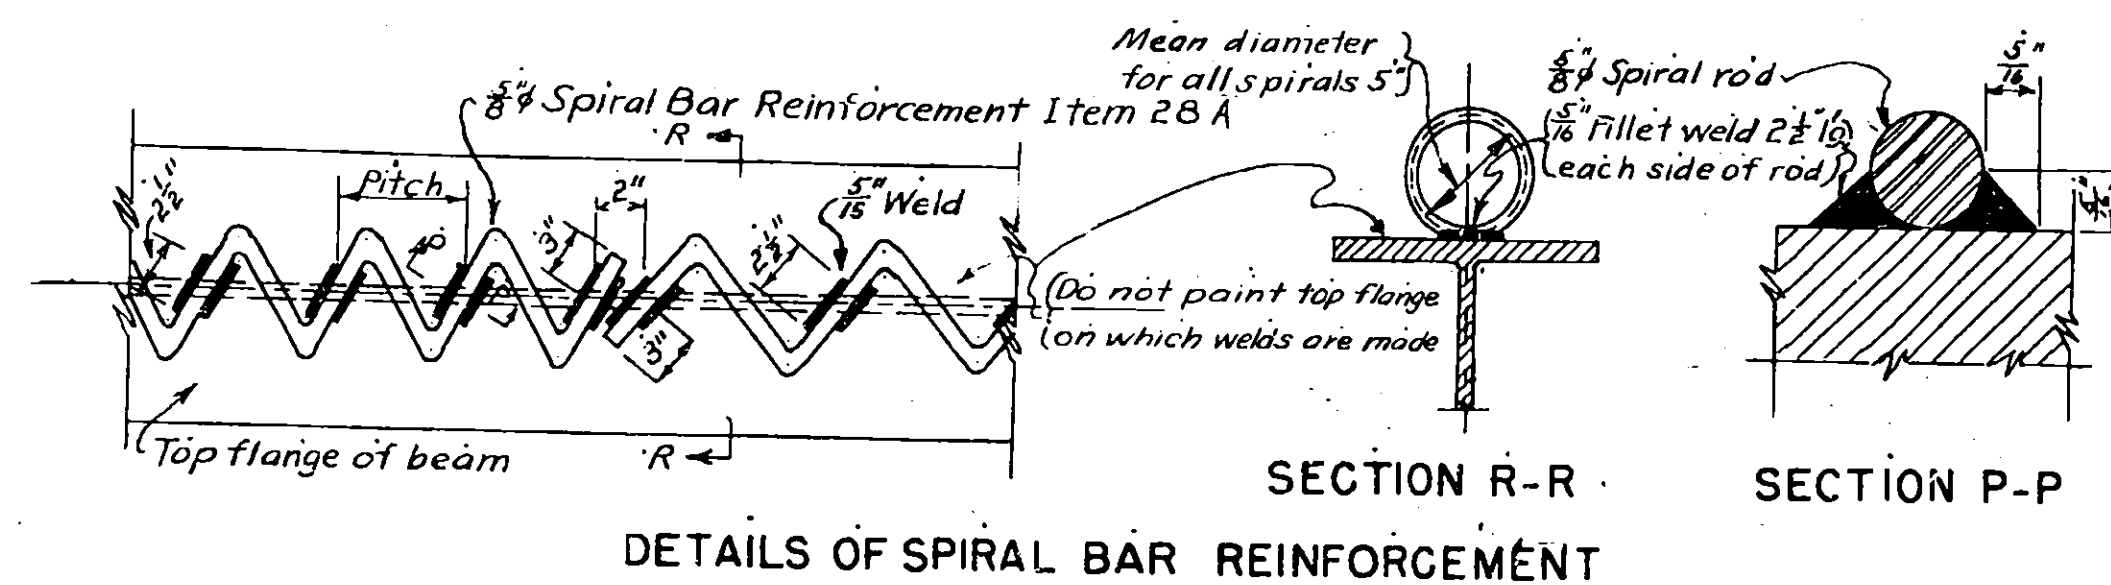


DETAIL OF FIXED BEARINGS AT ABUTMENTS
Scale: $\frac{1}{2}" = 1'-0"$

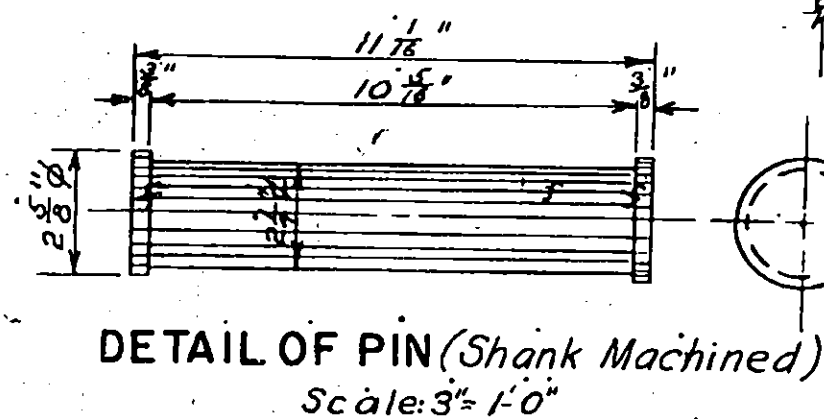


DETAIL OF PIN (*Shank Machined*)
Scale: 3" = 1'-0"

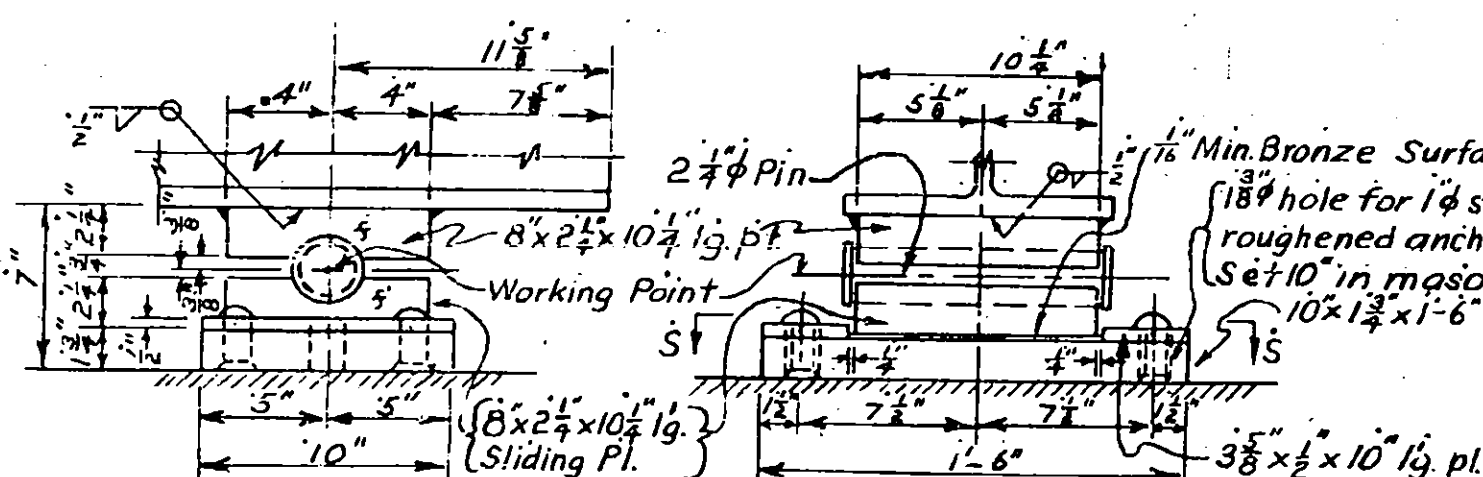

DETAIL OF EXPANSION BEARINGS AT PIERS
Scale: $1\frac{1}{2}" = 1'-0"$


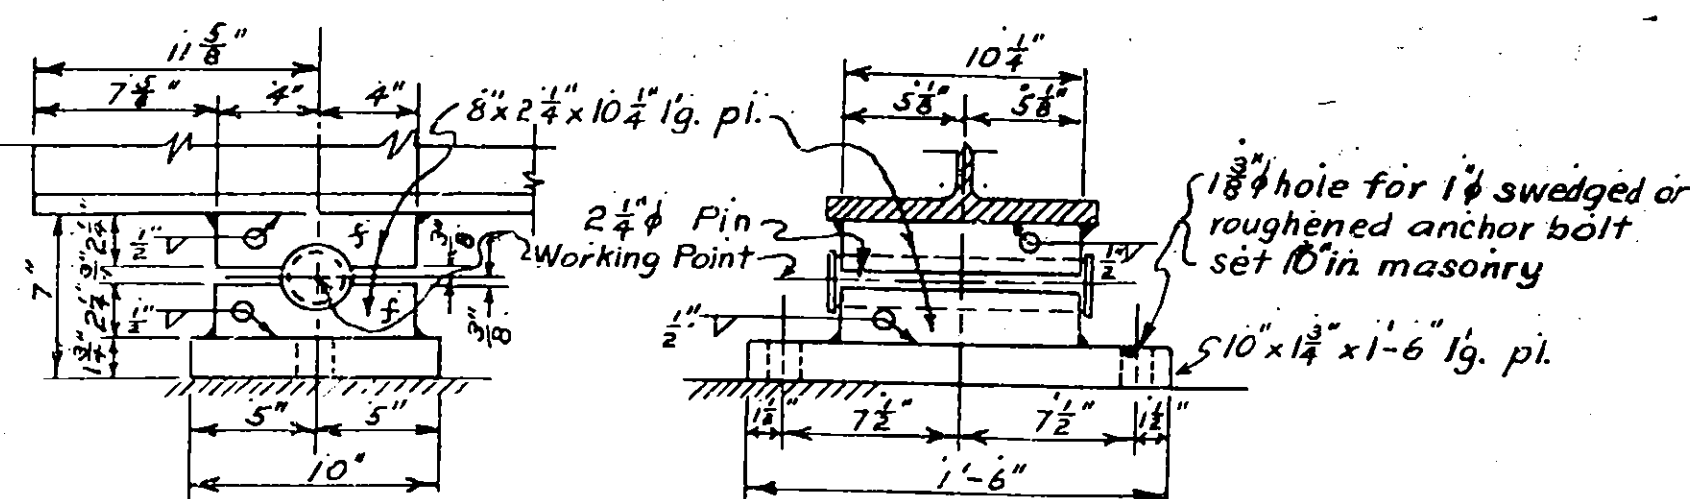


DETAIL OF FIXED BEARINGS AT PIERS
Scale $1\frac{1}{2}" = 1'-0"$

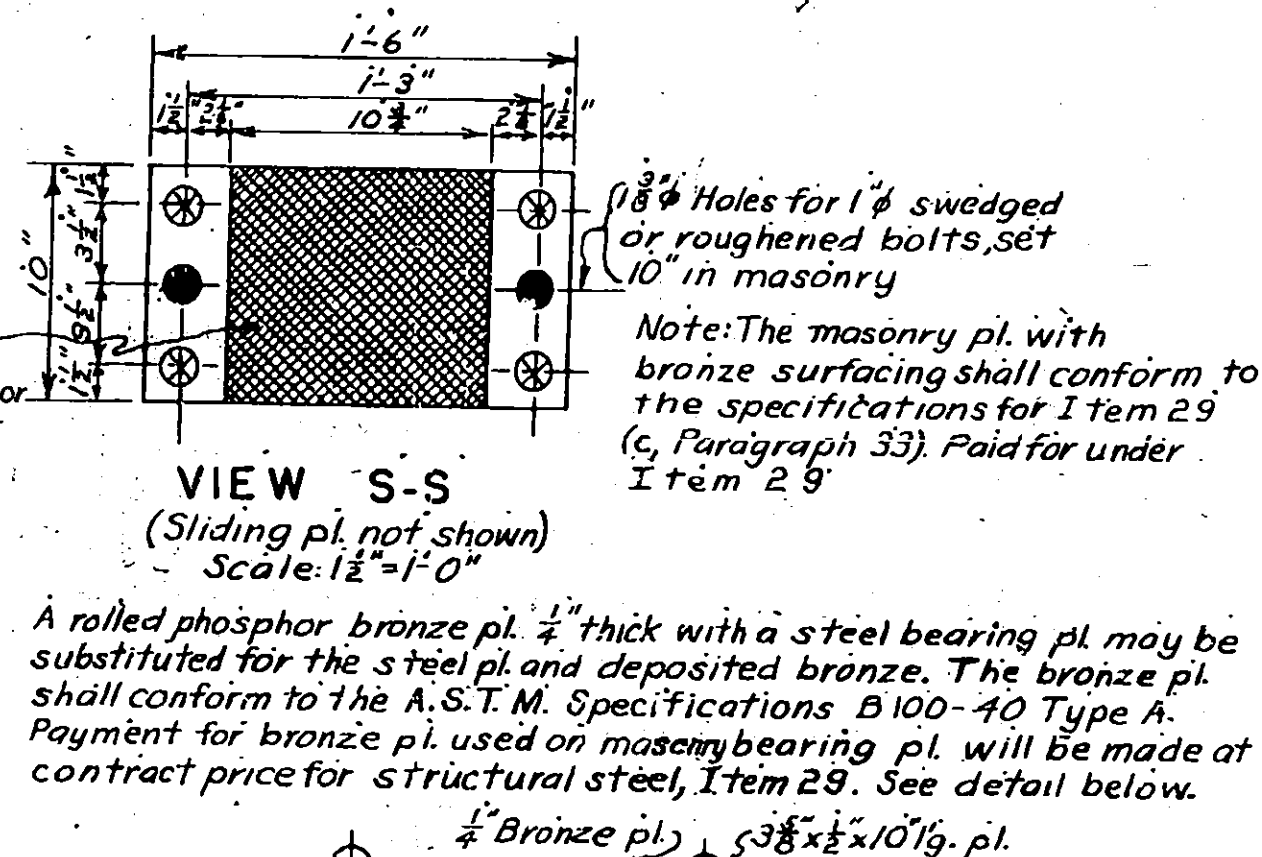

VIEW S-S
(Sliding pl. not shown)
Scale: $1\frac{1}{2}" = 1'-0"$

BAR LIST FOR SUPERSTRUCTURE				
Mark	Size	No.	Length	Description and Location
A	$\frac{3}{8}$ "	536	26'-8"	Straight Transverse Bars in Bottom of Slab
B	$\frac{3}{8}$ "	524	37'-3"	Transverse Bars in Top of Slab, hooked
C	$\frac{1}{2}$ "	76	38'-6"	Str. Longitudinal Bars in Approach Span
C1	$\frac{1}{2}$ "	268	29'-8"	Str. Longitudinal Bars in Main Spans
B1	$\frac{3}{8}$ "	12	29'-0"	Transv. Bars in Top of Slab at Abut, hooked.
C2	$\frac{1}{2}$ "	20	35'-4"	Str. Long. Bars in Approach Span Fascia
S	$\frac{1}{2}$ "	386	4'-0"	Stirrups in Fascia

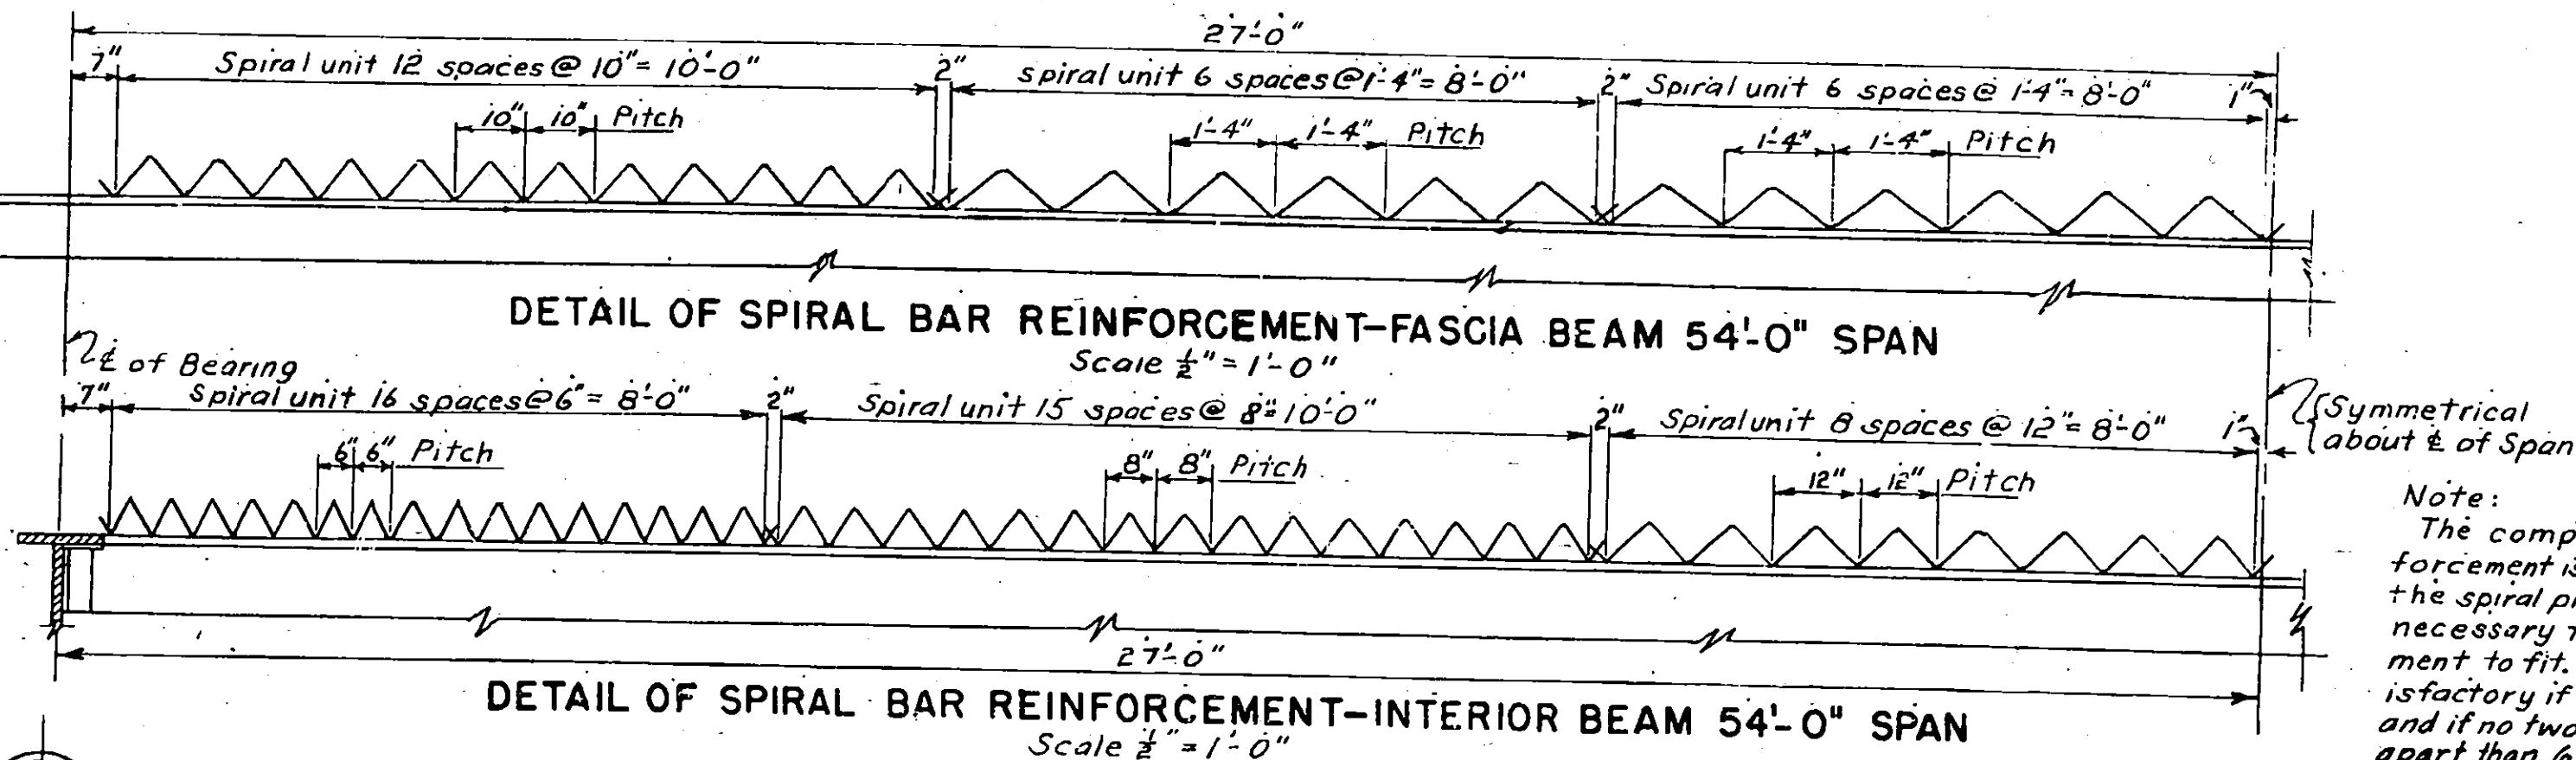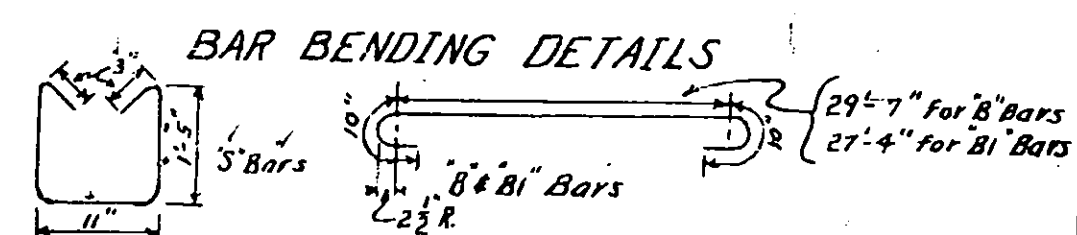

DETAIL OF SPIRAL BAR REINFORCEMENT-FASCIA BEAM 54'-0" SPAN

DETAIL OF SPIRAL BAR REINFORCEMENT-INTERIOR BEAM 54'-0" SPAN
Scale $\frac{1}{4}" = 1'-0"$

Note:
The computed spacing of the transverse slab reinforcement is 5" . Since this spacing conflicts with the spiral pitches welded to the beam it will be necessary to vary the spacing of the slab reinforcement to fit. The slab bars will be considered satisfactory if there are 8 bars in each layer in a dist of 3'-8" and if no two bars are closer than 4" centers or further apart than 6" centers.

SUPERSTRUCTURE NOTES

SUPERSTRUCTURE NOTES

All concrete in superstructure shall be Item 18, Class 1A Concrete for Structures except pavement. Pavement concrete to be Item 47B, Cement Concrete Pavement.

The cost of furnishing and installing joint material including caulking compound, premoulded bituminous joint material, elastic cement, sponge rubber, joint material, lead wool, bituminous material and copper flashing shall be included in the prices bid for the various items affected.

All joints where caulking is required.

All joints where caulking compound is to be placed must be thoroughly clean and dry before the priming coat is applied. The sides of the joint shall be primed 20 to 30 minutes before caulking compound is placed.

Rivets to be $\frac{3}{8}$ " diameter, holes $\frac{15}{16}$ " diameter unless otherwise noted.
Camber beams as shown on plans. The thickness of cement concrete pavement and height of concrete curb shall be as shown on plans.

the Engineer in the field in order to follow closely the roadway grade.

Designing and detailing have been done in accordance with the A.A.S.H.O. Specifications 1944 for Highway Bridges.

Material and fabrication are in accordance with New York State Department of Public Works Specifications of January 2, 1951 and current modification.

Loading: This structure has been designed for a series of H-20 Trucks, in each traffic lane. Dimensions and distribution as specified in the A.A.S.H.O. 1944 Specifications. Trucks spaced 30 feet apart between adjacent axles.

No construction joints other than those shown on the plans will be permitted without written permission of the Deputy Chief Engineer, Bridges.
Reinforced bars may be spliced at places approved by the Engineer. Bars so spliced shall be:

Immediately before placing pavement concrete, the concrete surface or surfaces upon which it is to be placed shall be

Surface or surfaces upon which it is to be placed shall be thoroughly wetted down continuously for one hour, if the air temperature is above 50°F. Payment to be made under Item 1W and 1WA in highway estimate.

Item 62 is not in this contract (N.I.C.). Additional $\frac{3}{8}$ " overlying concrete shall replace the waterproofing.

Where steel exceeding one inch in thickness is to be welded

Diaphragm connections to be rivet bolts.

Diaphragm connections to be rivet bolts or equal.
N.I.C. on drawings means not included in contract.

1998, 1999, 2000, 2679, 26

...and the fact that the ...


GEES ROAD BRIDGE
STA 378+60

STA. 378+60
SUPERSTRUCTURE


SUPERSTRUCTURE.

FED. RD. DIV. No.	STATE	FED. AID PROJ. No.	COUNTY	SHEET No.	TOTAL SHEETS
	N. Y.		Madison	44	67
Mohawk Thruway - North Chittenango - Canastota Gees Road - "M" Line					

At intervals of 100 ft. or at such intervals as the Engineer may direct, lateral trenches or weep holes four feet in width shall be opened up through the shoulders to the ditches to effectively drain the subgrade before the pavement is constructed. These shall be filled with Item 41BT, Foundation Course Broken Stone and the excavation will be paid for under Item 2B, Unclassified Excavation.

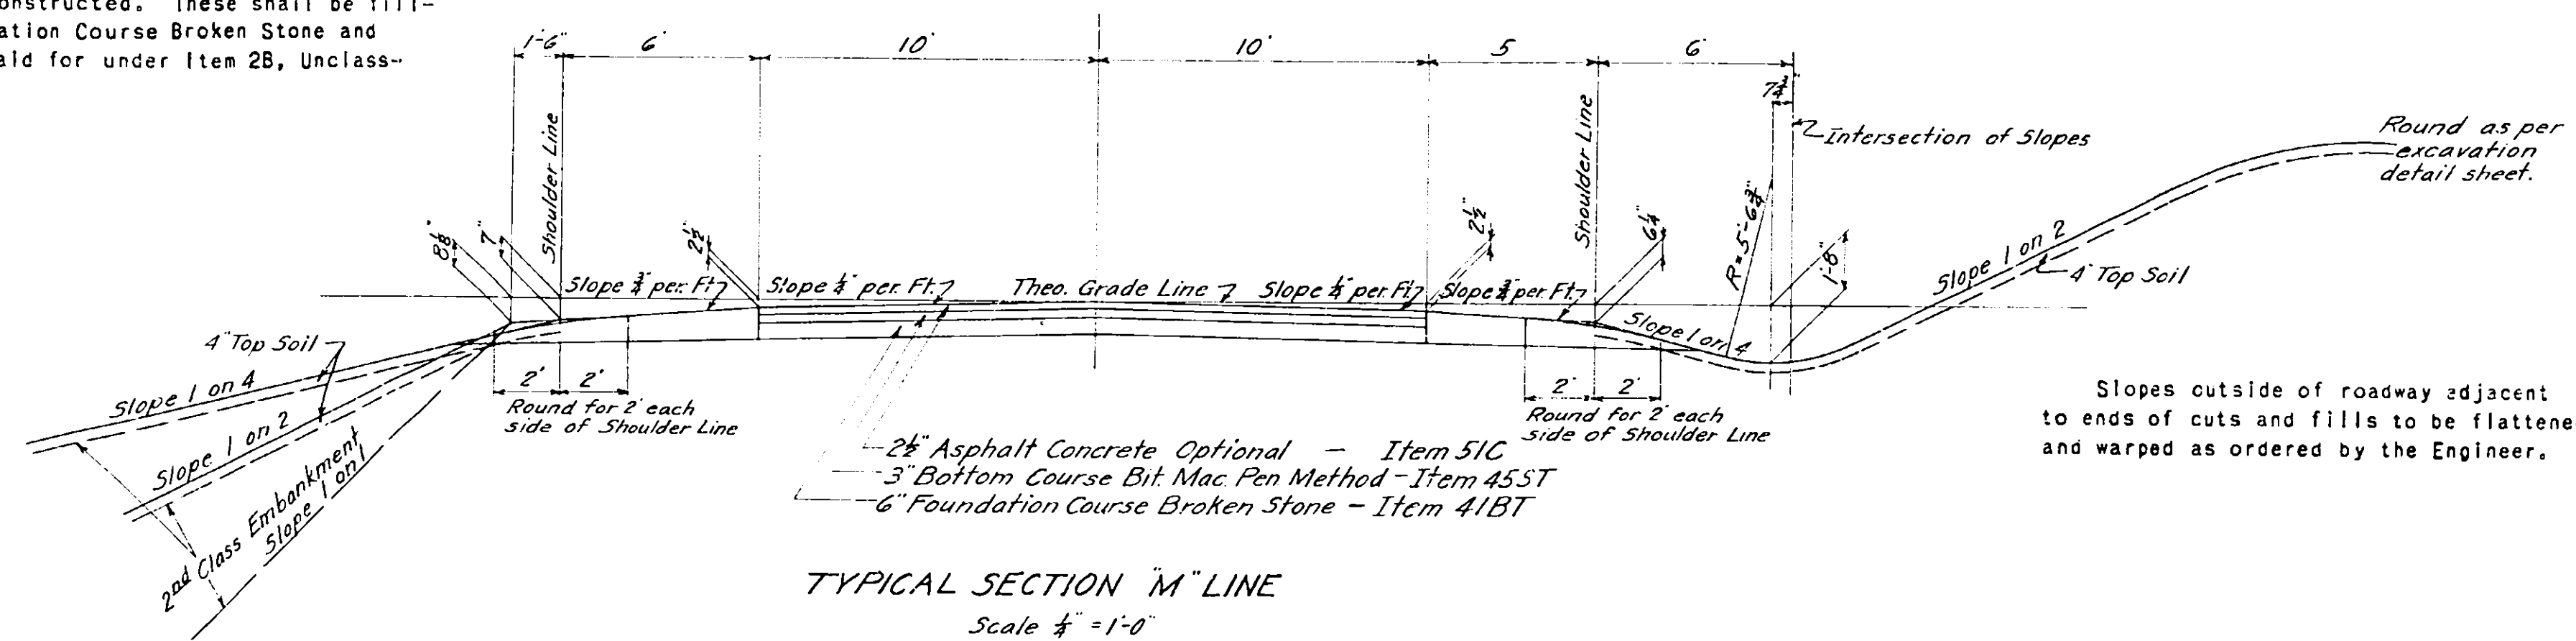

Second Class Embankment shall be used between the lines indicated if ordered by the Engineer. Second Class Embankment is material stripped from cuts and under embankments as ordered, but shall not include stumps, logs, brush nor other objectionable material.

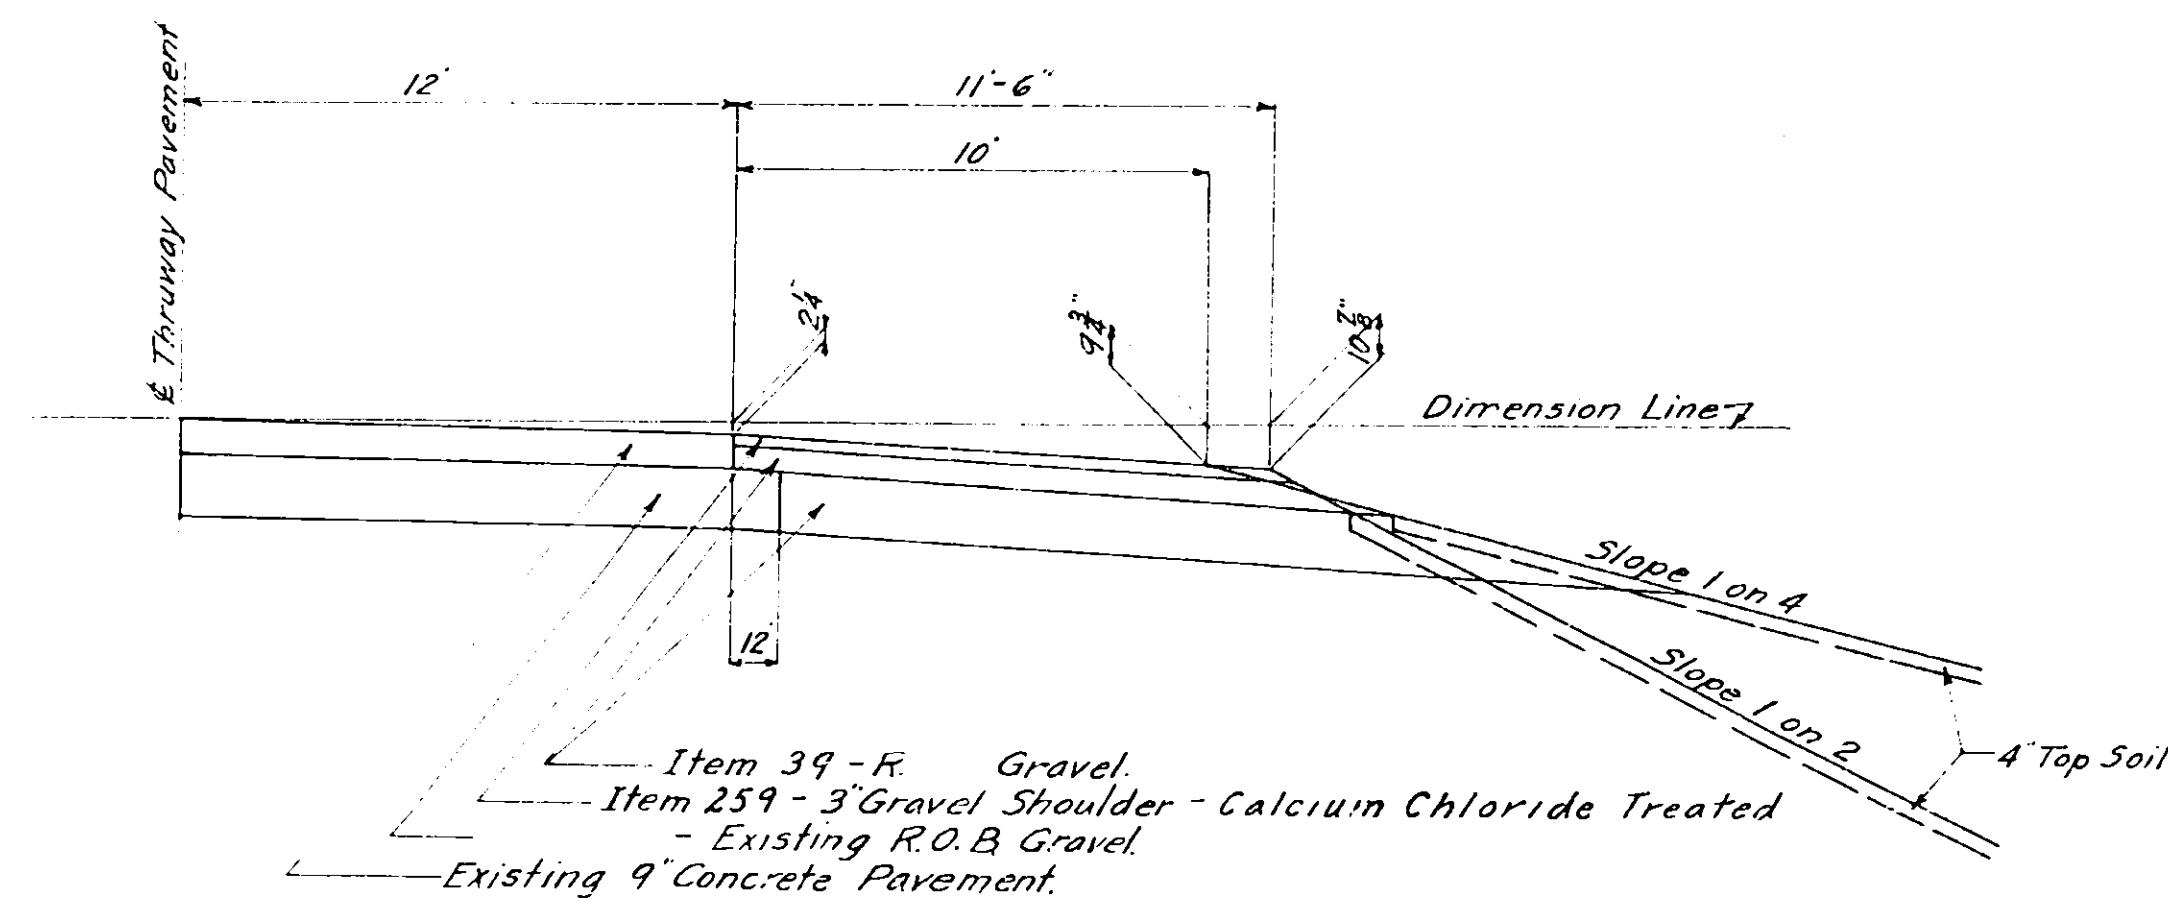

PART SECTION OF THRUWAY
SHOWING SHOULDER TO BE BUILT AFTER
REMOVAL OF TEMPORARY INTERSECTION
Scale 1/4" = 1'-0"

NOTE: -

MAINTENANCE and PROTECTION of TRAFFIC: The Contractor shall maintain and protect traffic within the limits of his contract for the entire length and duration of the contract in accordance with Item No. 76, with the following modifications:

The temporary crossing at Gees Road shall be maintained until the relocation of Tag Street, Station M 0+00 to N 29+56 C.L. and the relocation of Town road N 29+56 C.L. to N 69+00 is passable and opened to traffic. The temporary crossings at Tag Street (Station 352+70 C.L. = L 21+10 C.L.) and at Town road (Station 421+23 C.L. = N 87+89.5) shall be maintained until the grade separation at Gees Road is completed and opened to traffic.

Thruway traffic shall be maintained as required.

Signs shall be erected in accordance with Standard Structure Sheet No. 49-43, on the Thruway as well as on Tag Street, Gees Road and the Town road at Sta. 421+23 L. N 87+89.5.

Item 5 - TRENCH, CULVERT and BRIDGE EXCAVATION

From	Cu. Yds.
Drainage Sheet	61
Estimate	9
TOTAL	70

Item 2B - UNCLASSIFIED EXCAVATION

From	C.Y.
Road Excavation	493
Borrow	32510
Remove Temp. Intersection	407
Waste	717
Estimate	2873
TOTAL	37000

TABLE of LENGTHS

ROAD		BRIDGE	
Station to Station	Lin. Ft. = Miles	Station to Station	Lin. Ft. = Miles
M 0+00 M 10+77	1077 .204		
M 10+77 M 13+23		246 .046	
M 13+23 M 21+20	797 .151		
TOTAL	1074 .355	246 .046	

Item 32D - OPTIONAL GUIDE RAILING

Station to Station	Side	Anchors	Lin. Ft.
M 6+46 M 10+76	R & L	2	860
M 13+23 M 17+23	R & L	2	800
		4 Anchors @ 20	1680
		Estimate	60
		TOTAL	1800

DRAINAGE STRUCTURES


Present Structure	Station	REMARKS
24" RCCP - 92' long	M 13+00	Build 2 - 5' headwalls on existing pipe.
18" C.M.P. Culv. 50' long	M 11+03	Remove and store.
18" C.M.P. Culv. 40' long	M 12+00	Remove and store.

Made by: Traced by: Checked by:
PLAN: F.E. White, J.E. White, J.J. Meyer, J. J. Colangelo
PROFILE:

Prepared Pursuant to the Highway Law & Recommended by
Date: 10/1/54 Larry Ketchum
ENGINEER DISTRICT NO. 2

FED. RD. DIV. No.	STATE	FED. AID PROJ. No.	COUNTY	SHEET No.	TOTAL SHEETS
	N.Y.		Madison	44	67
Mohawk Thruway - North Chittenango Canastota Gees Road - M Line					

At intervals of 100 ft.
lateral trenches or weep holes
four feet in width
opened up through the should-
ers to the ditches to effectively drain the subgrade
before the pavement is constructed. These
filled with Item 41BT, Foundation Course Broken Stone and
the excavation paid for under Item 2B, Unclas-
sified Excavation.

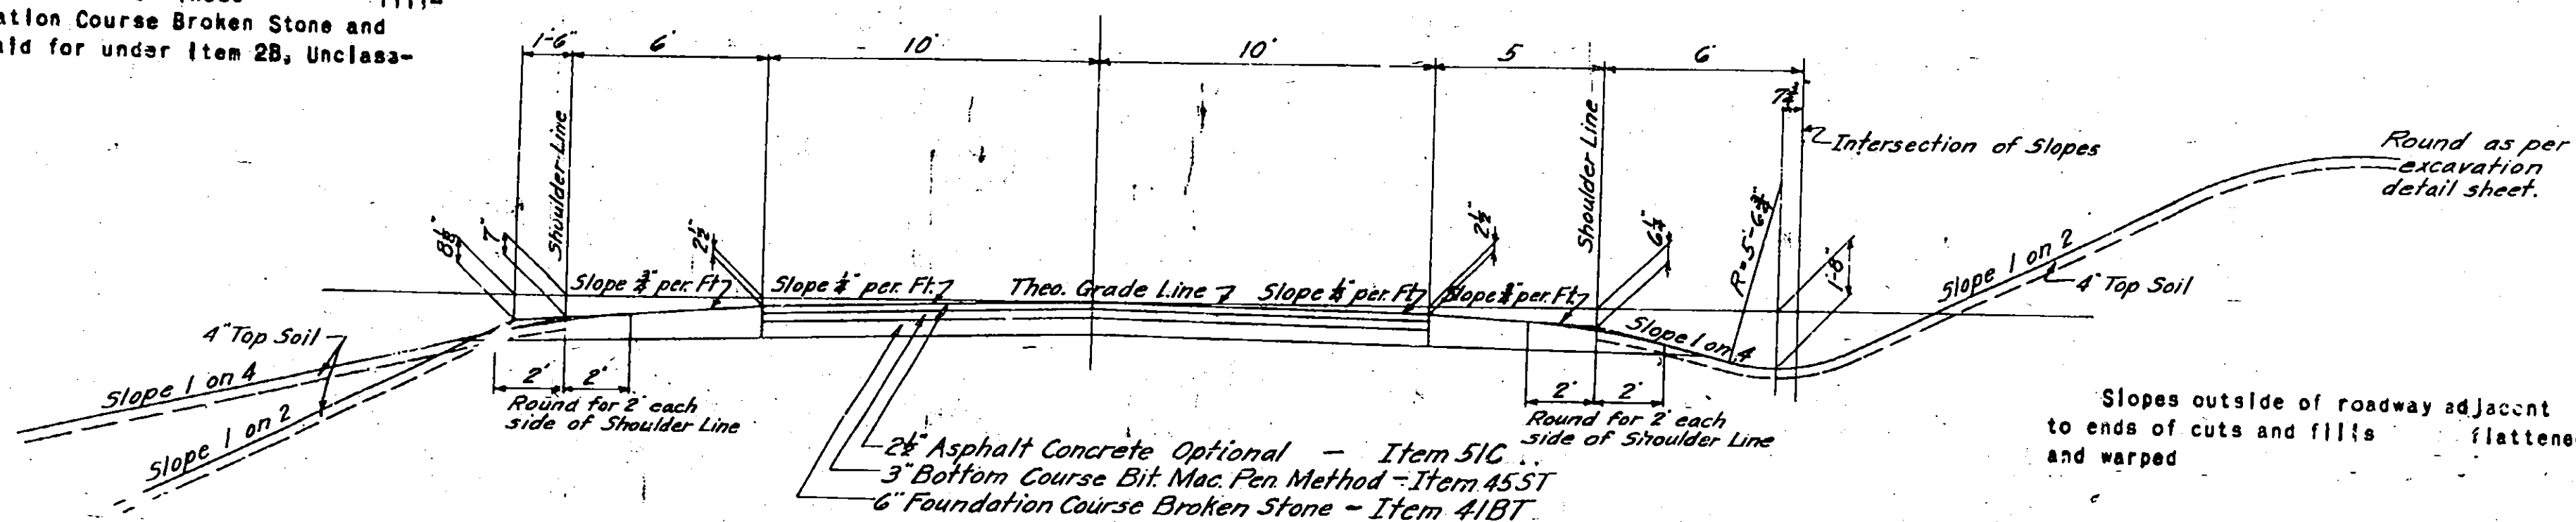

TYPICAL SECTION M LINE
Scale 1/4" = 1'-0"

NOTE: -

MAINTENANCE and PROTECTION of TRAFFIC: The Contractor shall maintain and protect traffic within the limits of his contract for the entire length and duration of the contract in accordance with Item No. 76, with the following modifications:

The temporary crossing at Gees Road shall be maintained until the relocation of Tag Street, Station N 0+00 to N 25+56 C.L. and the relocation of Town road N 20+56 C.L. to N 60+00 is passable and opened to traffic. The temporary crossings at Tag Street (Station 362+70 C.L. = L 21+10 C.L.) and at Town road (Station 421+23 C.L. = M 87+89.5) shall be maintained until the grade separation at Gees Road is completed and opened to traffic.


Thruway traffic shall be maintained as required.

Signs shall be erected in accordance with Standard Structure Sheet No. 40-43, on the Thruway as well as on Tag Street, Gees Road and the Town road at Sta. 421+23 L N 87+89.5

Item 5 - TRENCH, CULVERT and BRIDGE EXCAVATION

From Cu. Yds.

TOTAL

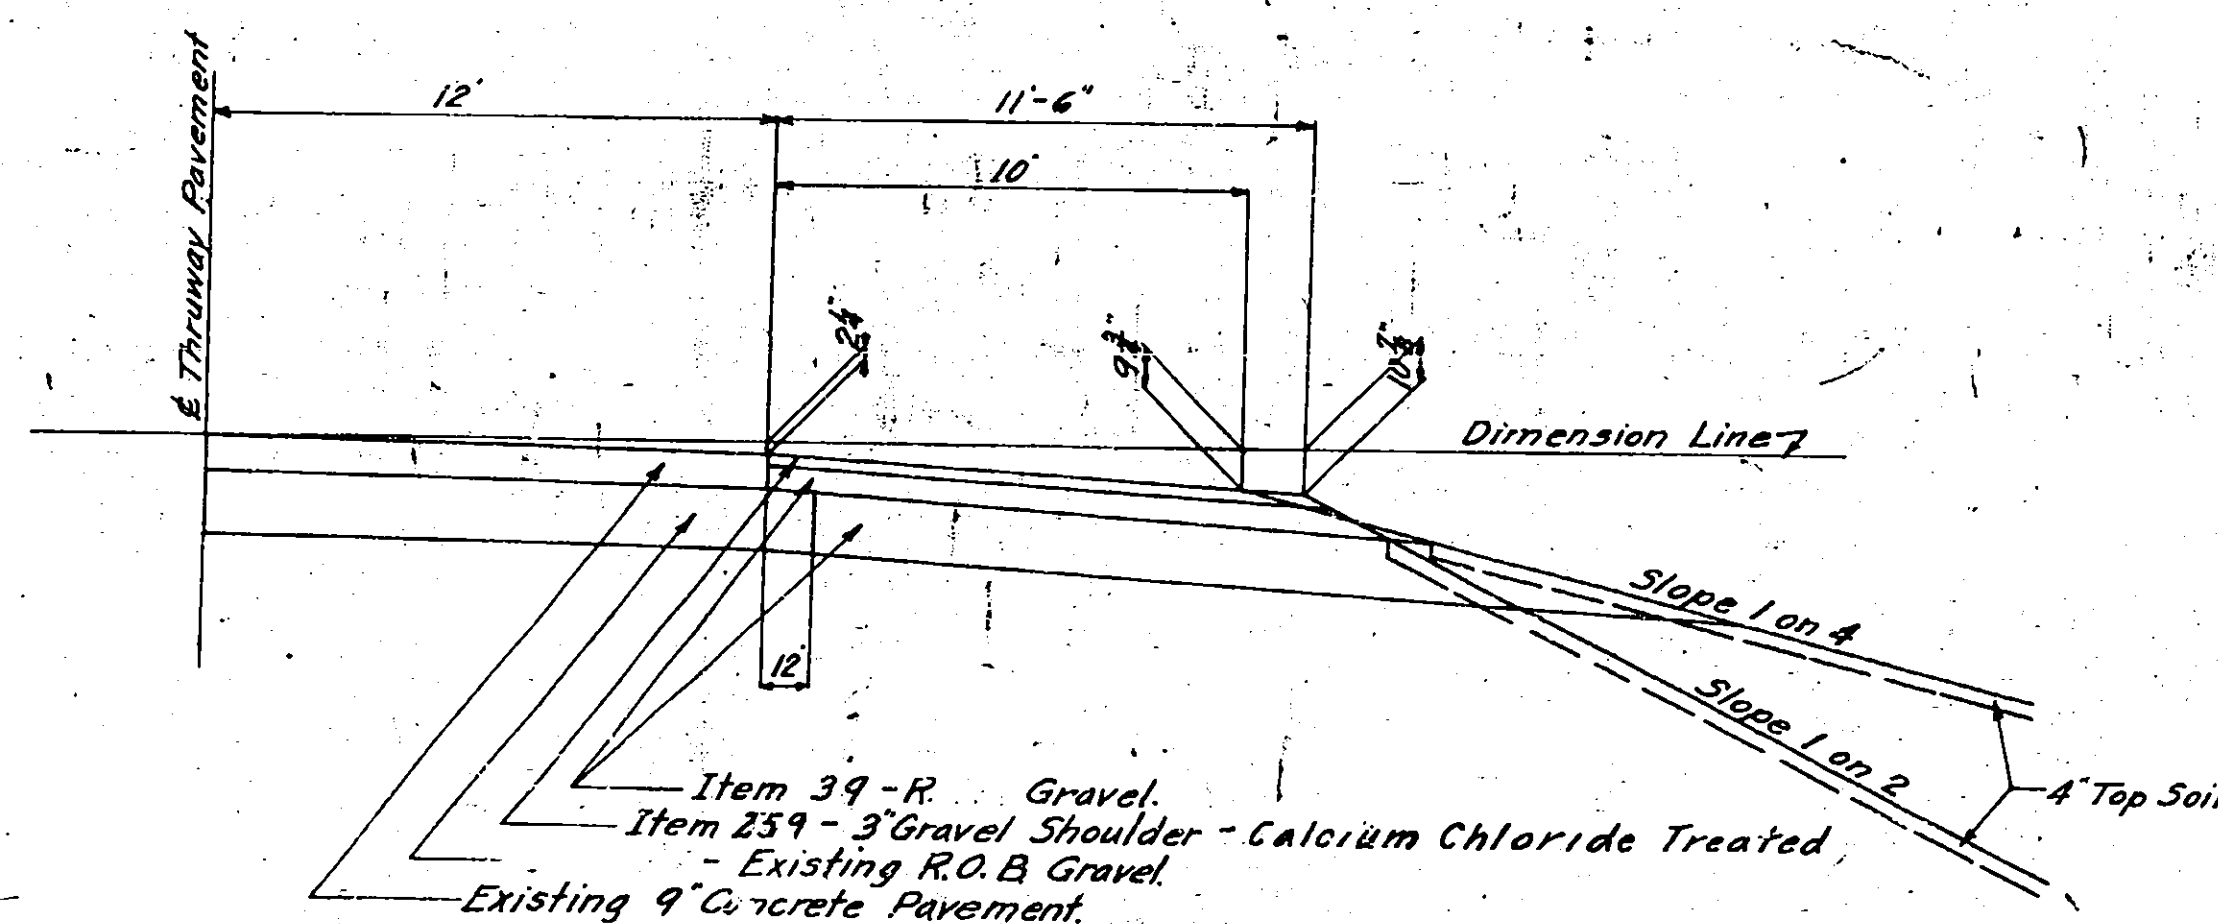

PART SECTION OF THRUWAY
SHOWING SHOULDER TO BE BUILT AFTER
REMOVAL OF TEMPORARY INTERSECTION
Scale 1/4" = 1'-0"

Item 2B - UNCLASSIFIED EXCAVATION
From C.Y.
Road Excavation
Borrow
Remove Temp. Intersection

TOTAL

TABLE of LENGTHS

ROAD		BRIDGE	
Station to Station	Lin. Ft. = Miles	Station to Station	Lin. Ft. = Miles
M 0+00 M 10+77	1077 .204		
M 10+77 M 13+23	797 .151	246 .046	
M 13+23 M 21+20			
TOTAL	1874 .355	246 .046	

Item 32D - OPTIONAL GUIDE RAILING

Station to Station	Side	Anchors	Lin. Ft.
M 6+46 M 10+76	Rt		11
M 10+76 M 16+77	Lt		11
M 16+77 M 16+75	Lt	4 Anchors @ 20	80

TOTAL

DRAINAGE STRUCTURES

Present Structure	Station	REMARKS
24" RCCP - 92' long	M 13+00	Build 2 - 5' headwalls on existing pipe
18" C.M.P. Culv. 50' long	M 11+03	Remove and store.
18" C.M.P. Culv. 40' long	M 18+00	Remove and store.

Made by Traced by Checked by
F.E. White F.E. White J.J. Dwyer & J.J. C. Langdo

Prepared Pursuant to the Highway Law & Recommended by

Date Larry Ketchum
ENGINEER DISTRICT No. 2

SCHEDULE A

M 0+00 - M 9+76	L&R 121A	367 C.Y.	Break in shoulder to end of road section
M 14+23 - M 21+00	L&R 121A	255 C.Y.	ditto
M 0+00 - M 9+76	L&R 123	0.97 Acres	Edge of pavement to end of road section
M 14+23 - M 21+00	L&R 123	0.68 Acres	ditto
M 7+00 - M 9+76	L&R 124	292 S.Y.	Sodded berm gutters and slope channels
M 14+23 - M 17+00	L&R 124	293 S.Y.	ditto
M 7+00 - M 10+76	L&R IWA	7 M Gal.	In areas where Item 124 is used.
M 13+23 - M 17+00	L&R IWA	7 M Gal.	ditto
From BRIDGE PLANS			
M 9+76 - M 10+76	L&R 121A	115 C.Y.	Break in shoulder to end of road section
M 13+23 - M 14+23	L&R 121A	115 C.Y.	ditto
M 9+76 - M 10+76	L&R 123B	0.21 Acres	Edge of pavement to end of road section
M 13+23 - M 14+23	L&R 123B	0.21 Acres	ditto
M 9+76 - M 10+76	L&R 124	330 S.Y.	Sodded berm gutters, slope channels and horizontal stripes
M 13+23 - M 14+23	L&R 124	330 S.Y.	ditto
TOTAL	121A	622 C.Y.	Neat)
		700 C.Y.	Rounded) Highway
TOTAL	121A	230 C.Y.	Neat)
		253 C.Y.	Rounded) Bridge
TOTAL	123	1.65 Acres	Neat)
		1.80 Acres	Rounded) Highway
TOTAL	123B	0.42 Acres	Neat)
		0.46 Acres	Rounded) Bridge
TOTAL	124	585 S.Y.	Neat)
		650 S.Y.	Rounded) Highway
TOTAL	124	660 S.Y.	Neat)
		726 S.Y.	Rounded) Bridge
TOTAL	IWA	14 M Gal.	Neat
		14 M Gal.	Rounded

SCHEDULE B

DETAIL SPECIFICATIONS TO ACCOMPANY PUBLIC WORKS SPECIFICATIONS

1W	FURNISHING WATER EQUIPMENT
IWA	APPLYING WATER
a	Areas - See Schedule A.
	Rates - As specified.
121A	TOPSOIL FURNISHED AND PLACED
a	Areas - See Schedule A.
c1	Subgrade scarified as directed by Engineer.
c3	Topsoil Thickness - 4 inches loose measure
123	SEEDING
a	Areas - See Schedule A.
b	Seeds - See Schedule D.
	Fertilizer - M-55, Type No.2 (10-10-10)
	Mulch - M-59, Hay or M-60, Straw
c2	No inoculation required for Alsike Clover.
c3	Rate of Seeding - 50 lbs. pure live seed per acre.
	Rate of Fertilizer - 600 lbs. per acre.
c4	Rate of Mulch - 2 tons per acre.
123B	SEEDING ON PREPARED AREAS
a	Areas - See Schedule A.
124	SODDING
a	Areas - See Schedule A.
c3	Sodding shall be as shown on Standard Sheet 50-34, Bridge Plans, or as directed by Engineer.

SCHEDULE C

DETAIL SPECIFICATIONS FOR PLANTS

FED. ROAD DIST. NO. STATE PROJ. NO. YEAR SHEET NO. 45 67

ROADSIDE DEVELOPMENT SHEET

MOHAWK THRUWAY
GEES ROAD

SCHEDULE D

DETAIL SPECIFICATIONS FOR SEEDS

NAME	PURITY	GERMINATION	POUNDS PURE LIVE SEED	FEET
Creeping Red Fescue (Festuca rubra)	Commercial		95	75 25
Redtop (Agrostis alba)	Commercial		90	85 10
Perennial Ryegrass (Lolium perenne)	Commercial		95	75 7
Alsike Clover (Trifolium hybridum)	Commercial	Max. 25% hard seed	95	85 3
Wild White Clover (Trifolium repens var.)	Kent Wild, N.Y.	Wild, N. Zealand Wild	95	95 5
		Max. 25% hard seed		
		RATE		50

SUMMARY

121A	953 C.Y.	Topsoil furnished and placed
123	1.80 Acres	Seeding
123B	0.46 Acres	Seeding on Prepared Areas
124	1376 S.Y.	Sodding
IWA	14 M Gals.	Applying Water
1W	Nec.	Furnishing Water Equipment



A. Dittler

K. Keil

F. L. White


Larry Ketchum

Fed. Rd. Div. No.	State	Fed. Aid Proj. No.	COUNTY	Sheet No.	Total Sheets
	N.Y.		MADISON	46	67
MOHAWK THRUWAY					
NORTH CHITTENANGO - CANASTOTA					
GEES ROAD 'M' LINE					

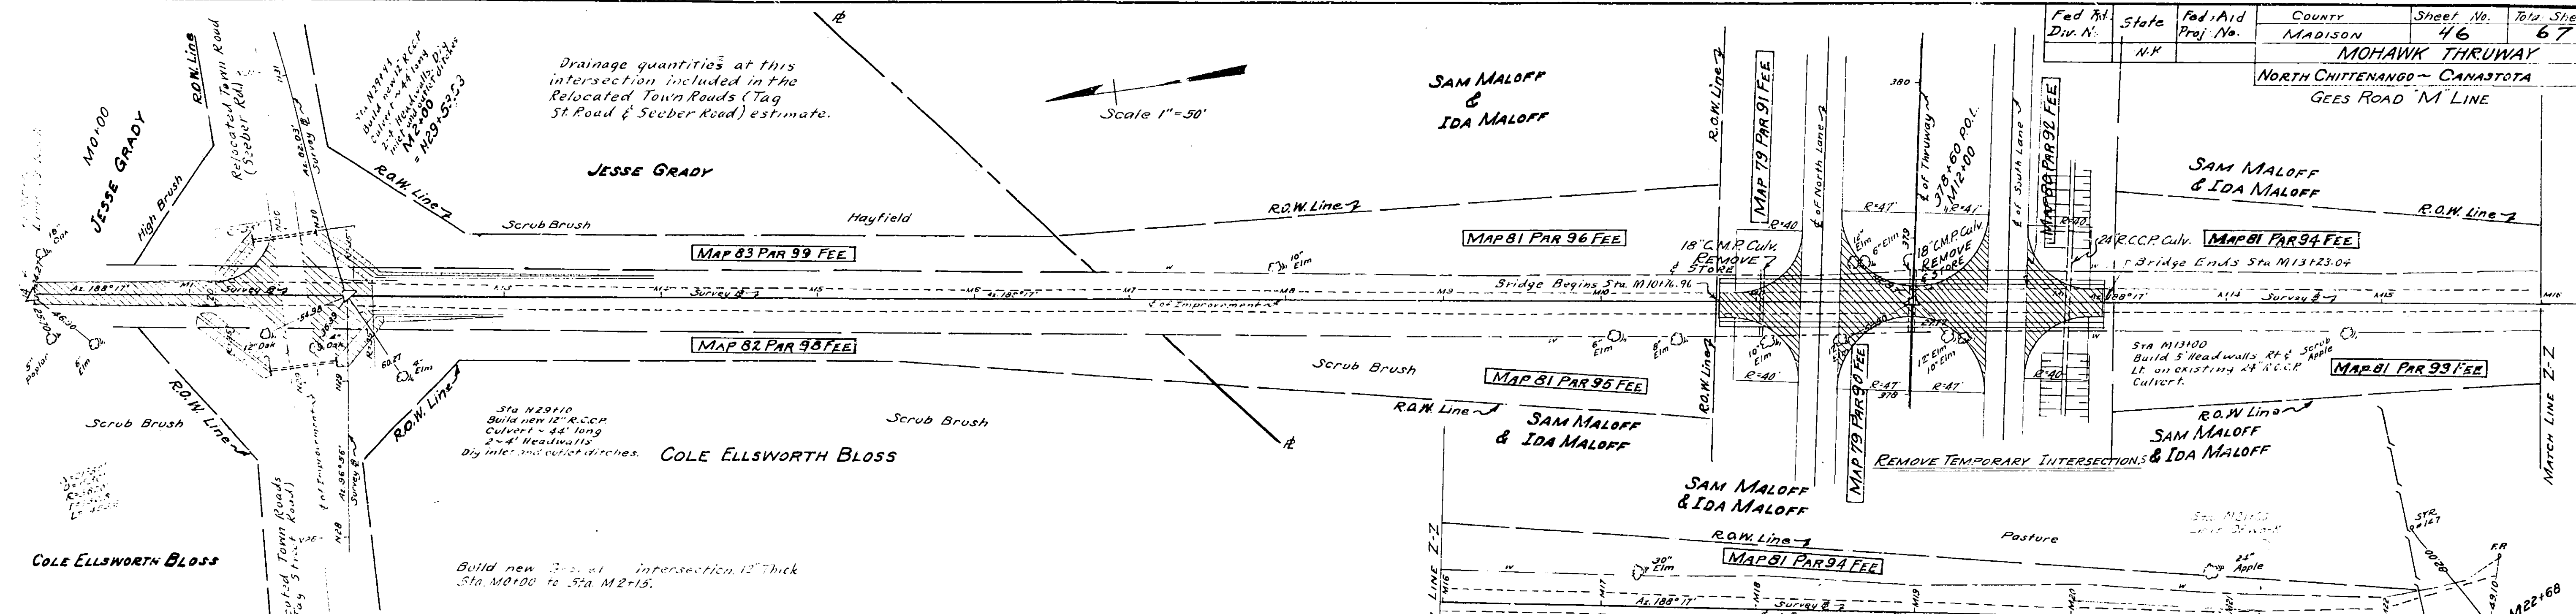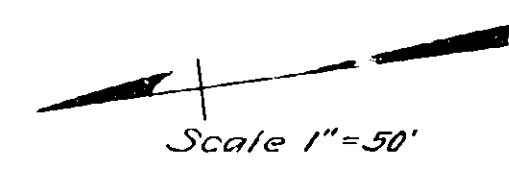

After the grade separation structure at Gees Road is completed and opened to traffic and before final acceptance of the contract, the temporary intersections at Tag Street (Sta. 352+70 C.L. = L 21+10 C.L.) and Town Road (Sta. 421+25 C.L. = N 87+09.5 C.L.) shall be removed, temporary structures removed, the Thruway repaved so as to present an appearance similar to the adjacent section of the Thruway, and a standard barrier built on each side of the Thruway.

Payment for this work will be made under the appropriate items.

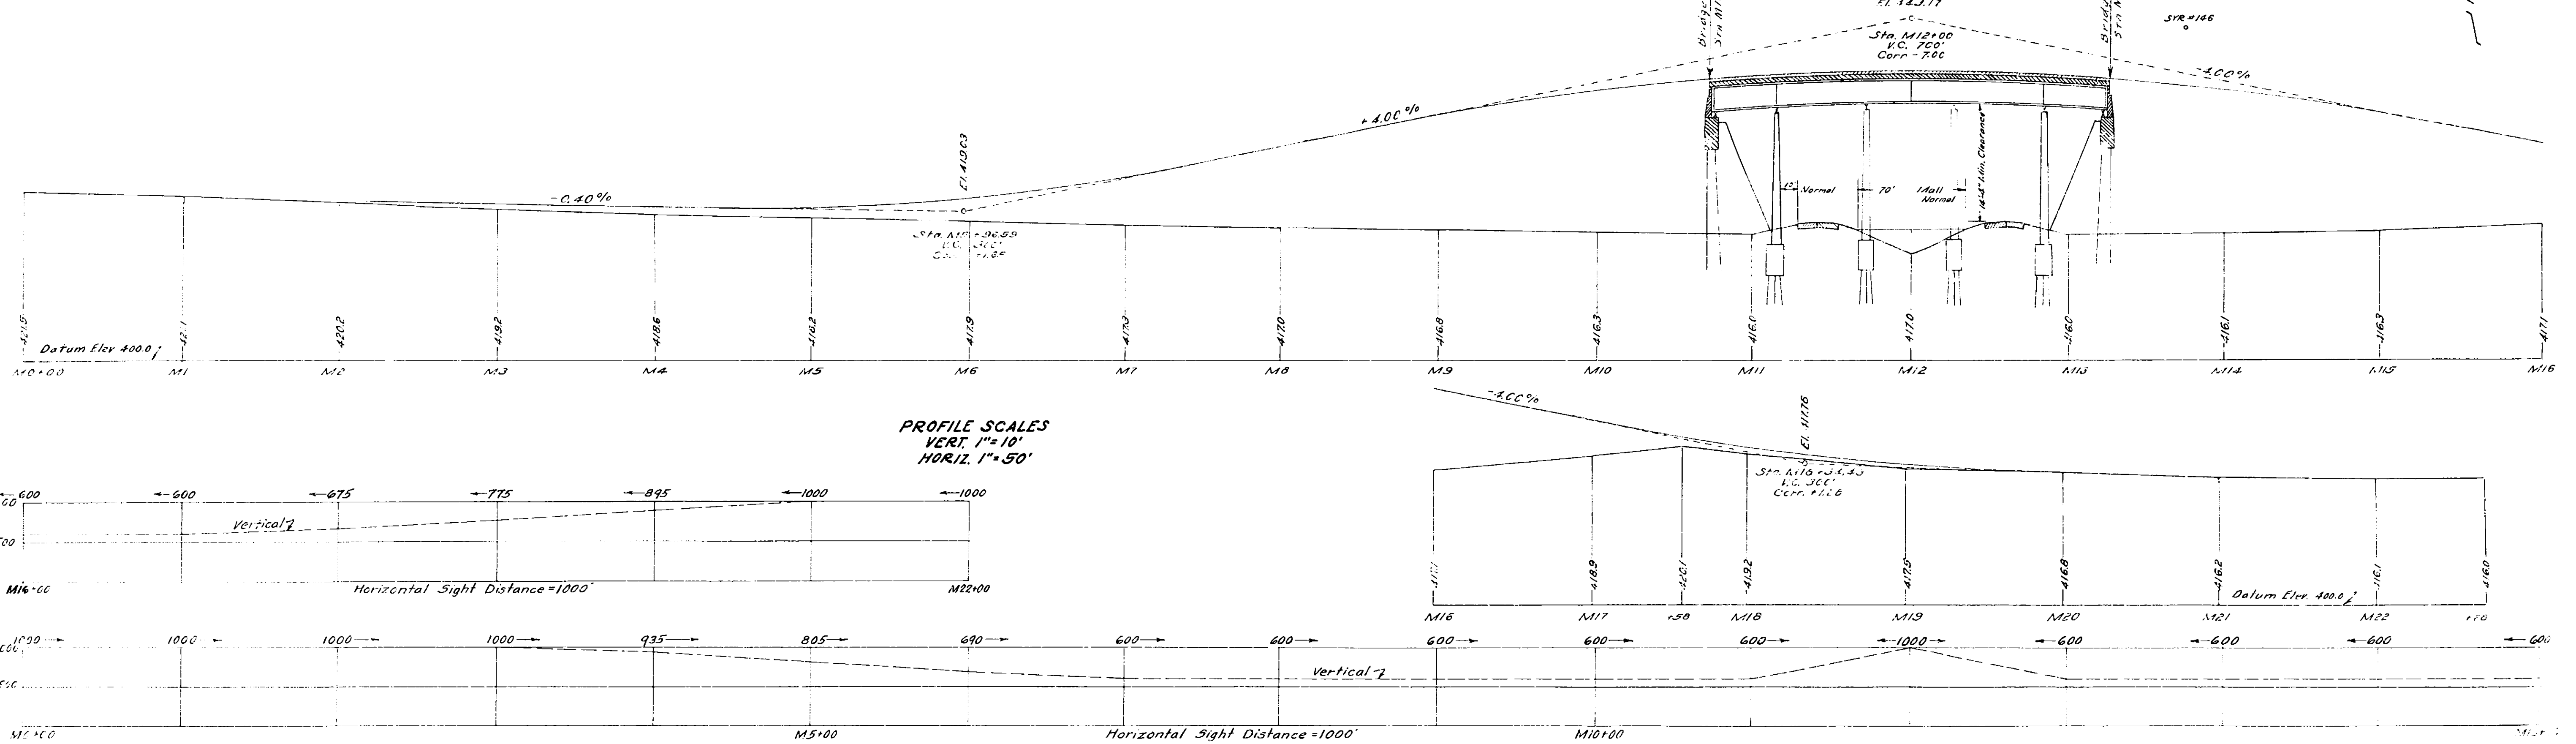


Made by: J. H. Ryan
Traced by: A. E. Keil
Checked by: J. H. Ryan
PLAN: J. H. Ryan
PROFILE: J. H. Ryan


SIGHT DISTANCE GRAPH
4.5 to 4.5

Prepared pursuant to the highway law & recommended by
Date: 10/1/50
Engineer: J. H. Ryan
District: 1

Fed. Rd. Div. No.	State	Fed. Aid Pct. No.	County	Sheet No.	Total Sheets
N.H.	N.H.		MADISON	46	67
MOHAWK THRUWAY					
NORTH CHITTENANGO - CANASTOTA					
GEES ROAD 'M' LINE					



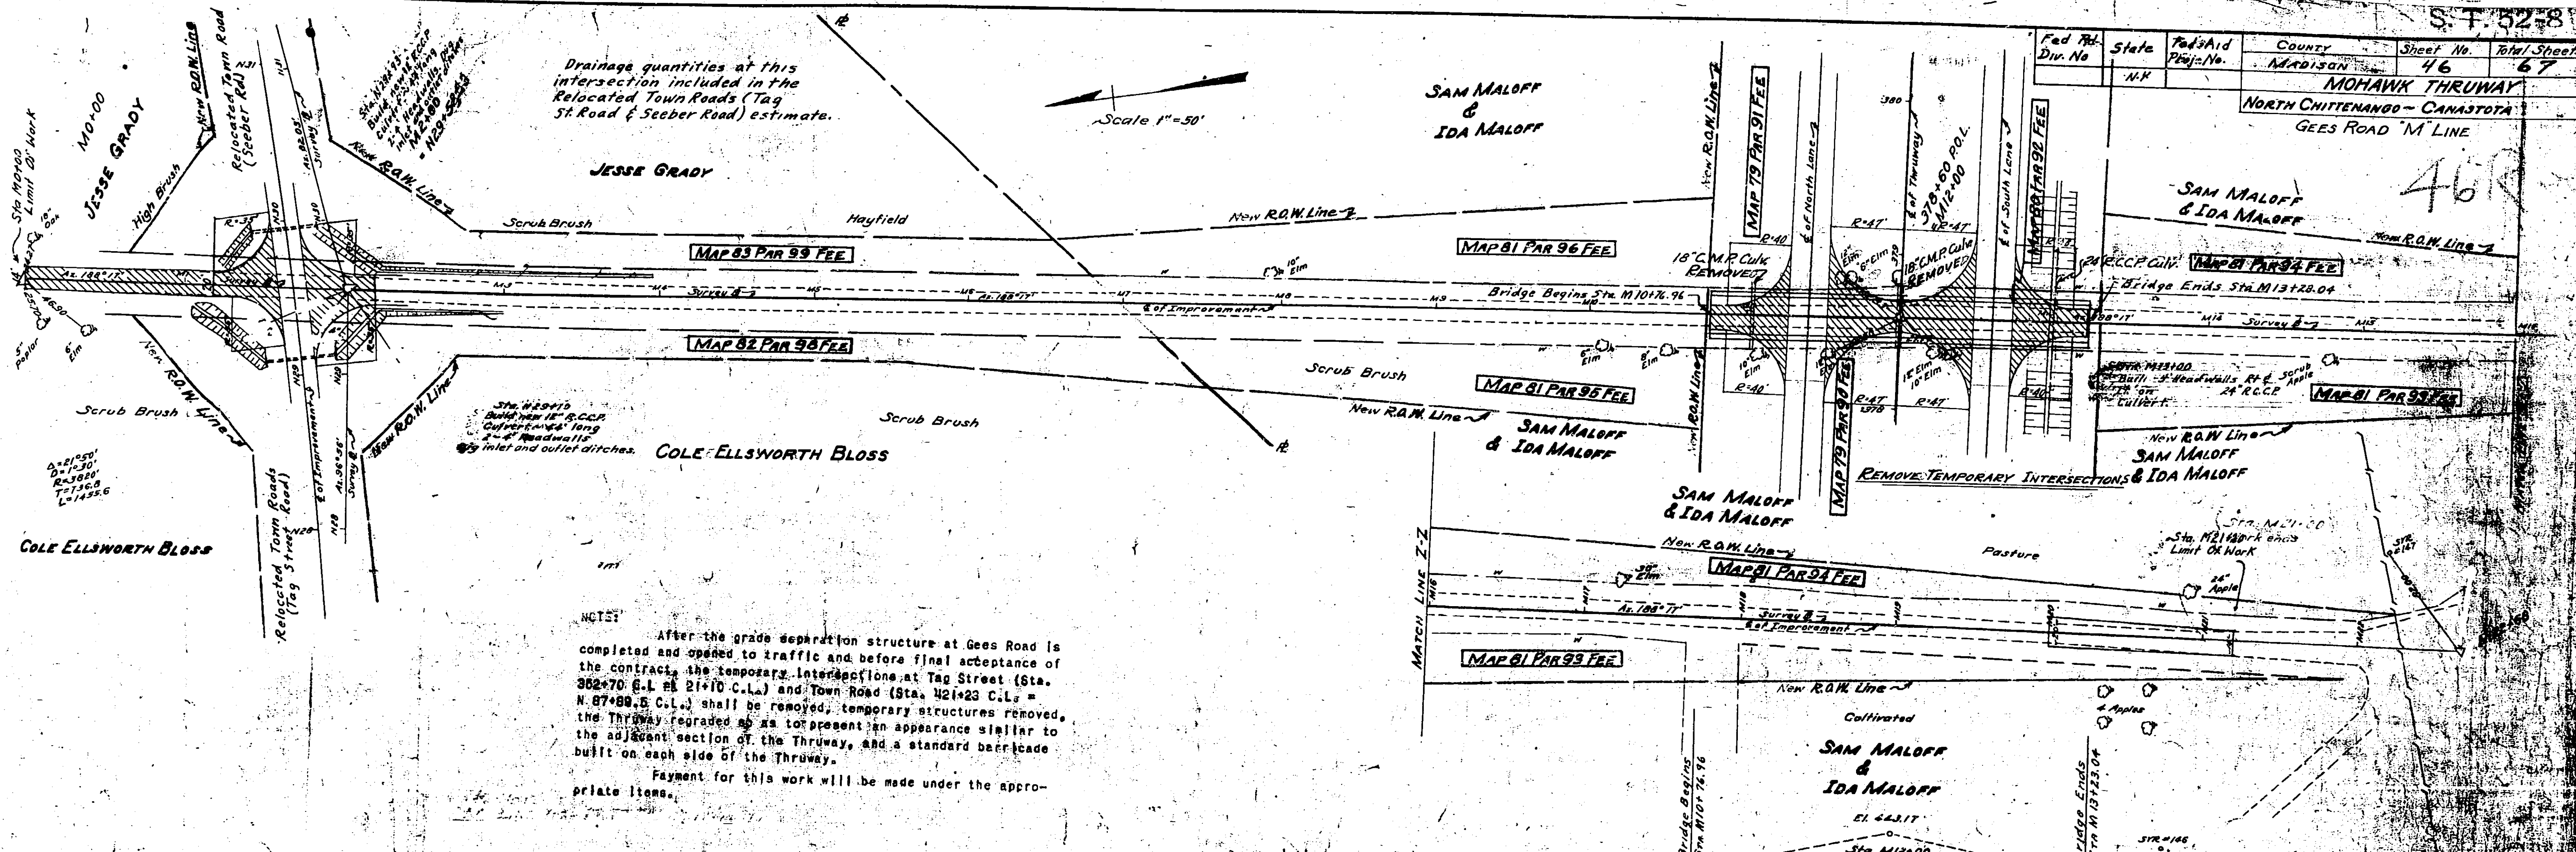


NOTES:
After the grade separation structure at Gees Road is completed and opened to traffic and before final acceptance of the contract, the temporary intersections at Tag Street (Sta. 362+70 C.L. at 21+10 C.L.) and Town Road (Sta. 421+23 C.L. at N. 87+80 C.L.) shall be removed, temporary structures removed, the Thruway regraded as to present an appearance similar to the adjacent section of the Thruway, and a standard barricade built on each side of the Thruway.
Payment for this work will be made under the appropriate items.

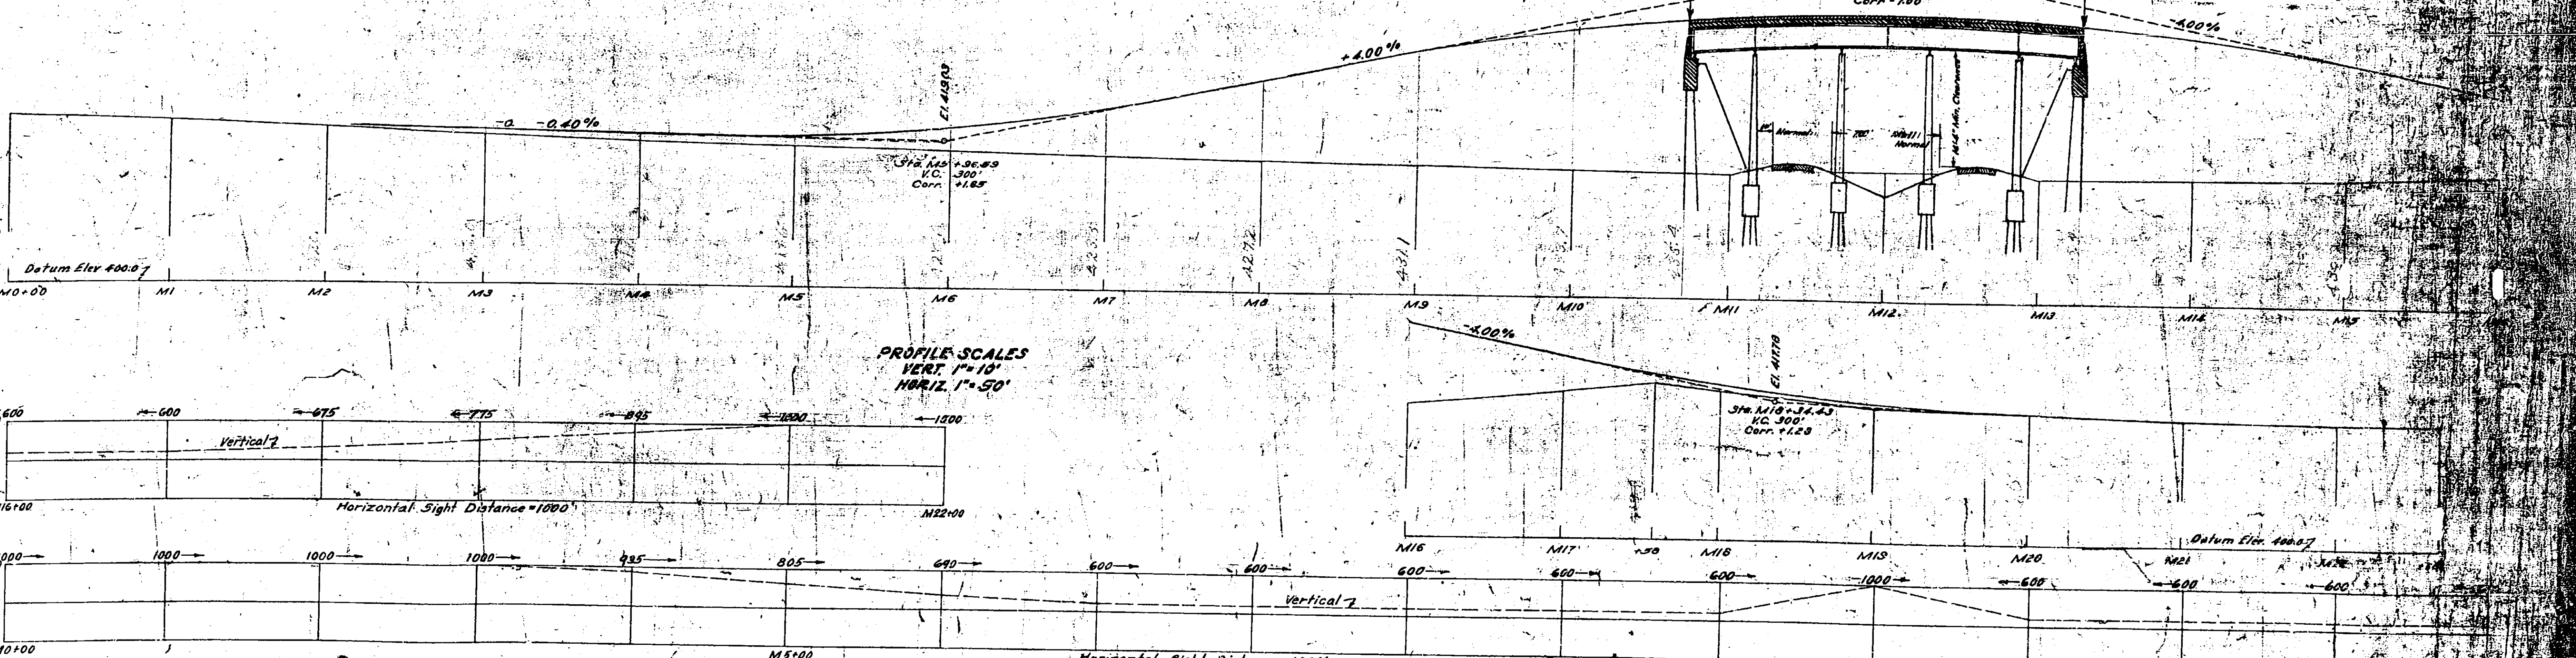

FED. AID DIST. NO.	STATE	FED. AID PROJ. NO.	FISCAL YEAR	SHEET NO.	TOTAL SHEETS
	N. Y.			47	67
MOHAWK			THRUWAY		
FROM			TO		
MADISON			COUNTY		

*This portion of Item 121, 123B & 124
to be included in Bridge Estimate.*

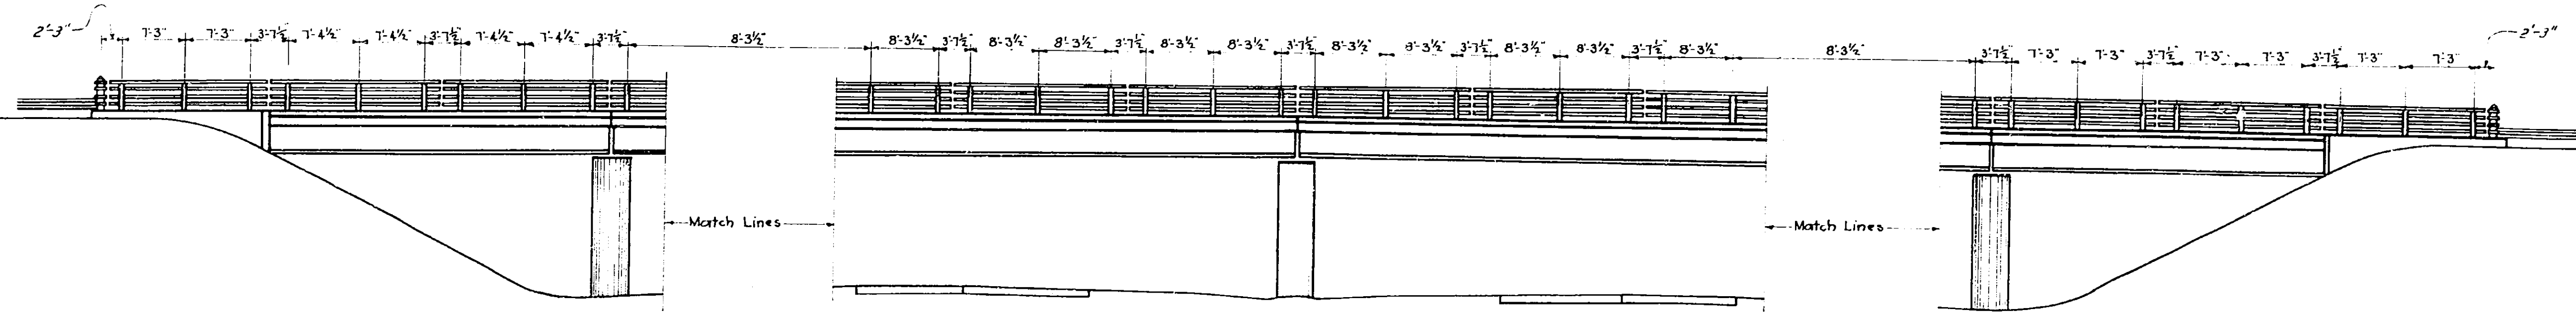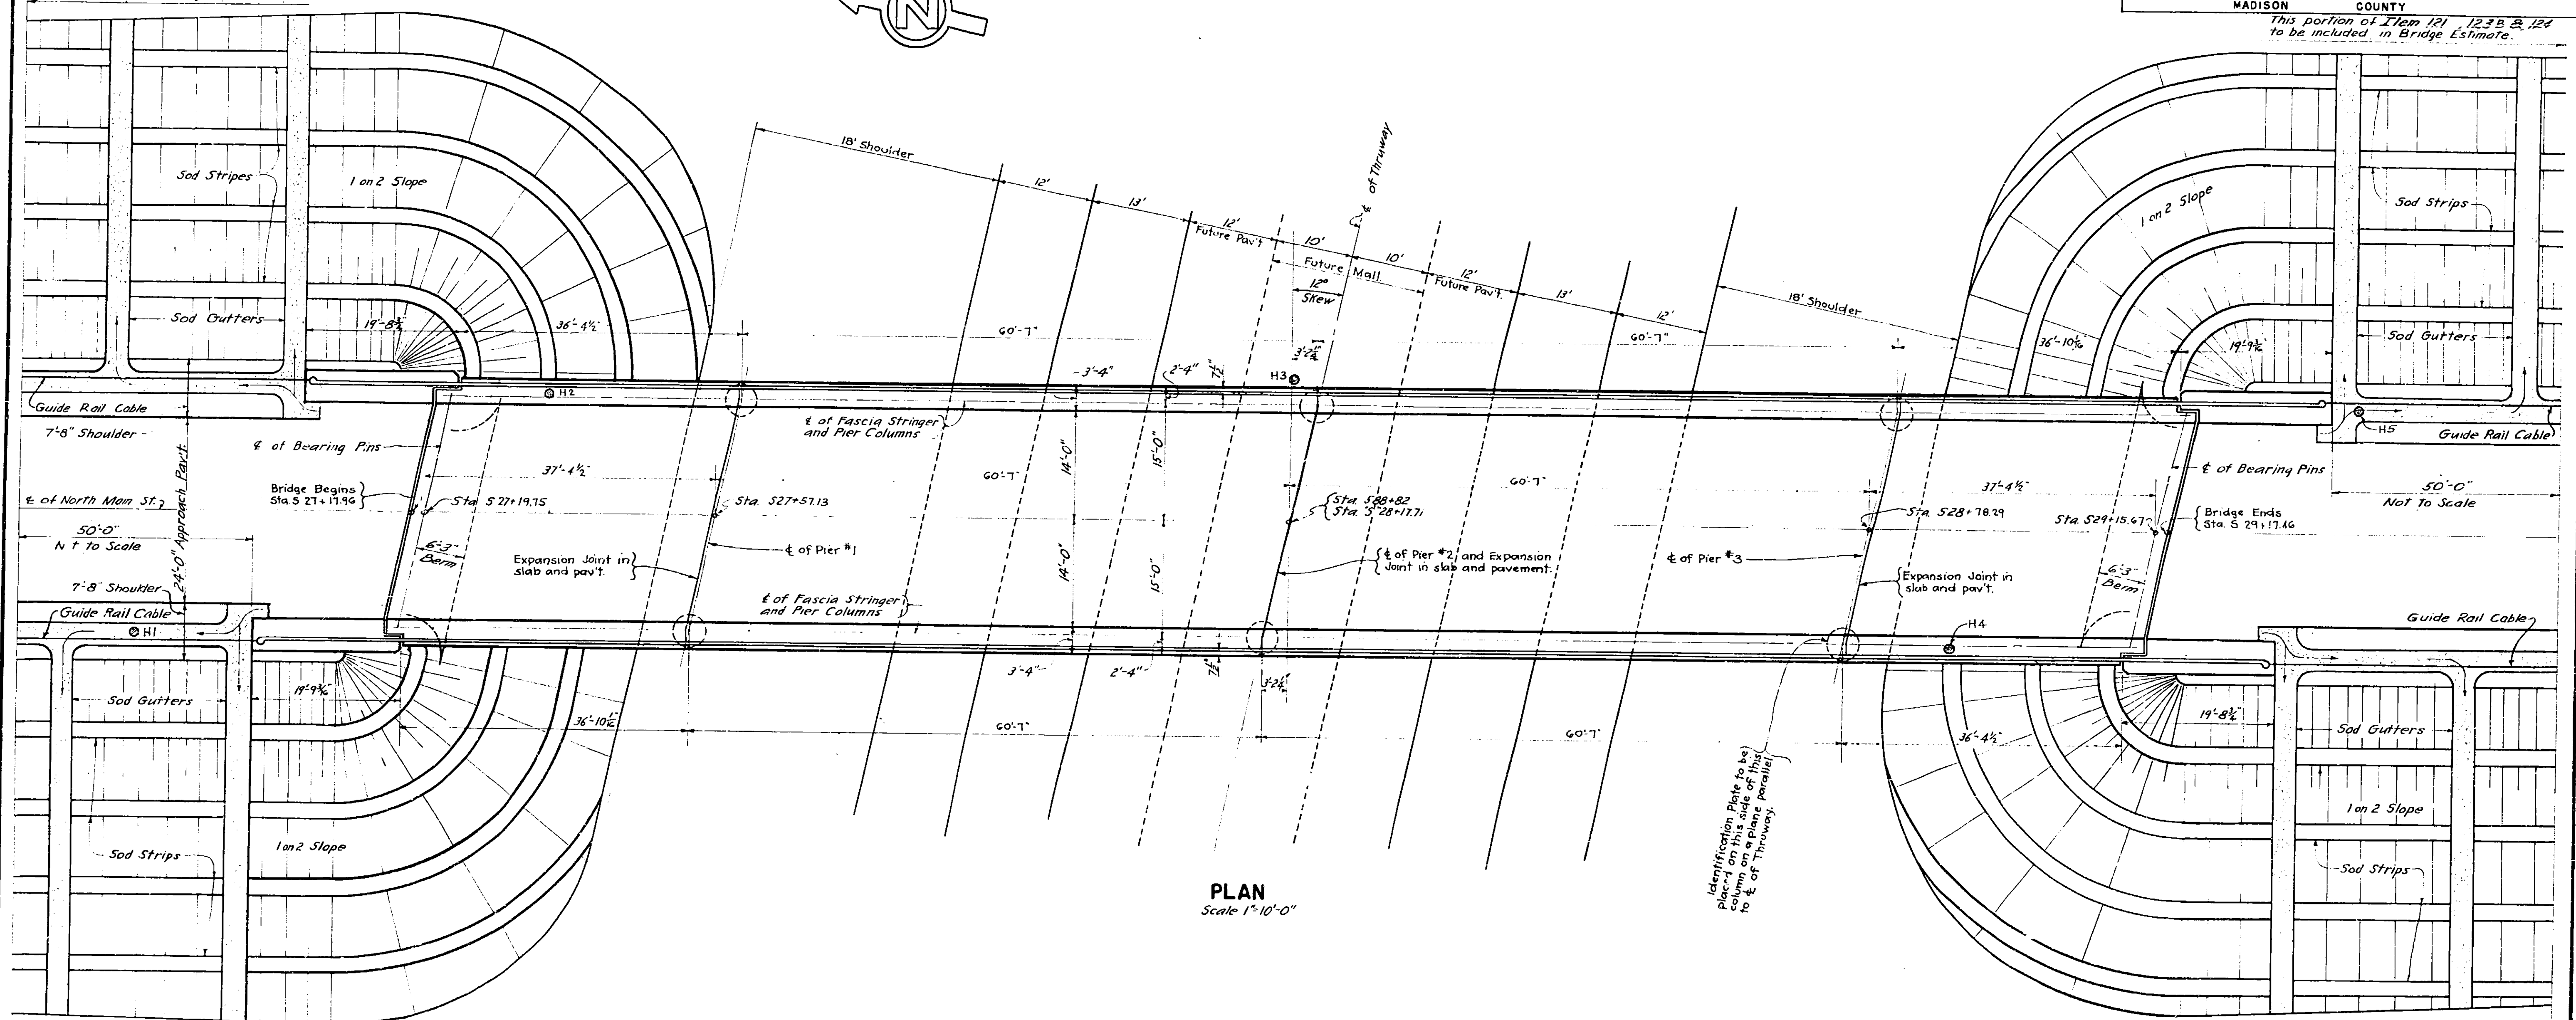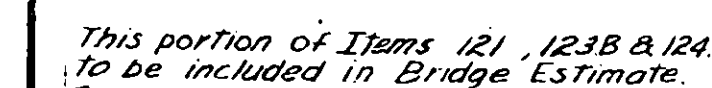


NORTH MAIN STREET
STA. 588 + 82
LAYOUT PLAN AND
ARCHITECTURAL ELEVATION


grm 1/1 9/13
checked by photo 4/51

C. M. ... 5:50
graff
Buck
A. 2: Green
graff

FED. AID DIST. NO.	STATE	FED. AID PROJ. NO.	FISCAL YEAR	SHEET NO.	TOTAL SHEETS
	N. Y.			48	67
FROM			TO		
MADISON			COUNTY		

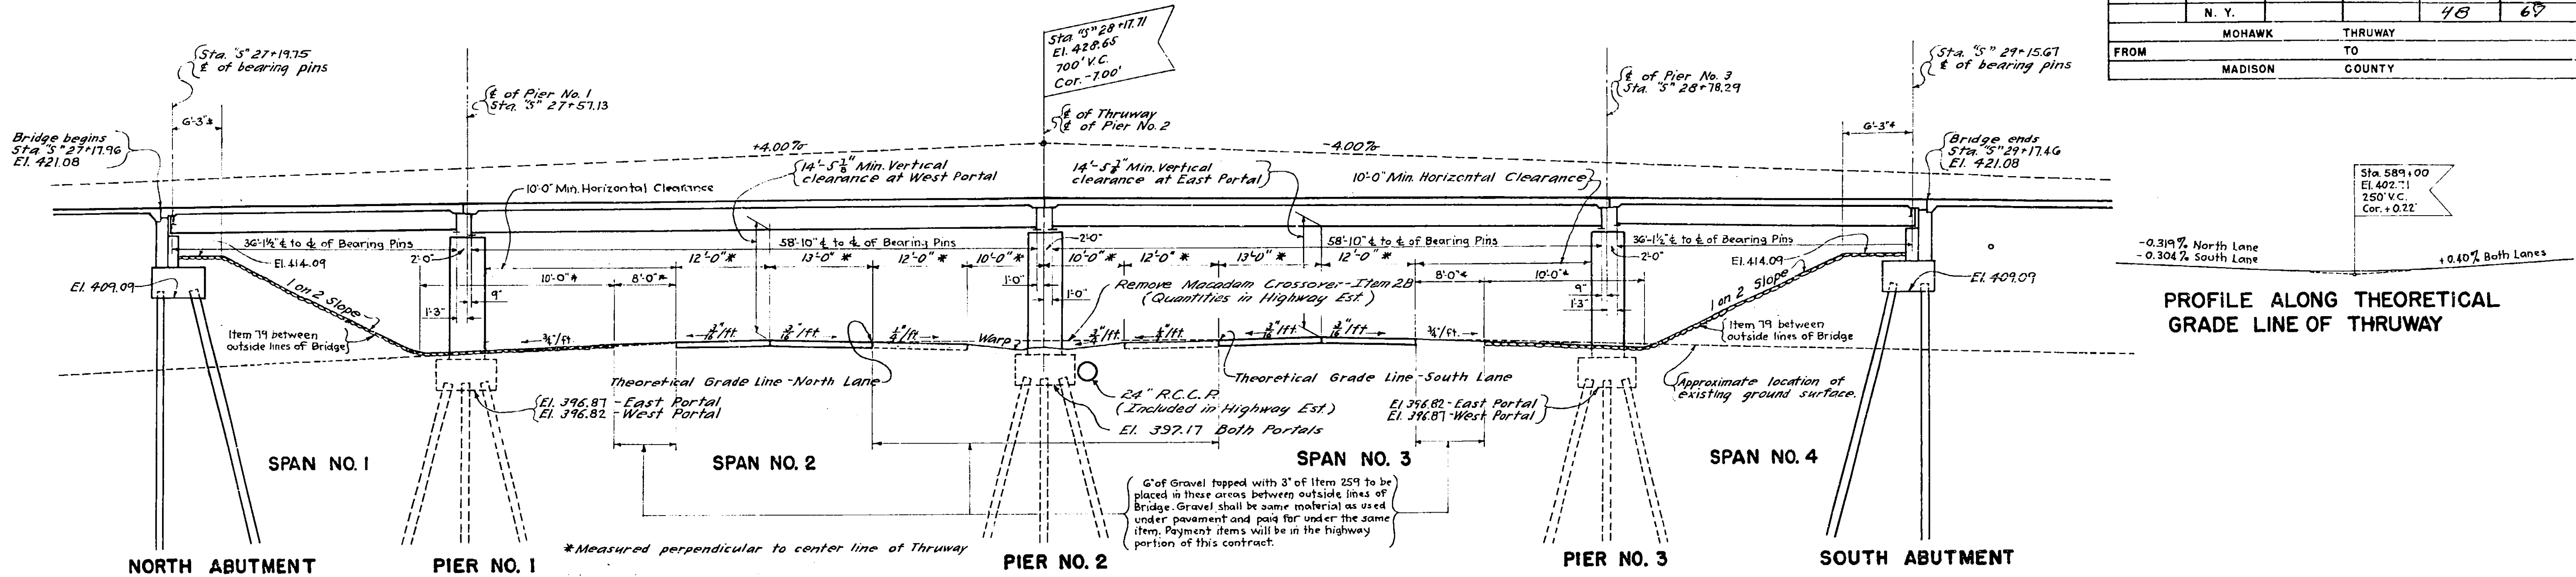

PROFILE ALONG & OF NORTH MAIN STREET
Scale: 1" = 10'-0"

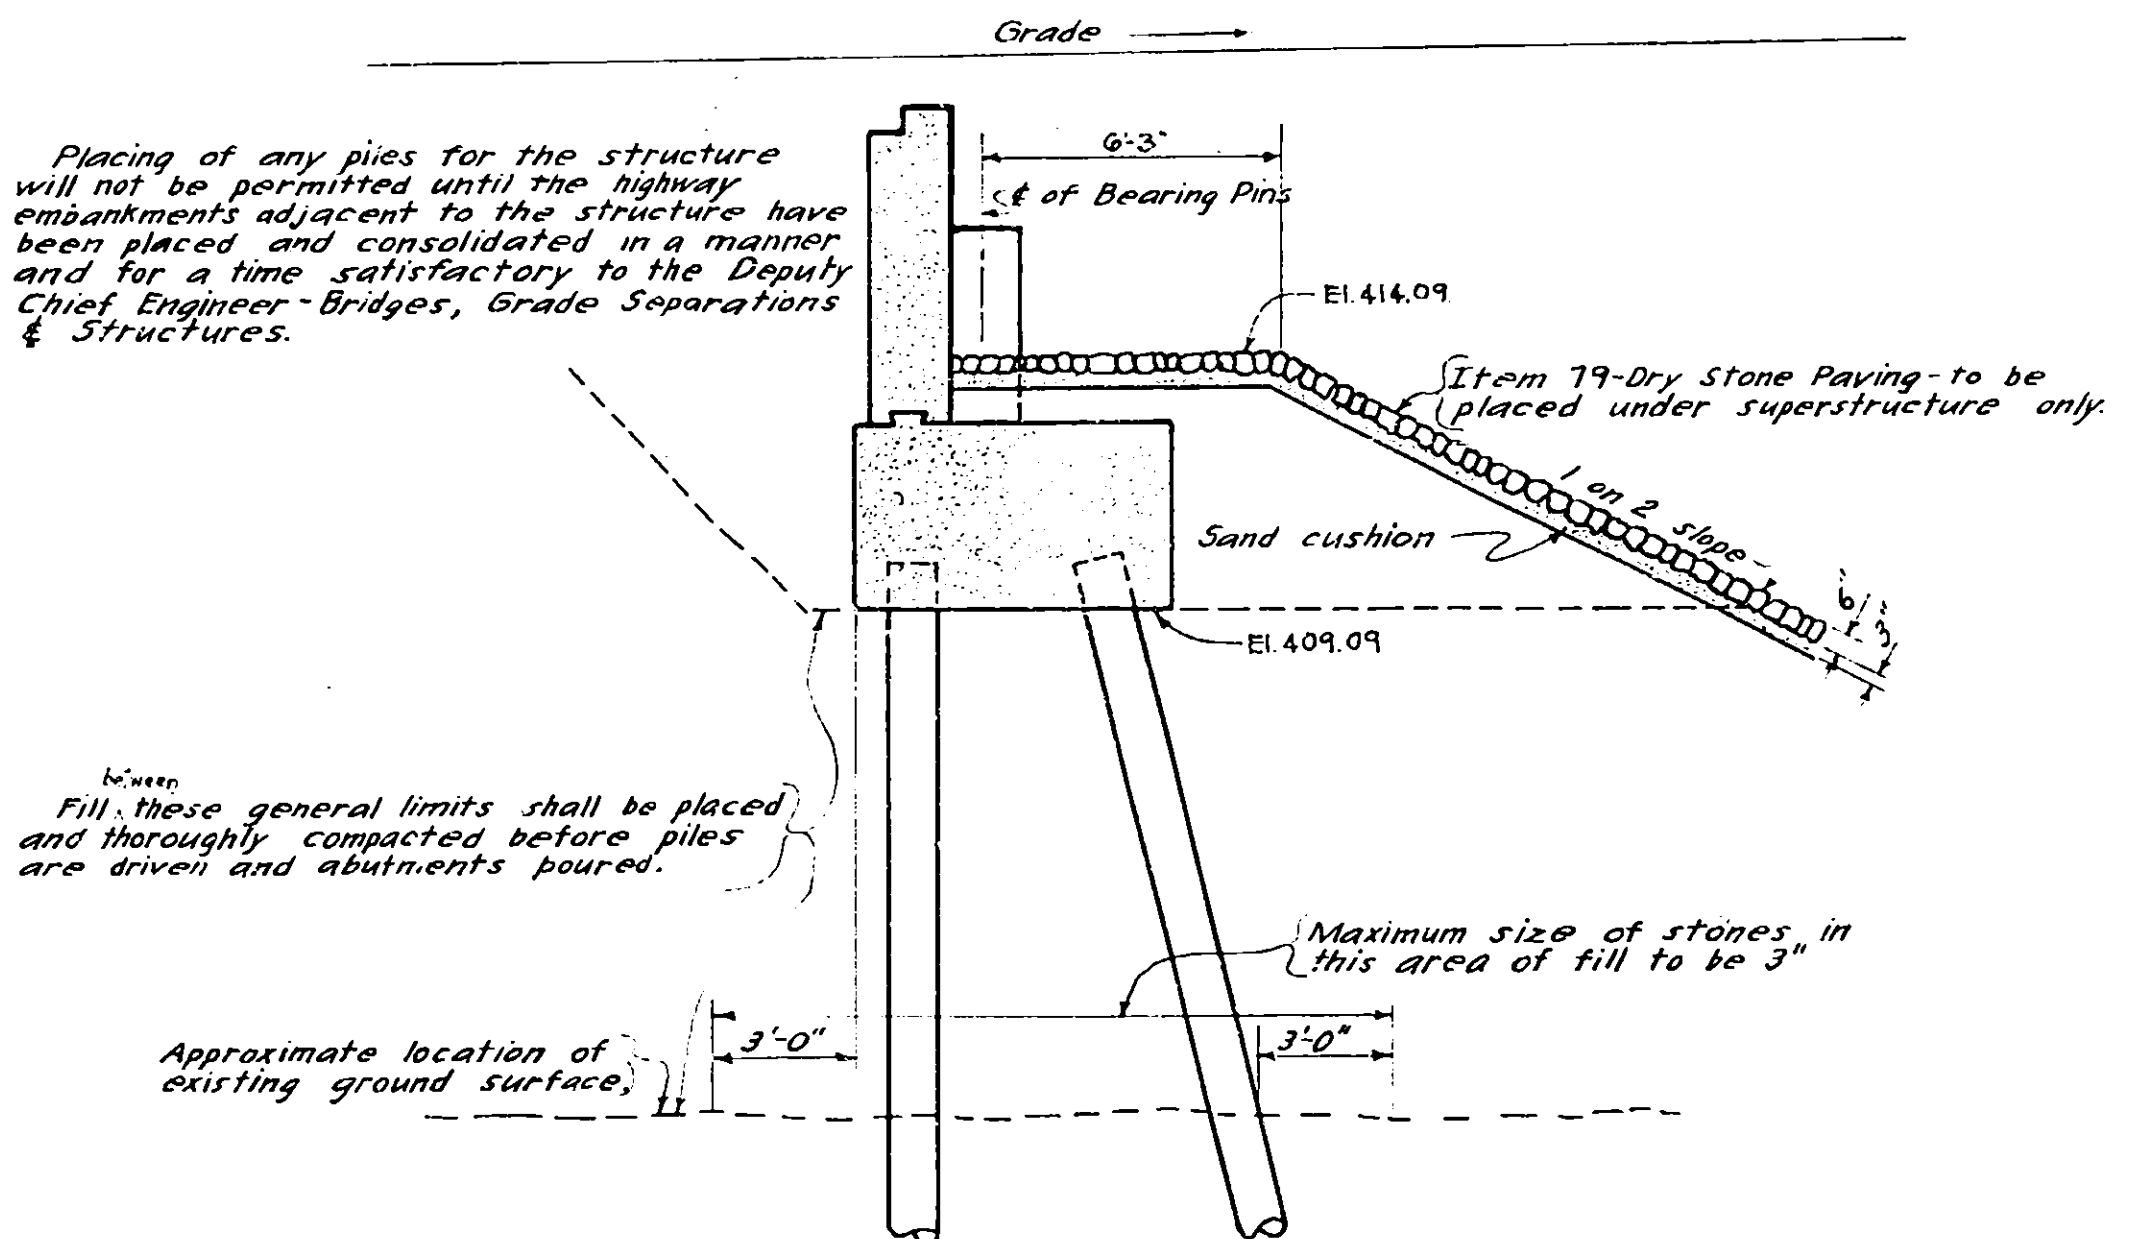

DETAIL OF EMBANKMENT AND BACKFILL AT ABUTMENT

GENERAL NOTES



All rivets to be 3/4".
All holes to be 1/2" unless otherwise noted.

Concrete in abutments and Piers shall be Item 20.
Concrete in superstructure except for pavement shall be Item 18.
Concrete in pavement shall be Item 47B.
The cost of furnishing and installing caulking compound, premoulded bituminous joint material, sponge rubber joint material, lead wool, copper flashing and Item 11B shall be included in the prices bid for the various items in this contract.
Materials and Fabrication - Specifications of New York State Department of Public Works dated Jan. 2, 1951 and current modifications and additions.
Design Specifications - AASHO 1945 - Loading H20-44 and current modifications.

No construction joints other than those shown on the plans will be permitted without the written permission of the Deputy Chief Engineer.
Where caulking compound is to be used the sides of the joints shall be primed with a material satisfactory to the manufacturer of the caulking compound, 20 to 30 minutes before the compound is placed. All joints must be thoroughly clean and dry before the priming coat is applied. Work must be performed by workmen experienced in this type of work. Caulking Compound must comply with D.P.W. Specs. M-35.


ESTIMATE OF QUANTITIES				
ITEM NO.	DESCRIPTION	UNIT	NEAT	ROUNDED
5	Trench Culvert & Bridge Excavation	C.Y.	118	140
15-2	Portland Cement Type 2	Bbl.	1172	1269
15-N	Natural Cement Type N	Bbl.	168	181
18	Class 1B Concrete For Structures	C.Y.	187	216
20	Class 1 Concrete	C.Y.	368	405
25 F	Steel Fabric Reinforcement	S.Y.	783	920
28	Bar Reinforcement for Structures	Lb.	90180	95000
28A	Spiral Bar Shear Connectors	Lb.	1507	1600
29	Structural Steel	Lb.	183131	189000
37	Metal Railing	L.F.	466	470
"B"	Cement Concrete Pavement	C.Y.	69	74
79	Dry Stone Paving	S.Y.	336	370
85C	Cast in Place Concrete Piles	L.F.	1260	1500
87	Furnishing Equipment for Driving Piles	L.S.	Nec.	Nec.
121	Topsoil Placed from Stockpiles	C.Y.	274	300
123 B	Seeding on Prepared Areas	Acre	0.51	10
124	Sodding	S.Y.	658	690

A Waterproofing Oil Treatment as specified in M-41W shall be applied to all exposed surfaces of concrete except the underside of Slab and top of Pierment.
A Waterproofing Oil Treatment as specified in M-41S shall be applied to the top of Pierment.
Where steel exceeding one inch in thickness is to be welded, mild steel arc-welding electrodes with covering of low hydrogen type shall be used. These electrodes must comply with ASTM (A 233-48T) requirements for Classification E 6015 or E 6016.
For design purposes the assumed load per pile does not exceed 30 Tons.
For Identification Plate details see Standard Sheet No. 52-41.
Sponge Rubber shall comply with A.S.T.M. - Specs. D 544.
The cost of furnishing and placing water used for wetting down top of slab, sodding and seeding will be paid for under Items 1 W and 1 WA of the highway portion of this contract.

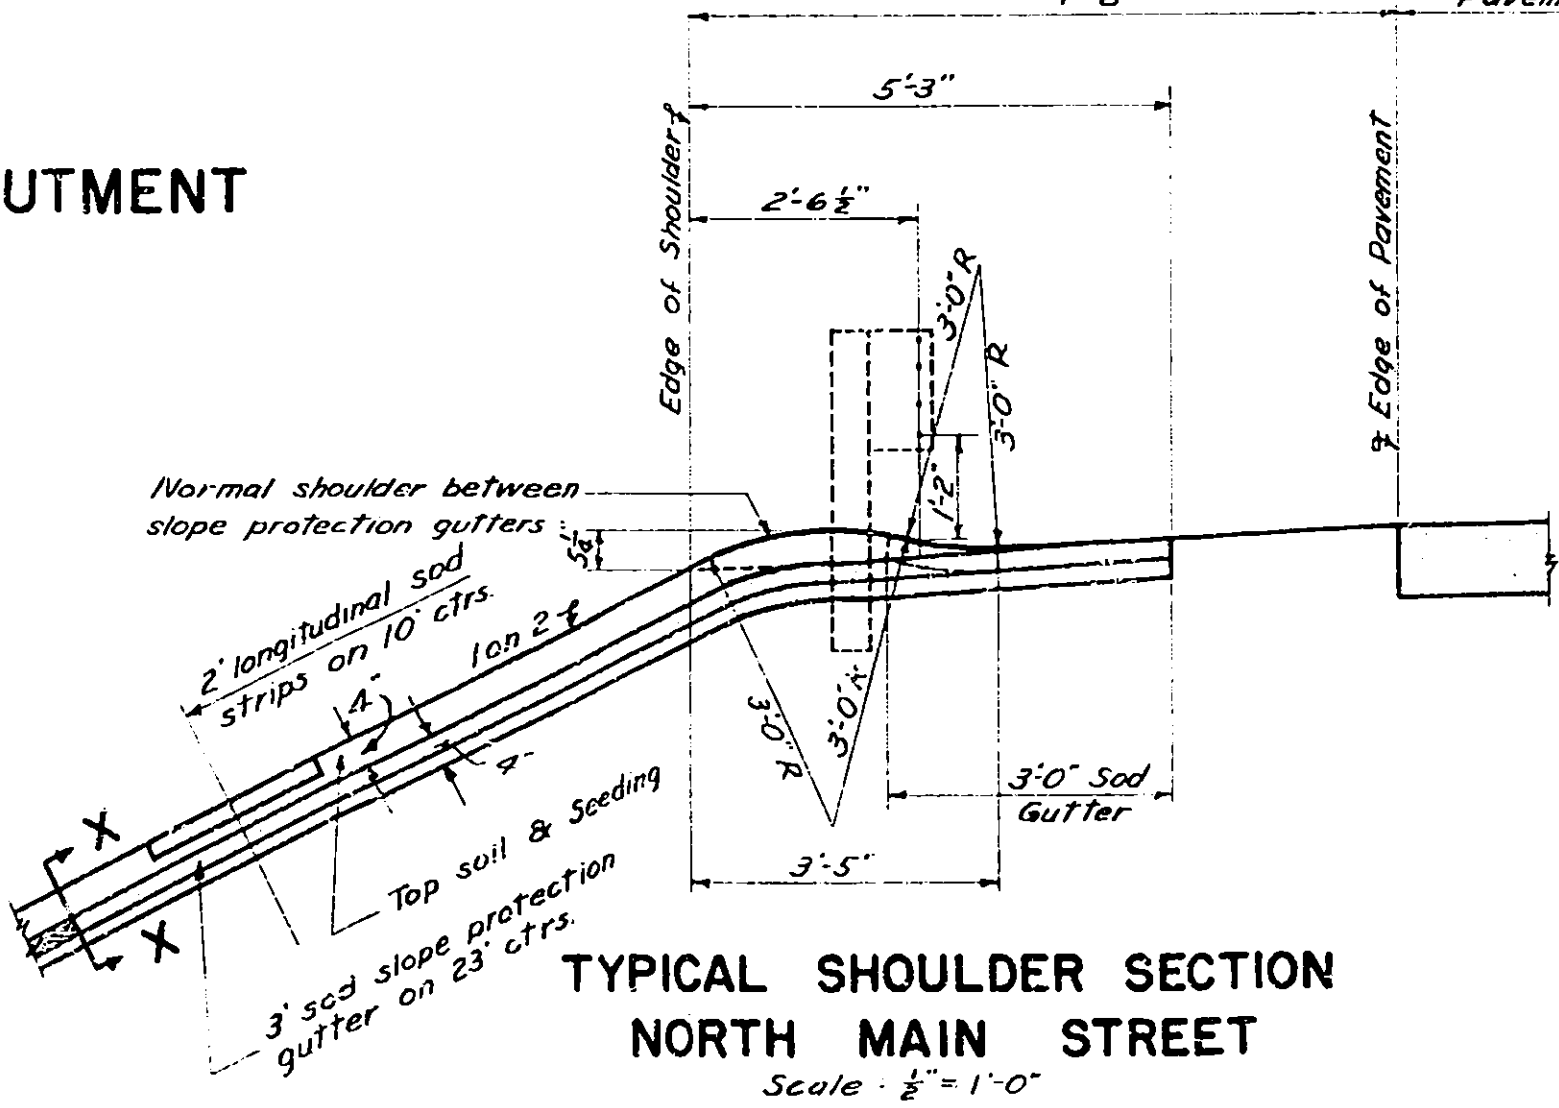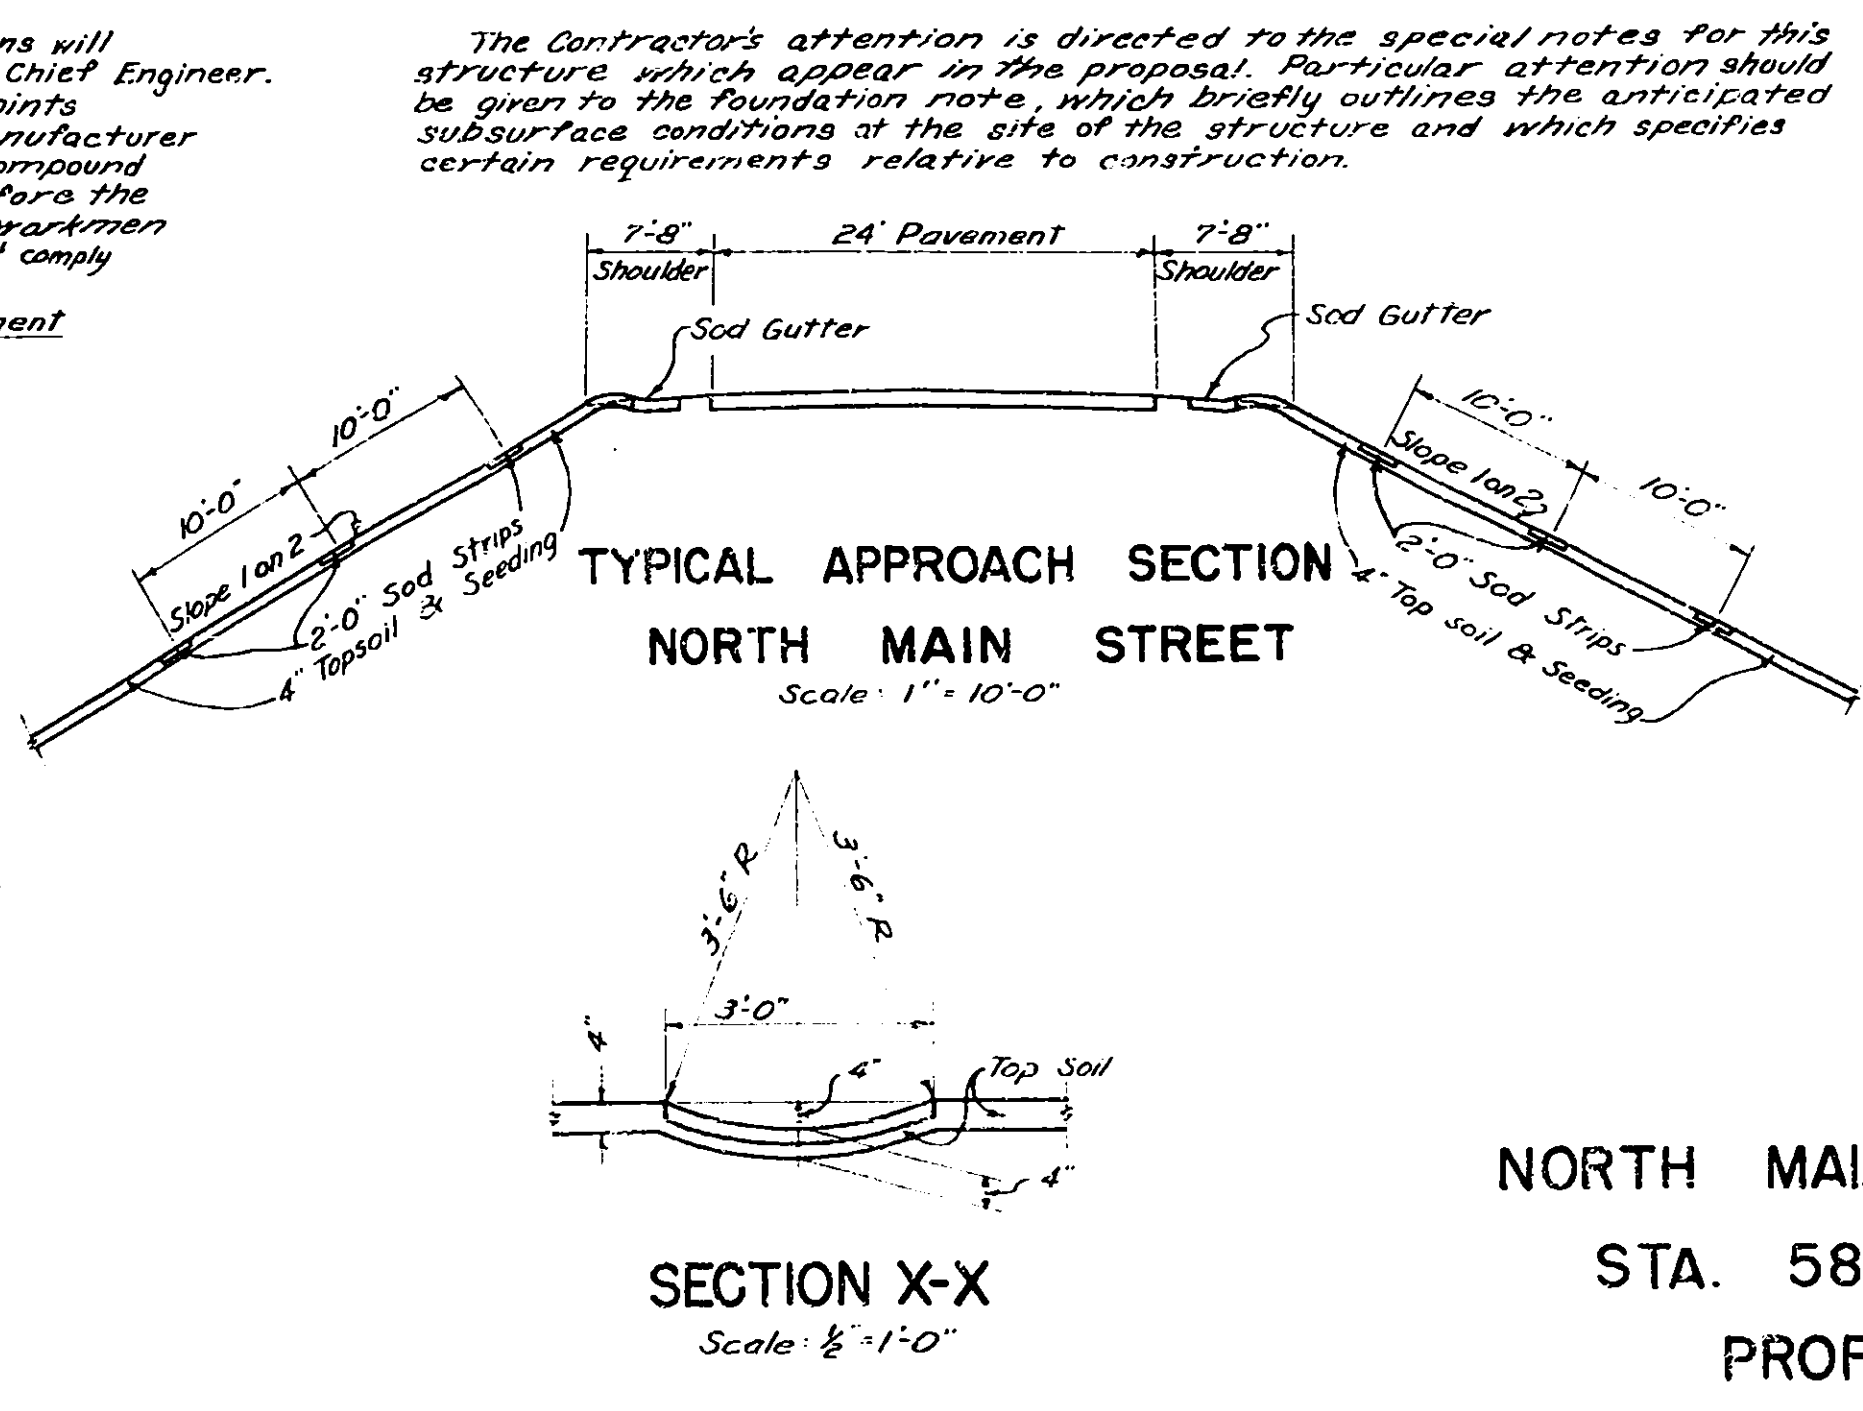


NORTH MAIN STREET
STA. 588 + 82
PROFILE

FED. AID DIST. NO.	STATE	FED. AID PROJ. NO.	FISCAL YEAR	SHEET NO.	TOTAL SHEETS
	N. Y.			48	67
FROM MADISON COUNTY			THRUWAY TO		

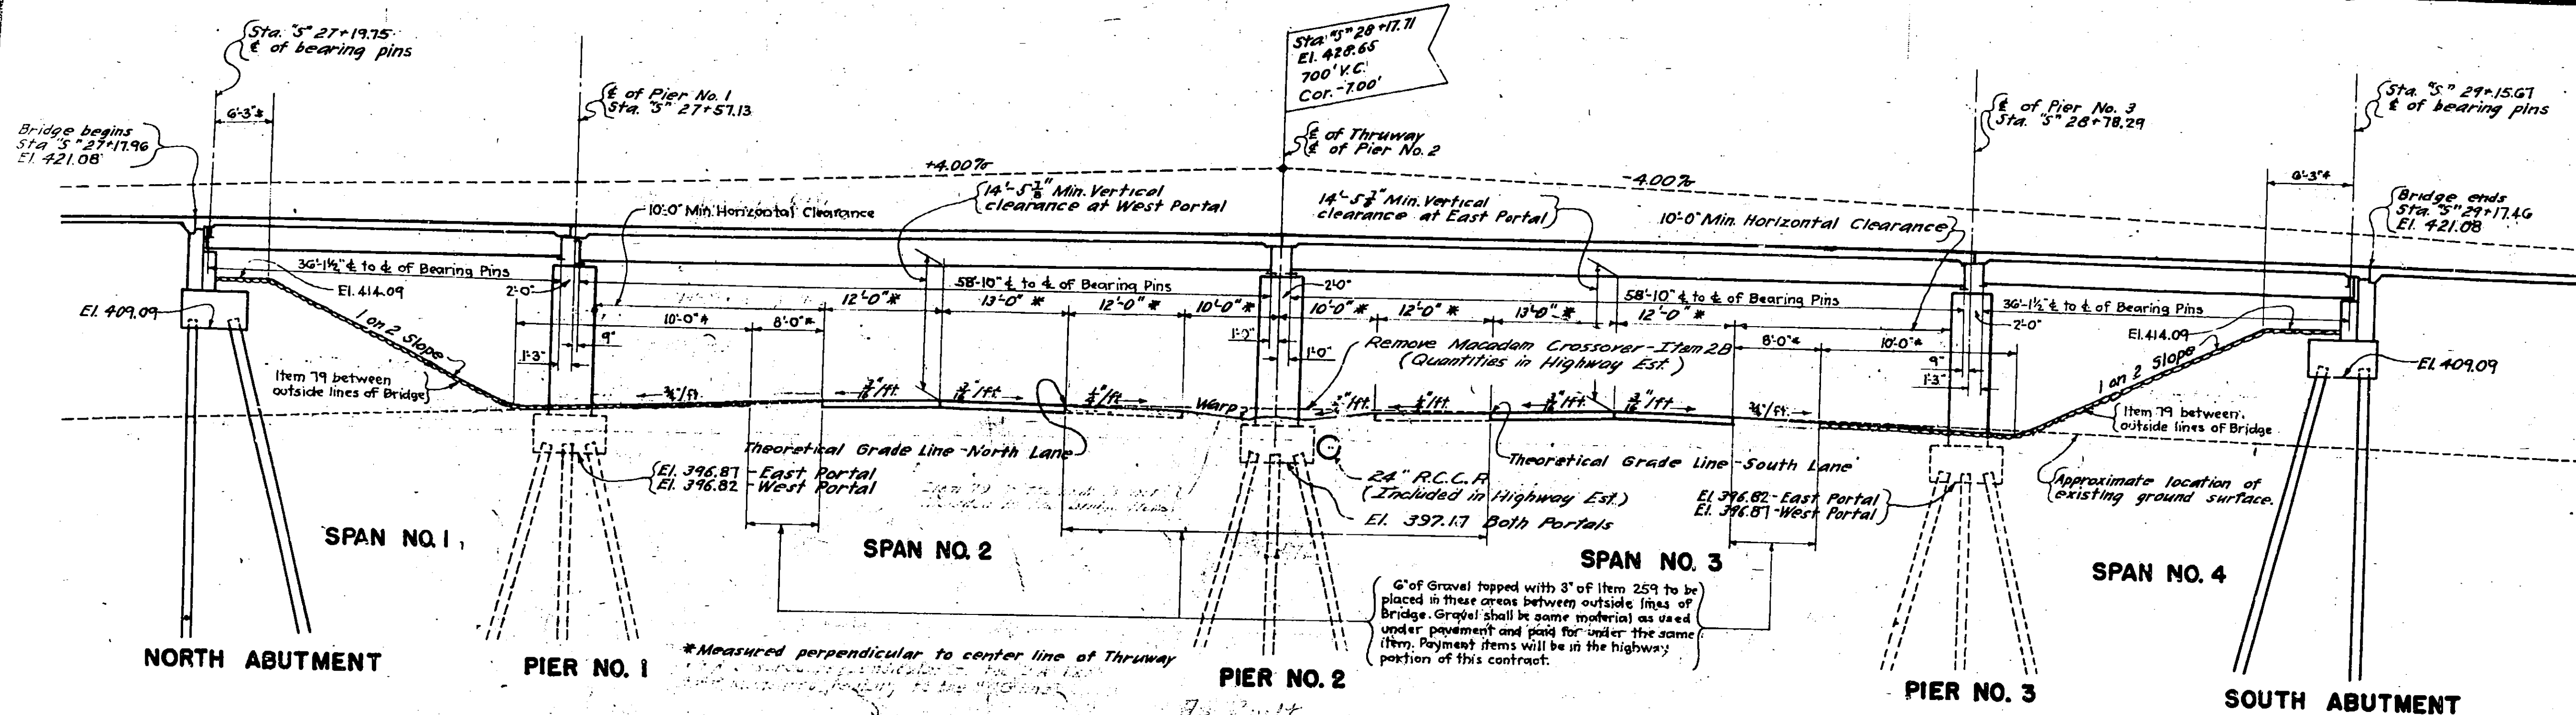

PROFILE ALONG THEORETICAL GRADE LINE OF THRUWAY

PROFILE ALONG E OF NORTH MAIN STREET

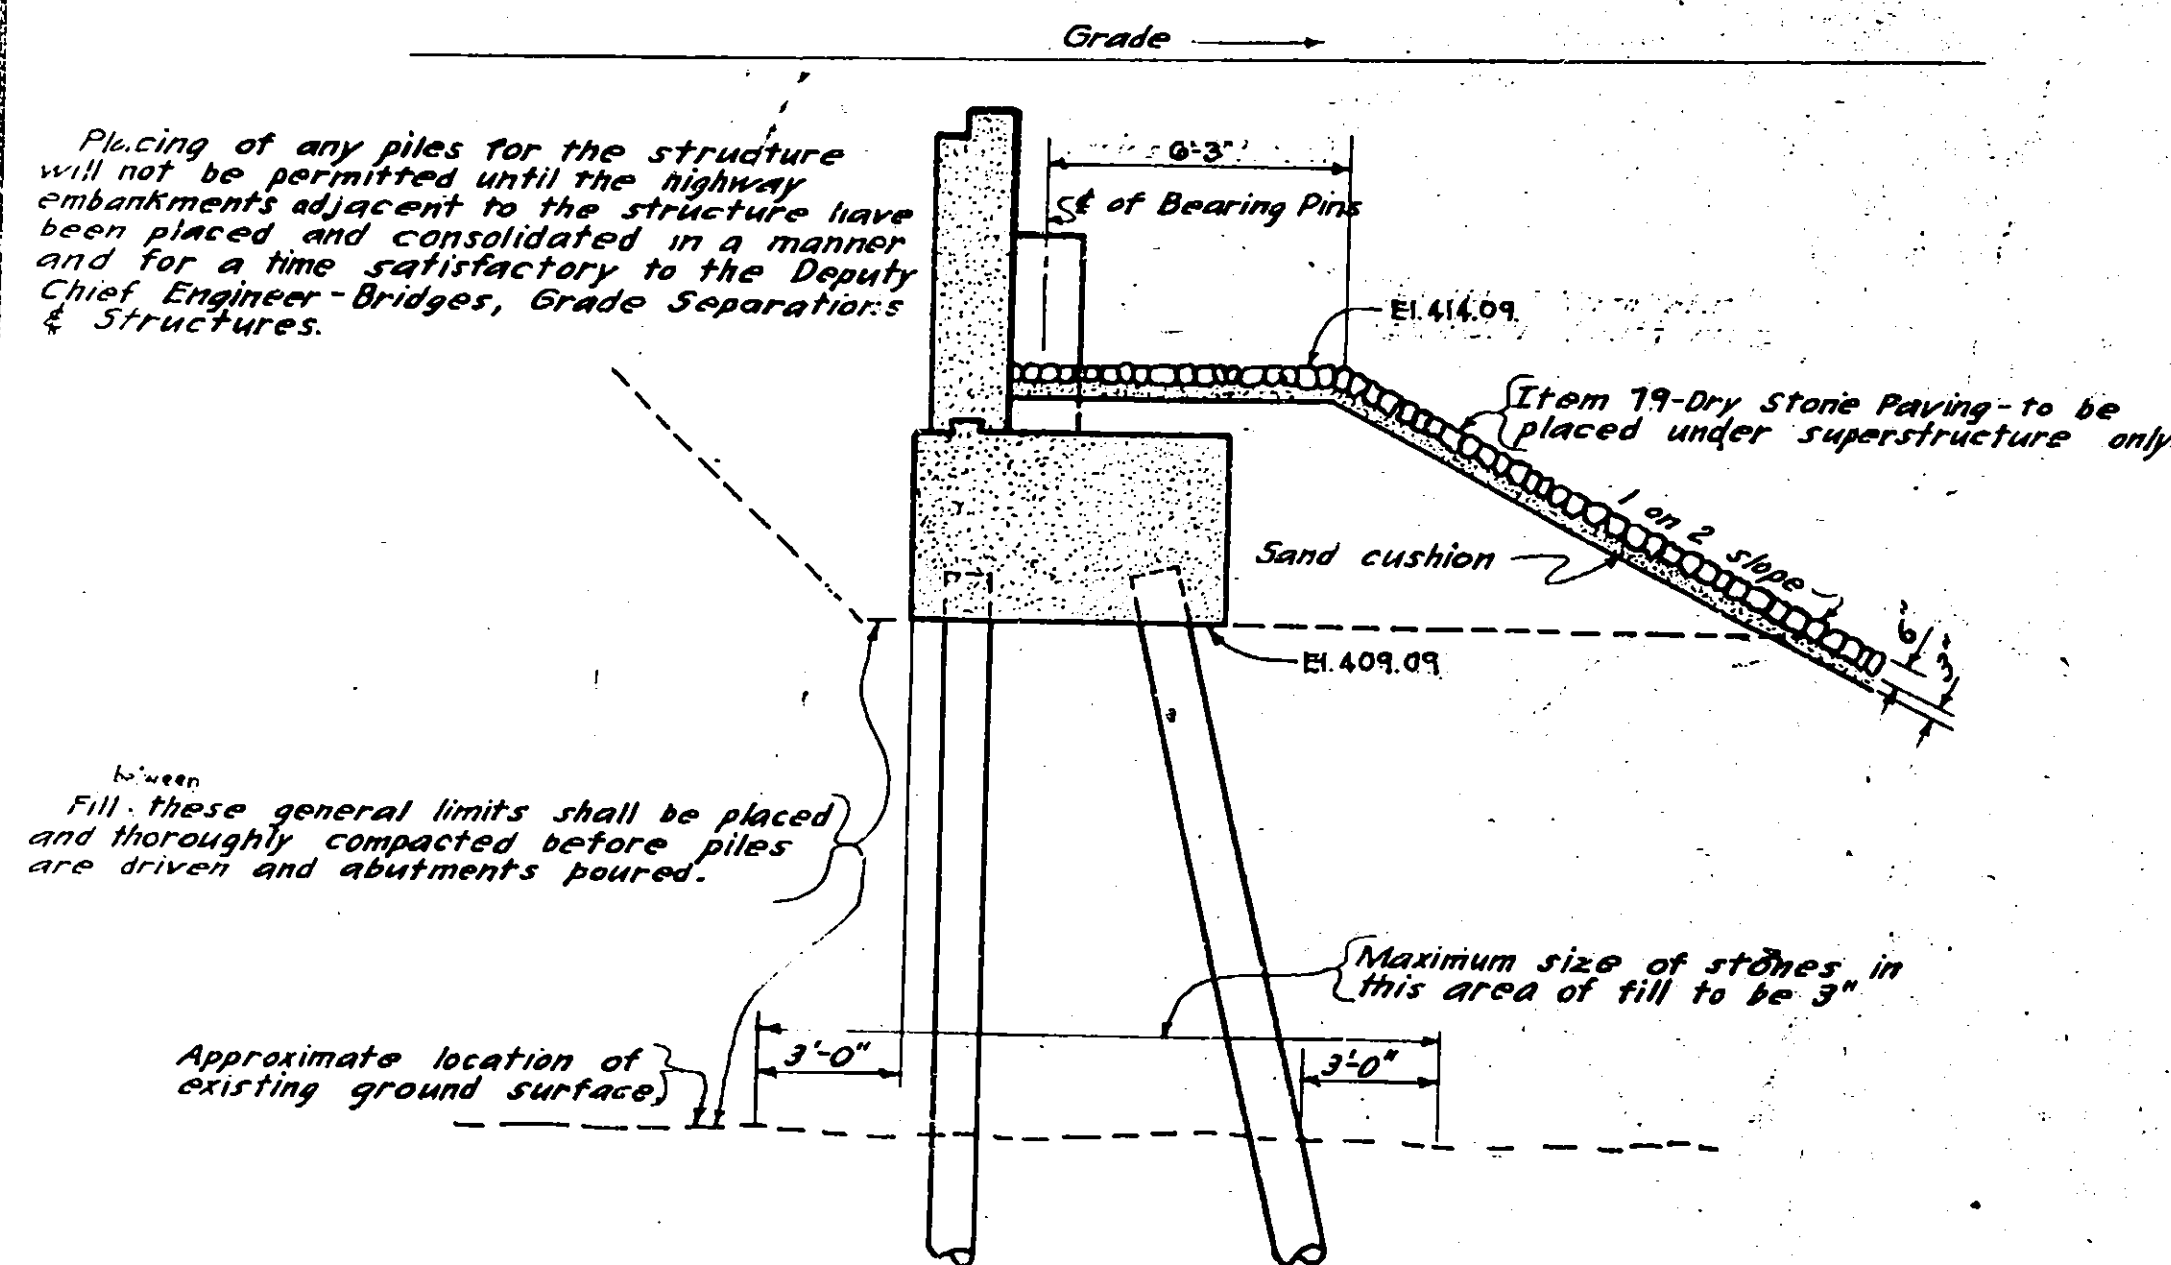

DETAIL OF EMBANKMENT AND BACKFILL AT ABUTMENT


GENERAL NOTES

- All rivets to be $\frac{3}{4}$ "
 All holes to be $\frac{1}{2}$ " unless otherwise noted.
- Concrete in abutments and Piers shall be Item 20.
 Concrete in superstructure except for pavement shall be Item 18.
- Concrete in pavement shall be Item 47B.
 The cost of furnishing and installing caulking compound, premoformed bituminous joint material, sponge rubber joint material, lead wool, copper flashing and Item 11B shall be included in the prices bid for the various items in this contract.
- Materials and Fabrication - Specifications of New York State Department of Public Works, dated Jan. 2, 1951 and current modifications and additions.
 Design Specifications - AASHTO 1949 - Loading H20-44 and current modifications.
- No construction joints other than those shown on the plans will be permitted without the written permission of the Deputy Chief Engineer.
 Where caulking compound is to be used the sides of the joints of the caulking compound, 30 to 35 minutes before the compound is placed. All joints must be thoroughly clean and dry before the priming coat is applied. Work must be performed by workmen experienced in this type of work. Caulking Compound must comply with D.P.W. Specs. M-35.


FINAL Total Contract Quantities

ITEM NO.	DESCRIPTION	UNIT	Final Quantities
5	Trench Culvert & Bridge Excavation	C.Y.	121.7
15-2	Portland Cement Type 2	Bbl.	1,152.3
15-N	Natural Cement Type N	Bbl.	1,850.0
18	Class III Concrete for Structures	C.Y.	201.12
20	Class I Concrete	C.Y.	
25F	Steel Fabric Reinforcement	S.Y.	734.0
28	Bar Reinforcement for Structures	Lb.	57,441
28A	Spiral Bar Shear Connectors	Lb.	1,530
37	Structural Steel	Lb.	1,032.5
47B	Cement Concrete Pavement	S.Y.	476.15
79	Dry Stone Paving	S.Y.	73.71
85C	Cast in Place Concrete Piles	L.F.	360.3
87	Furnishing Equipment for Driving Piles	L.F.	7,381.2
121	Topsoil Placed from Stockpiles	C.Y.	20%
123B	Seeding on Prepared Areas	Acres	173.3
124	Sodding	S.Y.	0.36
67A	Return Equip. for driving Piles (of N. Main St.)	L.F.	3,500.3
			100%


The Contractor's attention is directed to the special notes for this structure which appear in the proposal. Particular attention should be given to the foundation note, which briefly outlines the anticipated subsurface conditions at the site of the structure and which specifies certain requirements relative to construction.

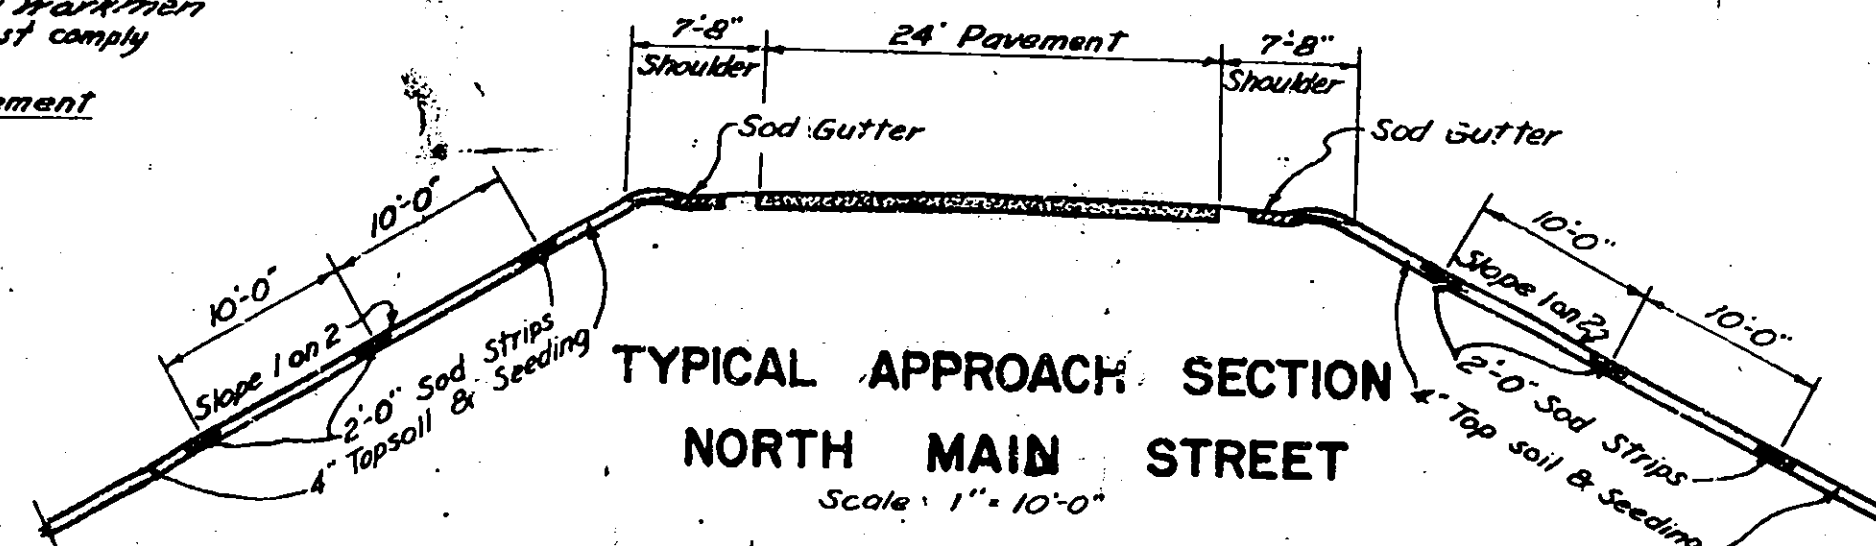

TYPICAL APPROACH SECTION
NORTH MAIN STREET

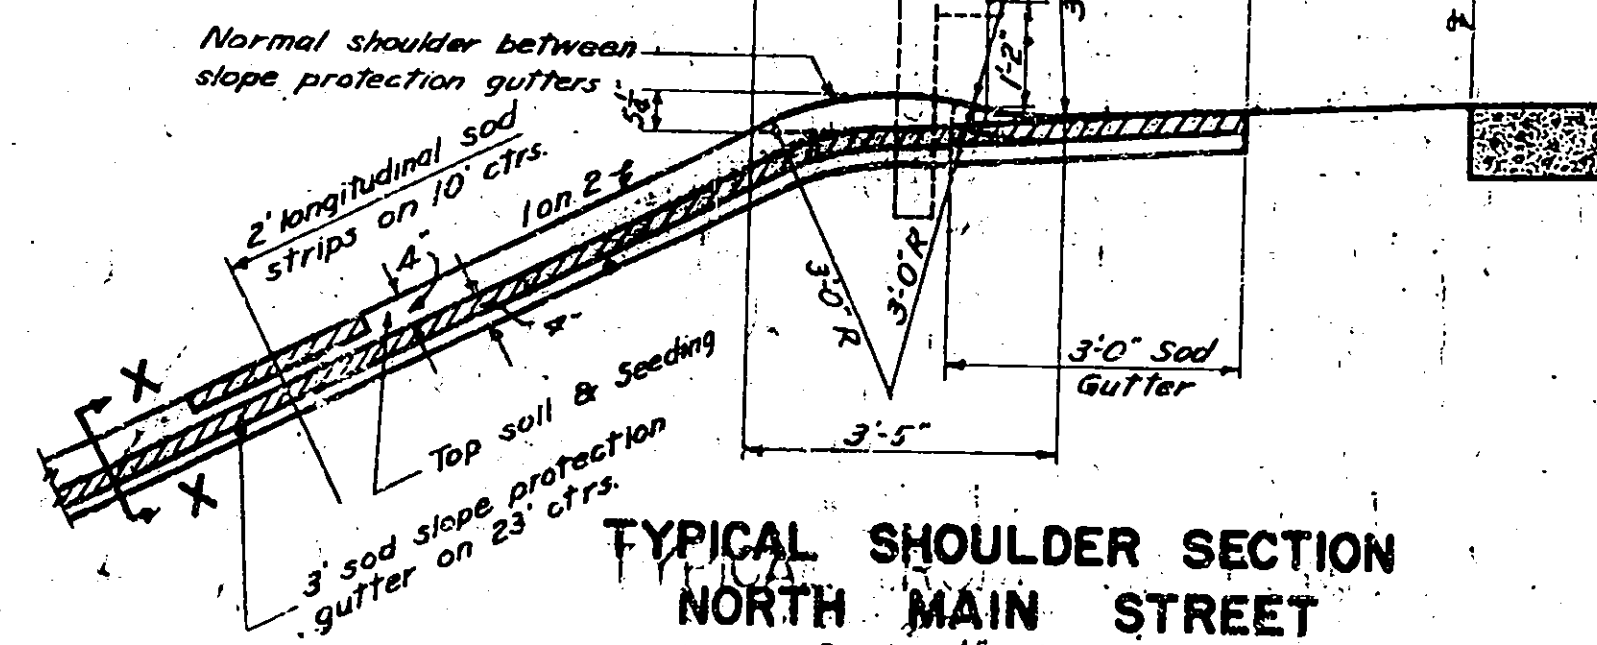



TYPICAL SHOULDER SECTION
NORTH MAIN STREET

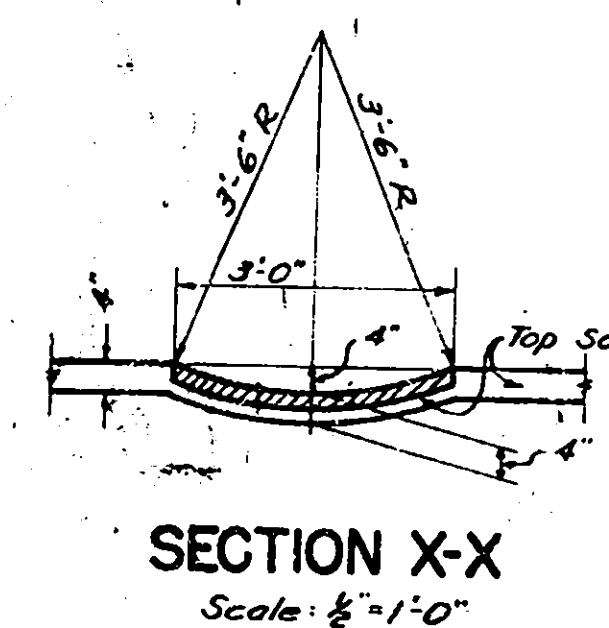

SECTION X-X


NORTH MAIN STREET
STA. 588 +.82
PROFILE

IN CHARGE OF *Dr. Mercurio*
 DESIGNED BY *Dr. Mercurio*
 DETAIL BY *V. F. Green*
 CHECKED BY *A. F. Green*

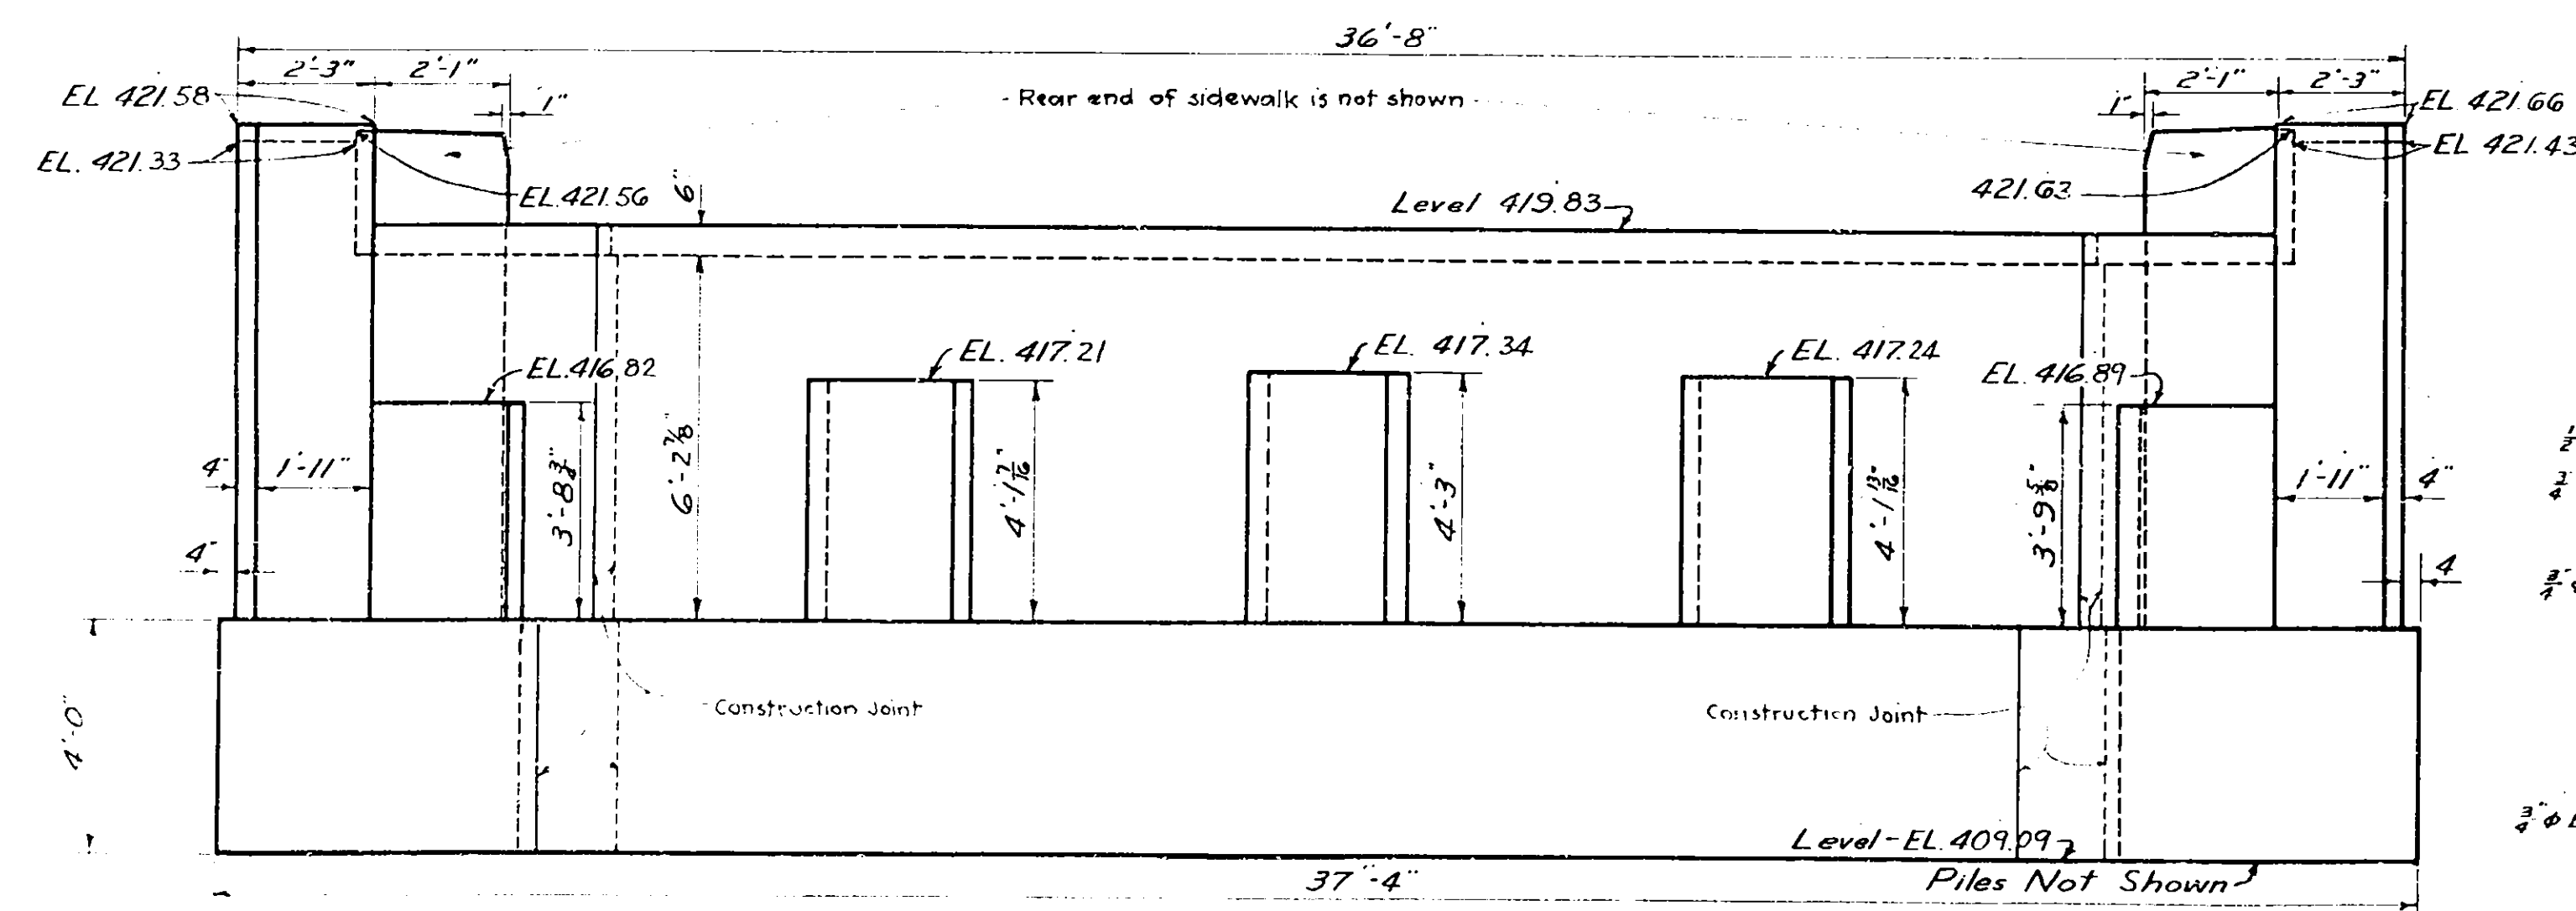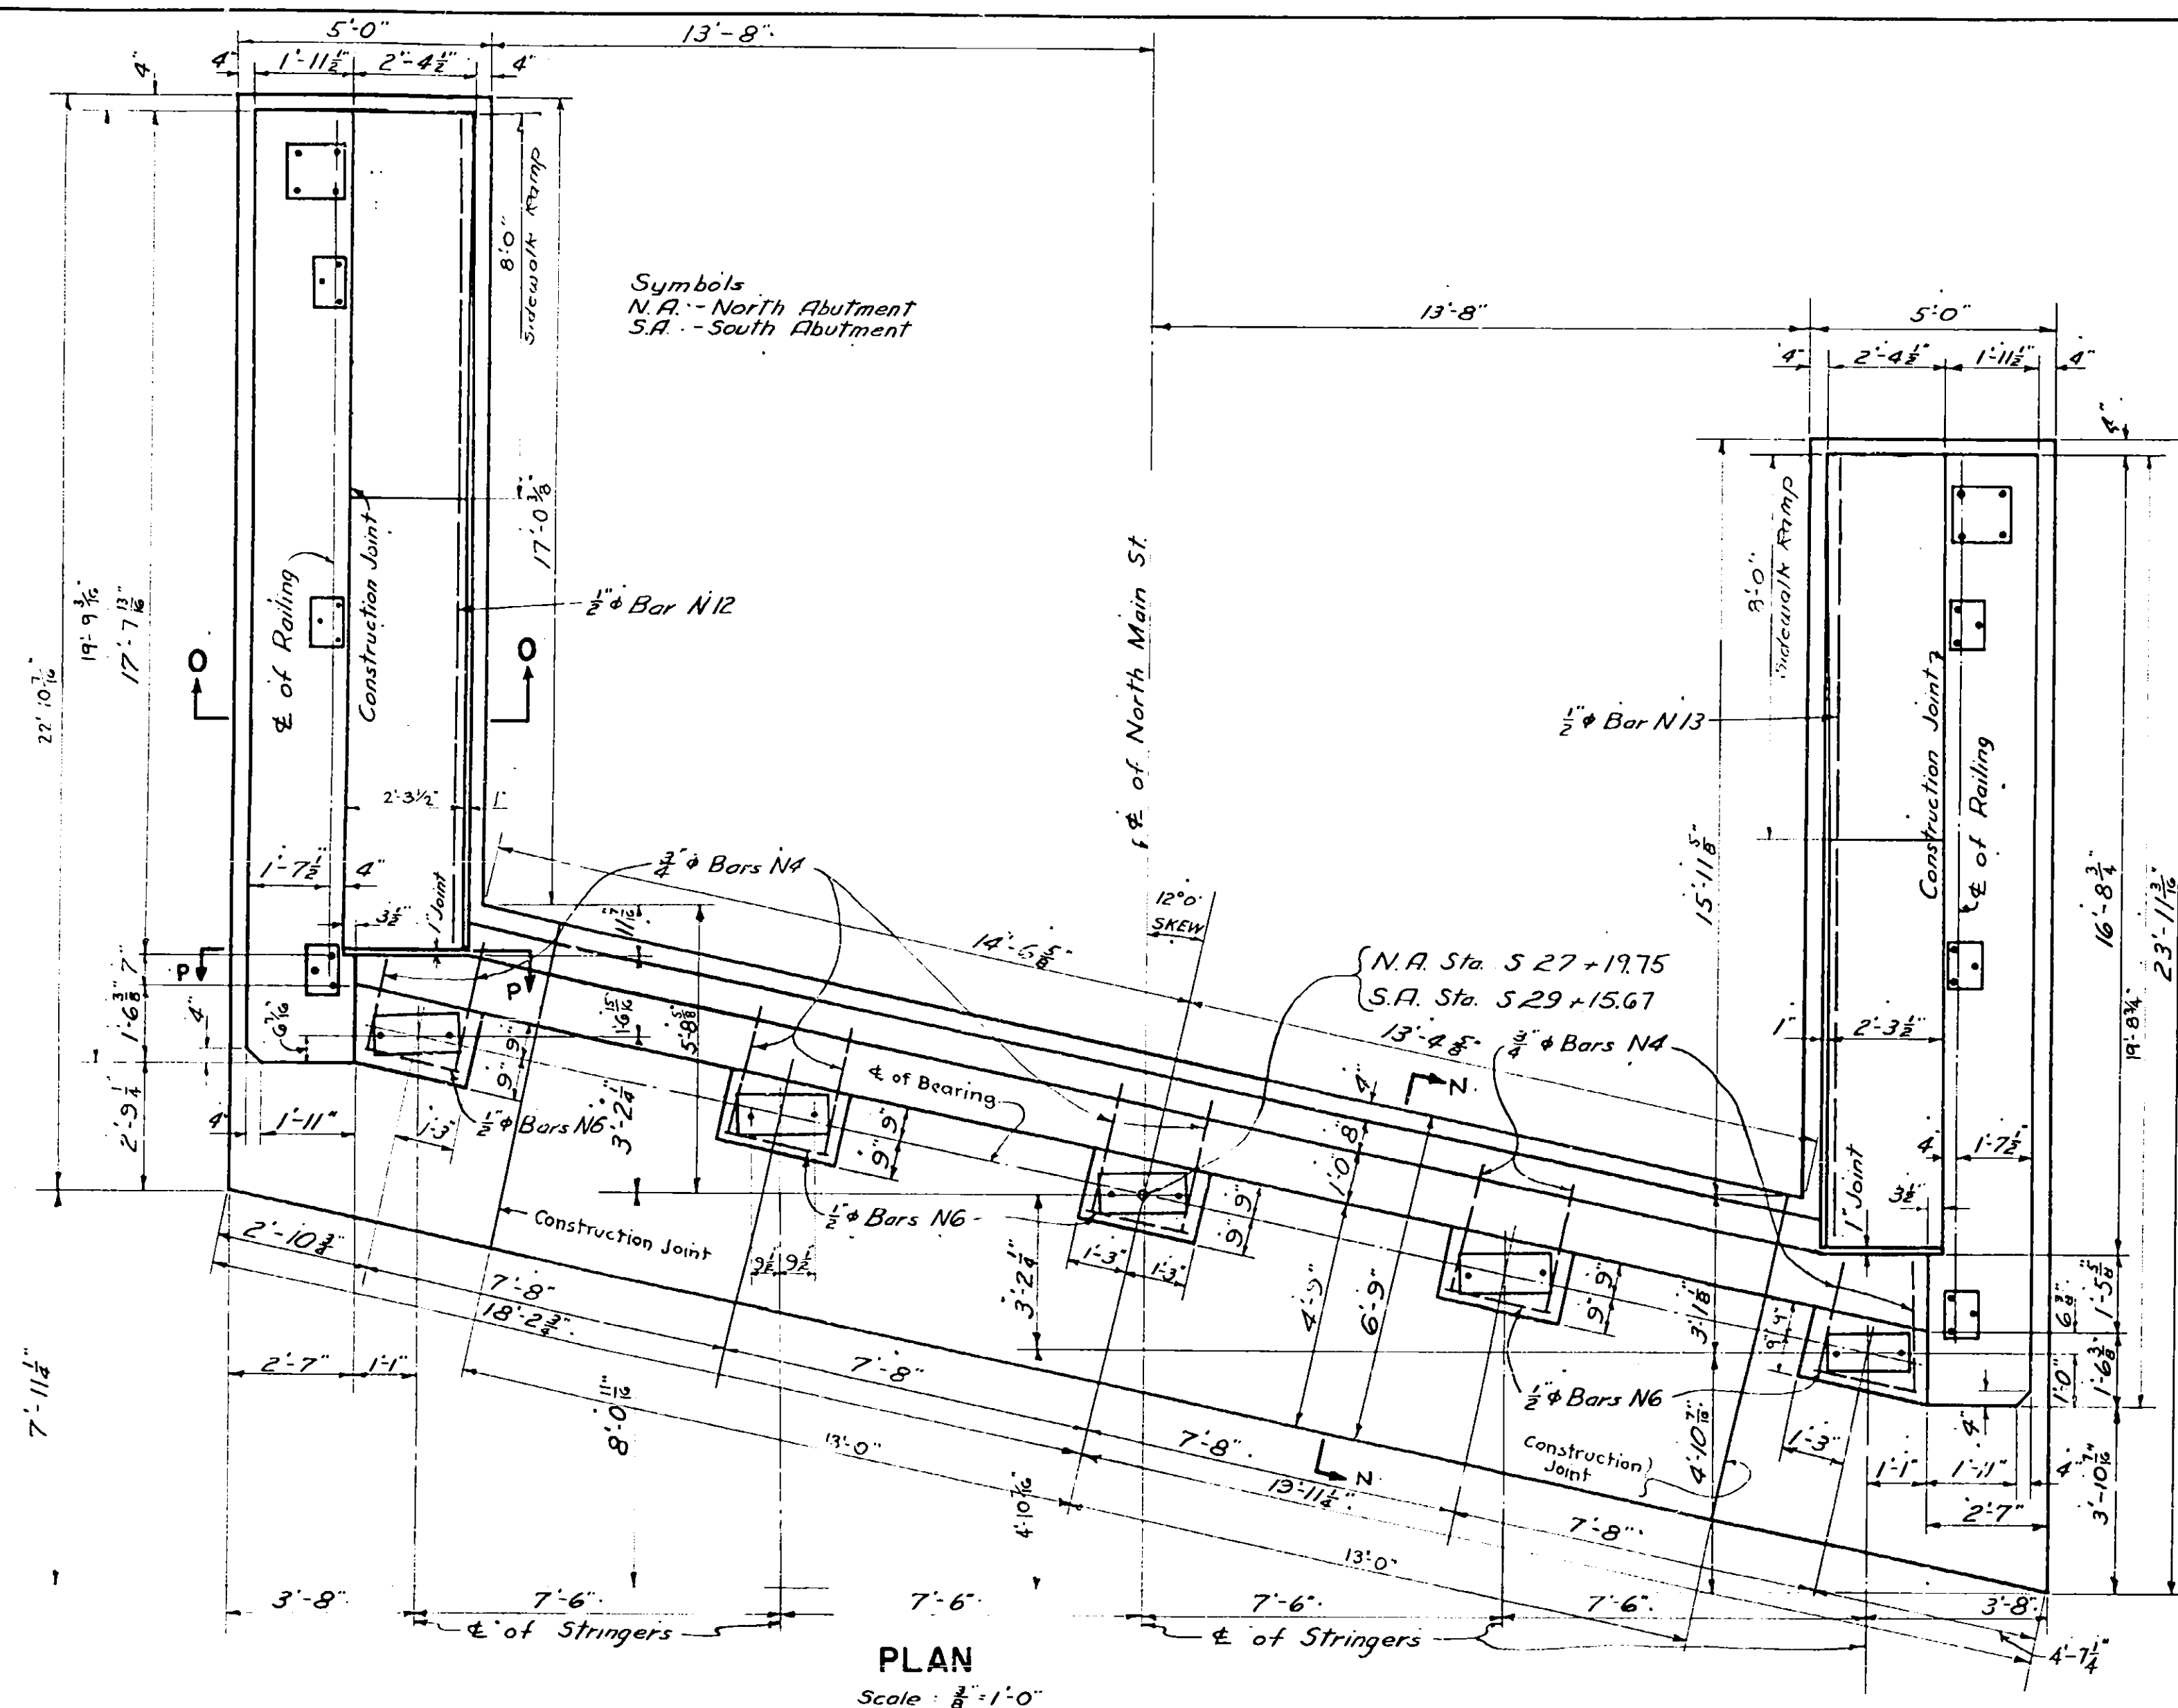


ELEVATION
Scale: $\frac{3}{8}'' = 1'-0$

Note:-
For details of Piles
see pigr sheet.

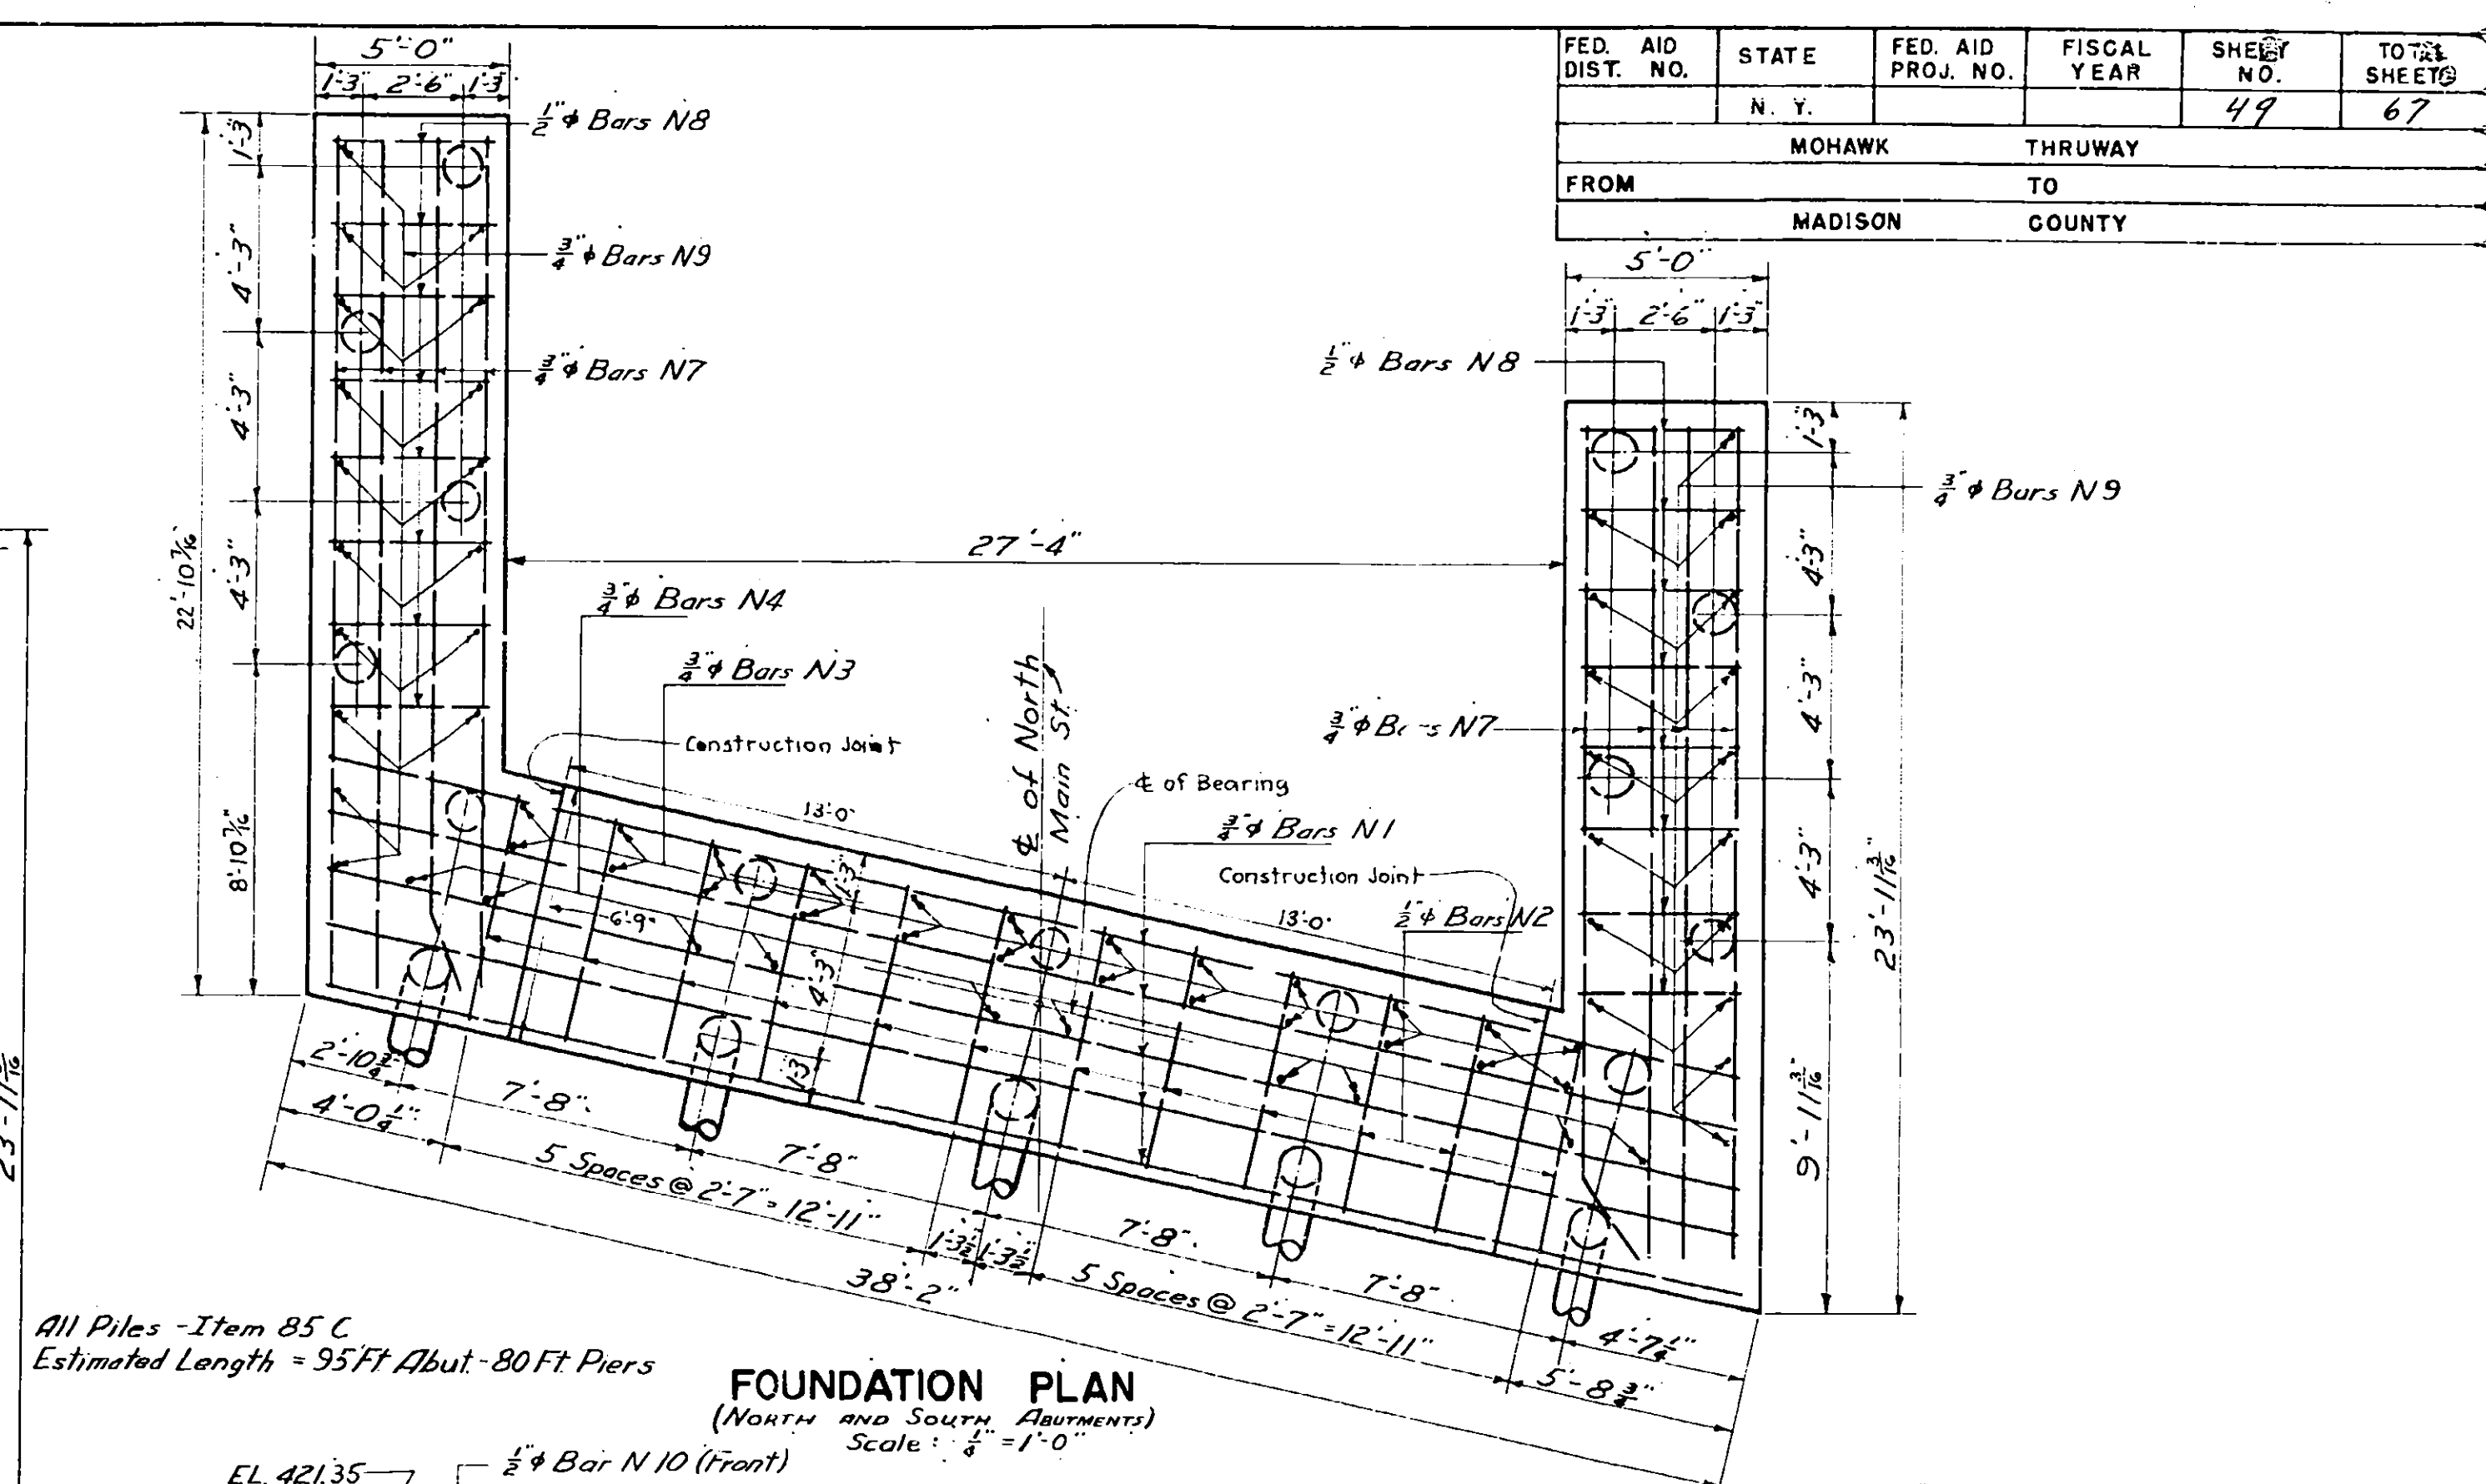


FOUNDATION PLAN
(NORTH AND SOUTH ABUTMENTS)
Scale: $\frac{1}{4}'' = 1'-0''$

All Piles - Item 85 C
Estimated Length = 95 Ft Abut. - 80 Ft Piers

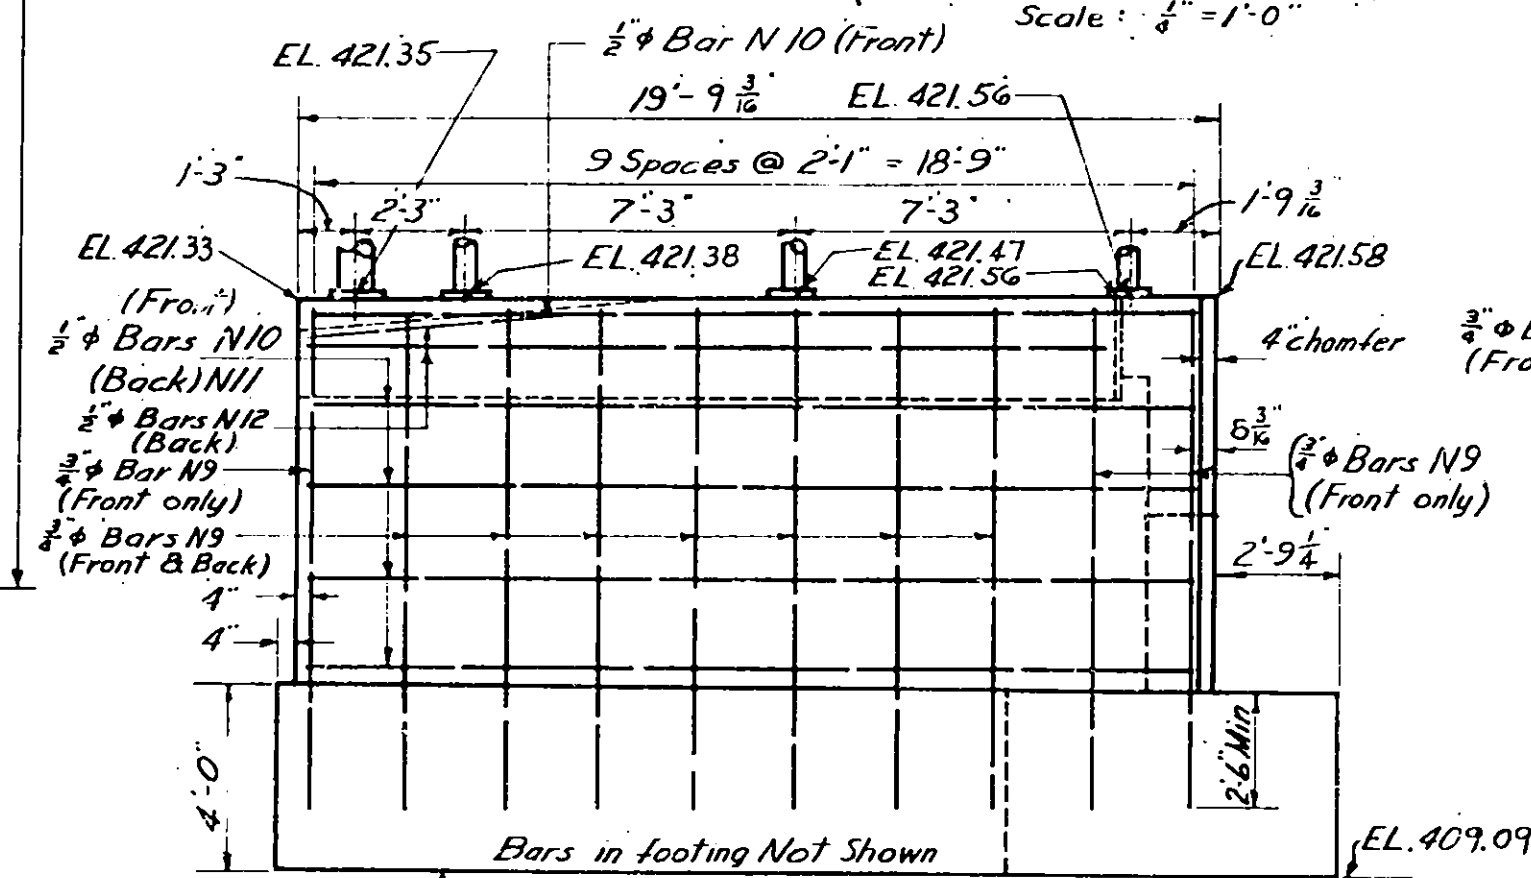


WEST SIDE	NORTH ABUTMENT
EAST SIDE	SOUTH ABUTMENT

Scale: $\frac{1}{4}" = 1'-0"$

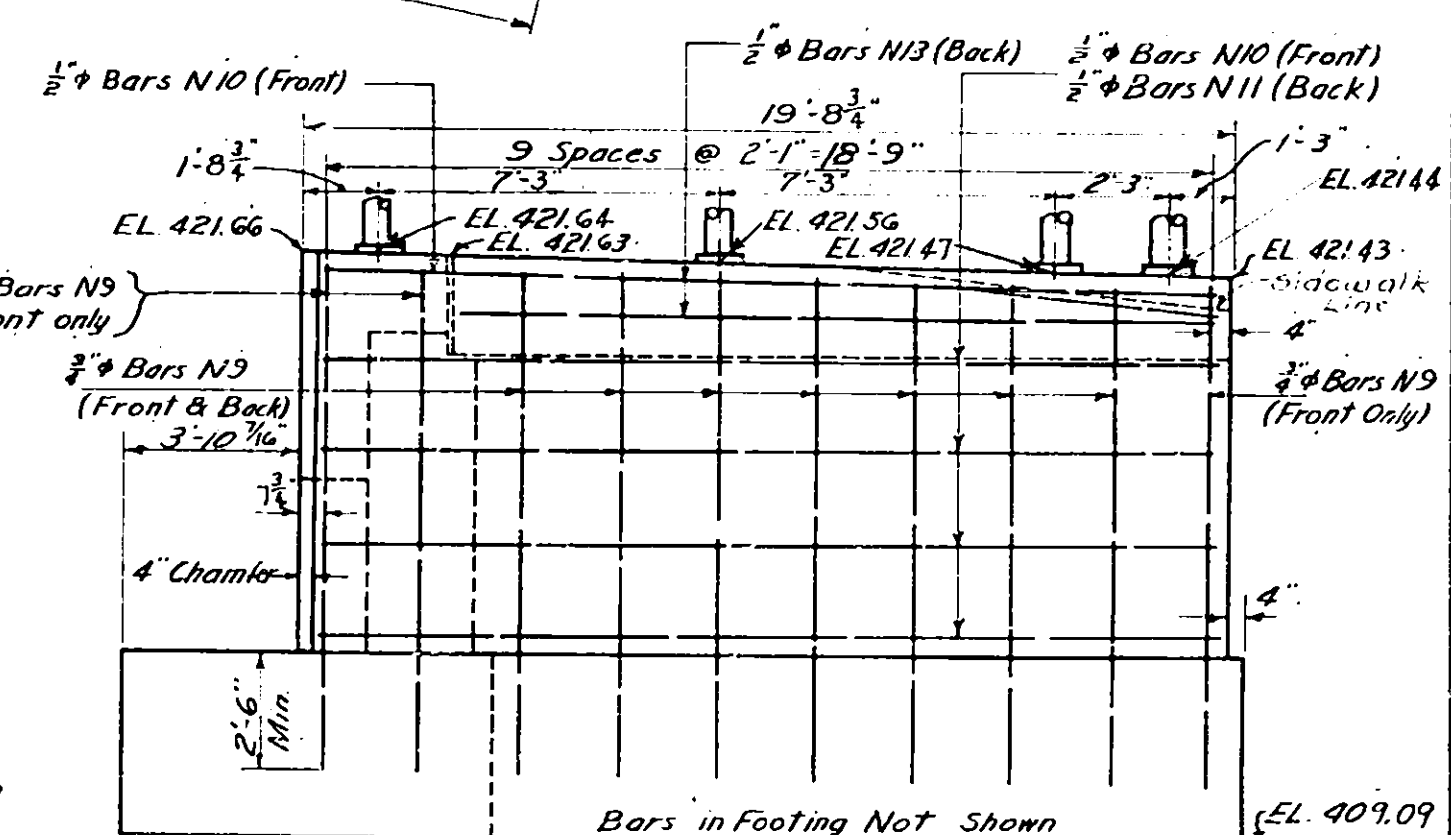


EAST SIDE	NORTH ABUTMENT
WEST SIDE	SOUTH ABUTMENT

Scale: $\frac{1}{2}$ " = 1'-0"

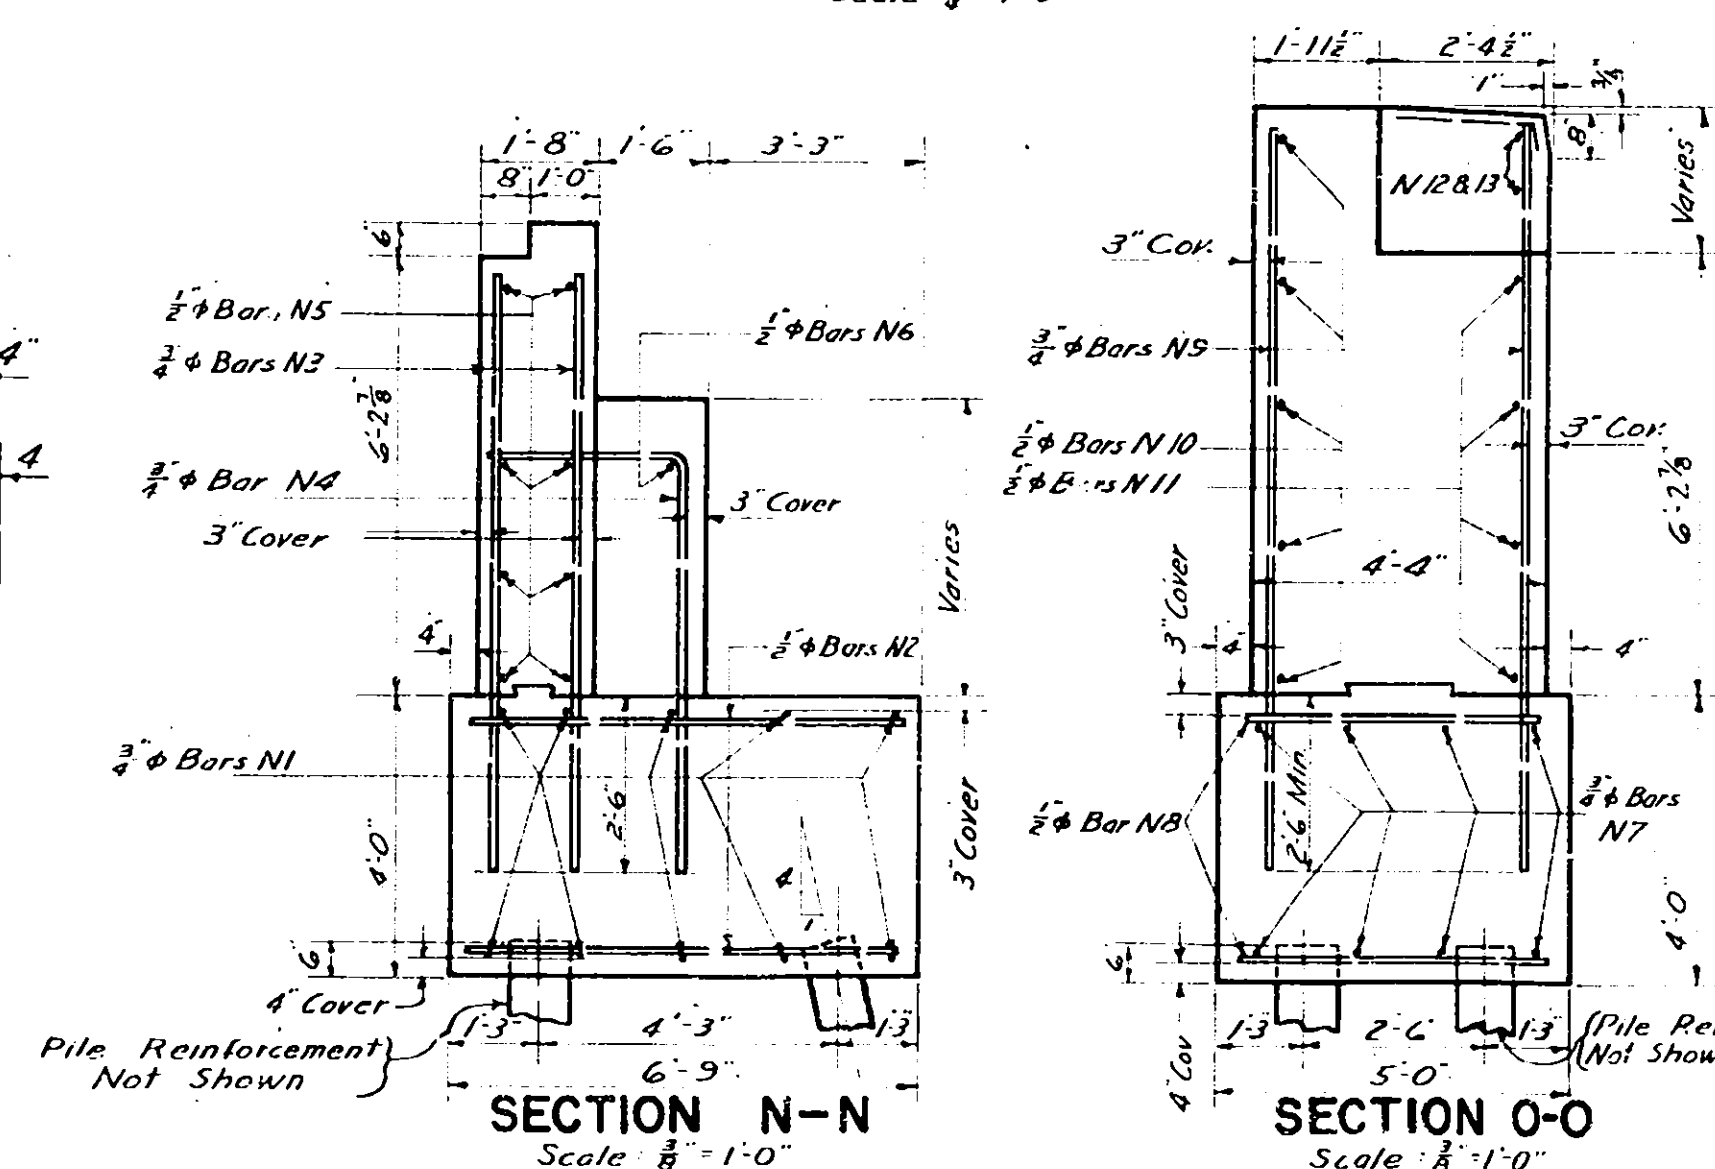


SECTION N-
Scale: $\frac{3}{8}'' = 1'-0''$

Scale: $\frac{3}{8}'' = 1'-0''$

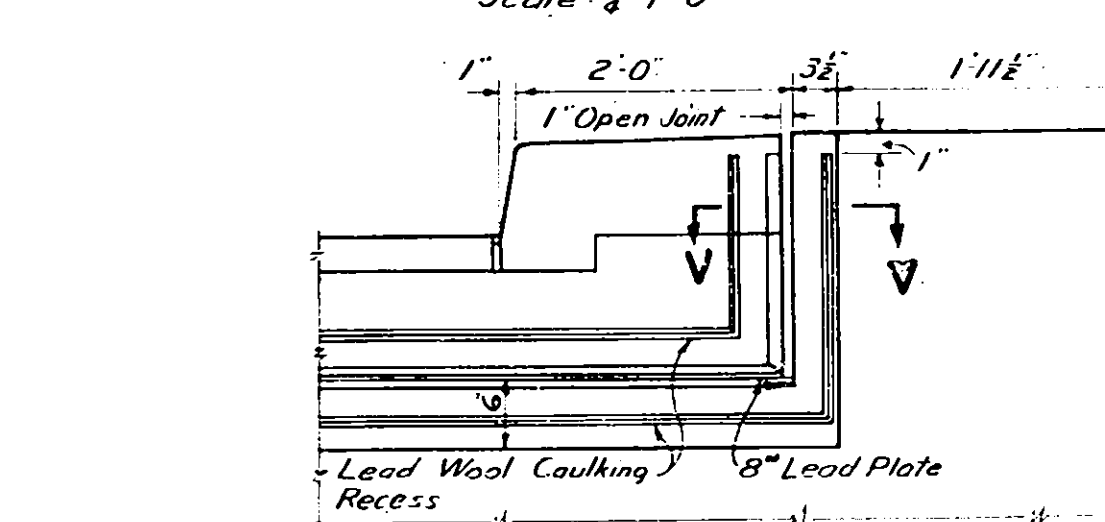

SECTION P-P
Scale: $\frac{3}{4}'' = 1'-0''$

Scale: $\frac{3}{4}'' = 1'$

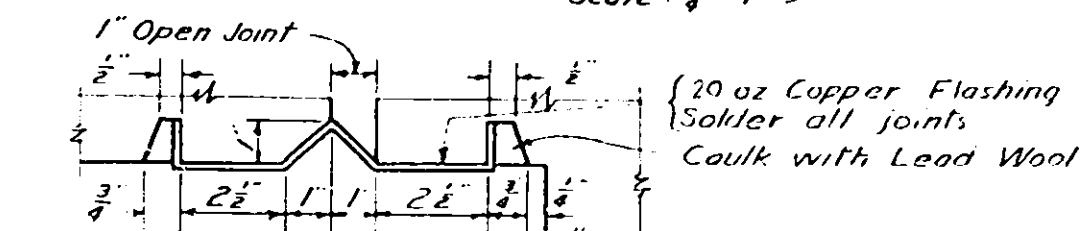

SECTION V-V
Scale: 3"=1'-0"

Scale : 3" = 1'-0"


NORTH MAIN STREET

STA. 588 + 82


ABUTMENTS

FED. AID DIST. NO.	STATE	FED. AID PROJ. NO.	FISCAL YEAR	SHEET NO.	TOTAL SHEETS
	N. Y.			50	67
FROM			THRUWAY		
MADISON			COUNTY		

Cols. No. 146 El. 417.04
Cols. No. 364 El. 417.34
Cols. No. 255 El. 416.99

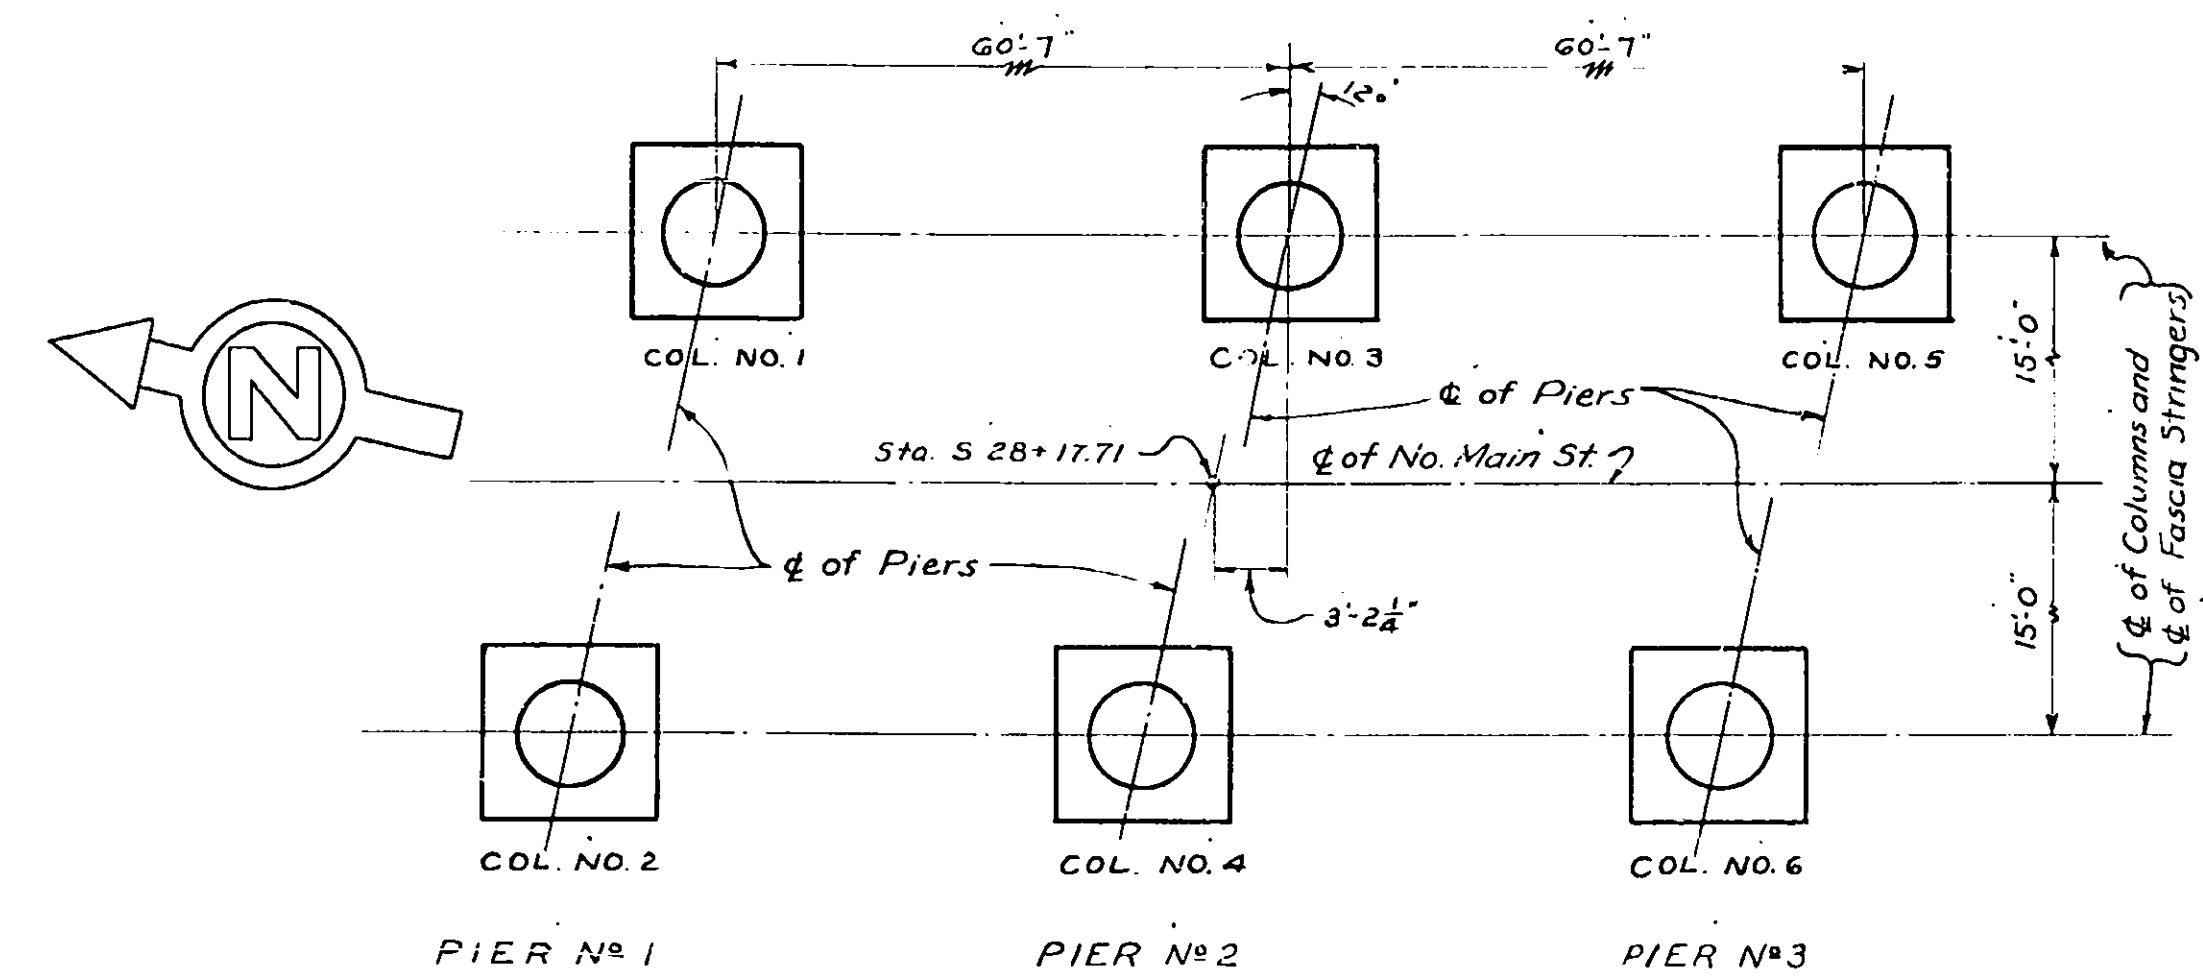


LOCATION OF COLUMNS
Scale: 1/8" = 1'-0"

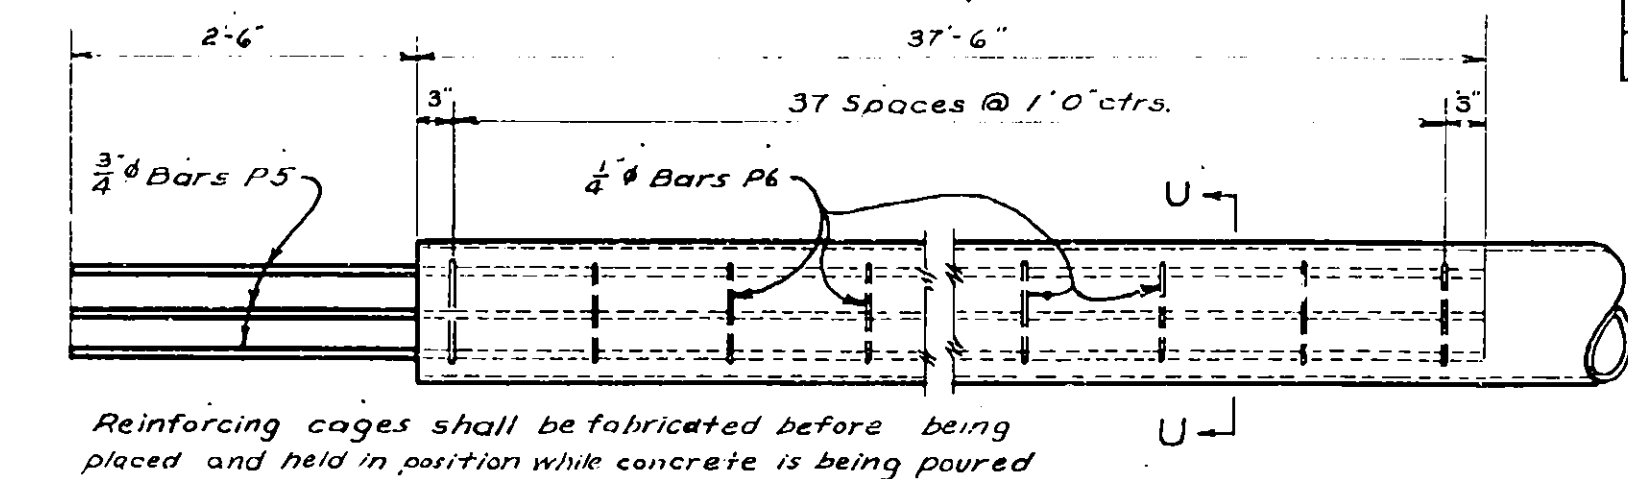


PILE REINFORCEMENT DETAILS
Scale: 1/2" = 1'-0"


All piles - Item 85 C
Estimated length = 95' for Abutments and 80' for Piers

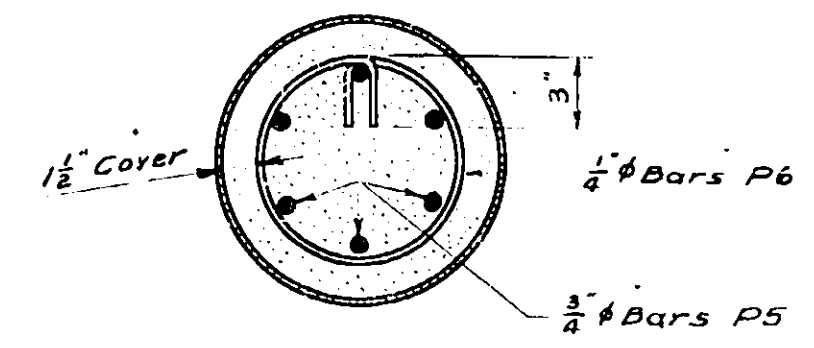


SECTION U-U
Scale: 1/2" = 1'-0"

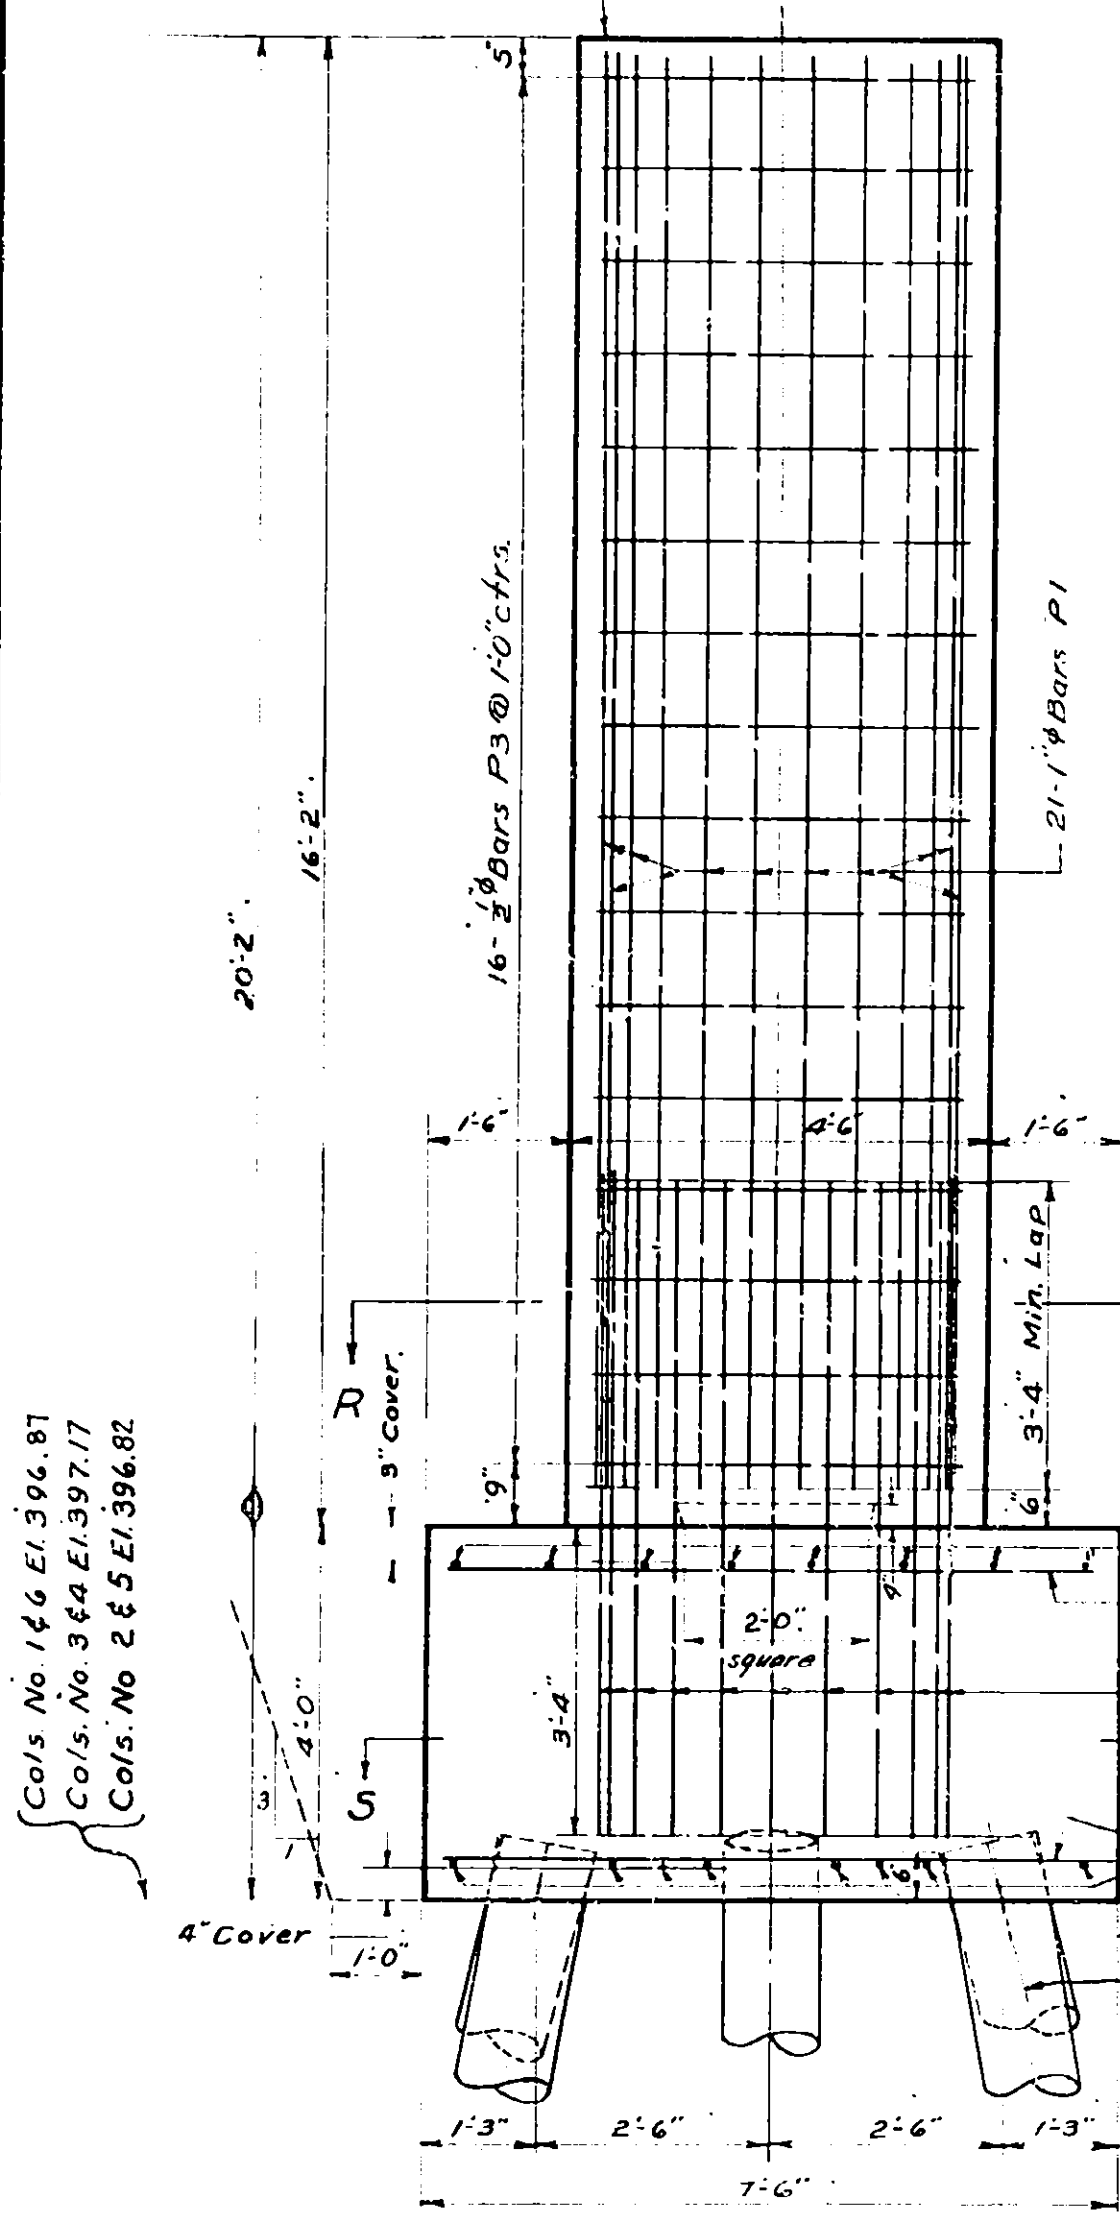

ELEVATION OF COLUMNS
Scale: 1/2" = 1'-0"

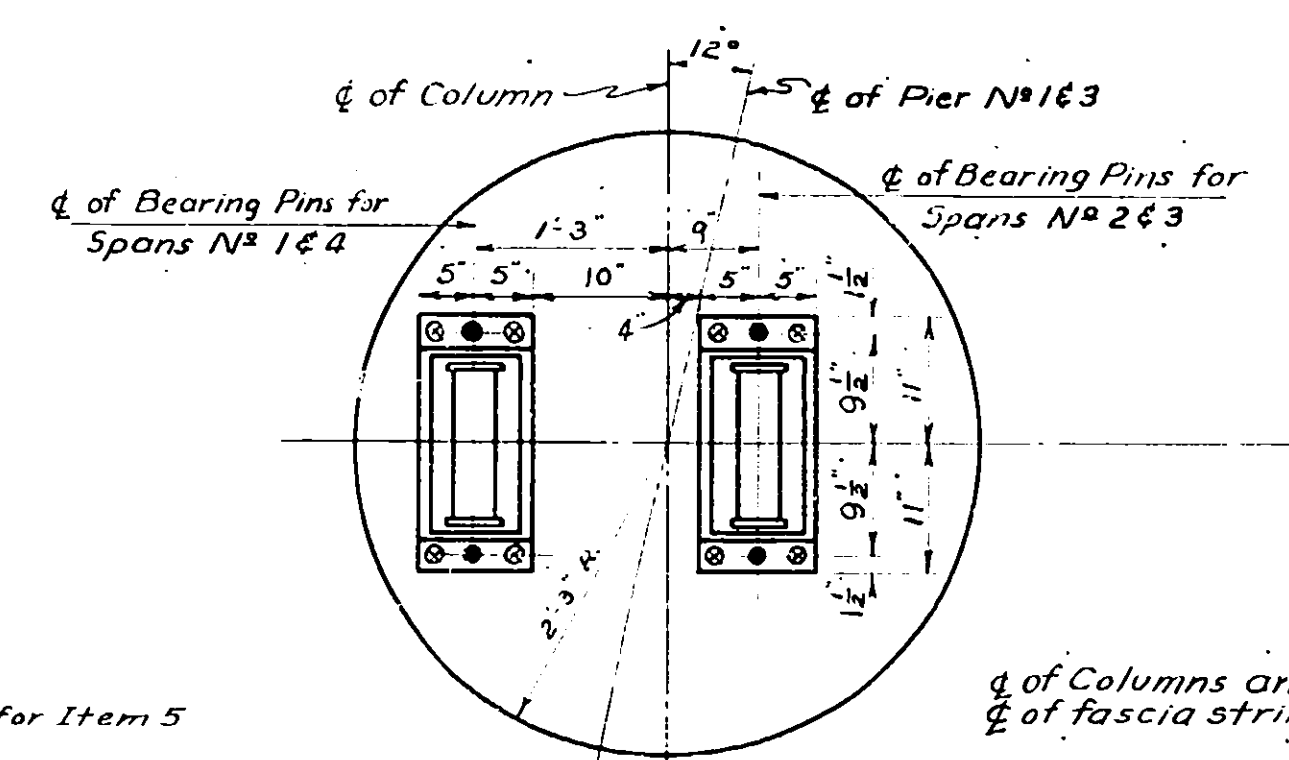



DETAIL OF COLUMNS NO. 1, 2, 5 & 6
EXPANSION BEARINGS
Scale: 1/2" = 1'-0"

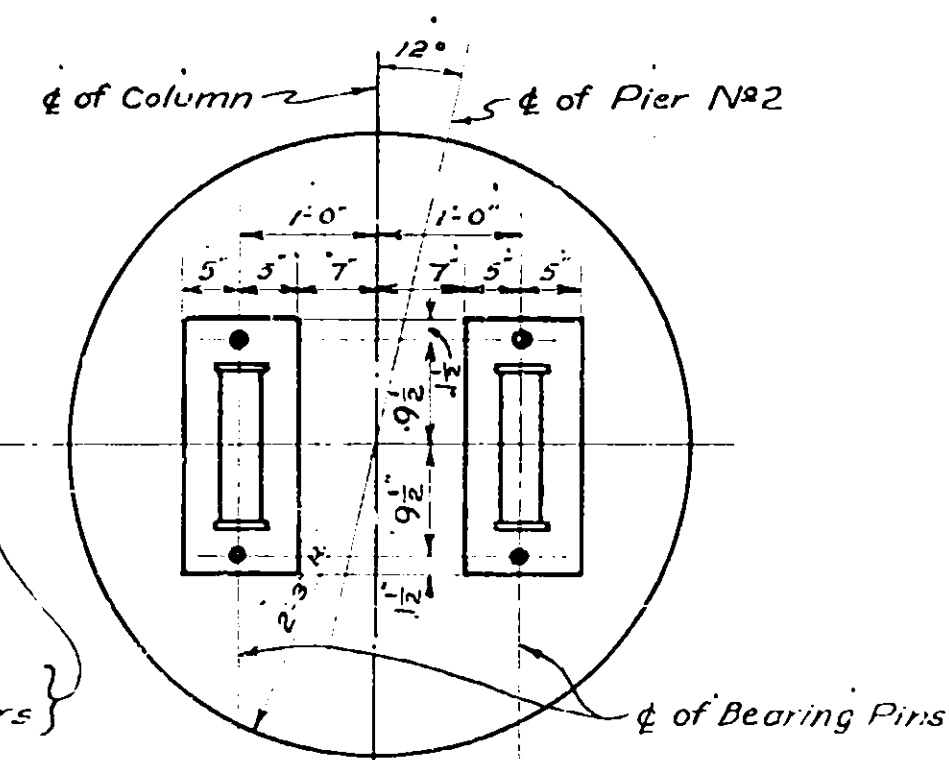


DETAIL OF COLUMNS NO. 3 & 4
FIXED BEARINGS
Scale: 1/2" = 1'-0"

BAR LIST				
MARK	SIZE	NO.	LENGTH	LOCATION AND DESCRIPTION
A	5"	478	32'-5"	Transverse Bars in Bottom of Slab Str.
B	5"	454	35'-11"	Transverse Bars in Top of Slab Bent
D	2"	240	31'-0"	Longitudinal Bars in Center Spans Str.
E	2"	240	20'-1"	" " " " End Str.
F	3/4"	324	3'-11"	Stirrups in Fascia Bent
N1	3/4"	20	37'-0"	Longitudinal Bars-Abut. Footing Str.
N2	1/2"	48	6'-5"	Transverse " " " Str.
N3	3/4"	48	6'-7"	Vertical " " " Backwall
N4	3/4"	20	8'-8"	Bent " " in Bridge Seat Bent
N5	1/2"	16	37'-0"	Longitudinal " " in Backwall
N6	3/4"	10	2'-2"	Tie Bars in Bridge Seat
N7	3/4"	32	22'-0"	Longitudinal Bars in Wing Footings Str.
N8	3/4"	64	4'-6"	Transverse " " " Str.
N9	3/4"	68	10'-9"	Vertical " " " Str.
N10	20	18	18'-9"	Longitudinal Bars in Face of Wing
N11	1/2"	16	16'-0"	" " " " Back " "
N12	1/2"	4	17'-3"	" Bars in Sidewalk at Wings Str.
N13	4	4	16'-4"	" " " " " "
P1	1"	126	15'-6"	Vertical Bars in Columns Str.
P2	1"	126	7'-2"	Dowels Between Footing & Columns Str.
P3	3/4"	96	12'-11"	Hoops in Columns Bent
P4	3/4"	192	7'-0"	Transverse Bar in Footing
P5	3/4"	528	40'-0"	Vertical Bars in Piles Str.
P6	3/4"	3252	2'-10"	Hoop Bars in Piles Bent in field.


BAR BENDING DETAILS

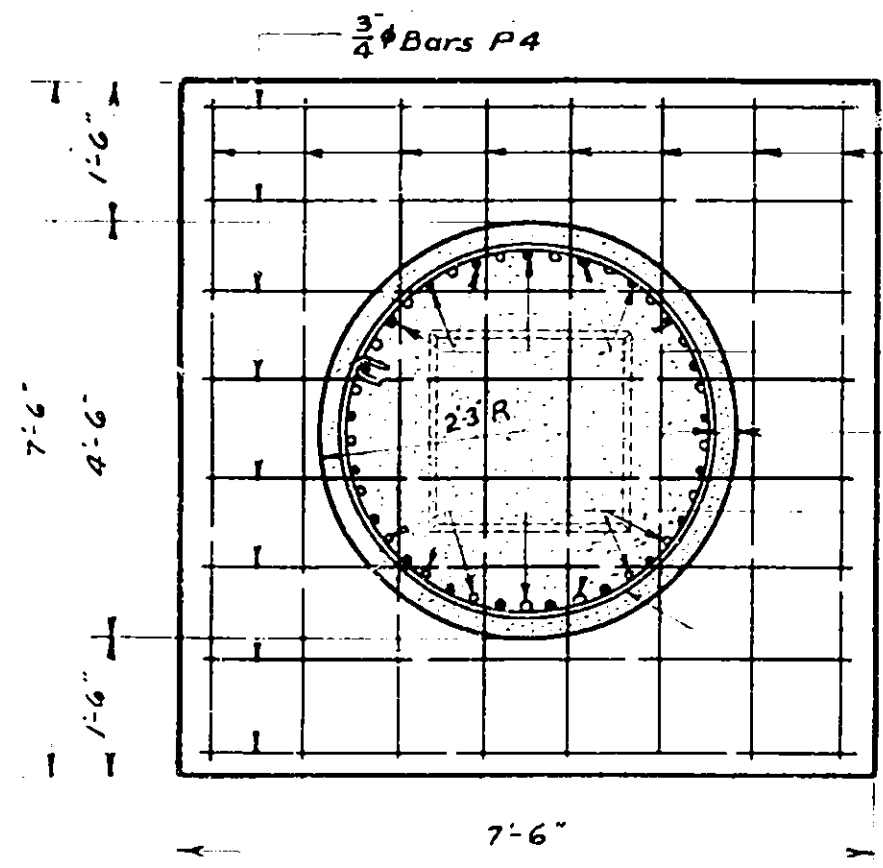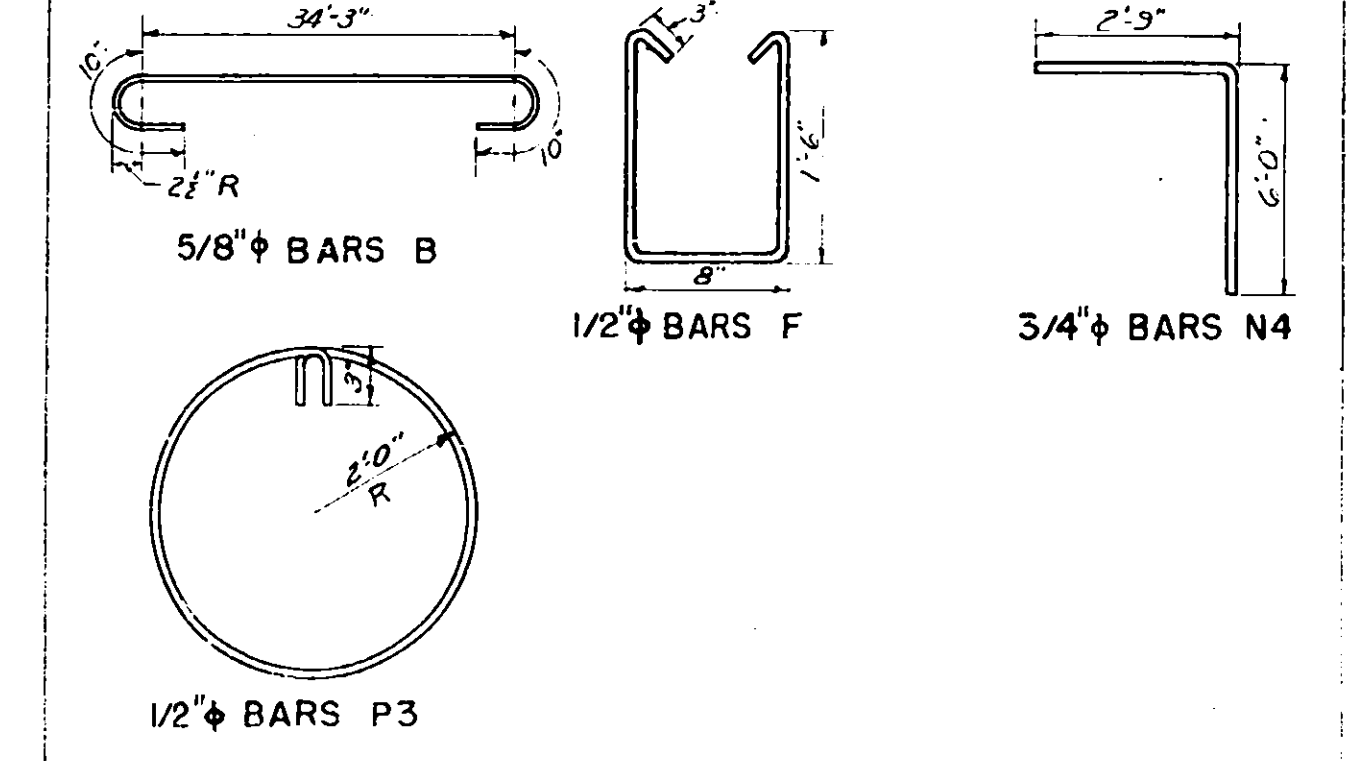

SECTION R-R
Scale: 1/2" = 1'-0"

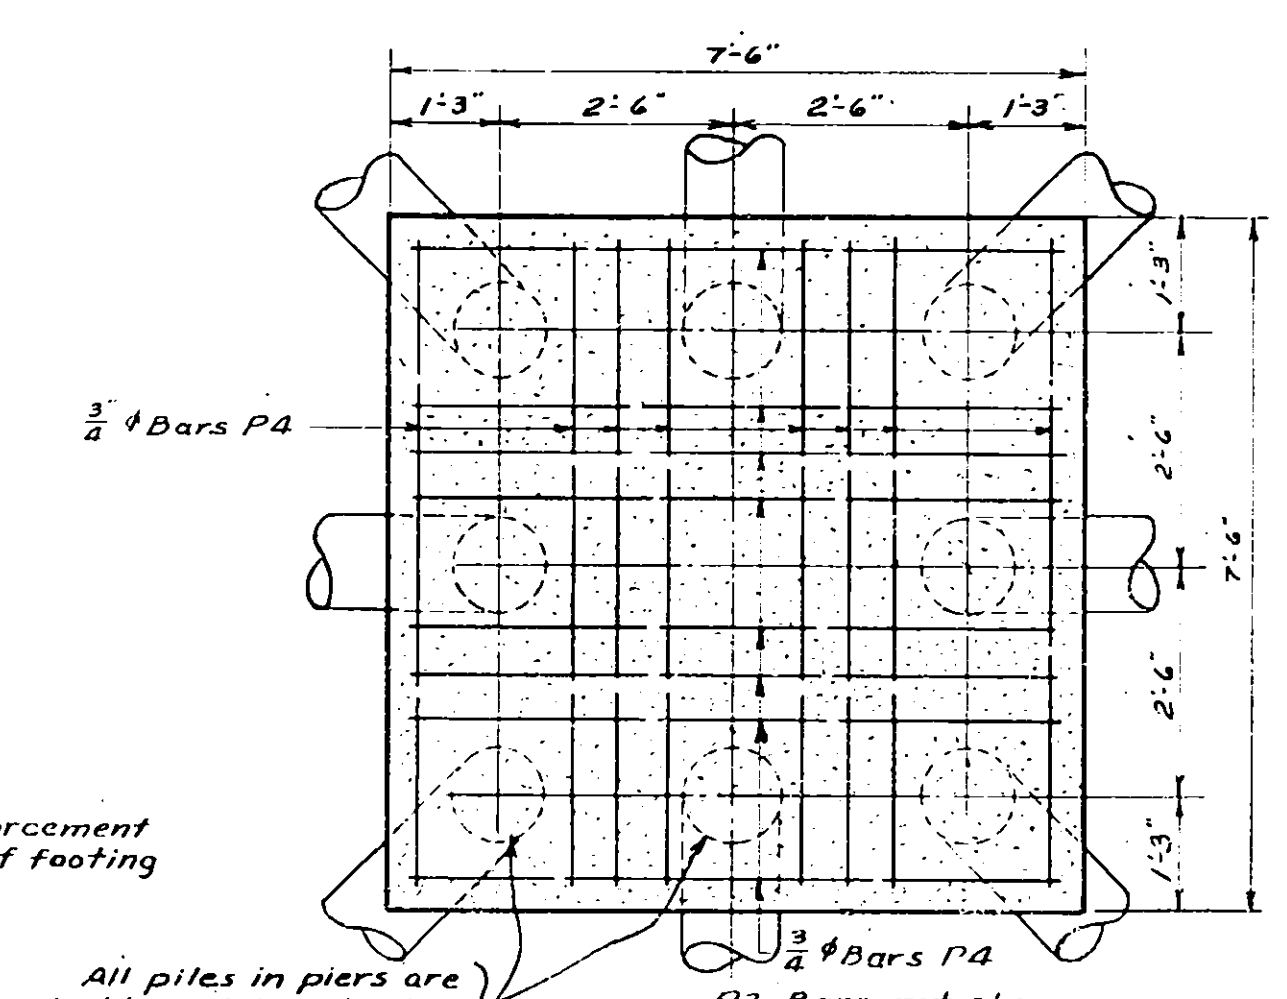

SECTION S-S
Scale: 1/2" = 1'-0"

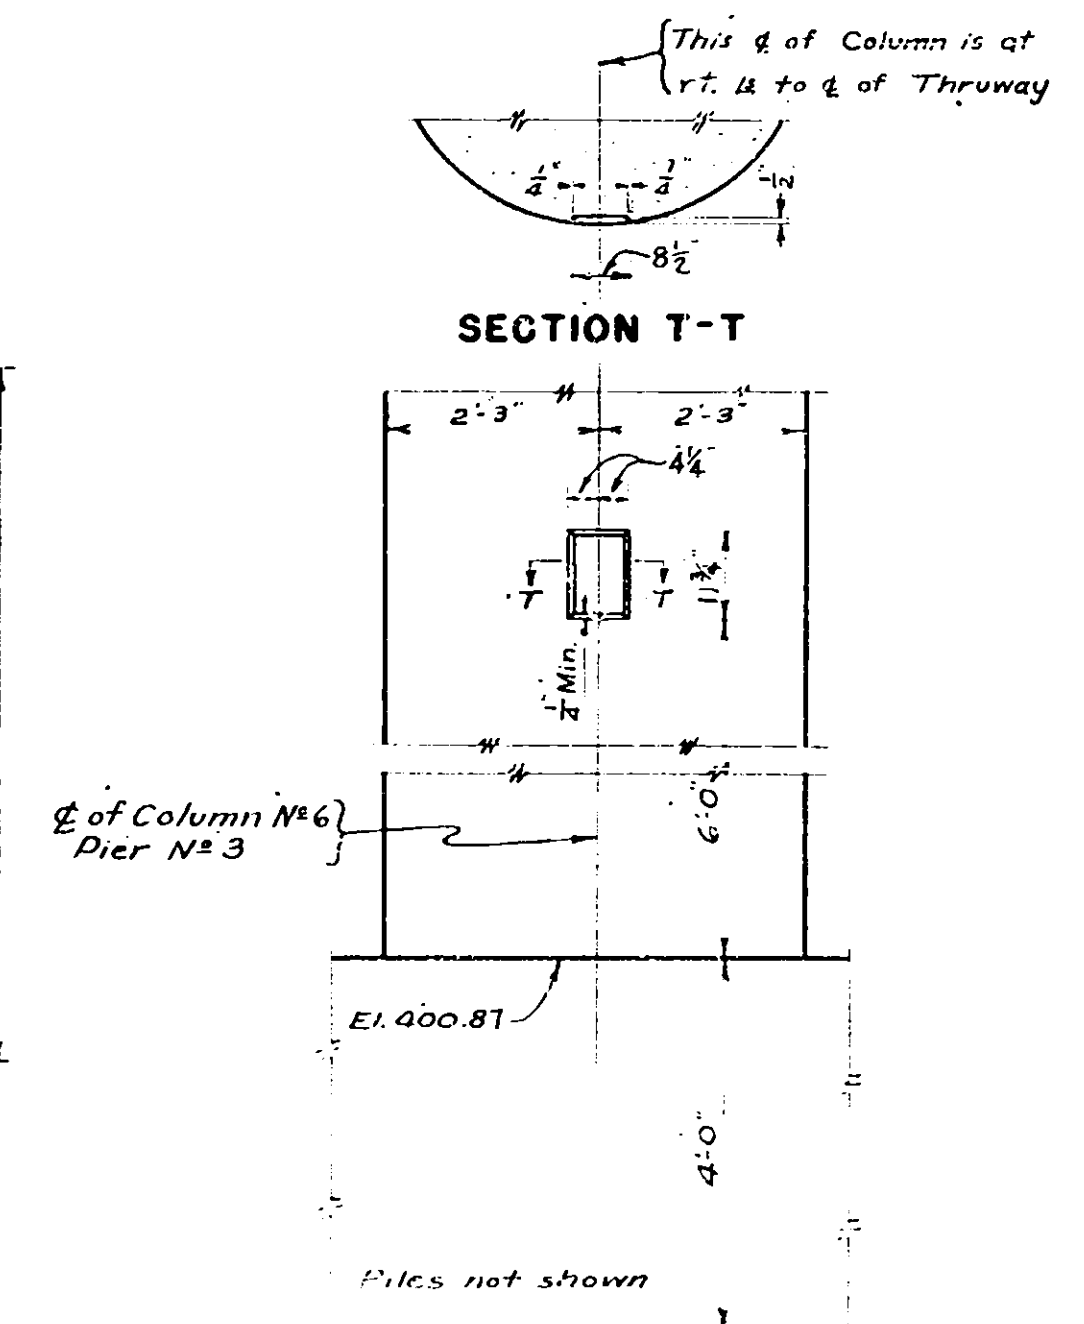

PARTIAL ELEVATION OF COLUMN NO. 6
SHOWING LOCATION OF
IDENTIFICATION PLATE RECESS
Scale: 1/2" = 1'-0"


NORTH MAIN STREET
STA. 588 + 82
PIERS

Cols. No. 146 El. 396.87
Cols. No. 364 El. 397.17
Cols. No. 255 El. 396.82


Checked by 10/6/01

W. M. H. S. S.
J. L. S. S.
J. L. S. S.
J. L. S. S.


NOTE: Stringers for End spans are not shown

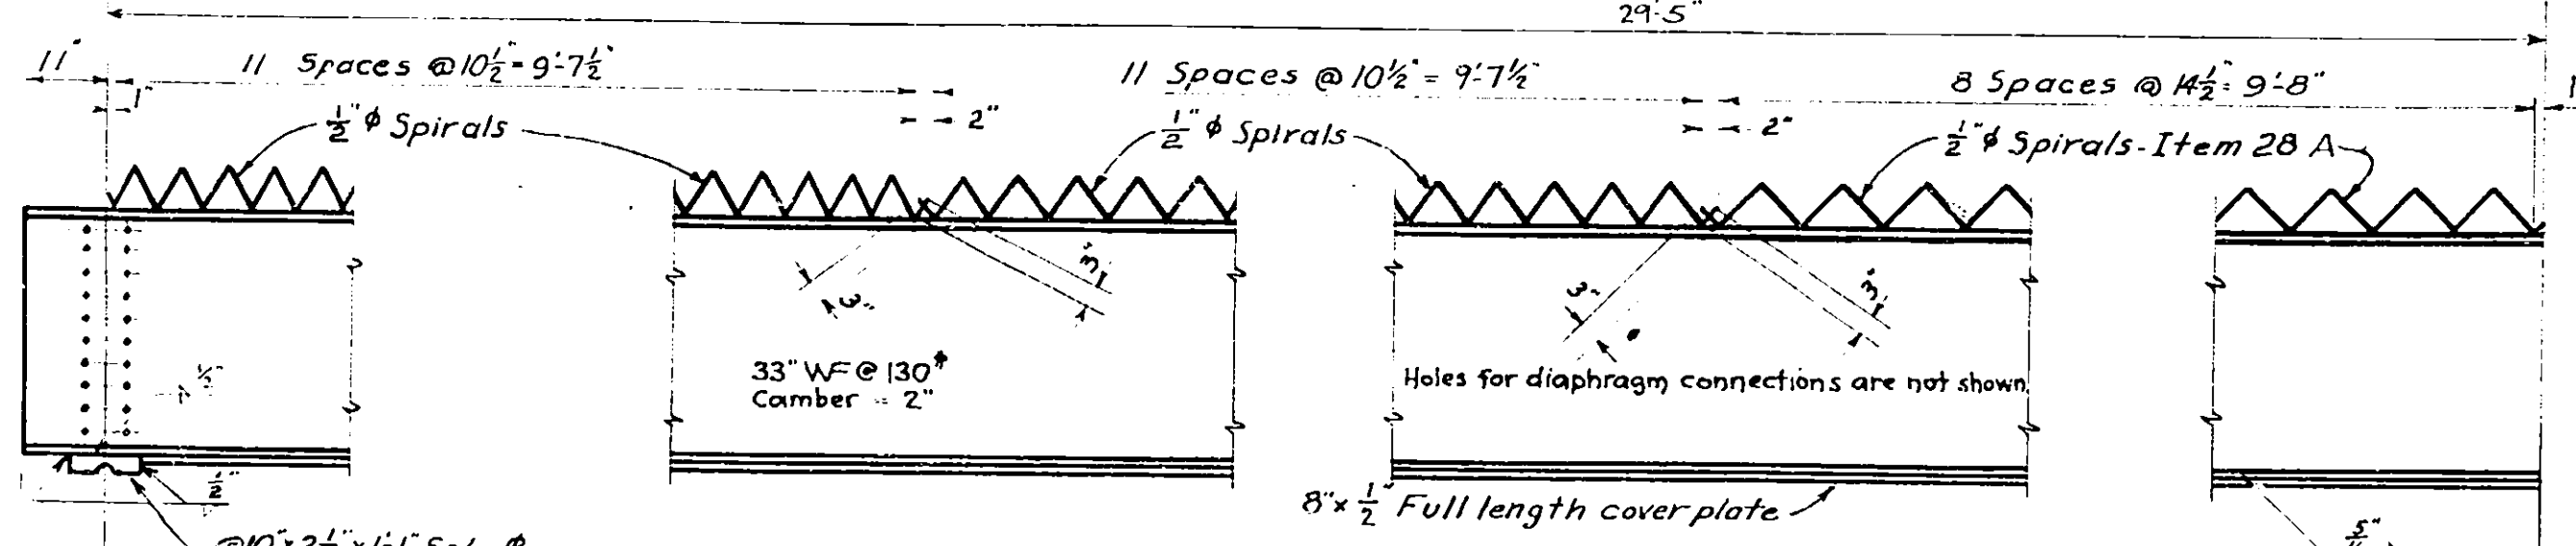


ELEVATION OF FASCIA STRINGERS NO. B6, B10, B11 & B15

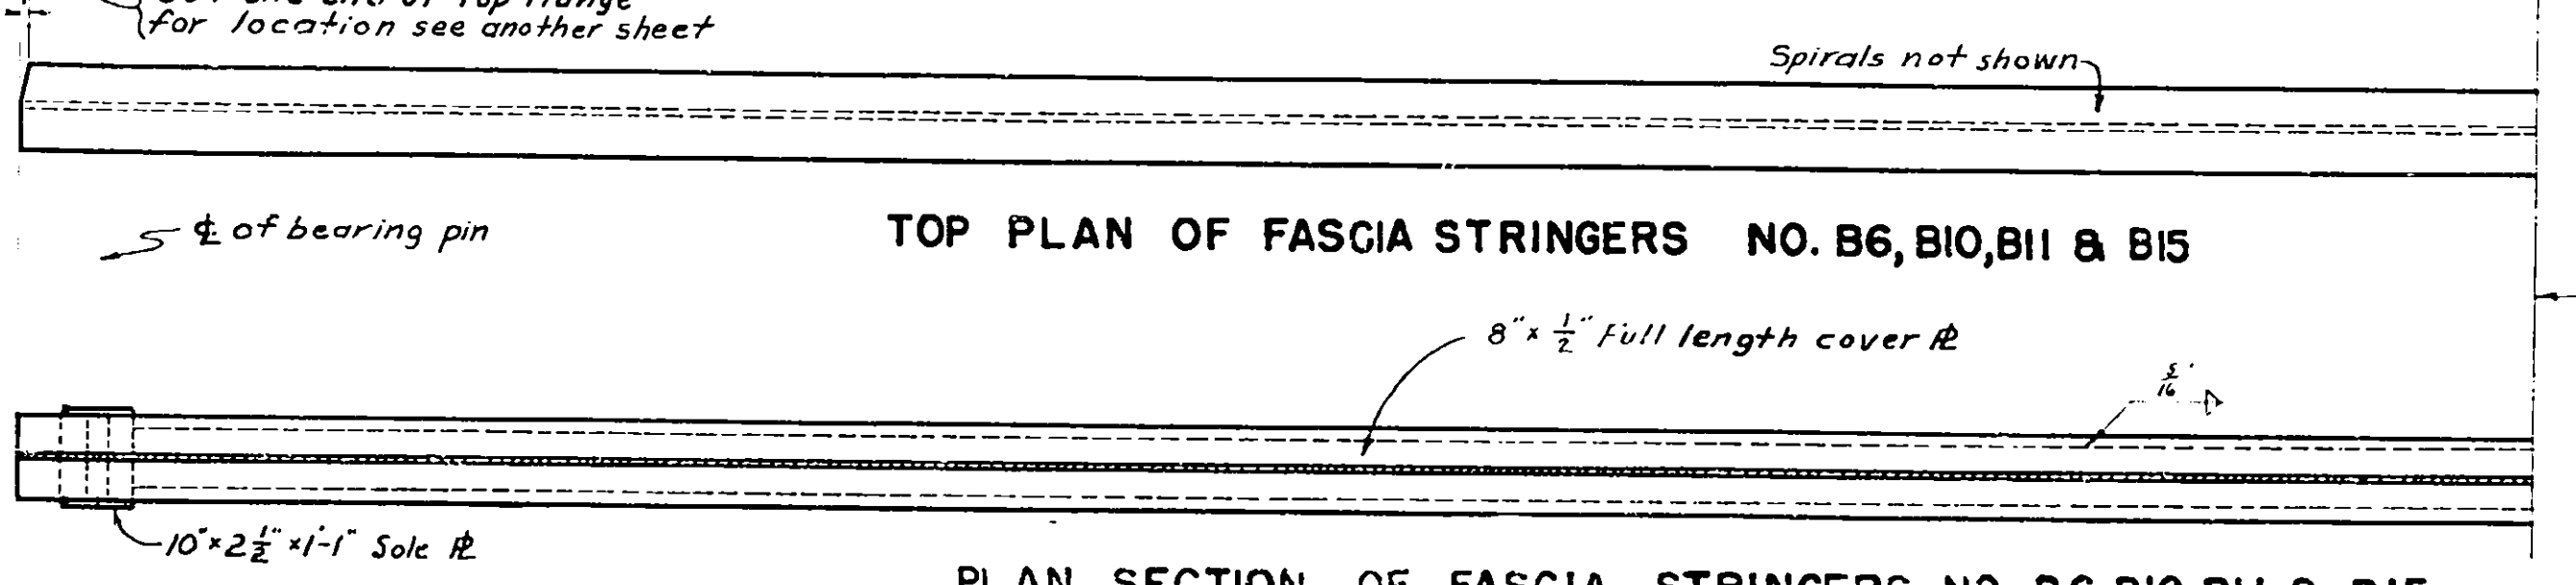

TOP PLAN OF FASCIA STRINGERS NO. B6, B10, B11 & B15

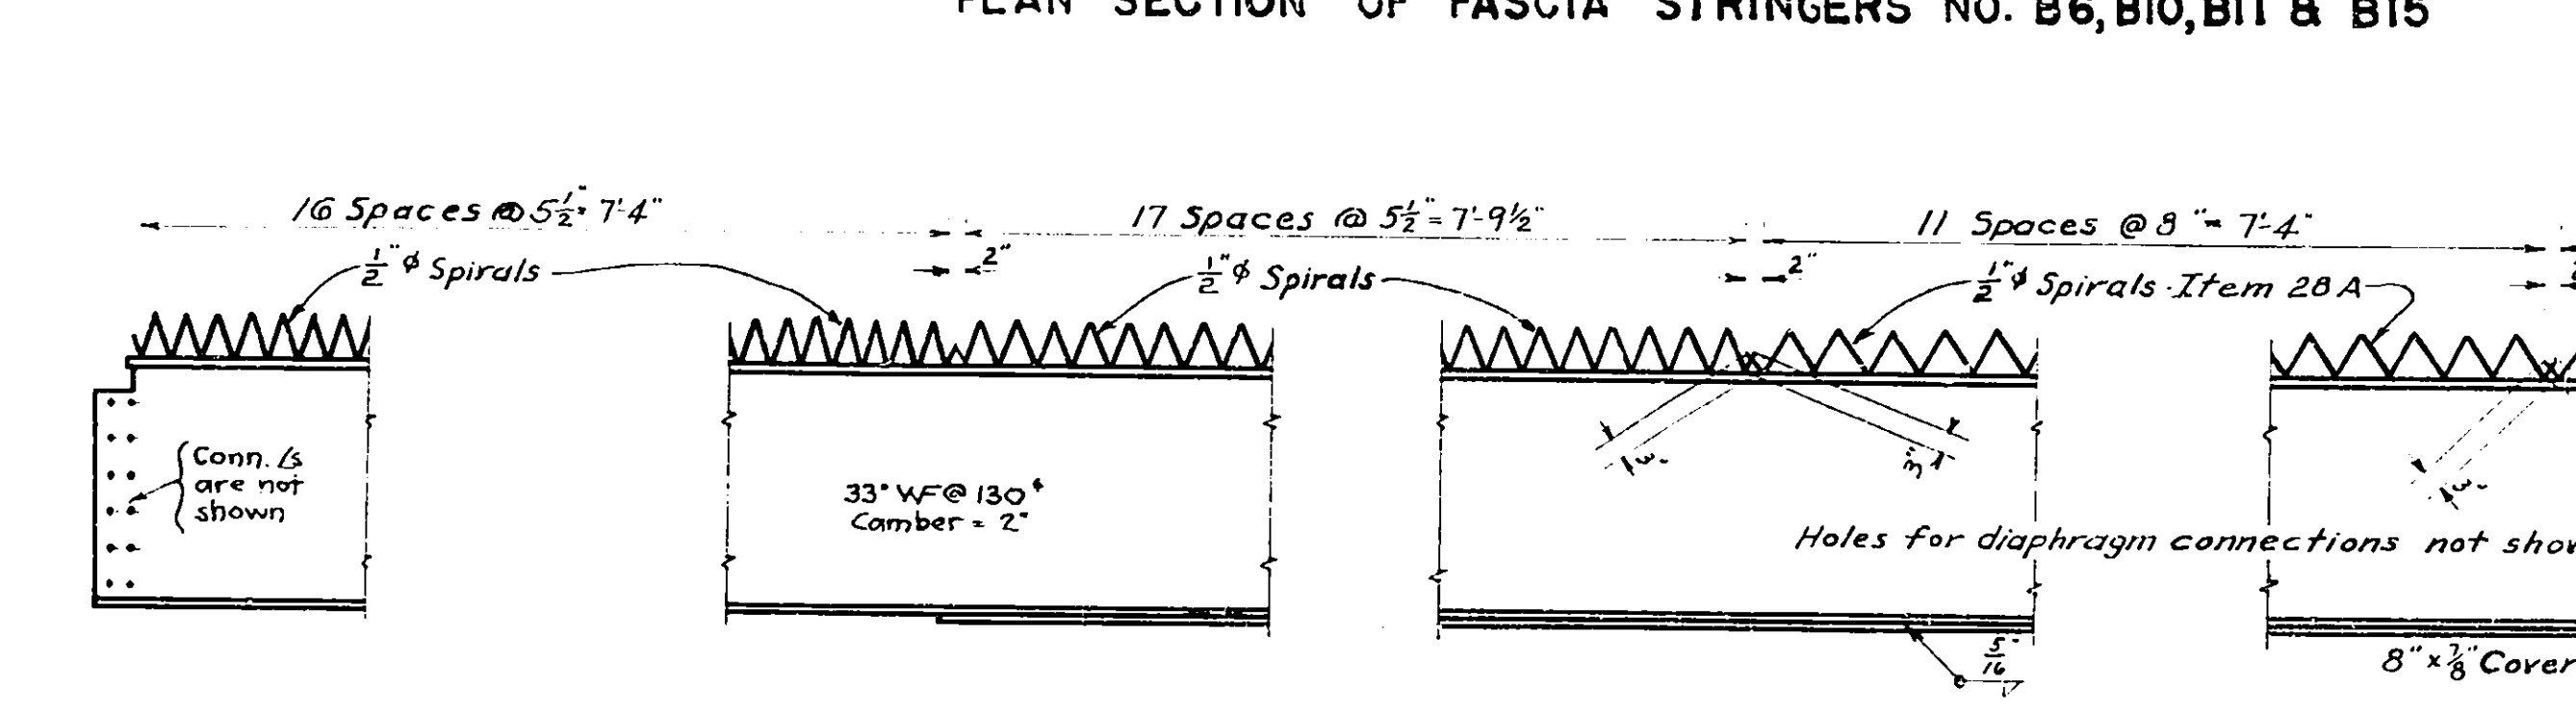


PLAN SECTION OF FASCIA STRINGERS NO. B6, B10, B11 & B15

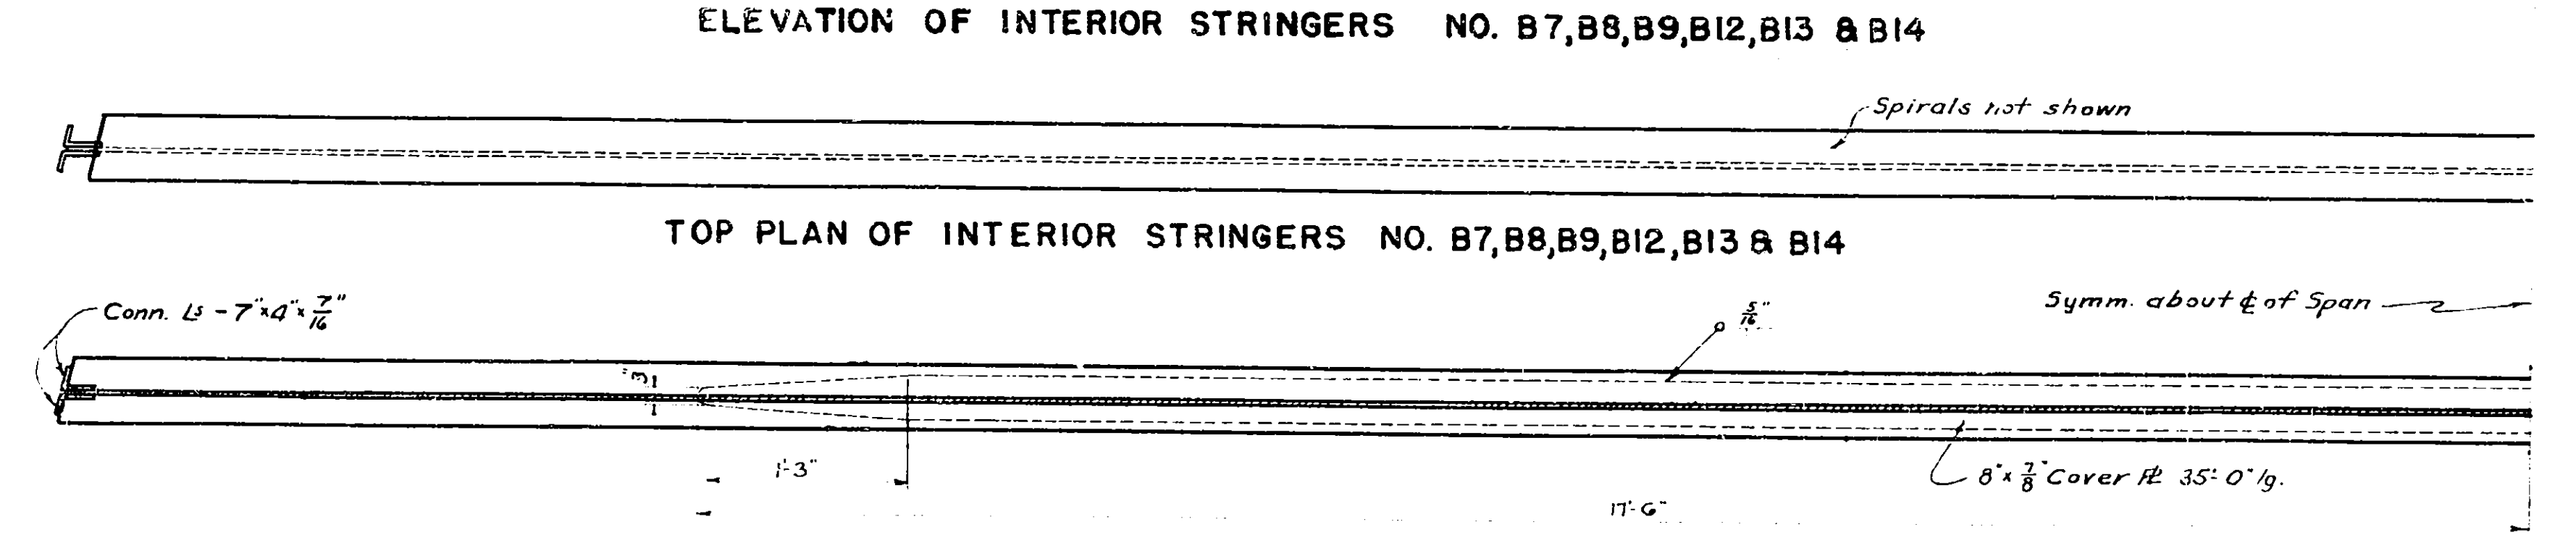


ELEVATION OF INTERIOR STRINGERS NO. B7, B8, B9, B12, B13 & B14




TOP PLAN OF INTERIOR STRINGERS NO. B7, B8, B9, B12, B13 & B14

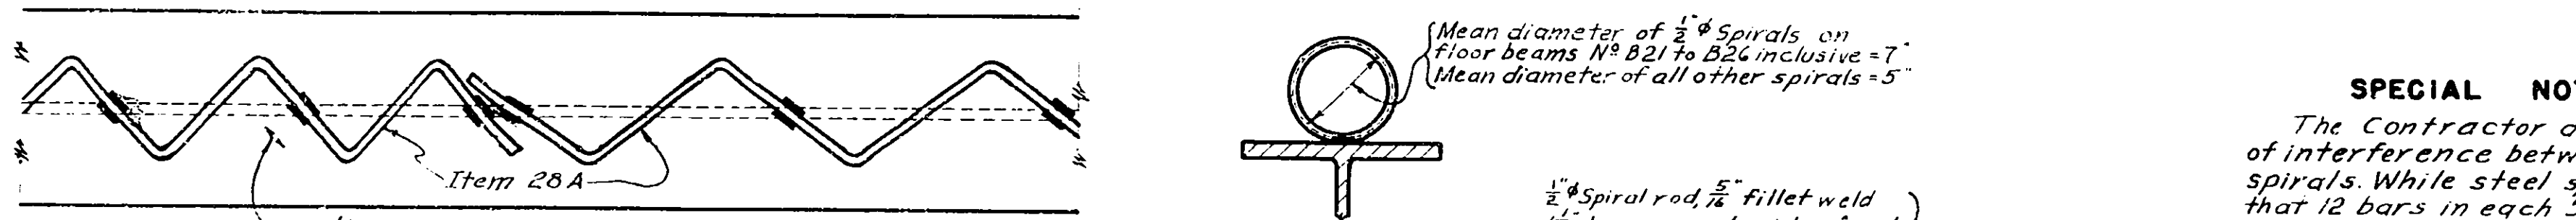


SECTION OF INTERIOR STRINGERS NO. B7, B8, B9, B12, B13 & B14

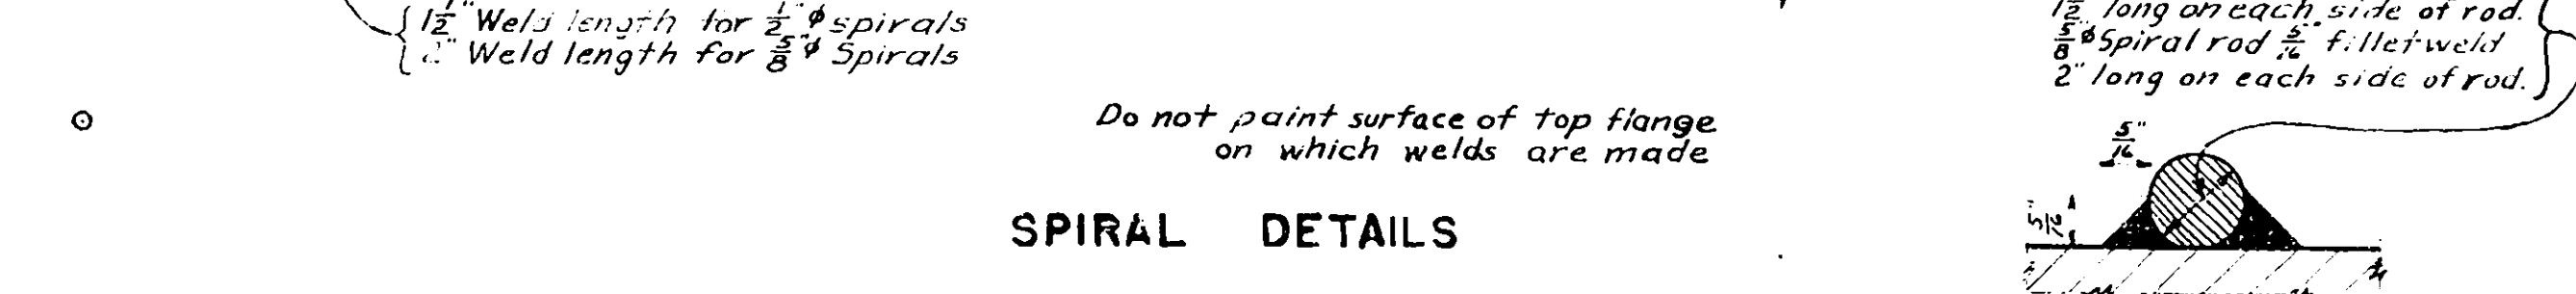


SPIRAL DETAILS

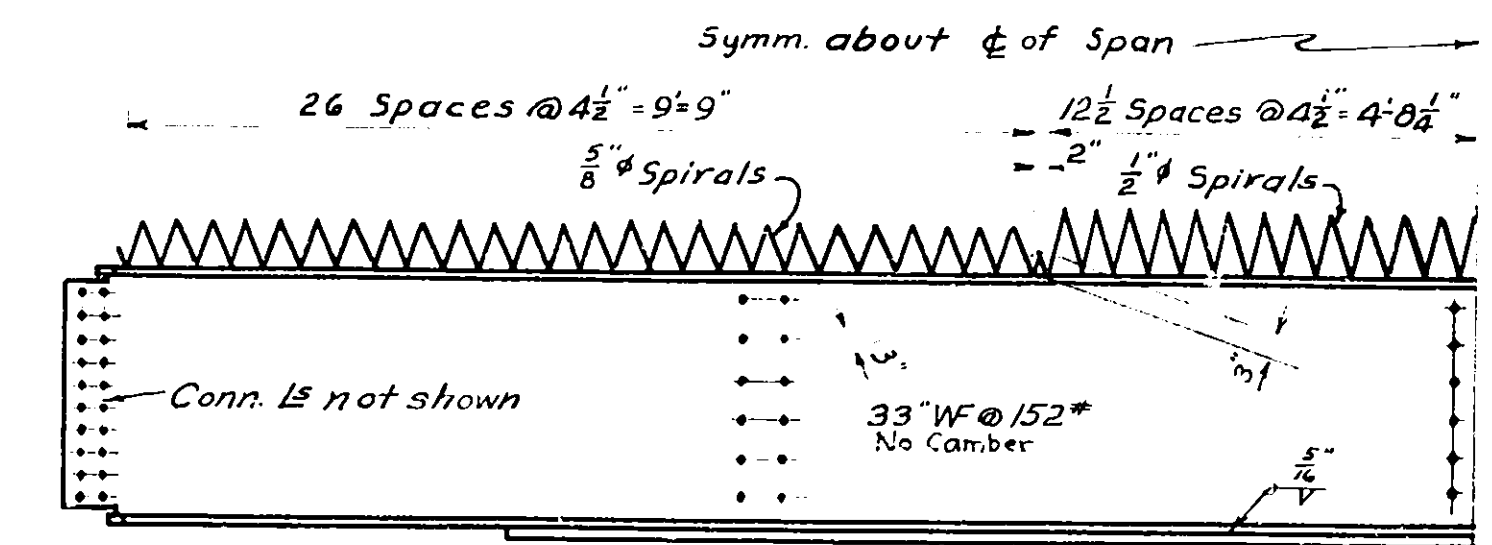


ELEVATION OF FLOOR BEAM NO. B22, B23, B24 & B25

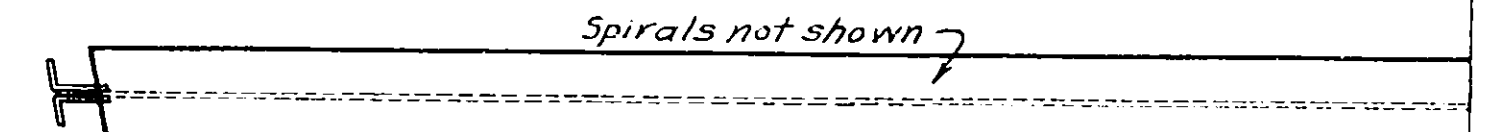


TOP PLAN OF FLOOR BEAM NO. B22, B23, B24 & B25

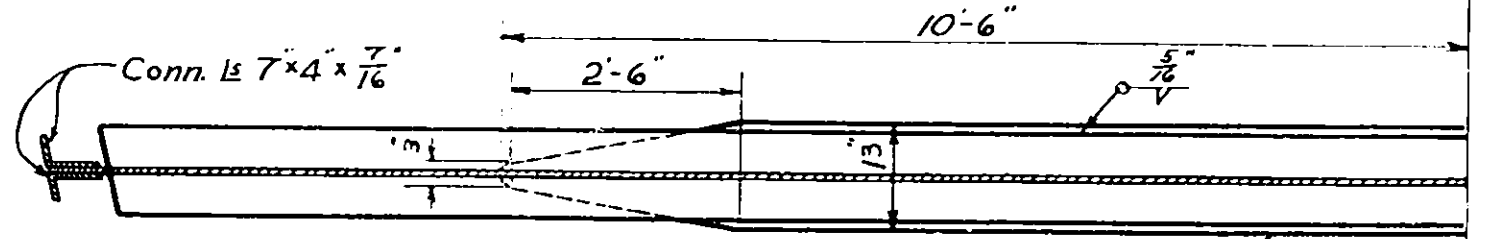


SECTION OF FLOOR BEAM NO. B22, B23, B24 & B25

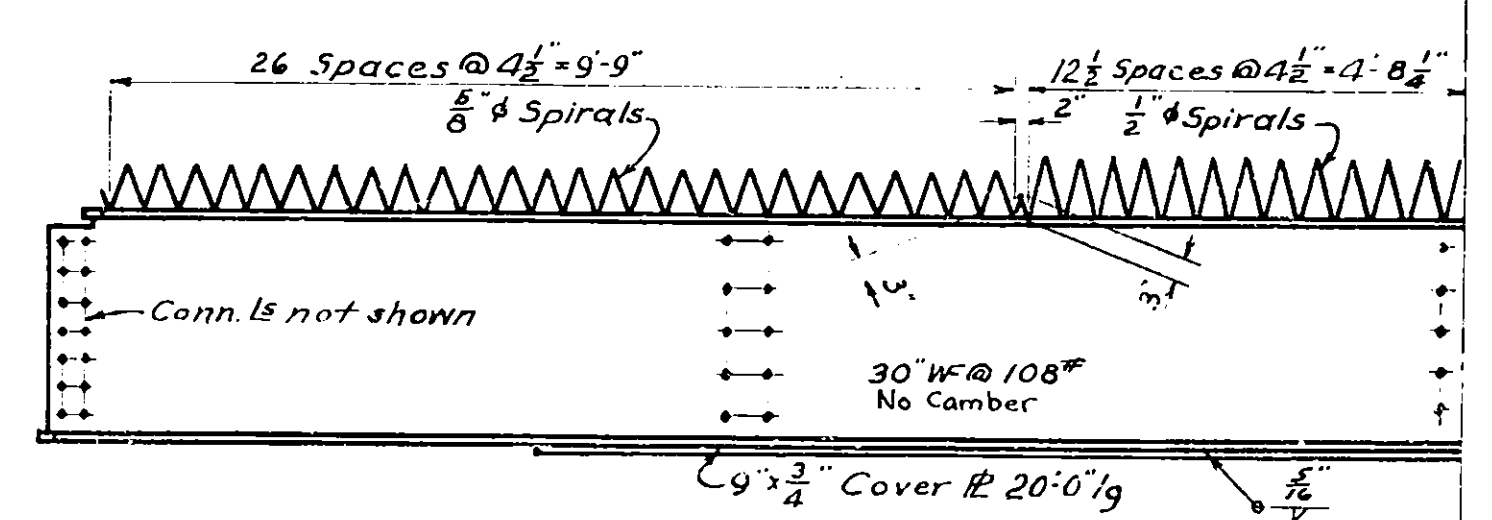

ELEVATION OF FLOOR BEAM NO. B21 & B26

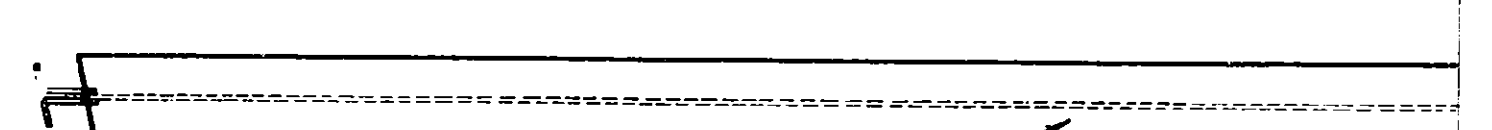

TOP PLAN OF FLOOR BEAM NO. 21 & 26

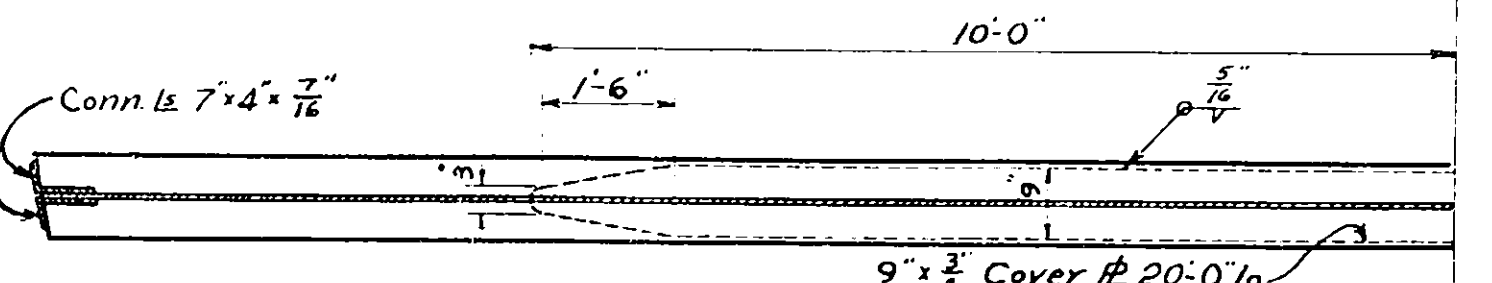


SECTION OF FLOOR BEAM NO. B21 & B26

SPECIAL NOTES FOR SPIRALS


The Contractor and Engineers attention is called to the possibility of interference between the reinforcing steel in the slab and the beam spirals. While steel spacing is given as 5 inches, it is to be understood that 12 bars in each 5 ft 0 in. will fill this requirement if no two bars are closer than 4 in. ctrs. or further apart than 6 in. ctrs. and even then some bars may have to be threaded thru one or more spirals. All spirals must have 2 structural welds 1/2 inch x 1/2 inch long for 1/2 inch spirals and 5/8 inch x 2 inch long for 5/8 inch spirals at each point of contact with the beam, one weld on each side of bar as shown. 5/32 or 1/16 Diameter electrodes shall be used in welding the spiral bar shear connectors. Special precautions must be exercised where welding crosses edge of flange to avoid any possibility of 'under-cut' or nicks in edge of flange.

FED. AID DIST. NO.	STATE	FED. AID PROJ. NO.	FISCAL YEAR	SHEET NO.	TOTAL SHEETS
	N. Y.			57	67


FROM MADISON TO THRUWAY COUN. V.

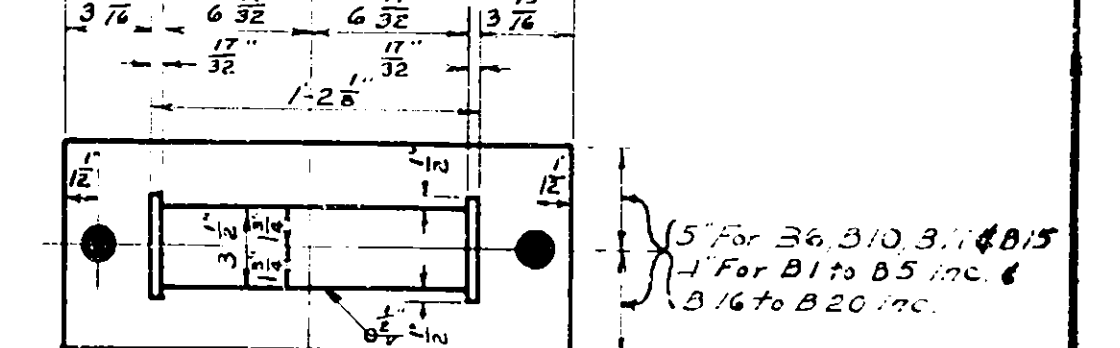


PLAN

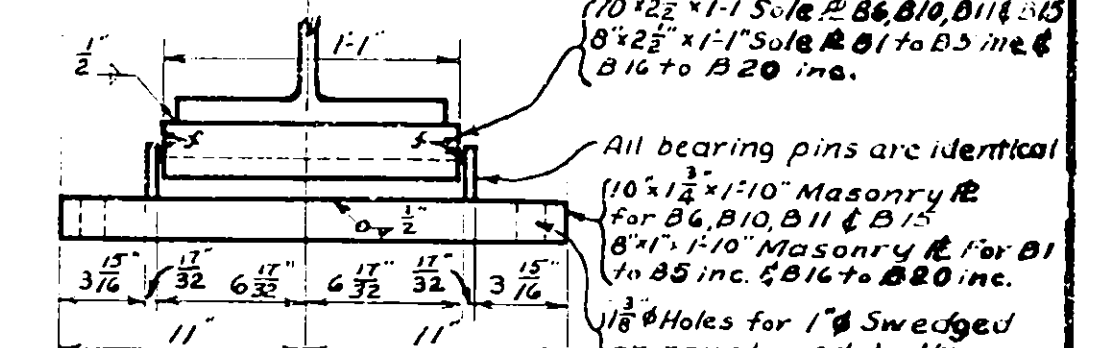


END ELEVATION

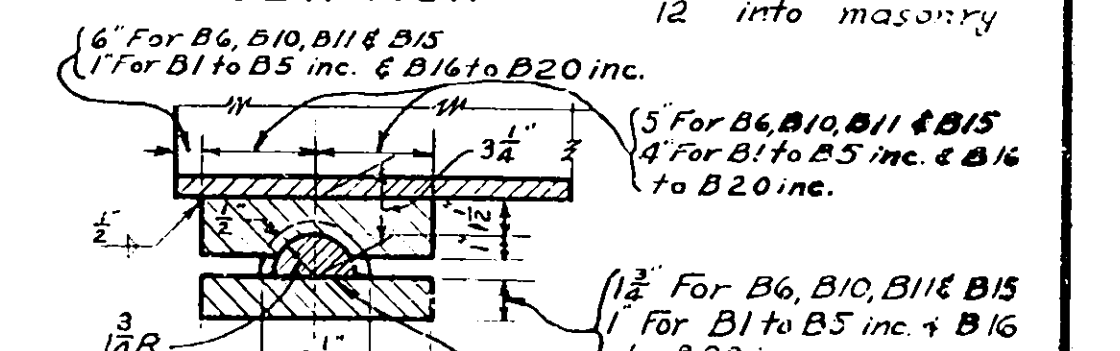


SECTION FIXED BEARING DETAILS

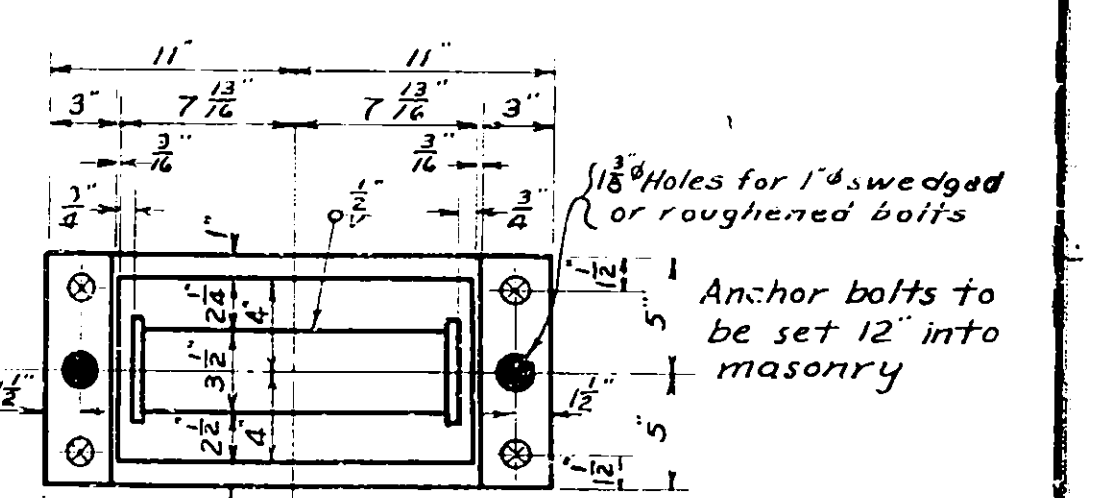

PLAN

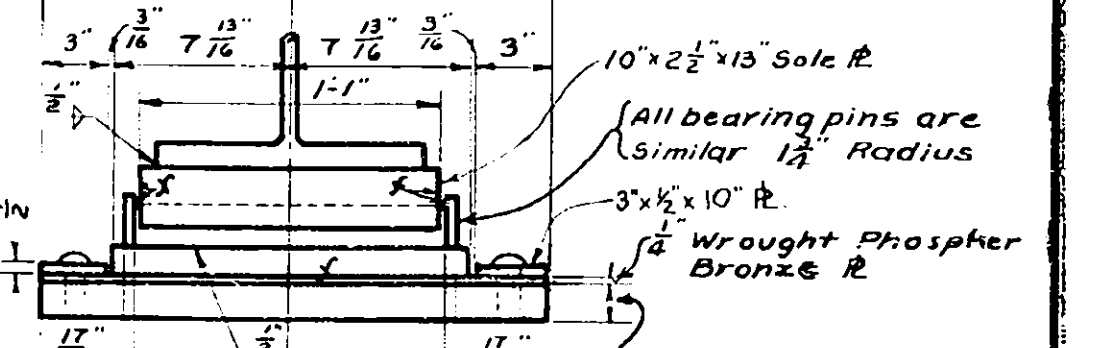


END ELEVATION

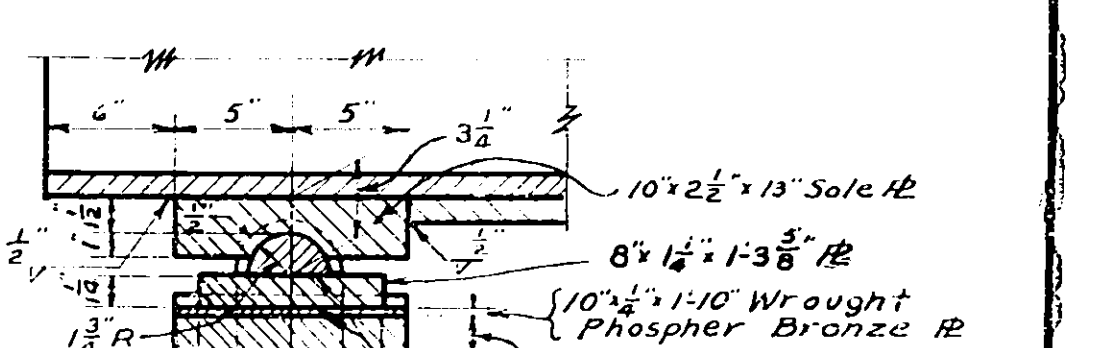


SECTION EXPANSION BEARING DETAILS

NORTH MAIN STREET
STA. 588 + 82
STRINGERS, FLOOR BEAMS AND BEARINGS


FED. AID DIST. NO.	STATE	FED. AID PROJ. NO.	FISCAL YEAR	SHEET NO.	TOTAL SHEETS
	N. Y.			52	67
MOHAWK			THRDWAY		
FROM			TO		
MADISON			COUNTY		

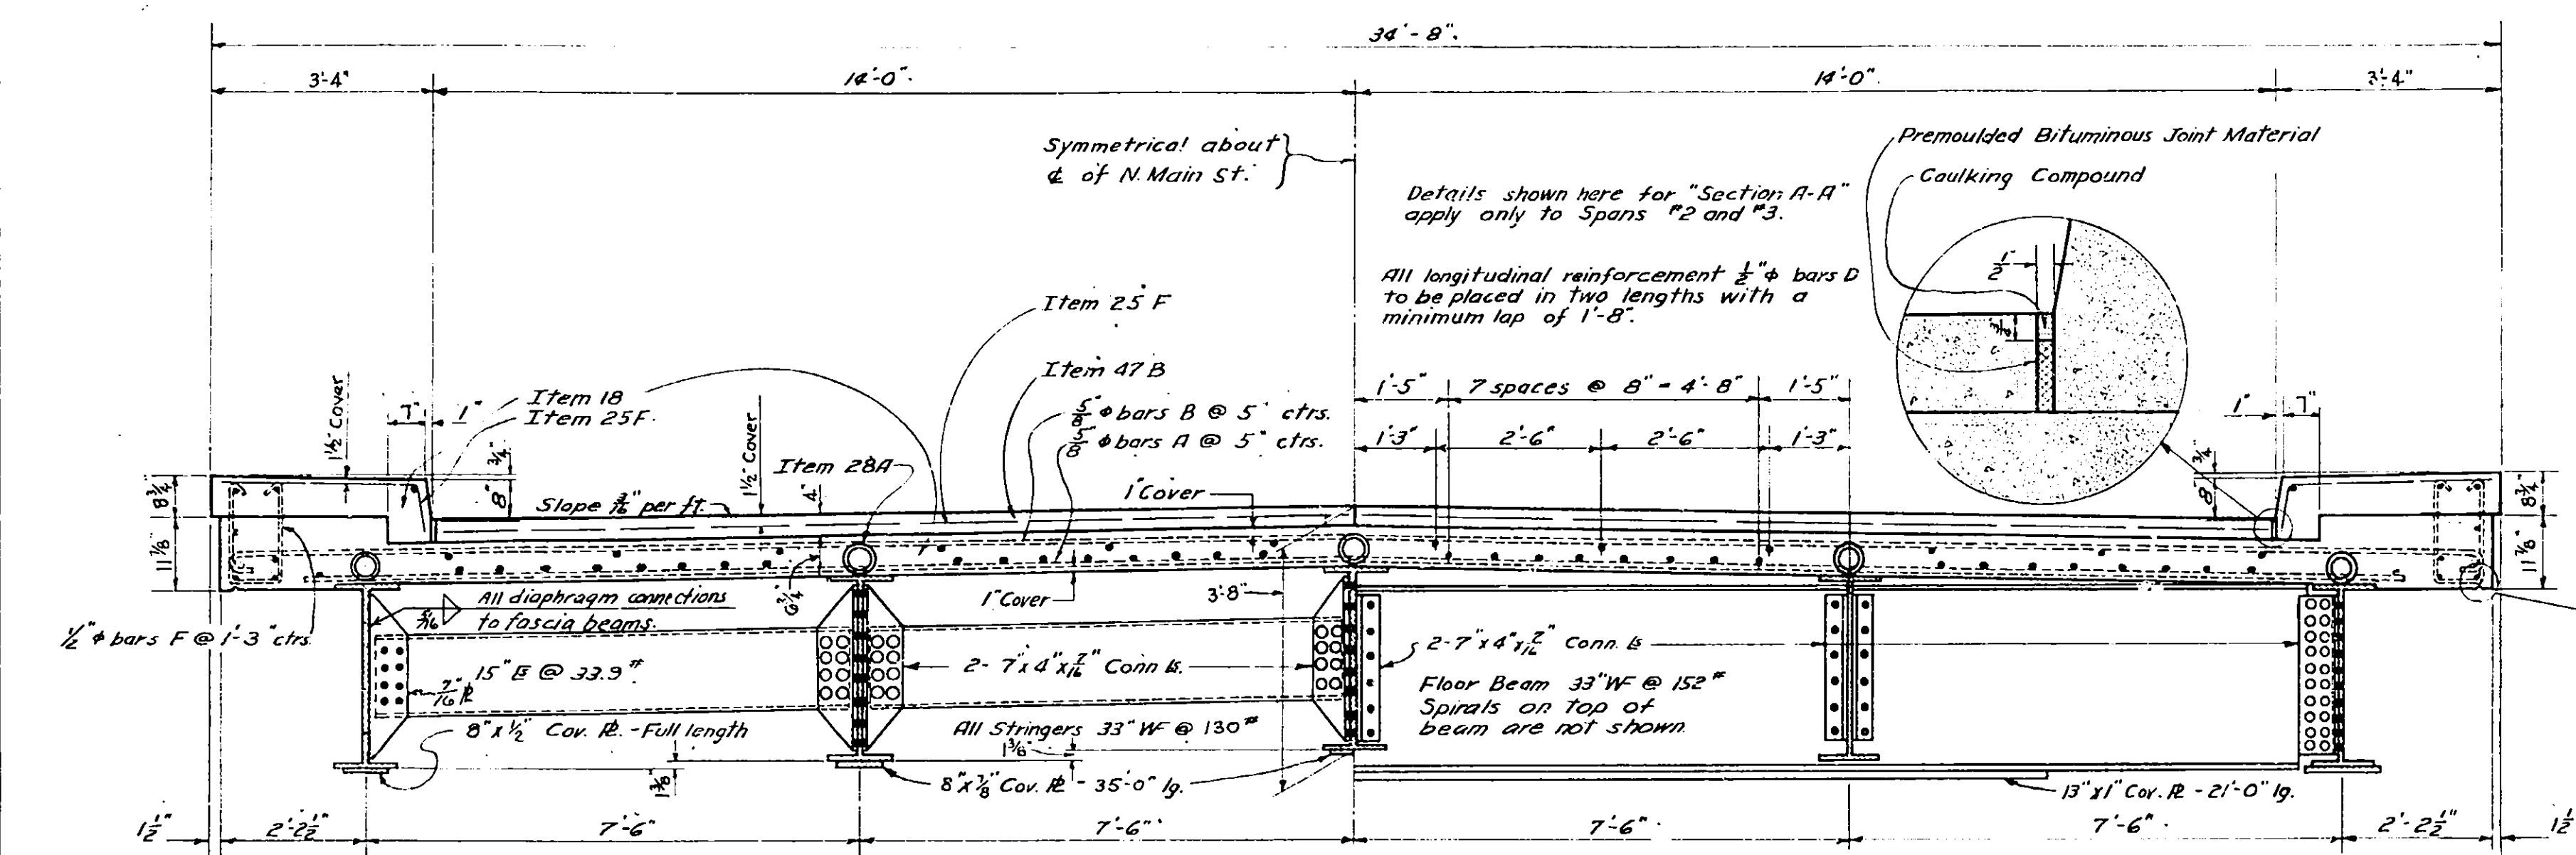


SECTION A-A

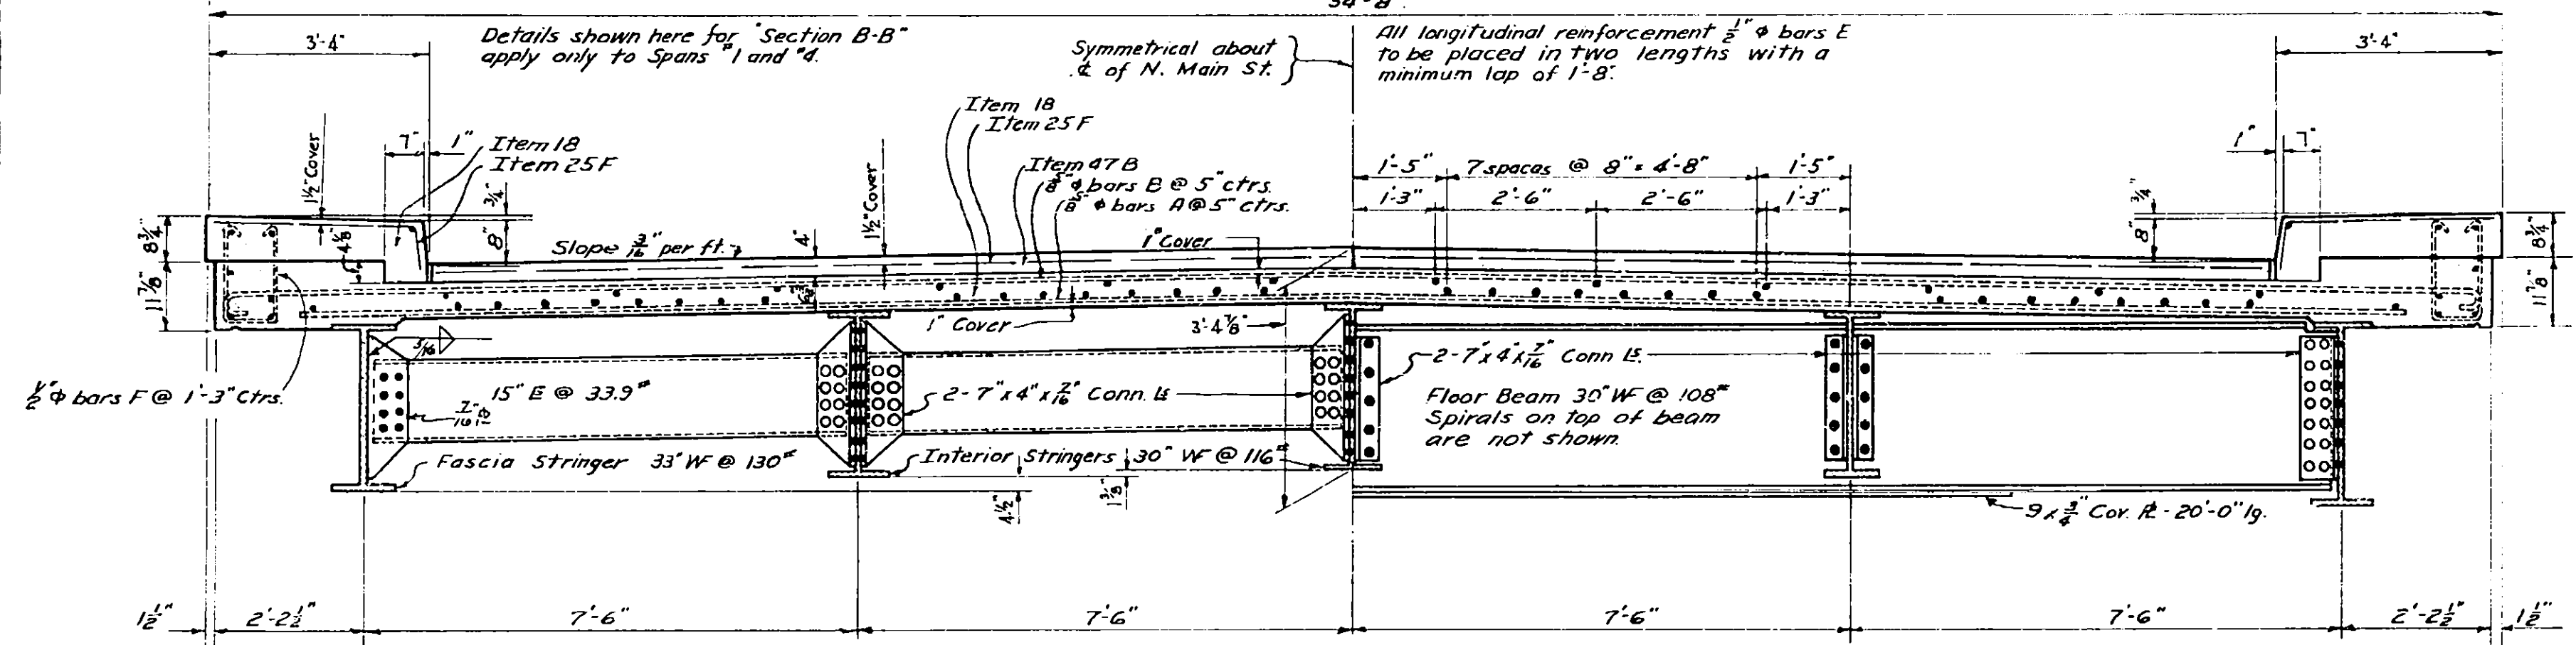Scale: $\frac{1}{2}'' = 1'-0''$ 


SECTION B-B

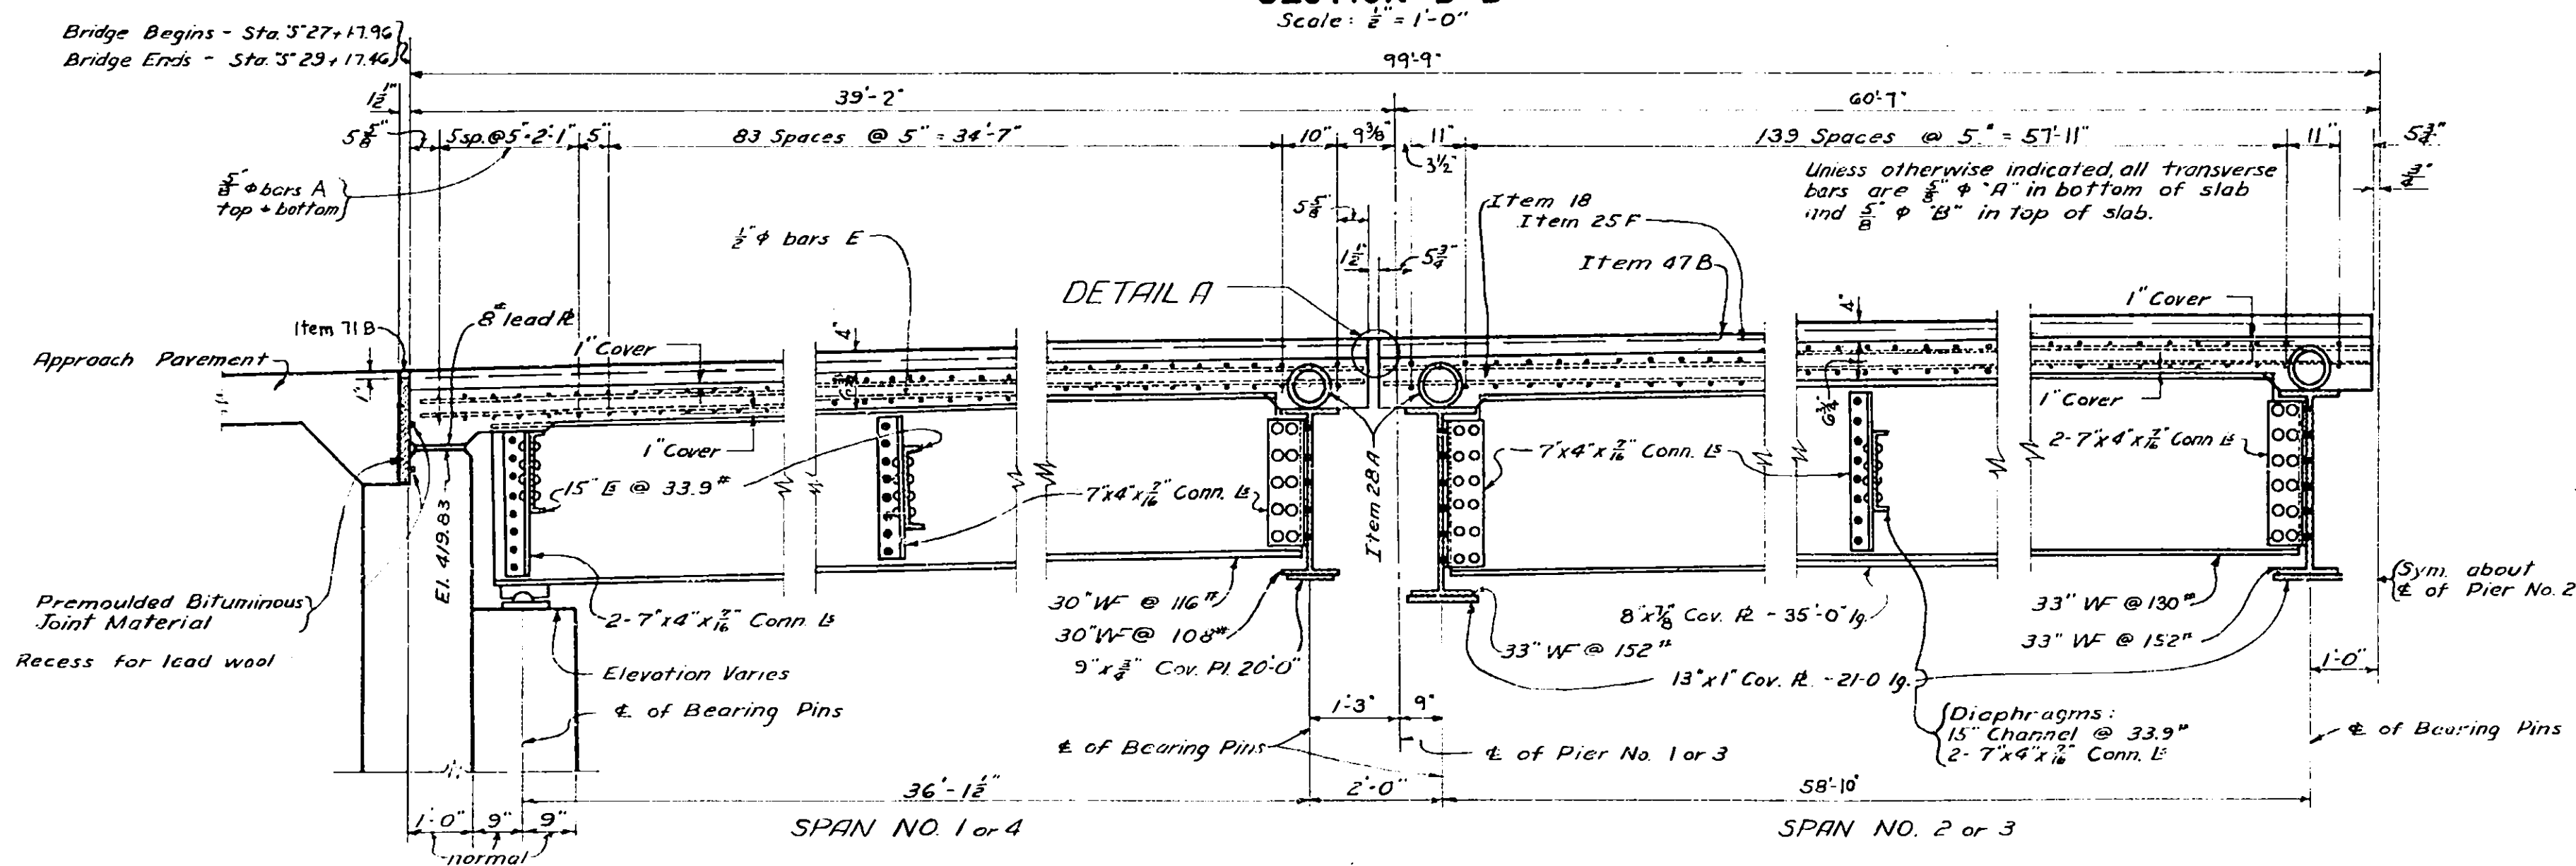Scale: $\frac{1}{2}'' = 1'-0''$ 


HALF LONGITUDINAL SECTION

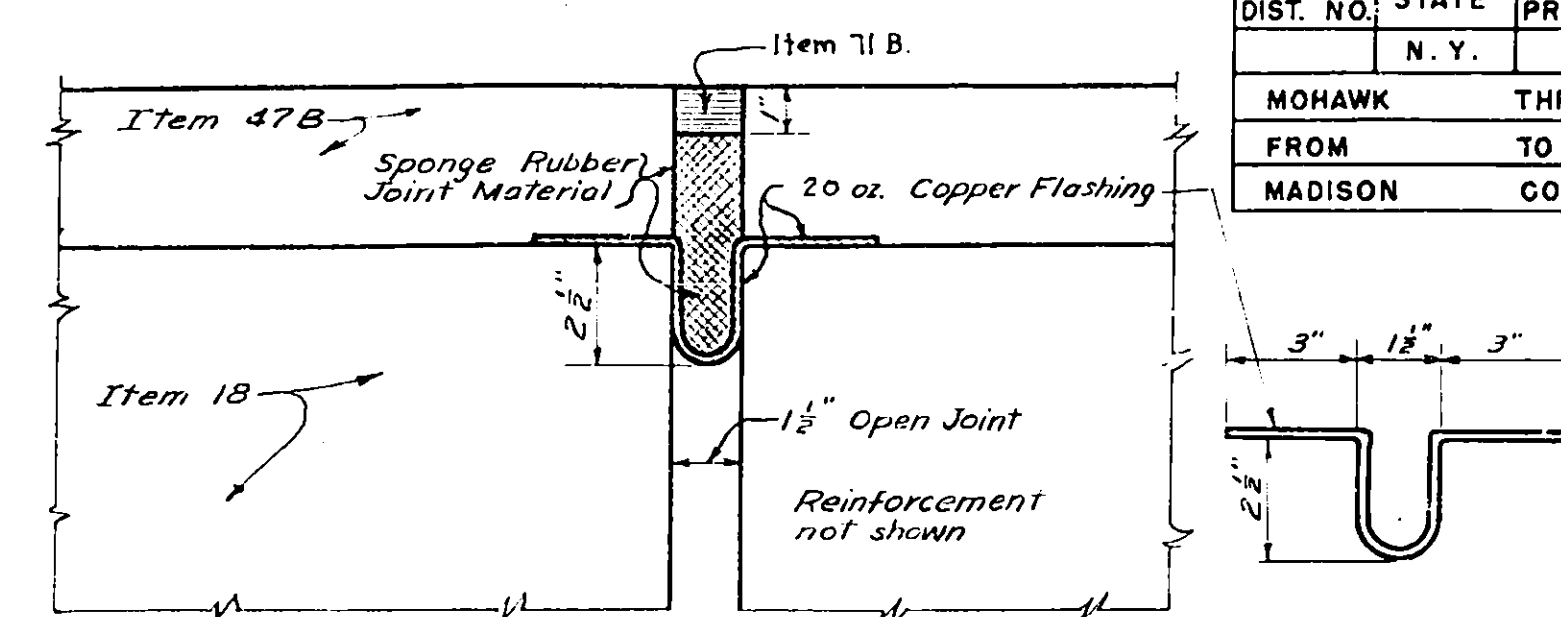Scale: $\frac{1}{2}'' = 1'-0''$ 


DETAIL A

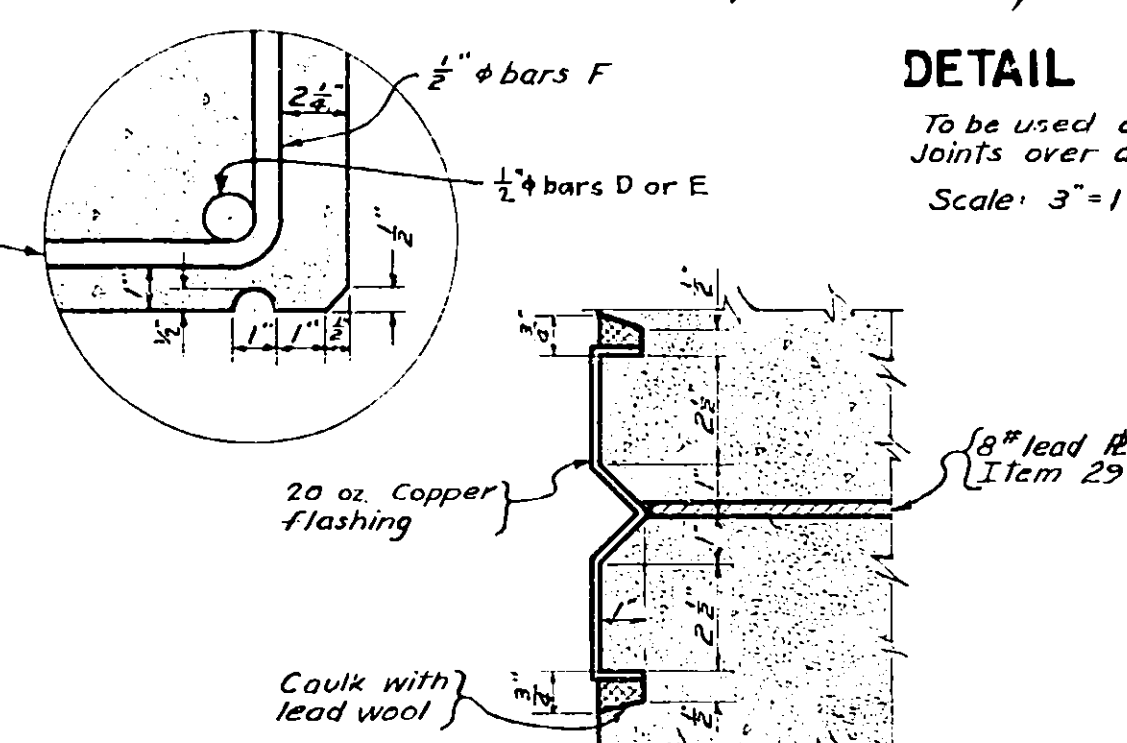To be used at all joints over all piers
Scale: $3'' = 1'-0''$ 

DETAIL AT FLASHING ON ABUTMENT



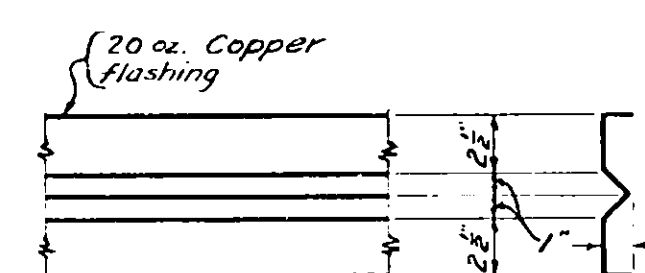
Scale: $3'' = 1'-0''$ 

COPPER FLASHING DETAIL

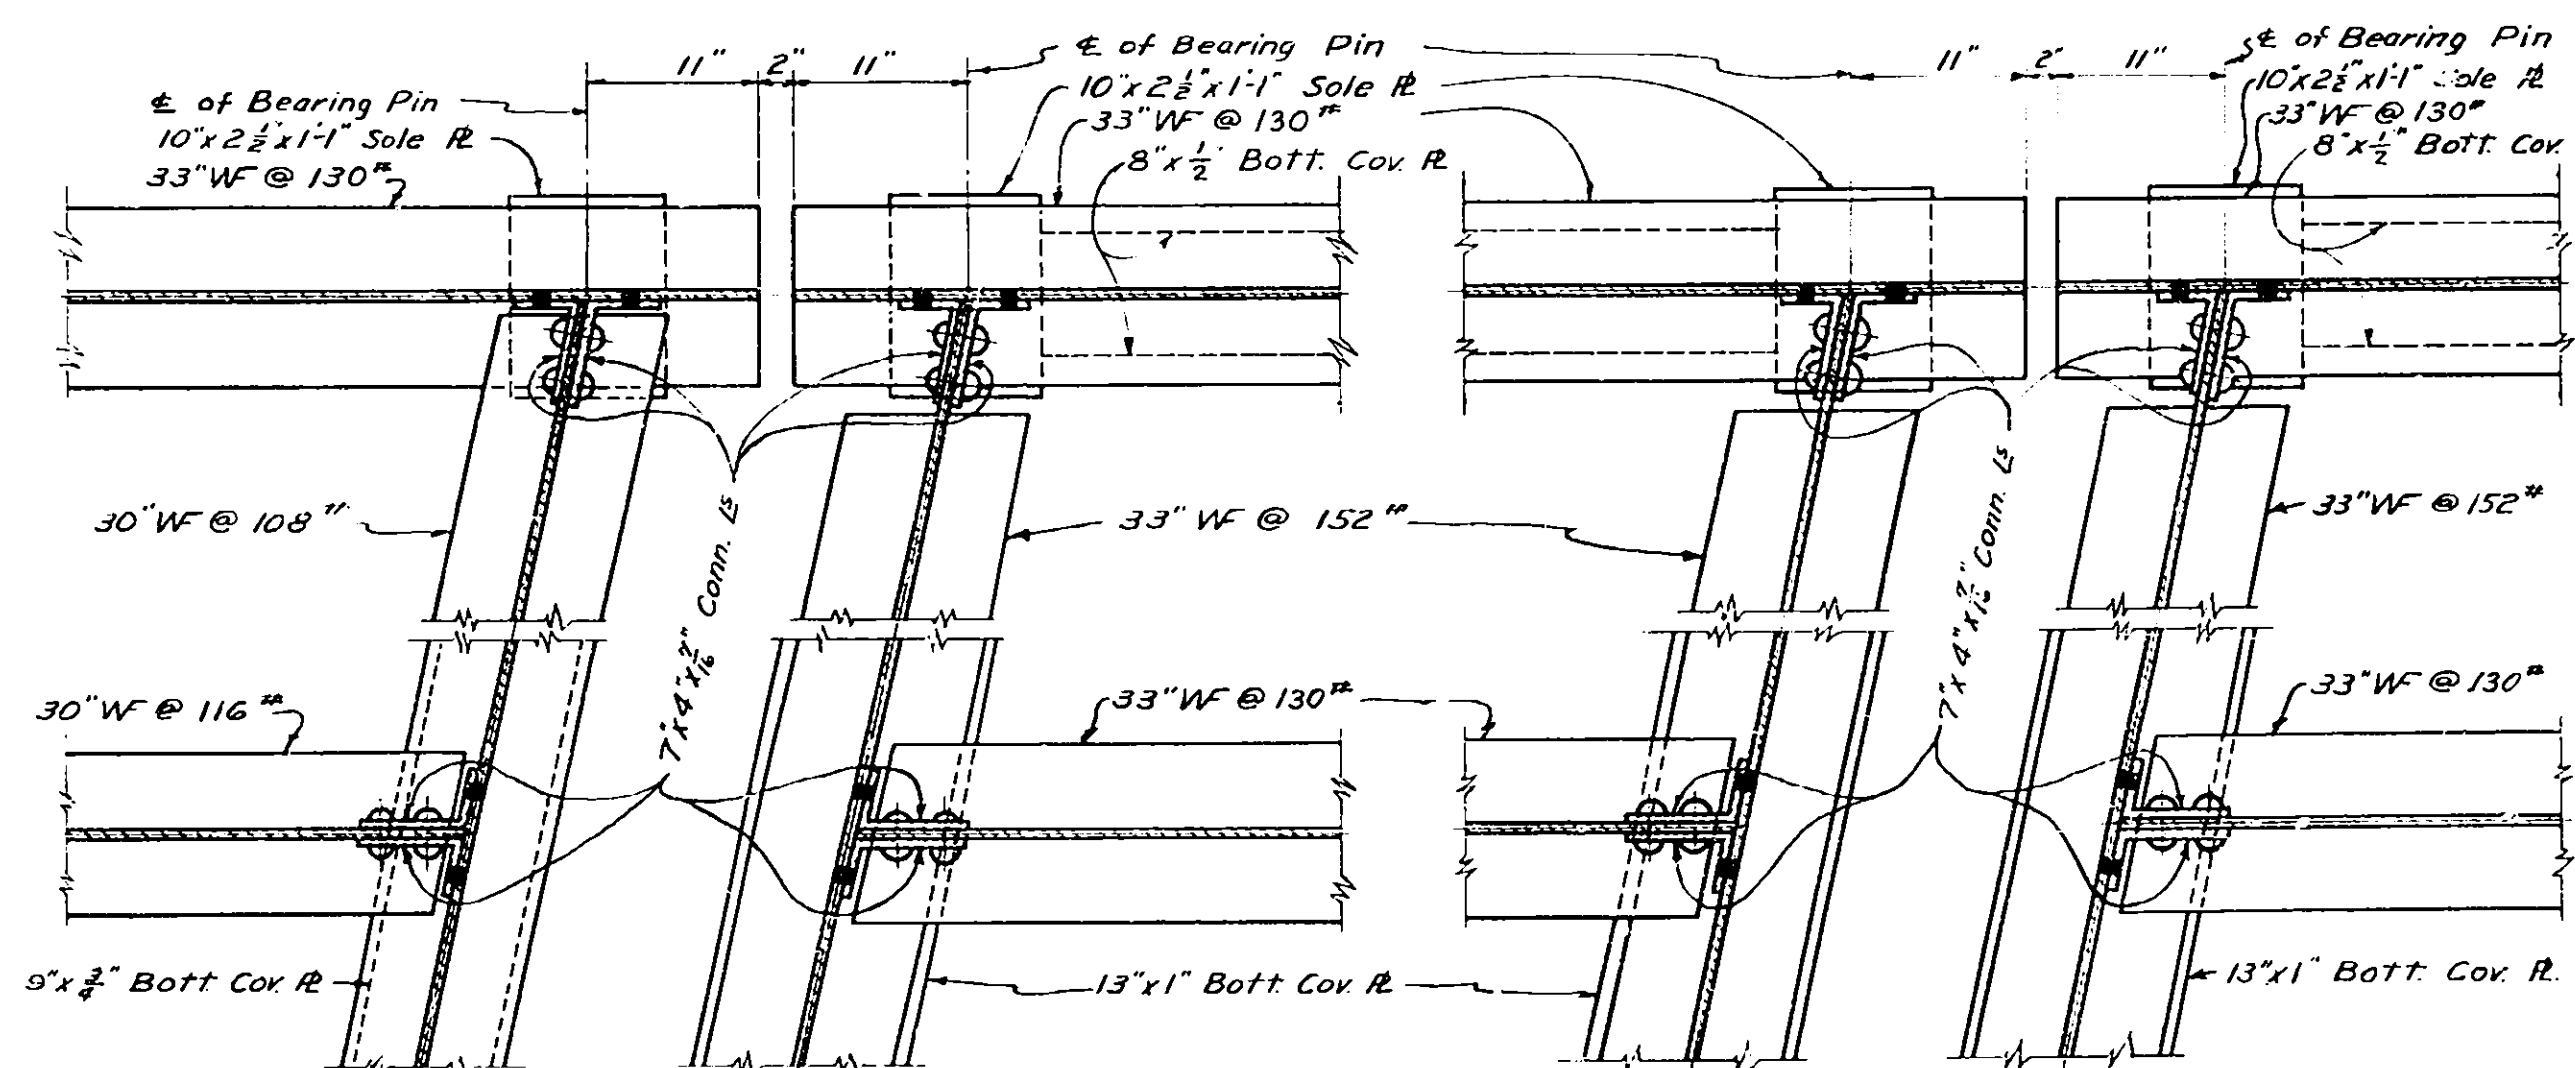Scale: $1\frac{1}{2}'' = 1'-0''$ PARTIAL PLAN OF BEAM CONNECTIONS
OVER PIER NO 1 & PIER NO 3PARTIAL PLAN OF BEAM CONNECTIONS
OVER PIER NO 2Scale: $1'' = 1'-0''$













NORTH MAIN STREET
STA. 588 + 82
SUPERSTRUCTURE

FED. AID DIST. NO.	STATE	FED. AID PROJ. NO.	FISCAL YEAR	SHEET NO.	TOTAL SHEETS
	N. Y.			53	67
FROM MOHAWK			THRUWAY TO		
MADISON			COUNTY		

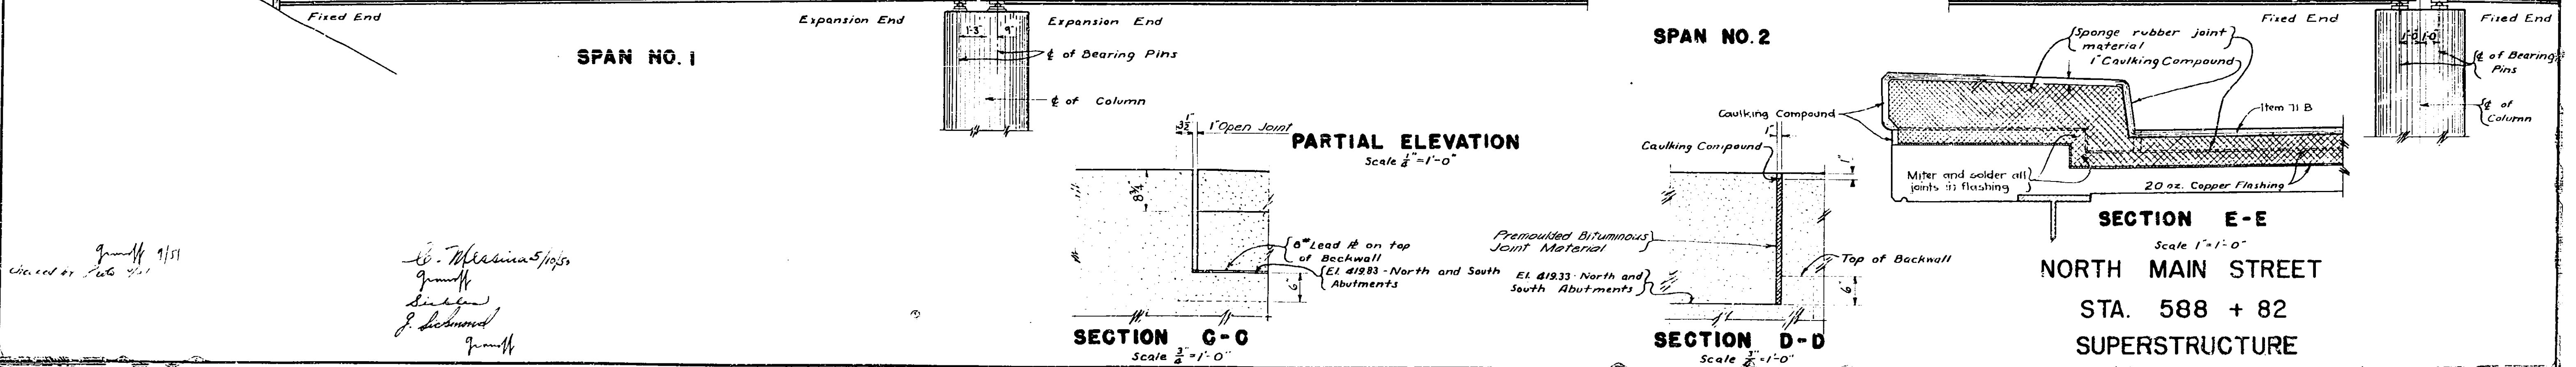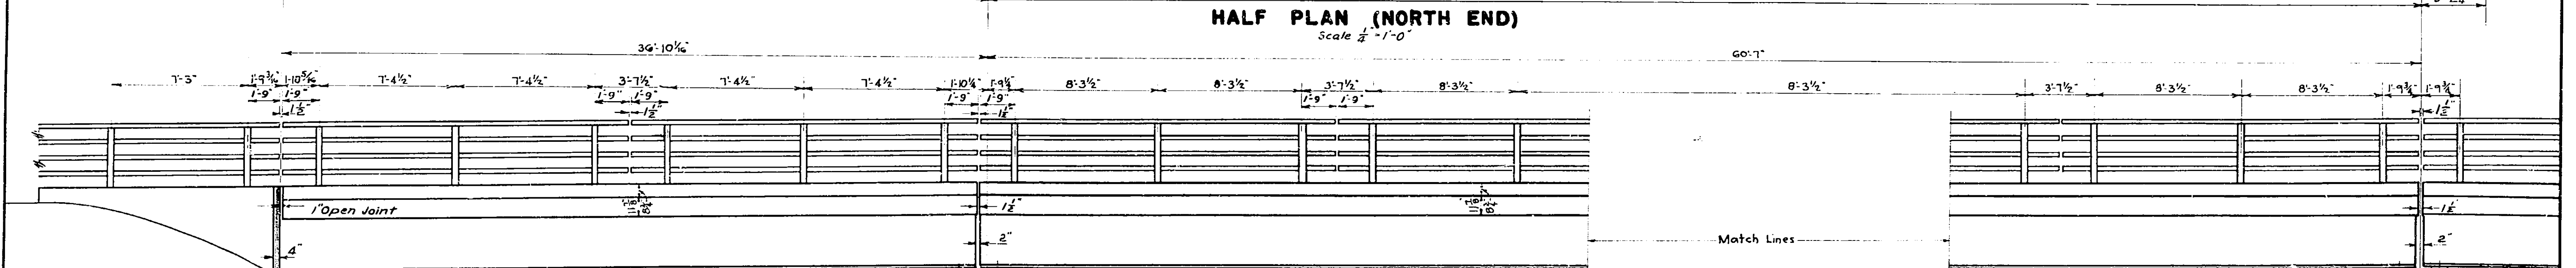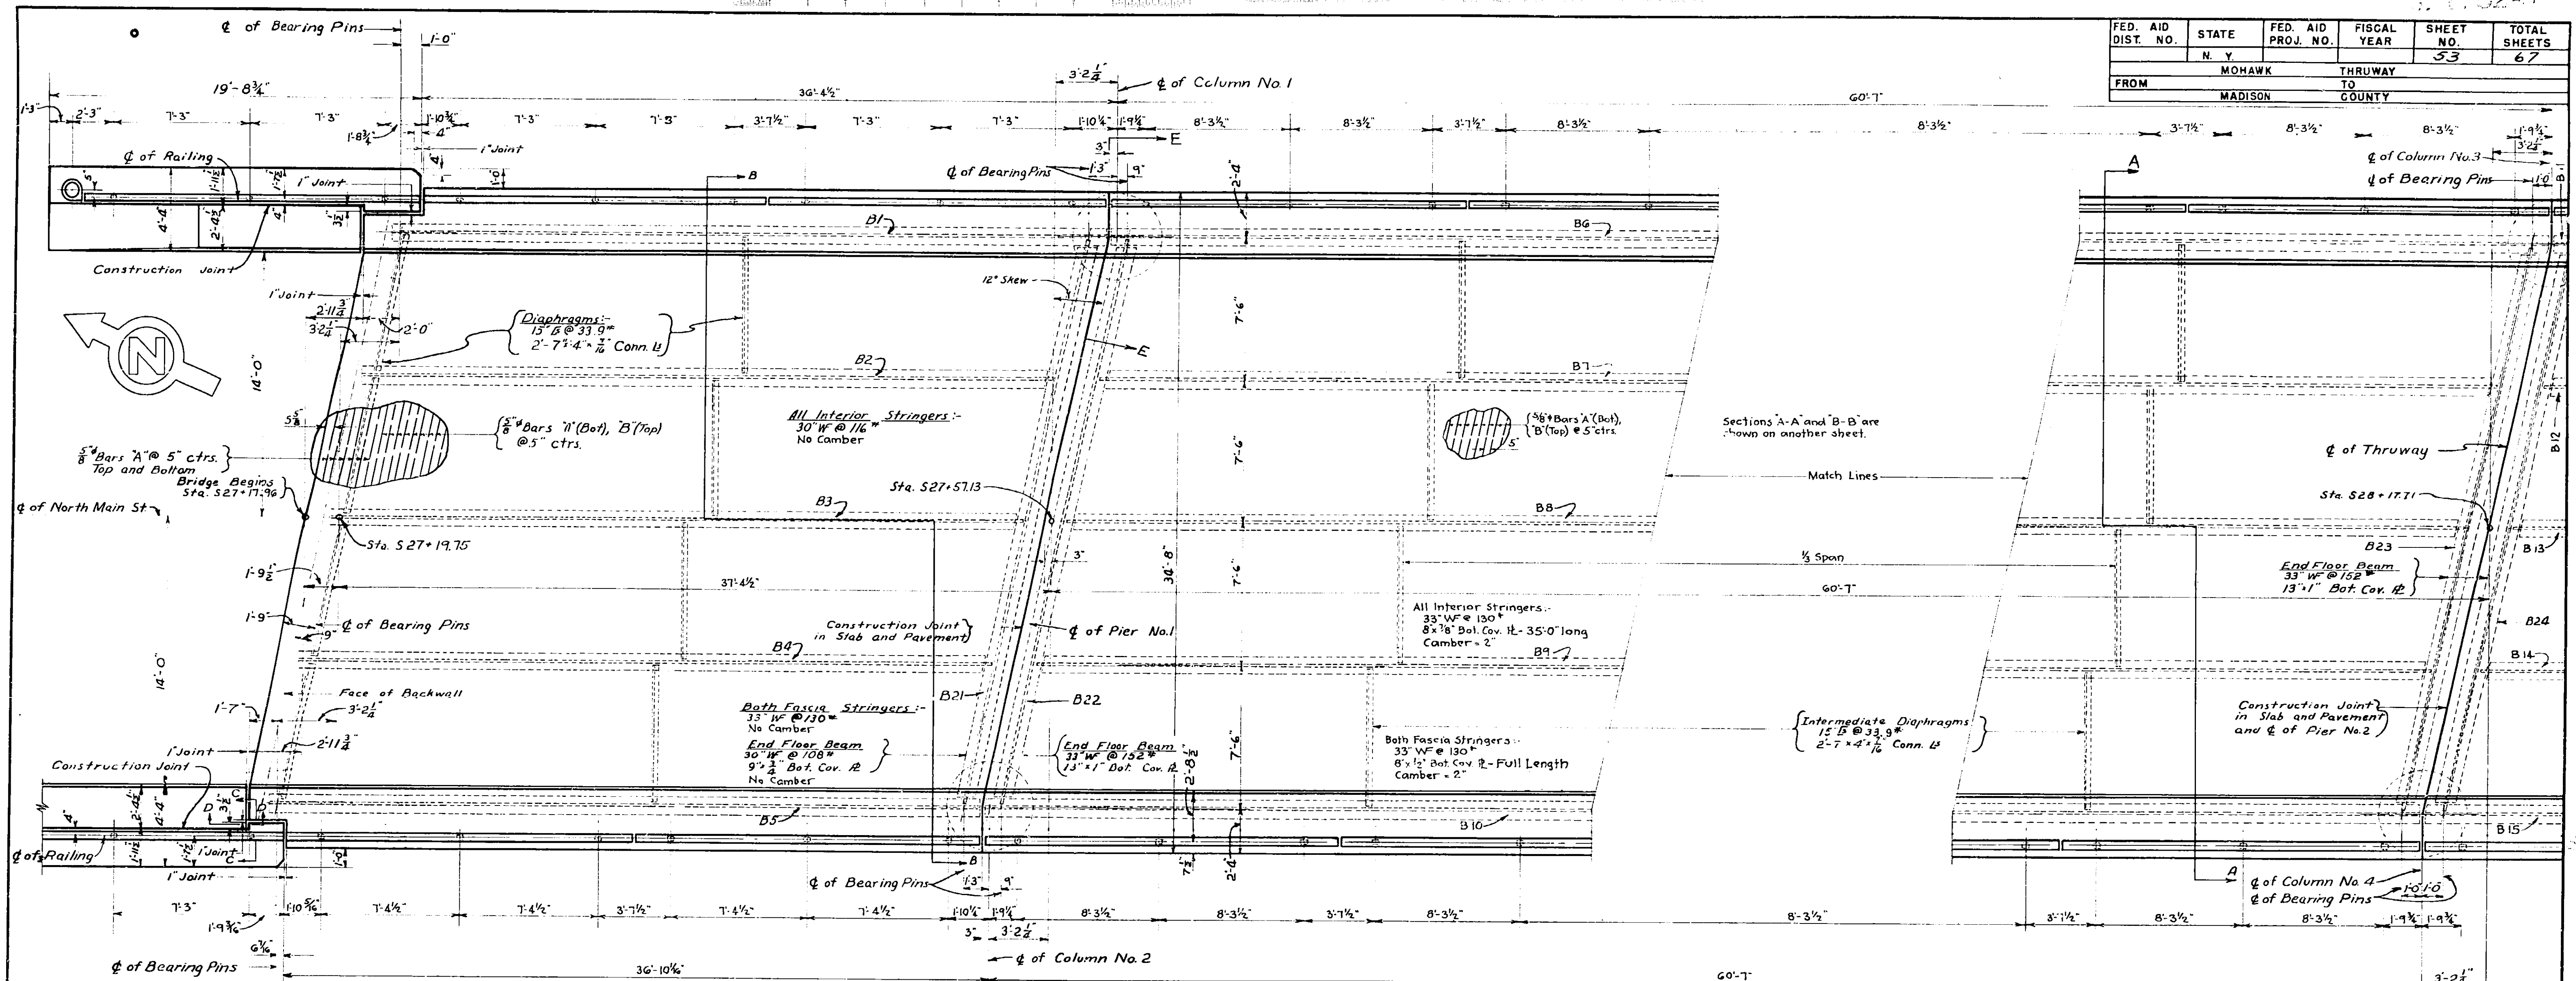

Checked by 9/11
G. W. Williams 5/10/53
J. Schumacher
J. Schumacher

FED. AID DIST. NO.	STATE	FED. AID PROJ. NO.	FISCAL YEAR	SHEET NO.	TOTAL SHEETS
	N. Y.			55	67
FROM MOHAWK			THRUWAY TO MADISON COUNTY		

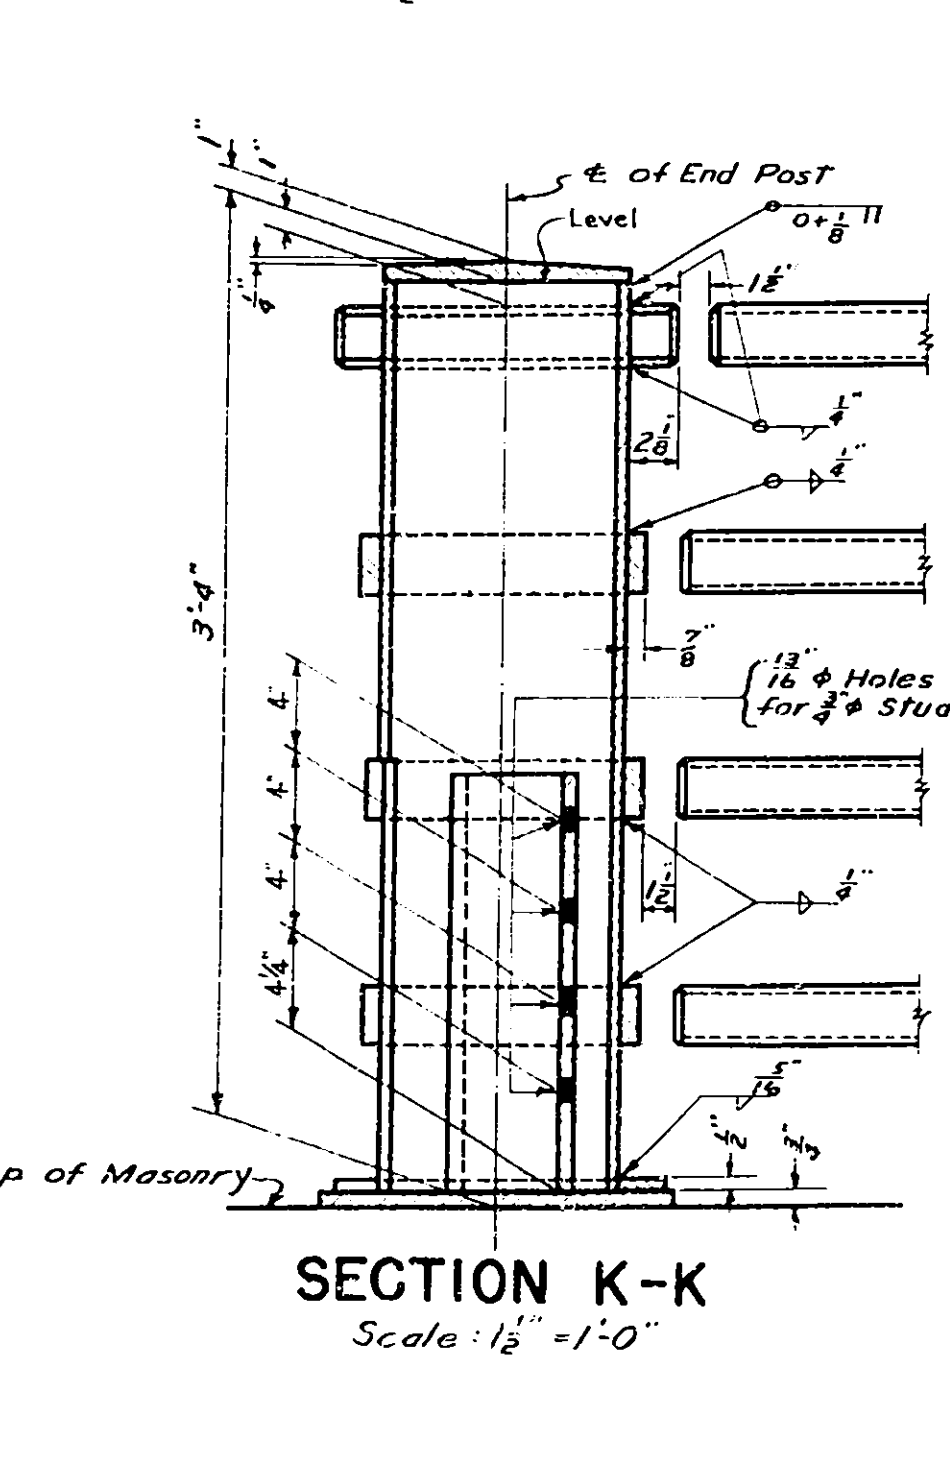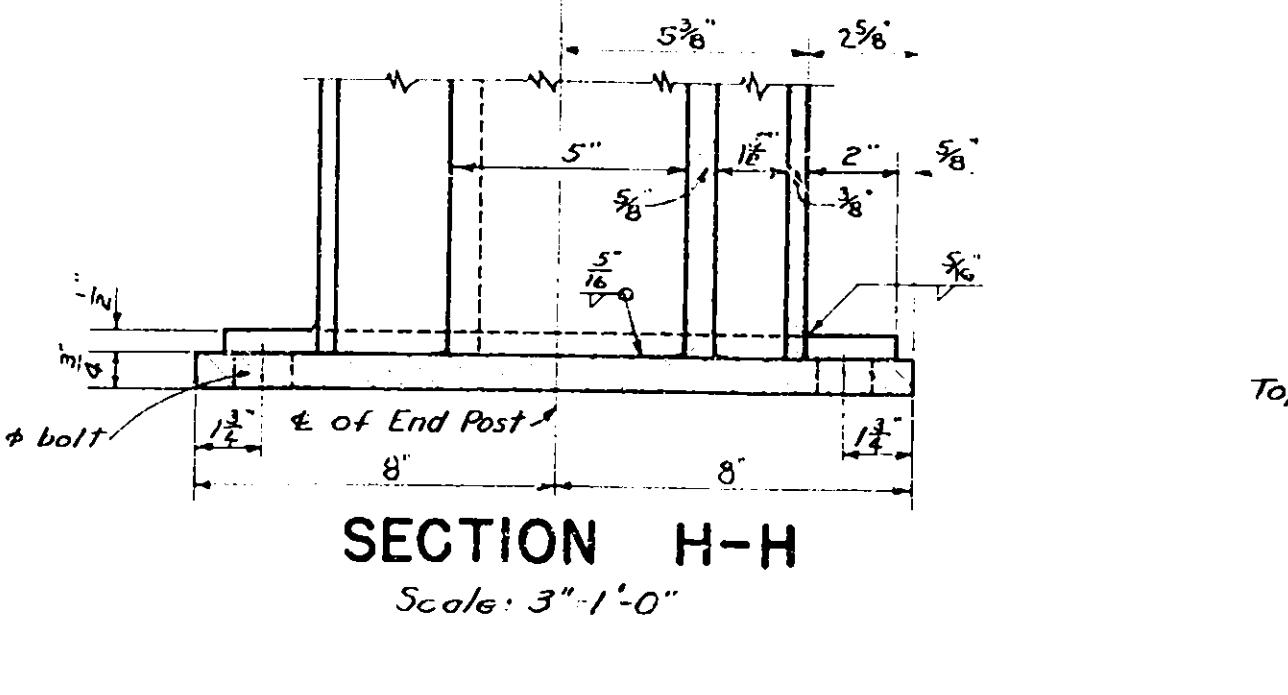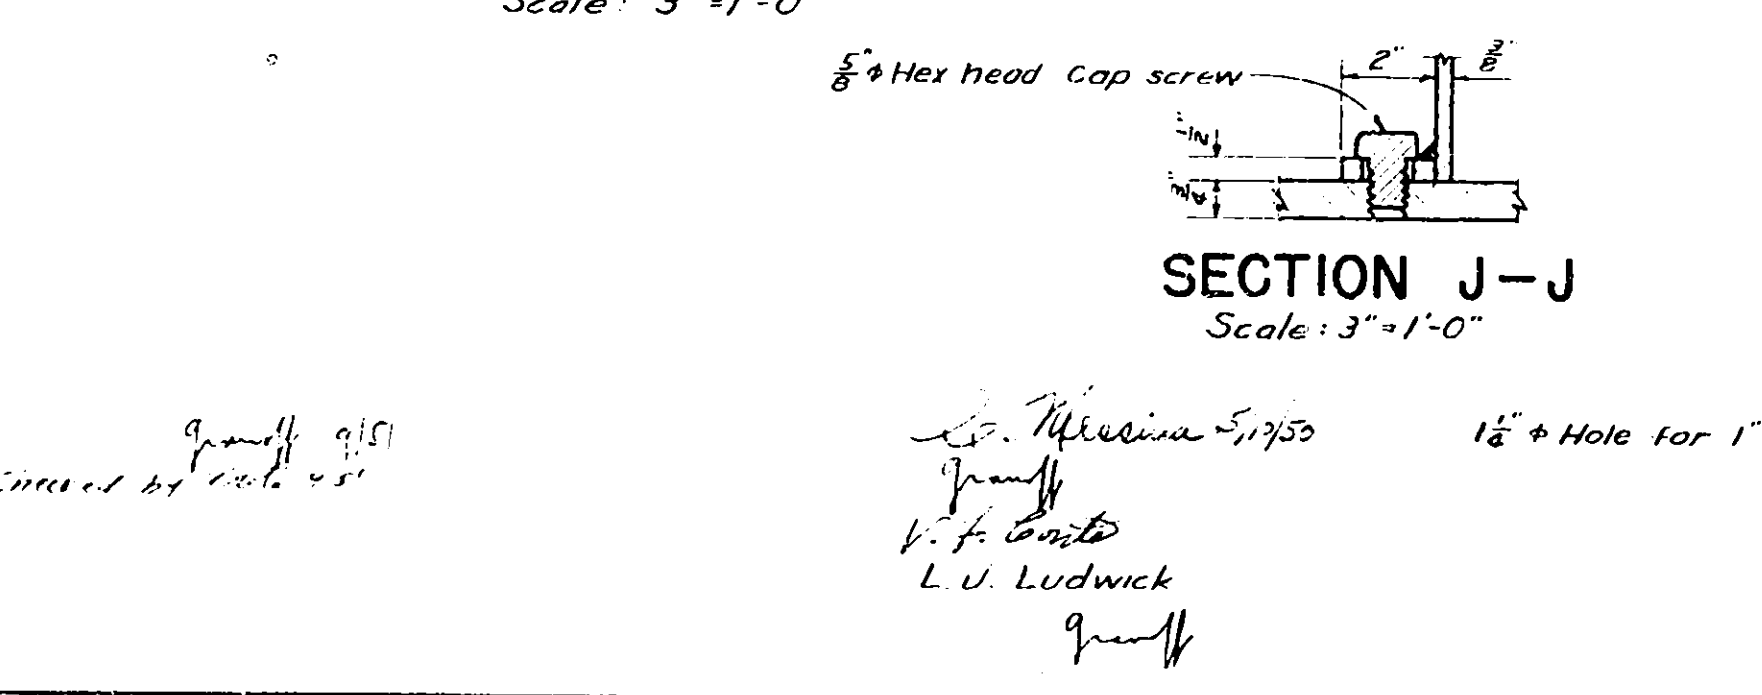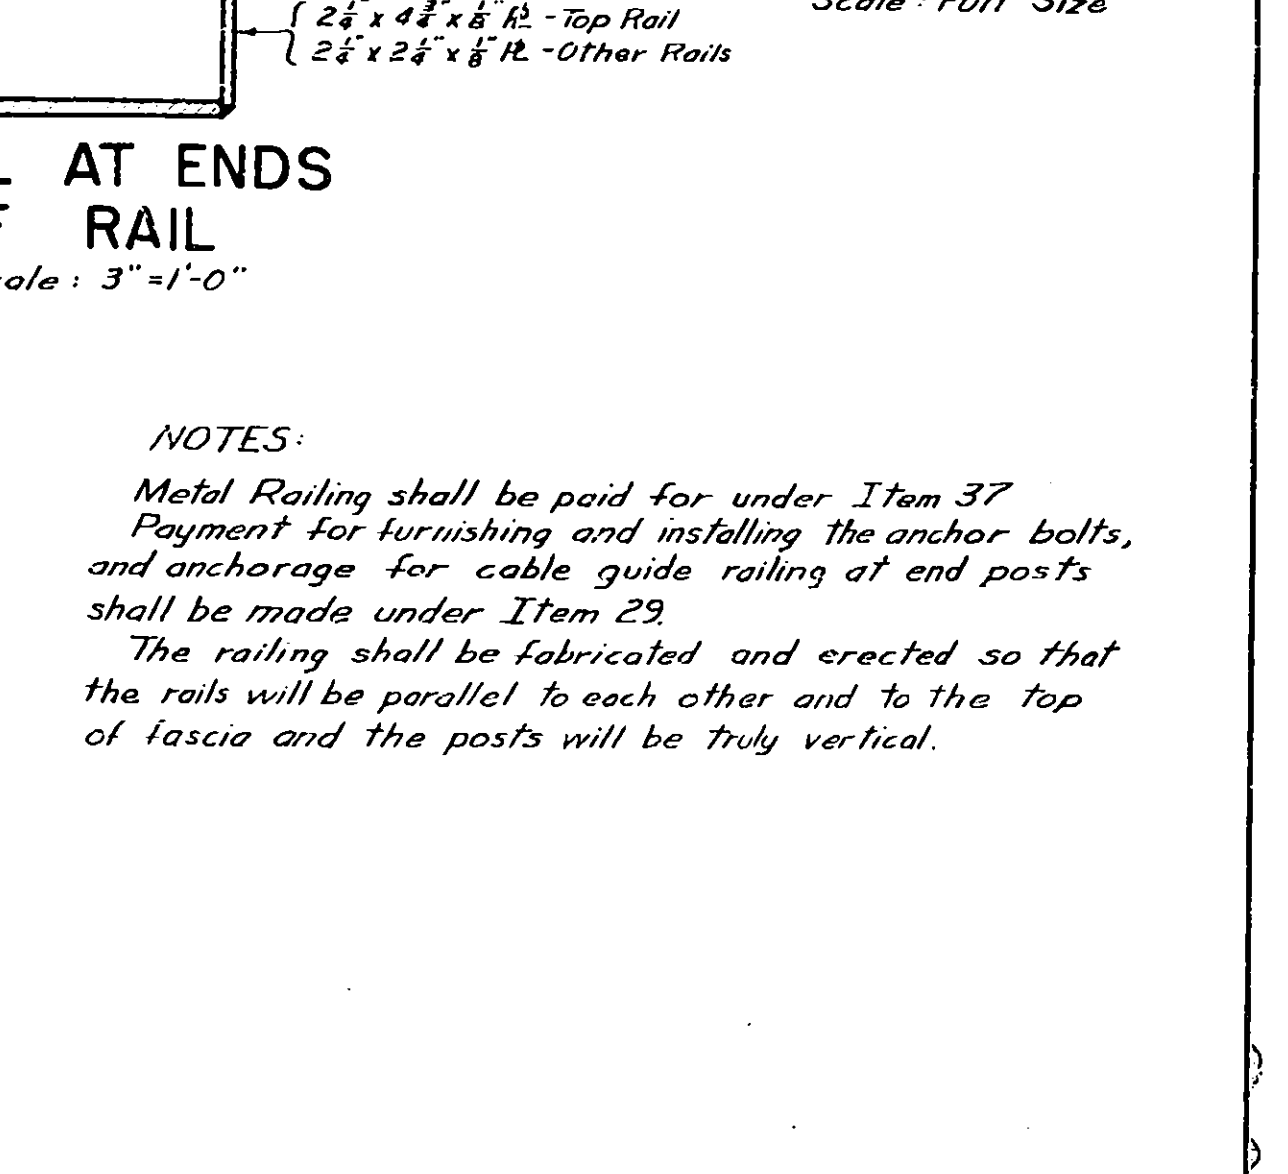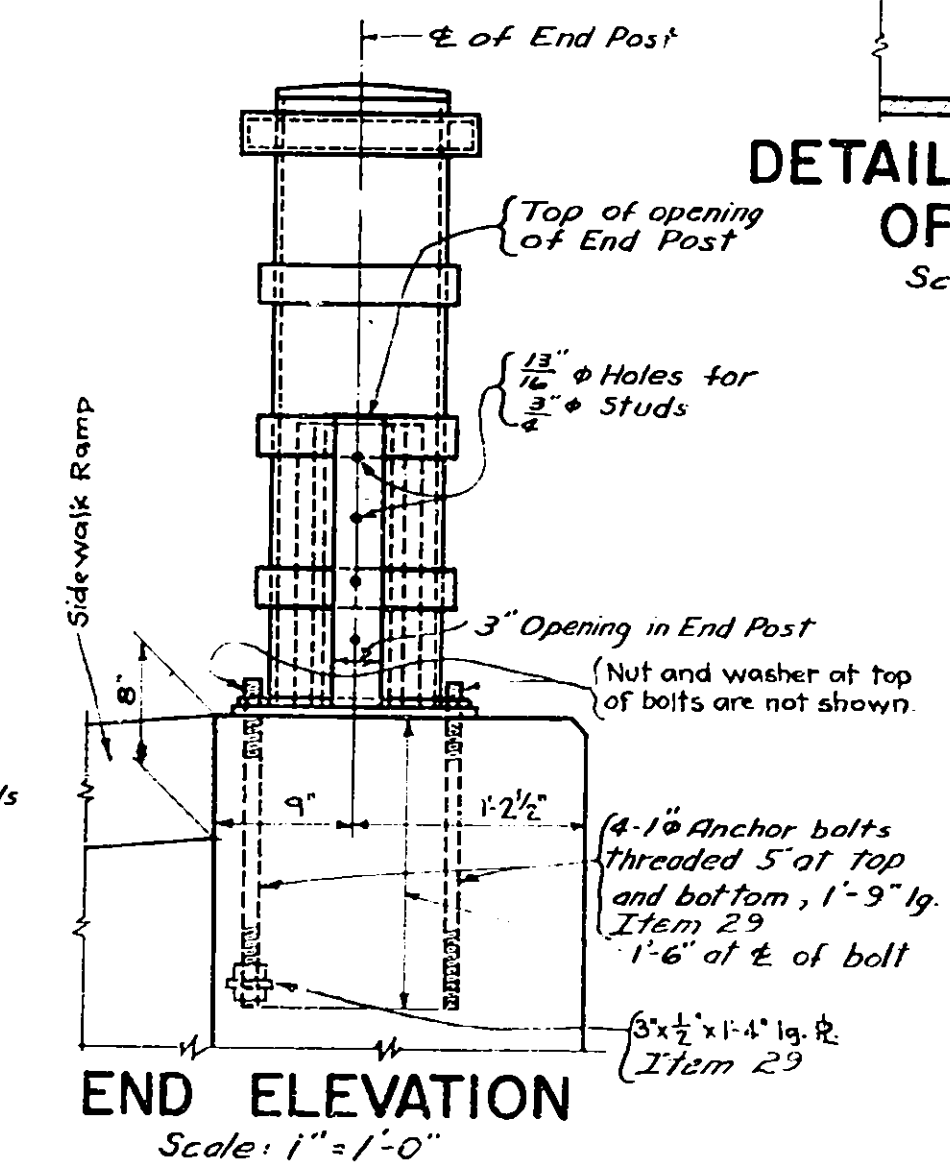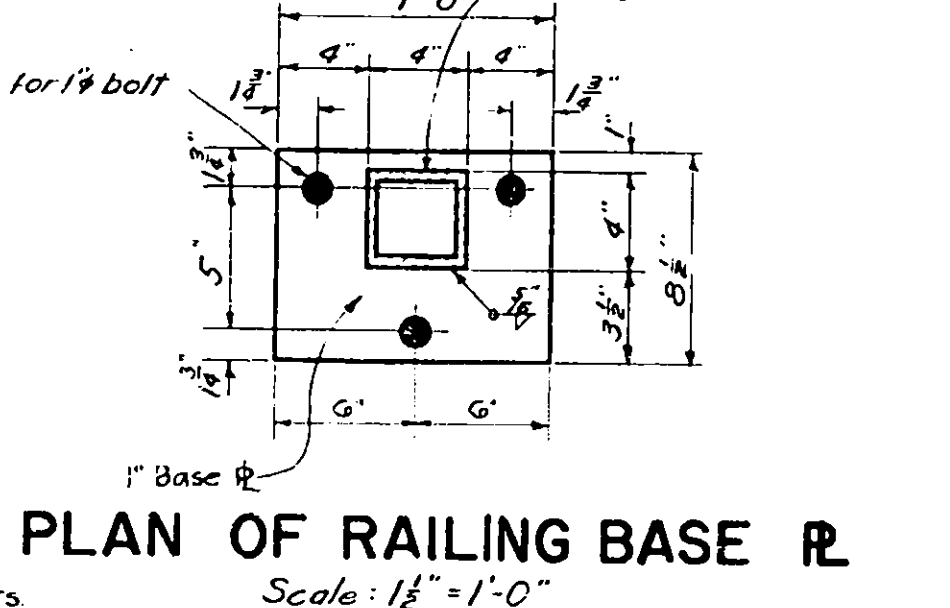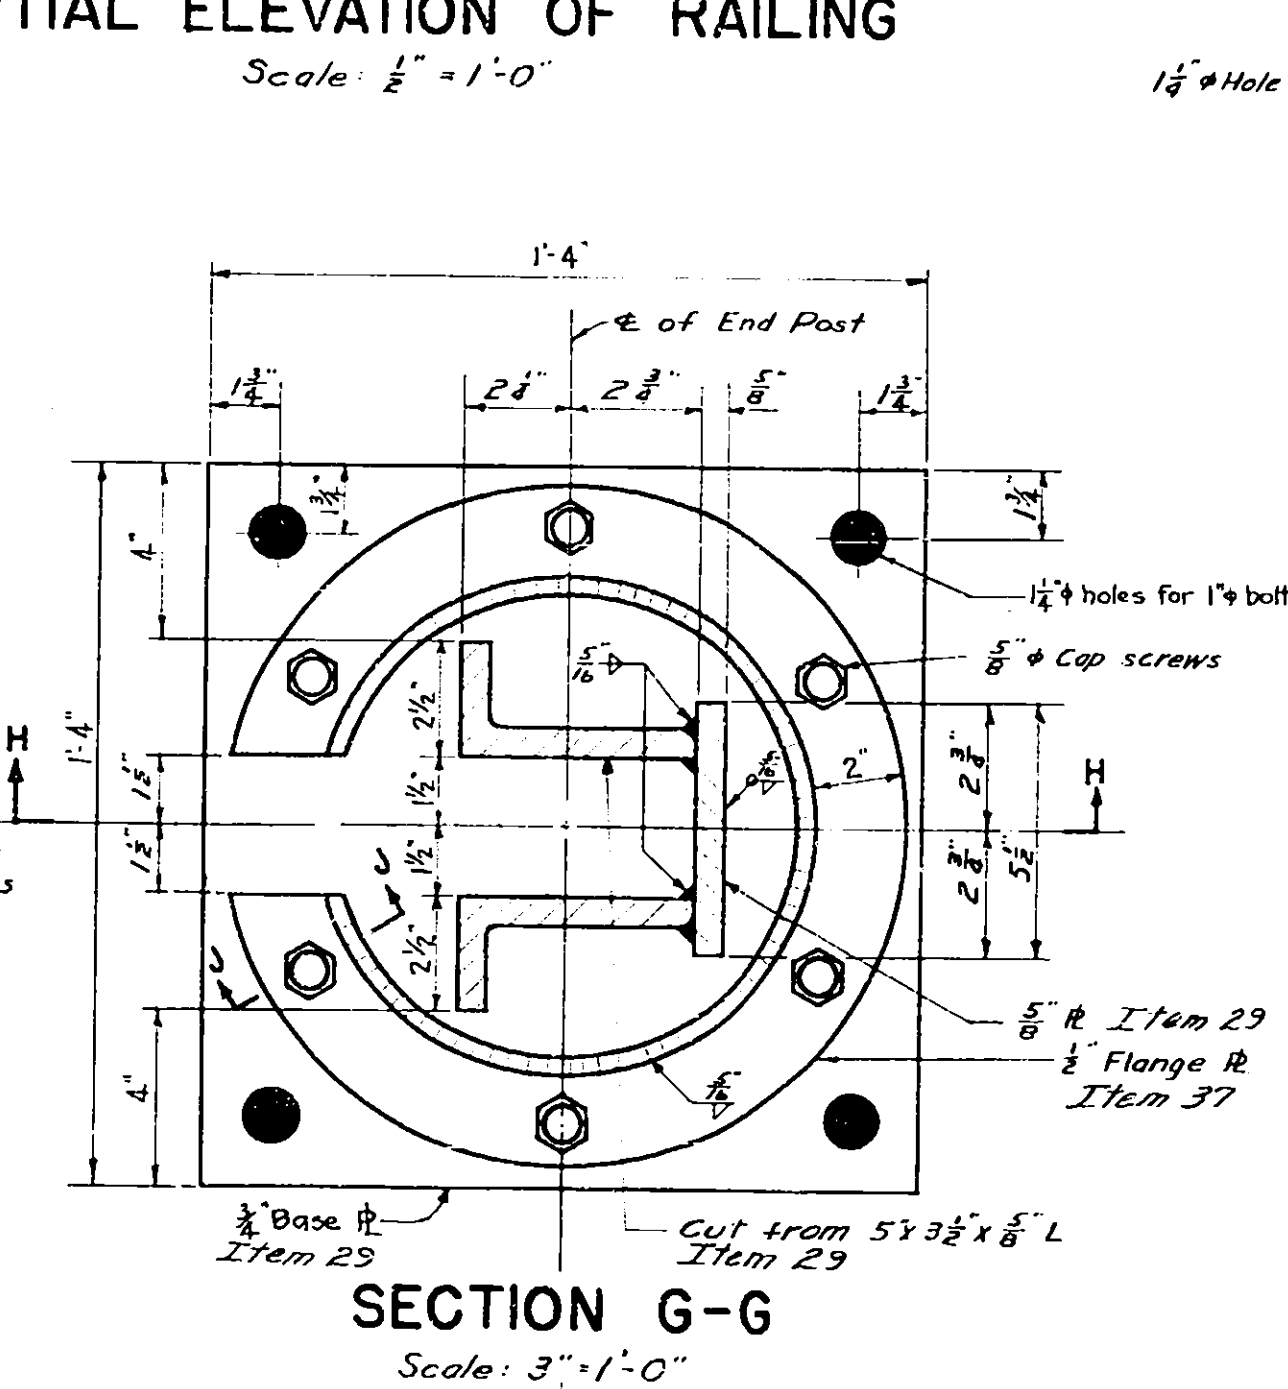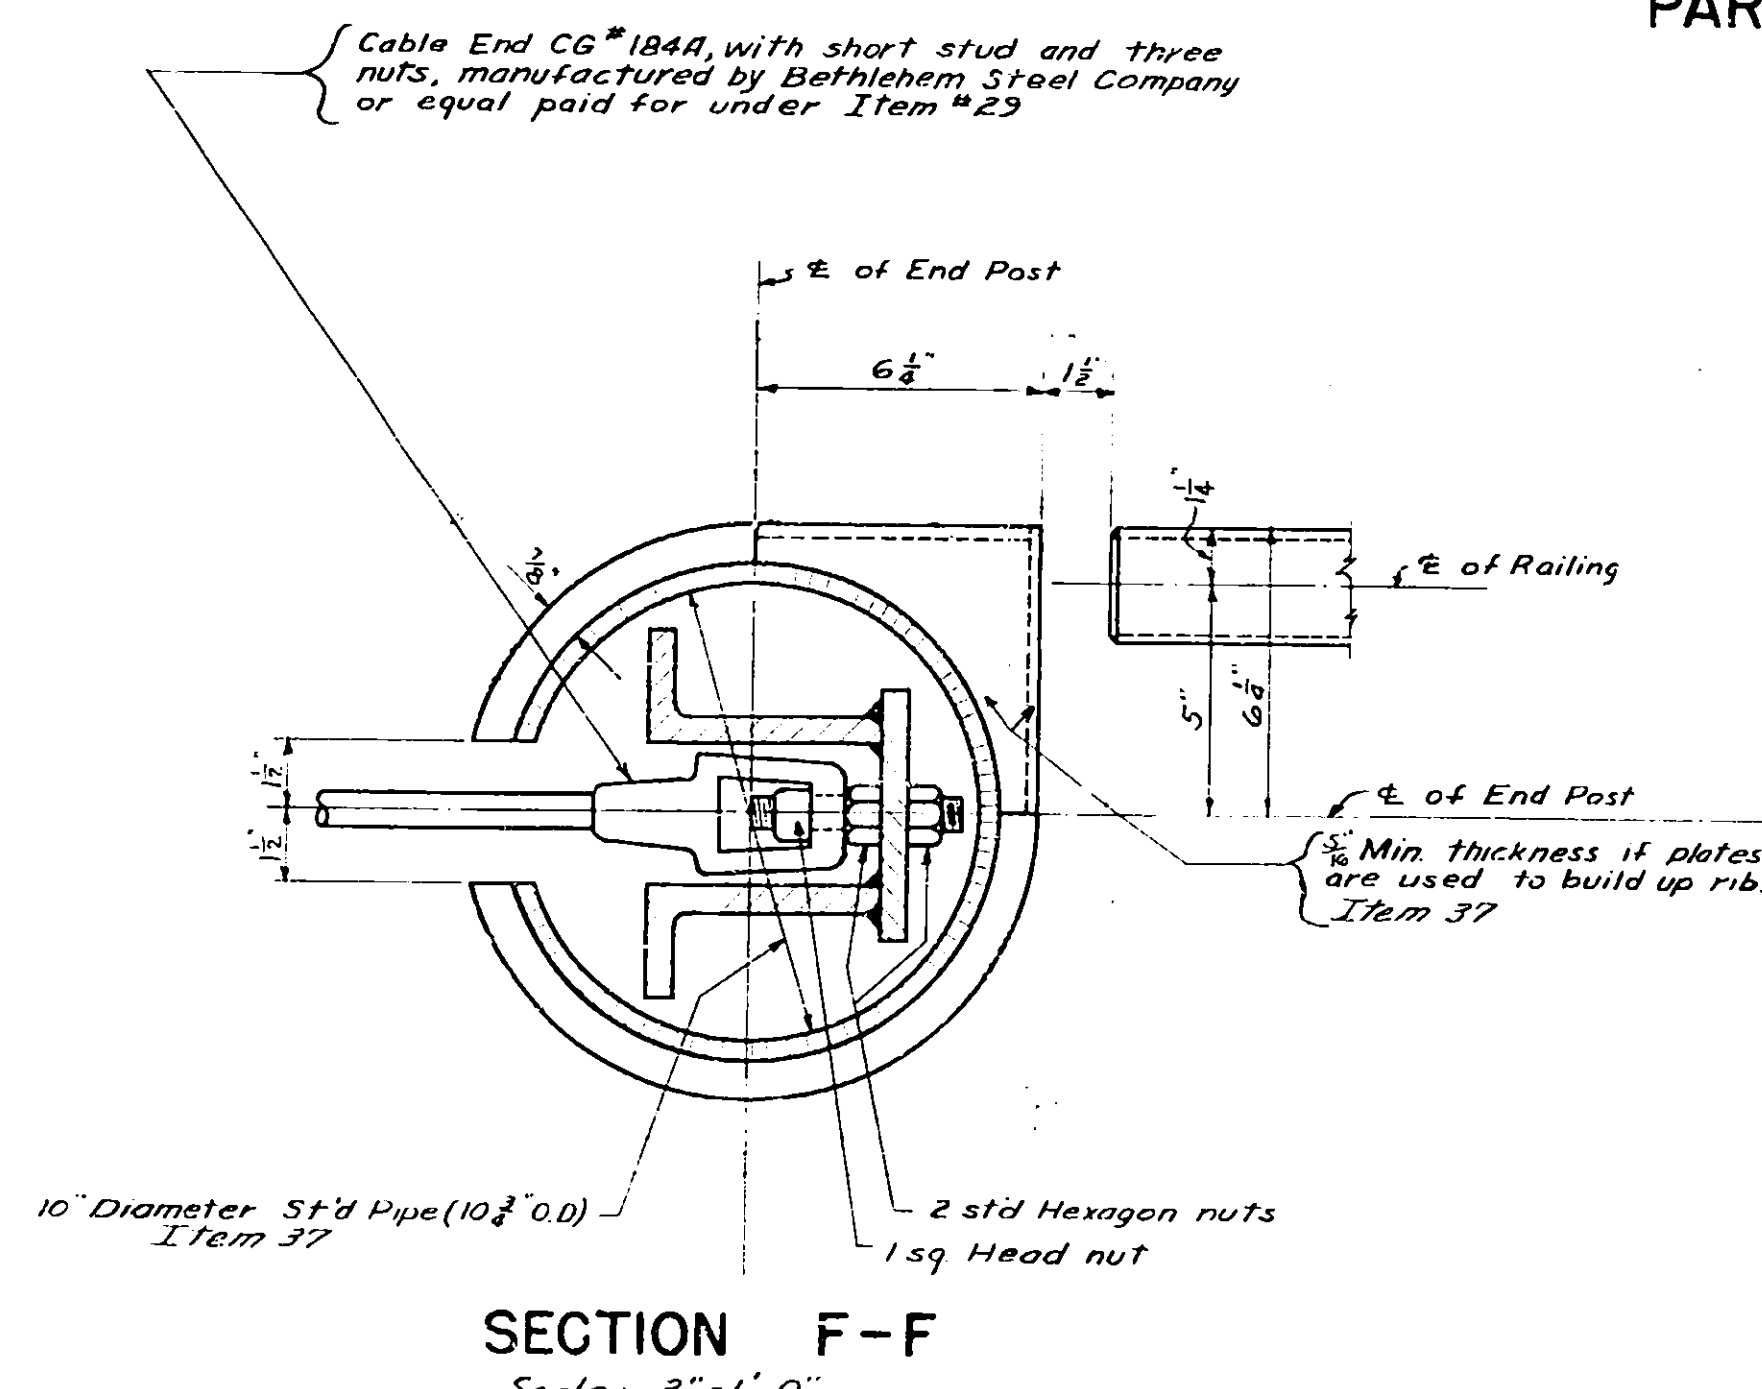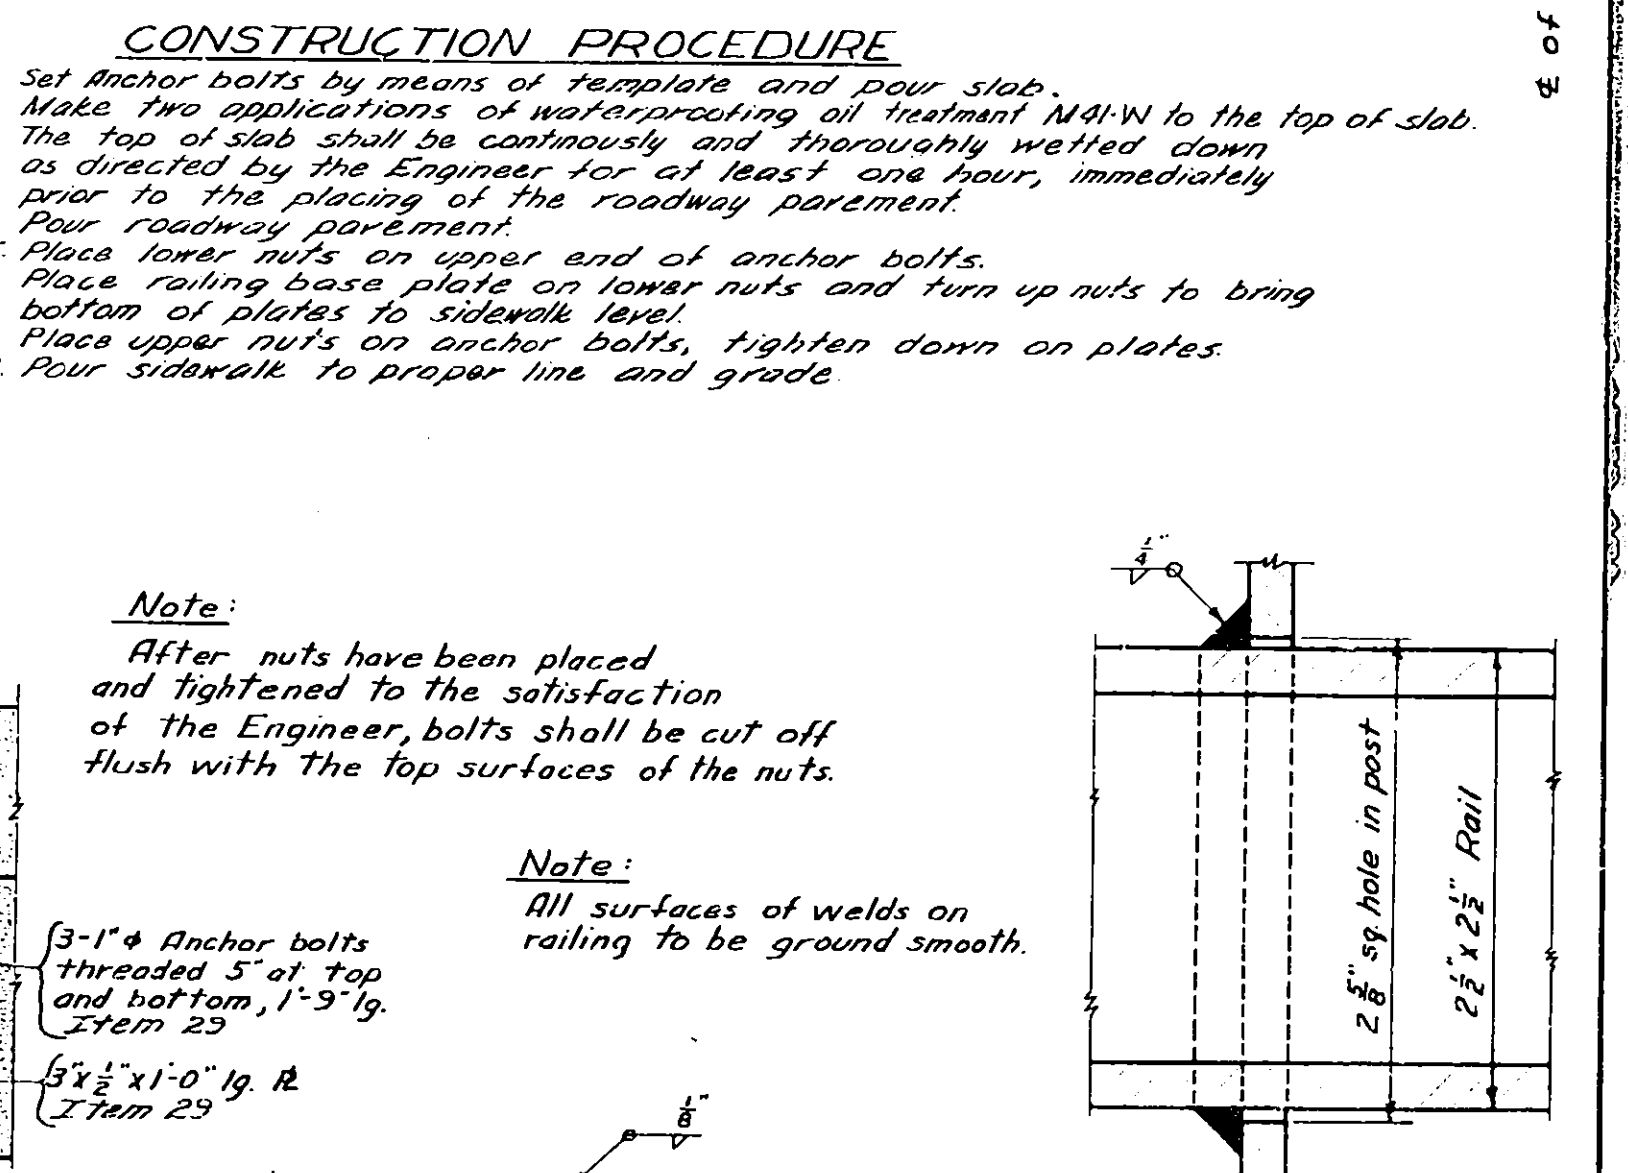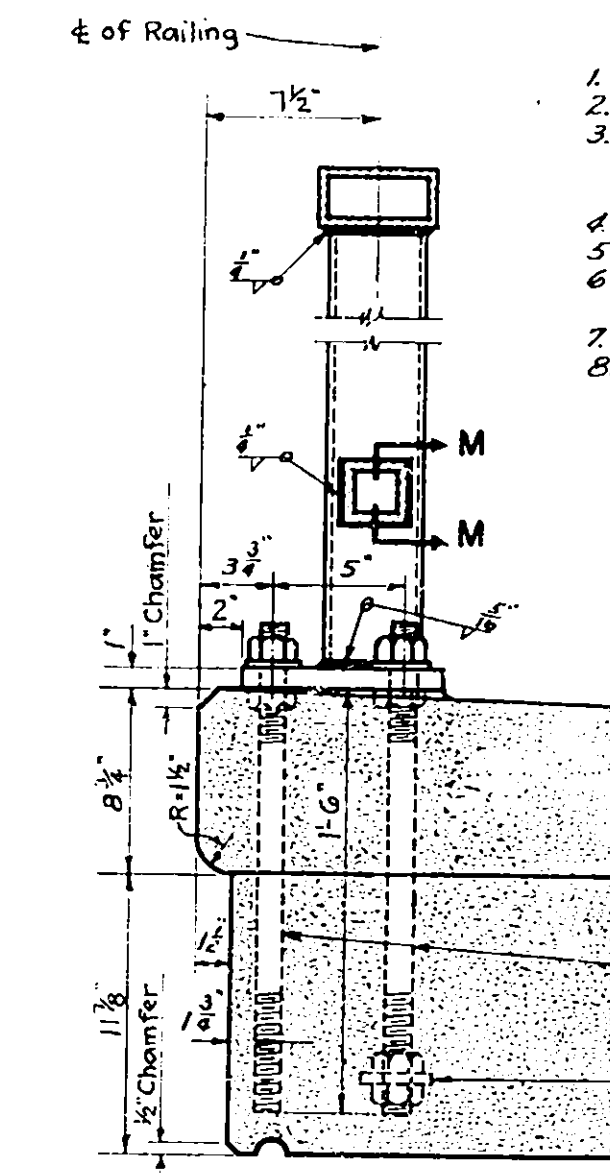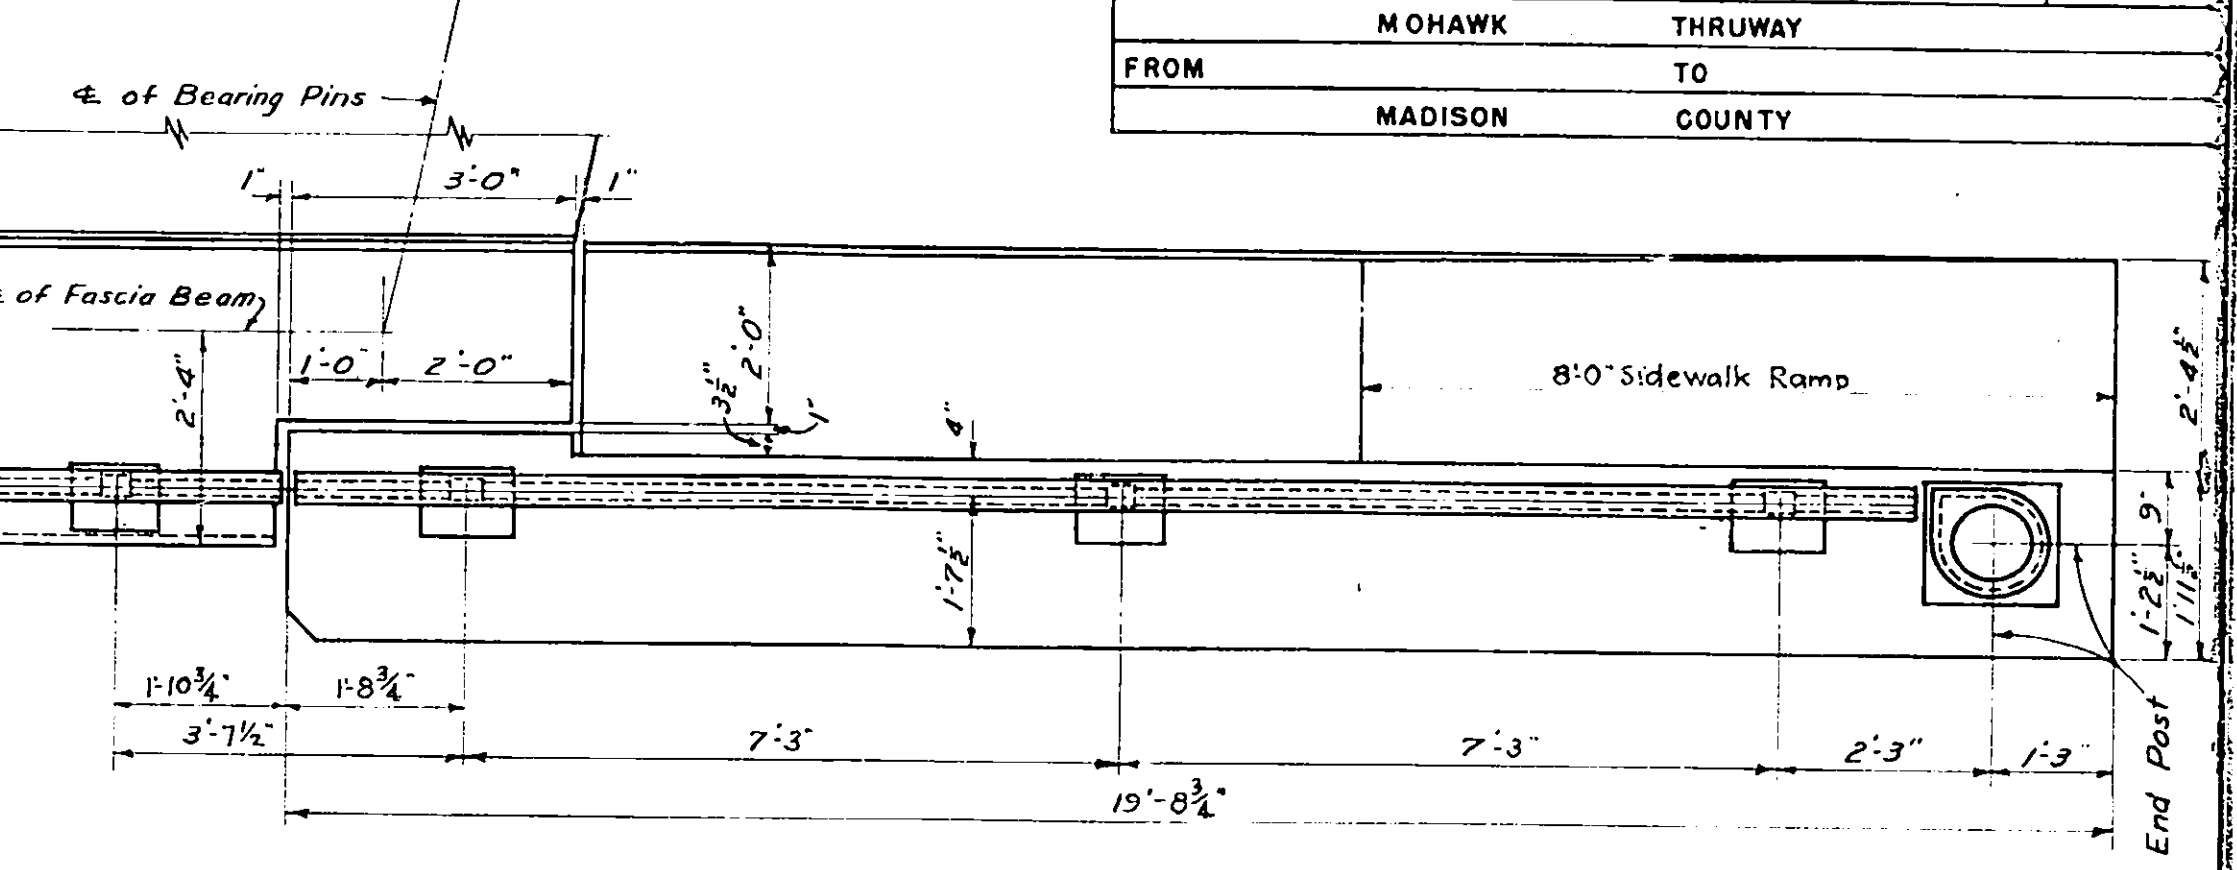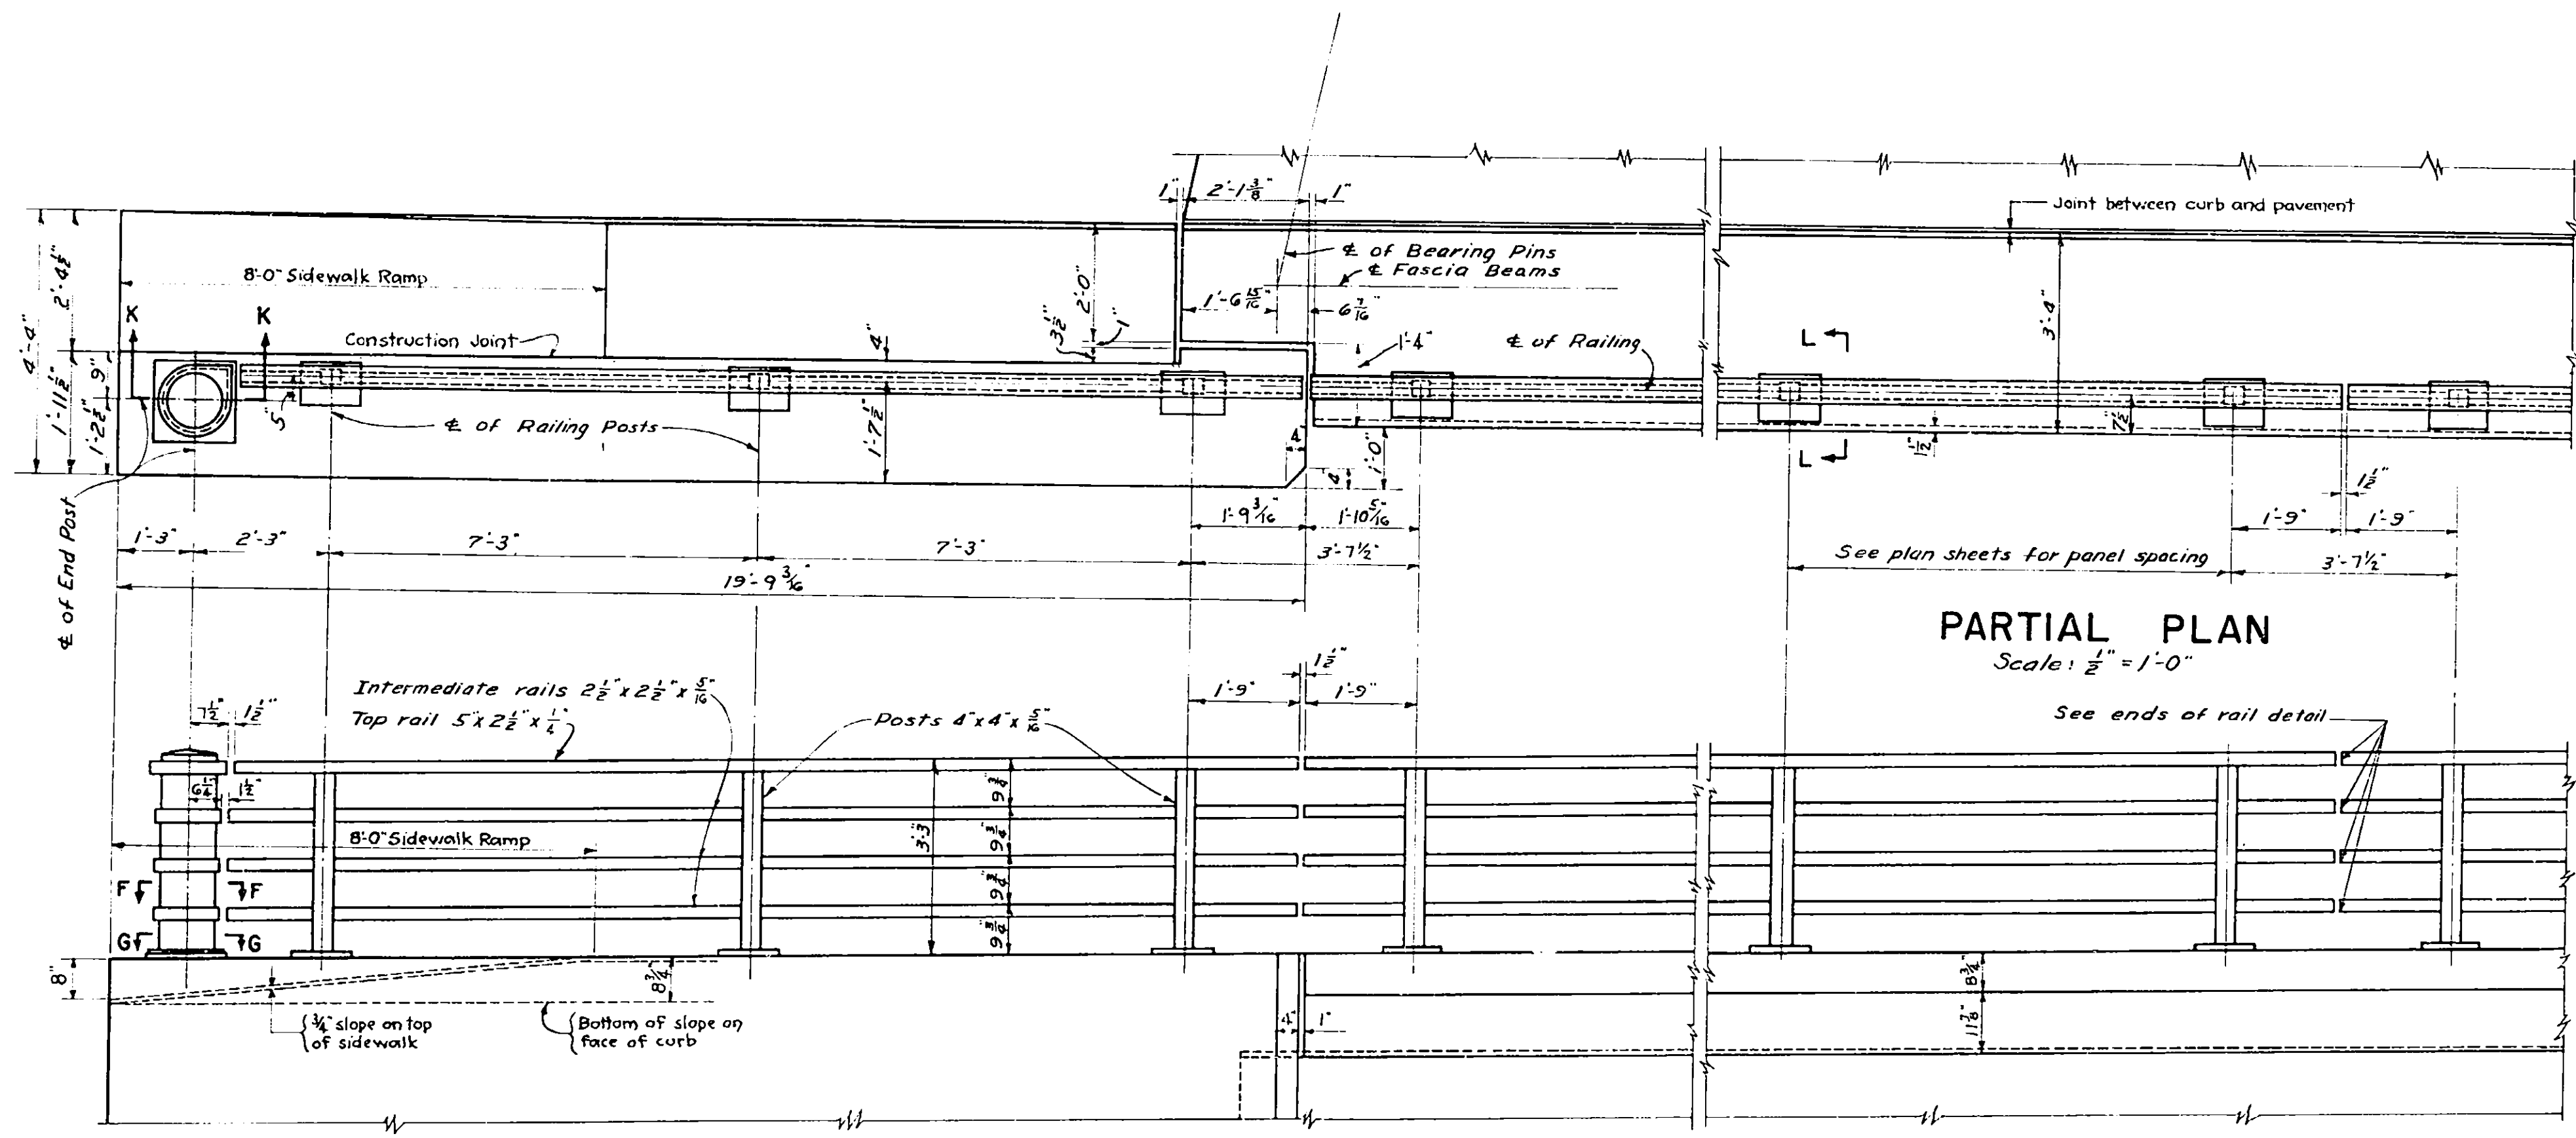


NORTH MAIN STREET
STA. 588 + 82
RAILING

W. F. Condit
L. U. Ludwick

FED. RD. DIV. No	STATE	FED. AID PROJ. No.	COUNTY	SHEET No.	TOTAL SHEETS
	N.Y.		MADISON	56	67
MOHAWK THRUWAY - N. CATTENANGO-CANASTOTA N. MAIN STREET					

At intervals of 100 feet or at such intervals as the Engineer may direct, lateral trenches or weep holes four feet in width shall be opened up through the shoulders to the ditches to effectively drain the subgrade before the pavement is constructed. These shall be filled with Item 4B1T, Foundation Course, Broken Stone and the excavation will be paid for under Item 2B, Unclassified Excavation.

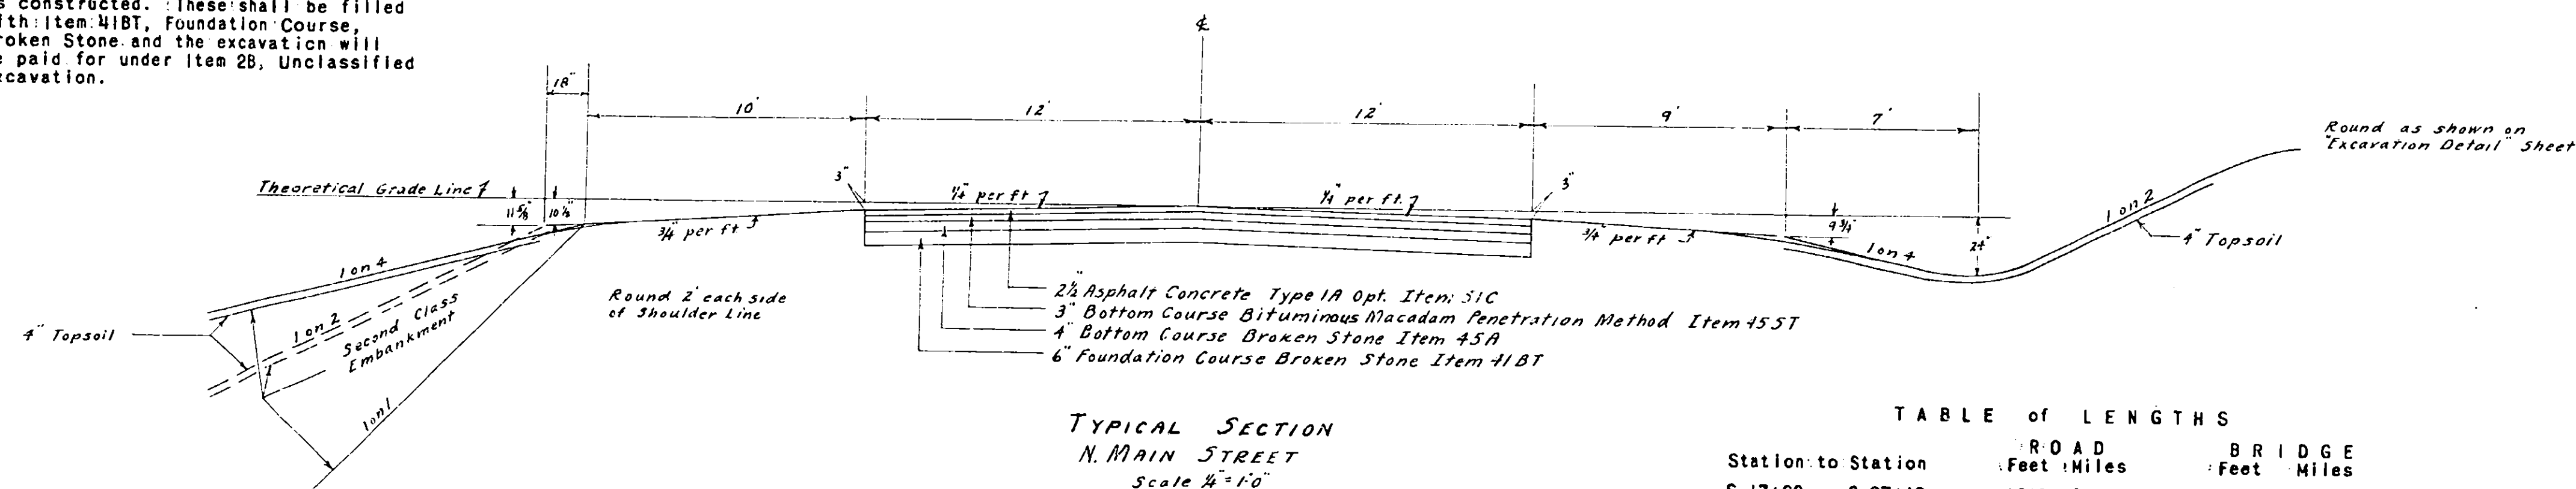

Slopes outside of roadway adjacent to ends of cuts and fills to be flattened and warped as ordered by the Engineer.

Second Class Embankment shall be used between the lines indicated if ordered by the Engineer. - Second Class Embankment is material stripped from cuts and under embankments as ordered, but shall not include stumps, logs, brush nor other objectionable material.

Station to:	Station	Side	Anchors	Length
S 21+04	S 26+94	Rt.	3	590'
S 21+02	S 27+02	Lt.	3	800'
S 29+34	S 35+04	Rt.	3	570'
S 29+00	S 34+00	Lt.	1	460'
			10	2220
		10 anchors @ 20'		200
		ESTIMATE		40
		TOTAL		2460


T A B L E o f L E N G T H S			
Station to Station		R O A D Feet Miles	B R I D G E Feet Miles
S 17+00	S 27+18	1018	0.193
S 27+18	S 29+17		199 0.038
S 29+17	S 36+00	683	0.129
	Bridge	1701	0.322
		199	0.038
	TOTAL	1800	0.360

Item 5 - TRENCH, CULVERT and
BRIDGE EXCAVATION

From	Cu. Yds.
Drainage Sheet	: 195
ESTIMATE	5
TOTAL	200

Item 2B - UNCLASSIFIED EXCAVATION
From Cu. Yds.

Road Excavation	1183
Borrow	60485
Drainage Ditches	312
Service Road	822
Removing Temp. Intersec-	
tions	270
Topsoil	2956
ESTIMATE	5972
TOTAL	72000

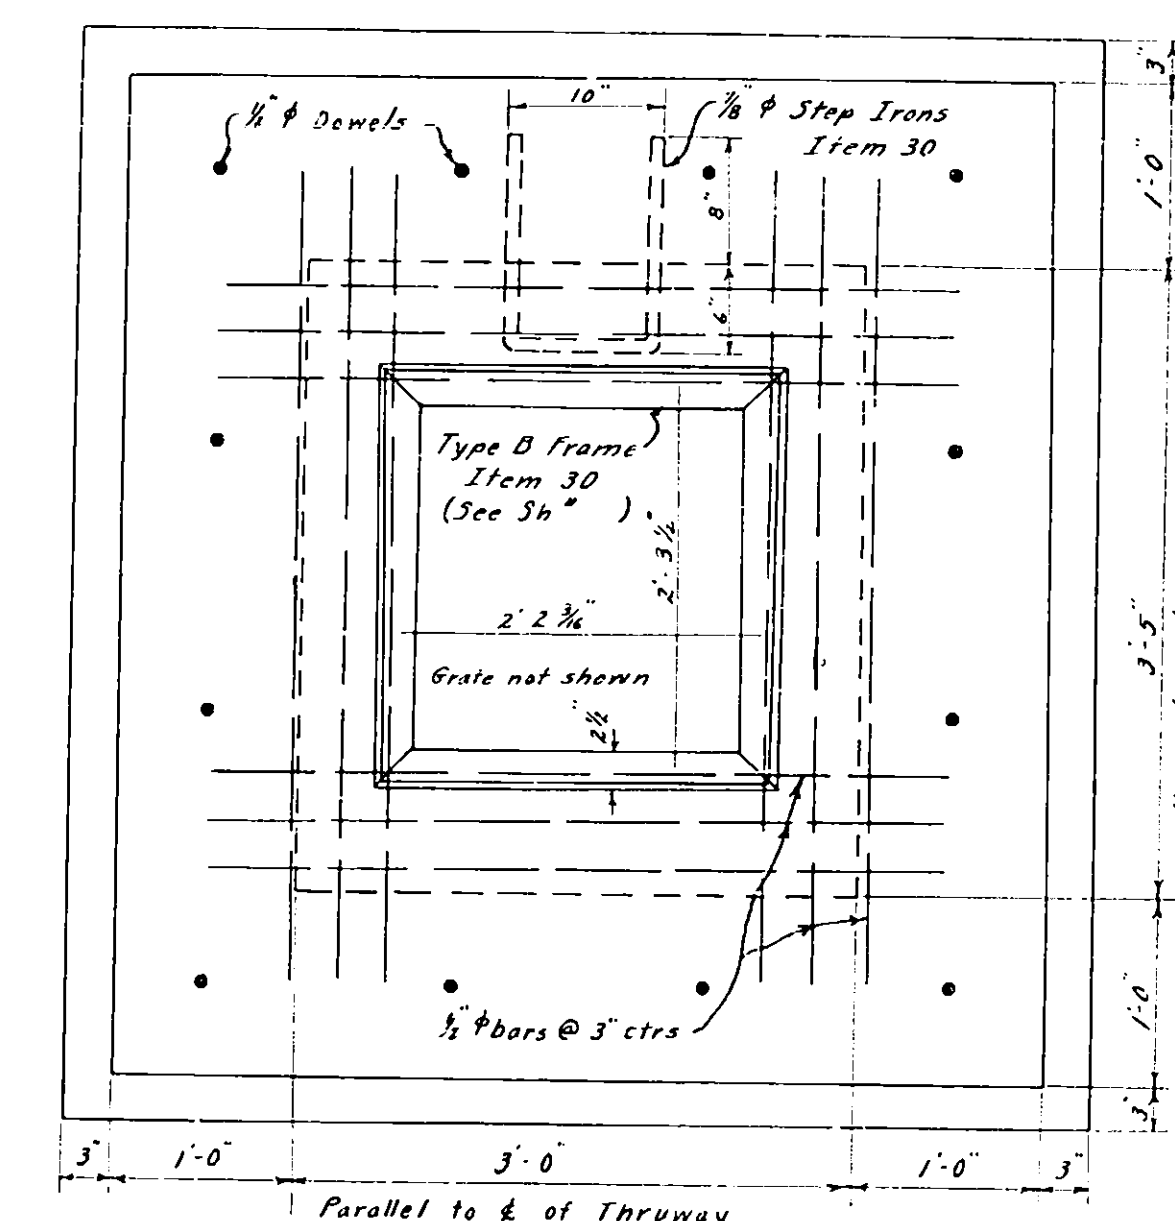

PLAN

MAINTENANCE and PROTECTION of TRAFFIC

The Contractor shall maintain and protect traffic in accordance with Item 76 for the duration of the contract within the limits of Main Street for the entire length of the contract and also within the limits of the Thruway so far as the limits of work extend.


Signs shall be erected in accordance with Standard Structure Sheet No. 49-43 on both the Thruway and No. Main St.

Any traffic required to use the Thruway shall be so routed that movement will be only in same direction as Thruway traffic.

NOTES FOR EMBANKMENT


For the approach embankments between Station "5" 20+00 and Station "5" 35+00 the procedure listed below shall be followed:

1. Remove all waste material from the surface for full width of the embankment.
2. Place a layer of pervious borrow (Item No. 2B) approved by the Engineer, two feet in thickness on the ground surface before starting the embankment construction.
3. Maintain rate of construction not greater than two feet per week until full height is reached.

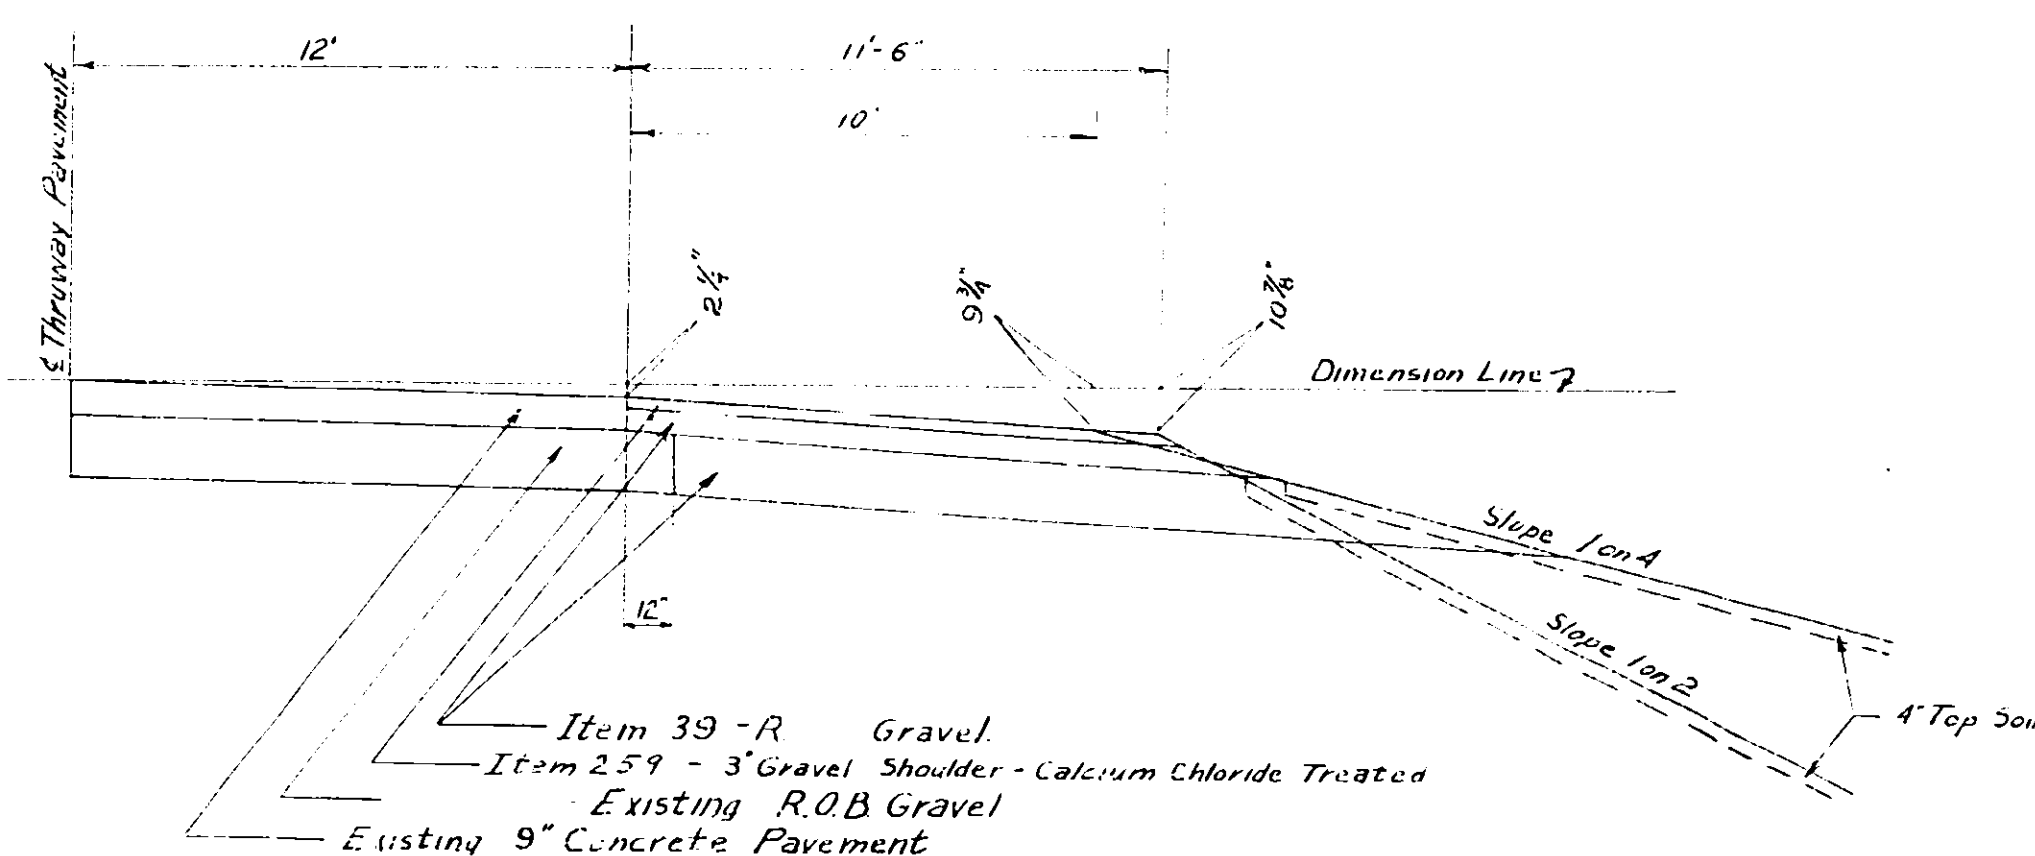

PART SECTION OF THRUWAY
SHOWING SHOULDER TO BE BUILT AFTER
REMOVAL OF TEMPORARY INTERSECTION
Scale $\frac{1}{4}'' = 1'-0''$

DRAINAGE STRUCTURES		
Present Structure	Station	REMARKS
None	S 19+00	Build new 24" Corr. Metal Pipe Culvert Crossing on left - 44' long. Build Headwalls.
None	S 21+95	Build new 24" Corr. Metal Pipe Culvert under service road - 36' long. Build Headwalls.
None	S 22+94	Build new 24" Corr. Metal Pipe Culvert under service road - 36' long. Build Headwalls.
None	S 24+37	Build new 24" Corr. Metal Pipe Culvert under service road - 40' long. Build Headwalls.
18" C.M.P. Culv. 40' long	S 28+18	Remove and Store.
None	588+50	Build new Special Drop Inlet in main with Type B Frame and Grate. Outlet to existing Drop Inlet at Sta. 588+60 C.L. with 110' of 24" R.C.C.P.

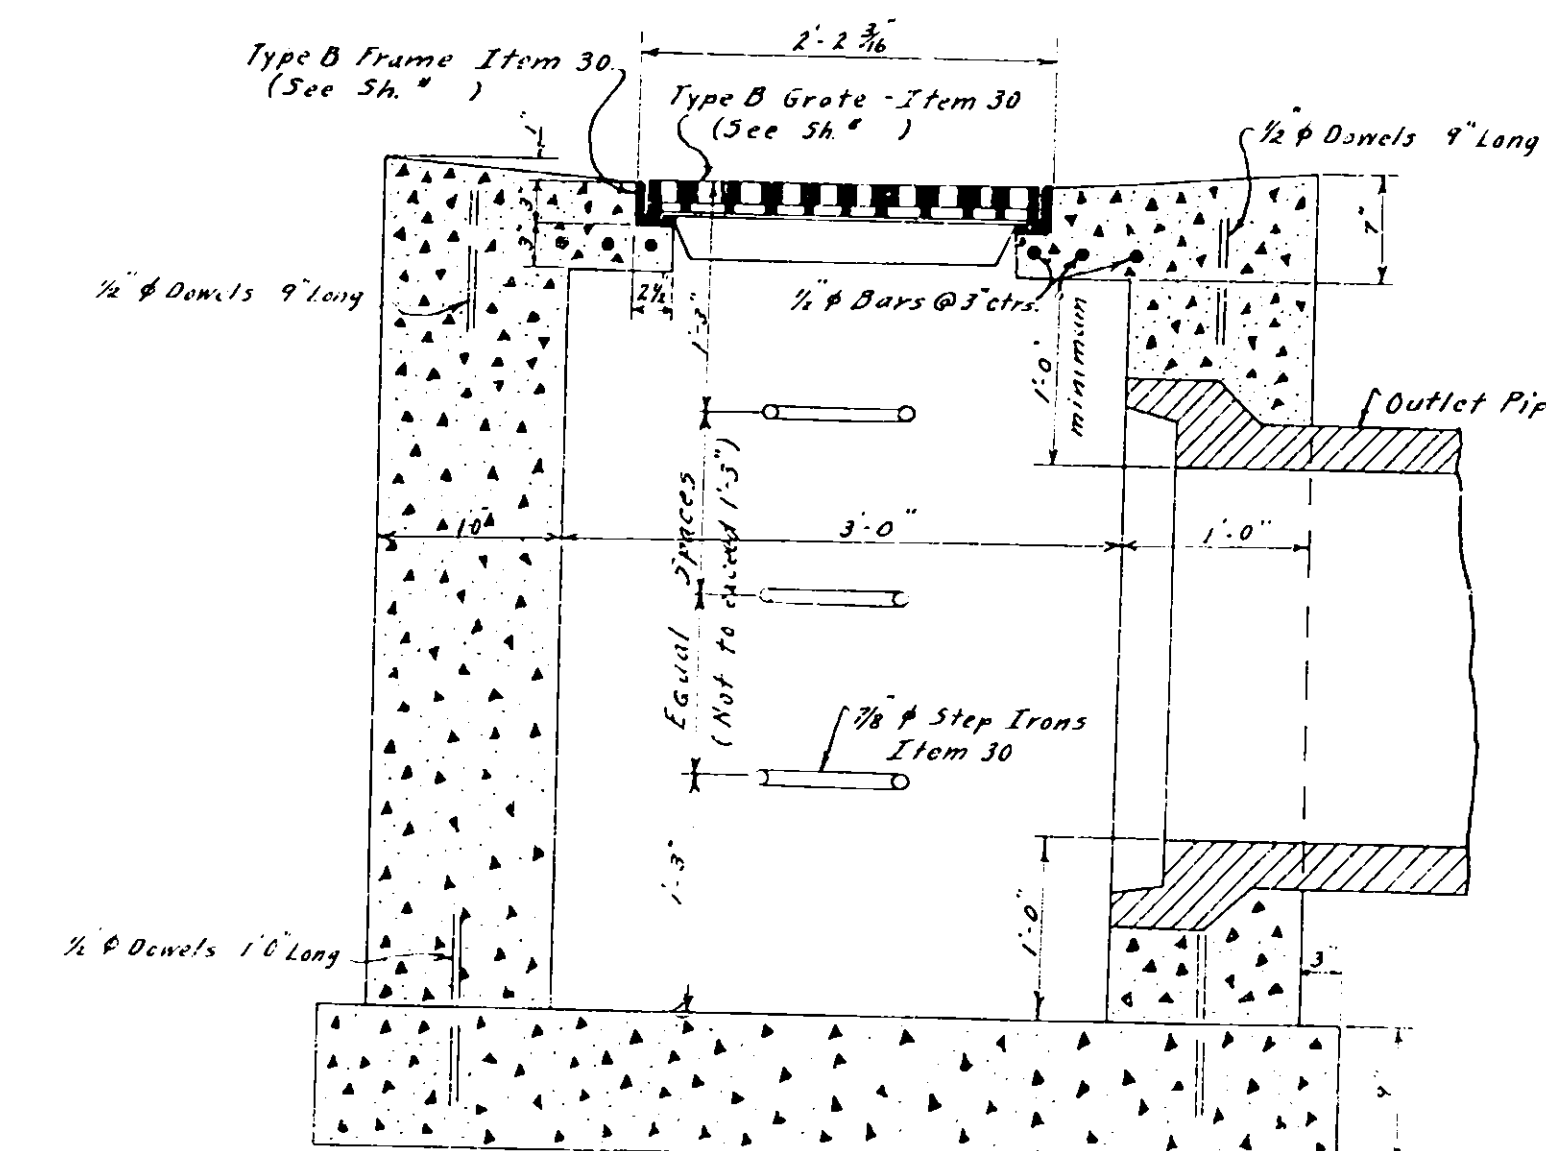

SECTIONAL ELEVATION
DETAILS OF SPECIAL DROP INLET
TO BE BUILT AT STA 588+50 IN MALL
Scale 1"=1'-0"

PREPARED PURSUANT TO THE HIGHWAY LAW & RECOMMENDED BY


DATE

ENGINEER DISTRICT NO 2

Made By _____ Traced By _____ Checked By _____
PLAN _____ Craig E. L. Hart
FRIED

FED. RD. Div. No.	STATE	FED. AID PROJ. No.	COUNTY	SHEET No.	TOTAL SHEETS
	NY		Madison	56	67
MOHAWK THRUWAY - K. CHITTENANGO - CANASTOTA N. MAIN STREET					

At intervals of 100 feet
lateral trenches or weep holes four feet
in width opened up through the
shoulders to the ditches to effectively
drain the subgrade before the pavement
constructed. These filled
with Item 41BT, Foundation Course,
Broken Stone and the excavation
paid for under Item 2B, Unclassified
Excavation.

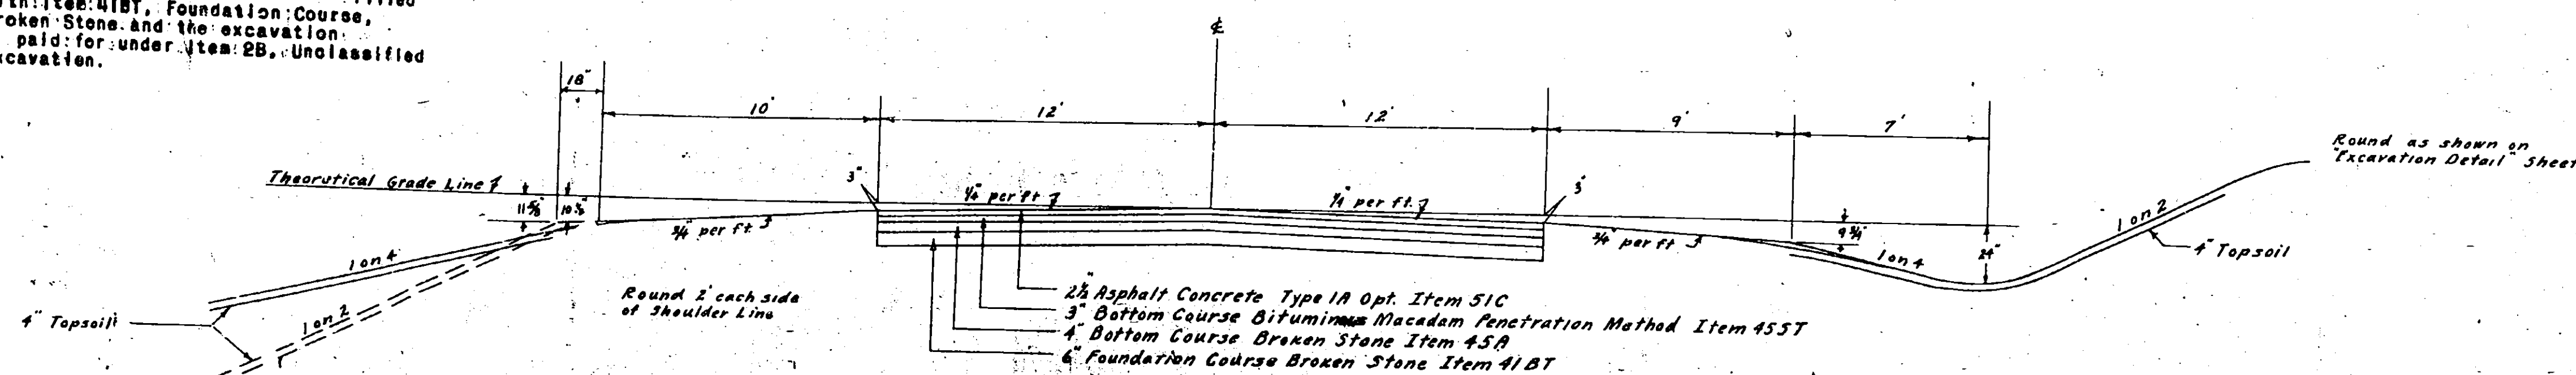

**TYPICAL SECTION
N. MAIN STREET**
Scale 1/4" = 1'-0"

TABLE OF LENGTHS

Station to Station	ROAD (Feet Miles)	BRIDGE (Feet Miles)
S 17+00 to S 27+18	1018 0.183	
S 27+18 to S 29+17	199 0.036	
S 29+17 to S 36+00	683 0.129	
	1701 0.322	
Bridge	199 0.036	199 0.036
TOTAL	1990 0.360	

Item 32D - CABLE GUIDE RAISING, OPTIONAL

Station to Station	Side	Length
S 21+00 to S 27+18	Rt.	
S 27+18 to S 29+17	Lt.	
S 29+17 to S 36+00	Rt.	
S 36+00 to S 40+00	Lt.	

anchors @ 20'

TOTAL

Item 5 - TRENCH, CULVERT and
BRIDGE EXCAVATION

From	To	Cu. Yds.
S 17+00	S 27+18	14.19

TOTAL

Item 2B - UNCLASSIFIED EXCAVATION

From	To	Cu. Yds.
S 17+00	S 27+18	14.19

TOTAL

MAINTENANCE and PROTECTION of TRAFFIC

The Contractor shall maintain and protect traffic in accordance with Item 78 for the duration of the contract within the limits of Main Street for the entire length of the contract and also within the limits of the Thruway so far as the limits of work extend.


Signs shall be erected in accordance with Standard Structures Sheet No. 40-43 on both the Thruway and No. Main St.

Any traffic required to use the Thruway shall be so routed that movement will be only in same direction as Thruway traffic.

NOTES FOR EMBANKMENT


For the approach embankments between Station 5+20+00 and Station 5+35+00 the procedure listed below shall be followed:

1. Remove all waste material from the surface for full width of the embankment.
2. Place a layer of pervious borrow (Item No. 2B) approved by the Engineer, two feet in thickness on the ground surface before starting the embankment construction.
3. Maintain rate of construction not greater than two feet per week until full height is reached.

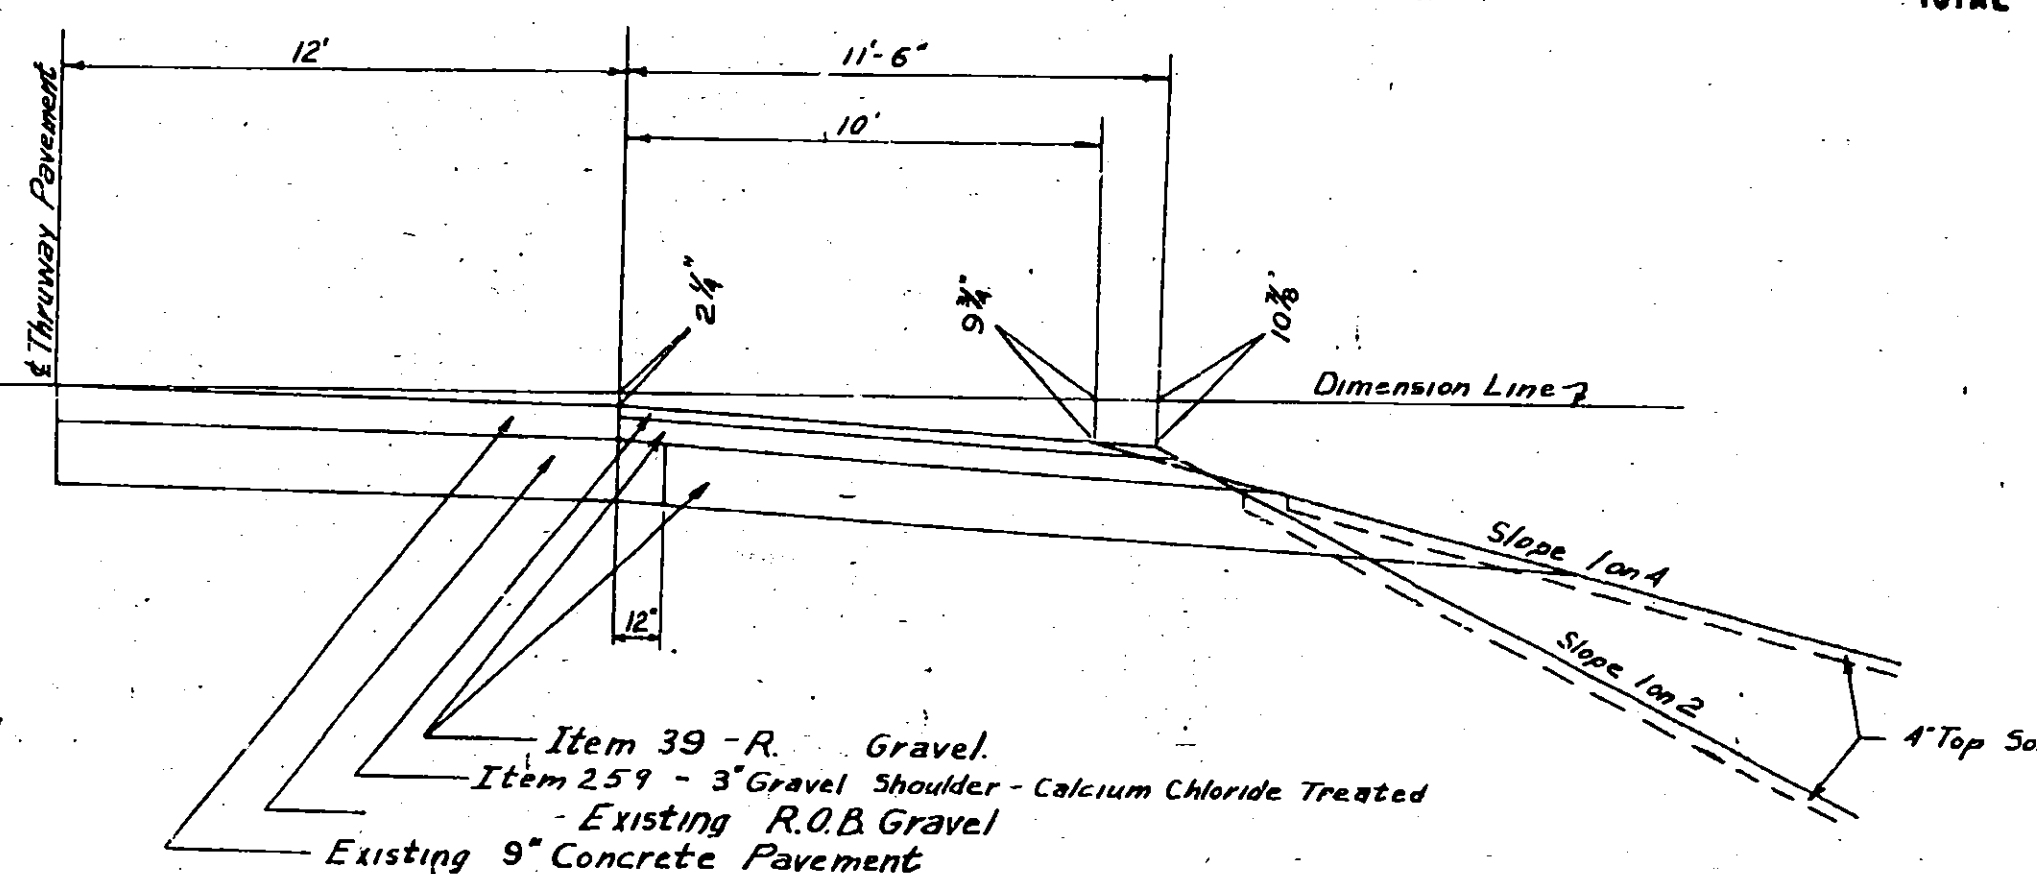


**PART SECTION OF THRUWAY
SHOWING SHOULDER BUILT AFTER
REMOVAL OF TEMPORARY INTERSECTION**
Scale 1/4" = 1'-0"

Present Structure	Station	REMARKS
None	S 17+00 to S 27+18	
None	S 27+18 to S 29+17	
None	S 29+17 to S 36+00	
None	S 36+00 to S 40+00	
18" C.M.P. Culv. 40' long	S 28+18	Remove and store.
None	S 36+00	Build new Special Drop Inlet in wall with Type B Frame and Grate. Outlet to Drop Inlet at Sta. 36+00: C.L. with 110' of 24" R.C.C.P.

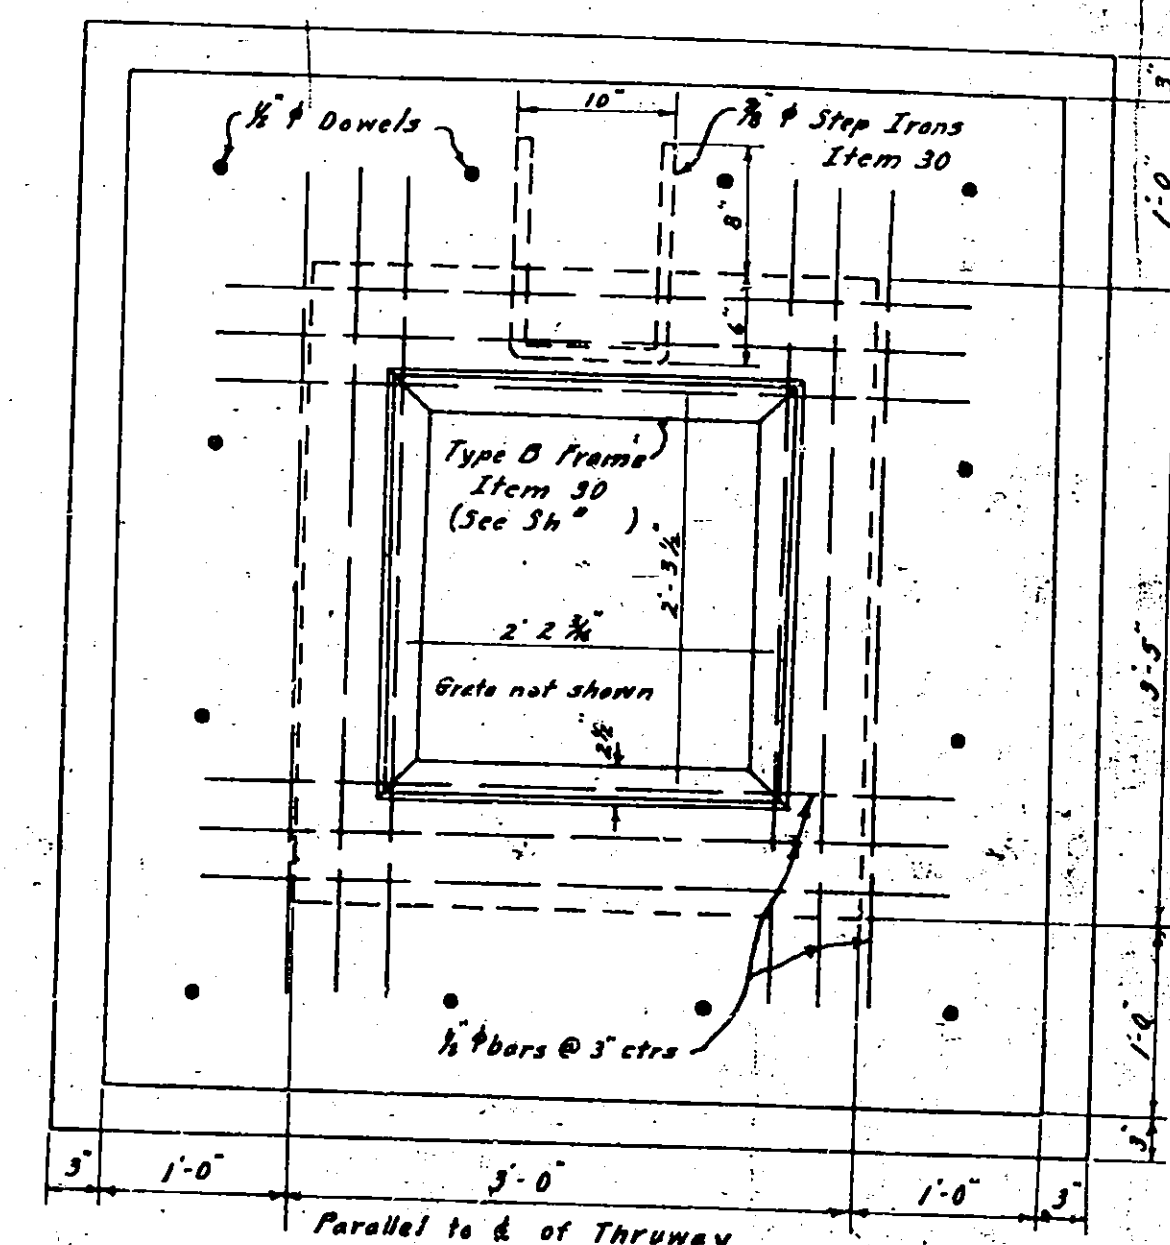

PLAN

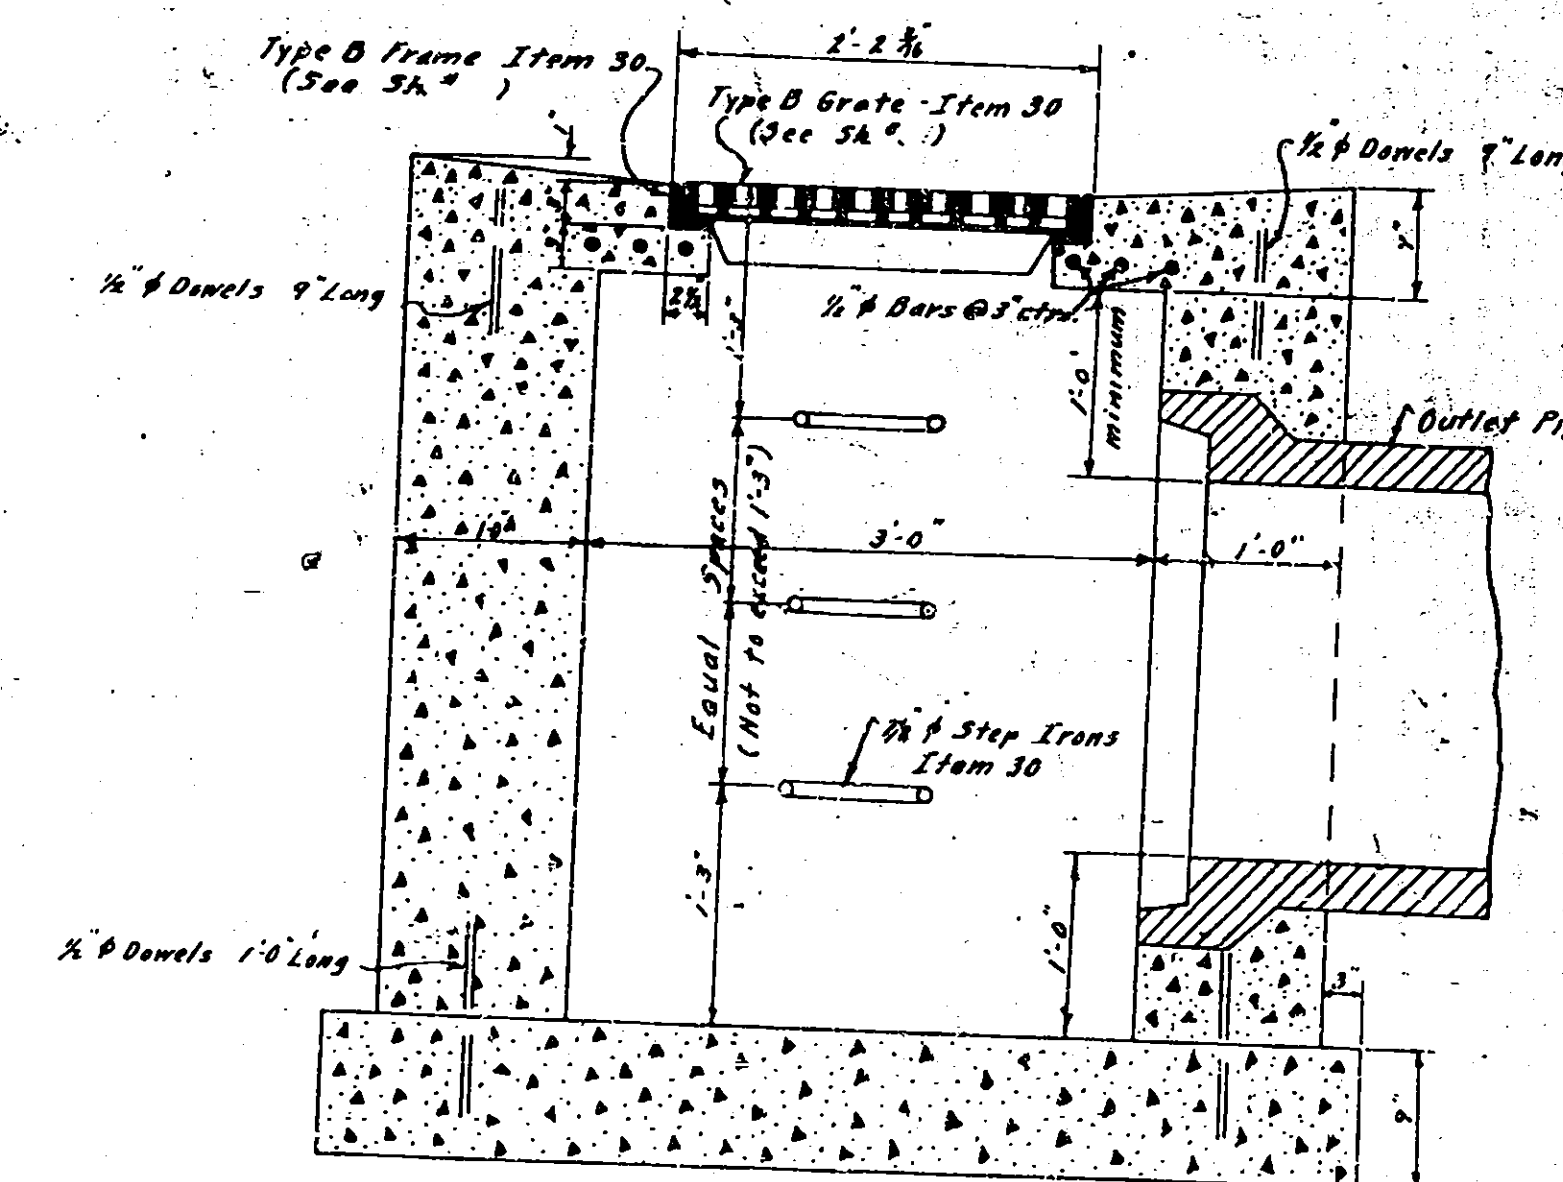

**SECTIONAL ELEVATION
DETAILS OF SPECIAL DROP INLET**
To be built at Sta. 36+00 in wall
Scale 1" = 1'-0"

Made By Traced By Checked By

PLAN
PROFILE

PREPARED PURSUANT TO THE HIGHWAY LAW & RECOMMENDED BY

DATE

Law Kitchum
ENGINEER DISTRICT No. 2

SCHEDULE A

LOCATION AND QUANTITY OF PAYMENT ITEMS	ITEM	QUANTITY	REMARKS
S 17+00 - S 26+47 L&R	121	663 C.Y.	Break in shoulder to limit of road section.
S 29+88 - S 35+00 L&R	121	371 C.Y.	ditto
S 38+00 - S 39+40	121	164 C.Y.	Thruway Wall
S 17+00 - S 26+47 L&R	123	1.66 Acres	Edge of pavement to end of road section.
S 29+88 - S 35+00 L&R	123	0.82 Acre	ditto
S 38+00 - S 39+40	123	.41 Acre	Thruway Wall
S 21+00 - S 26+47 L&R	124	658 S.Y.	Sodded berm gutters and slope channels.
S 29+88 - S 34+54 L&R	124	441 S.Y.	ditto
S 21+00 - S 27+18 L&R	IWA	12 M Gal.	In areas where item 124 is used.
S 29+17 - S 34+54 L&R	IWA	9 M Gal.	ditto

From BRIDGE PLANS

S 26+47 - S 27+18 L&R	121	137 C.Y.	Break in shoulder to limit of road section.
S 29+17 - S 29+88 L&R	121	137 C.Y.	ditto
S 26+47 - S 27+18 L&R	123B	0.25 Acre	Edge of pavement to limit of road section.
S 29+17 - S 29+88 L&R	123B	0.26 Acre	ditto
S 26+47 - S 27+18 L&R	124	329 S.Y.	Sodded berm gutter, slope channels and horizontal strips.
S 29+17 - S 29+88 L&R	124	329 S.Y.	ditto

TOTAL	121	1200 C.Y. Neat) 1350 C.Y. Rounded)	Highway
TOTAL	121	274 C.Y. Neat) 300 C.Y. Rounded)	Bridge
TOTAL	123	2.49 Acres Neat) 3.50 Acres Rounded)	Highway
TOTAL	123B	0.51 Acre Neat) 1.00 Acre Rounded)	Bridge
TOTAL	124	1099 S.Y. Neat) 1200 S.Y. Rounded)	Highway
TOTAL	124	658 S.Y. Neat) 690 S.Y. Rounded)	Bridge
TOTAL	IWA	21 M Gal. Neat) 21 M Gal. Rounded)	

SCHEDULE B

DETAIL SPECIFICATIONS TO ACCOMPANY PUBLIC WORKS SPECIFICATIONS

ITEM NO.	PAR NO.	DESCRIPTION
IW		FURNISHING WATER EQUIPMENT
IWA		APPLYING WATER
	a.	Areas - See Schedule A.
		Rates - As specified.
121		TOPSOIL PLACED FROM STOCKPILES
	a.	Areas - See Schedule A.
	c.1	Subgrade scarified as directed by Engineer.
	c.3	Topsoil Thickness - 4 inches loose measure.
123		SEEDING
	a.	Areas - See Schedule A.
	b.	Seeds - See Schedule D.
		Fertilizer - M-55, Type No. 2 (1C-1C-10)
		Mulch - M-59, Hay or M-60, Straw
	c.2	No inoculation required for Alsike Clover.
	c.3	Rate of Seeding - 50 lbs. pure live seed per acre.
		Rate of Fertilizing - 600 lbs. per acre.
	c.4	Rate of mulch - 2 tons per acre.
123B		SEEDING ON PREPARED AREAS
	a.	Areas - See Schedule A.
124		SODDING
	a.	Areas - See Schedule A.
	c.3	Sodding shall be as shown on Standard Sheet 50-34, Bridge Plans, or as directed by Engineer.

SCHEDULE C

DETAIL SPECIFICATIONS FOR PLANTS

ITEM & SUBITEM	QUAN.	GENUS & SPECIES	ABBR.	COMMON NAME	SIZE	SPECIFICATIONS & REMARKS
----------------	-------	-----------------	-------	-------------	------	--------------------------

FED. ROAD DIST. NO. STATE PROJ. NO. YEAR NO. SHEET TOTAL

ROADSIDE DEVELOPMENT SHEET
MOHAWK THRUWAY
N. CHITTENANGO - CANASTOTA
North Main St. - Canastota

SCHEDULE D

DETAIL SPECIFICATIONS FOR SEEDS

A - MIN. % PURITY	B - MIN. % GERMINATION	C - POUNDS PURE LIVE SEED PER ACRE
NAME	VARIETY	
Creeping Red Fescue (Festuca rubra)	Commercial	95 75 25
Redtop (Agrostis alba)	Commercial	90 85 10
Perennial Ryegrass (Lolium perenne)	Commercial	95 75 7
Alsike clover (Trifolium hybridum)	Commercial Max. 25% Hard Seed	95 85 3
Wild White Clover (Trifolium repens var.)	Kent Wild, N.Y. Wild, N. Zealand Wild - Max. 25% Hard Seed	95 95 5
	RATE	50

SUMMARY

ITEM	QUANTITY	DESCRIPTION
IWA	21 M Gal.	Applying Water
121	1450 C.Y.	Topsoil Placed from Stockpiles
123	3.50 Acres	Seeding
123B	1.00 Acre	Seeding on Prepared Areas
124	1860 S.Y.	Sodding
IW	Nec.	Furnishing Water Equipment



Lucy Ketchum

A. Dutton





Keil

F. L. White


Fed. Rd. Div. No.	State	Fed. Aid. County	Proj. No.	Sheet No.	Total Sheets
	N.Y.	Madison		58	67
Mohawk Thruway No. Chittenango - Canastota					
No. Main Street, Canastota					

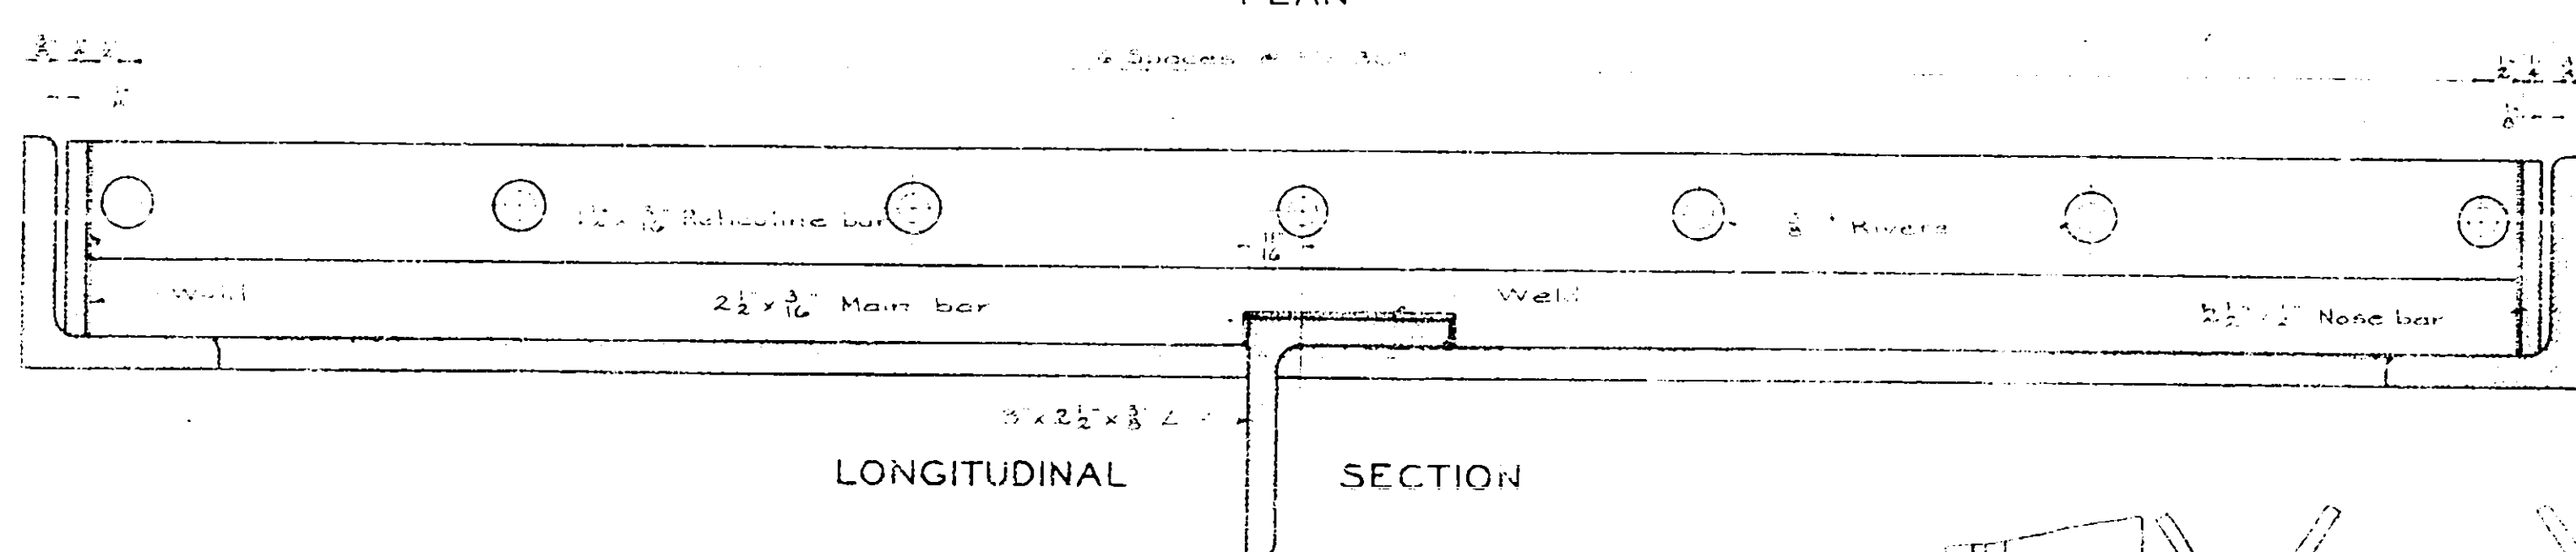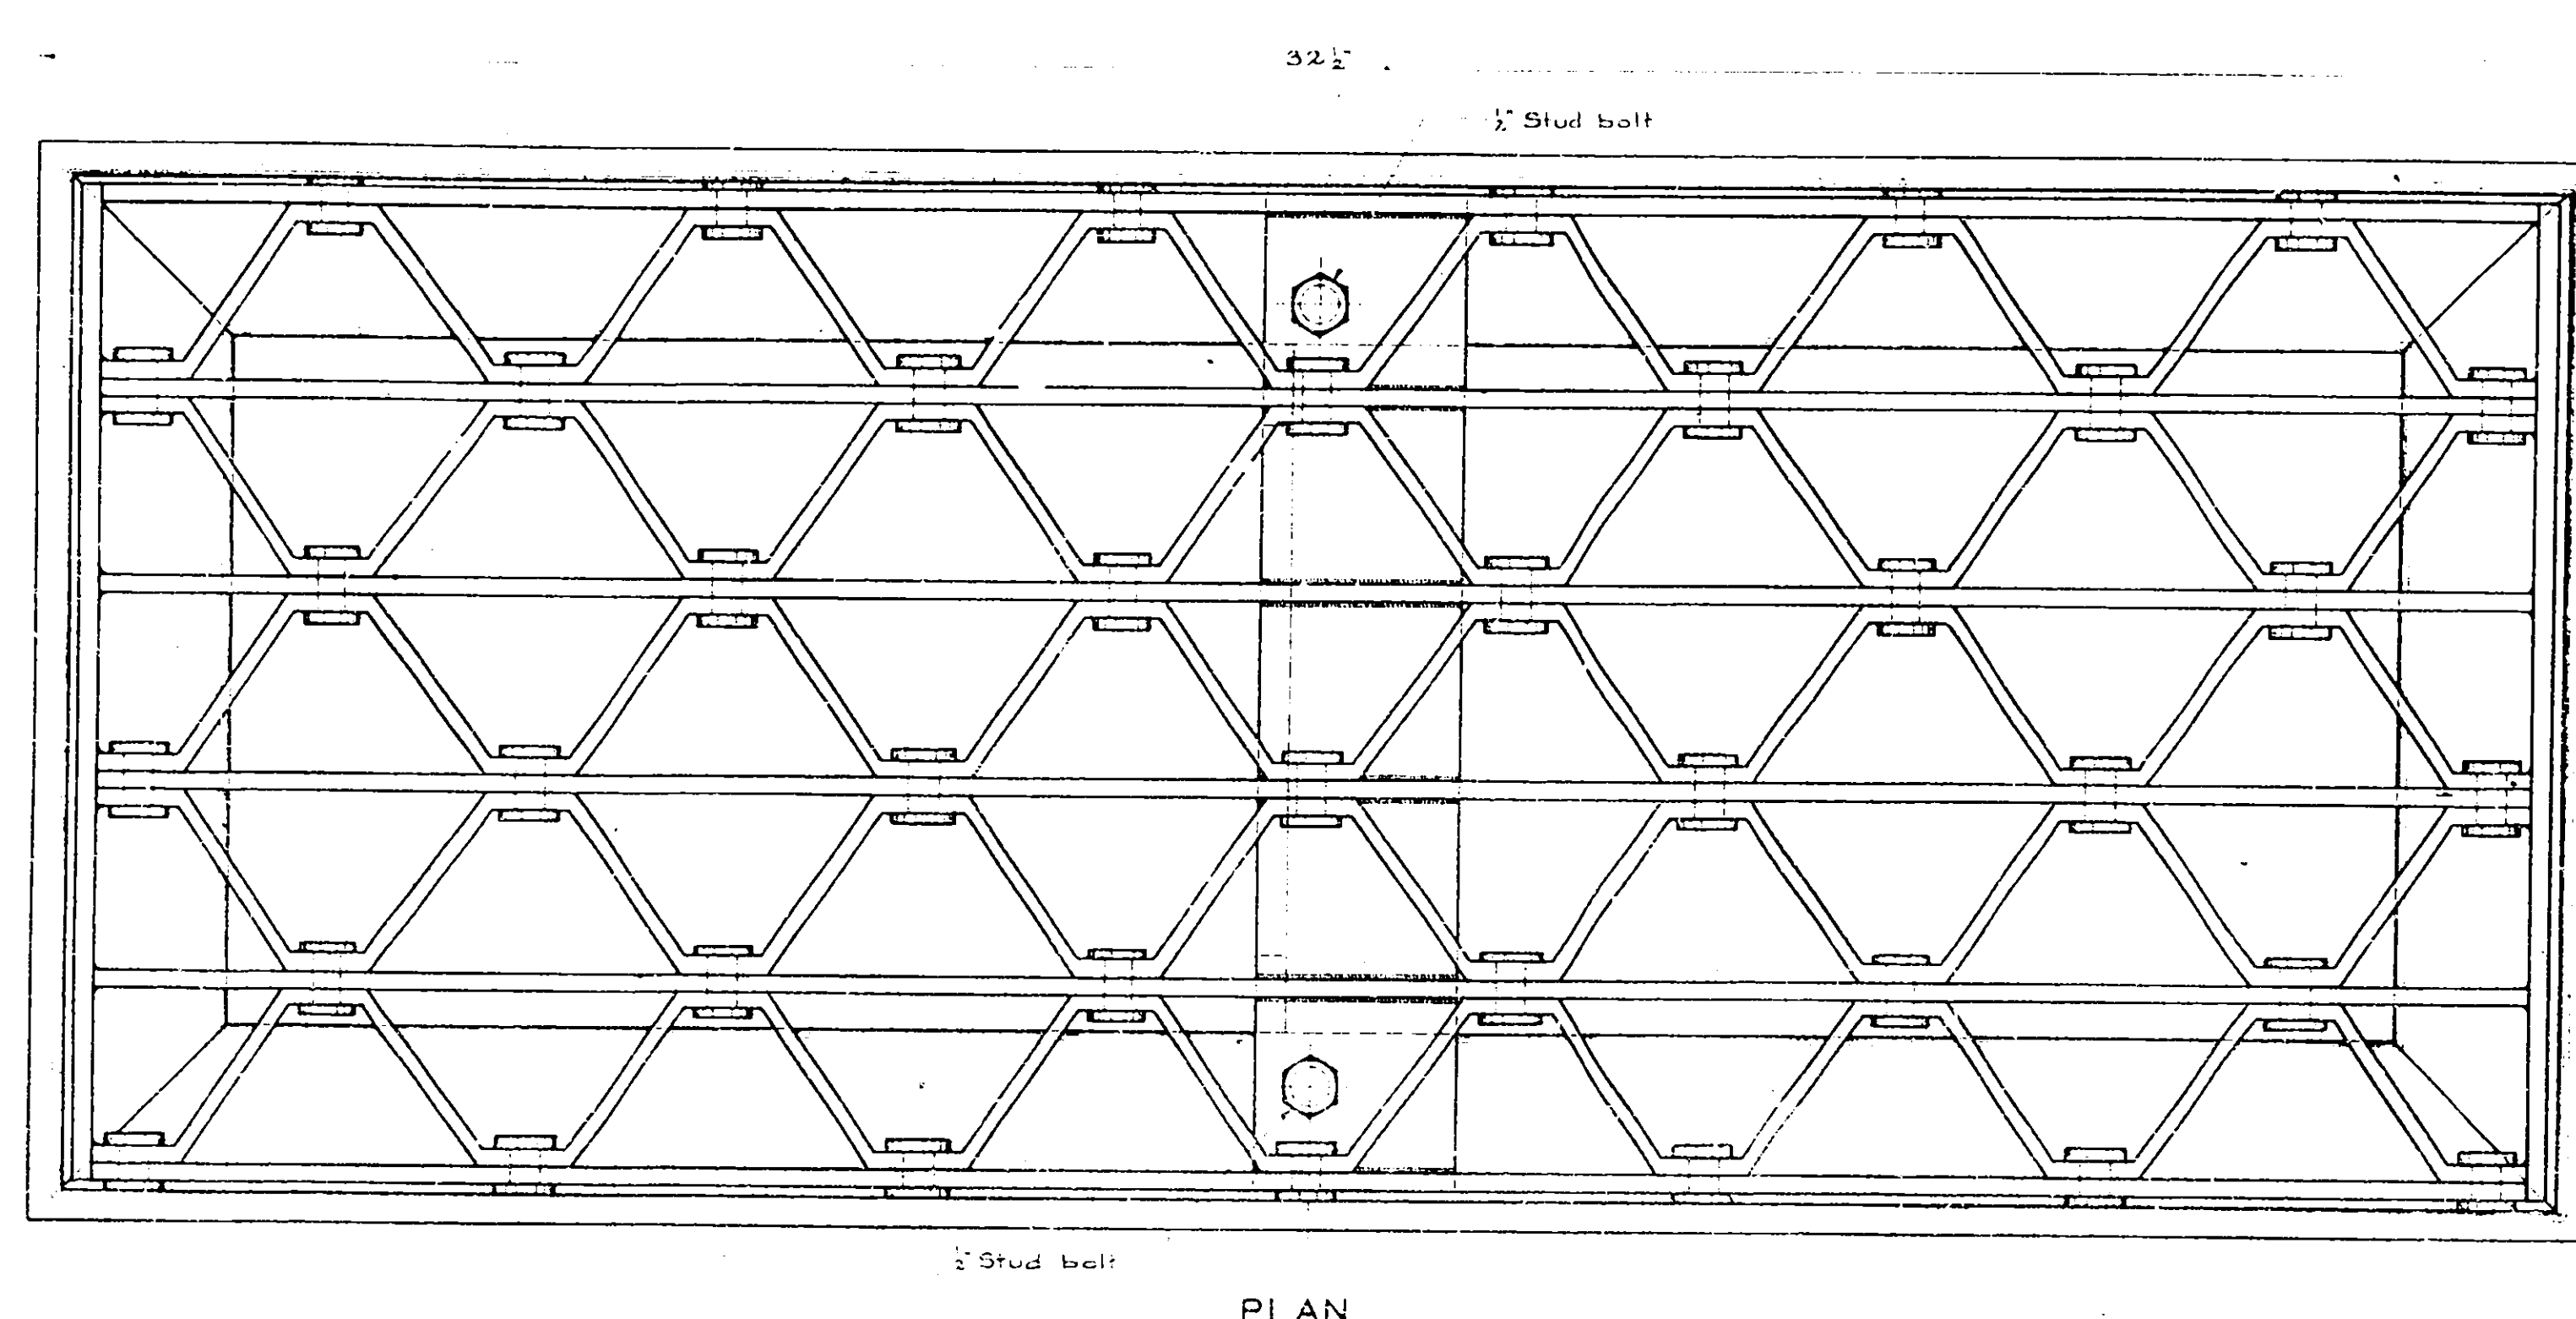



FRAME & GRATE TYPE A

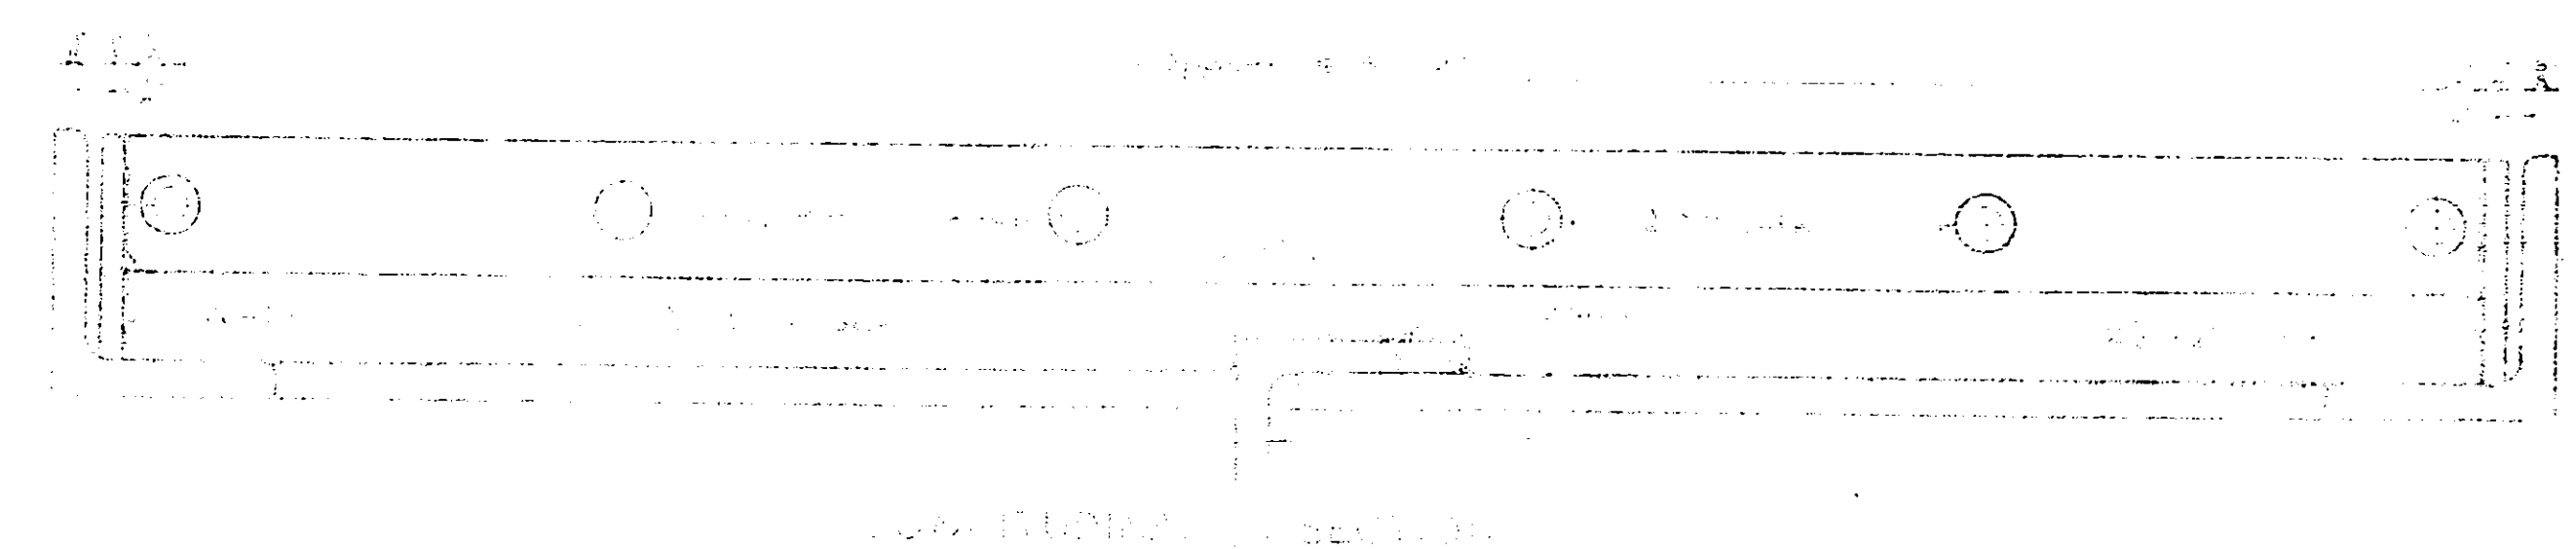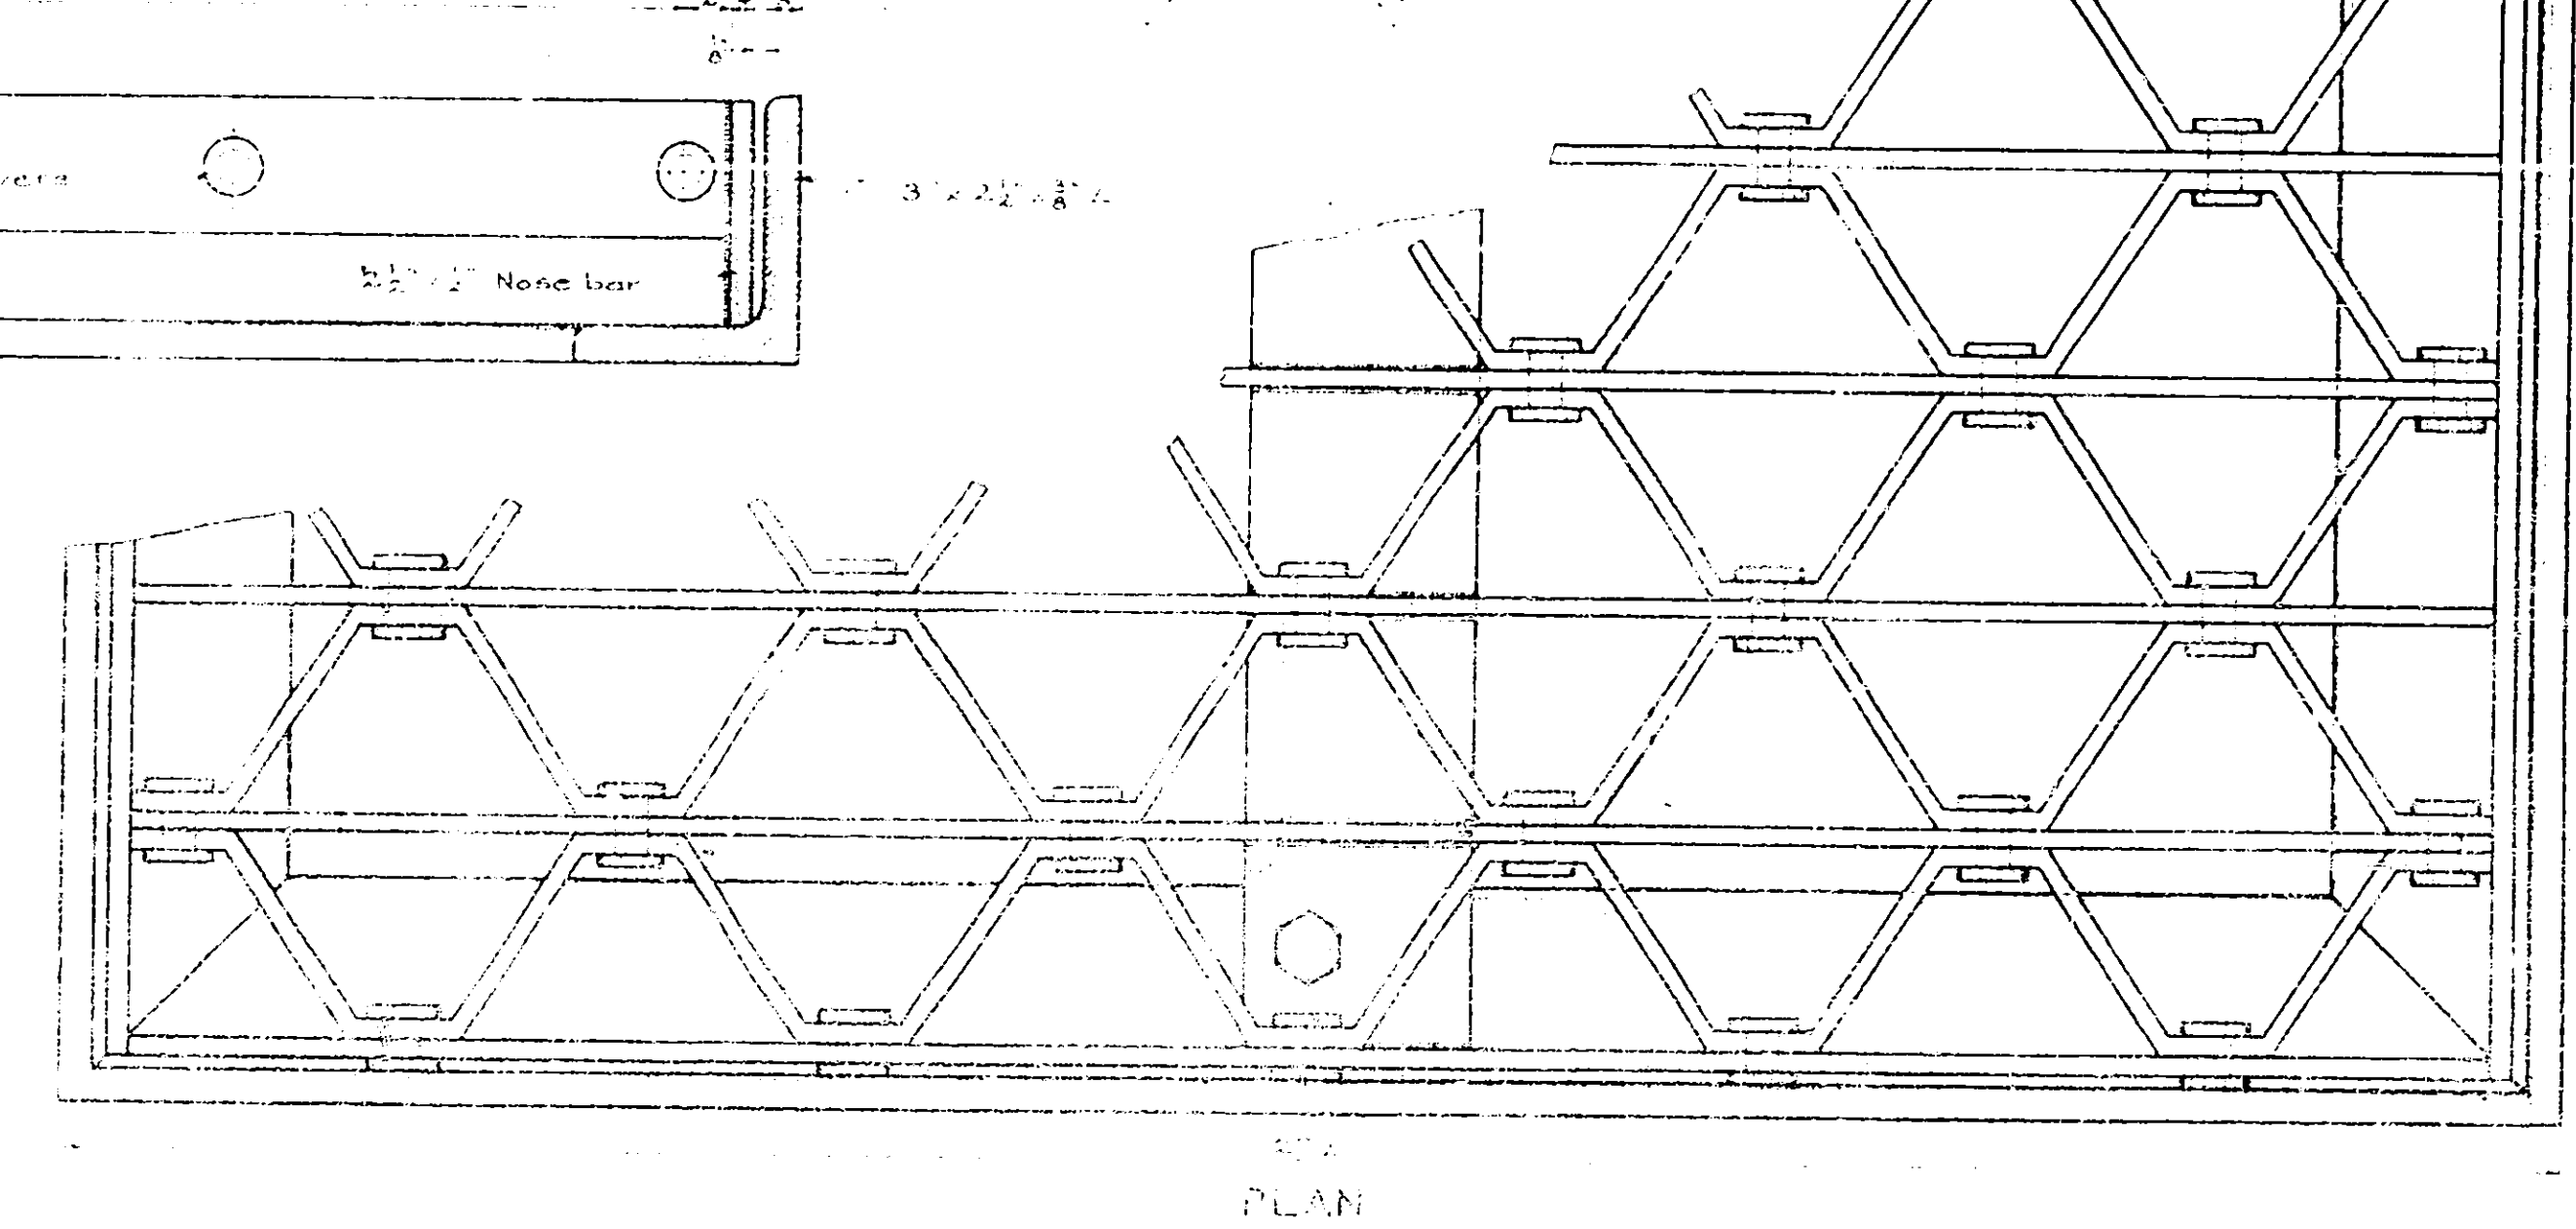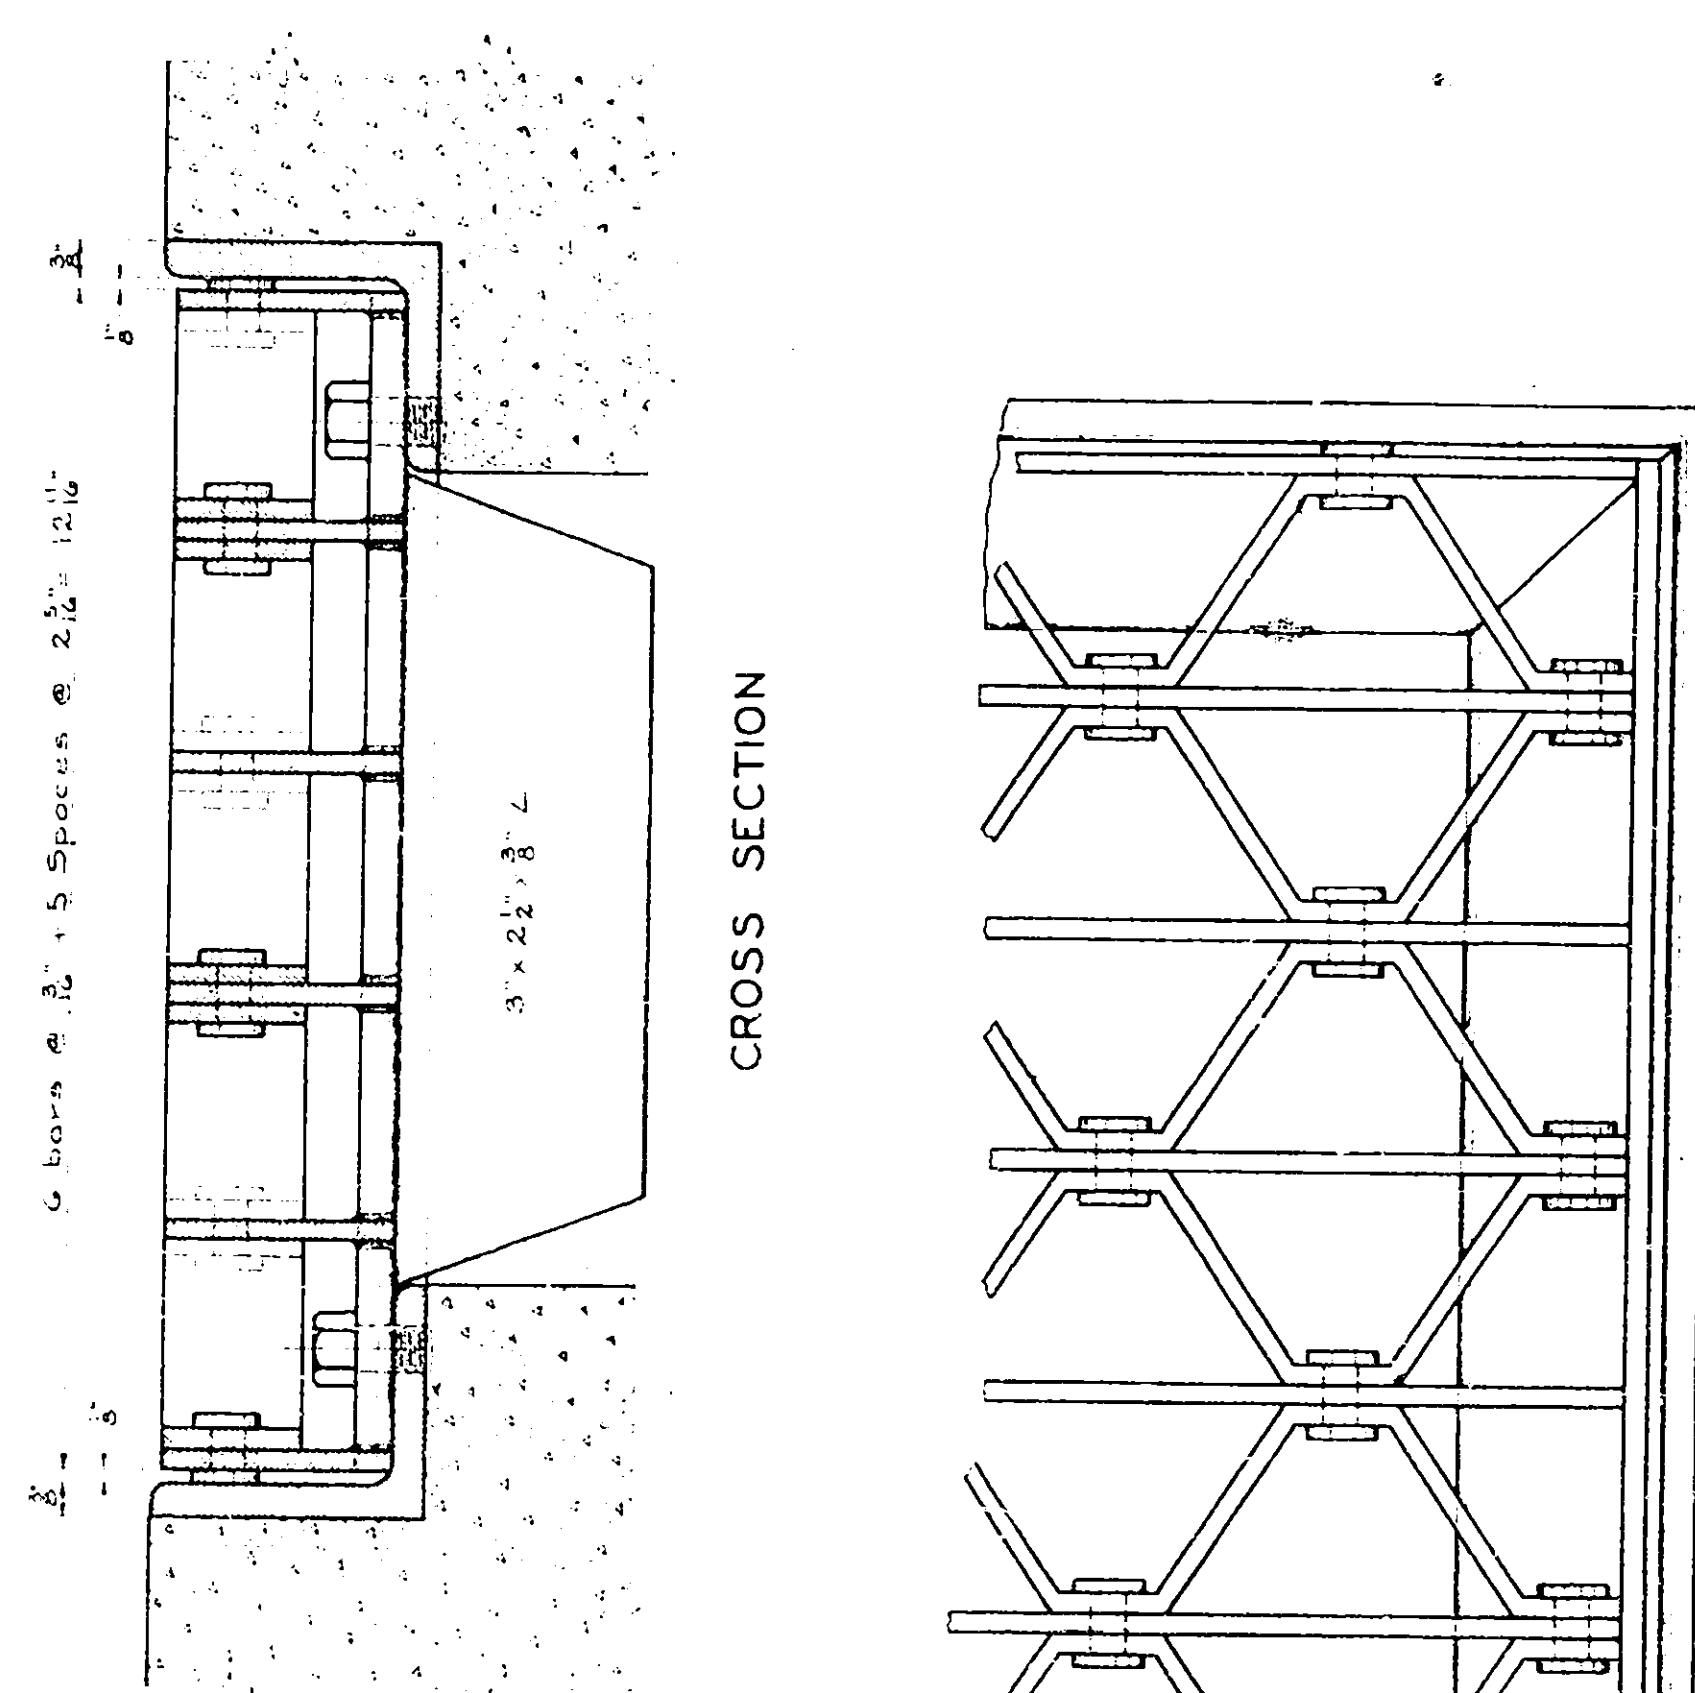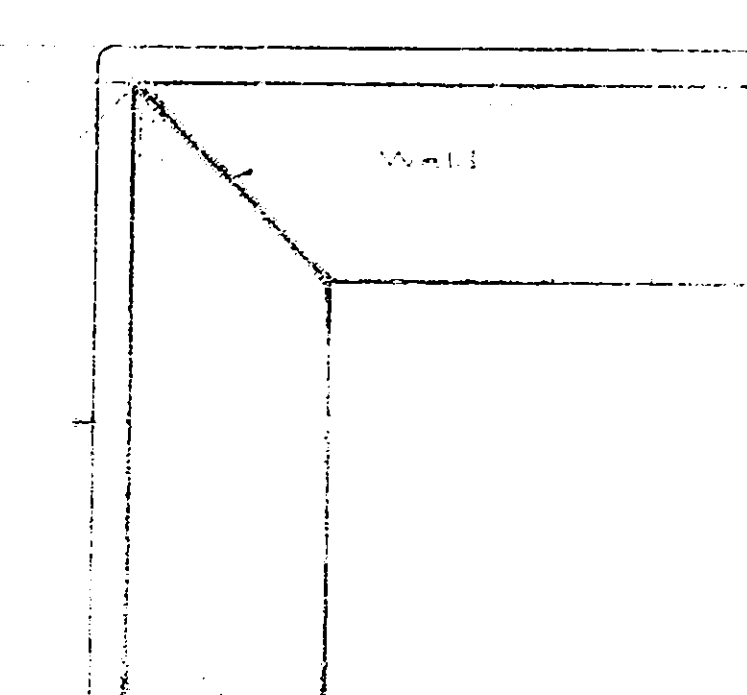

FRAME & GRATE TYPE A

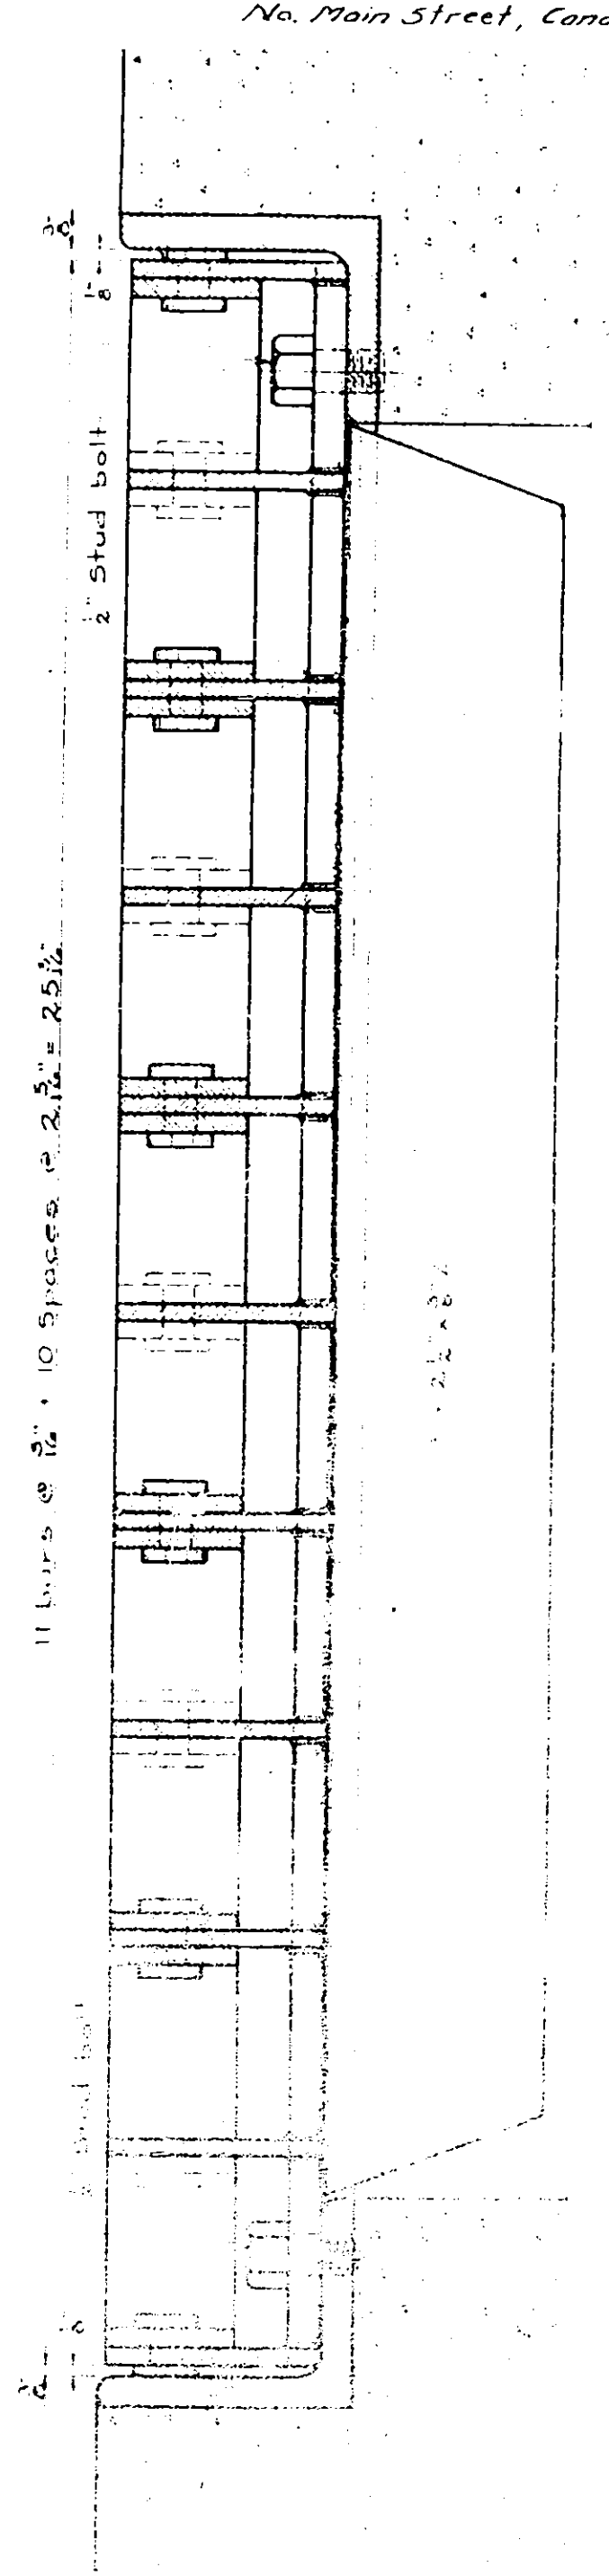

FED. RD. DIV. NO.	STATE	FED. AID PROJ. NO.	COUNTY	SHEET NO.	TOTAL SHEETS
	N.Y.		MADISON	59	67
MOHAWK THRUWAY N. CHITTENANGO - CANASTOTA N. MAIN ST., CANASTOTA					

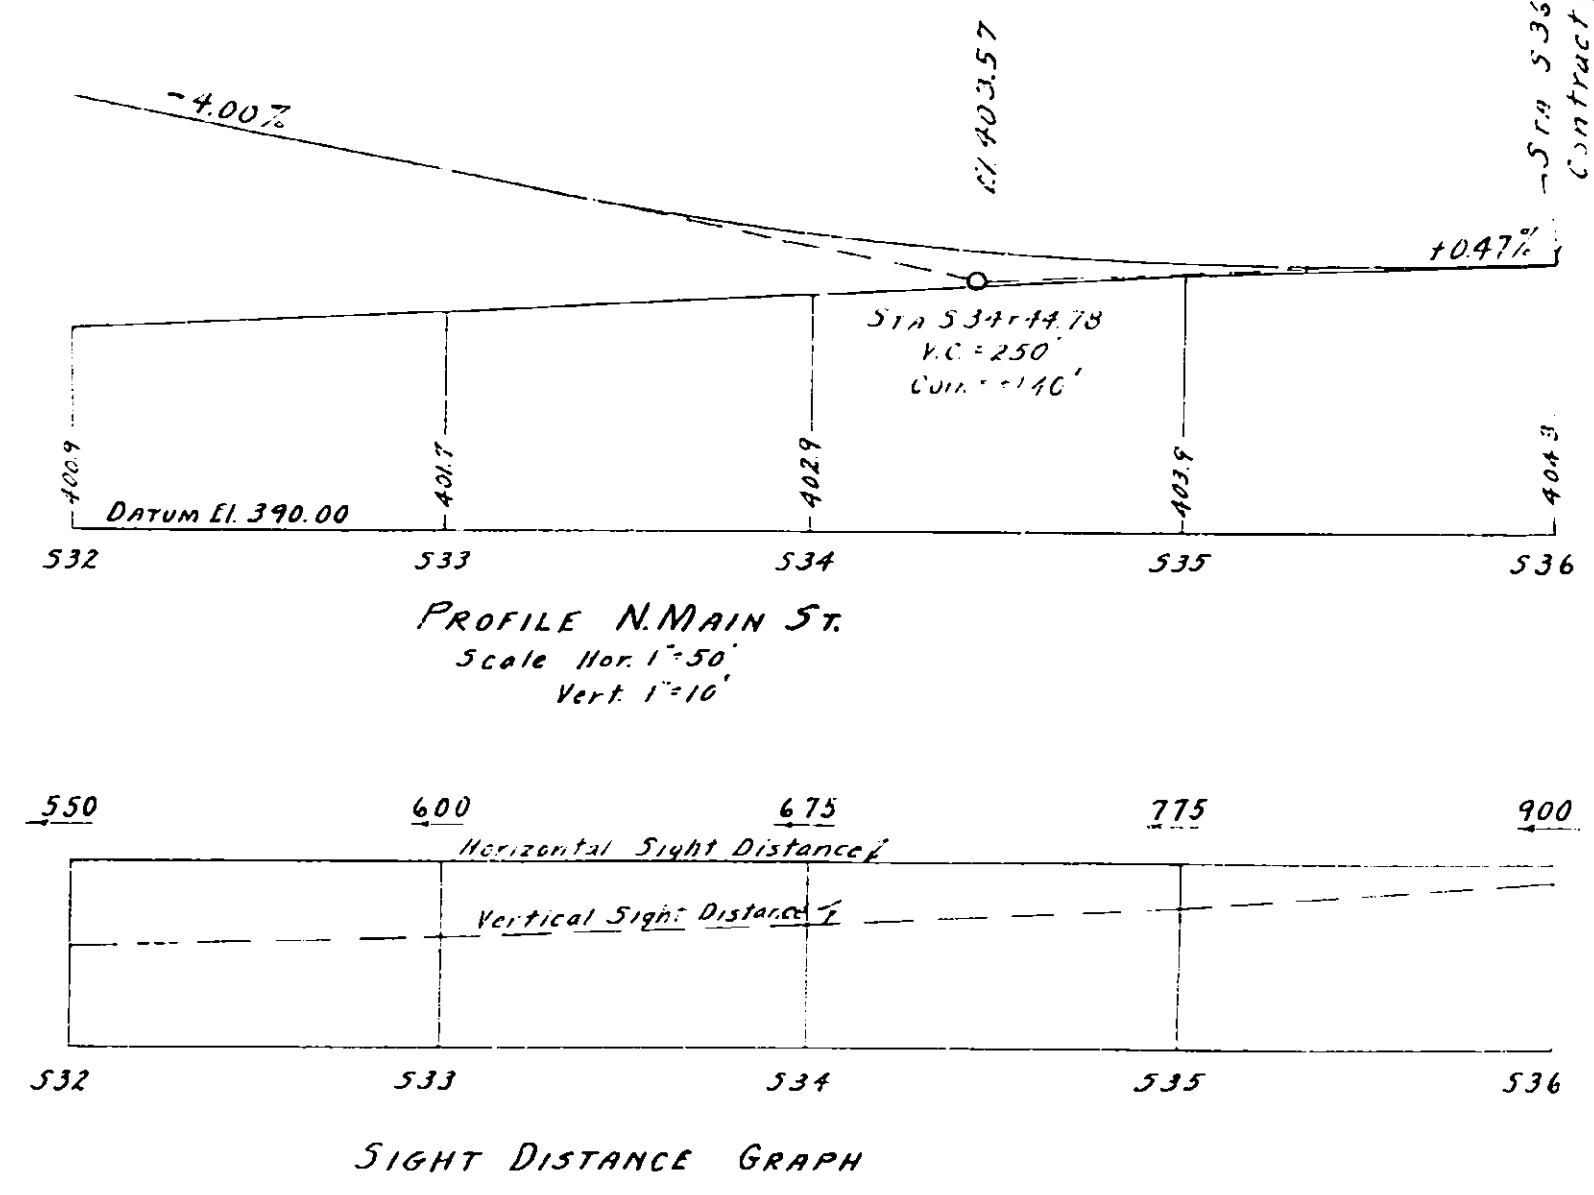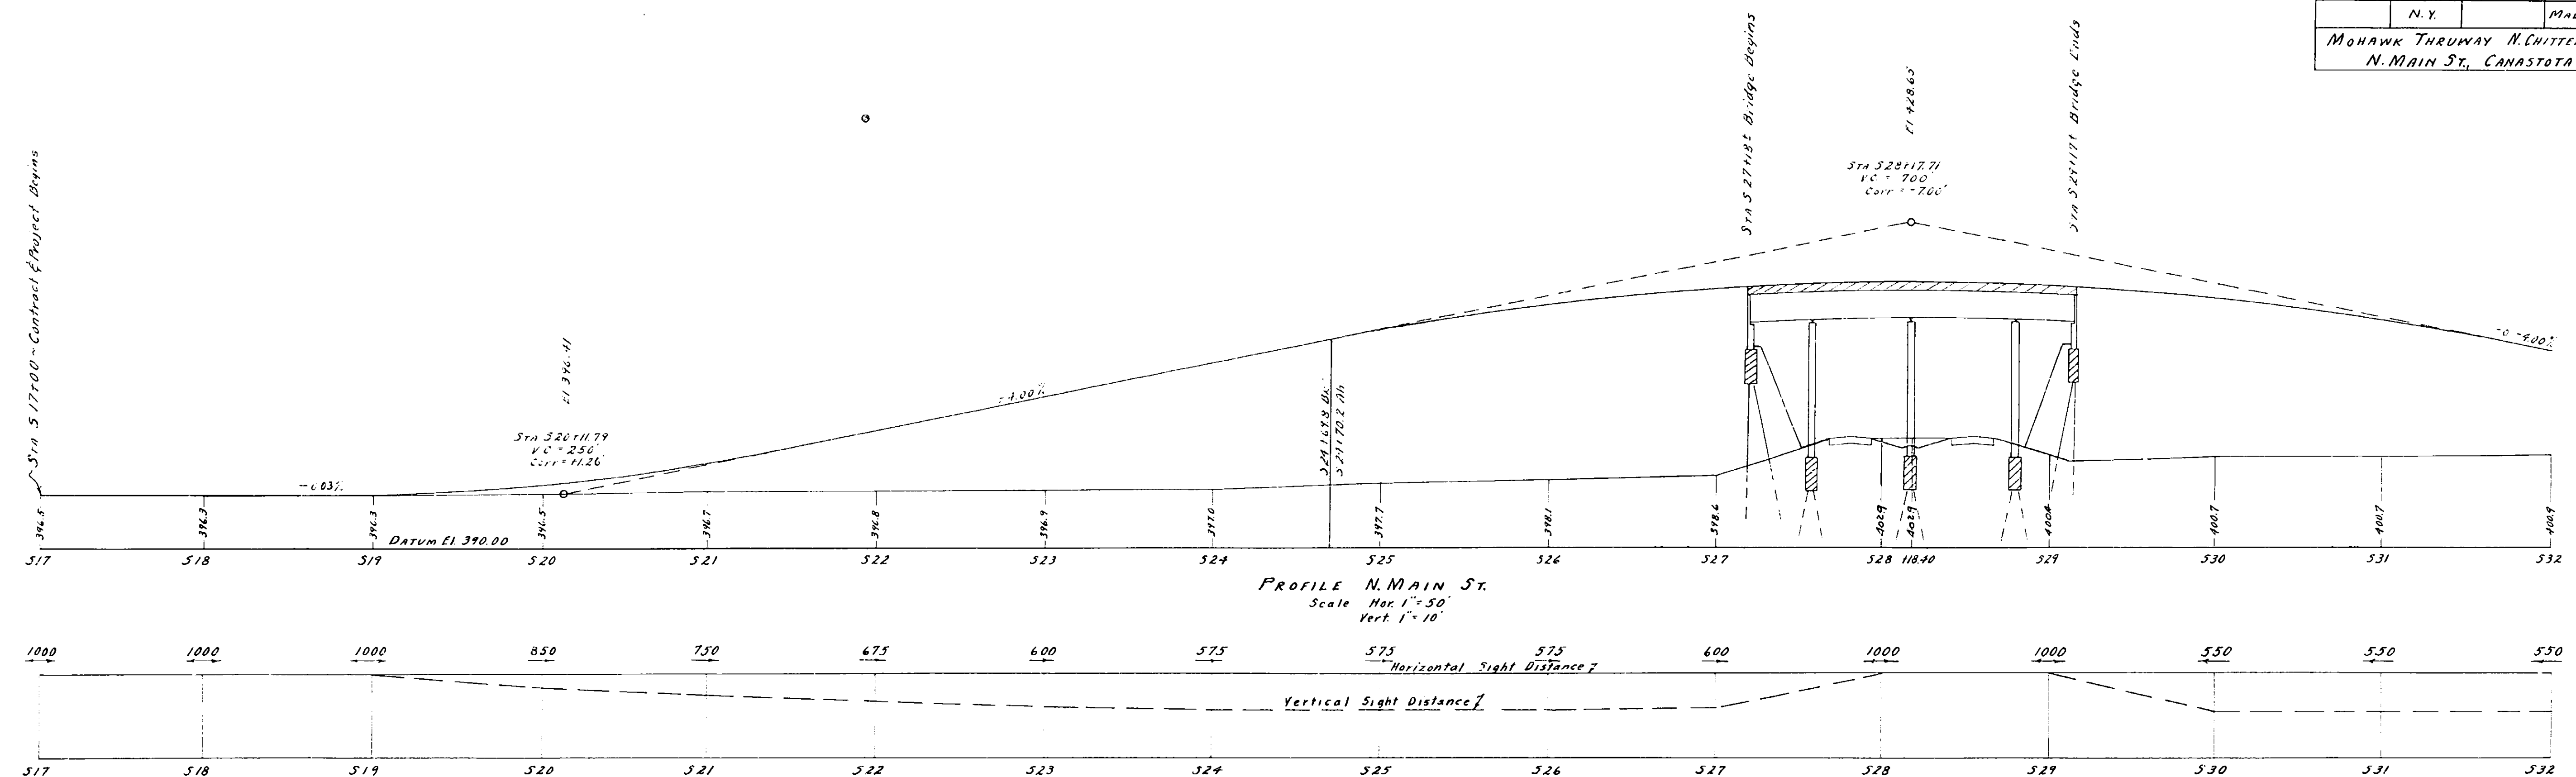

MADE BY: TRACED BY: CHECKED BY:

PLAN: Celangile, G.E. White

PROFILE: _____



PREPARED PURSUANT TO THE HIGHWAY LAW & RECOMMENDED BY

DATE: _____

ENGINEER DISTRICT NO. 10

FED. RD. DIV. NO.	STATE	FED. AID PROJ. NO.	COUNTY	SHEET NO.	TOTAL SHEETS
	N.Y.		MADISON	59	67
MOHAWK THRUWAY N. CHITTENANGO - CANASTOTA N. MAIN ST., CANASTOTA					


59R

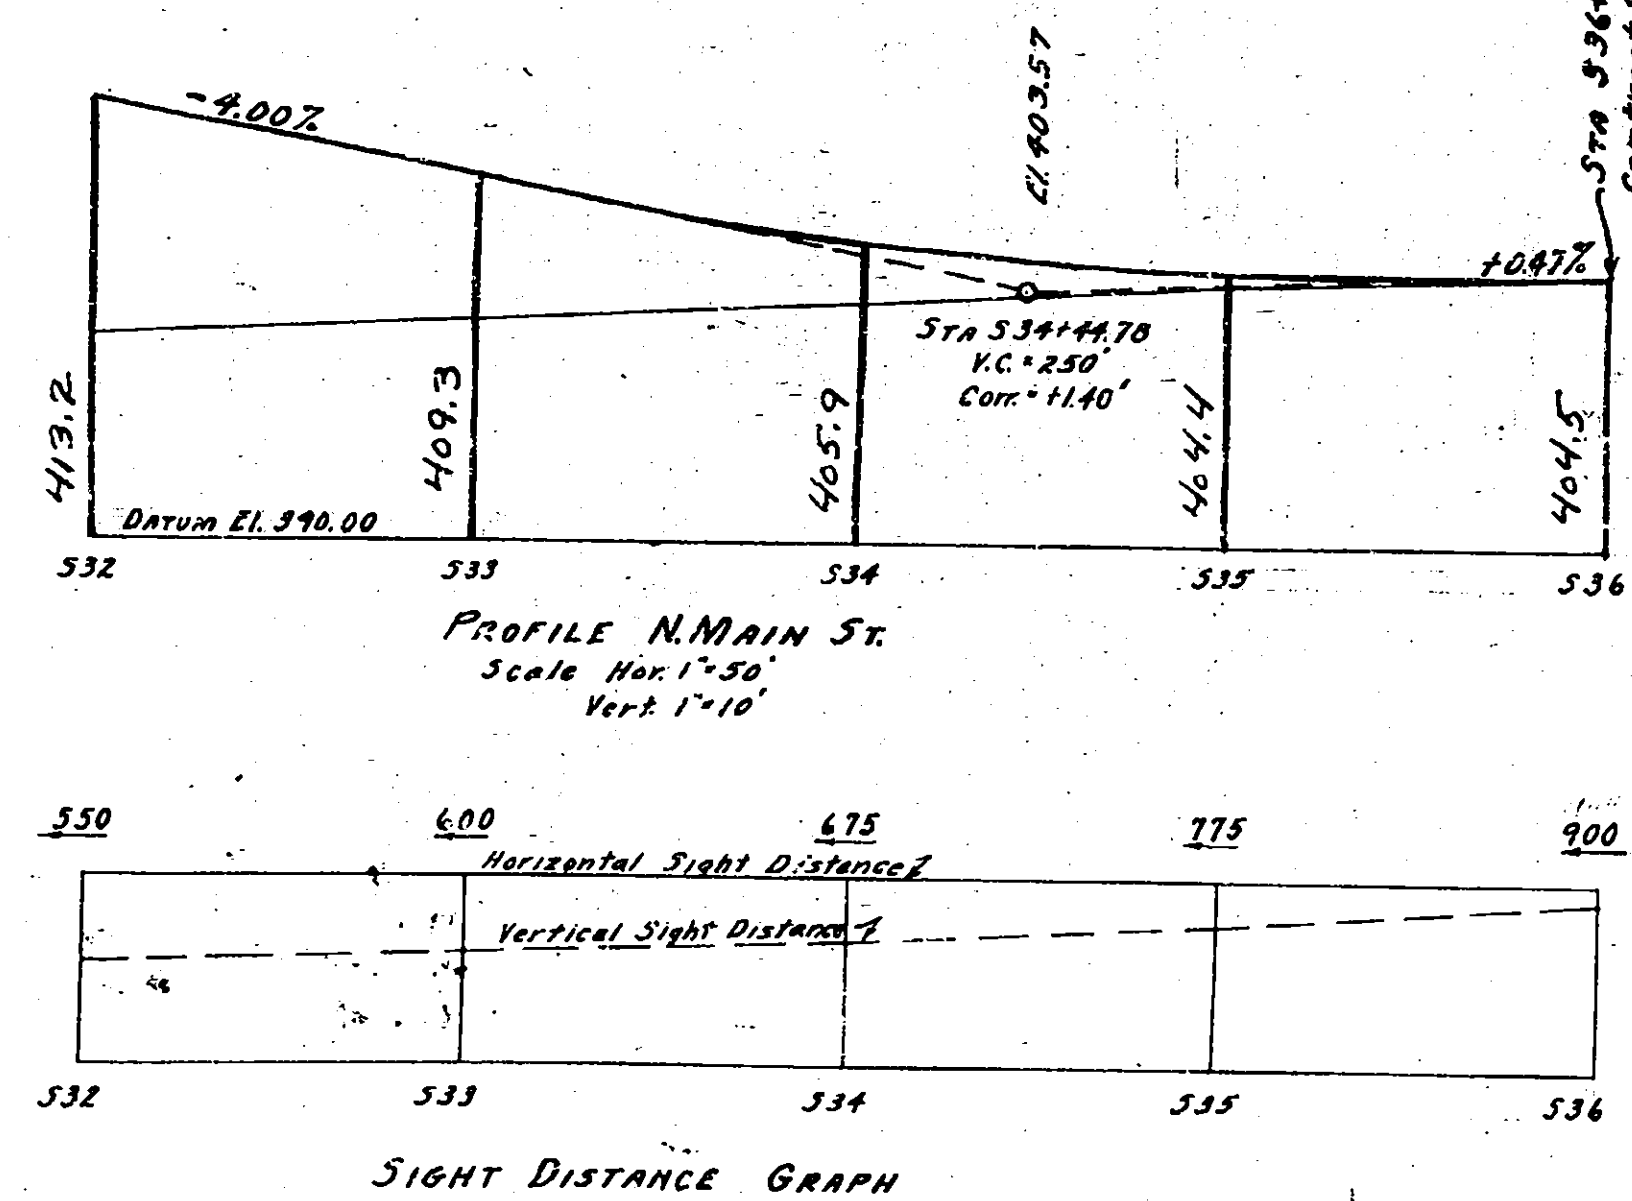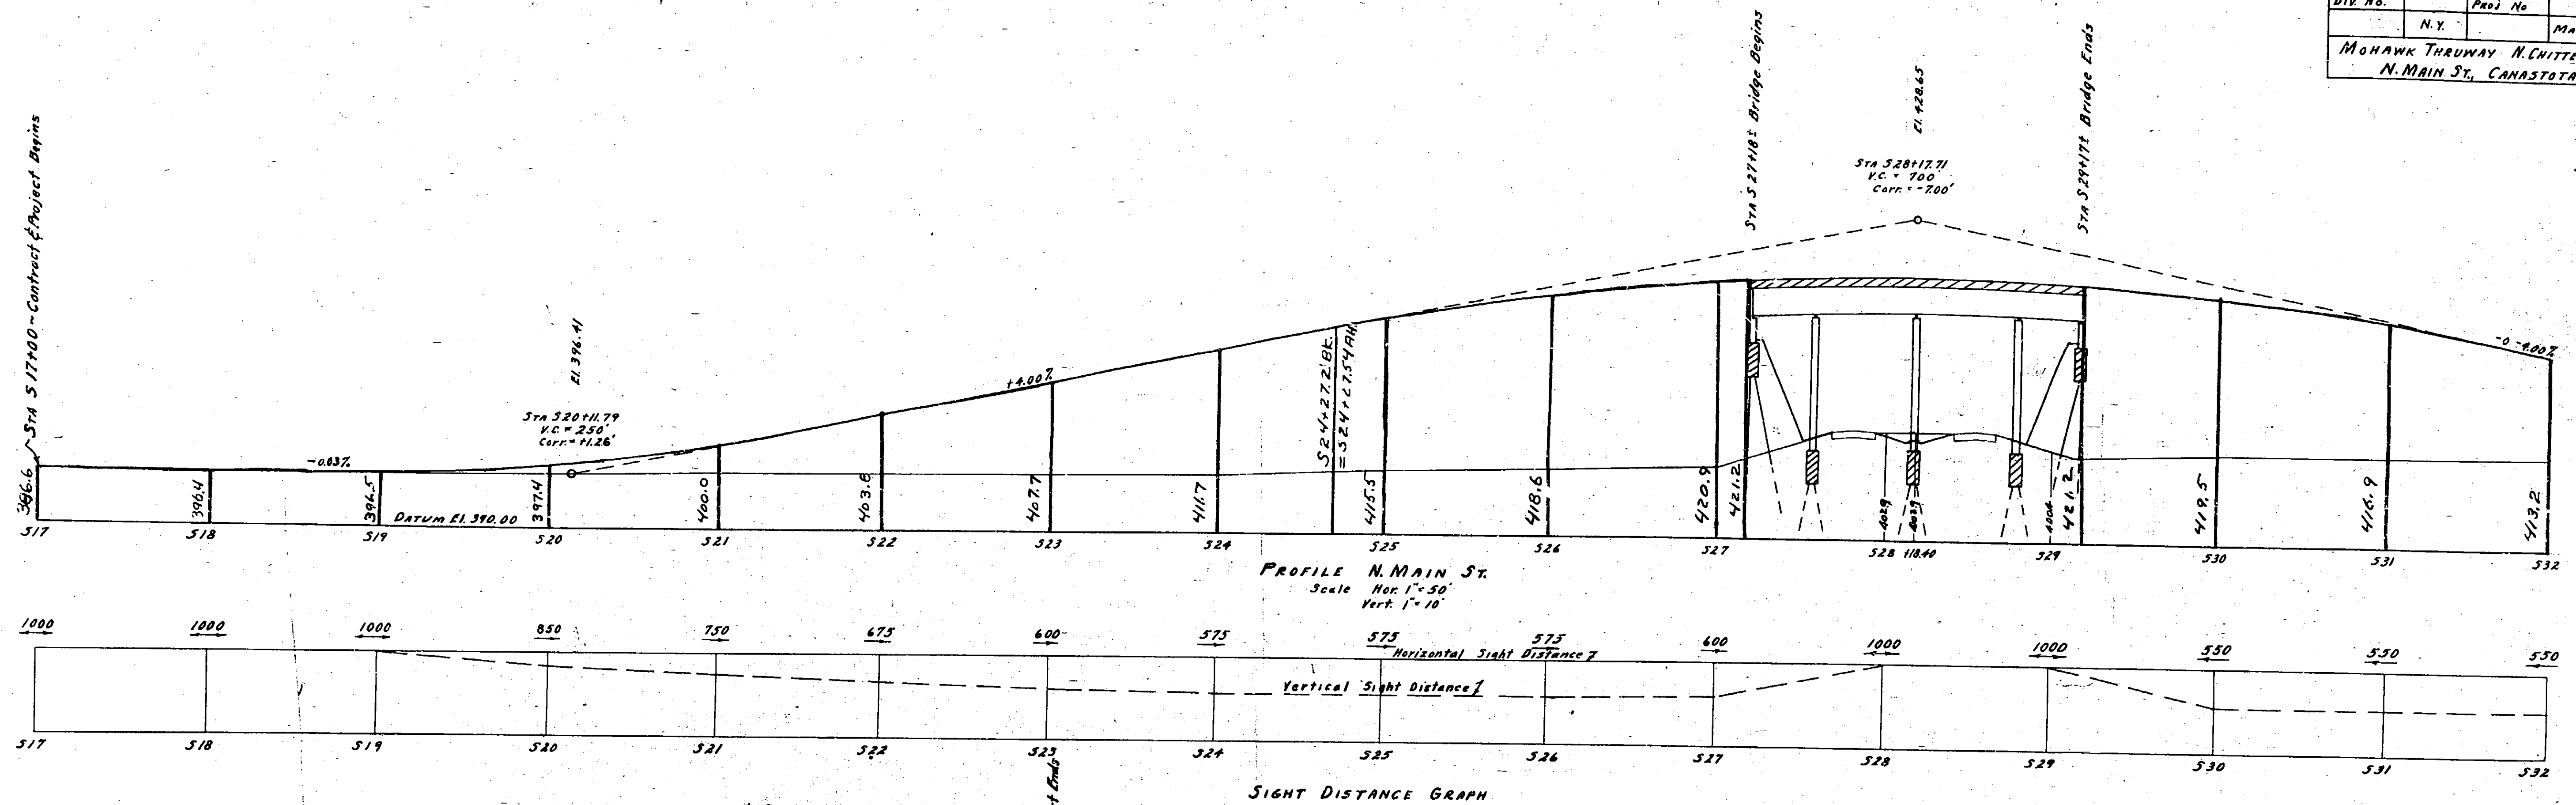

	MADE BY	TRACED BY	CHECKED BY
PLAN	_____	Colangelo	P. E. White
PROFILE	_____	_____	_____

PREPARED PURSUANT TO THE HIGHWAY LAW & RECOMMENDED BY
 _____ Larry Ketchum
 DATE _____ ENGINEER DISTRICT NO. 2


MADE BY _____ TRACED BY _____ CHECKED BY _____

PLAN  _____ Colangelo, _____ F. E. White


PROFILE _____

FED. RD. DIV. No.	STATE	FED. AID PROJ. No.	COUNTY	SHEET NO.	TOTAL SHEETS
	NY		MADISON	60	67

MOHAWK THRUWAY - N. CHITTENANGO - CANASTOTA
N. MAIN STREET

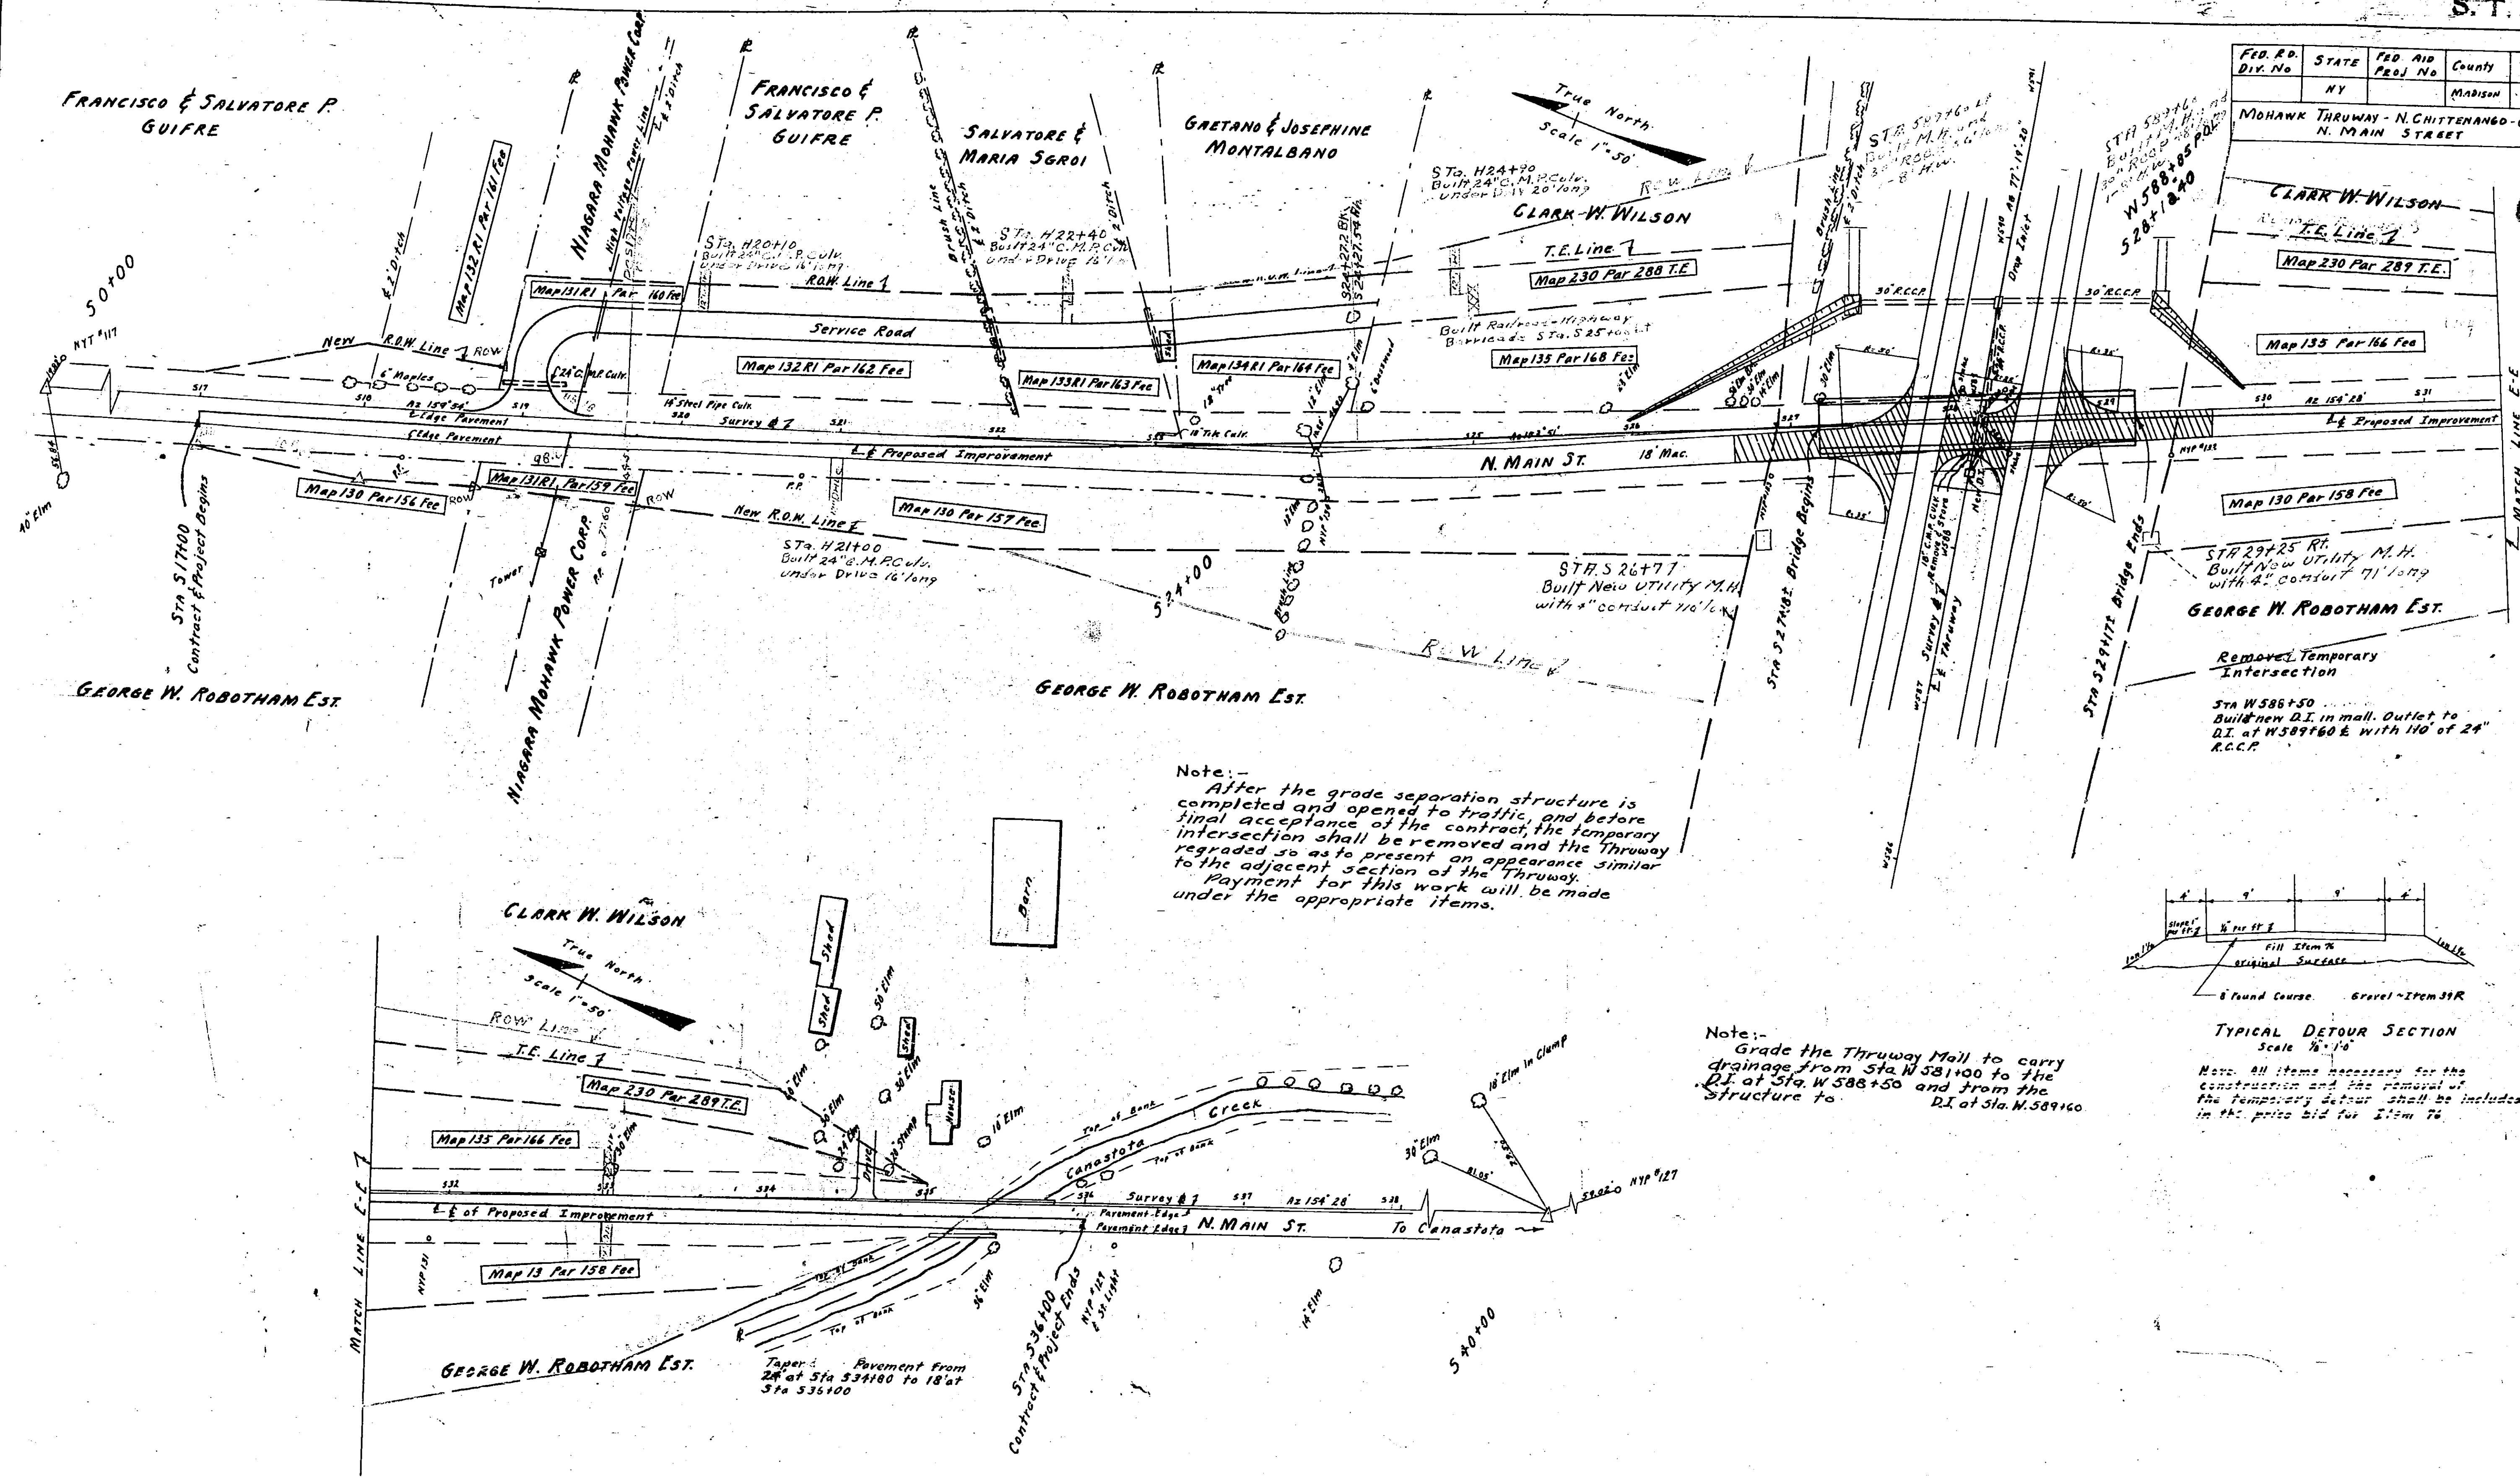

Note:-
After the grade separation structure is completed and opened to traffic, and before final acceptance of the contract, the temporary intersection shall be removed and the Thruway regraded so as to present an appearance similar to the adjacent section of the Thruway.
Payment for this work will be made under the appropriate items.

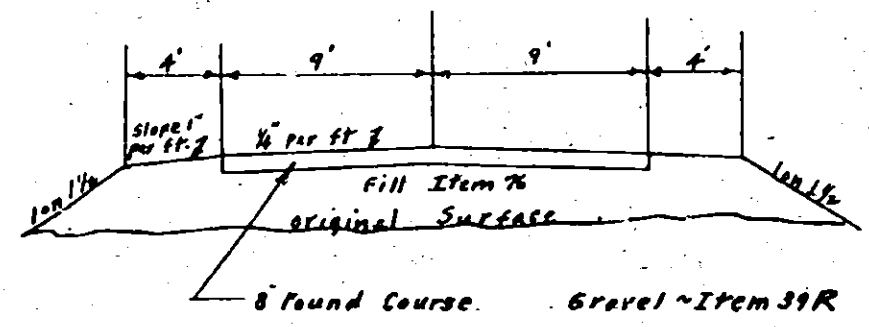

TYPICAL DETOUR SECTION
Scale 1/2"=1'-0"


Note:-
Grade the Thruway Mail to carry drainage from Sta. W 581+00 to the D.I. at Sta. W 588+50 and from the structure to the D.I. at Sta. W 589+60.

MADE BY _____ TRACED BY _____ CHECKED BY _____
PLAN _____ Colangelo _____
PROFILE _____


PREPARED PURSUANT TO THE HIGHWAY LAW & RECOMMENDED

DATE _____
ENGINEER DISTRICT _____

At intervals of 100 ft. or at such intervals as the Engineer may direct, lateral trenches or weep holes four feet in width shall be opened up through the shoulders to the ditches to effectively drain the subgrade before the pavement is constructed. These shall be filled with Item 39, Foundation Course R.O.B. Gravel and the excavation will be paid for under Item 28, Unclassified Excavation.

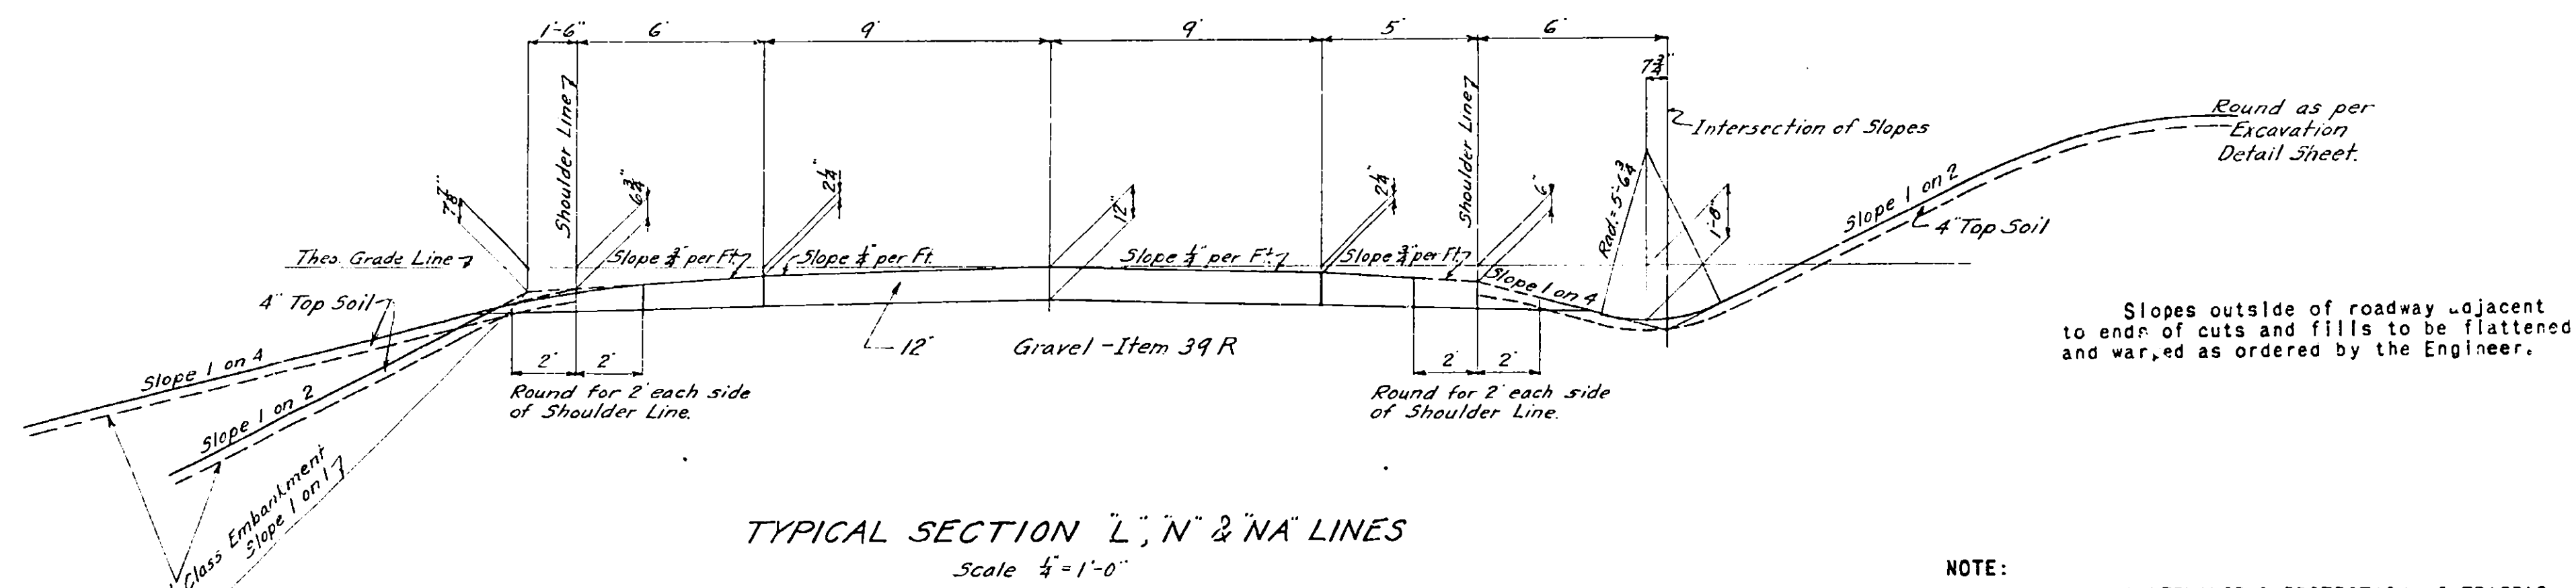

Second Class Embankment shall be used between the lines indicated if ordered by the Engineer. Second Class Embankment is material stripped from cuts and under embankments as ordered, but shall not include stumps, logs, brush nor other objectionable material.

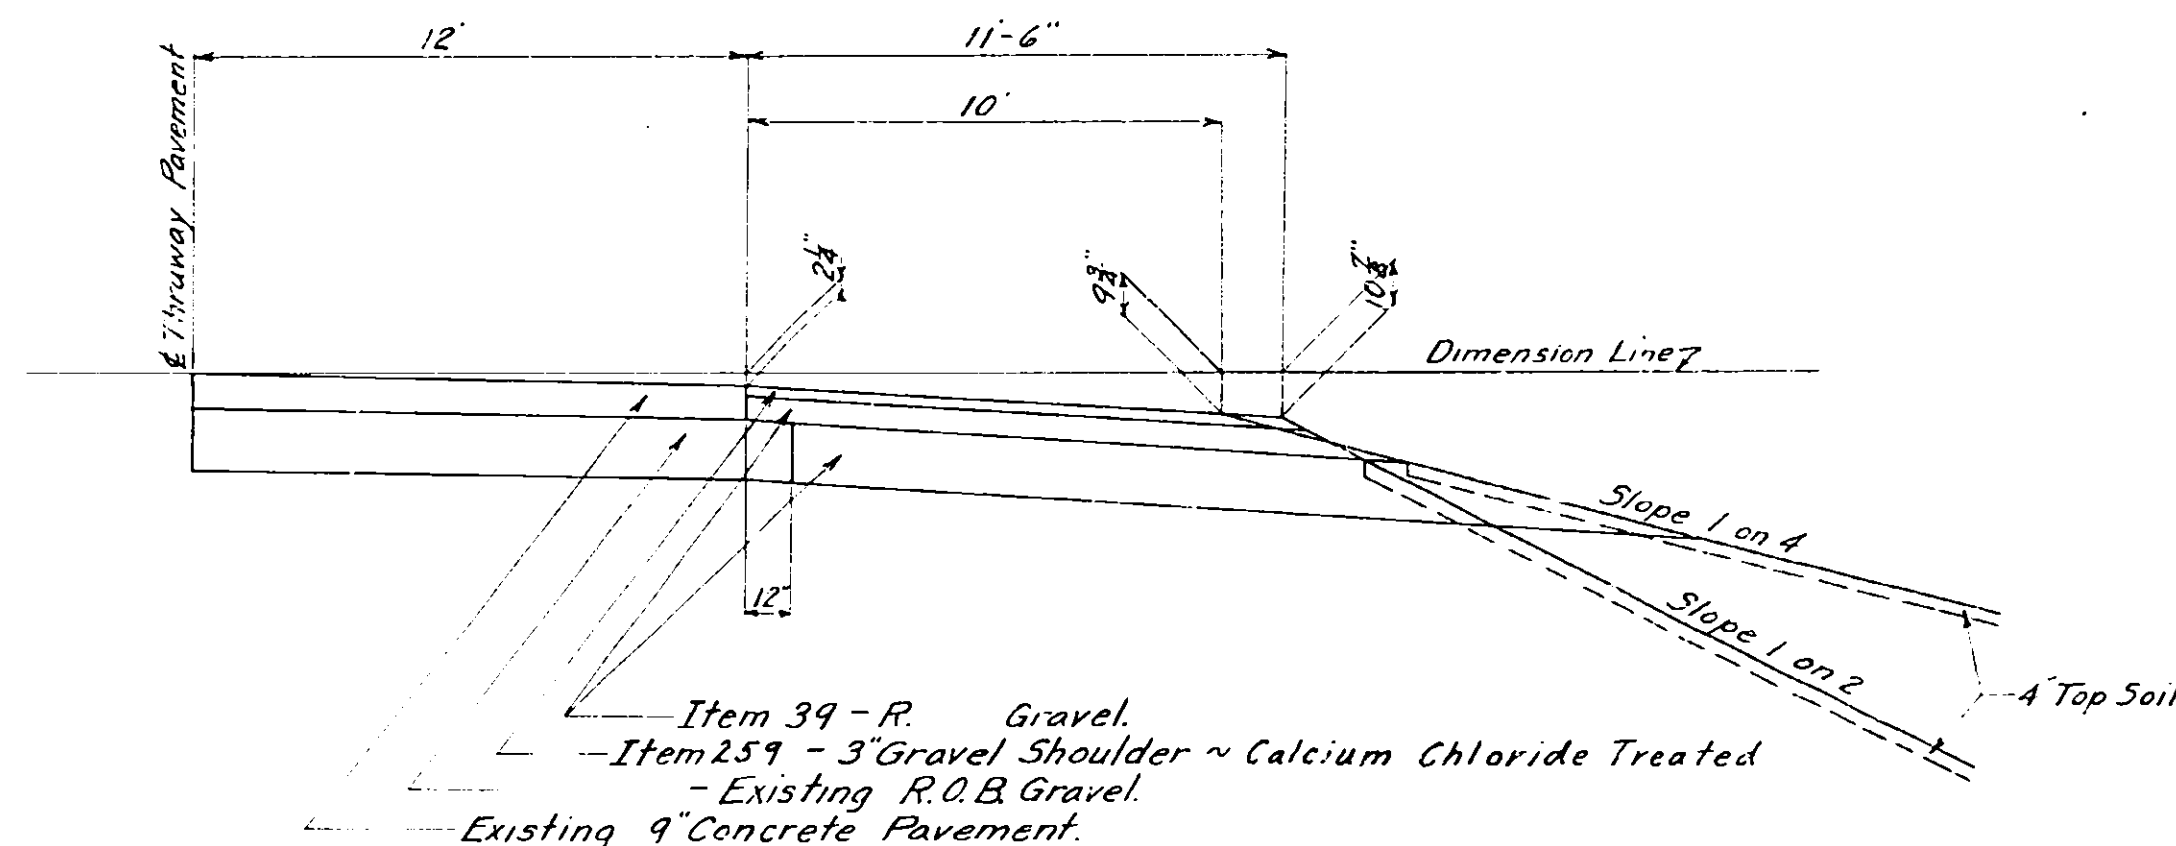

FED. RD. DIV. NO.	STATE	FED. AID PROJ. NO.	COUNTY	SHEET NO.	TOTAL SHEETS
	N.Y.		Madison	61	67
Mohawk Thruway N. Chittenango-Cornwall Relocated Town Road L, N and NA Lines					

Item 28 - UNCLASSIFIED EXCAVATION

From	C.Y.
Road Excavation	1913
Borrow	31184
Remove Temp. Intersection	1037
Top Soil	2691
Drainage Structures	247
Waste	4344
Estimate	3584
TOTAL	45000

NOTE:

- MAINTENANCE & PROTECTION OF TRAFFIC -

The contractor shall maintain and protect traffic within the limits of his contract for the entire length and duration of the contract in accordance with Item No. 76 with the following modifications: - The temporary crossing at Gees Road shall be maintained until the relocation of Tag Street, Station N 0+00 to N 29+56 C.L. and the relocation of town road N 29+56 C.L. to N 69+00 is passable and opened to traffic. The temporary crossings at Tag Street (Station 352+70 C.L. = L 21+10 C.L.) and at town road (Station 421+23 C.L. = N 87+88.5) shall be maintained until the Grade Separation at Gees Road is completed and opened to traffic.

Thruway traffic shall be maintained as required.

Signs shall be erected in accordance with Standard Structure Sheet No. 48-43.

TABLE of LENGTHS

Station	to Station	Lin. Ft.
L 9+00	L 10+73	173
N 0+00	N 10+51	1051
N 10+59	N 37+89	2730
N 37+98	N 48+00	1104
NA 49+00	NA 69+01.54	2001.54
TOTAL		7059.54 = 1.337 Miles

Item 5 - TRENCH, CULVERT and BRIDGE EXCAVATION

From	Cu. Yds.
Drainage Sheet	352
Estimate	48
TOTAL	400

DRAINAGE STRUCTURES

Present Structure	Station	REMARKS
None	N 0+00	Build new 18" R.C.C.P. Culv. 40 ft. long, 2 - 5 ft. H.Ws. Dig outlet ditch.
None	N 5+10	Build new 24" R.C.C.P. Culv. on skew 92 ft. long, using 52 ft. of 24" R.C.C.P. from existing culvert at Rt. of Sta. 352+70. Build 2 - 7 ft. H.Ws.
None	N 9+55	Build new 24" R.C.C.P. Culv. on skew 64 ft. long, 2 - 7 ft. H.Ws.
None	N 15+96	Build new 24" R.C.C.P. Culv. on skew 56 ft. long, 2 - 7 ft. H.Ws.
None	N 29+10	Build new 12" R.C.C.P. Culv. 44 ft. long, 2 - 4 ft. H.Ws. Dig inlet and outlet ditches.
None	N 29+93	Build new 12" R.C.C.P. Culv. 44 ft. long, 2 - 4 ft. H.Ws. Dig inlet and outlet ditches.
None	N 45+00	Build new 30" R.C.C.P. Culv. 40 ft. long, 2 - 8 ft. H.Ws.
None	NA 51+00	Build new 24" R.C.C.P. Culv. 48 ft. long, 2 - 7 ft. H.Ws.
30" C.M.P.	NA 65+12	Build new 48" R.C.C.P. Culv. 60 ft. long, 2 - 12 ft. H.Ws. Remove and store 30" C.M.P.
None	NA 64+50 Rt.	Ditch crossing 18" R.C.P., 24 ft. long. No H.Ws.
18" C.M.P. 80' long	352+00 Lt.	Remove and store.
24" R.C.C.P. 52' long	352+70 Rt.	Remove and use at Sta. N 5+10.
18" C.M.P. 90' long	353+50 Rt.	Remove and store.
18" C.M.P. 40' long	421+23 C.L. Mall	Remove and store.


Prepared Pursuant to the Highway Law & Recommended by

Made by Traced by Checked by
PLAN S. T. 32-8 S. T. 32-8 Colangelo
PROFILE

ENGINEER/DISTRICT No. 2

FED. RD. Div. No.	STATE	FED. AID Proj. No.	COUNTY	SHEET No.	TOTAL SHEETS
	N.Y.		Madison	61	67
Mohawk Thruway N. Chittenango - Canastota Relocated Town Road L, N and NA Lines					

At intervals of 100 ft. lateral trenches or weep holes four feet in width through the shoulders to the ditches to effectively drain the subgrade before the pavement is constructed. These are filled with Item 39, Foundation Course R.O.B. Gravel and the excavation paid for under item 28, Unclassified Excavation.

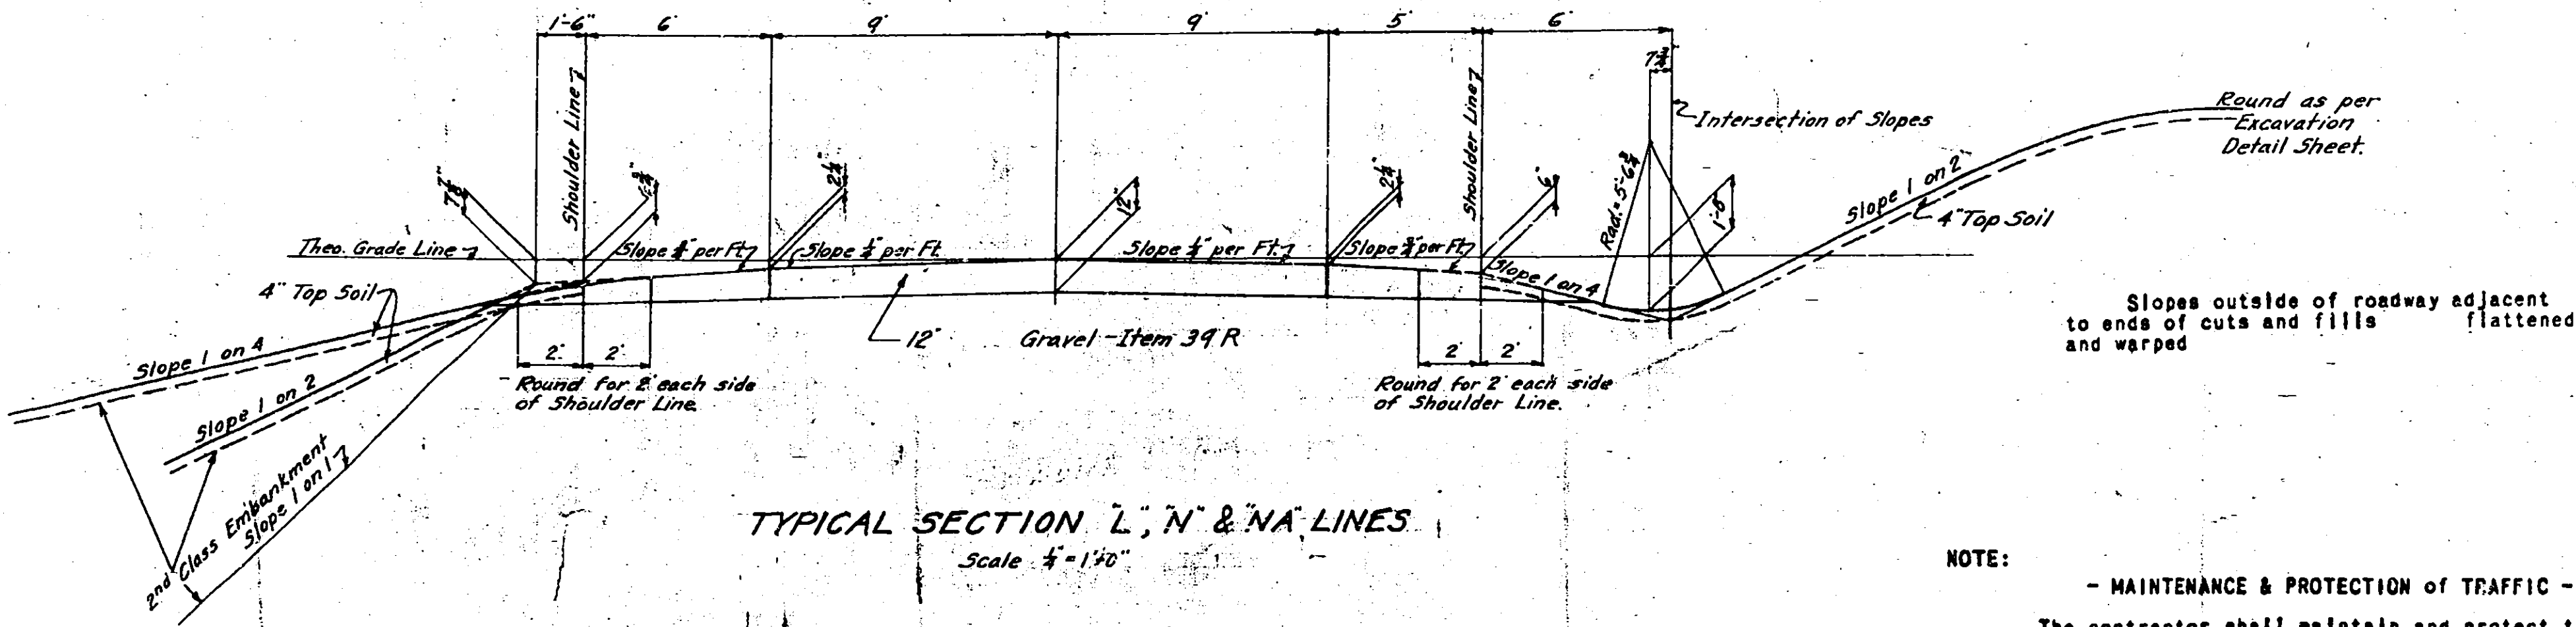

Second Class Embankment shall be between the lines established by the Engineer. Second Class Embankment material stripped from cuts and embankments shall be used, but shall not include stumps, logs, brush or other objectionable material.


NOTE:
- MAINTENANCE & PROTECTION OF TRAFFIC -
The contractor shall maintain and protect traffic within the limits of his contract for the entire length and duration of the contract in accordance with Item No. 78 with the following modifications: - The temporary crossing at Goes Road shall be maintained until the relocation of Tag Street, Station N 0+00 to N 28+88 C.L. and the relocation of town road N 28+88 C.L. to N 69+00 is passable and opened to traffic. The temporary crossings at Tag Street (Station 352+70 C.L. = L 21+10 C.L.) and at town road (Station 421+23 C.L. = N 87+89.5) shall be maintained until the Grade Separation at Goes Road is completed and opened to traffic.
Thruway traffic shall be maintained as required.
Signs shall be erected in accordance with Standard Structure Sheet No. 48-49.

Item 28 - UNCLASSIFIED EXCAVATION
From Road Excavation C.Y.
Borrow
Remove Temp. Intersection

TOTAL

TABLE of LENGTHS

Station to Station	Lin. Ft.
L 9+00 to L 10+73	173
N 0+00 to N 10+51	1051
N 10+51 to N 37+88	2737
N 37+88 to N 48+00	1012
NA 48+00 to NA 69+01.54	2001.54
TOTAL	7084.84 = 1.337 miles

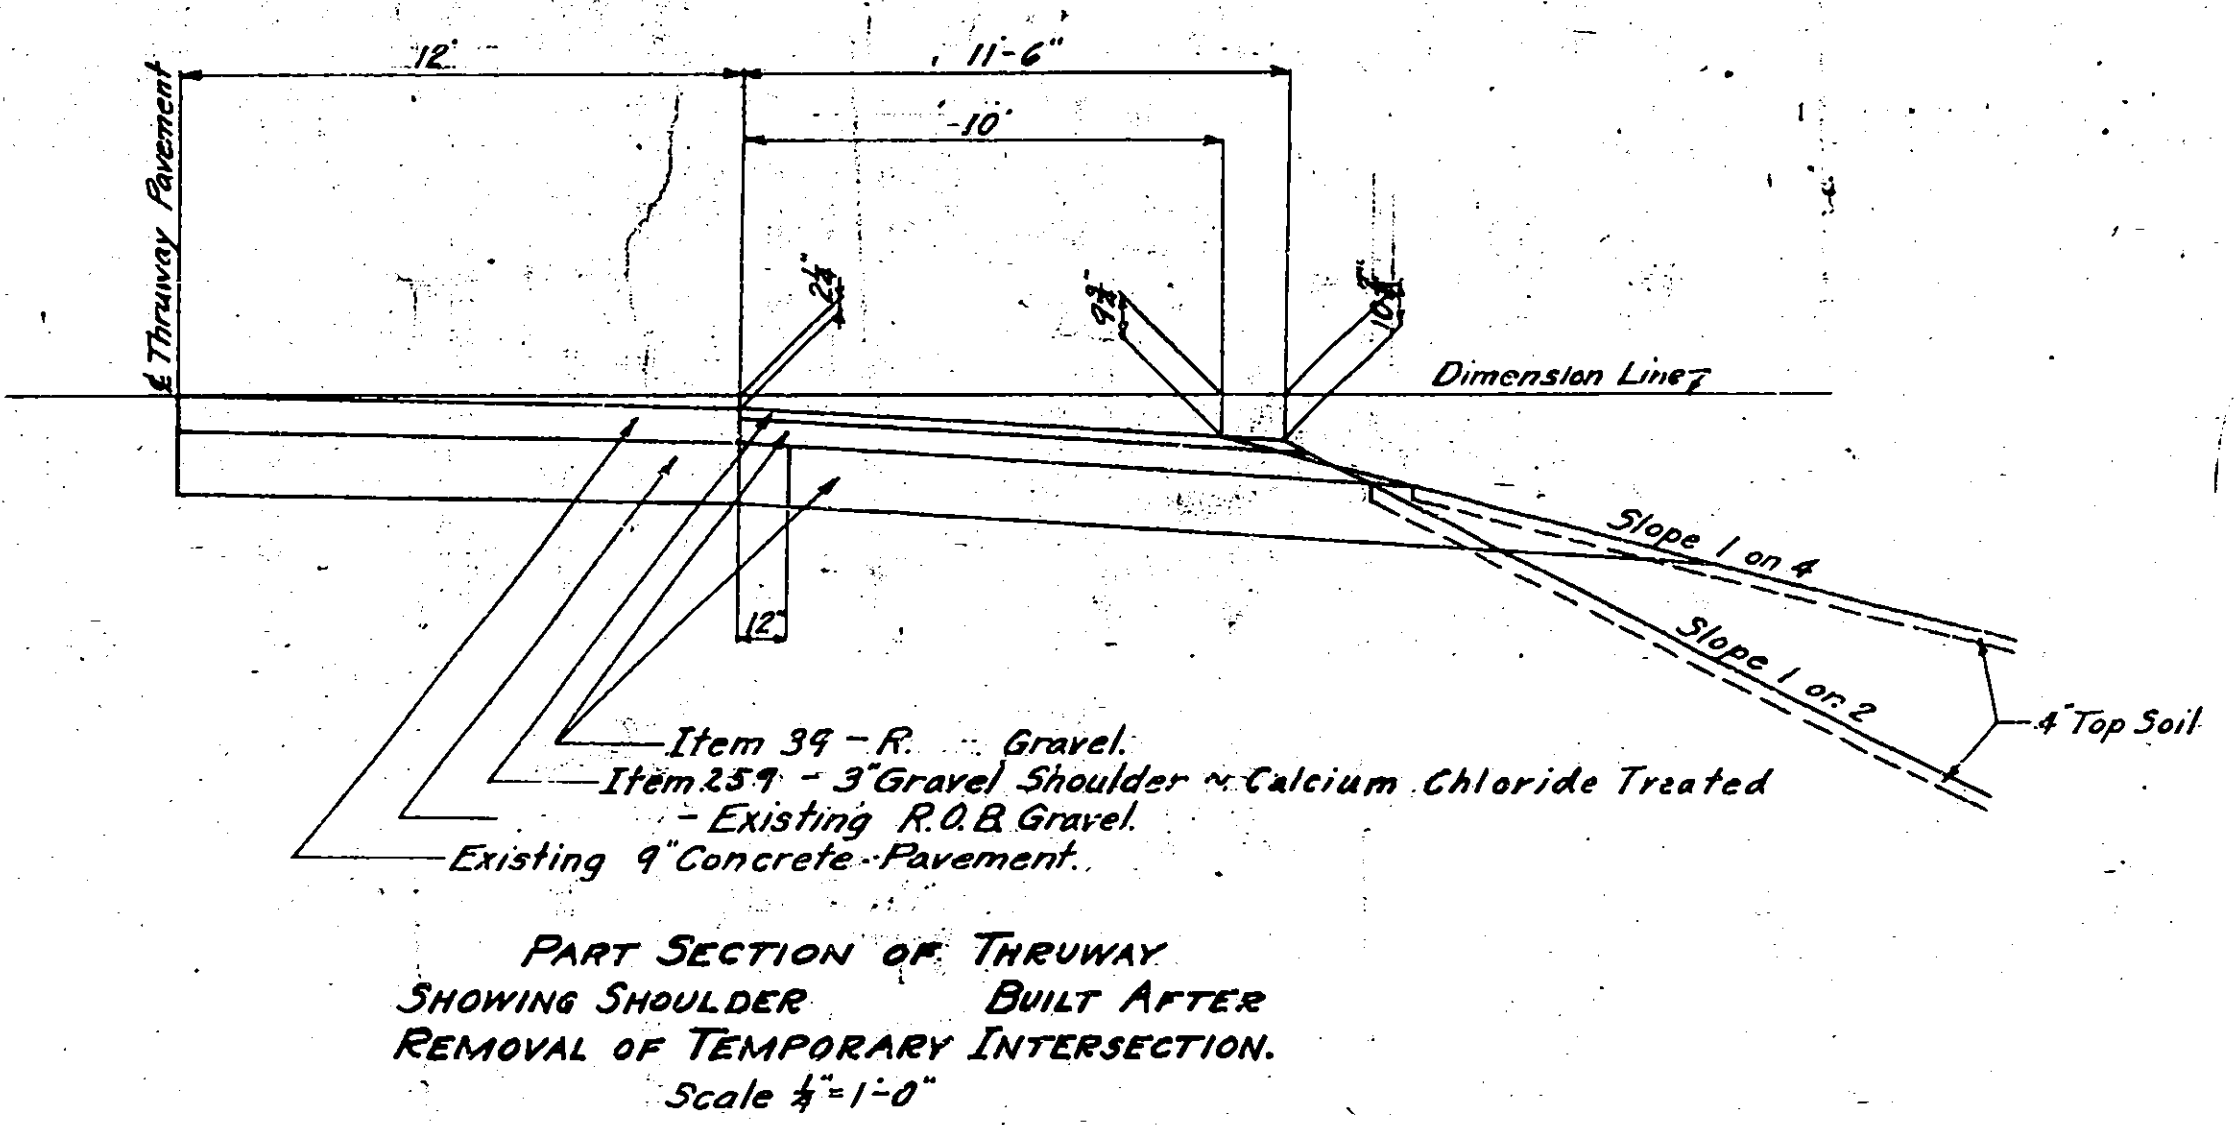

Item 5 - TRENCH, CULVERT and BRIDGE EXCAVATION
From Cu. Yds.
TOTAL


Present Structure	Station	REMARKS
None	N 0+00	Bull new 18" R.C.C.P. Culv. 40 ft. long, 2 - 8 ft. H.W.s. Dig outlet ditch.
None	N 6+10	Bull new 24" R.C.C.P. Culv. on skew 82 ft. long, 2 - 52 ft. of 24" R.C.C.P. from existing culvert at Sta. 352+70. Bull 2 - 7 ft. H.W.s.
None	N 9+55	Bull new 24" R.C.C.P. Culv. on skew 84 ft. long, 2 - 7 ft. H.W.s.
None	N 15+96	Bull new 24" R.C.C.P. Culv. on skew 56 ft. long, 2 - 7 ft. H.W.s.
None	N 29+10	Bull new 12" R.C.C.P. Culv. 44 ft. long, 2 - 4 ft. H.W.s. Dig inlet and outlet ditches.
None	N 29+83	Bull new 12" R.C.C.P. Culv. 44 ft. long, 2 - 4 ft. H.W.s. Dig inlet and outlet ditches.
None	N 48+00	Bull new 30" R.C.C.P. Culv. 40 ft. long, 2 - 8 ft. H.W.s.
None	NA 51+00	Bull new 24" R.C.C.P. Culv. 48 ft. long, 2 - 7 ft. H.W.s.
30" C.M.P.	NA 66+12	Bull new 48" R.C.C.P. Culv. 60 ft. long, 2 - 12 ft. H.W.s. Remove and store 30" C.M.P.
None	NA 84+50 Rt.	Ditch crossing 18" R.C.P., ft. long. No H.W.s.
18" C.M.P. 80' long	352+00 Lt.	Remove
24" R.C.C.P. 52' long	352+70 Rt.	Remove
18" C.M.P. 90' long	353+50 Rt.	Remove
18" C.M.P. 40' long	421+23 C.L. Mail	Remove

Lacy Feltman


Fed Rd Div. No.	State	Fed Aid Proj. No.	COUNTY	Sheet No.	Total Sheets
	N.Y.		MADISON	63	67

MOHAWK THRUWAY
NORTH CHITTENANGO - CANASTOTA
RELOCATED TOWN ROAD 'N' LINE

Scale 1" = 50'

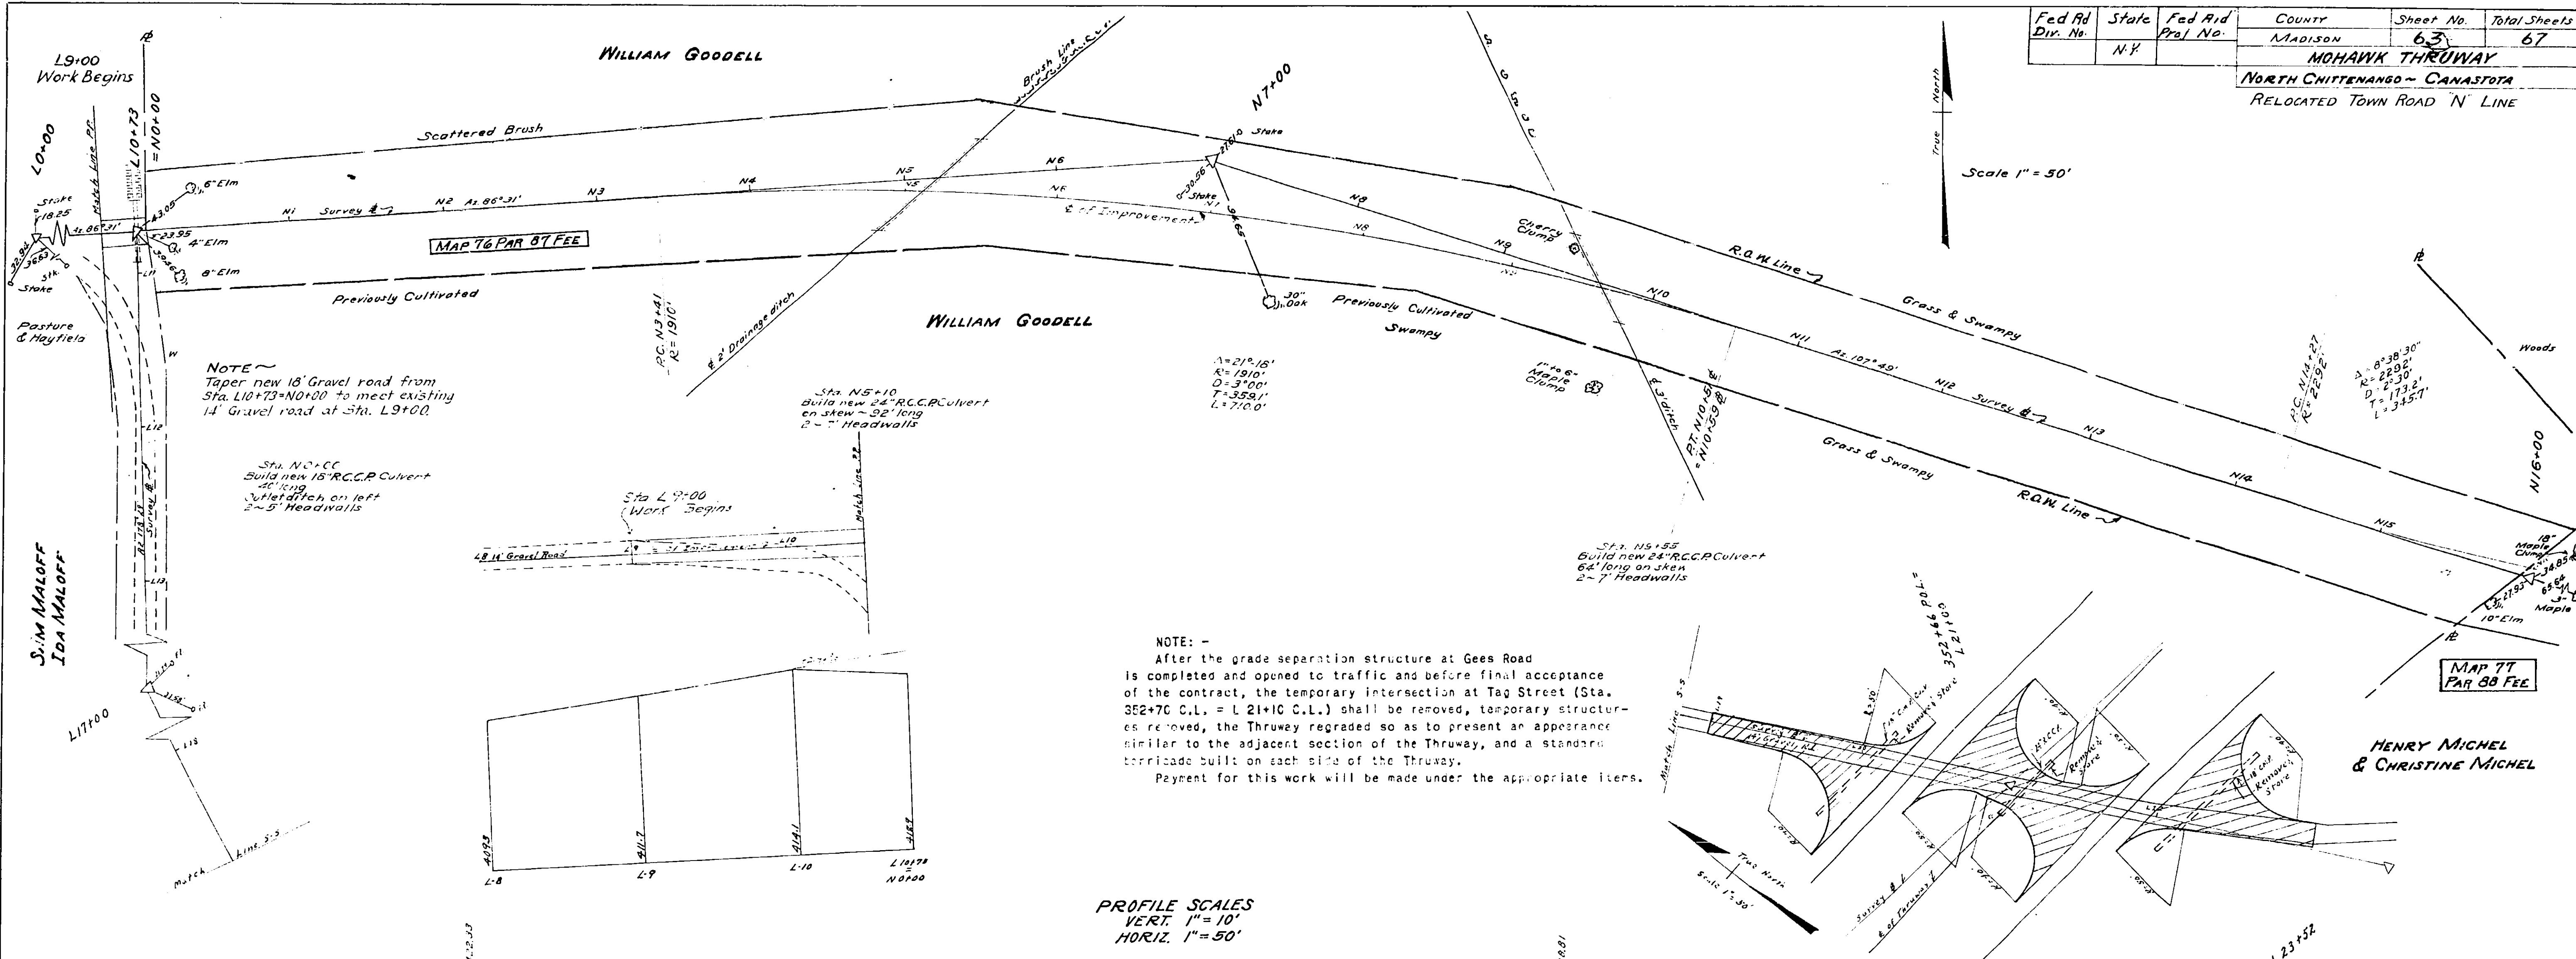

PROFILE SCALES
VERT. 1" = 10'
HORIZ. 1" = 50'

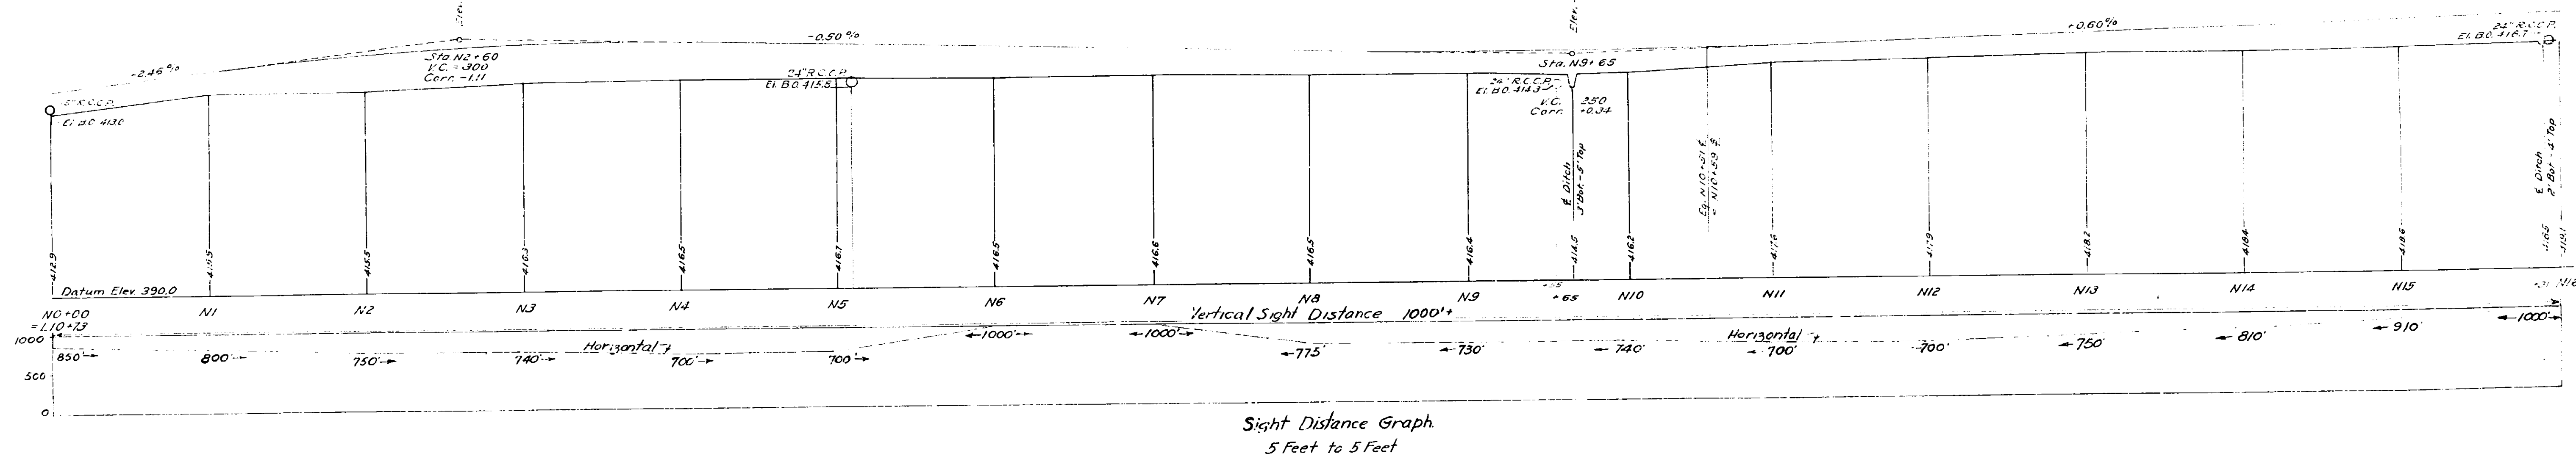


Made by Traced by Checked by
PLAN J. J. Ryan H. Kell J. E. White and J. B. Chase
PROFILE J. J. Ryan H. Kell J. E. White and J. B. Chase

Prepared pursuant to the Highway Law & recommended by:
Ray Kethum
ENGINEER, DISTRICT No. 2
Date


Fed Rd Div. No.	State	Fed Rd Proj. No.	COUNTY	Sheet No.	Total Sheets
	N.Y.		MADISON	63	67
MADONNA THRUWAY					
NORTH CHITTENANGO - CANASTOTA					
RELOCATED TOWN ROAD 'N' LINE					

Scale 1" = 50'

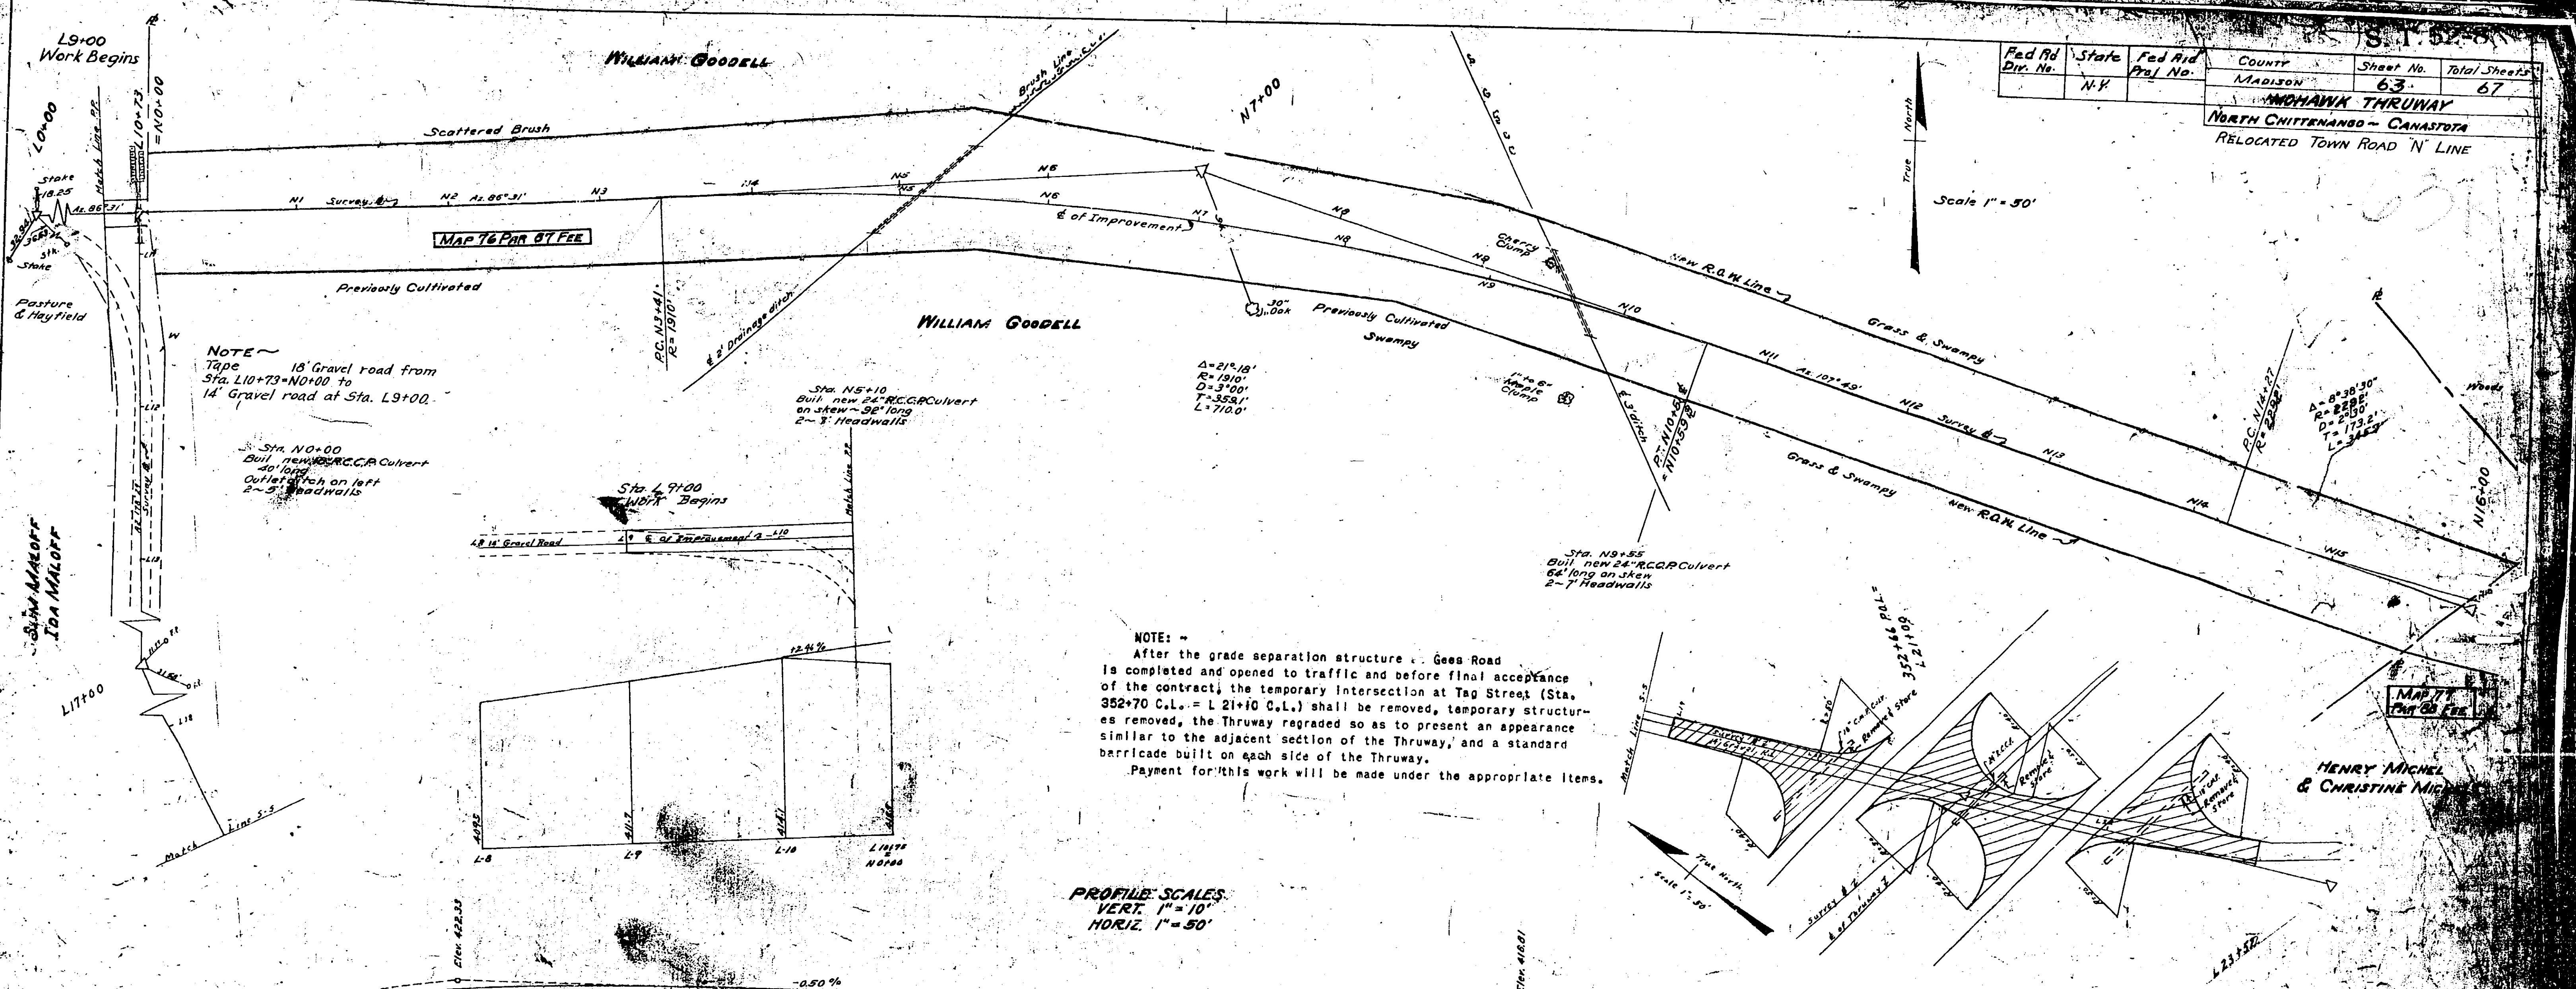

NOTE: -
 After the grade separation structure on Gees Road is completed and opened to traffic and before final acceptance of the contract, the temporary intersection at Tag Street (Sta. 352+70 C.L. = L 21+10 C.L.) shall be removed, temporary structures removed, the Thruway regraded so as to present an appearance similar to the adjacent section of the Thruway, and a standard barricade built on each side of the Thruway.
 Payment for this work will be made under the appropriate items.

PROFILE SCALES
 VERT. 1" = 10'
 HORIZ. 1" = 50'


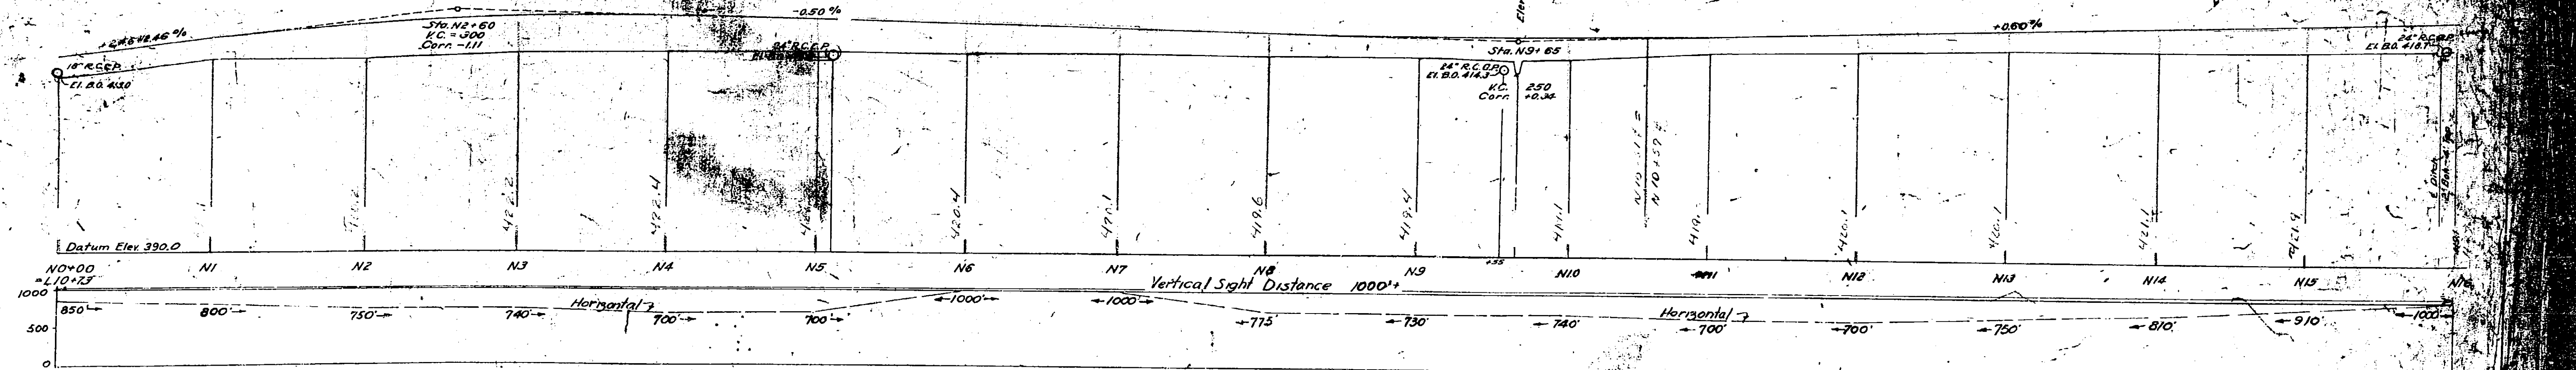


Sight Distance Graph
 5 Feet to 8 Feet

Made by: Traced by: Checked by:
 PLAN: Traced by: Checked by:
 PROFILE: Traced by: Checked by:

Prepared pursuant to the Highway Law & recommended by:
 Date: 10/1/57
 ENGINEER: Robert Kellum
 DISTRICT NO. 1

Fed Rd Div. No.	State	Fed Aid Proj. No.	COUNTY	Sheet No.	Total Sheets
	N.Y.		MADISON	64	67
MOHAWK THRUWAY					
NORTH CHITTENANGO ~ CANASTOTA					
RELOCATED TOWN ROAD "N" LINE					

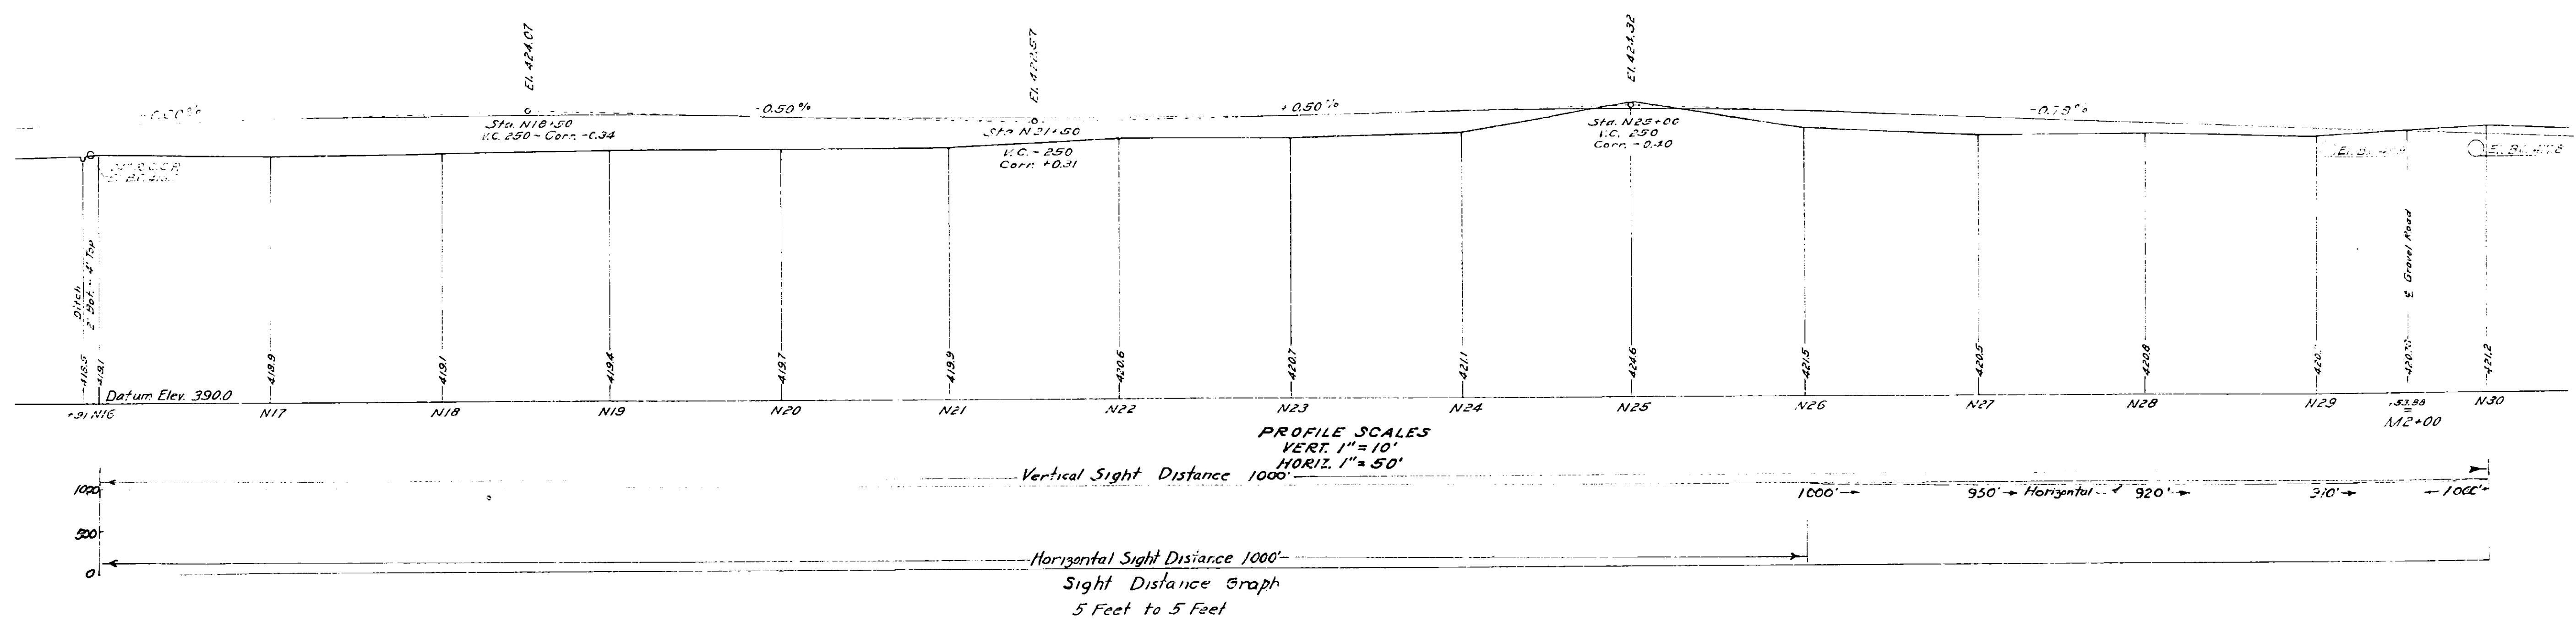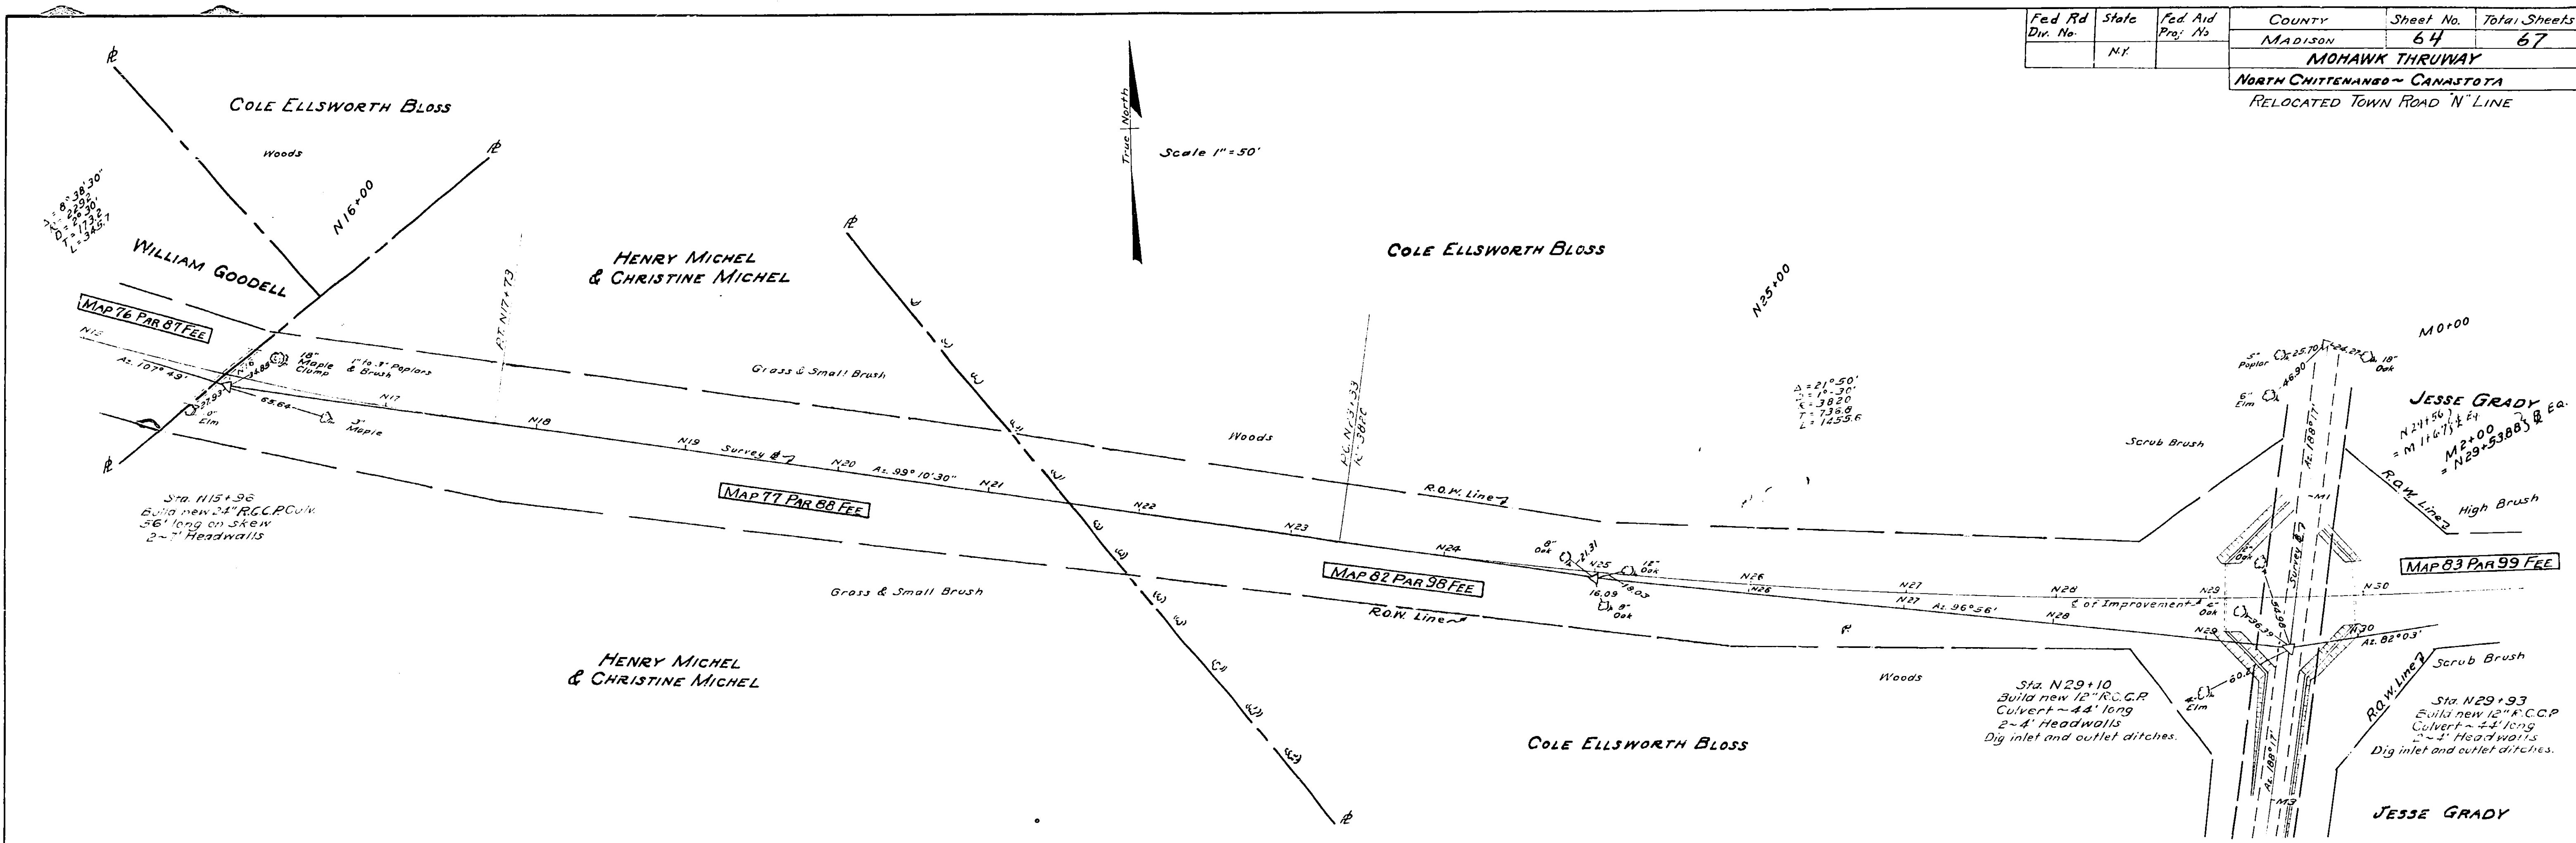



Made by Traced by Checked by
PLAN J. J. Hill 2.2.31 Hill and McLean
PROFILE J. J. Hill 2.2.31 Hill and McLean

Prepared pursuant to the Highway Law & recommendations of
Date 2.2.31
ENGINEER DISTRICT NO. 6

S. 1152-8

Fed. Rd. Dir. No.	State	Fed. Aid Proj. No.	COUNTY	Sheet No.	Total Sheets
	NK		MADISON	64	67
MONAWK THRUWAY					
NORTH CHITTENANGO - CANASTOTA					
RELOCATED TOWN ROAD 'N' LINE					



4R

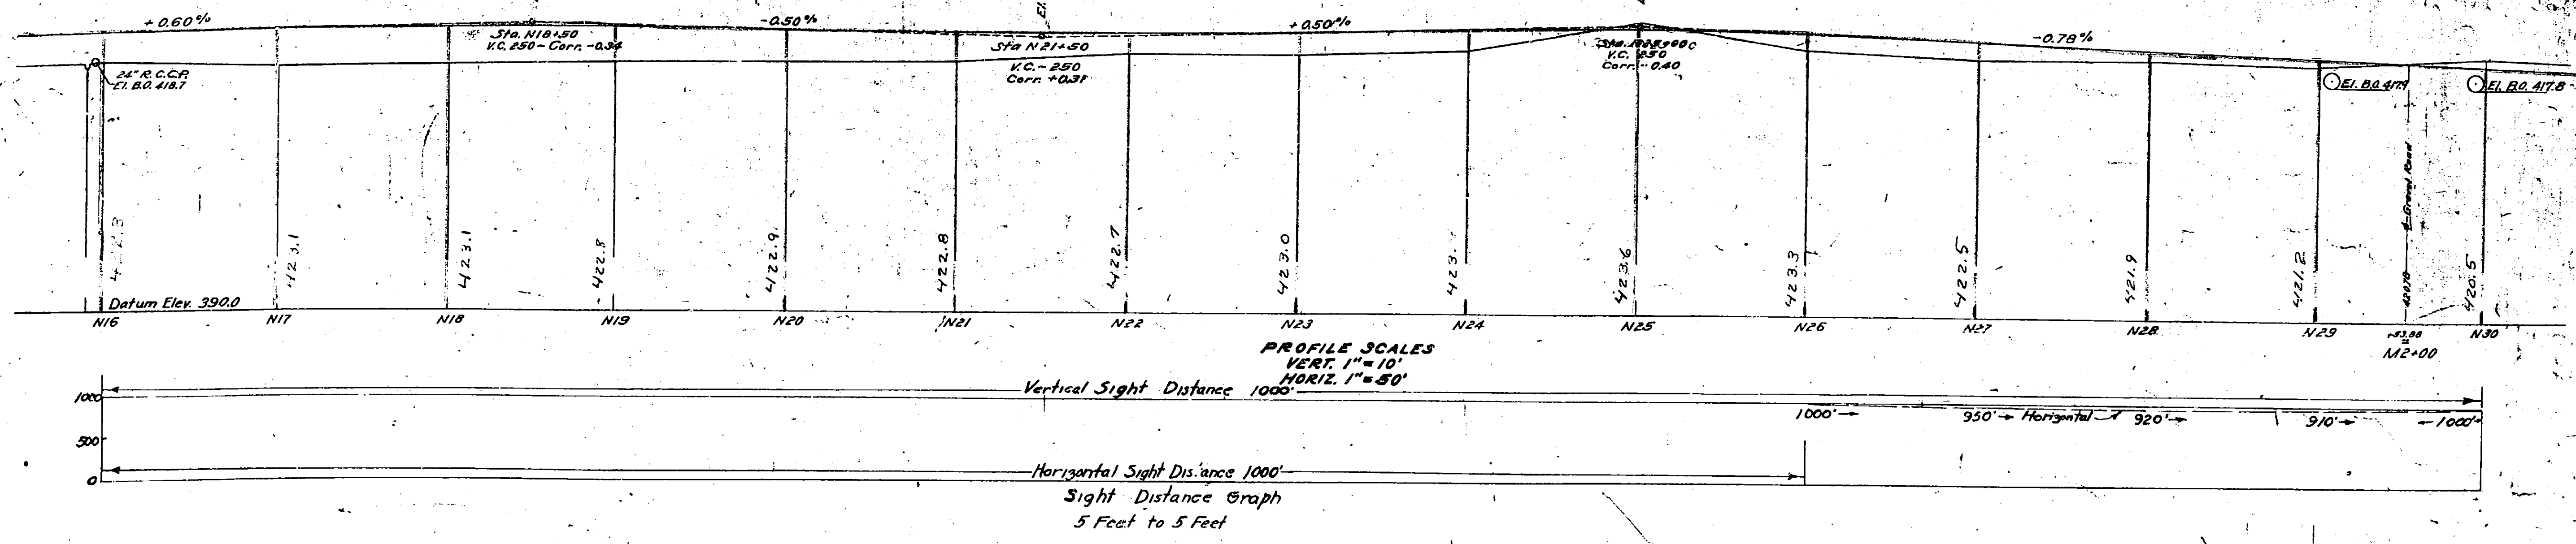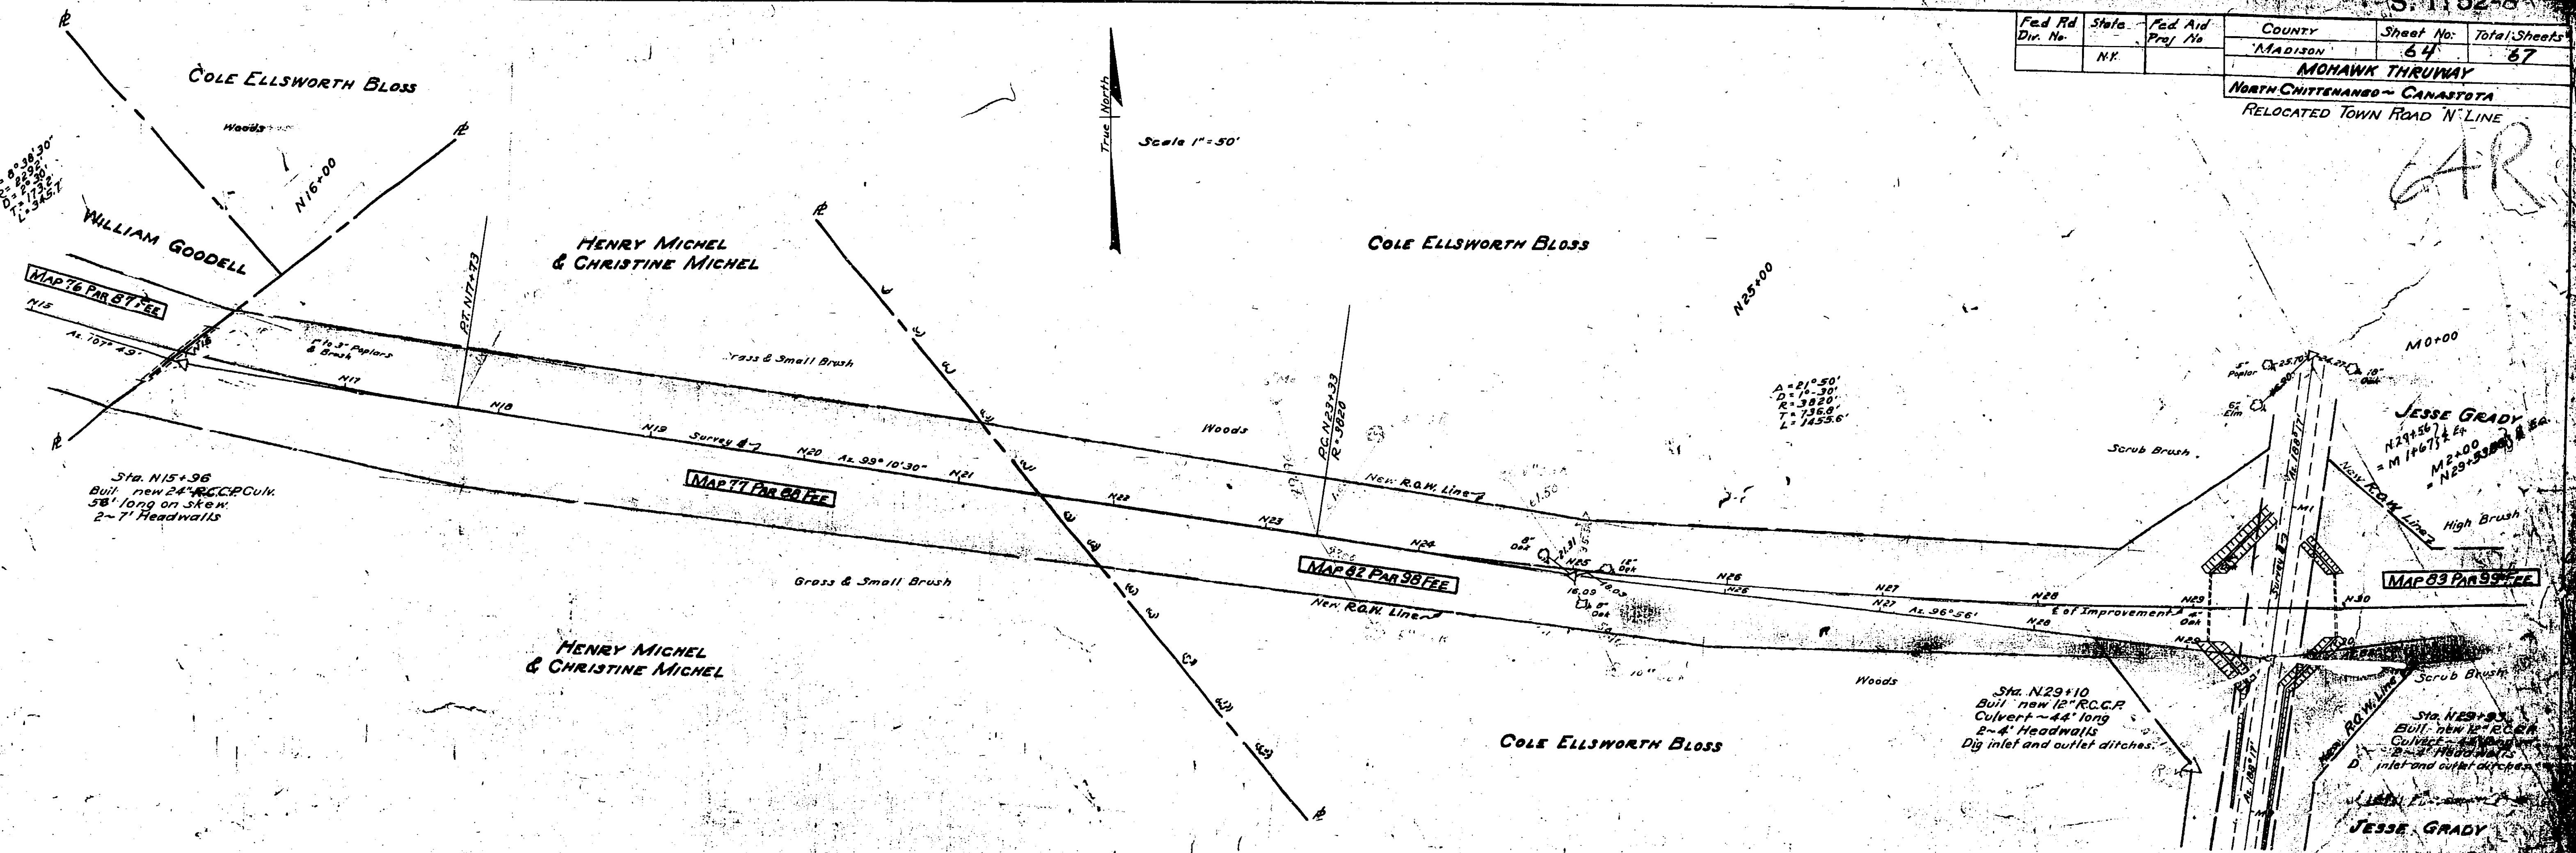

Made by Traced by Checked by
 PLAN J. J. [Signature] K. F. [Signature] J. J. [Signature] and M. D. [Signature]
 PROFILE J. J. [Signature] K. F. [Signature] J. J. [Signature] and M. D. [Signature]

Prepared pursuant to the Highway Law & recommended by:
 Date _____ Engineer, District No. 2



Fed. Rd. Div. No.	State	Fed. Aid Proj. No.	County	Sheet No.	Total Sheets
	N.Y.		MADISON	65	67
MOHAWK THRUWAY					
NORTH CHITTENANGO - CANASTOTA					
RELOCATED TOWN ROAD "N" LINE					

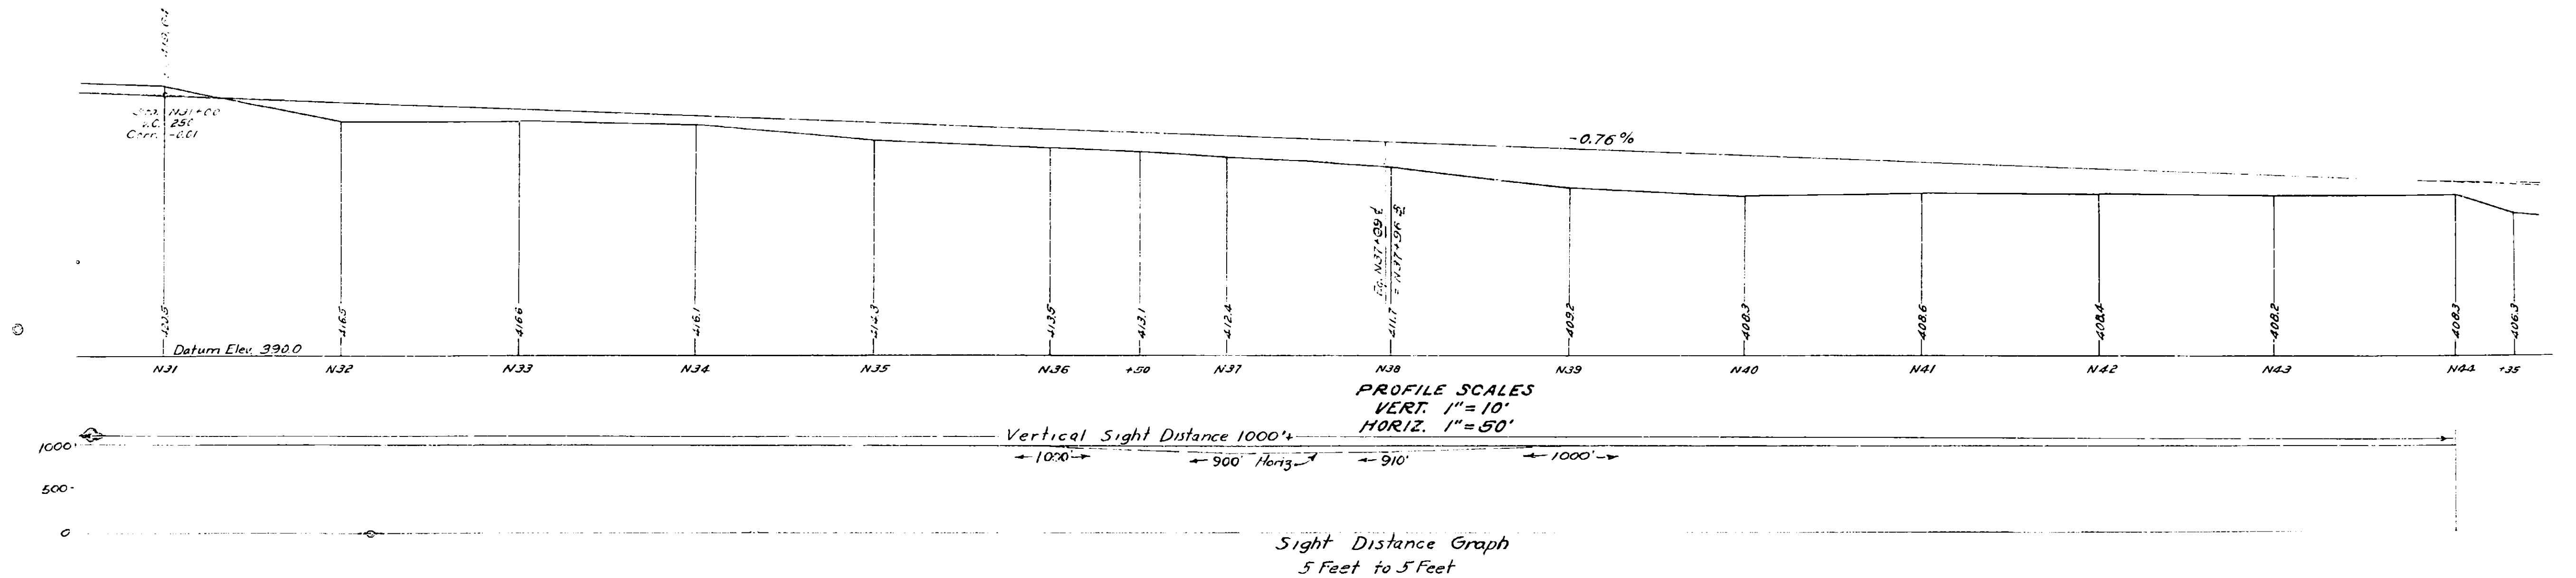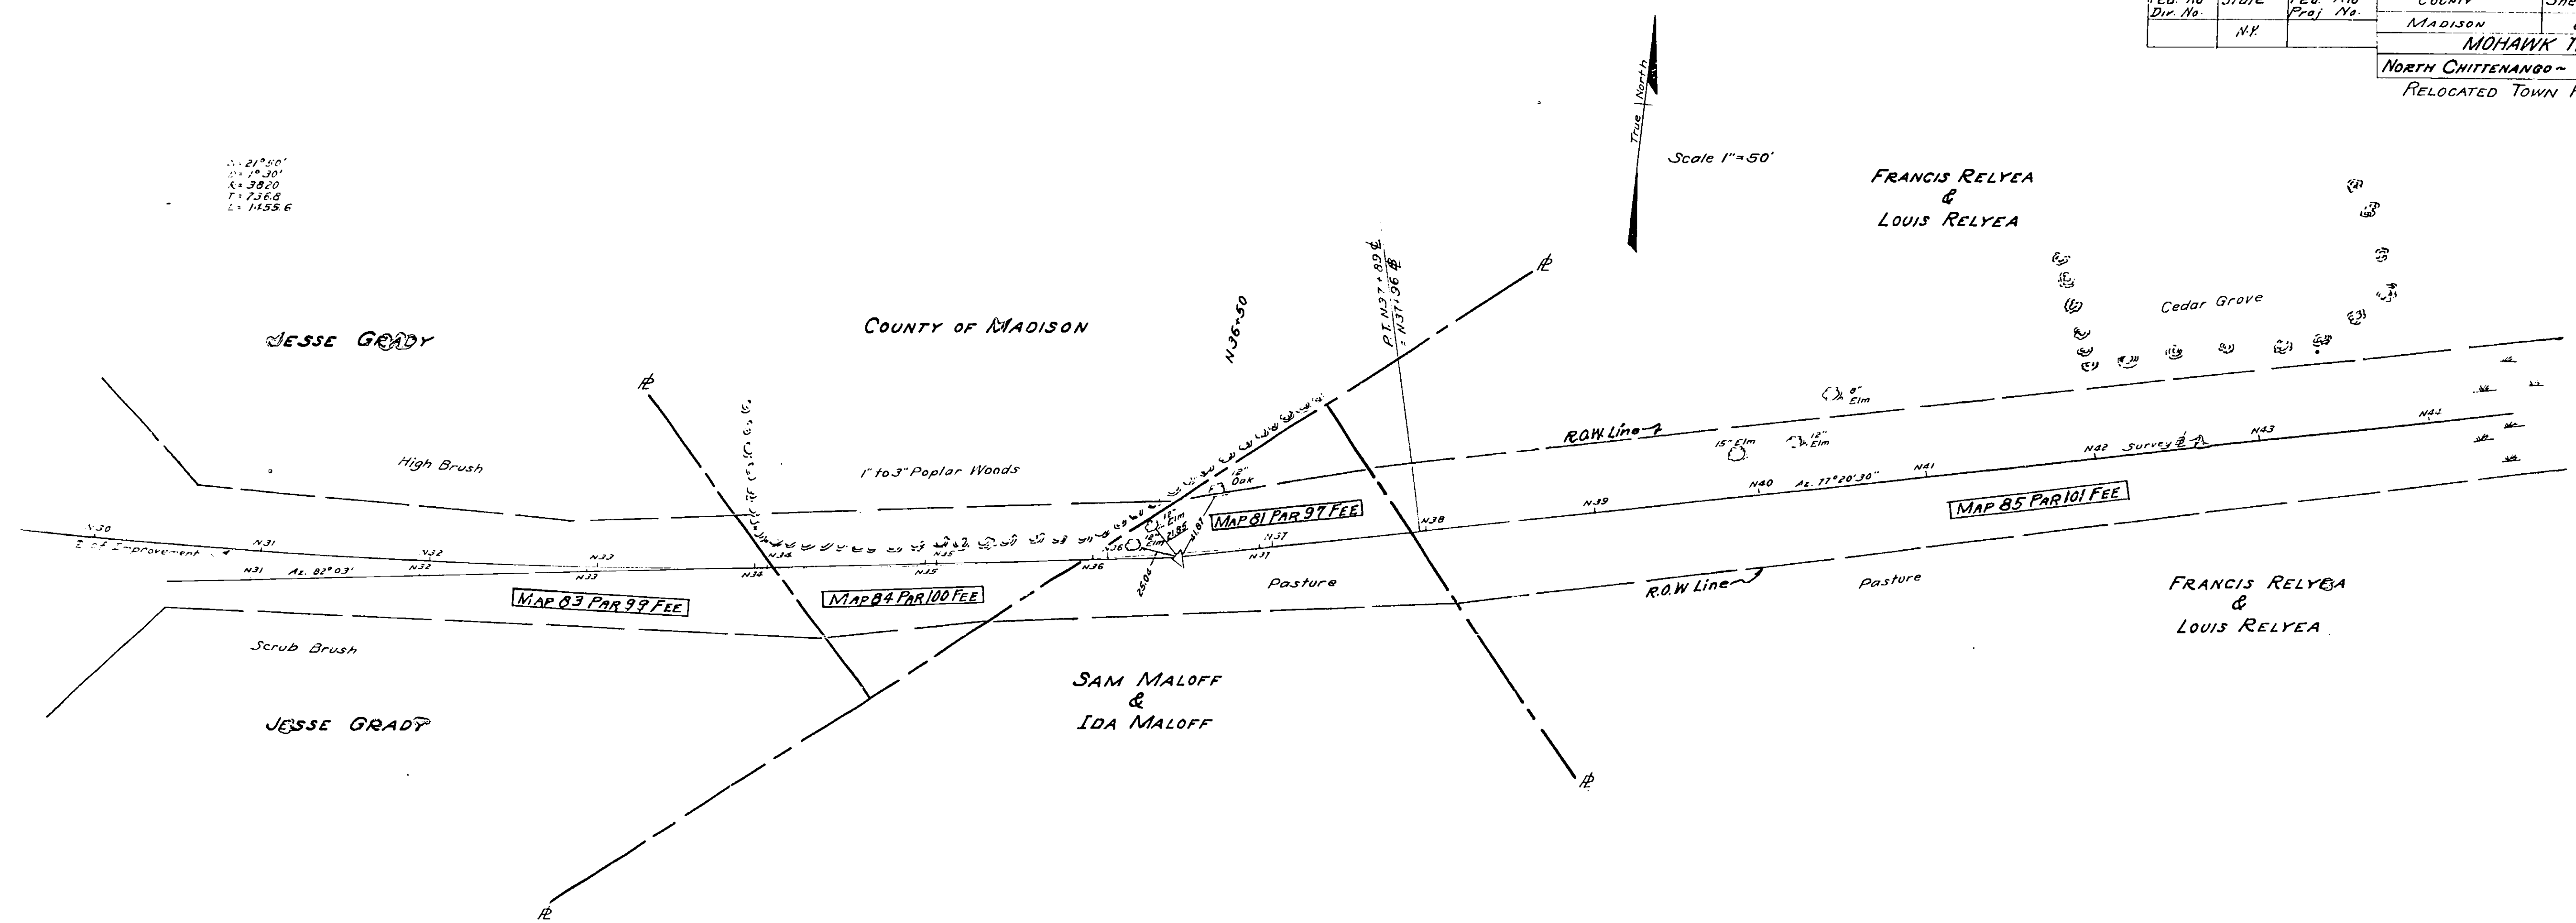

Fed. Rd. Dir. No.	State	Fed. Aid Proj. No.	County	Sheet No.	Total Sheets
	N.Y.		MADISON	65	67
MOHAWK THRUWAY					
NORTH CHITTENANGO - CANASTOTA					
RELOCATED TOWN ROAD 'N' LINE					

$\Delta = 21^{\circ}50'$
 $D = 1^{\circ}30'$
 $R = 3820$
 $T = 736.9$
 $L = 3455.6$


Scale 1"=50'

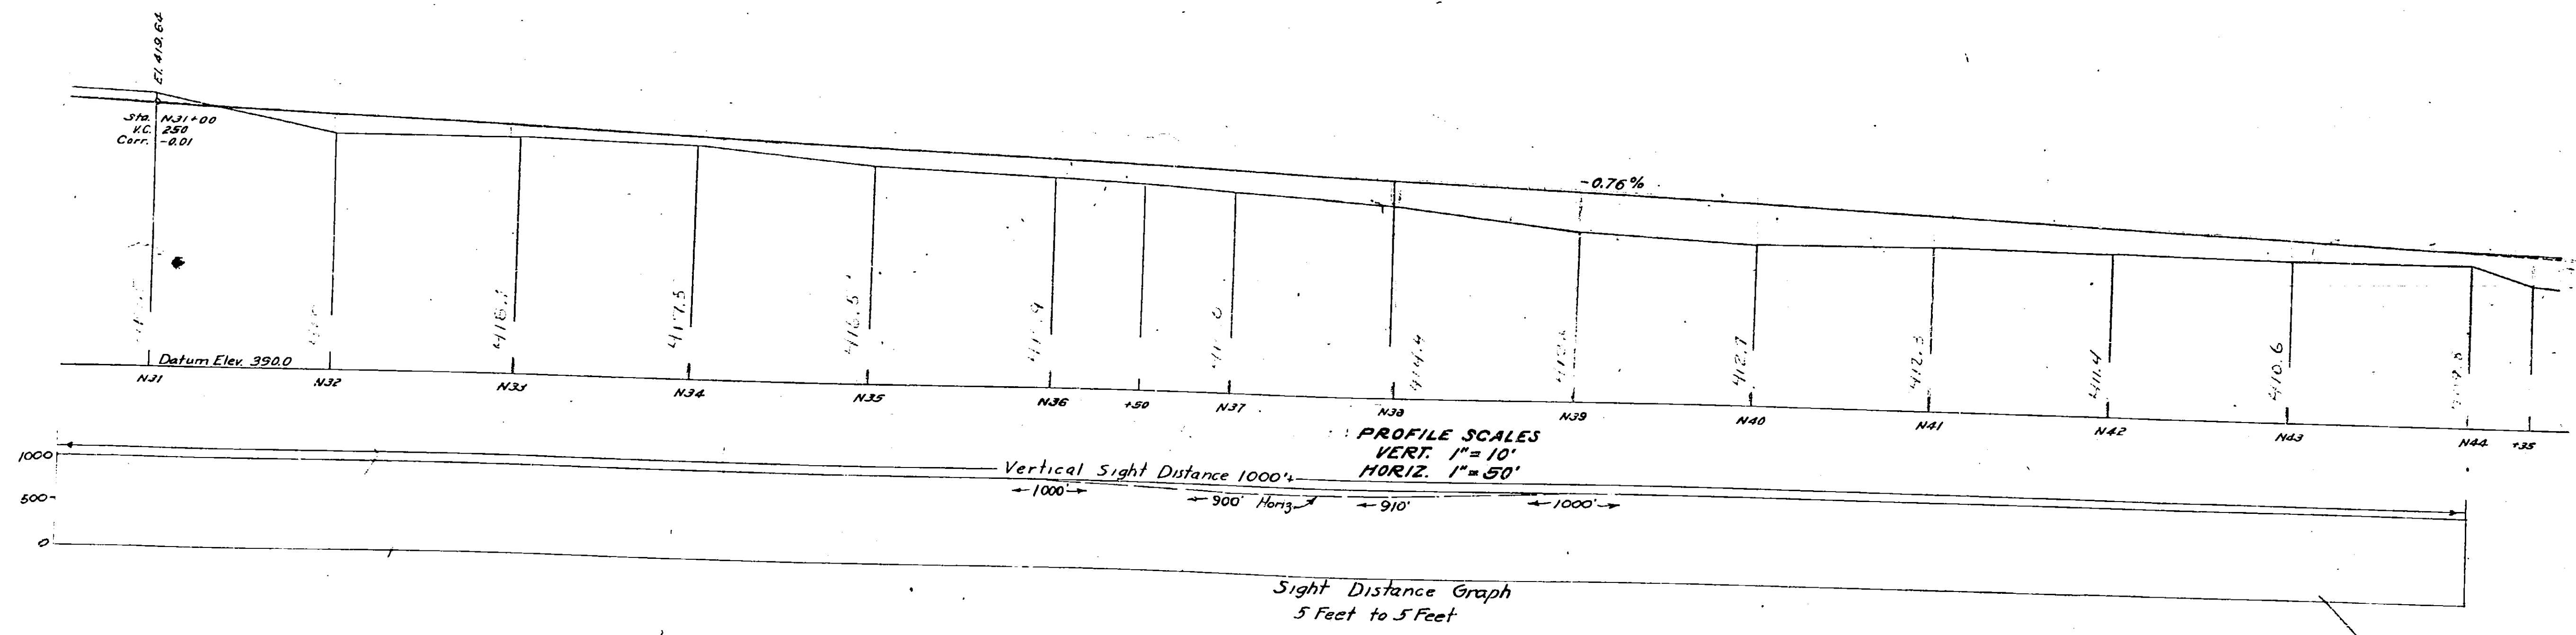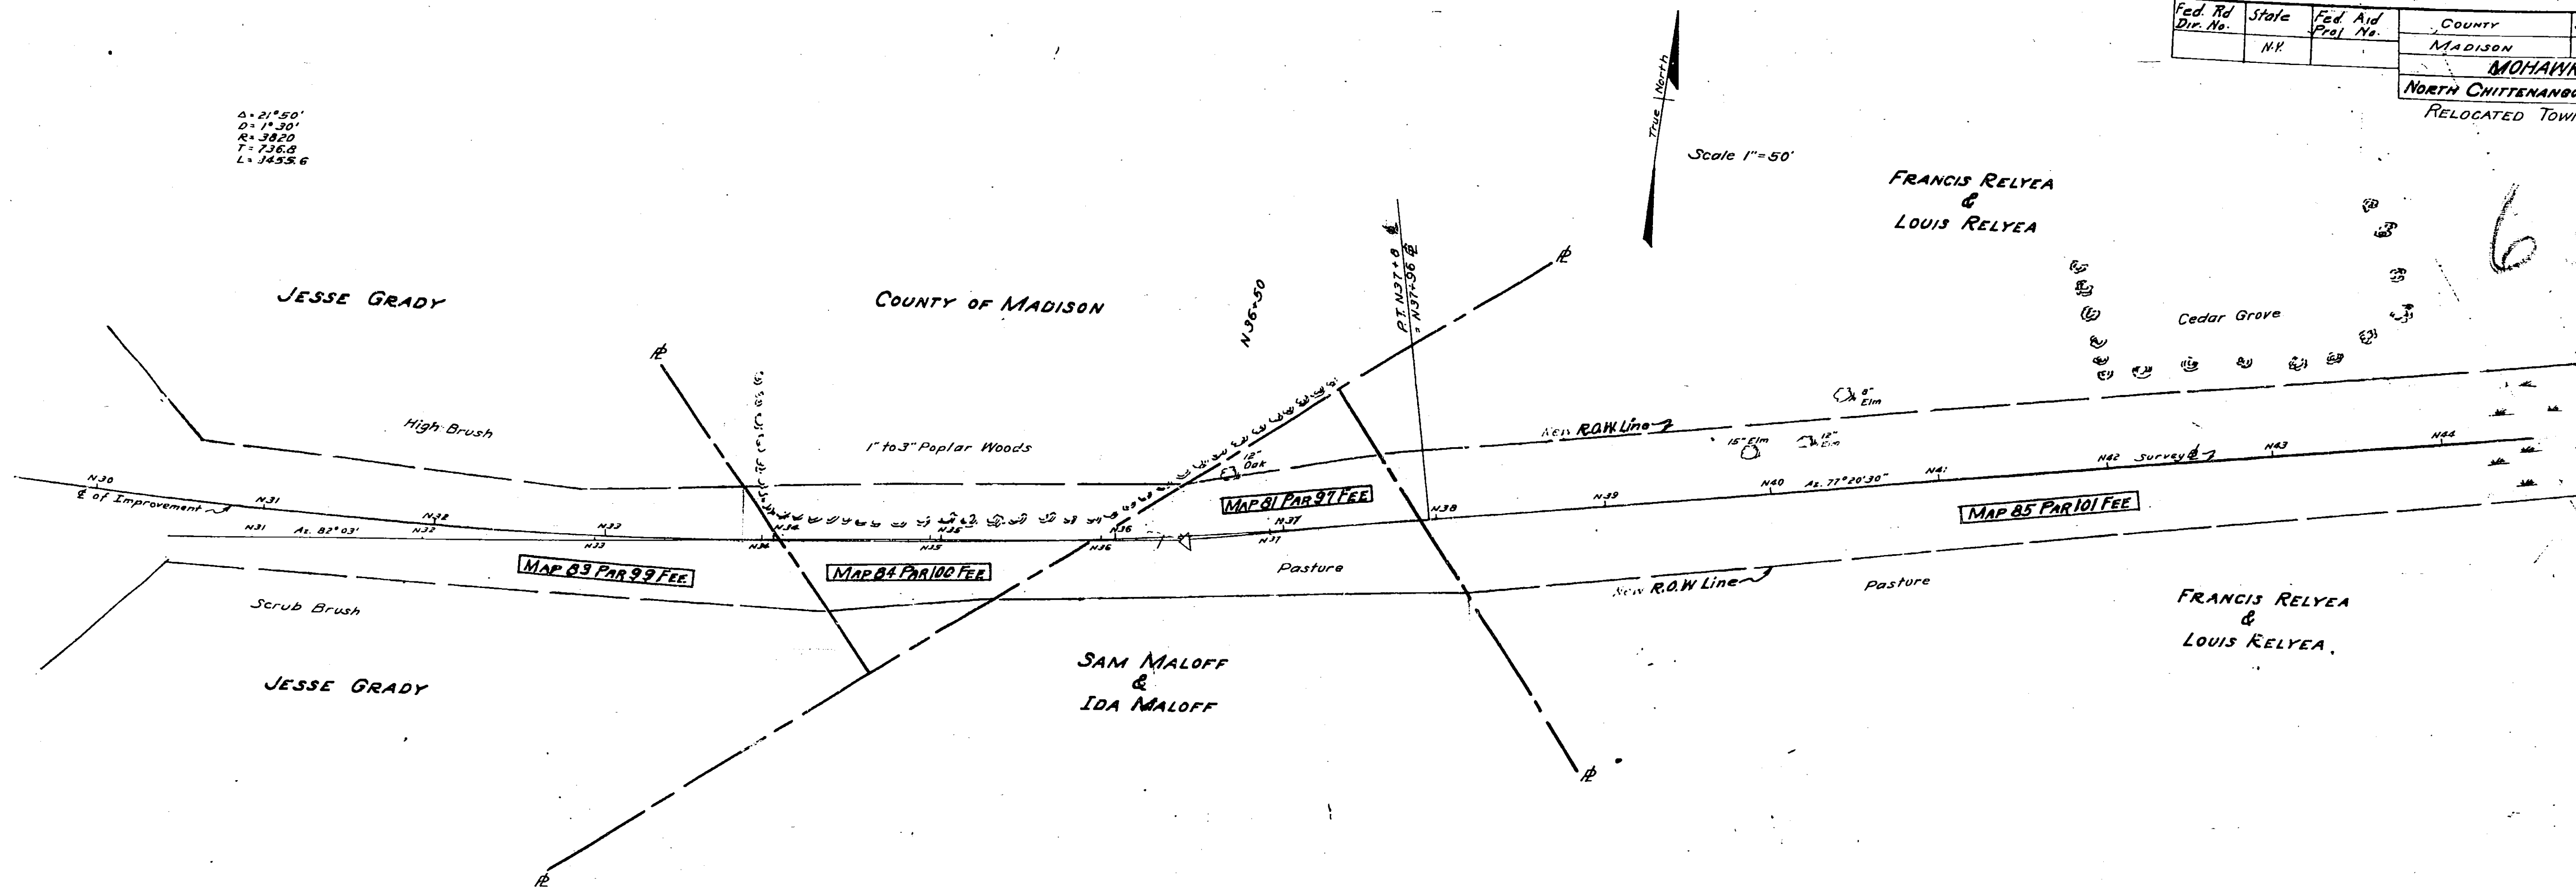

Made by H. H. H. Traced by H. H. H. Checked by H. H. H.
PLAN H. H. H.
PROFILE H. H. H.

Prepared pursuant to the Highway Law & recommended by:
Harry H. H.
ENGINEER DISTRICT No. 2
Date _____

Fed Rd Dir. No.	State	Fed Rd Proj. No.	County	Sheet No.	Total Sheets
	NY		MADISON	66	67
MOHAWK THRUWAY					
NORTH CHITTENANGO - CANASTOTA					
RELOCATED TOWN ROAD 'N' & 'NA' LINES					

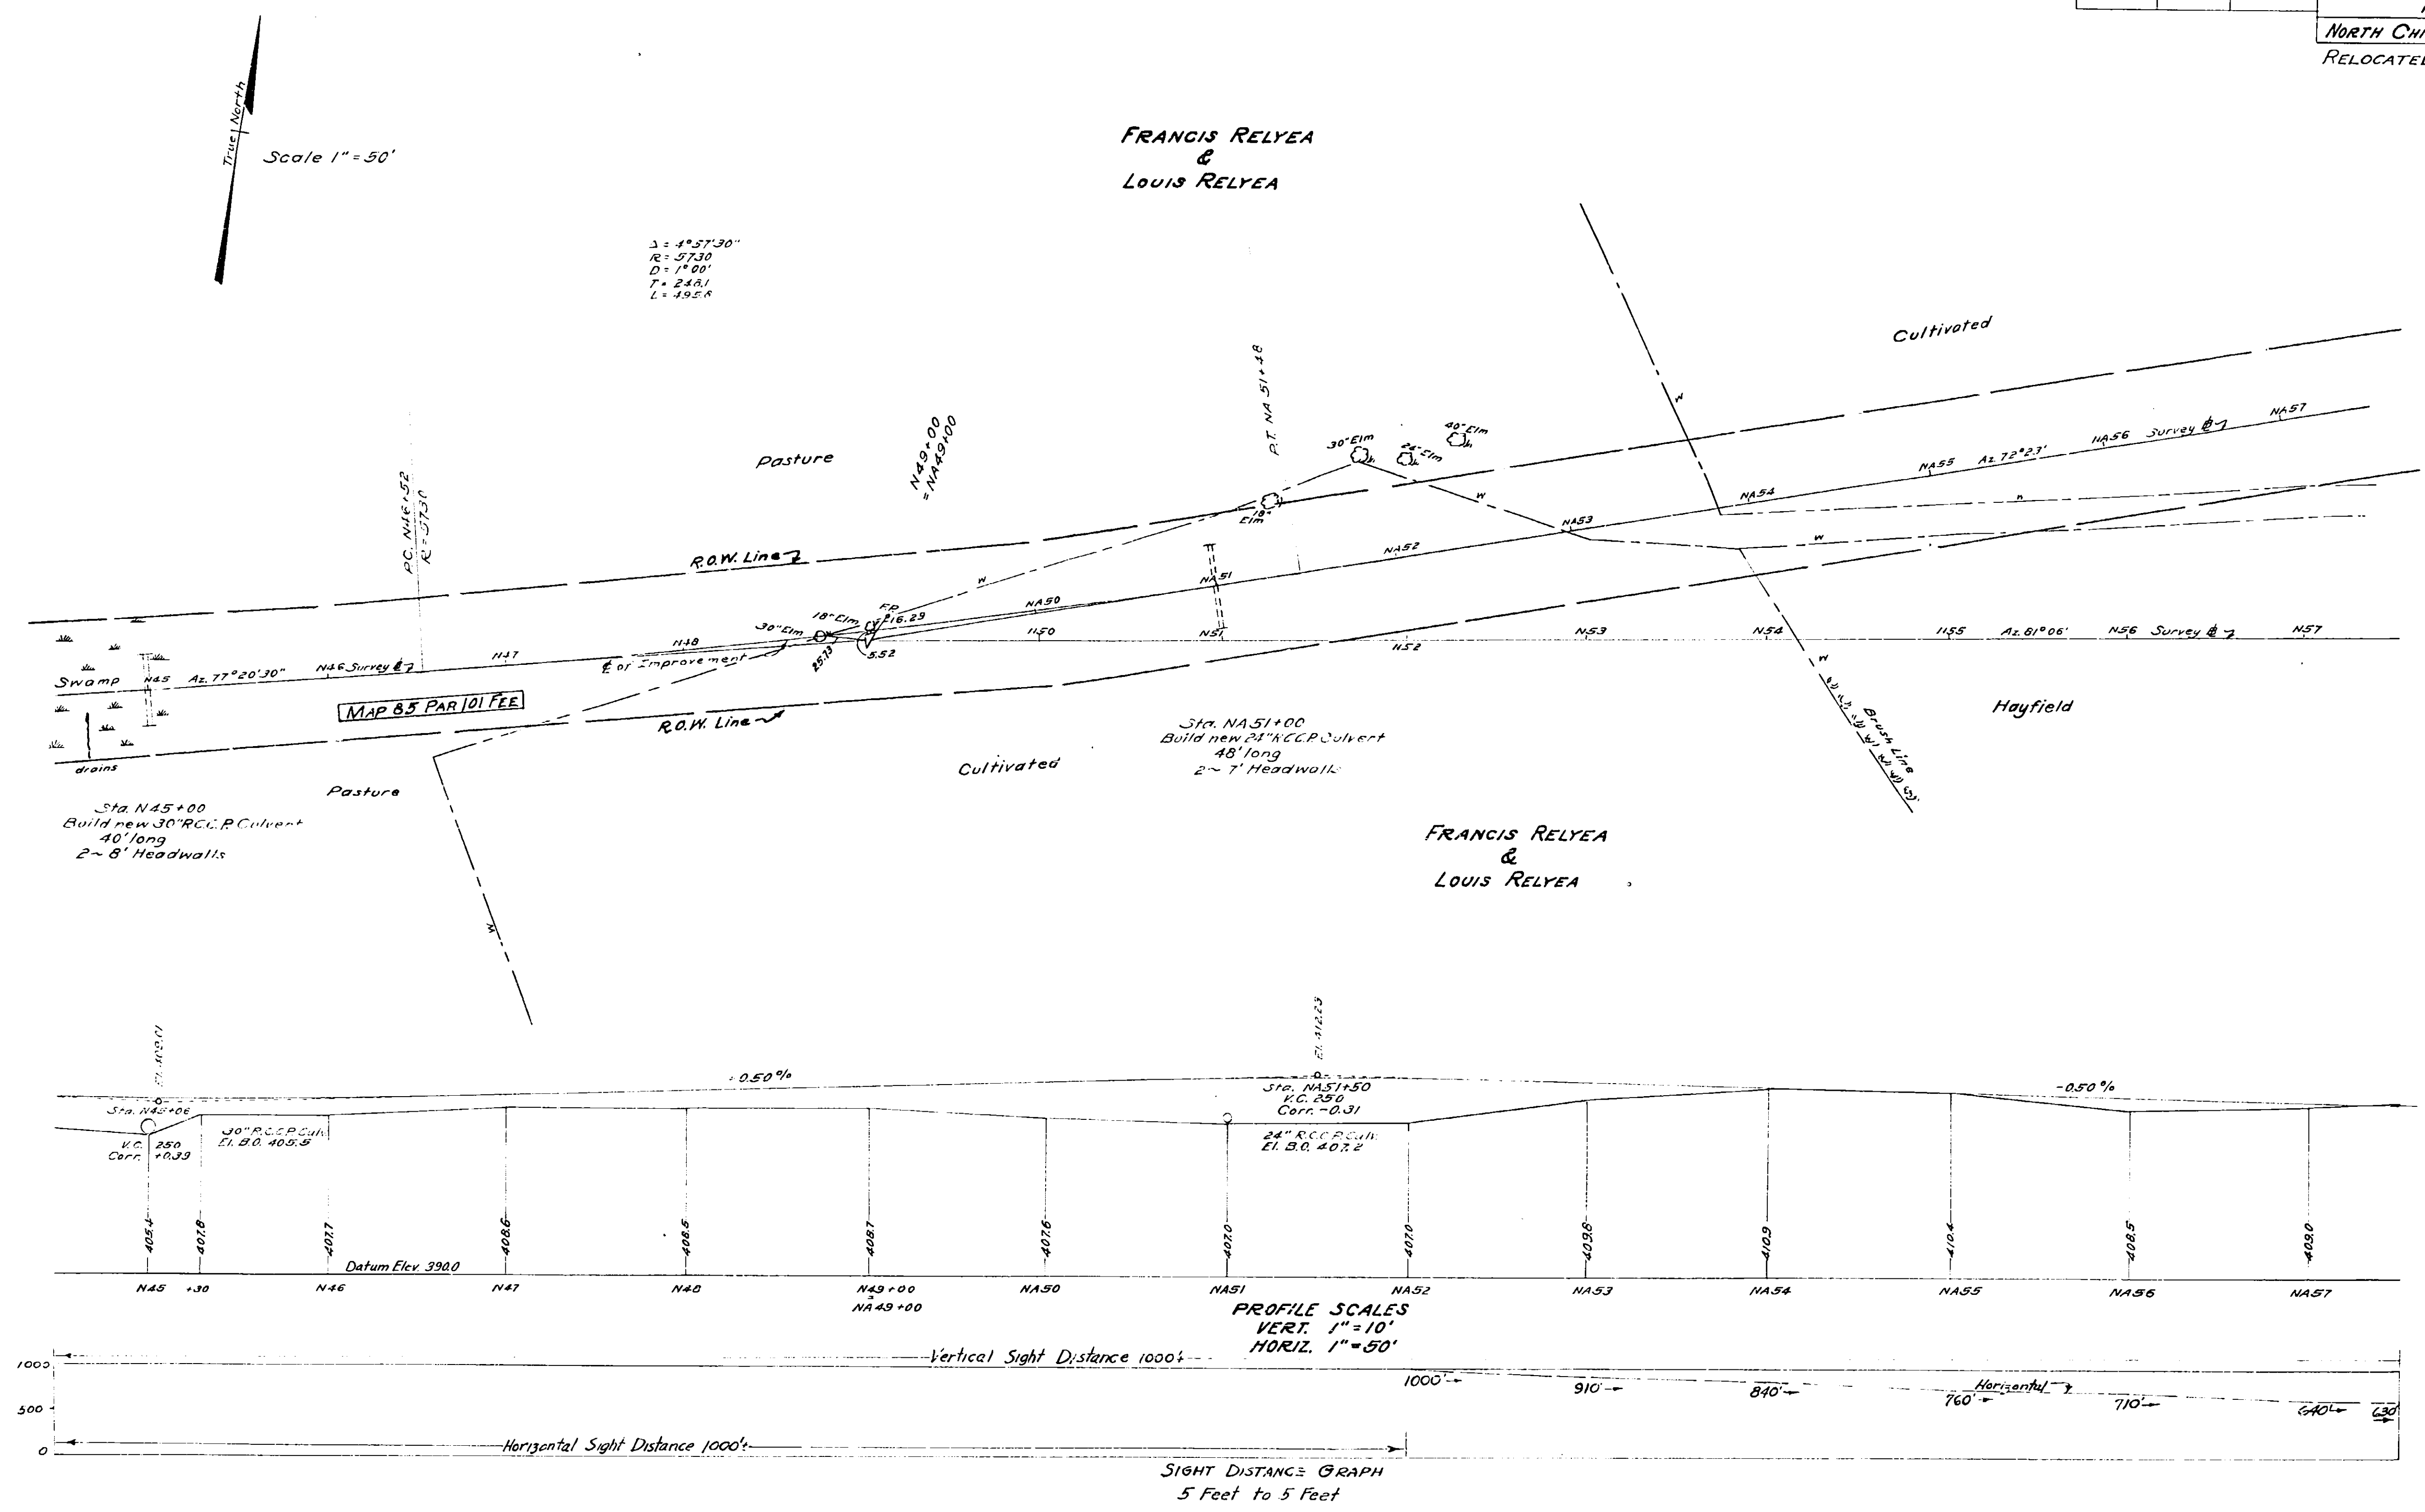

Made by Traced by Checked by

PLAN *[Signature]* K.F. Hill 7.8.2016 and 2016

PROFILE *[Signature]* K.L. Hill 7.8.2016 and 2016



Prepared pursuant to the Highway Law & recommended by:-

[Signature]

Date *[Signature]* ENGINEER DISTRICT No. 2

Fed. Rd. Div. No.	State	Fed. Rd. Proj. No.	County	Sheet No.	Total Sheets
	NY		MADISON	66	67
NEOHAWK THRUWAY					
NORTH CHITTENANGO - CANASTOTA					
RELOCATED TOWN ROAD 'N' & 'NA' LINES					

66R

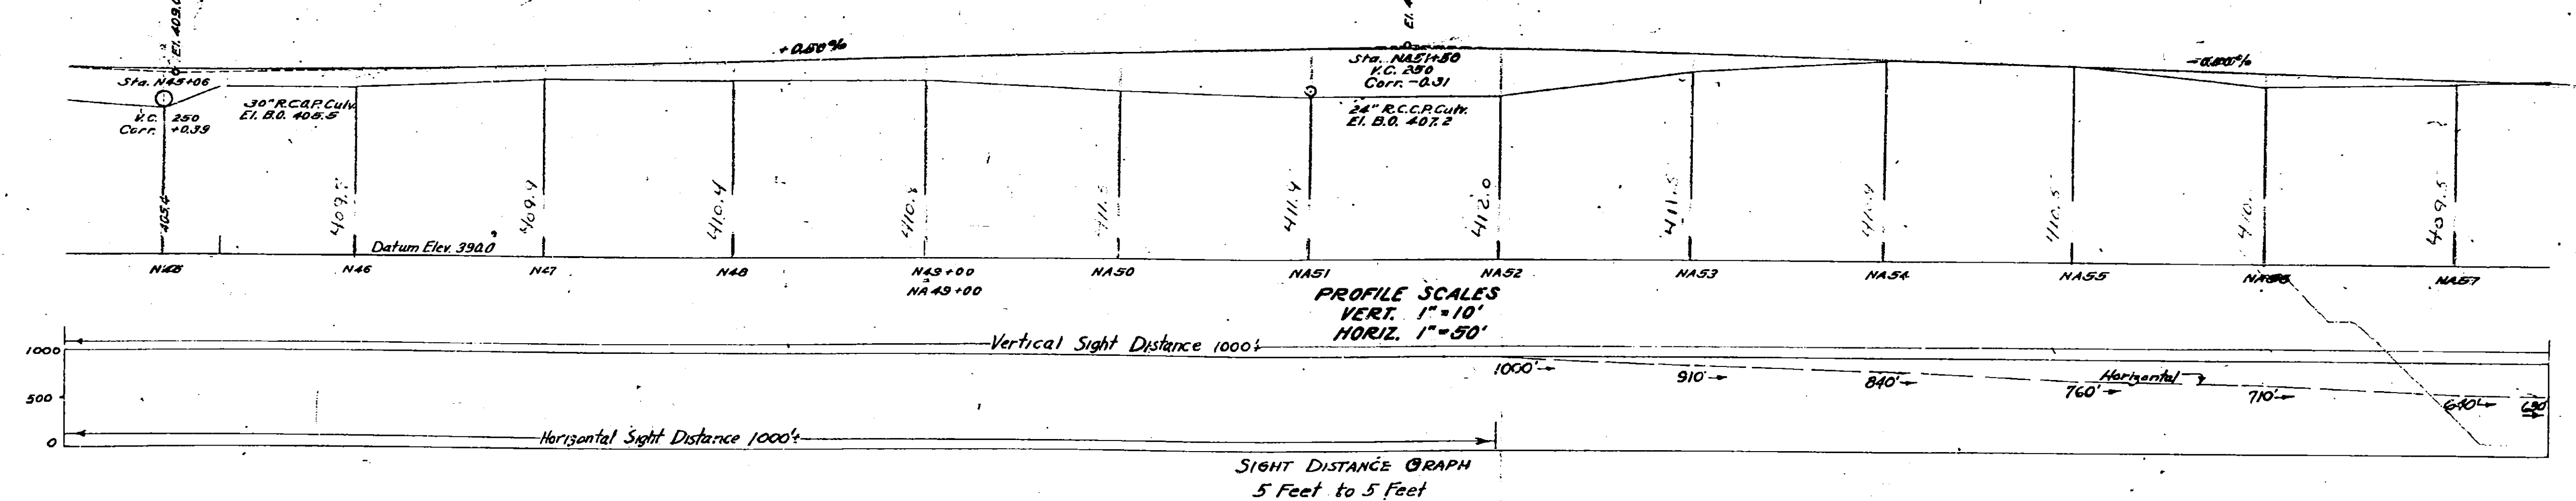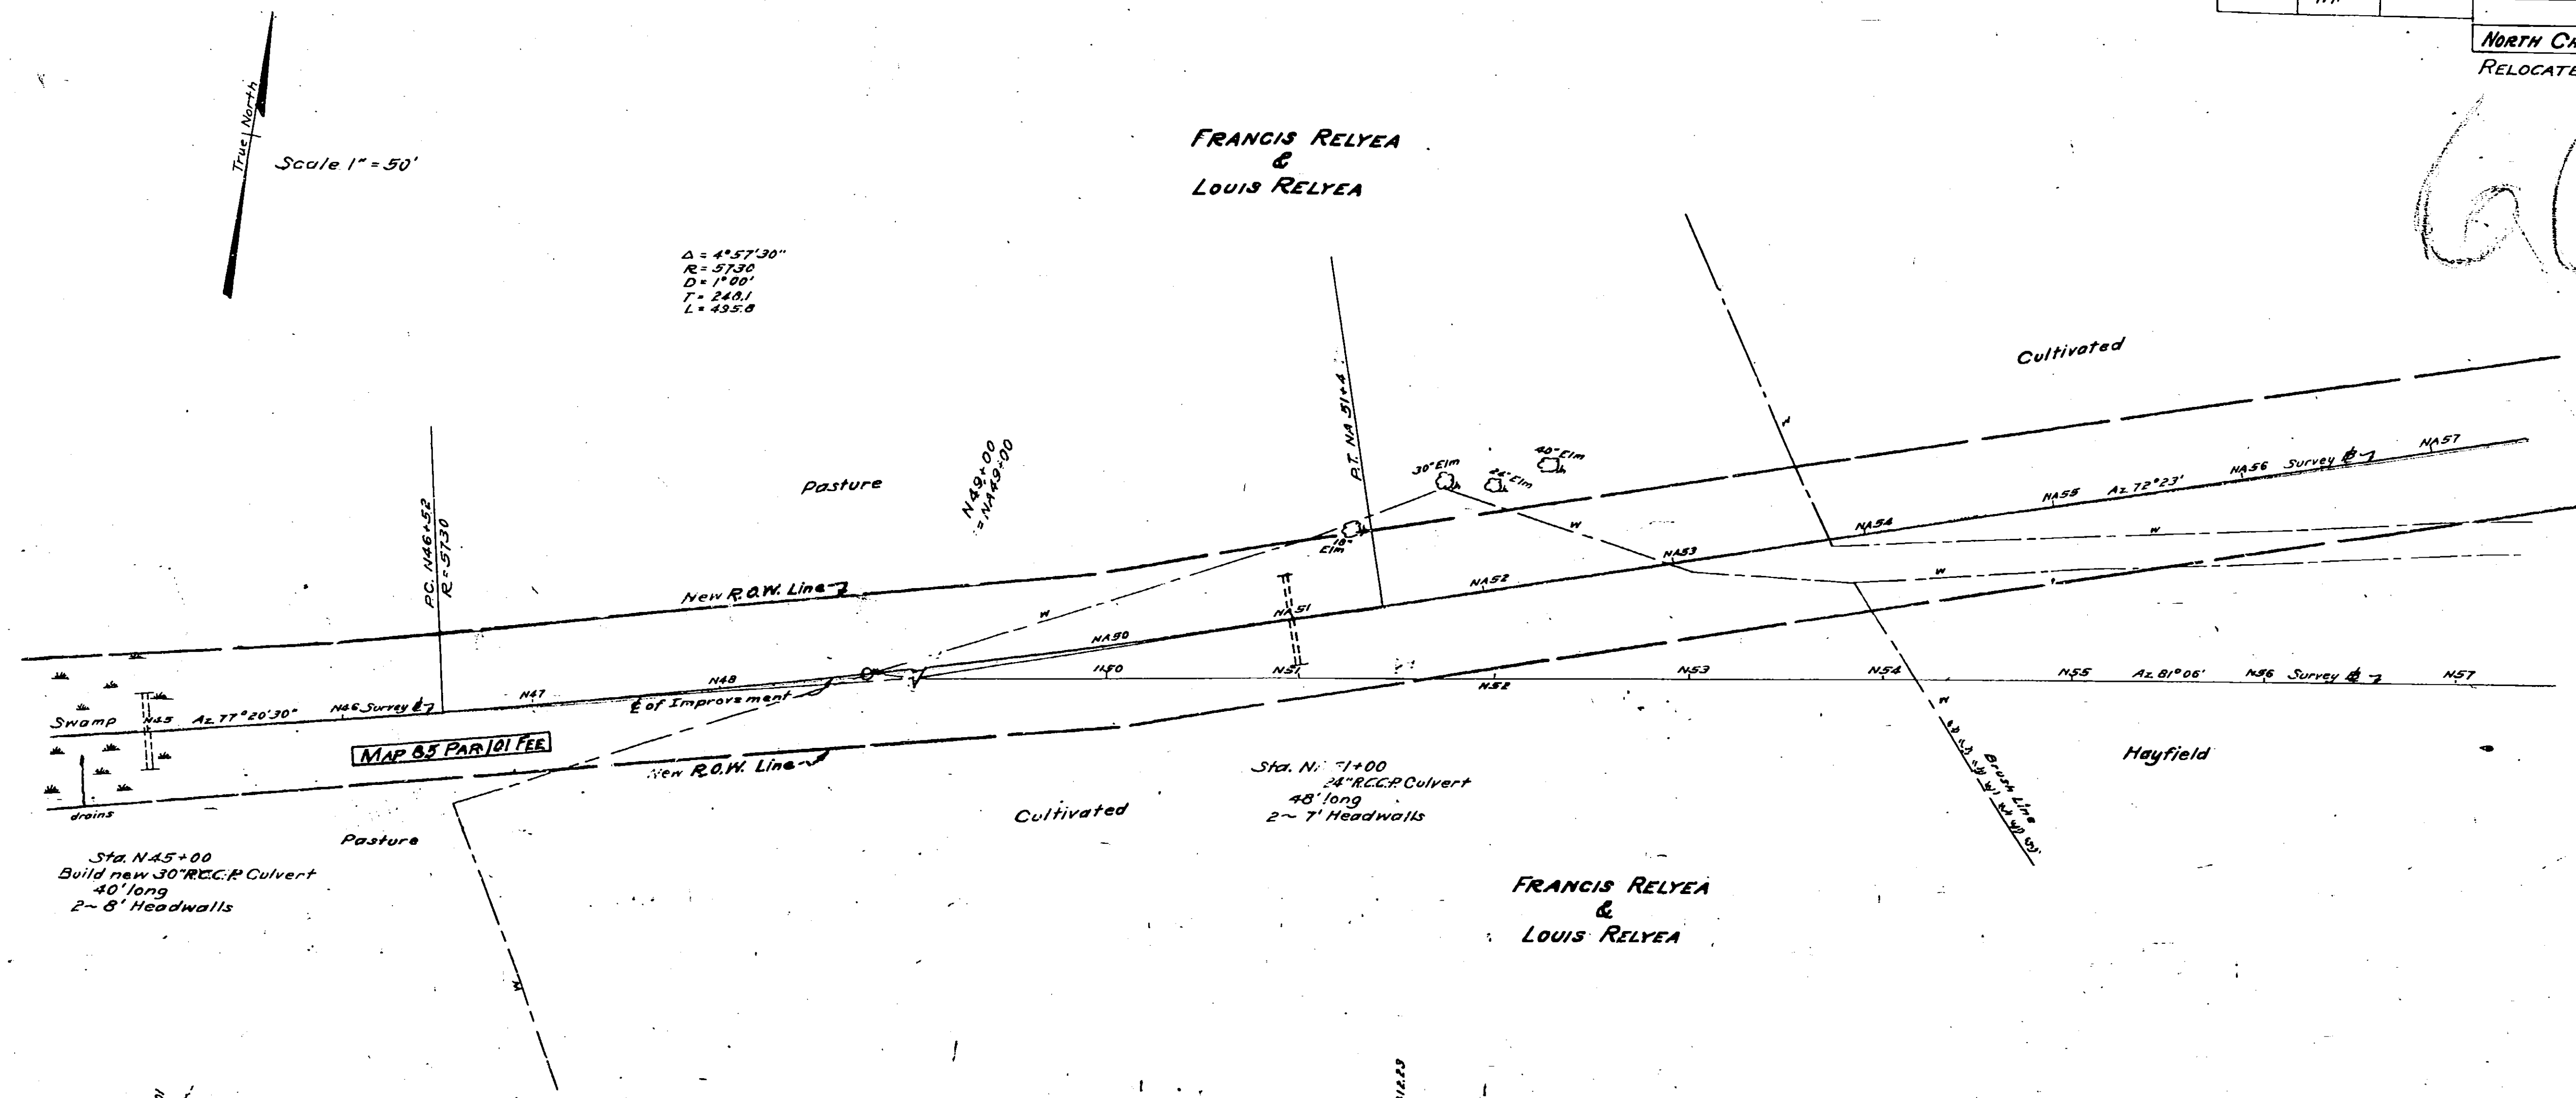

Made by Traced by Checked by



PLAN H. Relyea K.F. Neil R. White and P. McLean

PROFILE H. Relyea K.F. Neil R. White and P. McLean

Prepared pursuant to the Highway Law & recommended by:

Date Harry Kitchum
ENGINEER, DISTRICT NO. 2

Fed Rd Div No.	State	Fed Aid Proj No.	County	Sheet No.	Total Sheets
	N.Y.		MADISON	67	67
MOHAWK THRUWAY					
NORTH CHITTENANGO ~ CANASTOTA					
RELOCATED TOWN ROAD "NA" LINE					

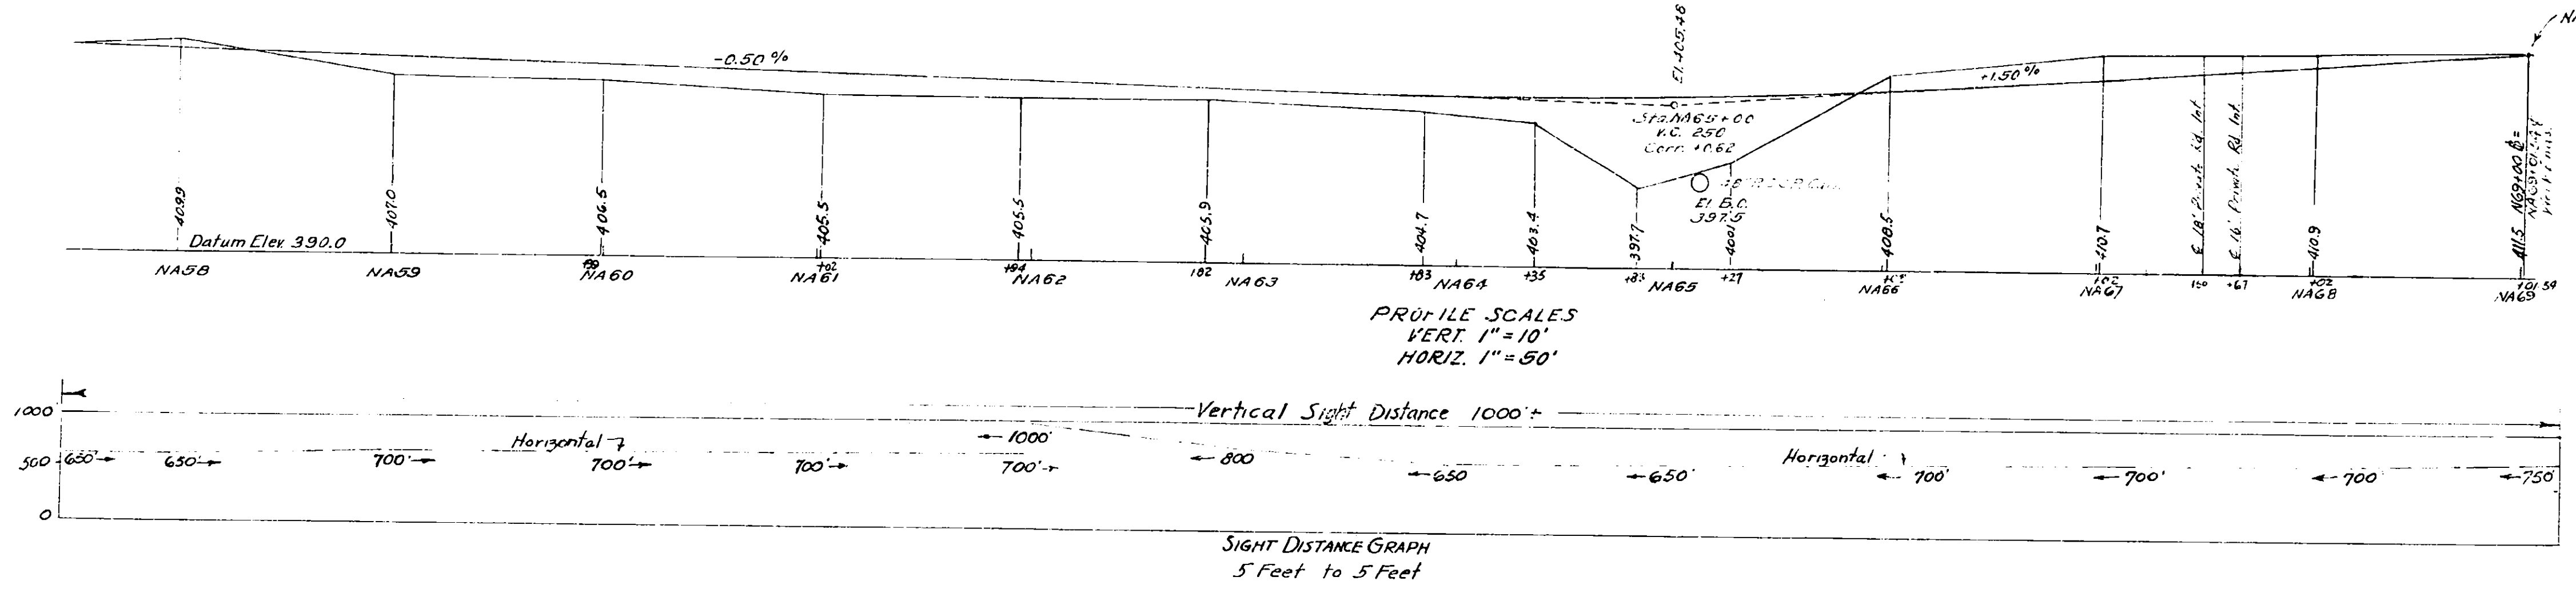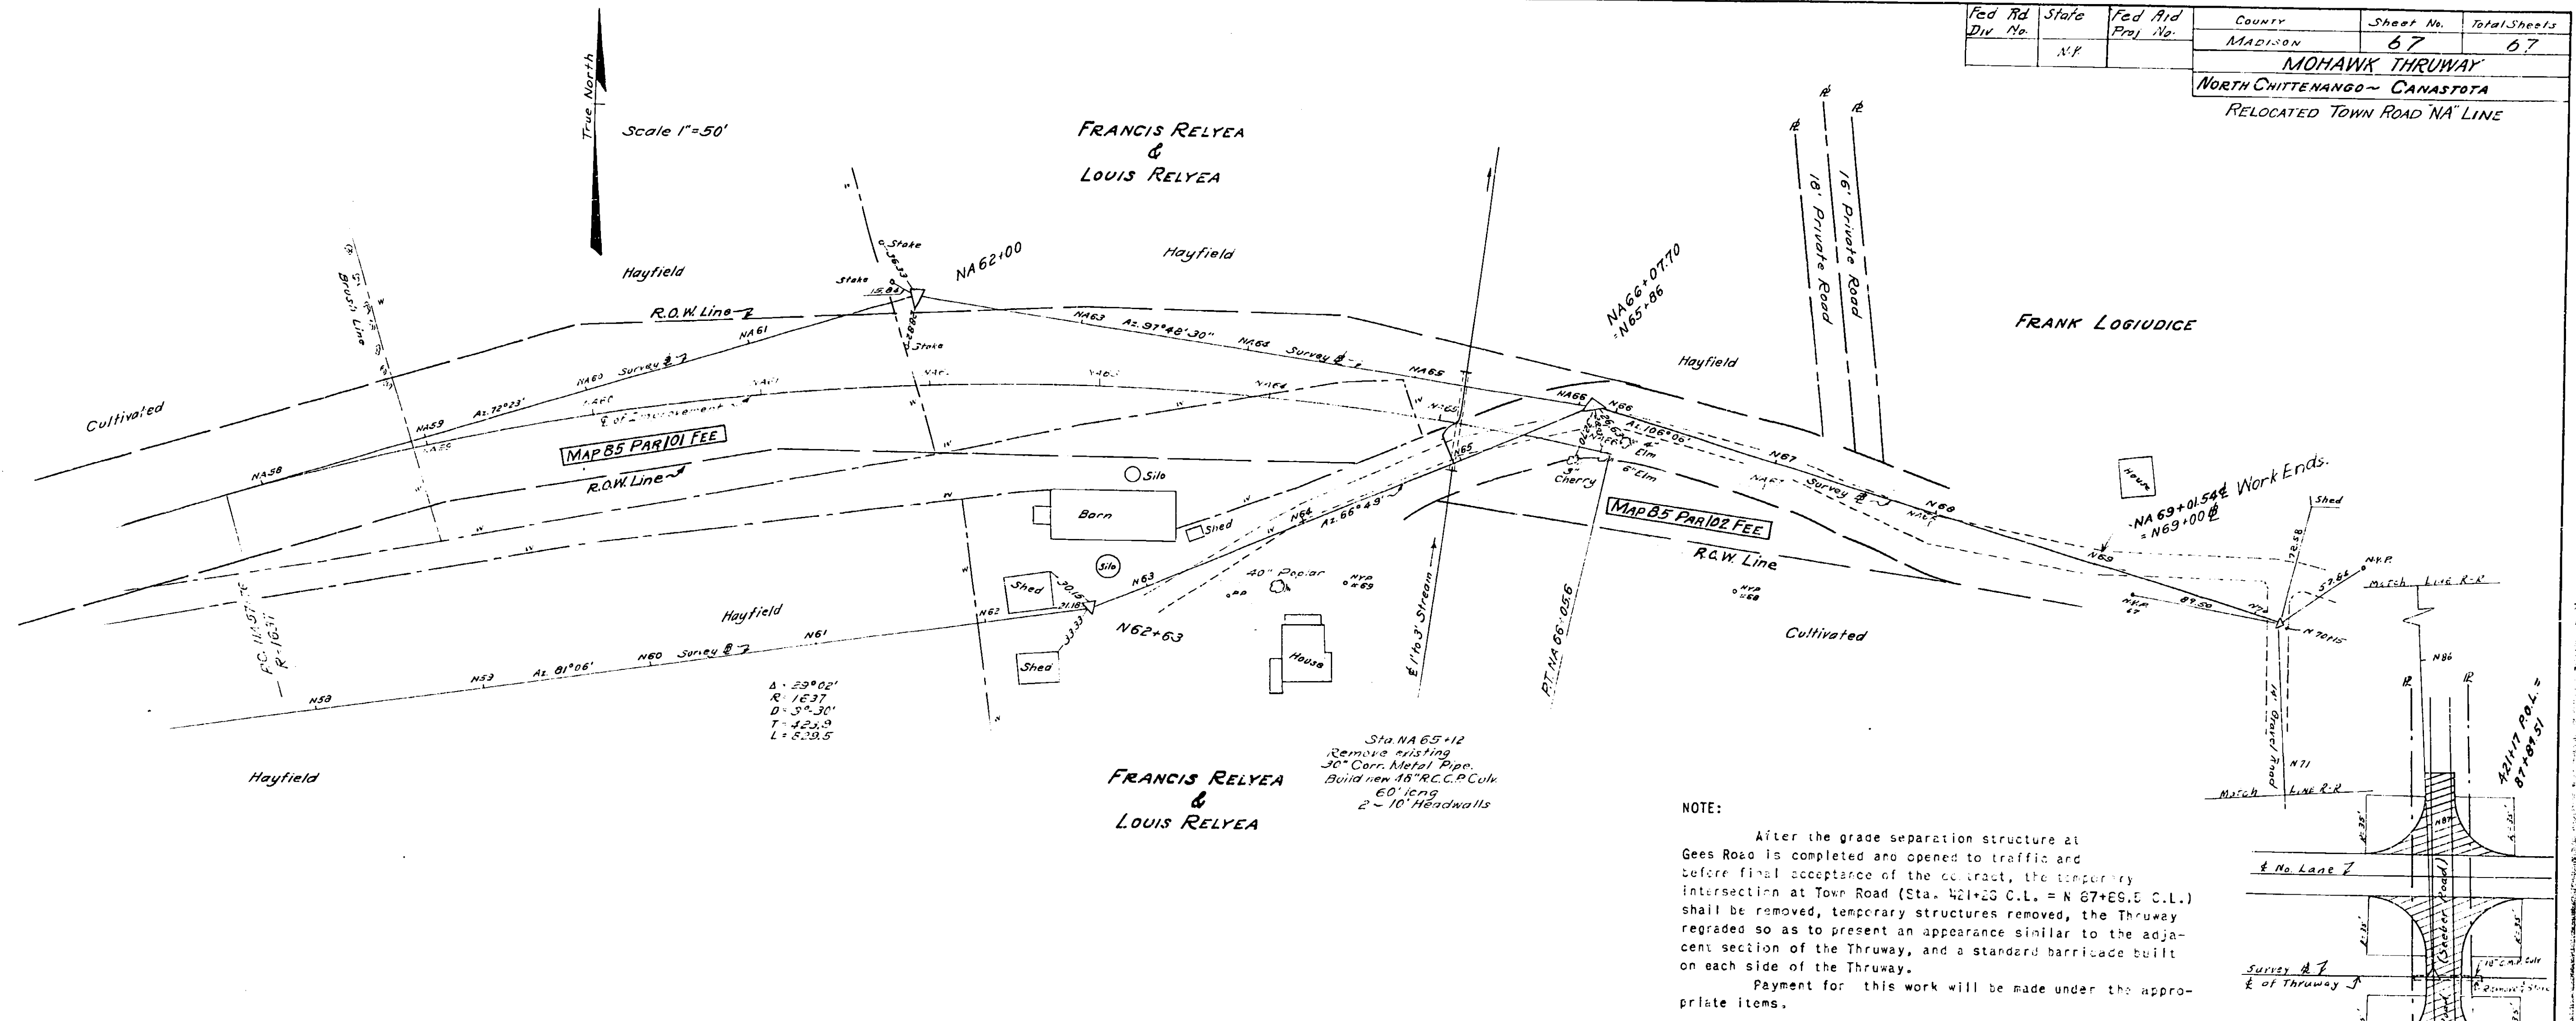

Made by Traced by Checked by

PLAN J.H. [Signature]


PROFILE J.H. [Signature]

Prepared pursuant to the Highway Law & recommended by:

Date [Blank] ENGINEER DISTRICT NO. 2



Fed Rd Div No.	State	Fed Aid Proj No.	Country	Sheet No.	Total Sheets
	N.P.		MADISON	67	67

MEHAWIK THRUWAY
NORTH CHITTENANGO - CANASTOTA
RELOCATED TOWN ROAD 'NA' LINE

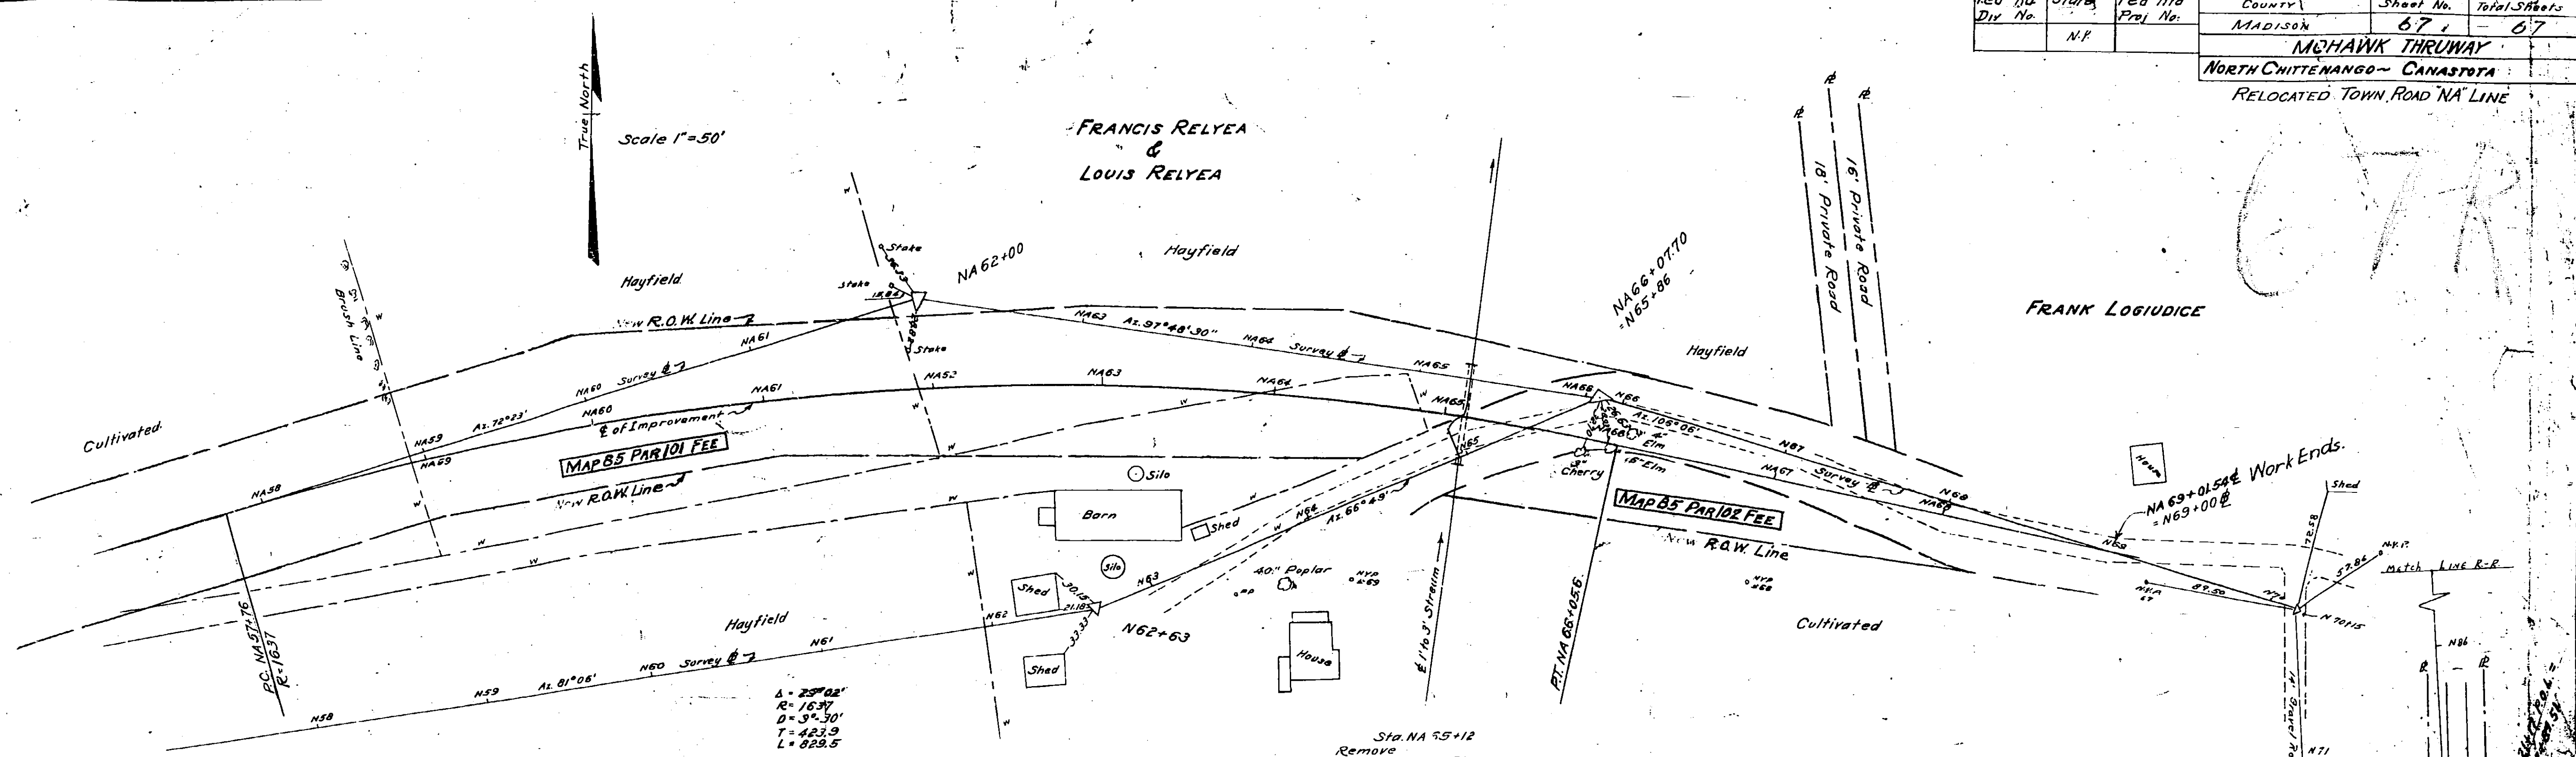

FRANCIS RELYEA
&
LOUIS RELYEA

NOTE:
After the grade separation structure at Gees Road is completed and opened to traffic and before final acceptance of the contract, the temporary intersection at Town Road (Sta. 421+23 C.L. = N 87+29.5 C.L.) shall be removed, temporary structures removed, the Thruway regraded so as to present an appearance similar to the adjacent section of the Thruway, and a standard barricade built on each side of the Thruway.
Payment for this work will be made under the appropriate items.

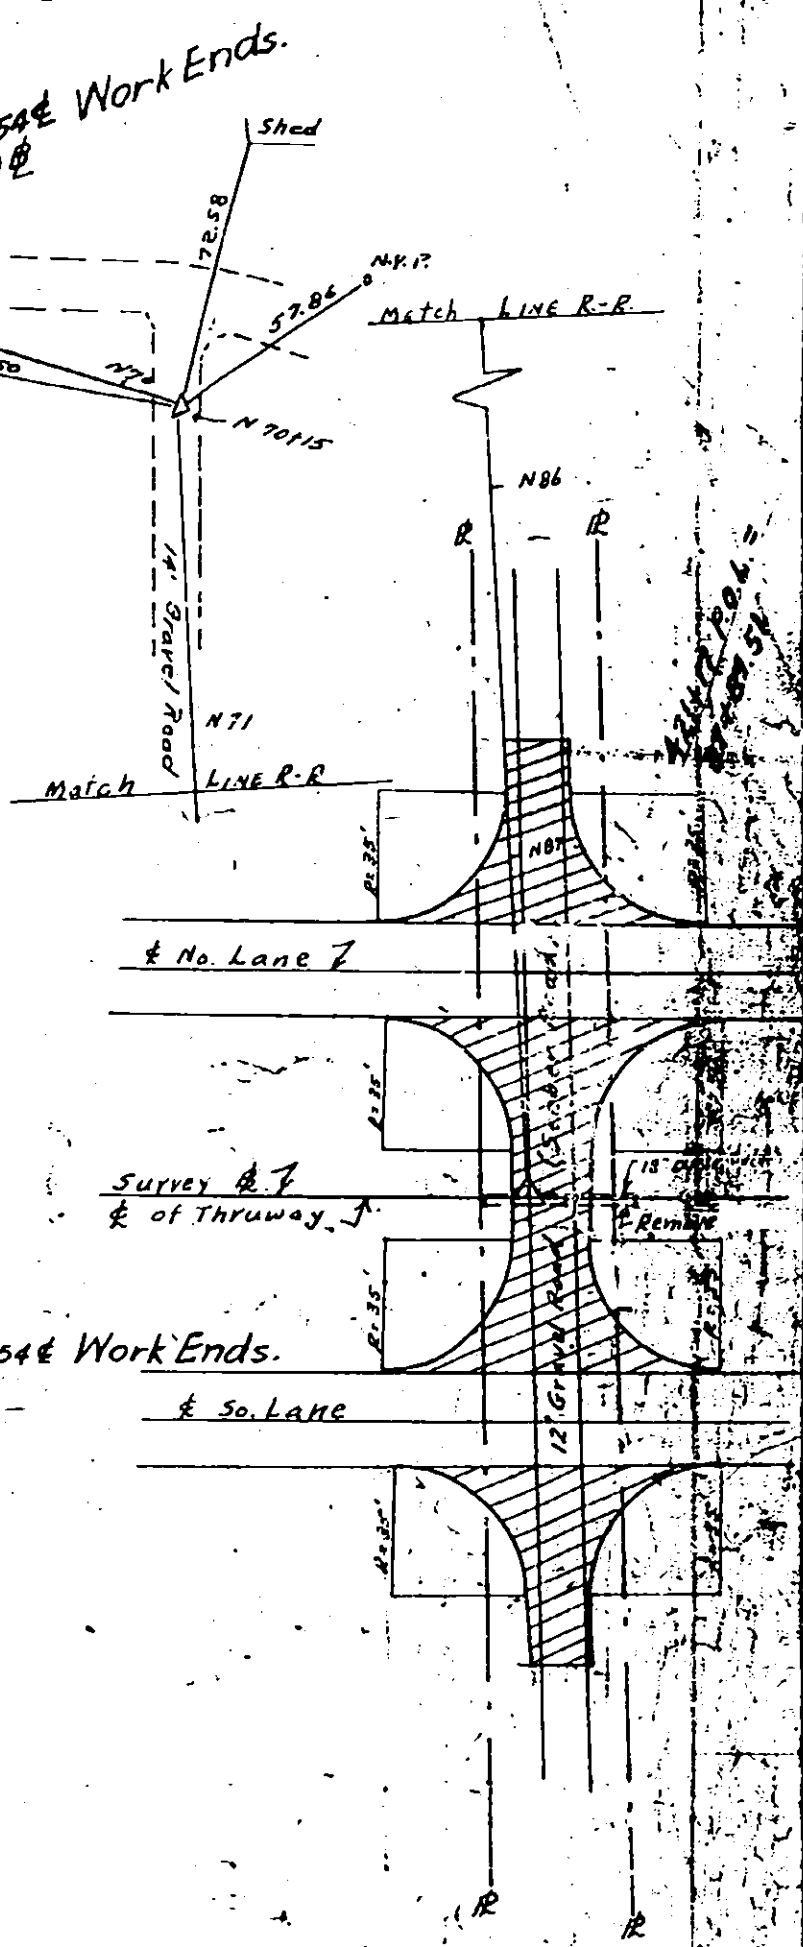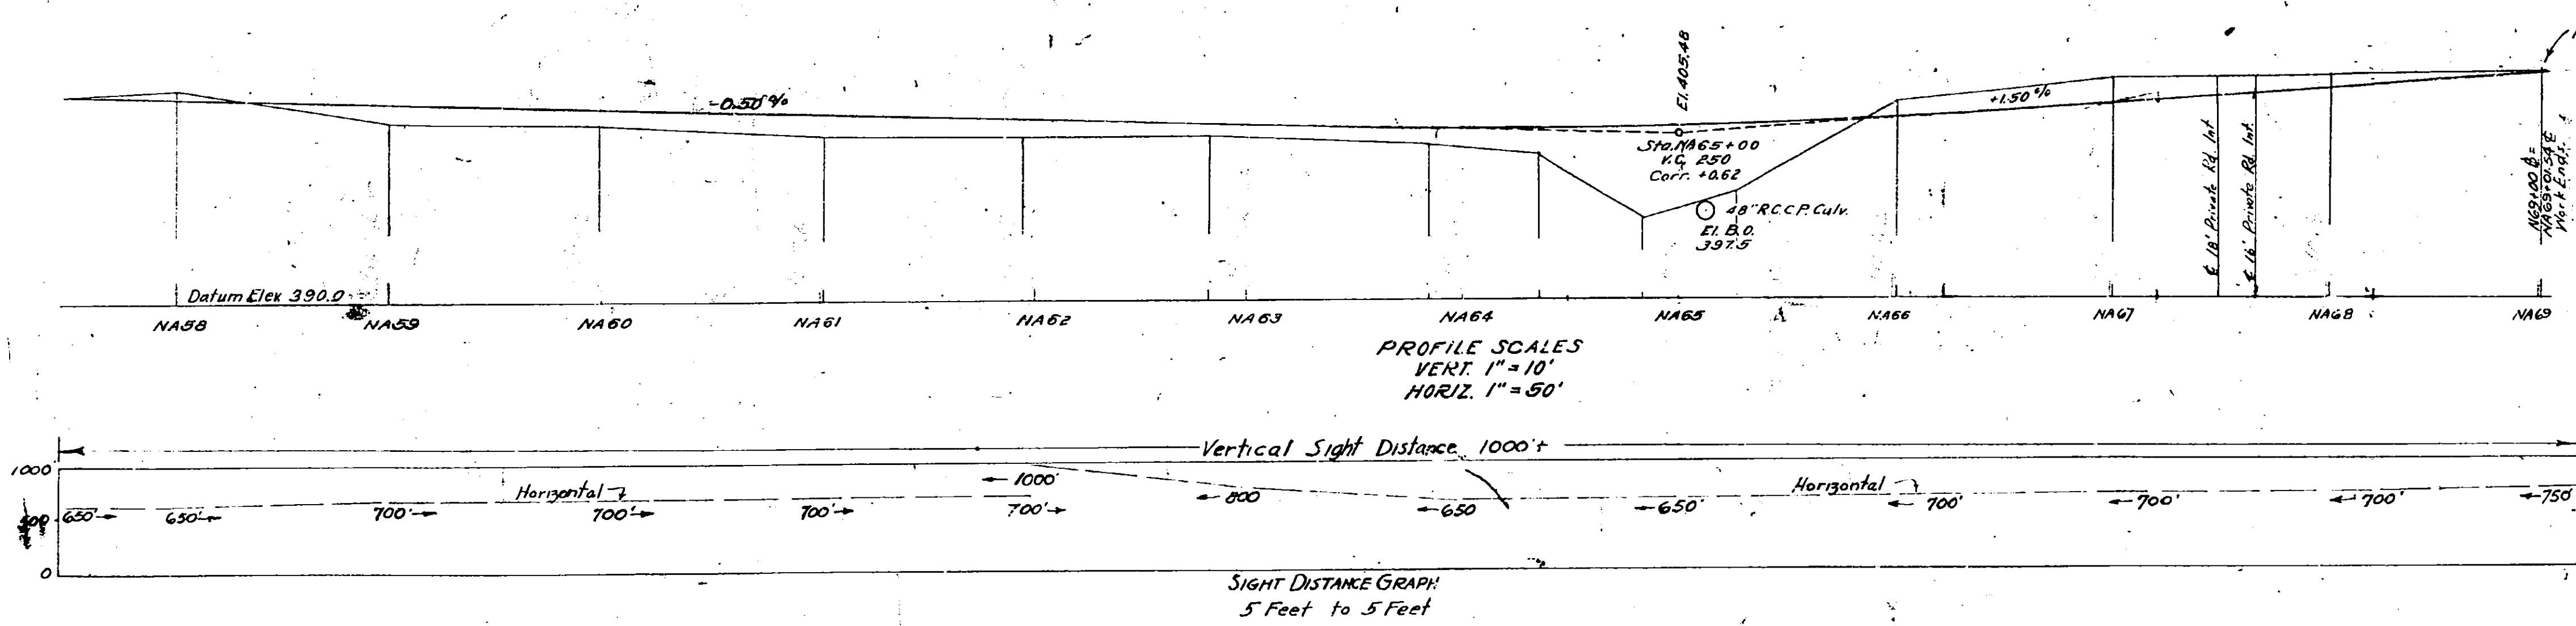

Made by Traced by Checked by
PLAN J. R. White
PROFILE J. R. White

Prepared pursuant to the Highway Law & recommended by:
DATE ENGINEER DISTRICT No. 2